
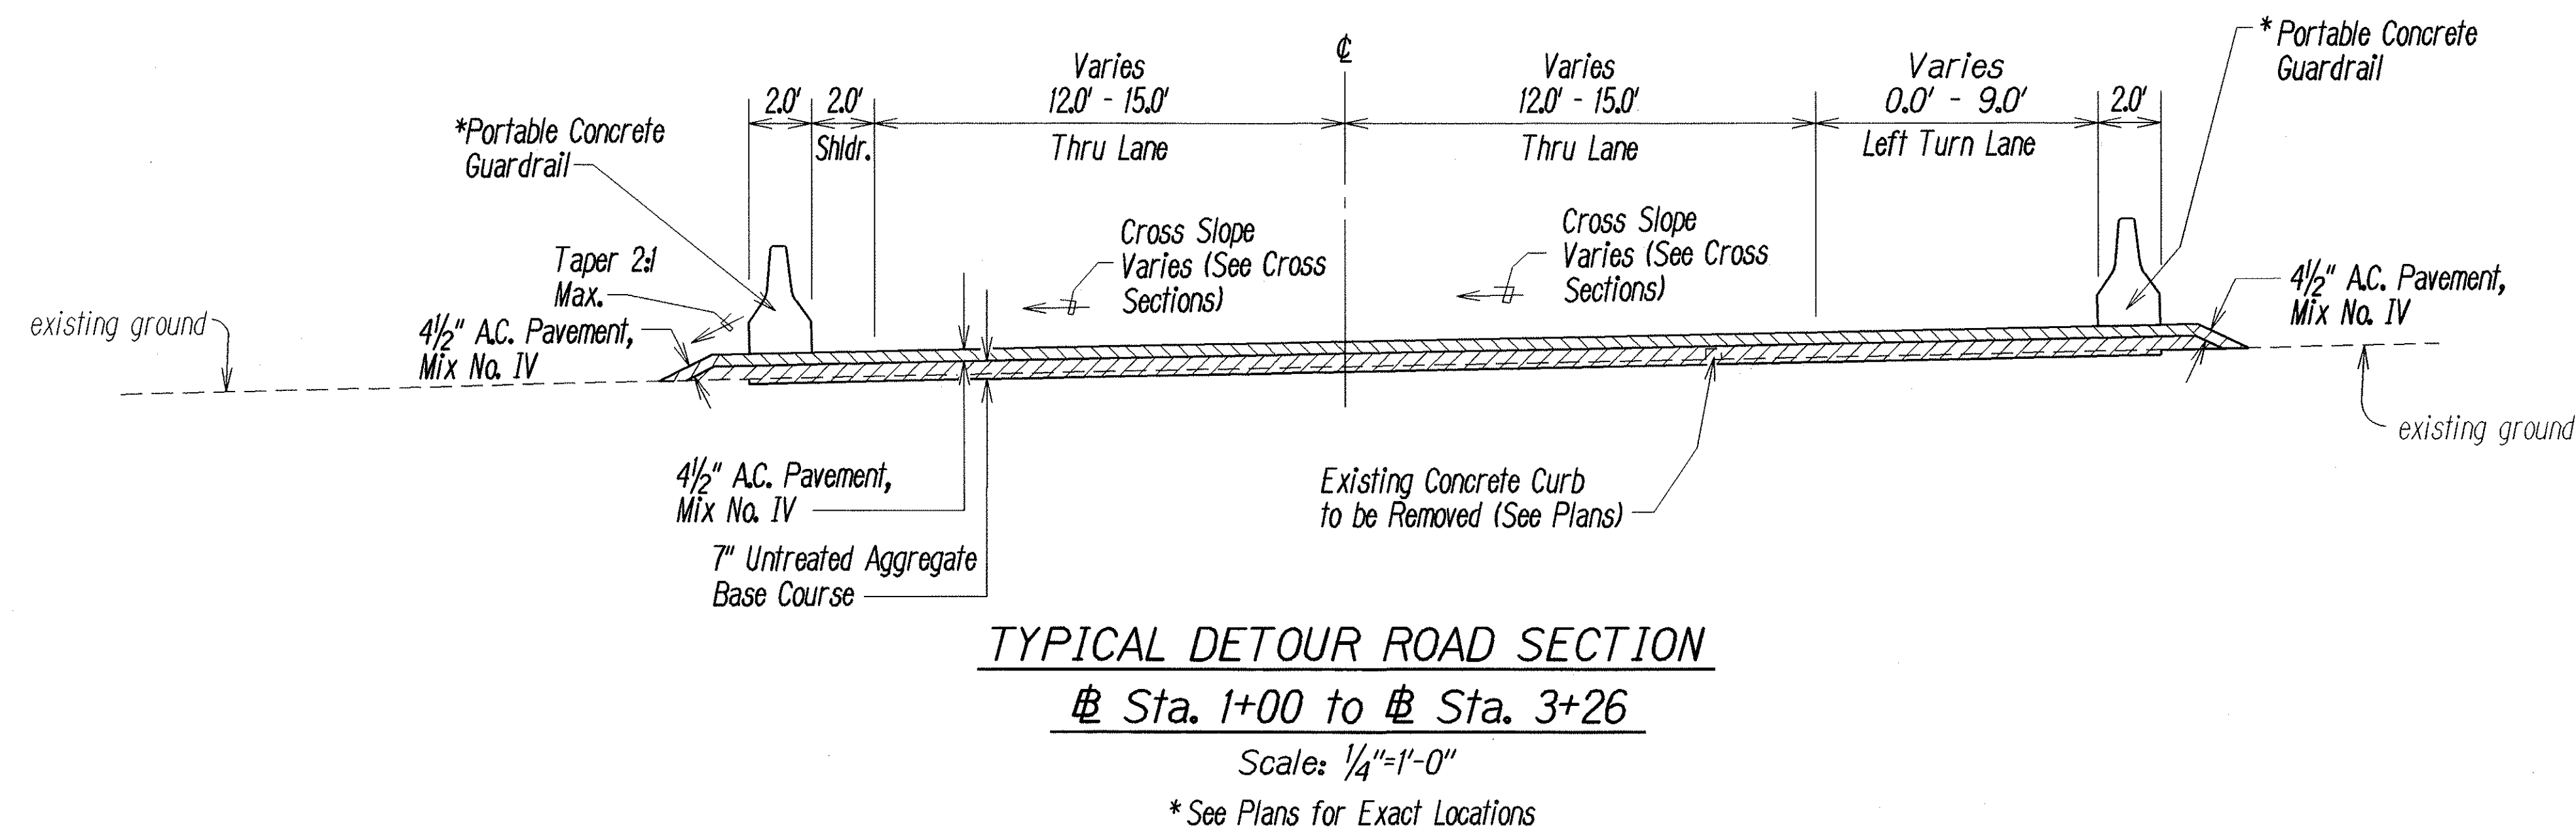
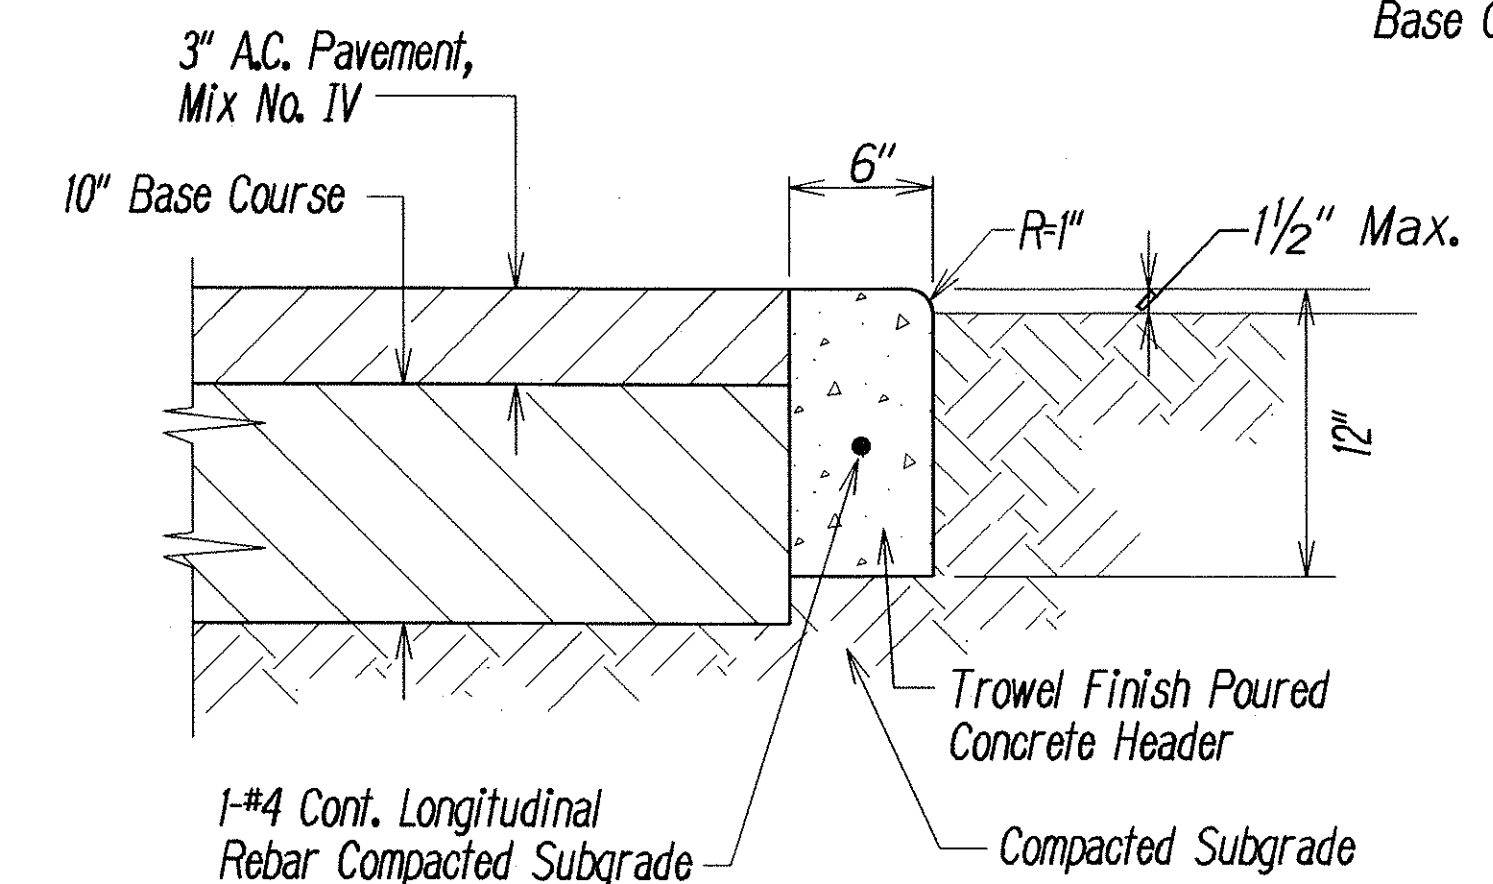



FED. ROAD DIST. NO.	STATE	FED. AID PROJ. NO.	FISCAL YEAR	SHEET NO.	TOTAL SHEETS
HAWAII	HAW.	BR-099-1(19)	2001	ADD.6	105

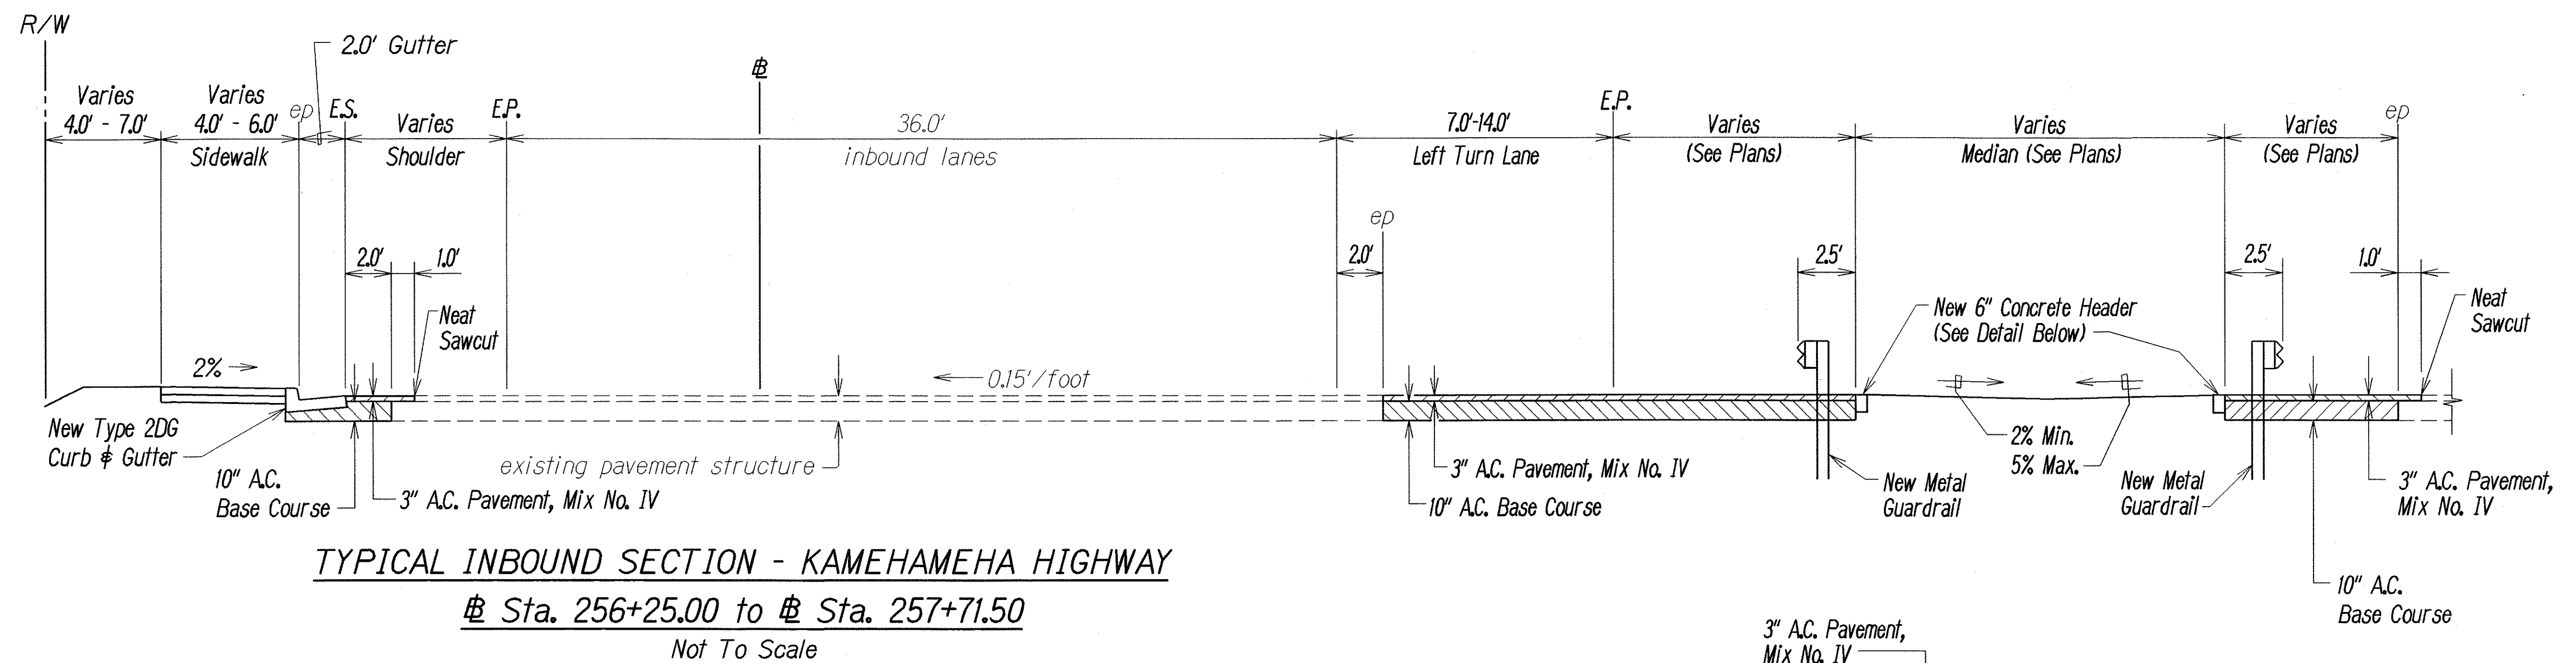


6/14/01	Revise Typical Detour Road Section.
DATE	REVISION
STATE OF HAWAII DEPARTMENT OF TRANSPORTATION HIGHWAYS DIVISION	
TYPICAL SECTION	
KAMEHAMEHA HIGHWAY	
Halawa Stream Bridge (Inbound) Replacement	
Federal Aid Project No. BR-099-1(19)	
Scale: As Shown	Date: Jan., 2001
SHEET No. 1 OF 3 SHEETS	

ADD.6

FED. ROAD DIST. NO.	STATE	FED. AID PROJ. NO.	FISCAL YEAR	SHEET NO.	TOTAL SHEETS
HAWAII	HAW.	BR-099-1(19)	2001	ADD.7	105

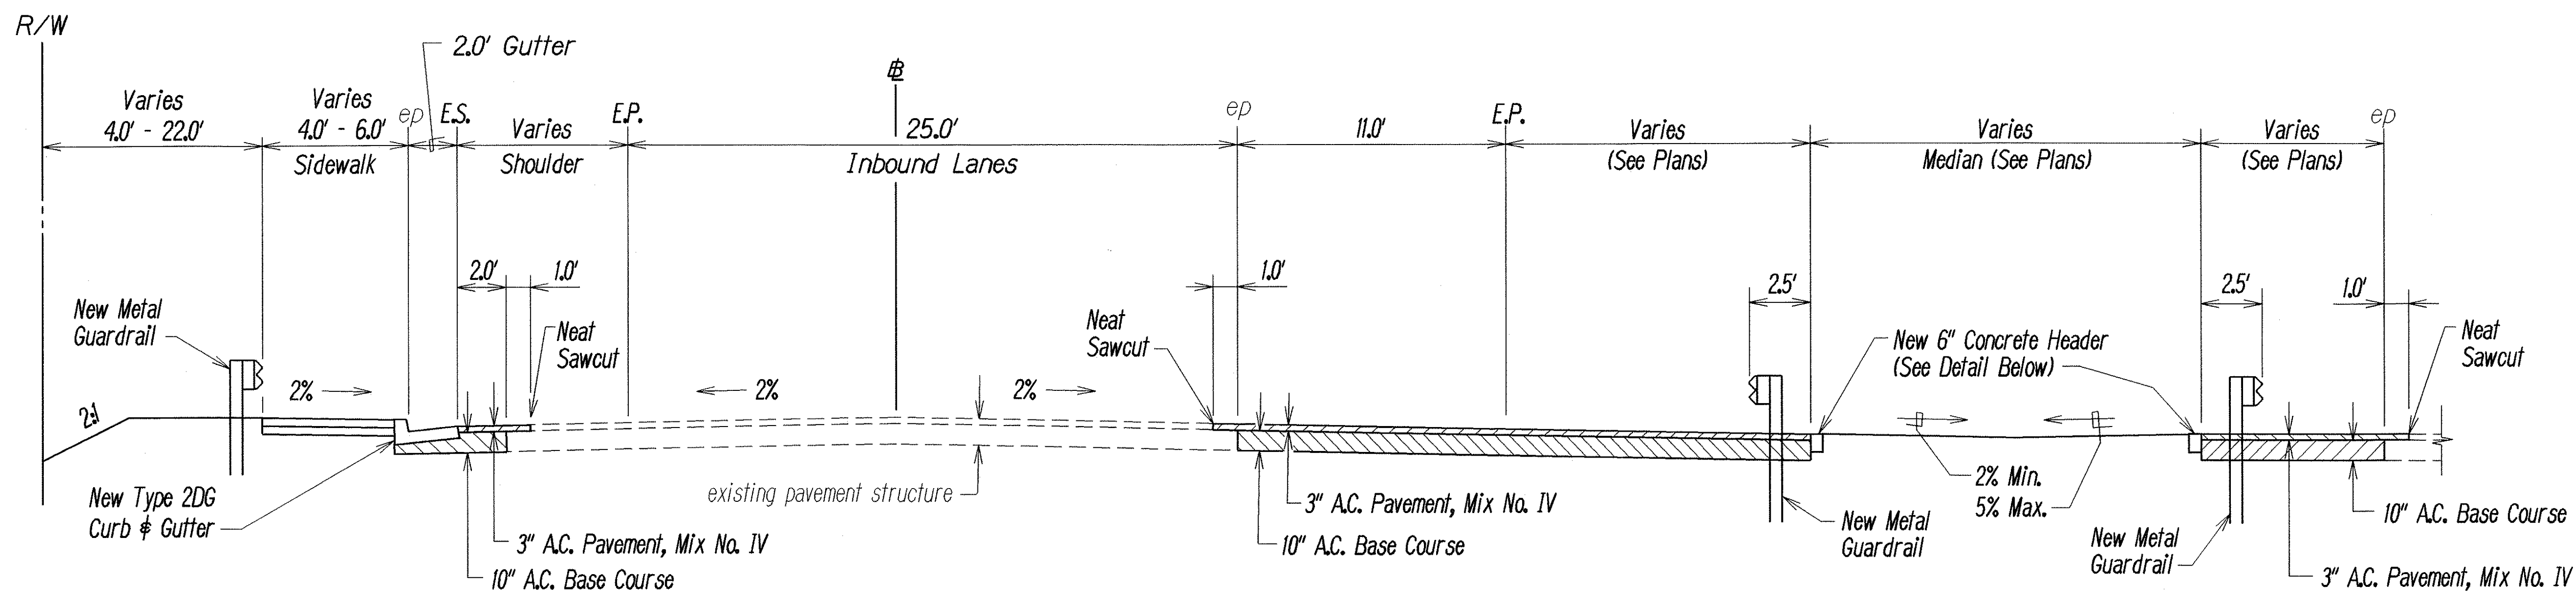

TYPICAL INBOUND SECTION - KAMEHAMEHA HIGHWAY
 Sta. 260+48.50 to Sta. 262+80.00
 Not To Scale

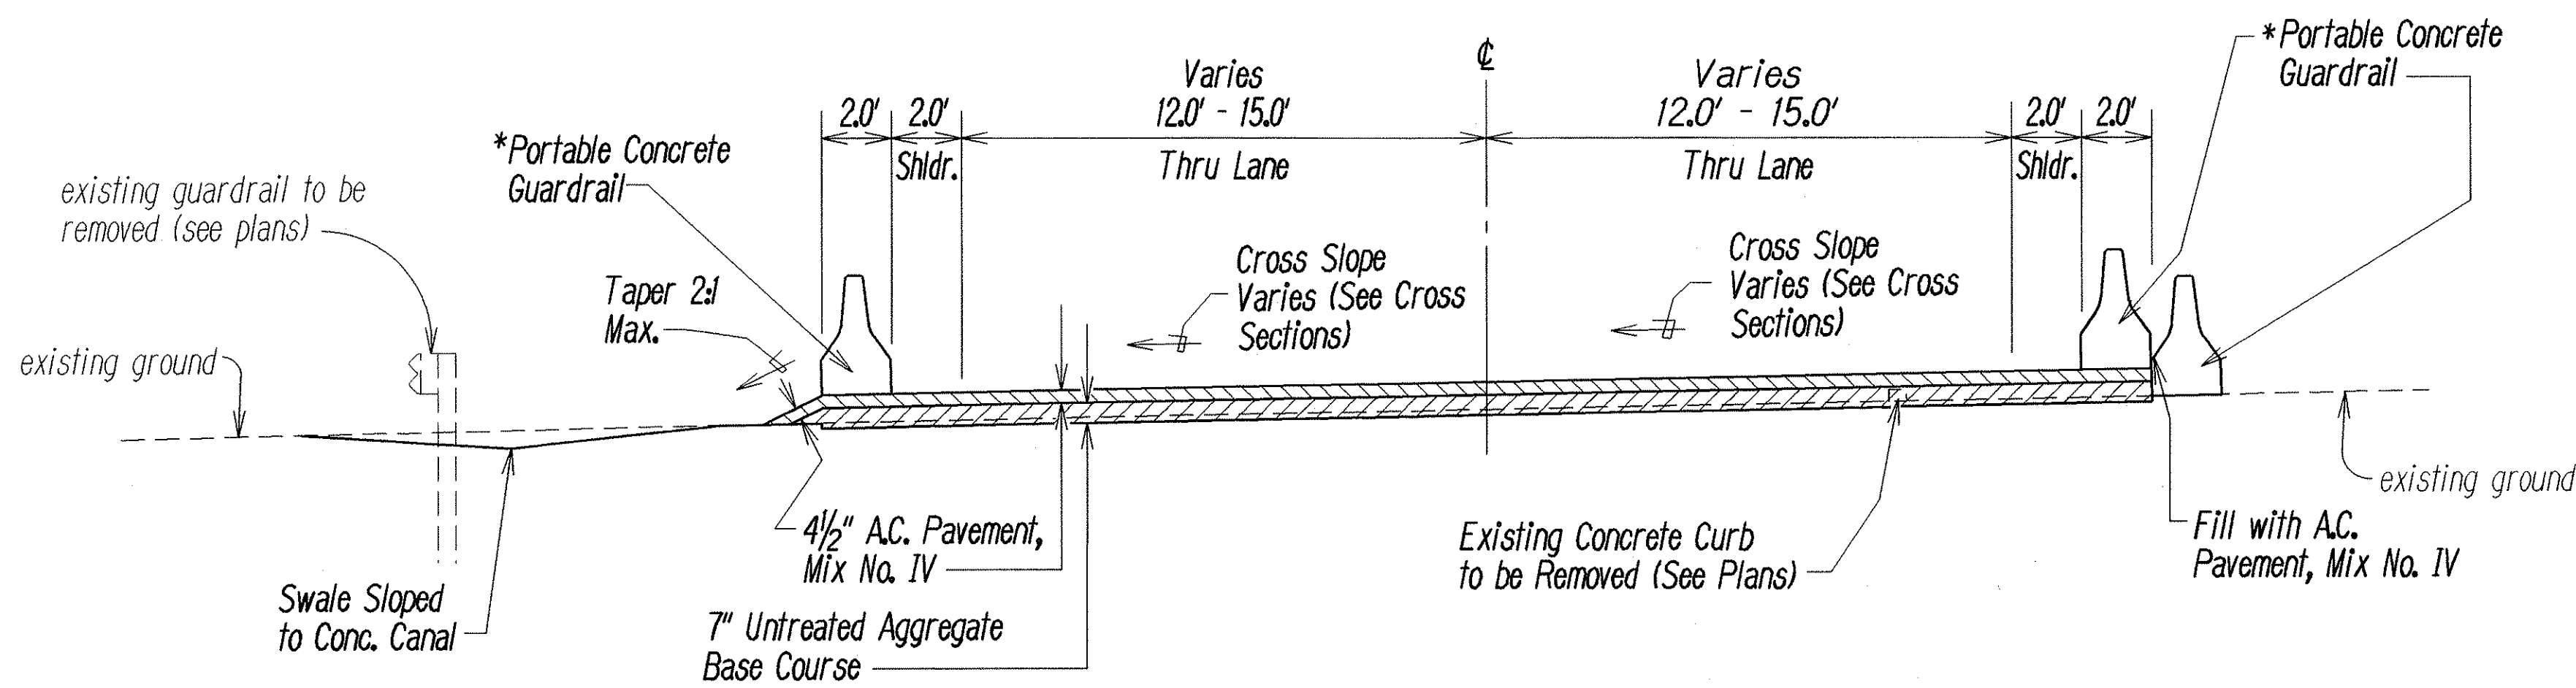


TYPICAL DETOUR ROAD SECTION
 Sta. 5+64 to Sta. 8+00
 Scale: 1/4"=1'-0"
 *See Plans for Exact Locations


DATE	_____
SURVEY PLOTTED BY	_____
DRAWN BY	_____
DESIGNED BY	_____
CHECKED BY	_____
ORIGINAL PLAN	_____
NOTE BOOK	_____
NO.	_____

6/14/01	Revise Typical Detour Road Section.
DATE	REVISION
STATE OF HAWAII DEPARTMENT OF TRANSPORTATION HIGHWAYS DIVISION	
TYPICAL SECTION	
KAMEHAMEHA HIGHWAY	
Halawa Stream Bridge (Inbound) Replacement	
Federal Aid Project No. BR-099-1(19)	
Scale: As Shown	Date: Jan., 2001
SHEET No. 2 OF 3 SHEETS	


FED. ROAD DIST. NO.	STATE	FED. AID PROJ. NO.	FISCAL YEAR	SHEET NO.	TOTAL SHEETS
HAWAII	HAW.	BR-099-1(19)	2001	8	105

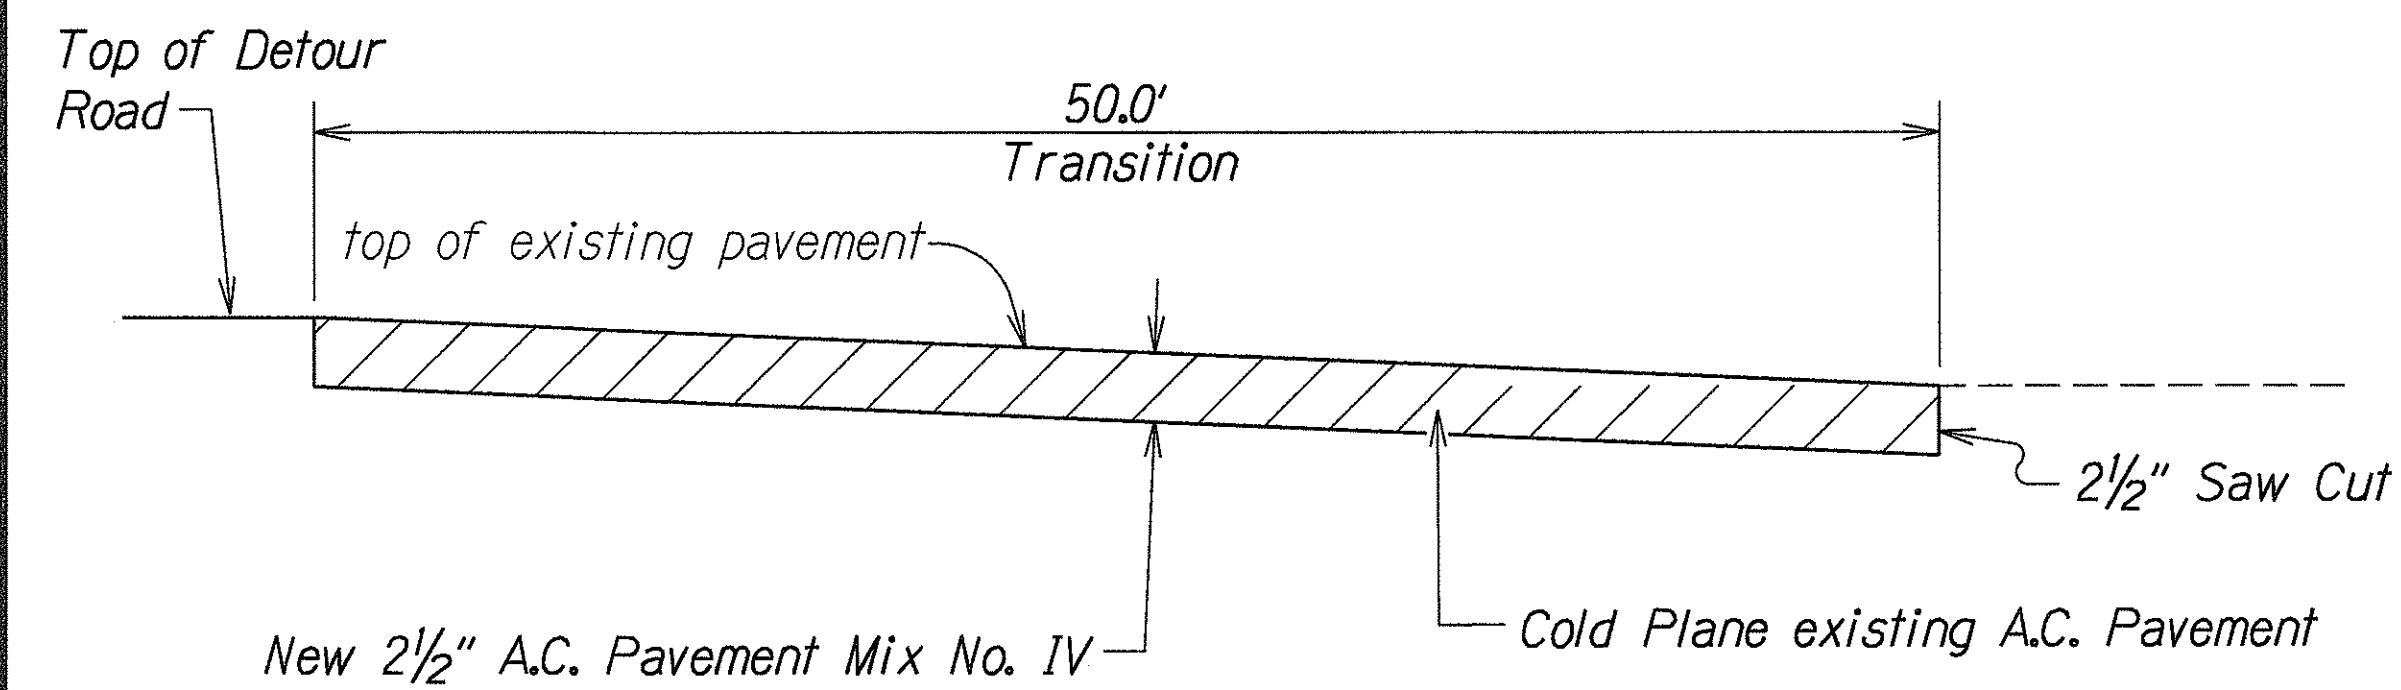


COLD PLANED TRANSITION TO EXISTING A.C. PAVEMENT
DETOUR ROAD CONNECTION TO KAMEHAMEHA HIGHWAY
 Not To Scale

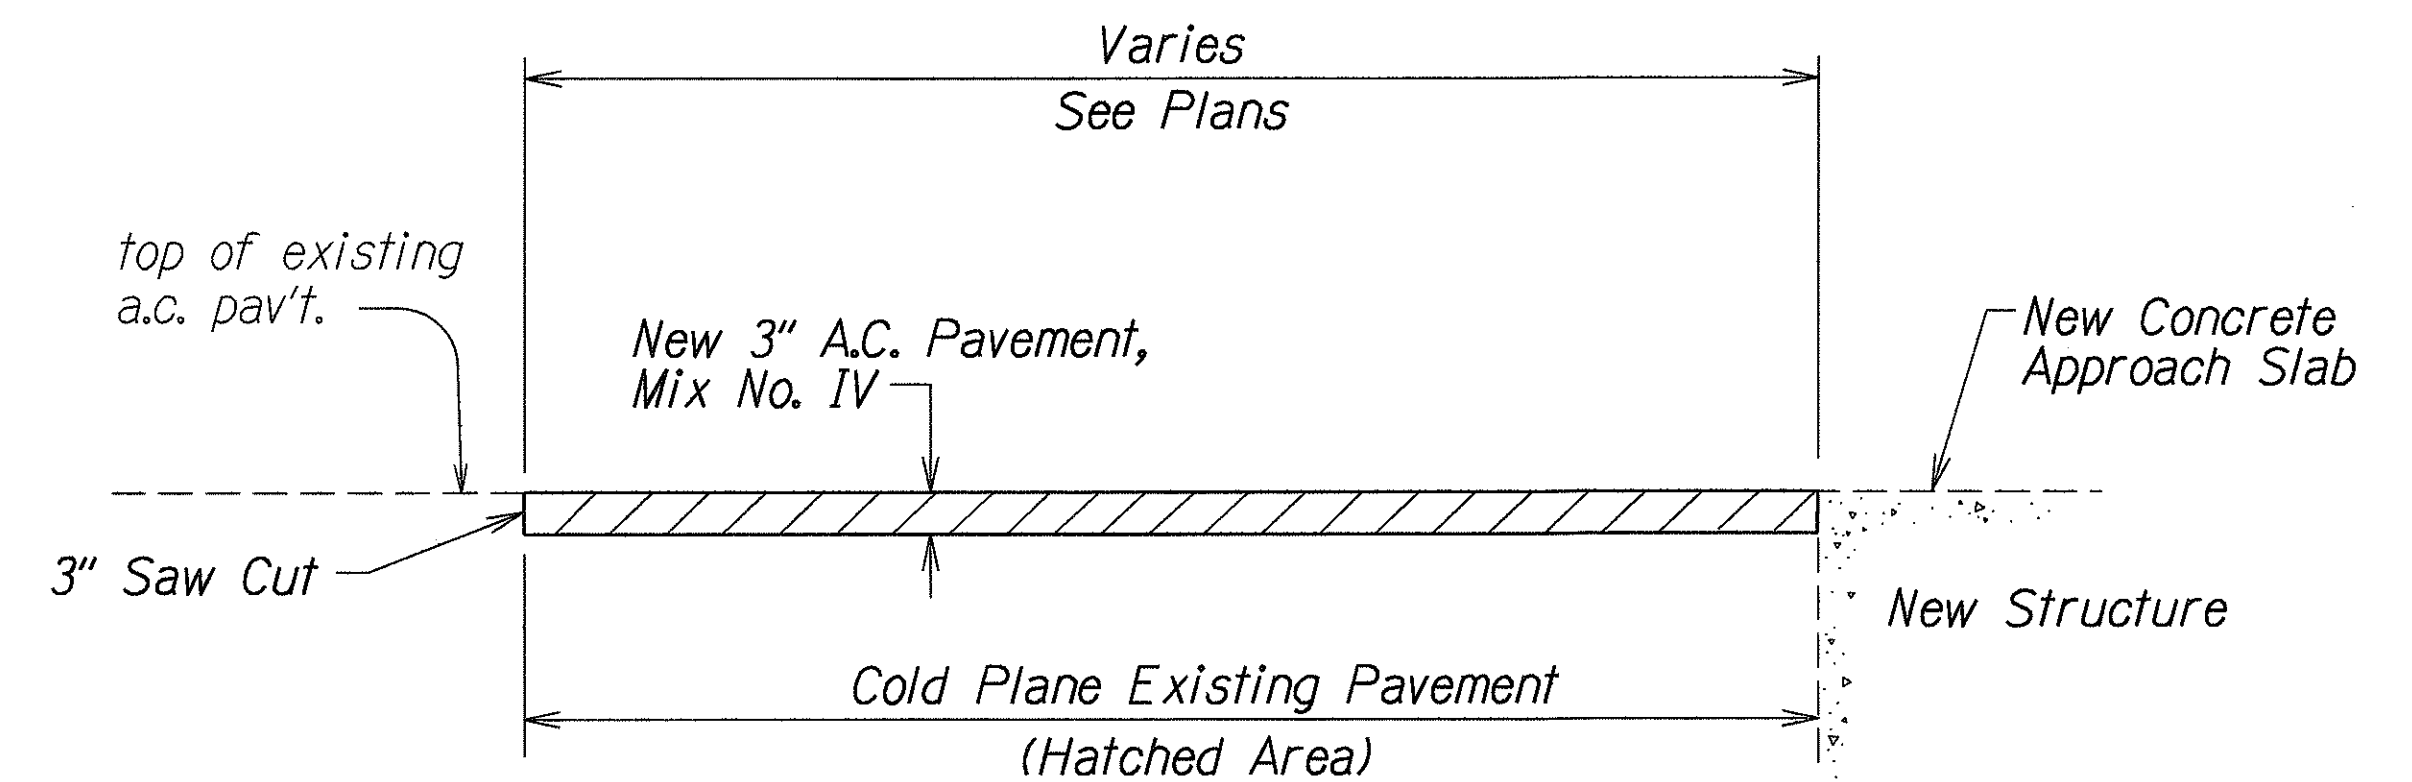

COLD PLANED TRANSITION AT STRUCTURE
 Not to Scale

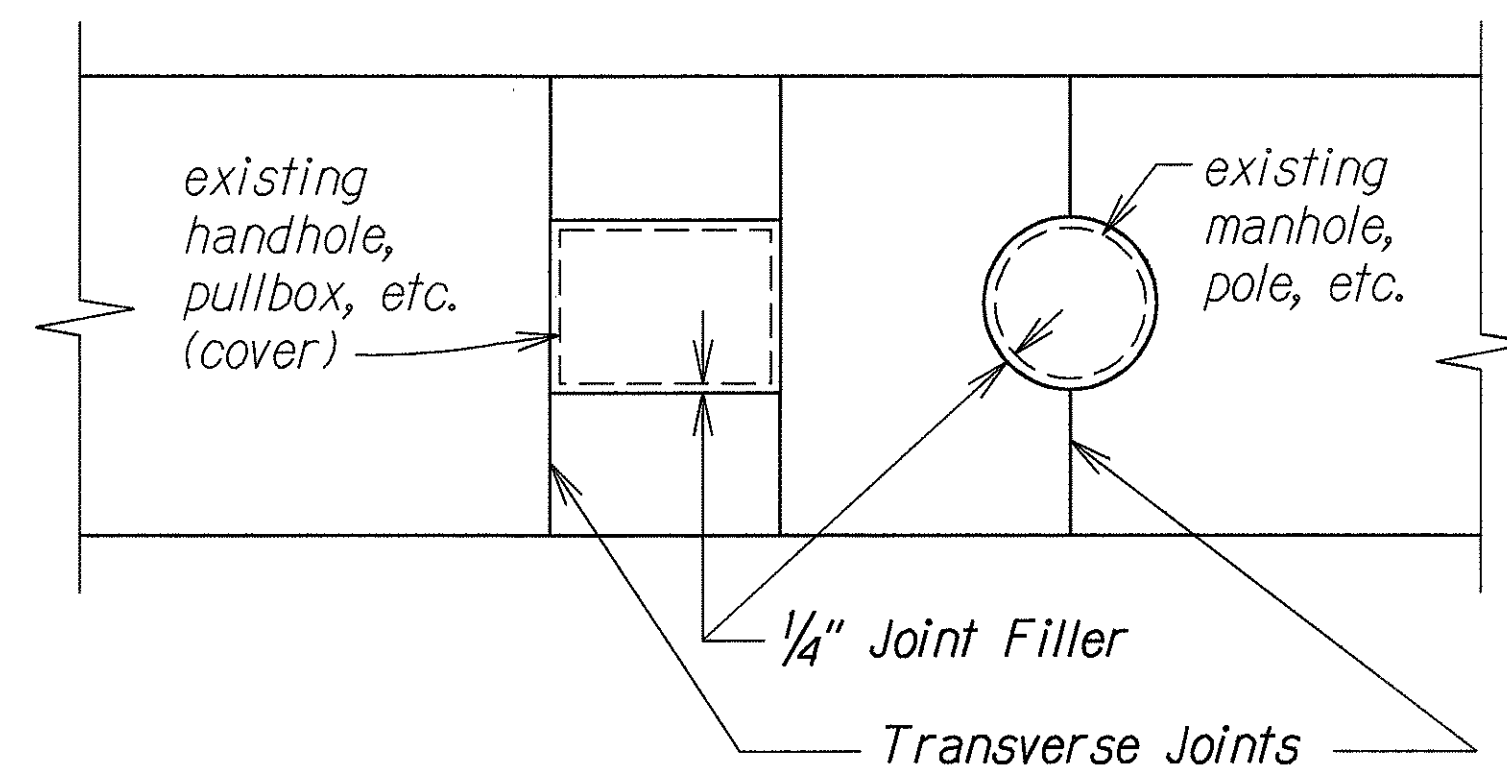


SIDEWALK ISOLATION JOINT DETAIL
 Not To Scale

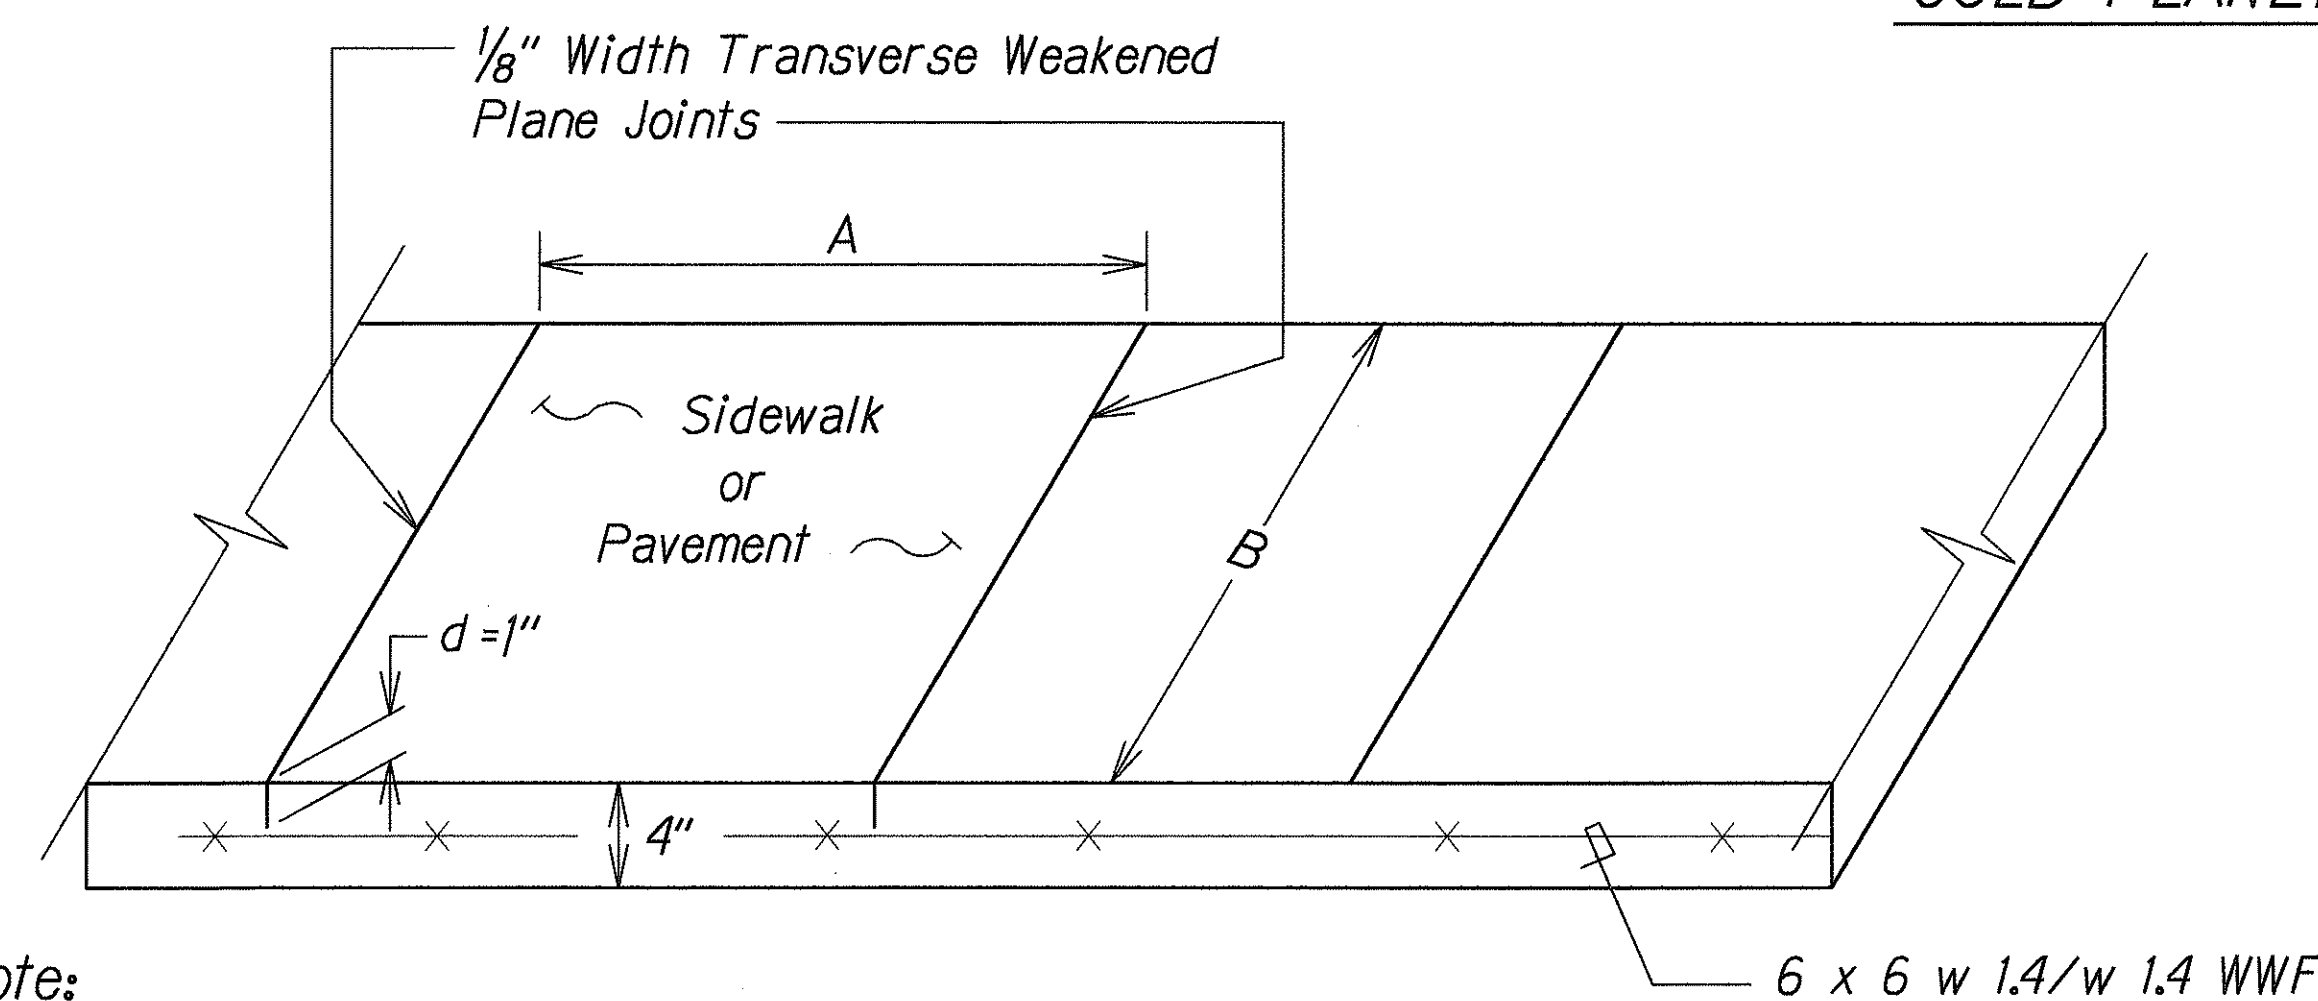


Note:
 1. (B/A or A/B) < 1.25 and (A or B) not to exceed 7'


SIDEWALK SCORE LINE DETAIL
 Not To Scale

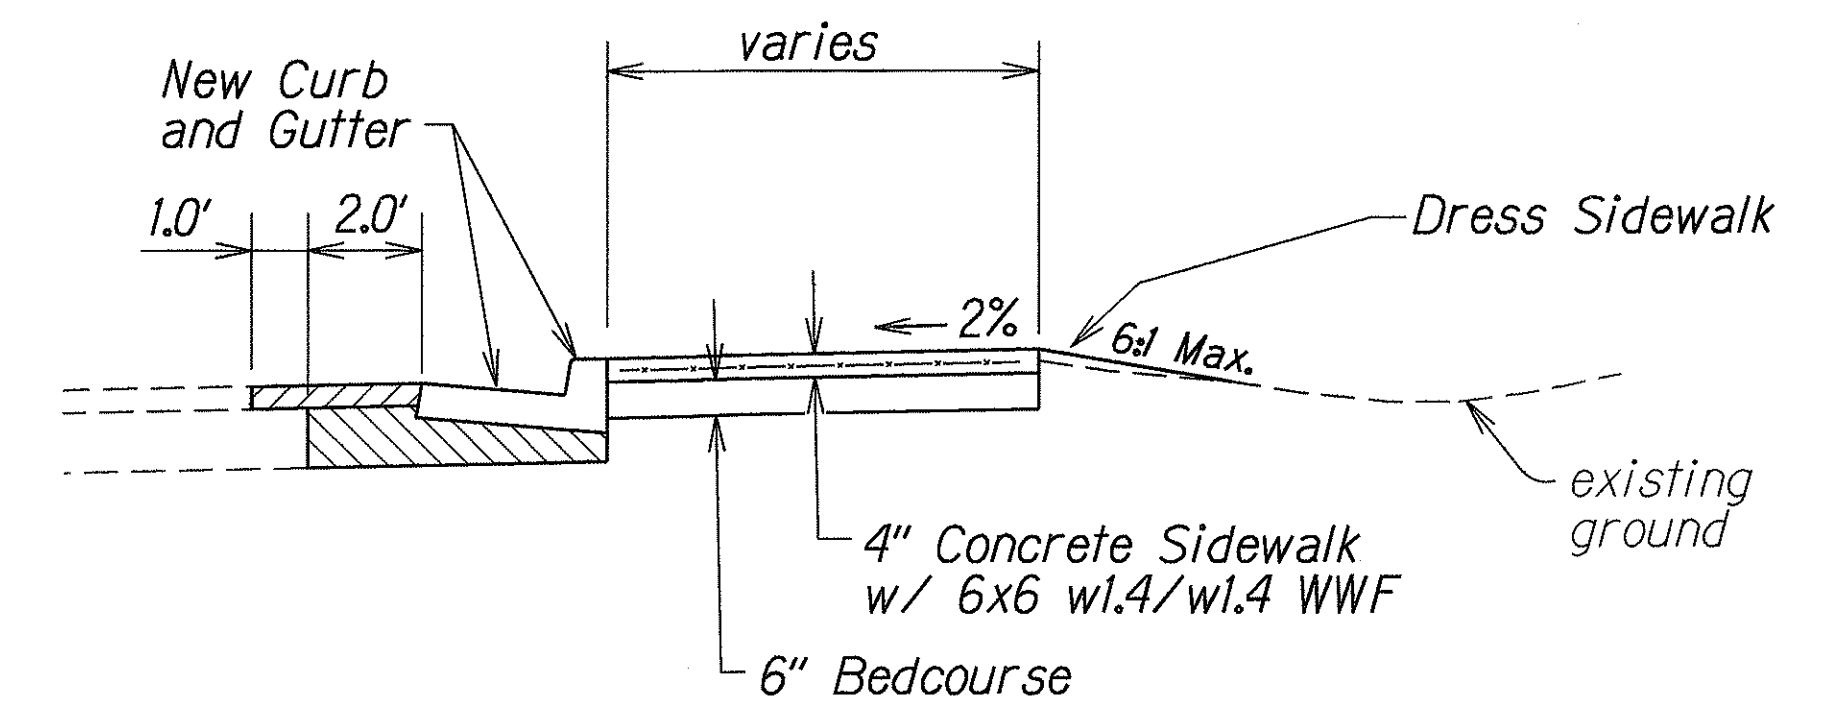

SIDEWALK DETAIL
 Not to Scale

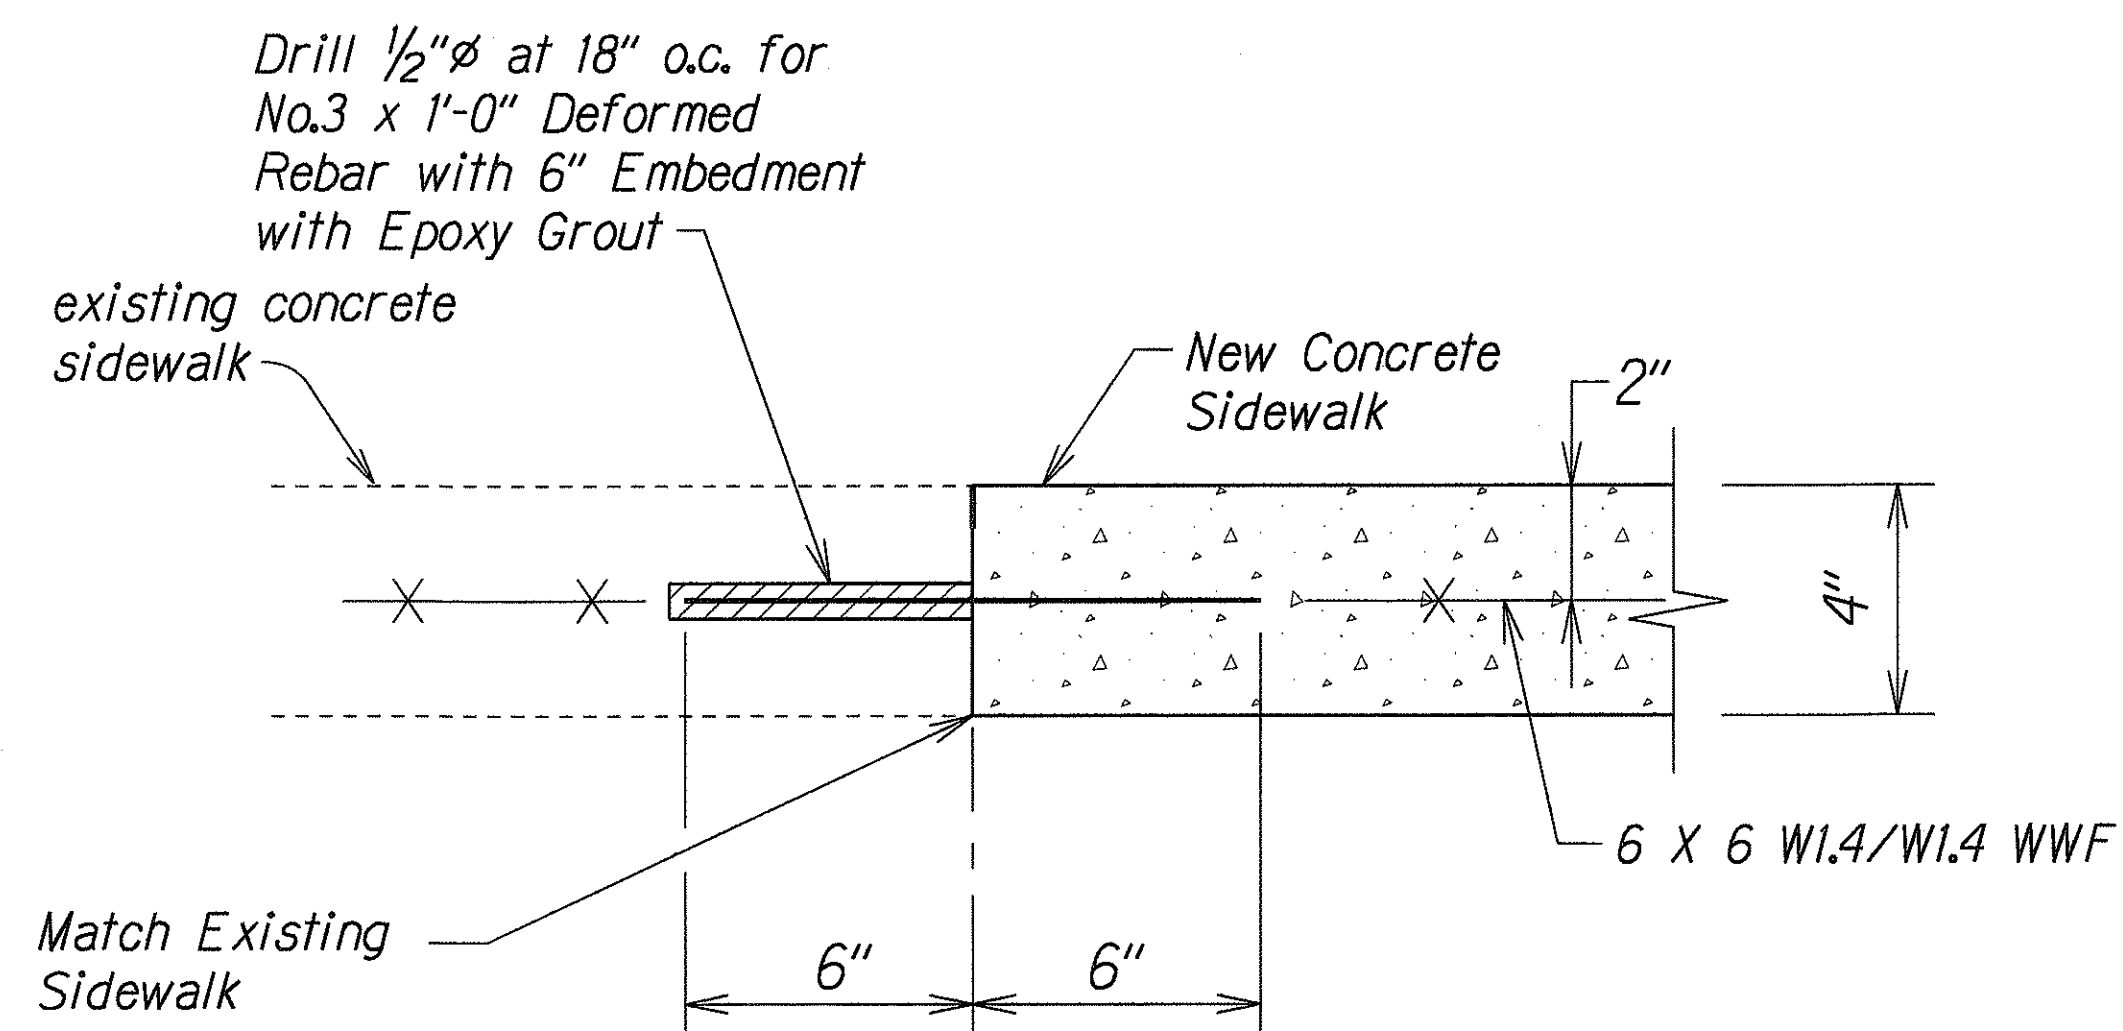

TRANSVERSE JOINT AT EXISTING SIDEWALK
 Not to Scale

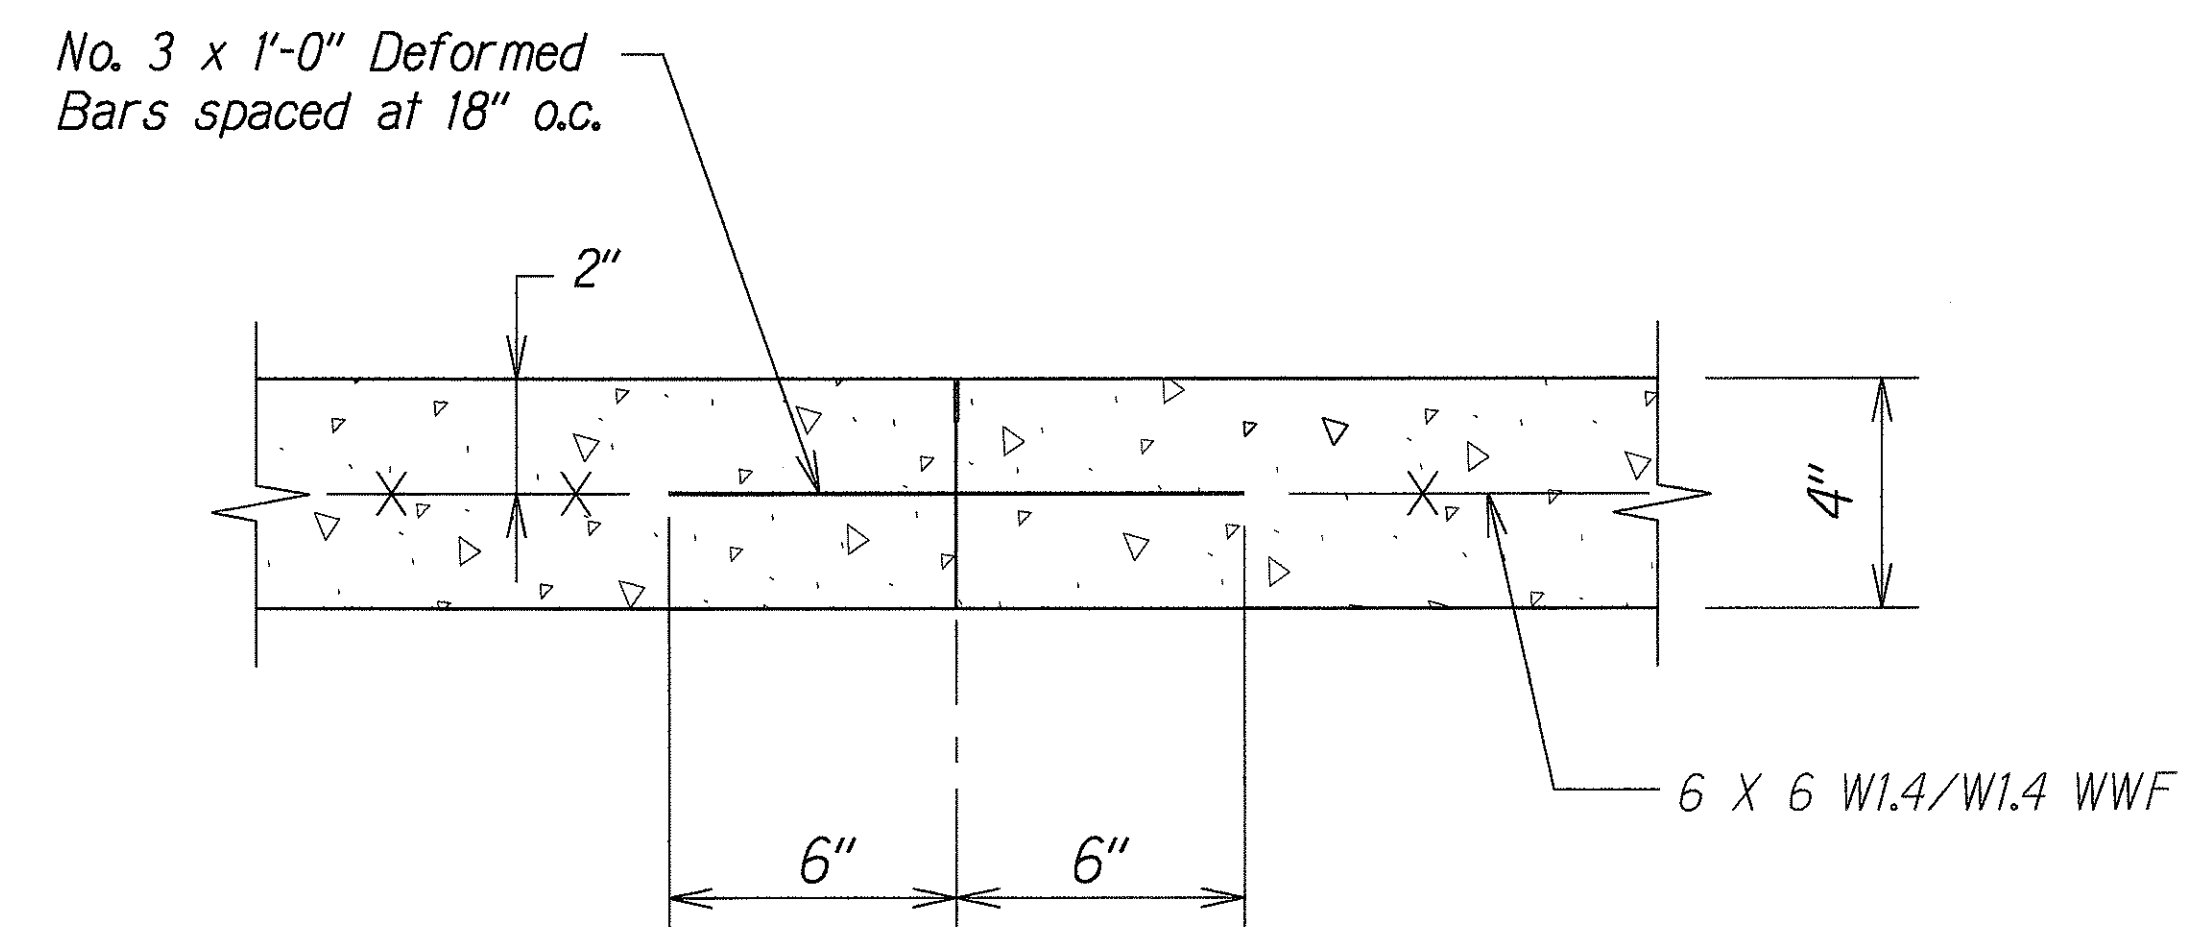

TRANSVERSE CONSTRUCTION JOINT DETAIL
 Not to Scale

DESIGNED BY	DATE
10-6-98	
CHECKED BY	
10-6-98	
NOTED BY	
10-6-98	
QUANTITIES BY	
10-6-98	
CHECKED BY	
10-6-98	

STATE OF HAWAII
 DEPARTMENT OF TRANSPORTATION
 HIGHWAYS DIVISION

TYPICAL DETAILS

KAMEHAMEHA HIGHWAY

Halawa Stream Bridge (Inbound) Replacement

Federal Aid Project No. BR-099-1(19)

Not to Scale Date: October, 2000

SHEET No. 3 OF 3 SHEETS