


FED. ROAD DIST. NO.	STATE	FED. AID PROJ. NO.	FISCAL YEAR	SHEET NO.	TOTAL SHEETS
HAWAII	HAW.	BR-099-1(19)	2001	21	105

TRUE NORTH
SCALE: 1" = 40'

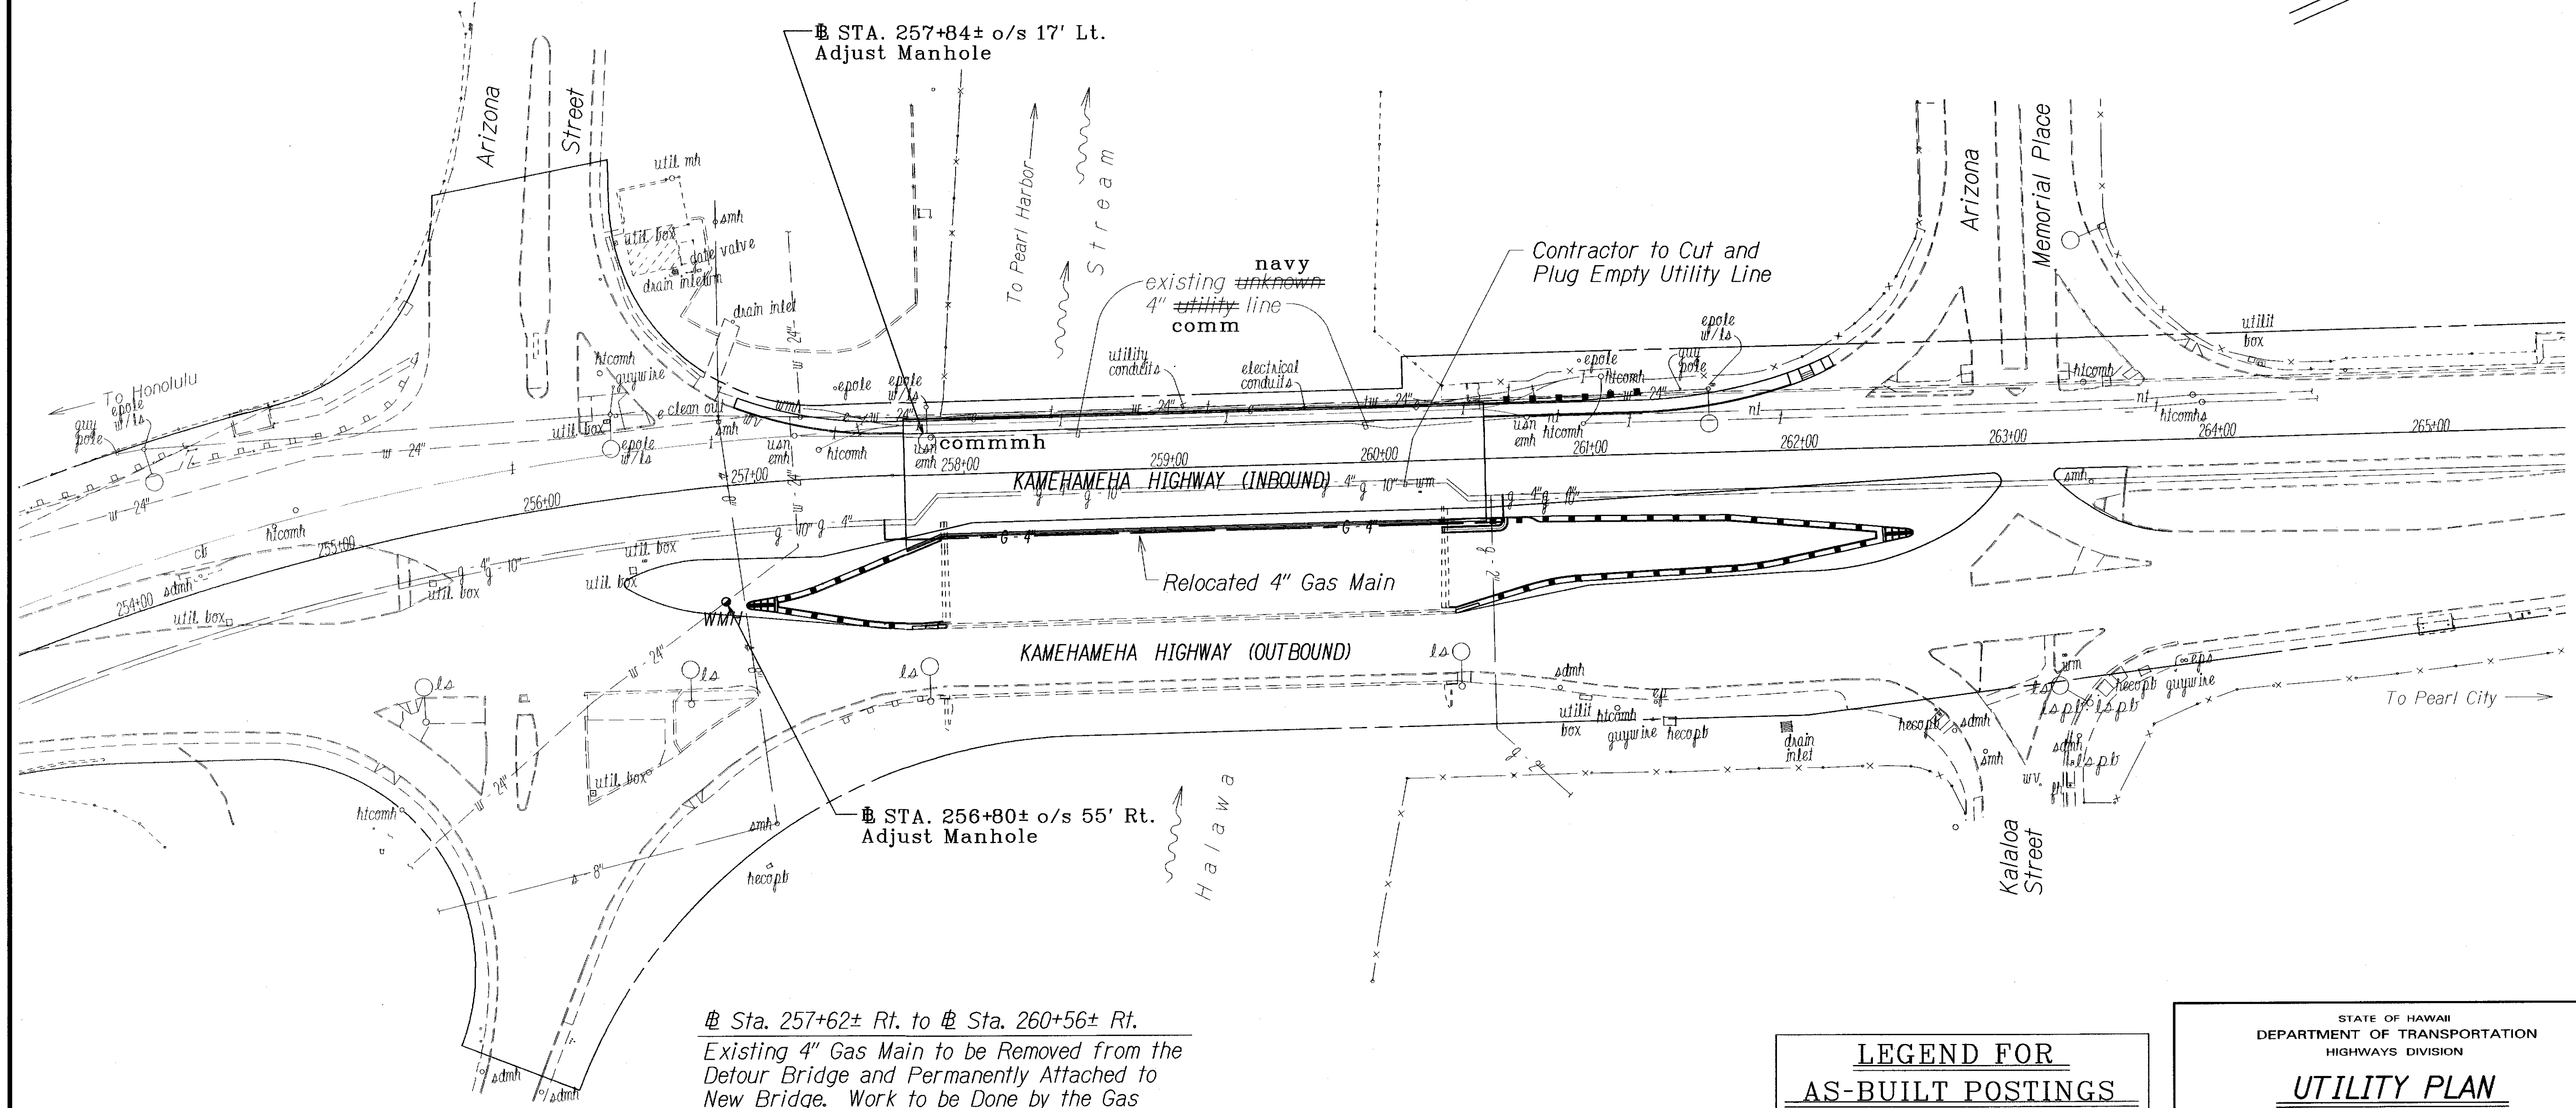

Sta. 257+62± Rt. to Sta. 260+56± Rt.
Existing 4" Gas Main to be Removed from the Detour Bridge and Permanently Attached to New Bridge. Work to be Done by the Gas Company Contractor For Details, See Plan Sheet No. 22.

LEGEND FOR AS-BUILT POSTINGS	
	Squiggly line for as-built deletion
	Double line for as-built deletion
Roadway	Text for as-built posting

STATE OF HAWAII
DEPARTMENT OF TRANSPORTATION
HIGHWAYS DIVISION

UTILITY PLAN

KAMEHAMEHA HIGHWAY
Halawa Stream Bridge (Inbound) Replacement
Federal Aid Project No. BR-099-1(19)

Scale: 1"=40' Date: Jan., 2001

SHEET No. 1 OF 1 SHEETS

ORIGINAL PLAN	DATE
NOTED BY	12/21/00
DESIGNED BY	
QUANTITIES BY	
CHECKED BY	

"AS-BUILT"