



FED. ROAD DIST. NO.	STATE	FED. AID PROJ. NO.	FISCAL YEAR	SHEET NO.	TOTAL SHEETS
HAWAII	HAW.	DE-0200(803)	2000	14	79

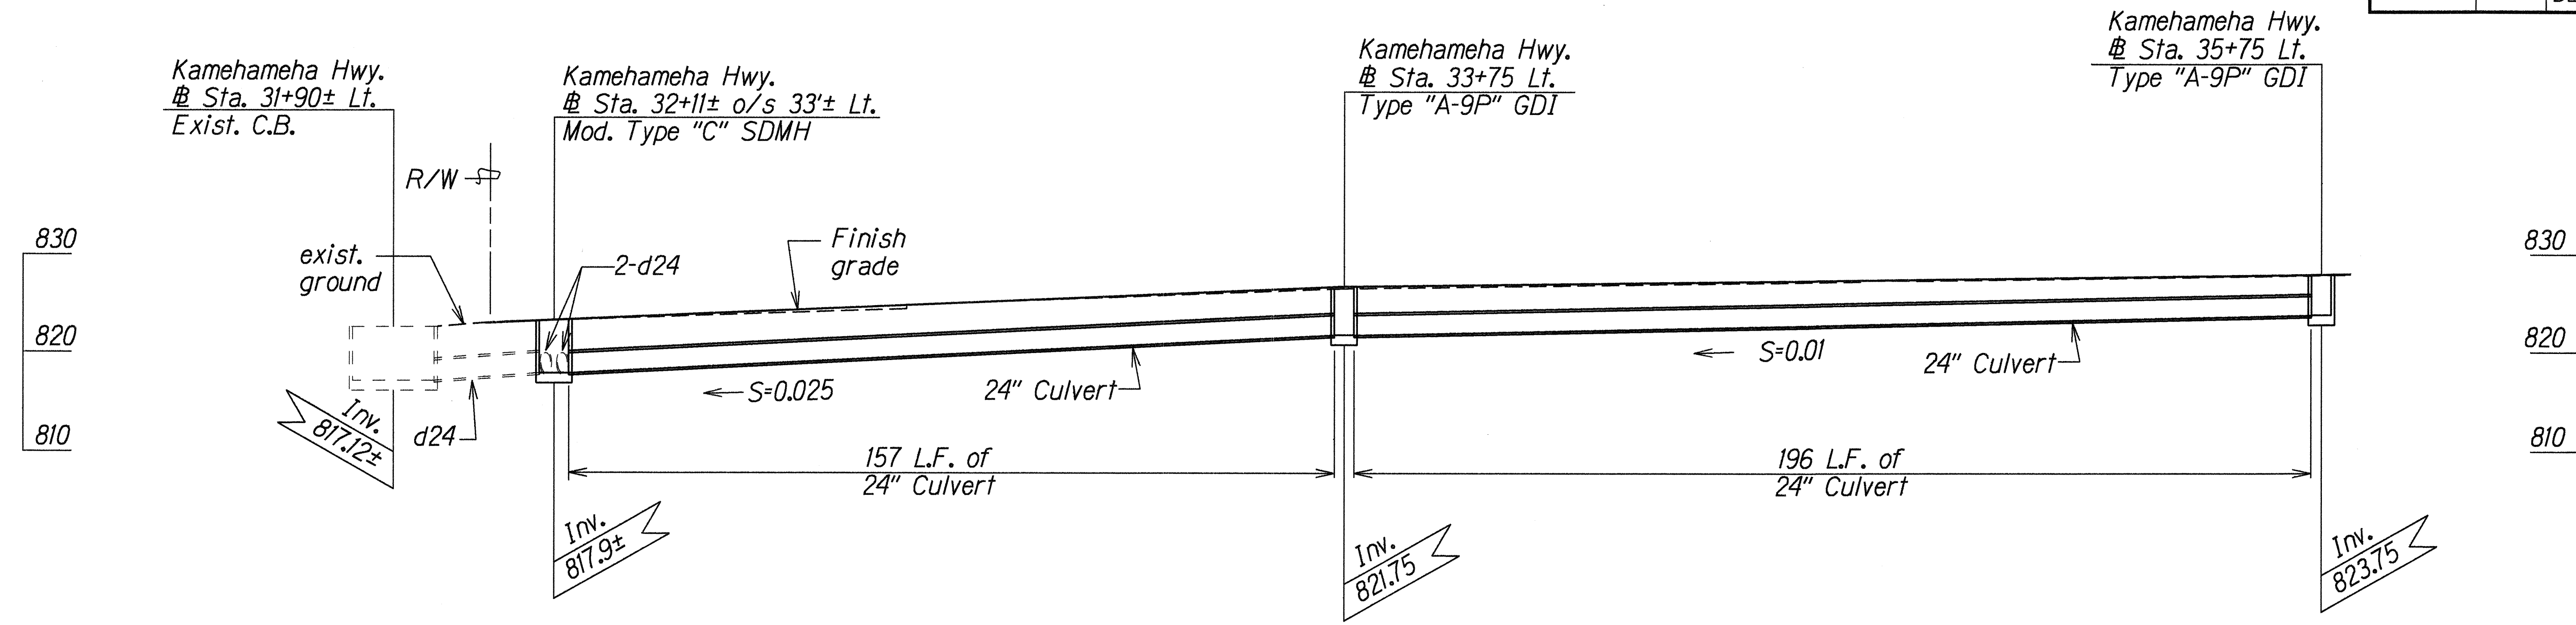

PROFILE - KAMEHAMEHA HWY. # STA. 31+90± LT. TO # STA. 35+75 LT.

Scale: Horiz. 1"=20'
Vert: 1"=10'

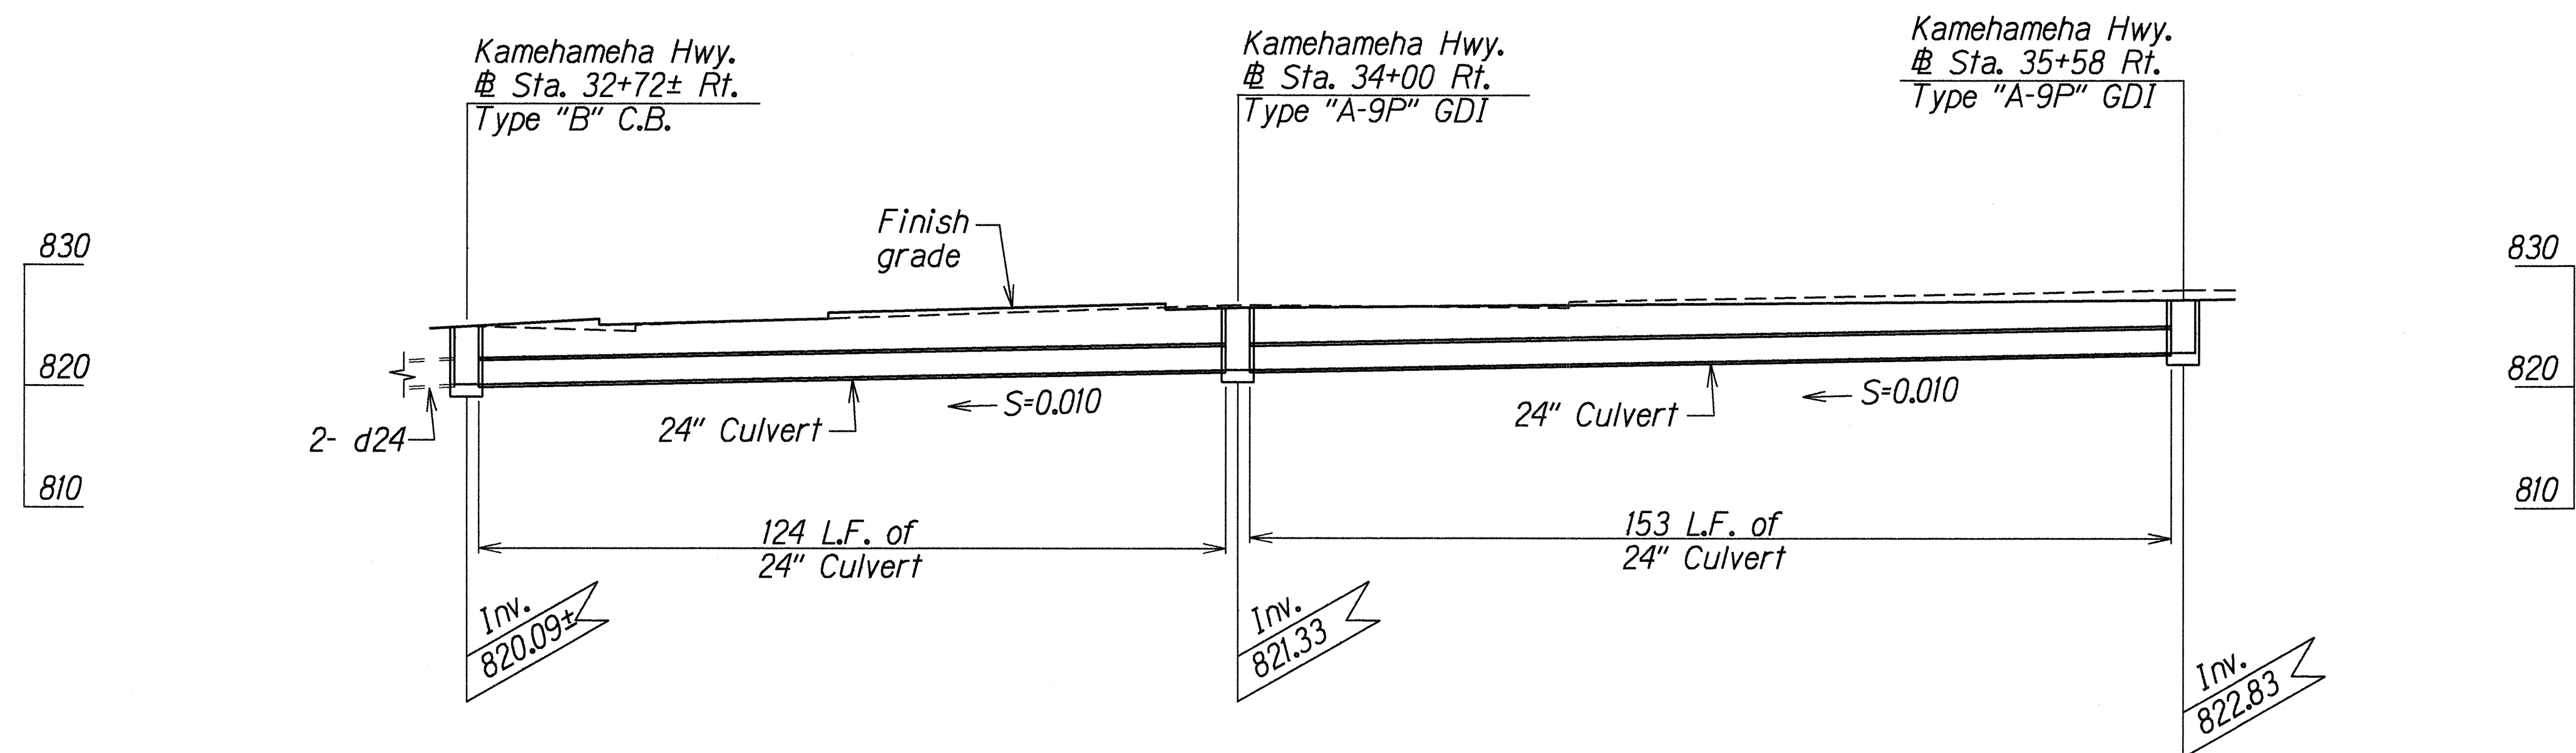

PROFILE - KAMEHAMEHA HWY. # STA. 32+72± RT. TO # STA. 35+58 RT.

Scale: Horiz. 1"=20'
Vert: 1"=10'

ORIGINAL PLAN	SURVEY PLOTTED BY	DATE
NOTE BOOK	DRAWN BY	4-22-99
QUANTITIES BY	CHECKED BY	

STATE OF HAWAII
DEPARTMENT OF TRANSPORTATION
HIGHWAYS DIVISION


DRAINAGE PROFILE

KAMEHAMEHA HIGHWAY
INTERSECTION IMPROVEMENTS AT
LEILEHUA GOLF COURSE ROAD
Fed. Aid Proj. No. DE-0200(803)

Scale: As shown Date: May, 2000


SHEET No. H3 OF 14 SHEETS

FED. ROAD DIST. NO.	STATE	FED. AID PROJ. NO.	FISCAL YEAR	SHEET NO.	TOTAL SHEETS
HAWAII	HAW.	DE-0200(803)	2000	15	79

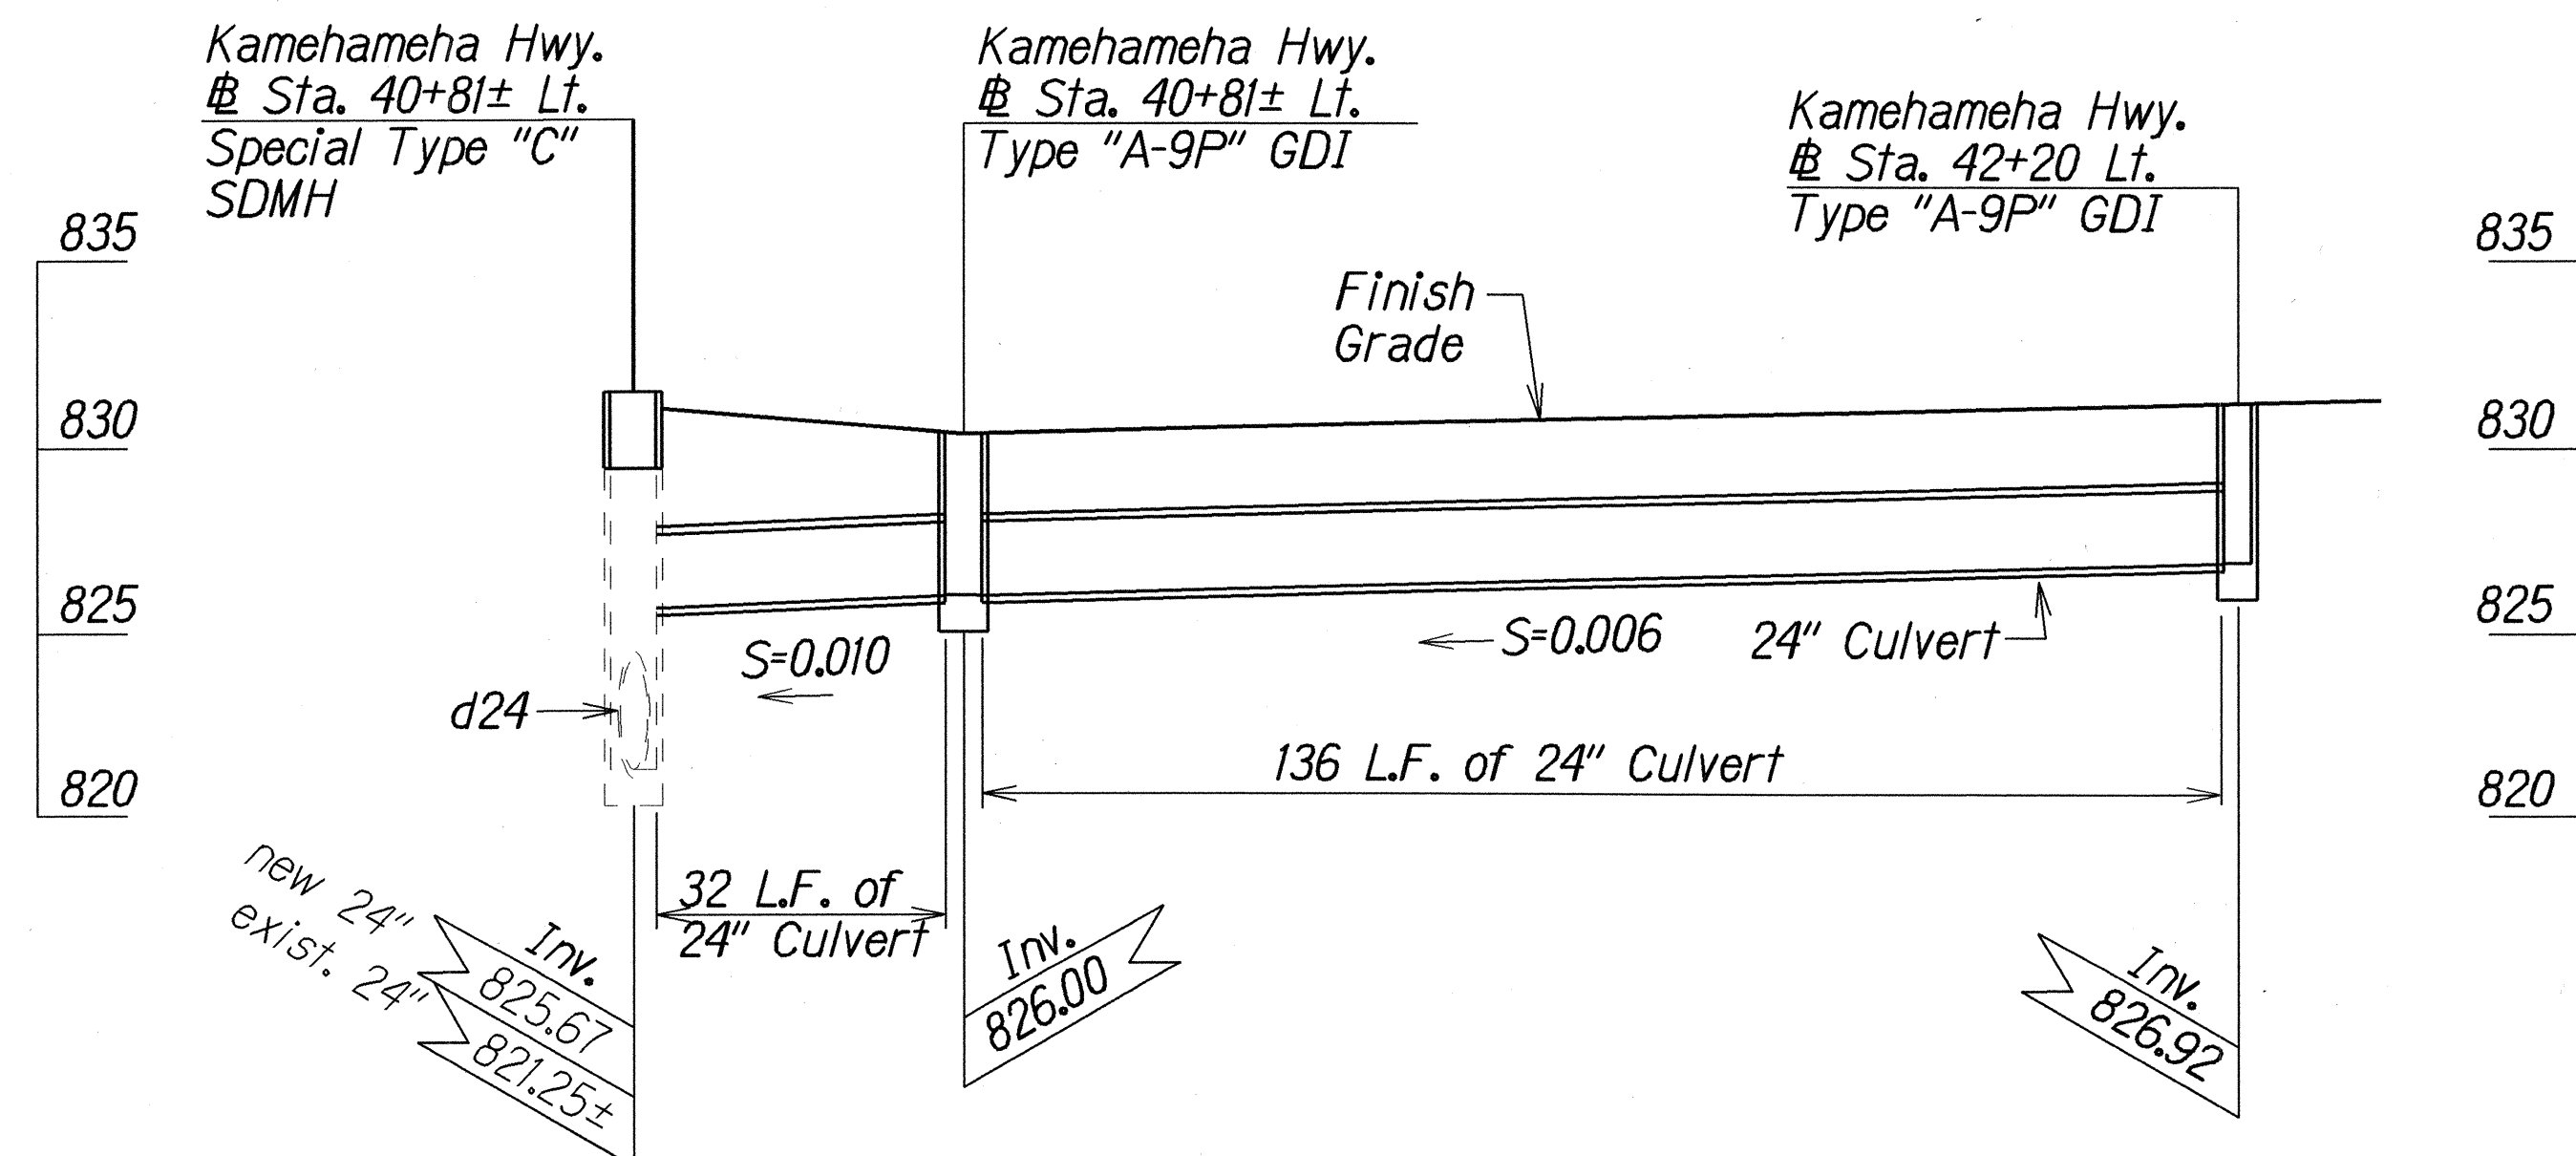


PROFILE - KAMEHAMEHA HIGHWAY @ STA. 40+81± LT. TO @ STA. 42+20 LT.

Scale: Horiz. 1"=20'
Vert: 1"=5'

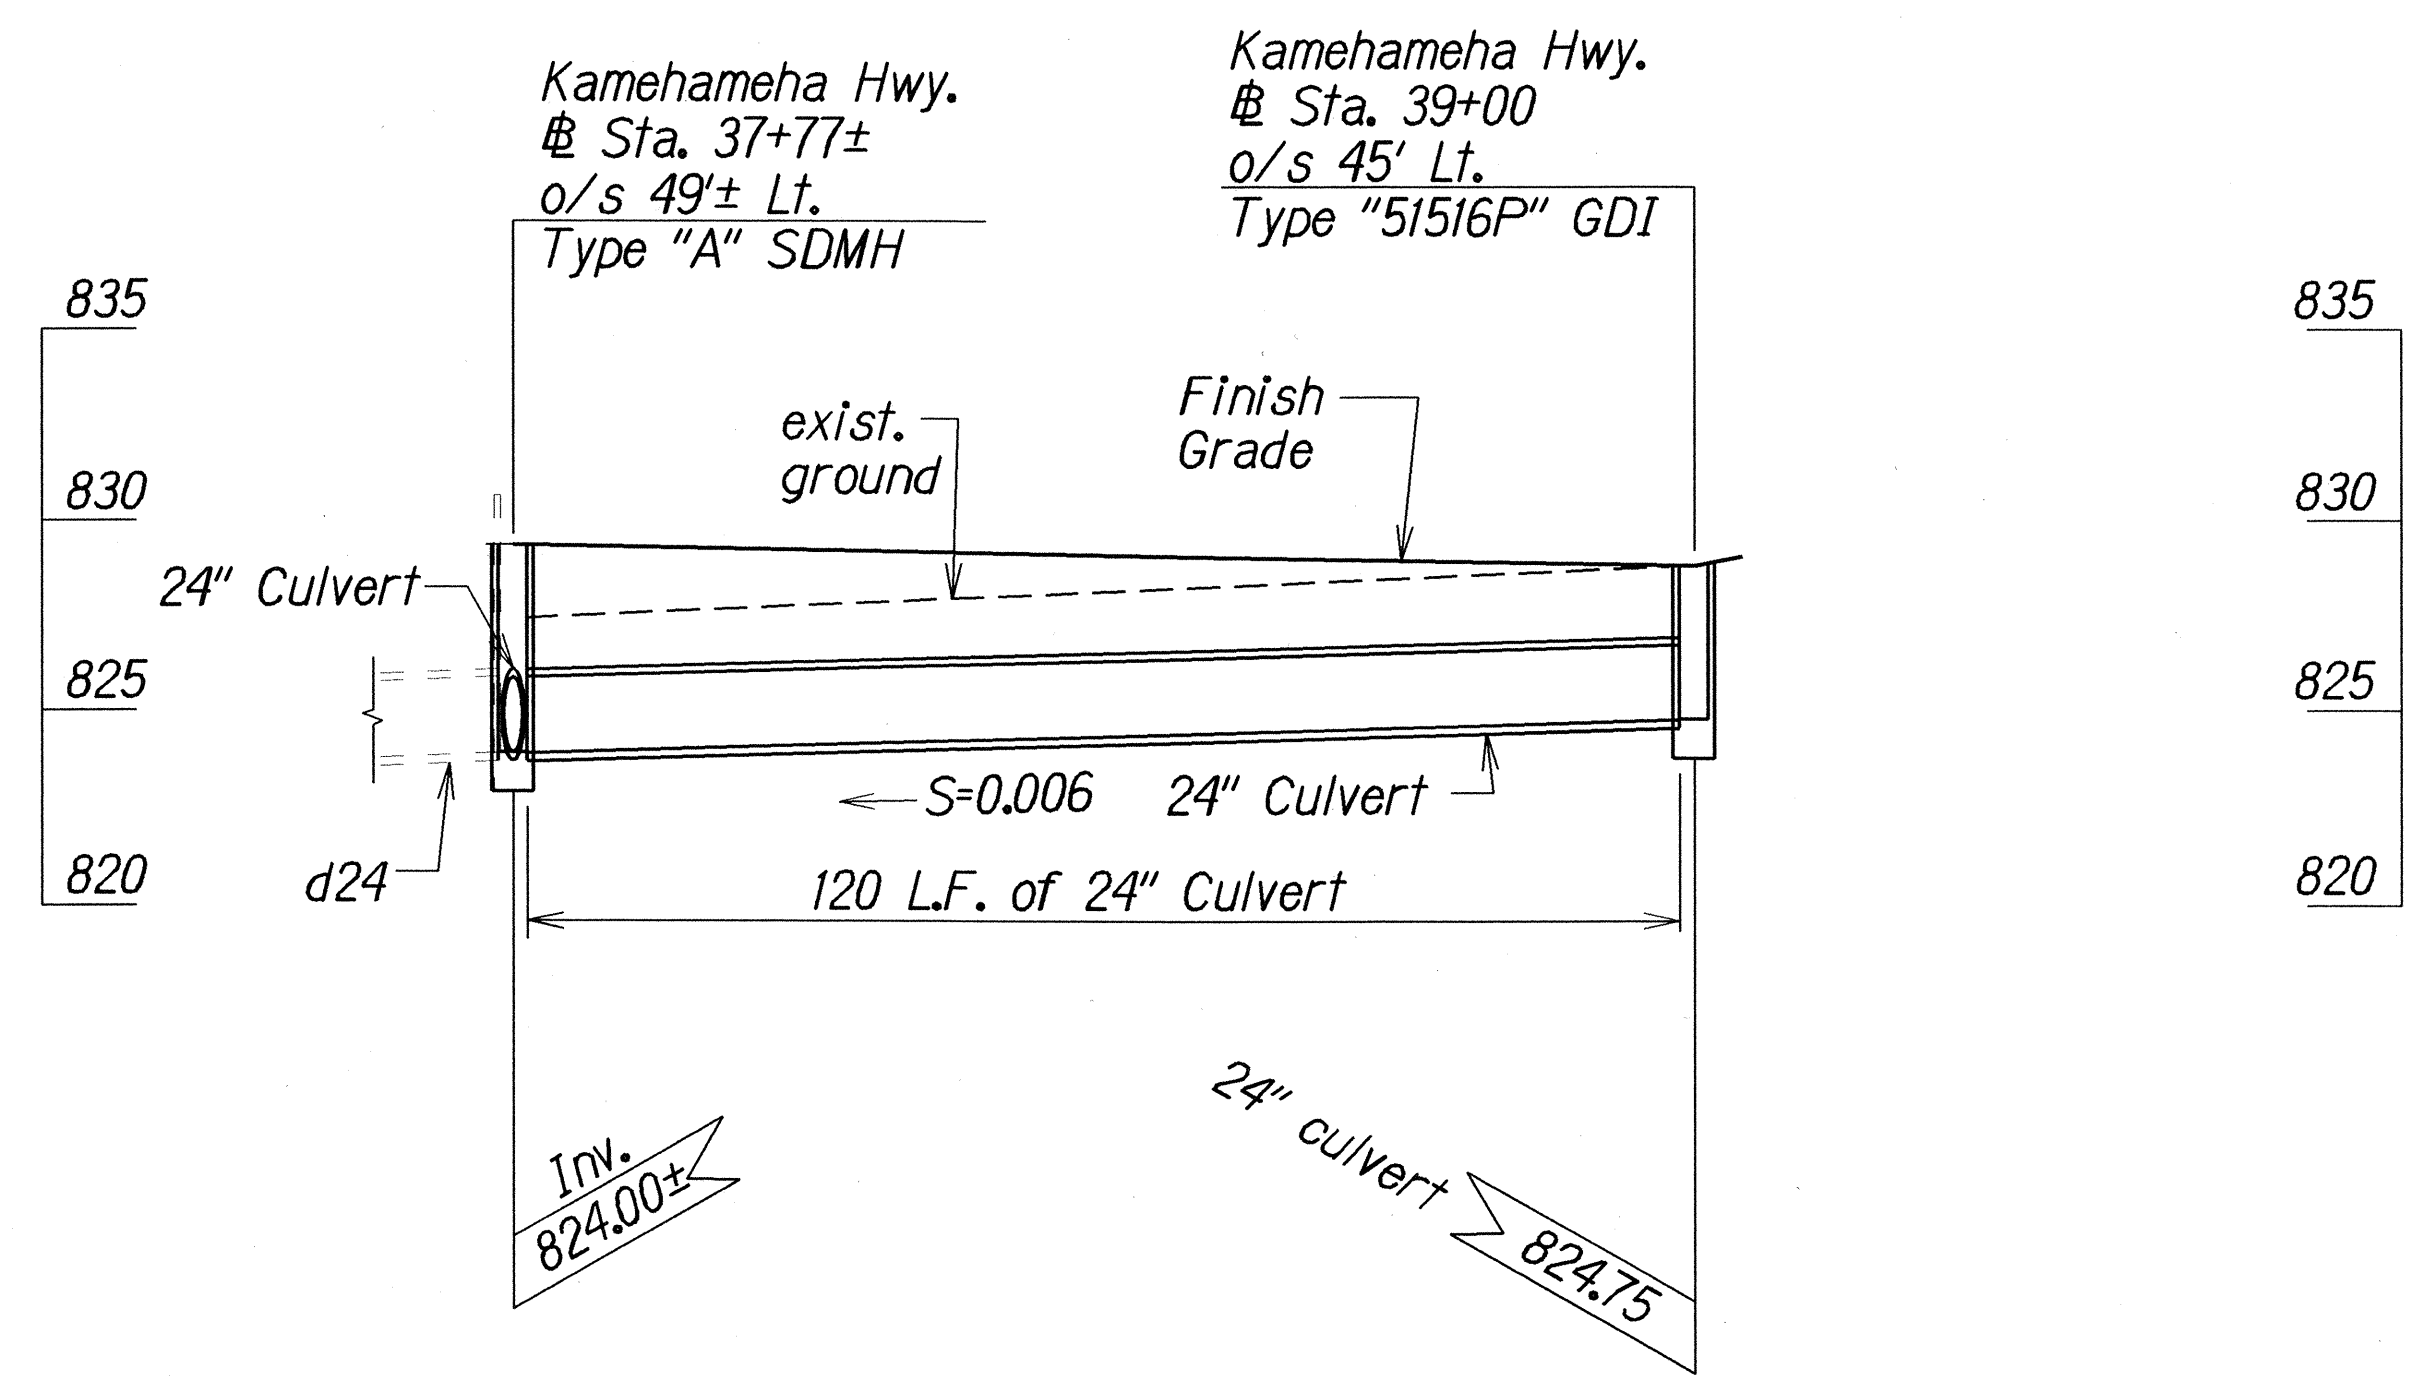

PROFILE - KAMEHAMEHA HIGHWAY @ STA. 37+77± O/S 49± LT. TO @ STA. 39+00 LT.

Scale: Horiz. 1"=20'
Vert: 1"=5'

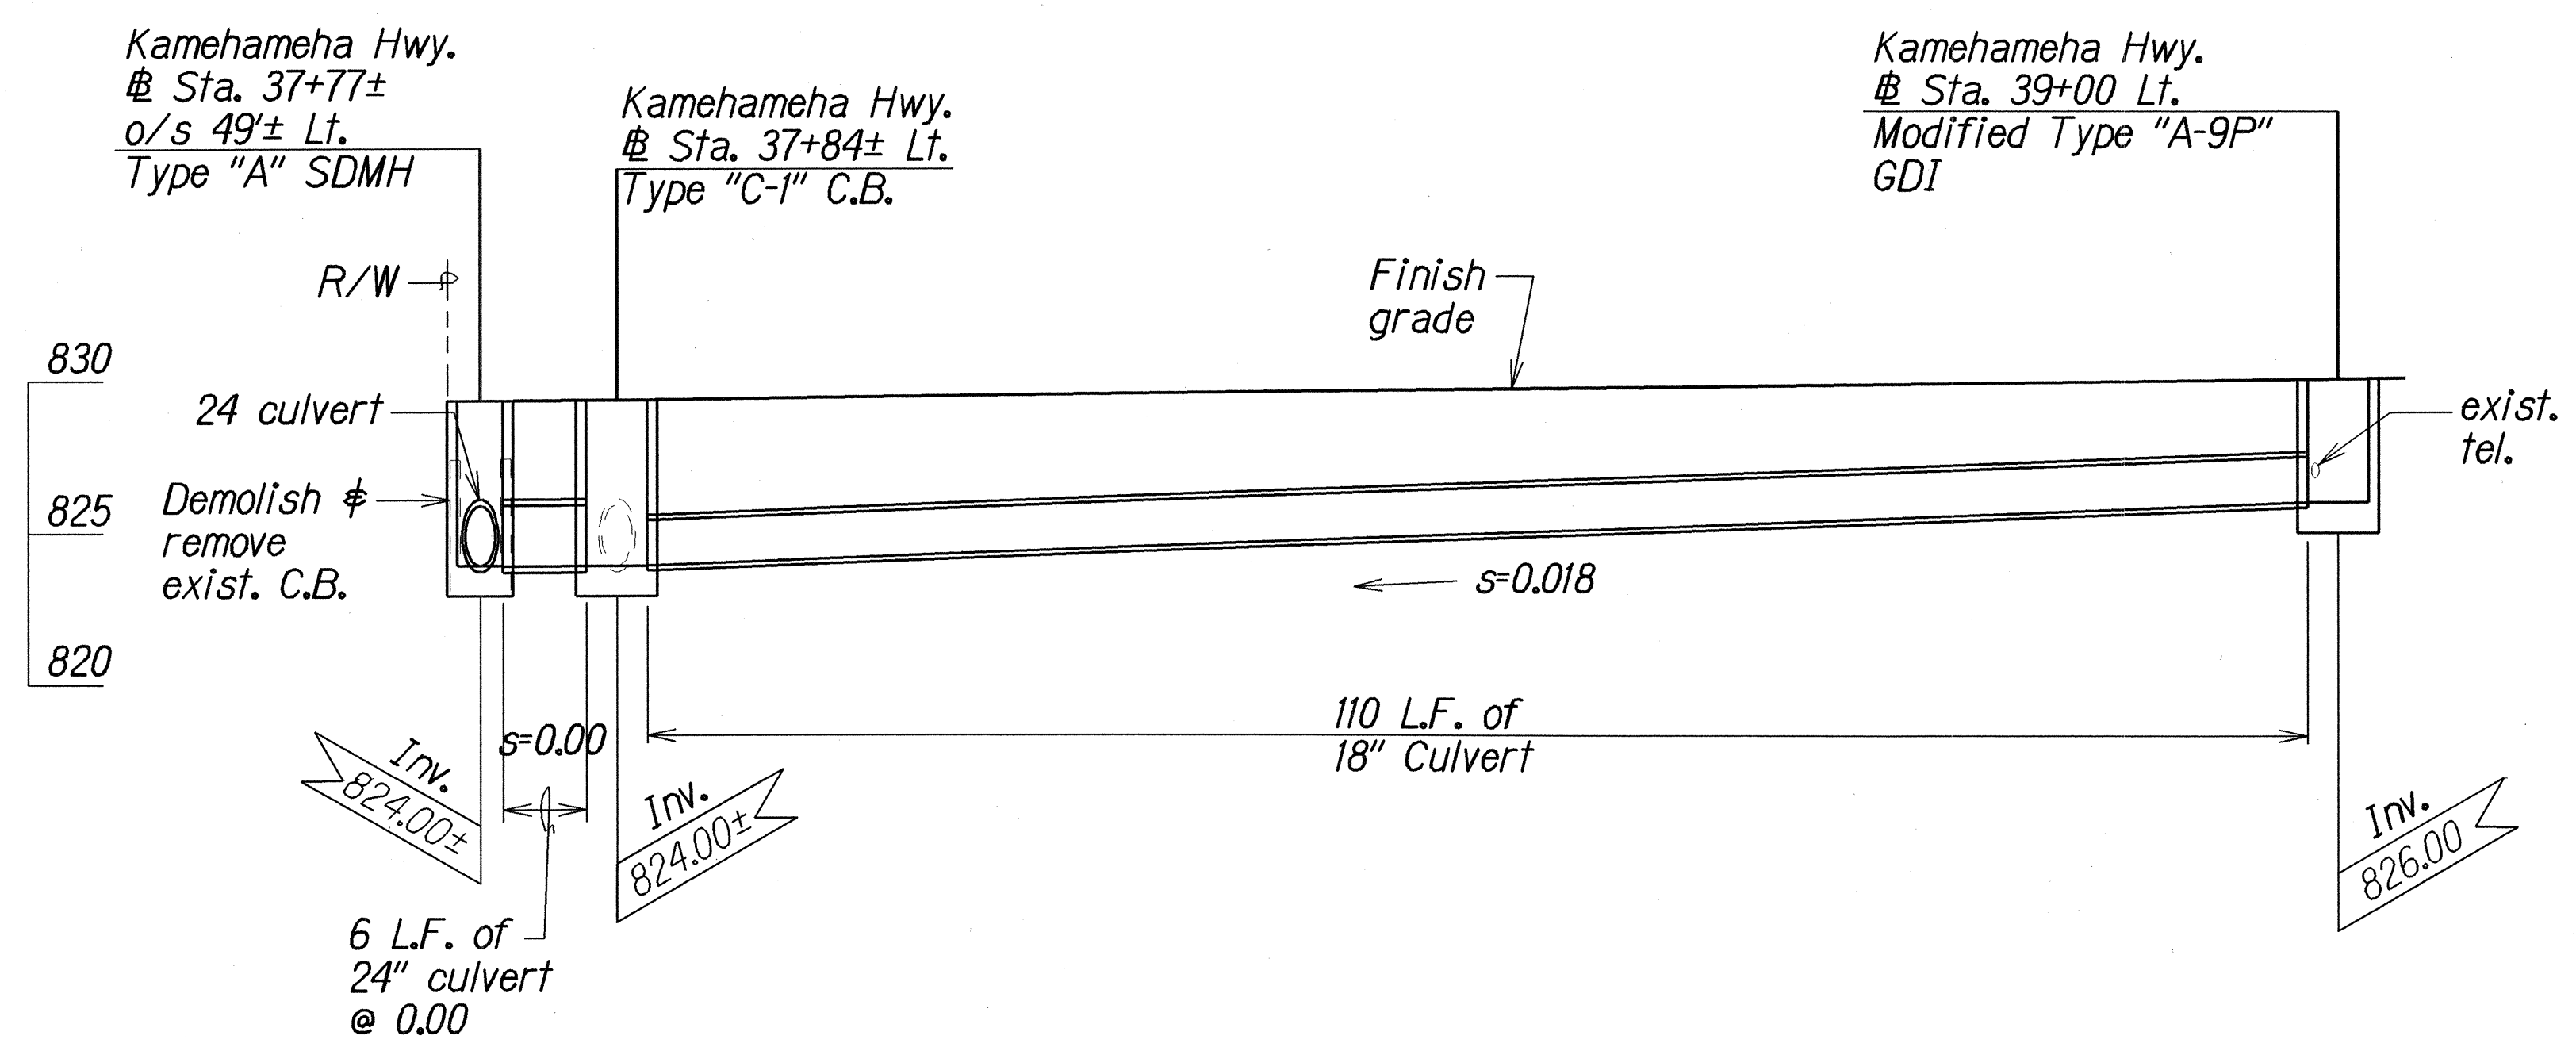

PROFILE - KAMEHAMEHA HIGHWAY @ STA. 39+00 LT. TO @ STA. 37+77± O/S 49± LT.

Scale: Horiz. 1"=10'
Vert: 1"=5'

ORIGINAL PLAN	DATE
SURVEY PLOTTED BY	4-23-00
DRAWN BY	
DESIGNED BY	
CHECKED BY	
QUANTITIES BY	
NOTED BY	

4/21/01 Deleted profile at 40+81, revised profile betw. sta 37+77 and 39+00 lt.


DATE REVISION

STATE OF HAWAII
DEPARTMENT OF TRANSPORTATION
HIGHWAYS DIVISION
DRAINAGE PROFILE
KAMEHAMEHA HIGHWAY
INTERSECTION IMPROVEMENTS AT
LEILEHUA GOLF COURSE ROAD
Fed. Aid Proj. No. DE-0200(803)

Scale: As shown Date: May, 2000


SHEET No. H4 OF 14 SHEETS

FED. ROAD DIST. NO.	STATE	FED. AID PROJ. NO.	FISCAL YEAR	SHEET NO.	TOTAL SHEETS
HAWAII	HAW.	DE-0200(803)	2000	16	79

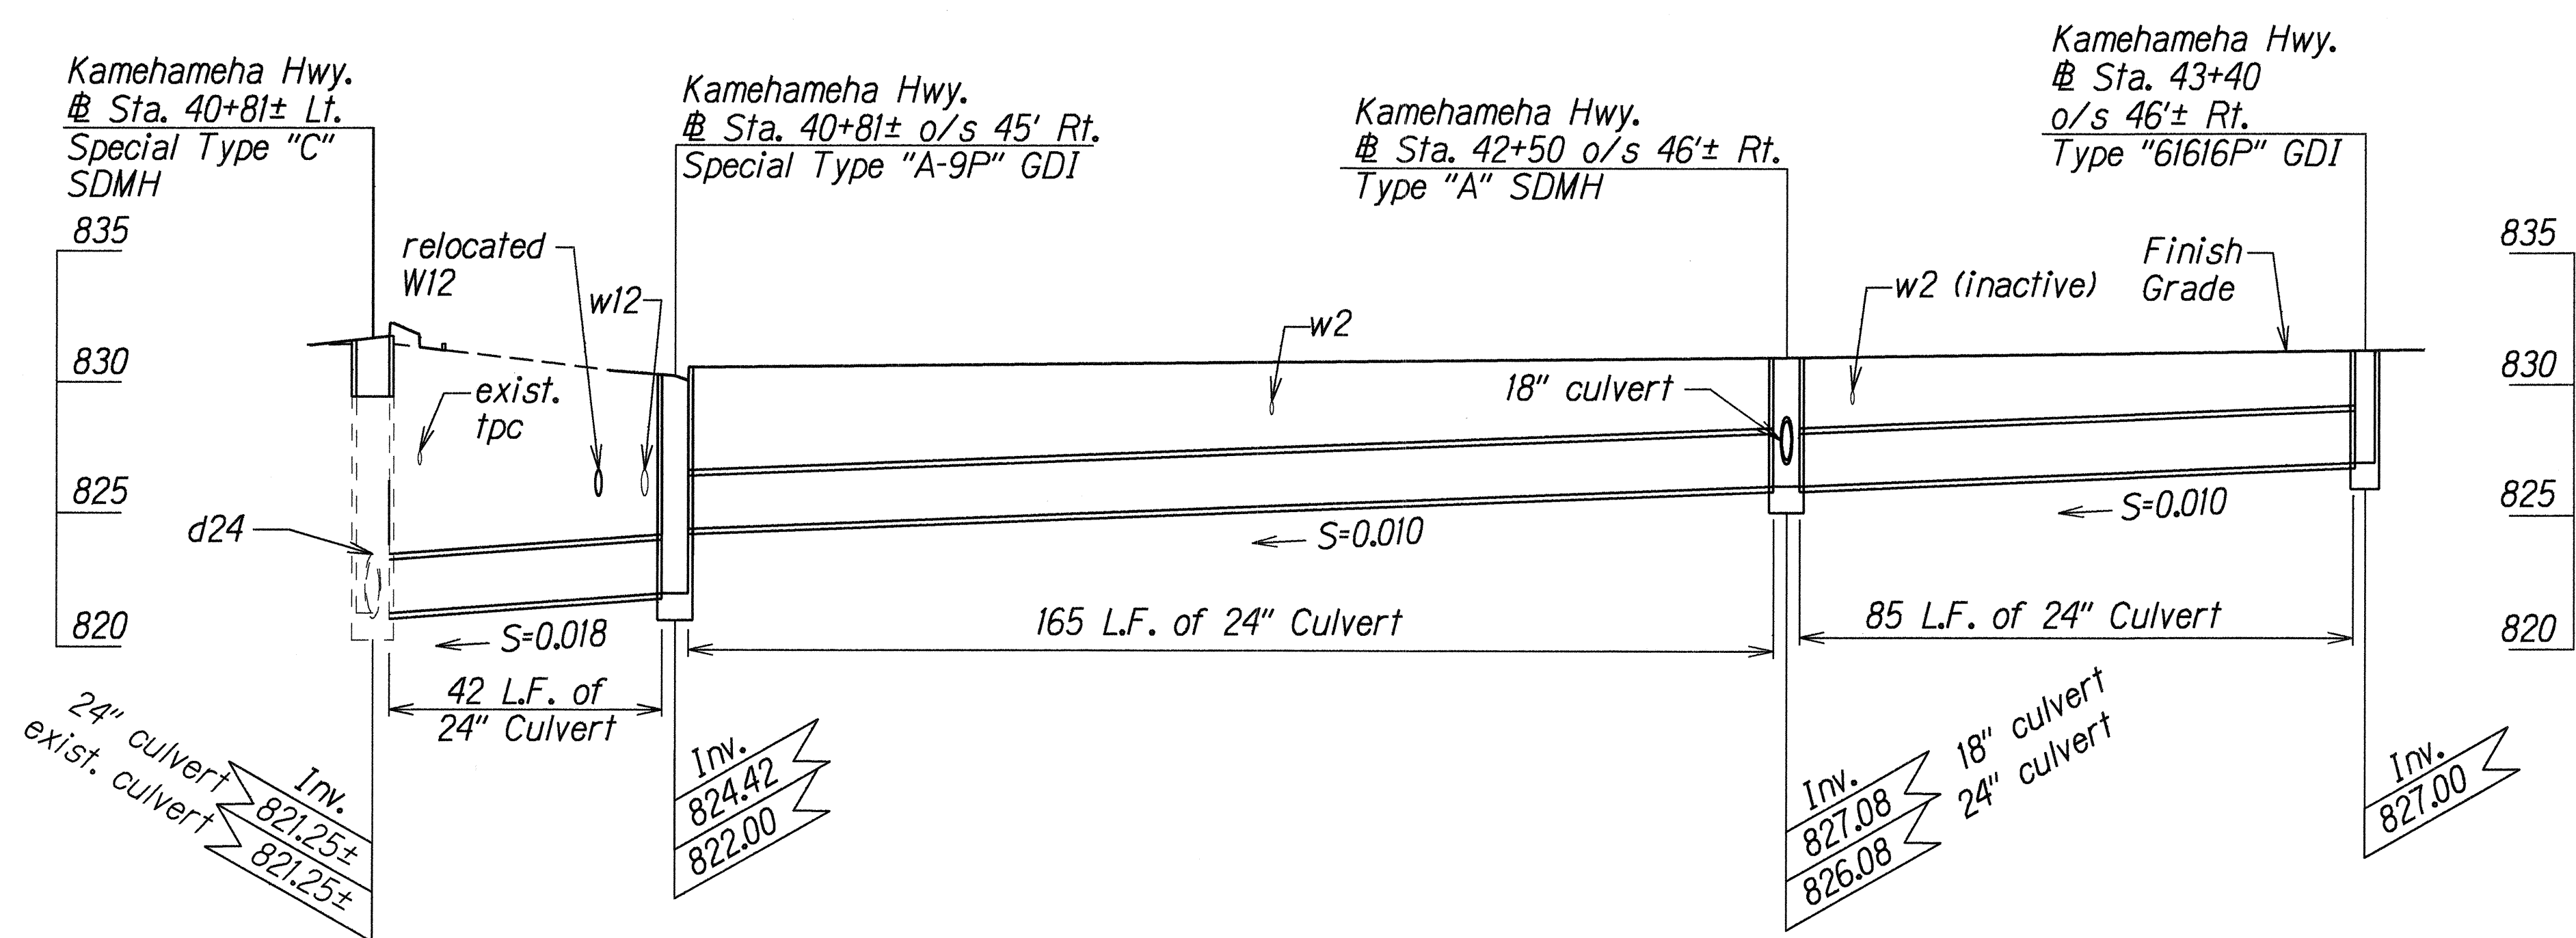


PROFILE - KAMEHAMEHA HIGHWAY STA. 43+40 O/S 46± RT. TO STA. 40+81± LT.

Scale: Horiz. 1"=20'
Vert: 1"=5'

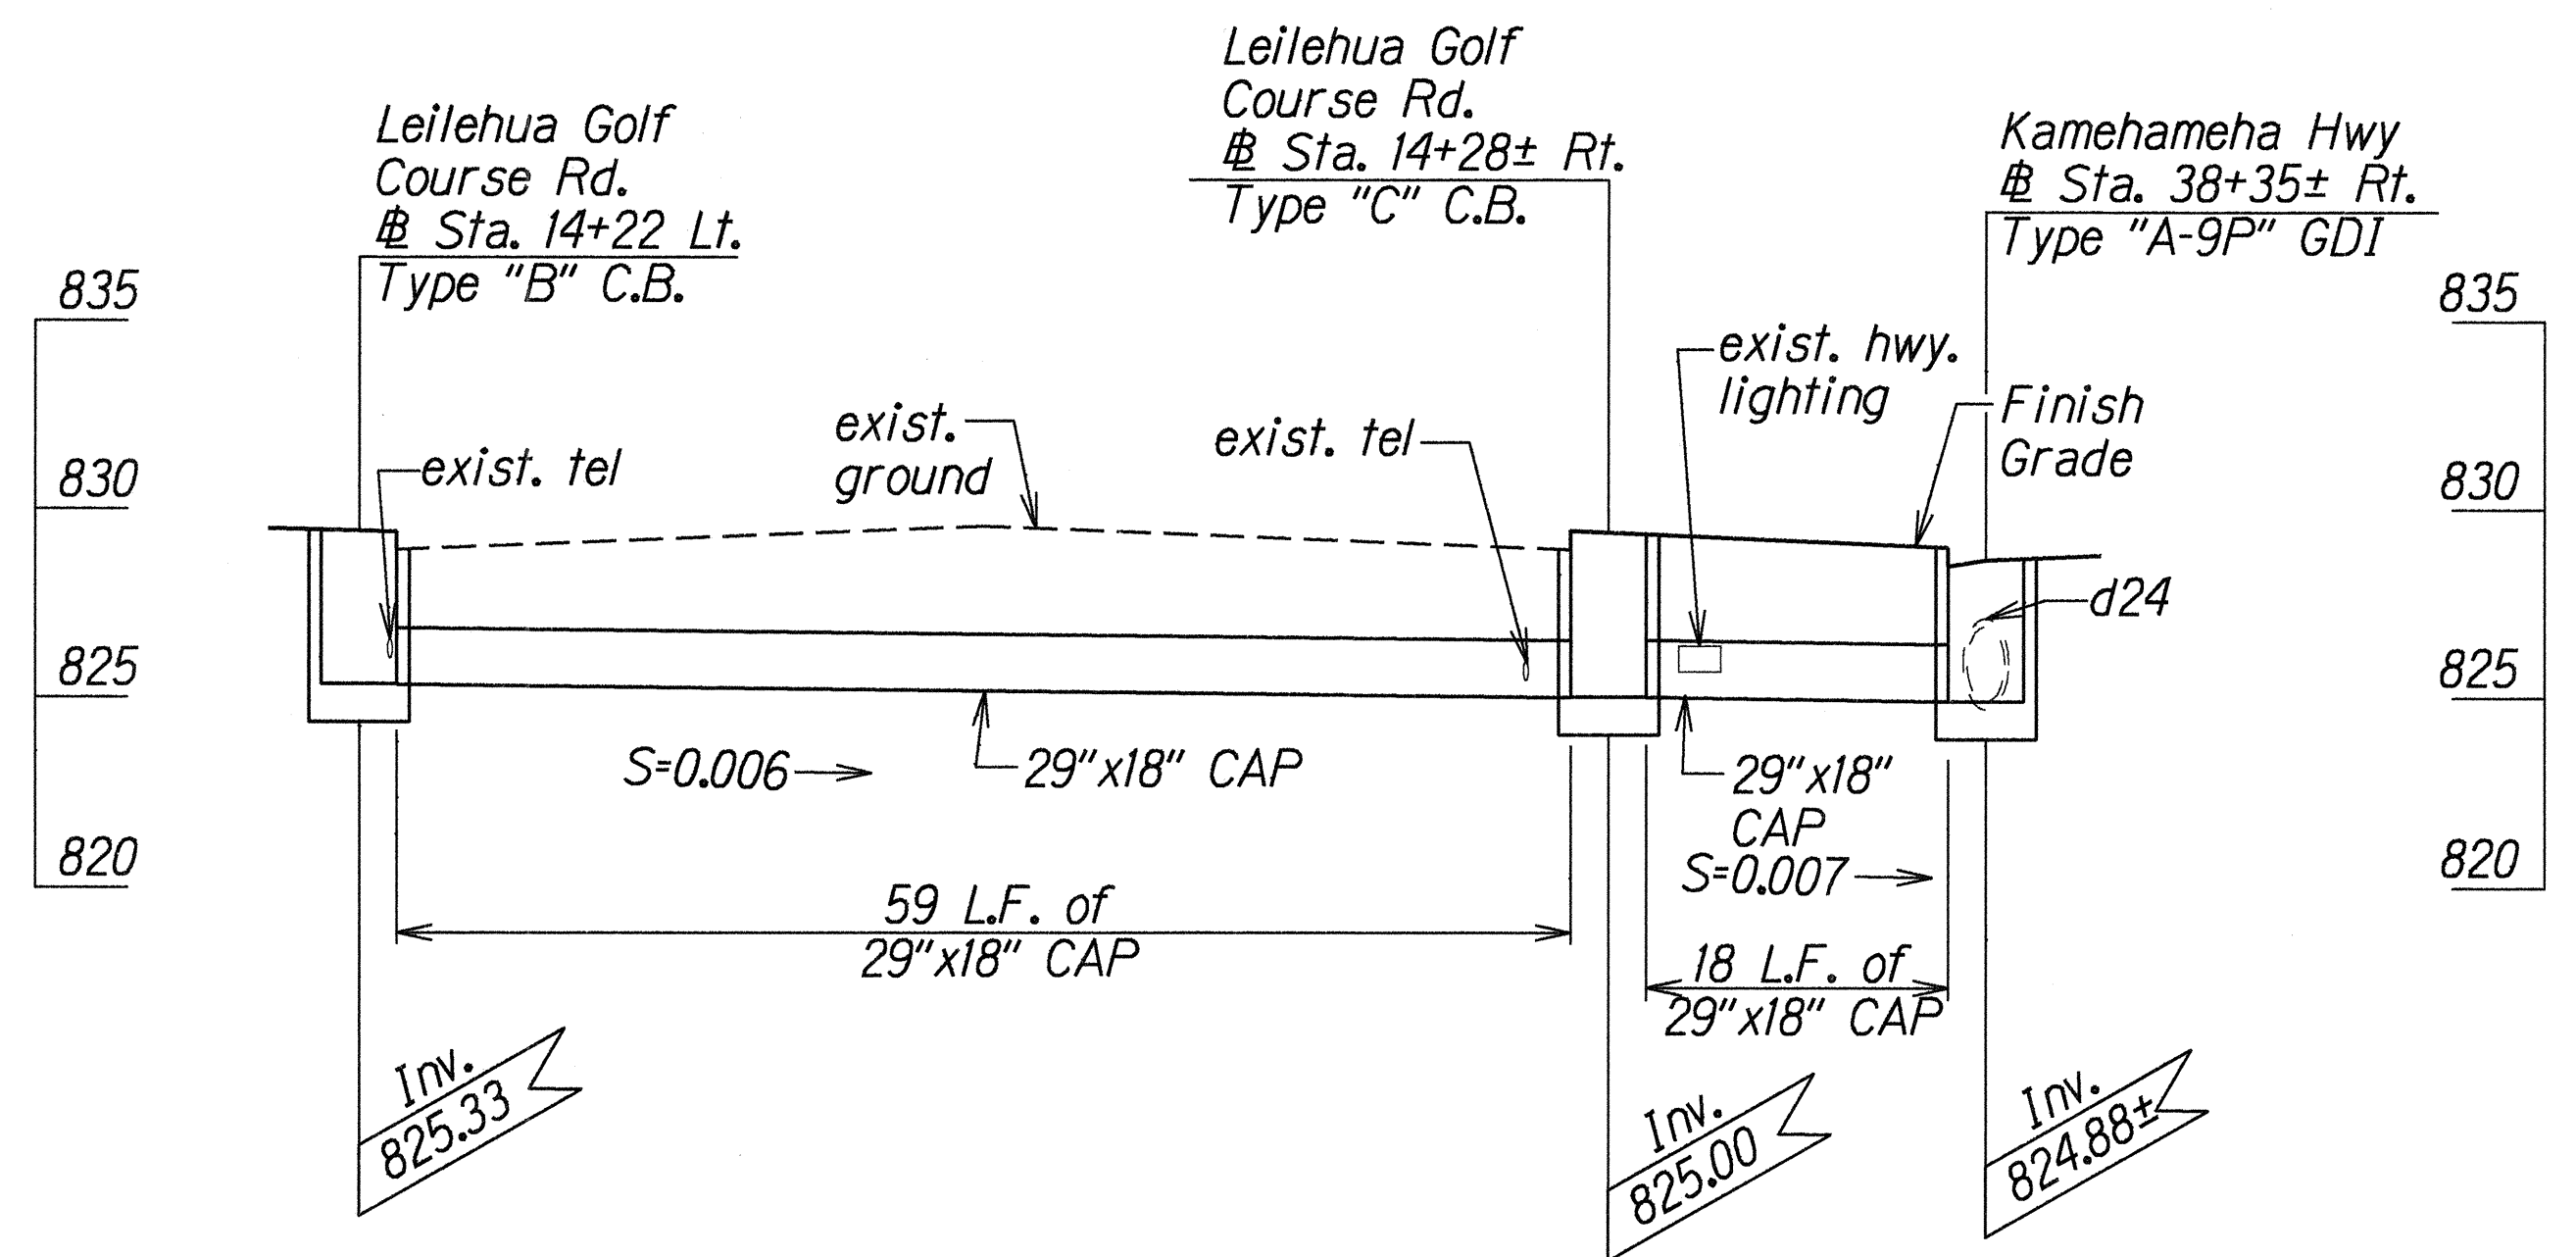

PROFILE - LEILEHUA GOLF COURSE RD. STA. 14+22 LT. TO KAMEHAMEHA HWY. STA. 38+35± RT.

Scale: Horiz. 1"=10'
Vert: 1"=5'

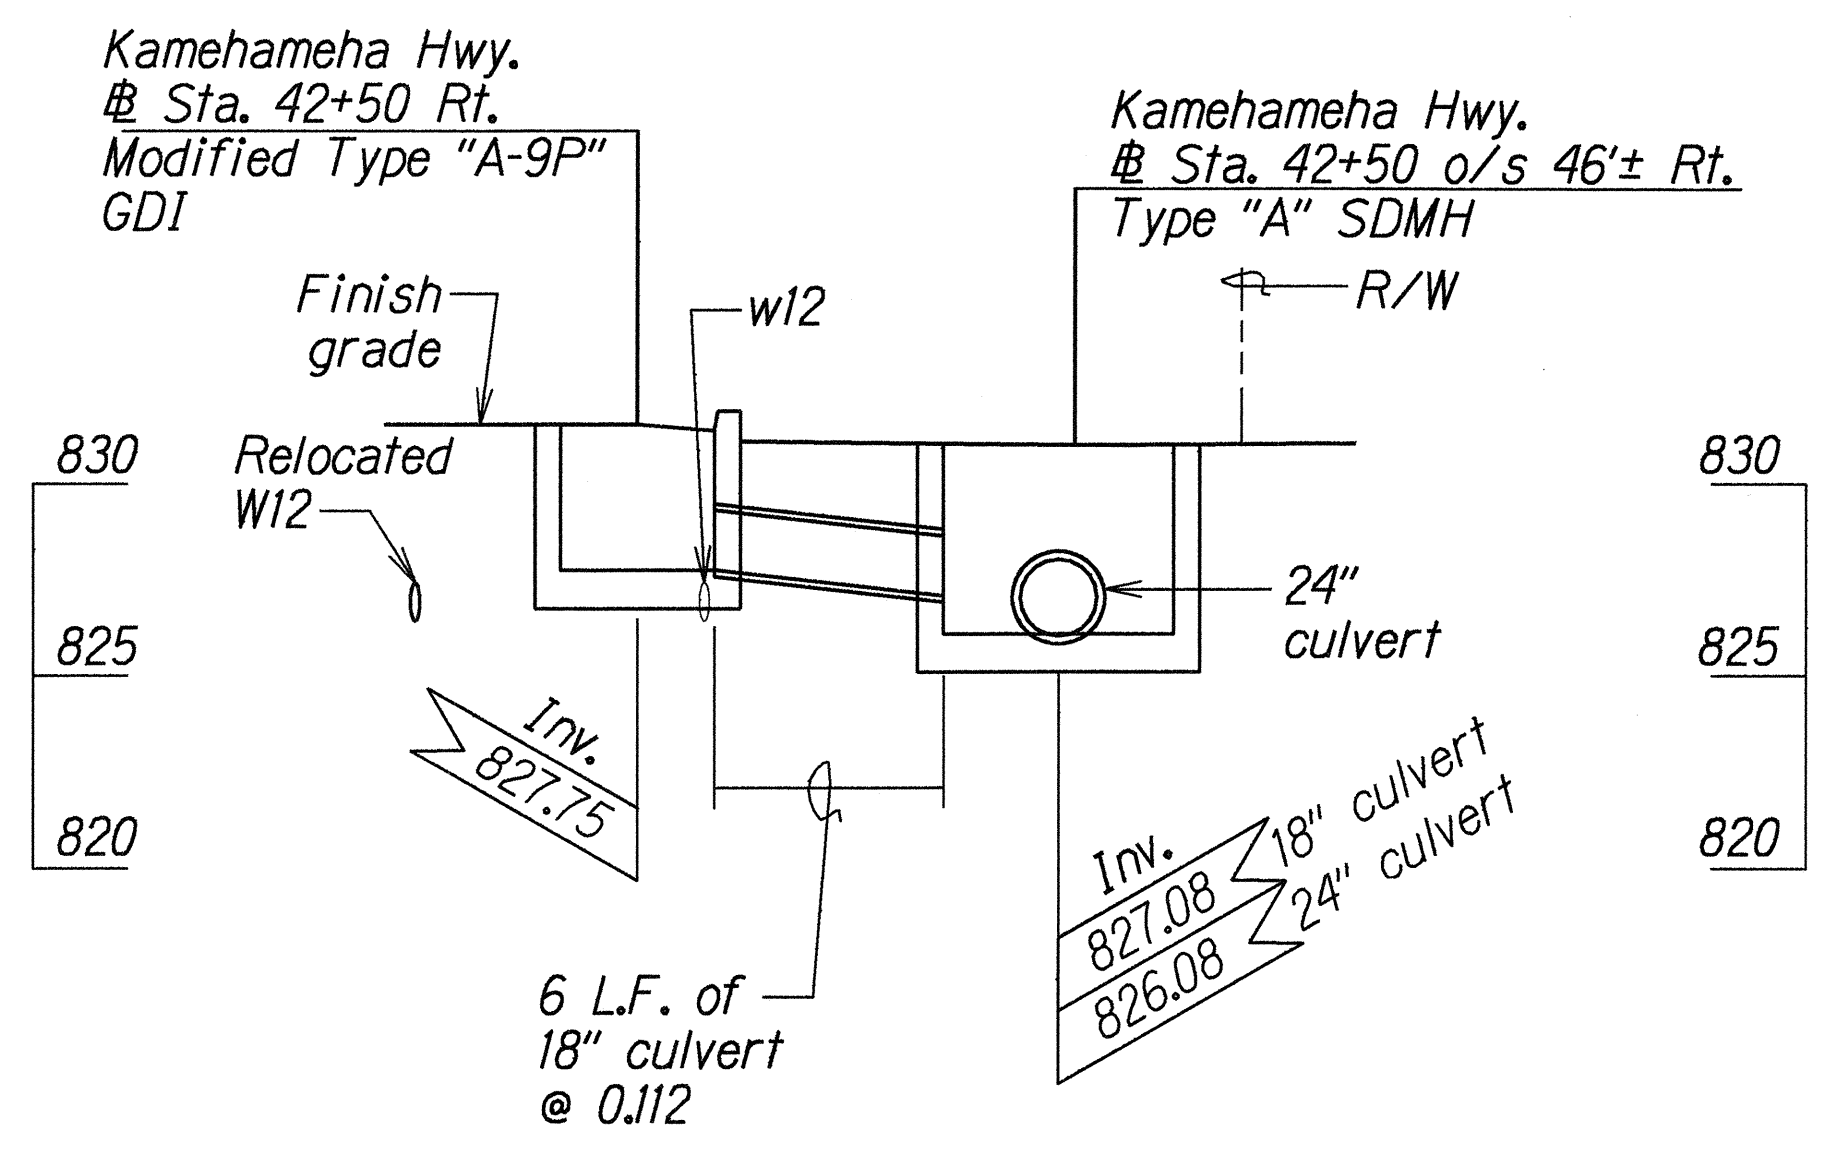

PROFILE - KAMEHAMEHA HIGHWAY AT STA. 42+50 RT.

Scale: Horiz. 1"=5'
Vert: 1"=5'

ORIGINAL PLAN	SURVEY PLOTTED BY	DATE
NOTE BOOK	DRAWN BY	4-22-99
3/23/2000	CHECKED BY	
	DESIGNED BY	
	NOTED BY	

STATE OF HAWAII
DEPARTMENT OF TRANSPORTATION
HIGHWAYS DIVISION

DRAINAGE PROFILE
KAMEHAMEHA HIGHWAY
INTERSECTION IMPROVEMENTS AT
LEILEHUA GOLF COURSE ROAD
Fed. Aid Proj. No. DE-0200(803)

Scale: As shown Date: May, 2000

SHEET No. H5 OF 14 SHEETS