


FED. ROAD DIST. NO.	STATE	PROJ. NO.	FISCAL YEAR	SHEET NO.	TOTAL SHEETS
HAWAII	HAW.	99D-01-97M	2001	5	9

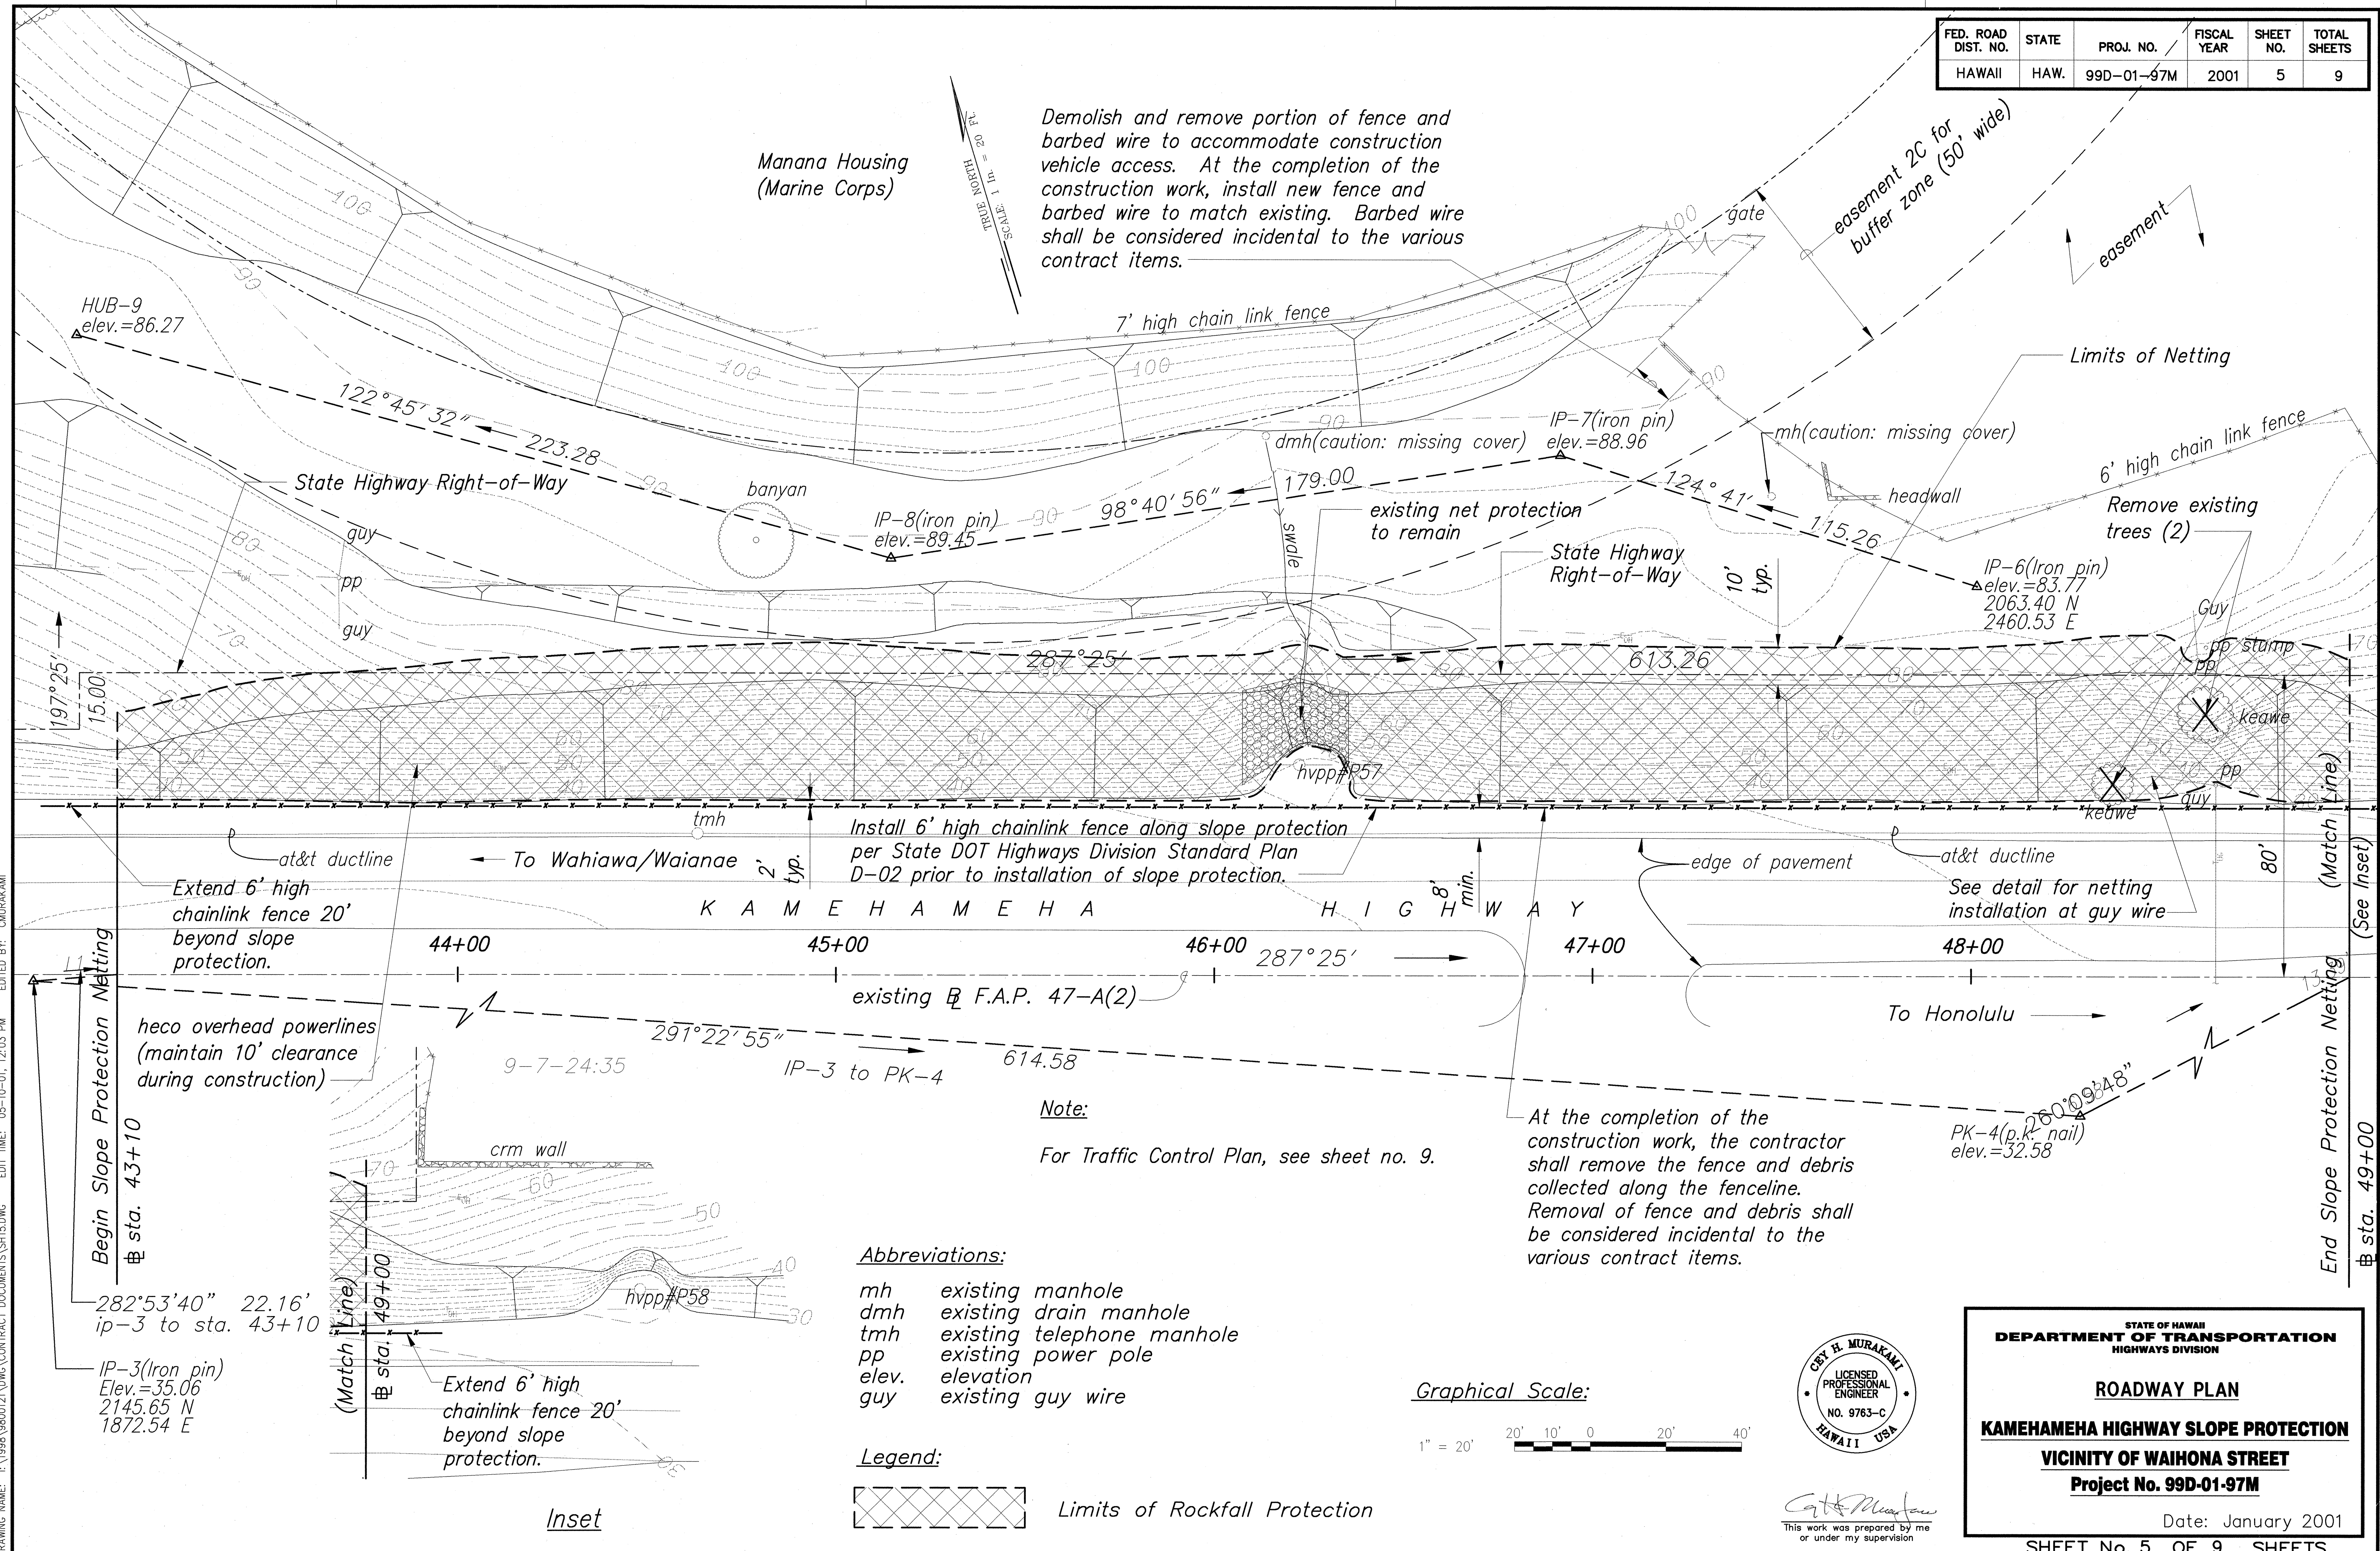

Demolish and remove portion of fence and barbed wire to accommodate construction vehicle access. At the completion of the construction work, install new fence and barbed wire to match existing. Barbed wire shall be considered incidental to the various contract items.



Install 6' high chainlink fence along slope protection per State DOT Highways Division Standard Plan D-02 prior to installation of slope protection.

At the completion of the construction work, the contractor shall remove the fence and debris collected along the fenceline. Removal of fence and debris shall be considered incidental to the various contract items.

Note:
For Traffic Control Plan, see sheet no. 9.

- Abbreviations:**
- mh existing manhole
 - dmh existing drain manhole
 - tmh existing telephone manhole
 - pp existing power pole
 - elev. elevation
 - guy existing guy wire

- Legend:**
- Limits of Rockfall Protection

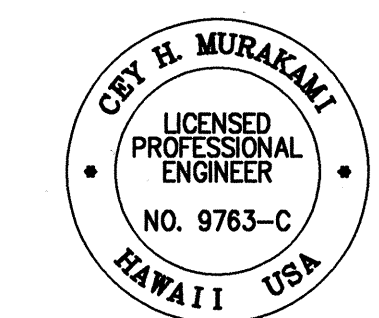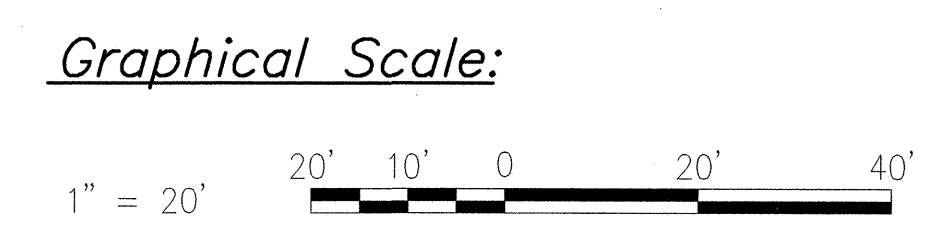

STATE OF HAWAII
DEPARTMENT OF TRANSPORTATION
HIGHWAYS DIVISION

ROADWAY PLAN

KAMEHAMEHA HIGHWAY SLOPE PROTECTION

VICINITY OF WAIHONA STREET

Project No. 99D-01-97M

Date: January 2001

SHEET No. 5 OF 9 SHEETS

SURVEY PLOTTED BY	DATE
DESIGNED BY	" "
NOTED BY	" "
CHECKED BY	" "
ORIGINAL PLAN	" "
NOTE BOOK	" "
QUANTITIES BY	" "
CHECKED BY	" "

DRAWING NAME: 1. 99D-01-97M CONTRACT DOCUMENTS SHEET 5WG EDIT TIME: 05-10-01, 12:03 PM EDIT BY: CAURKAMI

Inset