

INDEX TO DRAWINGS	
SHEET NO.	DESCRIPTION
1	TITLE SHEET
2	STANDARD PLANS SUMMARY
3	GENERAL NOTES AND LEGEND
4 - 5	UTILITY NOTES
6 - 10	TYPICAL SECTION & DETAILS
11 - 14	GUARDRAIL DETAILS & NOTES
15 - 19	CURB RAMP DETAILS
20 - 26	ROADWAY PLANS
27 - 29	DRAINAGE DETAILS
30 - 37	SIDEWALK UPGRADE
38 - 40	TRAFFIC SIGNAL PLAN & MISCELLANEOUS TRAFFIC DETAILS
41 - 44	CROSS SECTIONS


Sheet no. C.O.355-1 is a supplementary sheet to this project. Total sheet count after "As-Built" posting 45 sheets.

STATE OF HAWAII
DEPARTMENT OF TRANSPORTATION
HIGHWAYS DIVISION
HONOLULU, HAWAII
"AS-BUILT"
PLANS FOR
**KAMEHAMEHA HIGHWAY PEDESTRIAN
ACCESSIBLE ROUTE IMPROVEMENTS**
ACACIA ROAD TO HONOMANU STREET
FEDERAL AID PROJECT NO. STP-099-1(20)

DISTRICT OF EWA
ISLAND OF OAHU

PROJECT LIMITS



UNIT "E"
DESIGNED BY
J. FUJIMOTO
P.S. & E.BY
692-7581
PHONE
MAY 1999
DATE

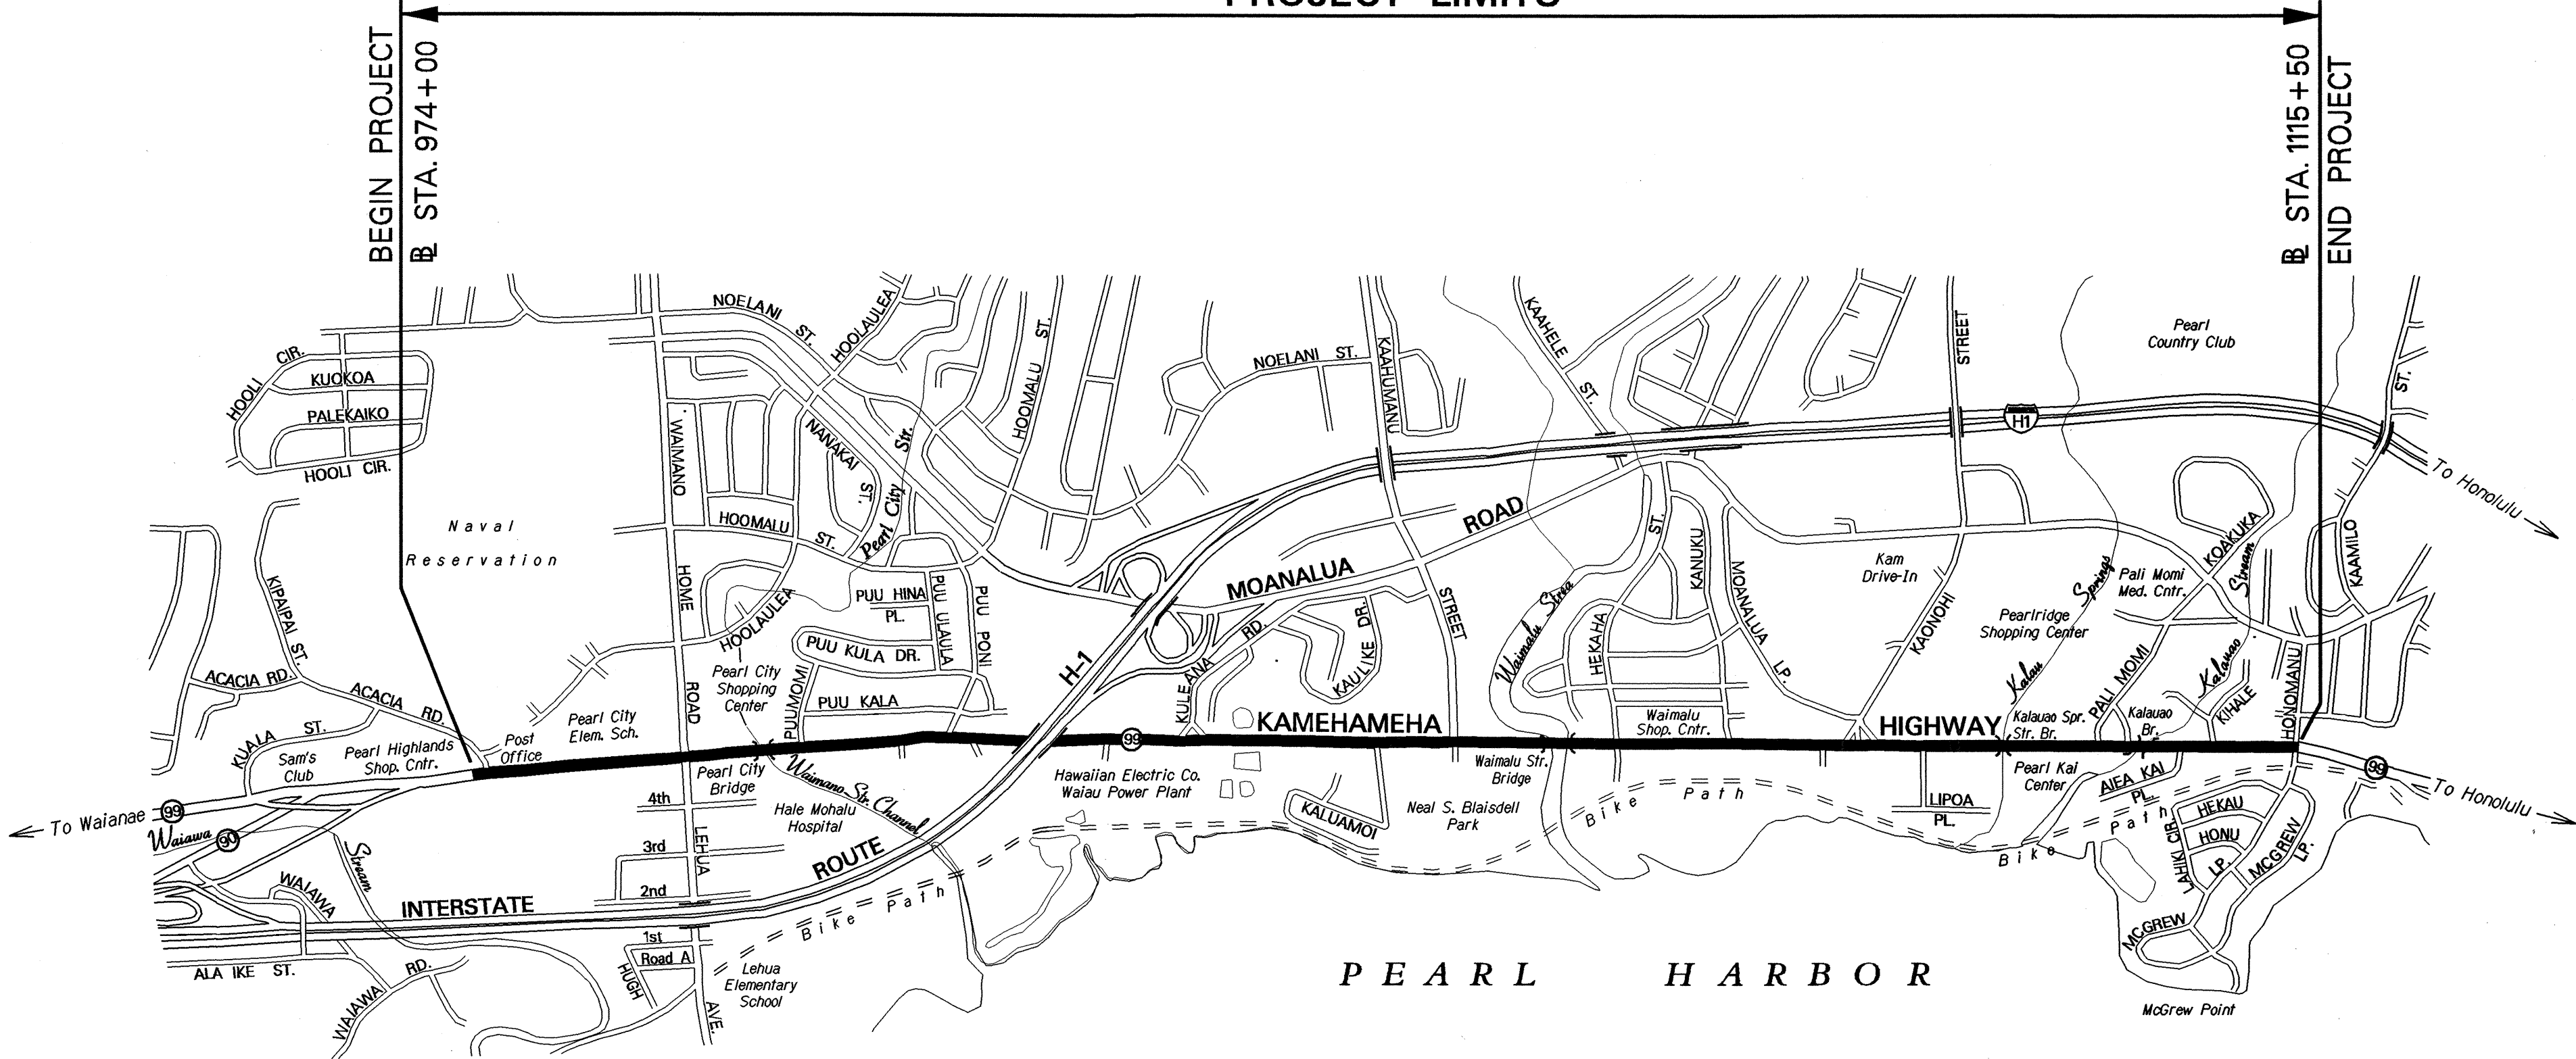


LOCATION PLAN

GROSS LENGTH OF PROJECT.....2.64 MILES
NET LENGTH OF PROJECT.....2.64 MILES

FED. ROAD DIST. NO.	STATE	FED. AID PROJ. NO.	FISCAL YEAR	SHEET NO.	TOTAL SHEETS
HAWAII	HAW.	STP-099-1(20)	1999	1	44

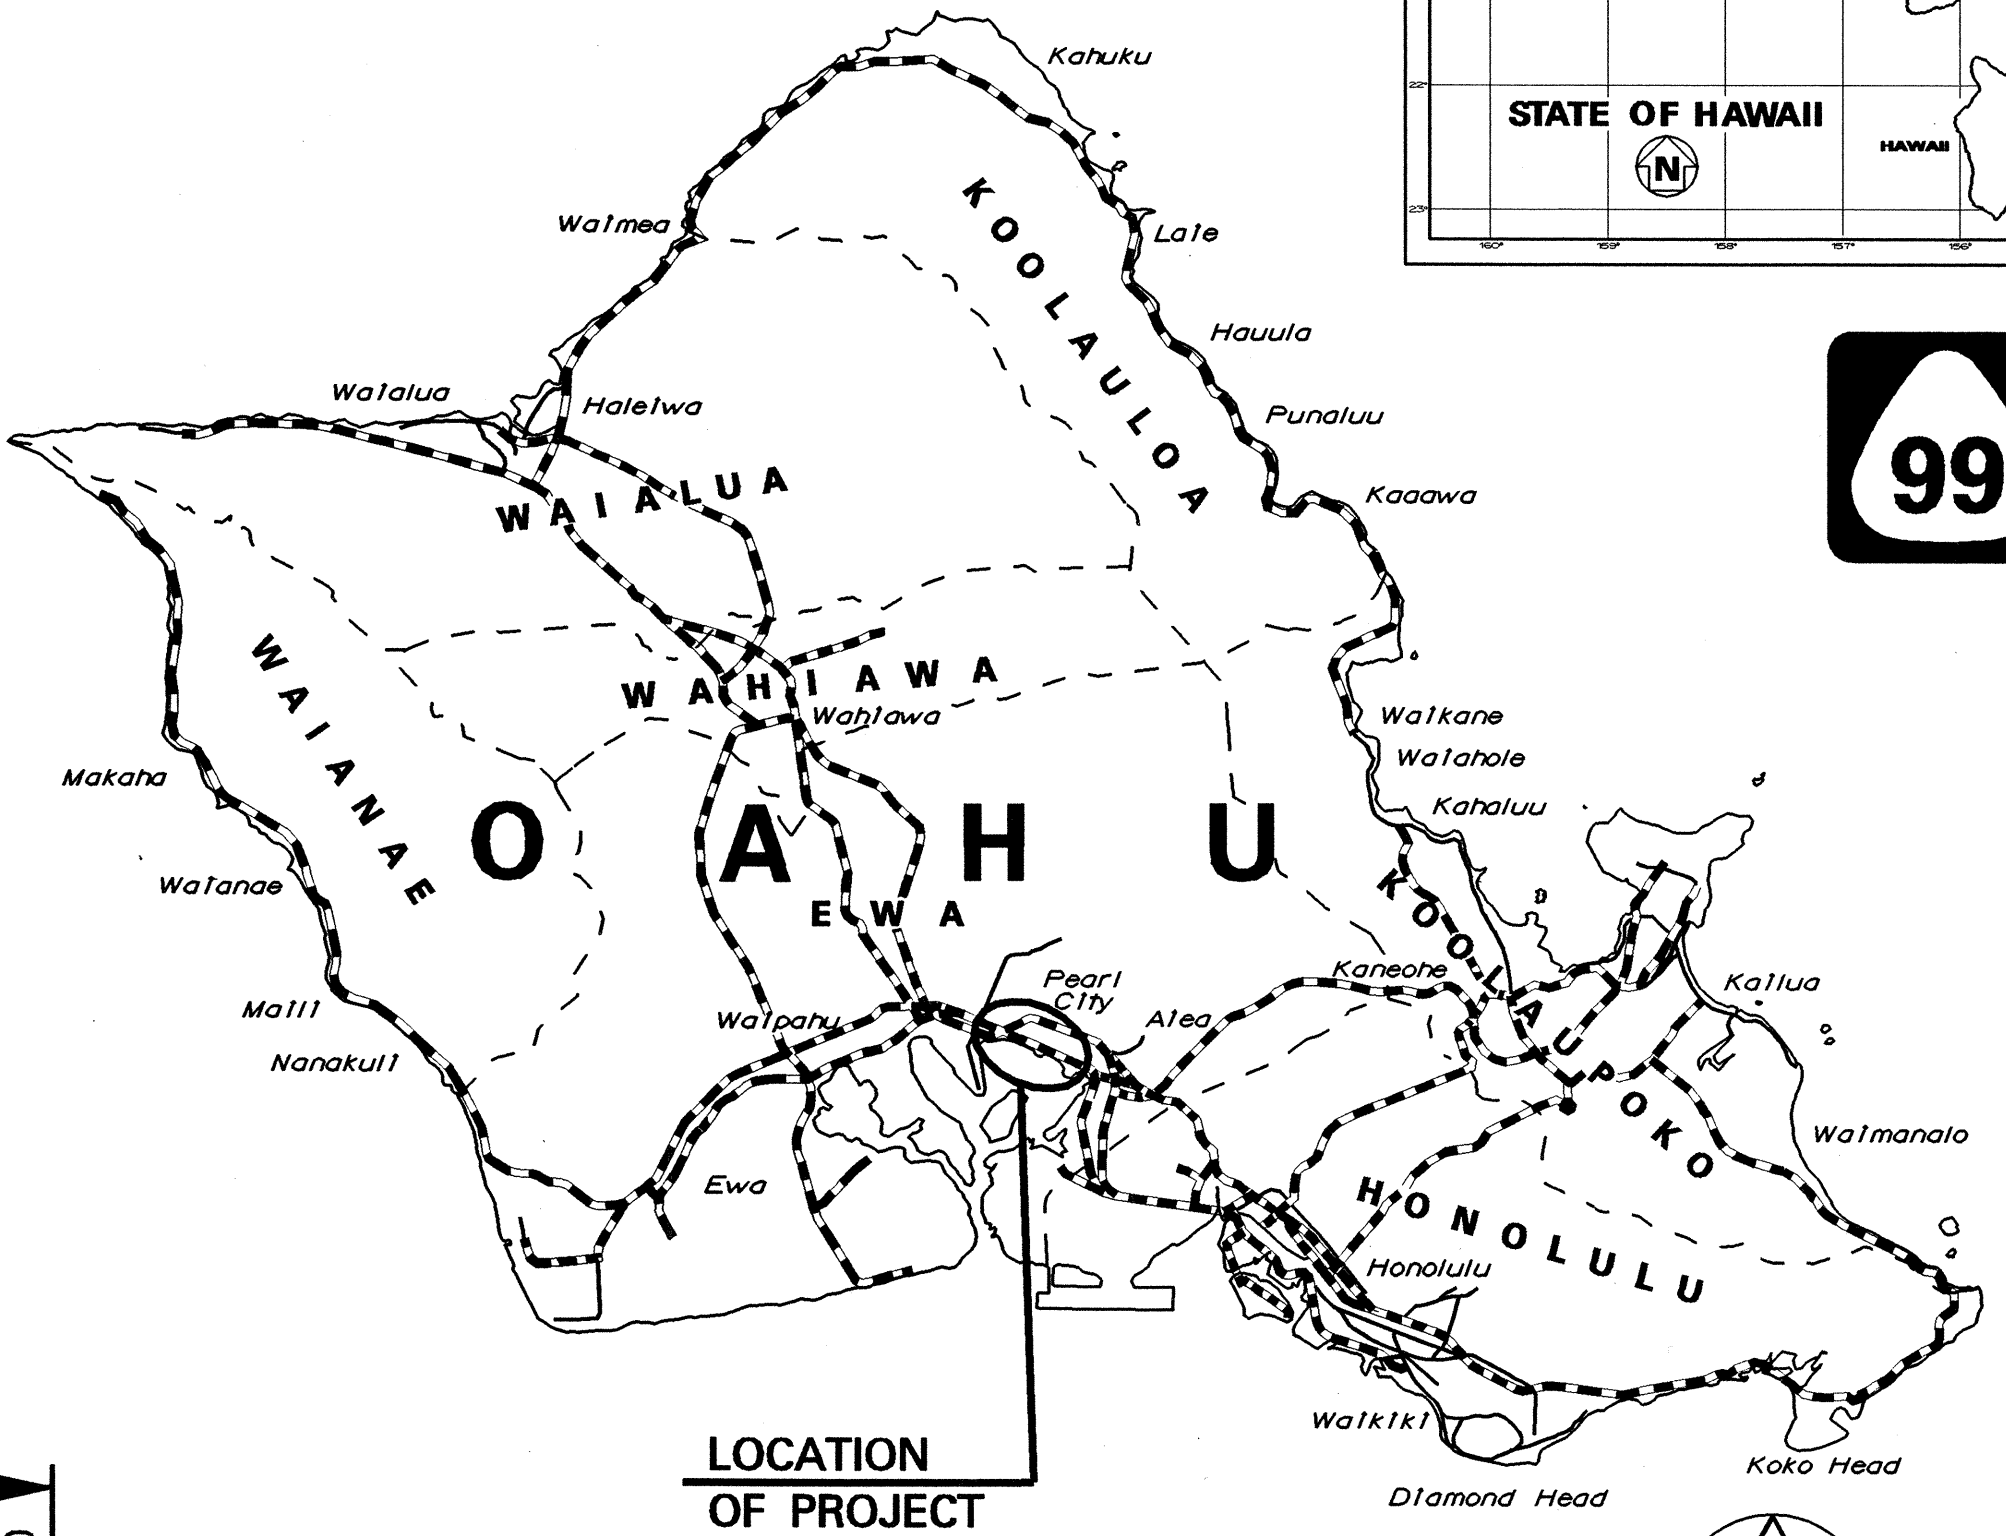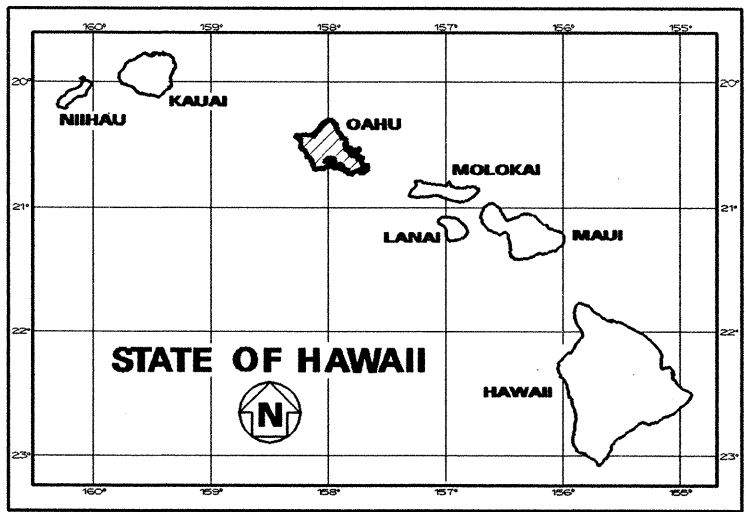

LOCATION
OF PROJECT

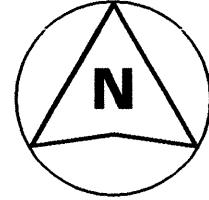

SCALE IN MILES

----- FEDERAL AID PROJECTS PREVIOUSLY CONSTRUCTED
OR UNDER CONSTRUCTION

MILE POST 18.30 TO MILE POST 20.94

CHANGES MADE DURING CONSTRUCTION HAVE BEEN
INCORPORATED ON THESE PLANS EXCEPT CHANGES
IN THE ORIGINAL THEORETICAL QUANTITIES. FOR
ACTUAL QUANTITIES, REFER TO PROJECT LEDGER
AND/OR COMPLETION REPORT.

DEPARTMENT OF TRANSPORTATION STATE OF HAWAII	
APPROVED:	
<i>[Signature]</i>	5-7-99
DIR. OF TRANSPORTATION	DATE