

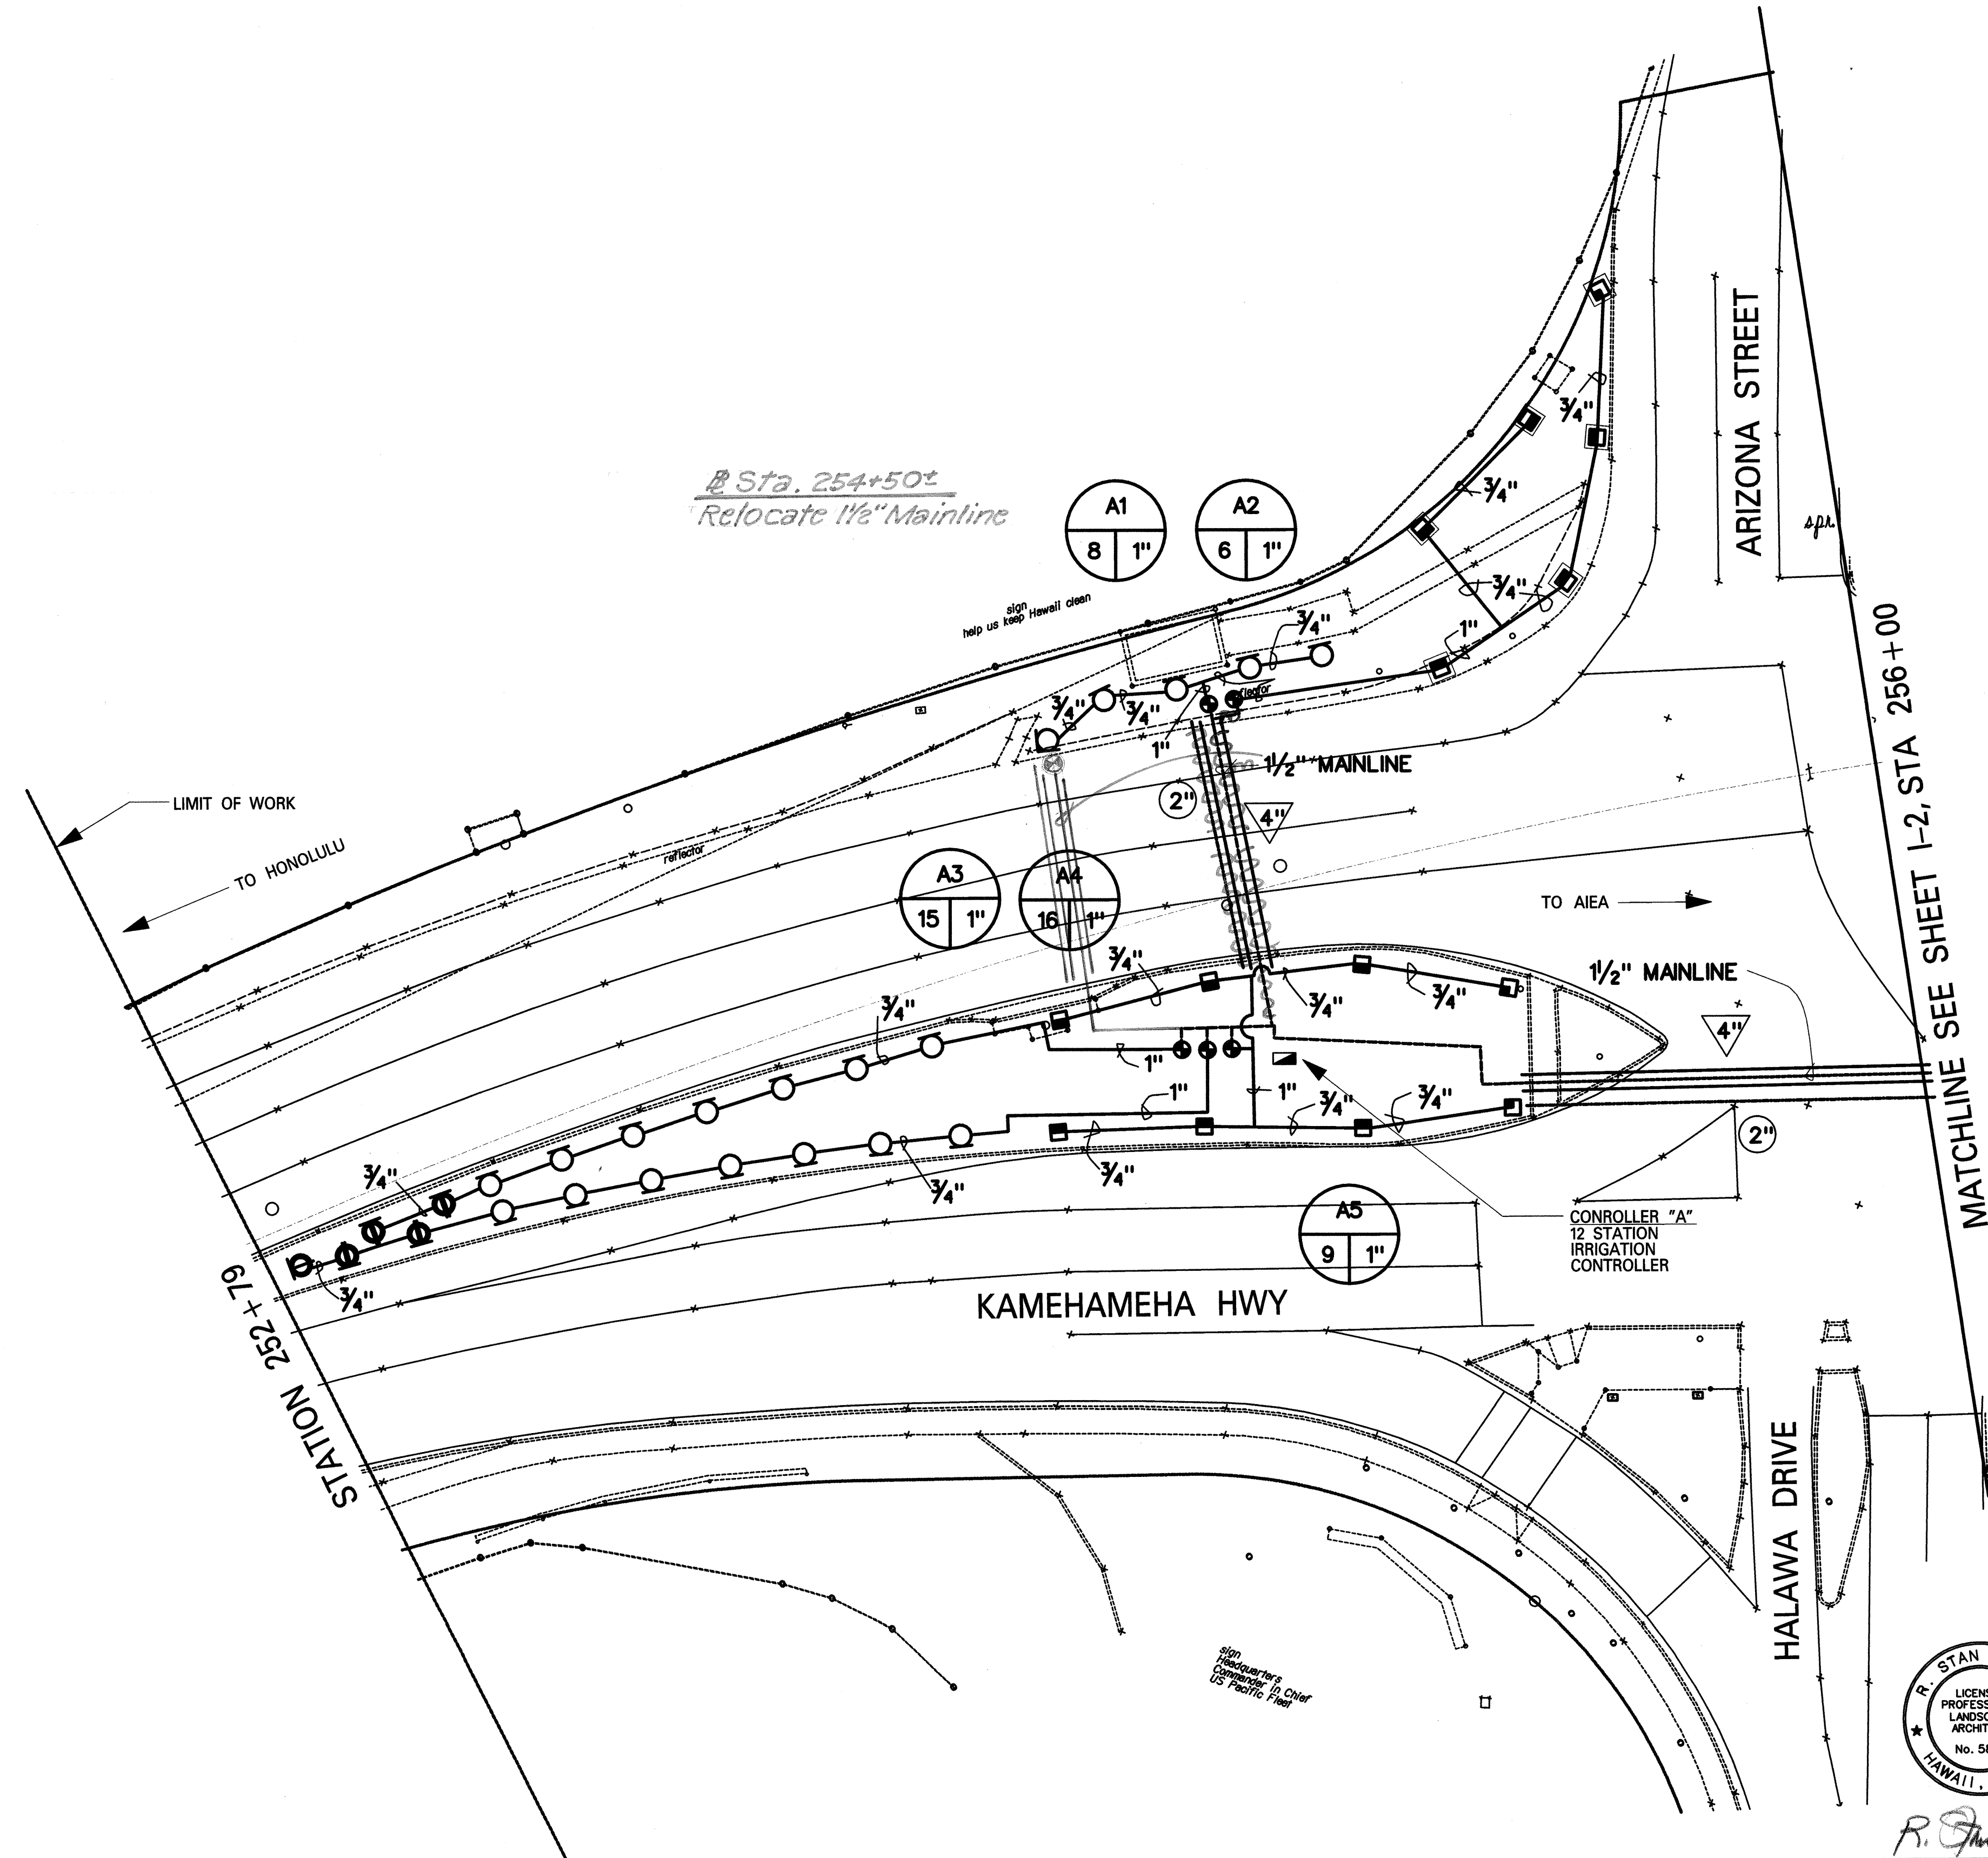


FED. ROAD DIST. NO.	STATE	FED. AID PROJ. NO.	FISCAL YEAR	SHEET NO.	TOTAL SHEETS
HAWAII	HAW.	99E-01-98	2000	3	14

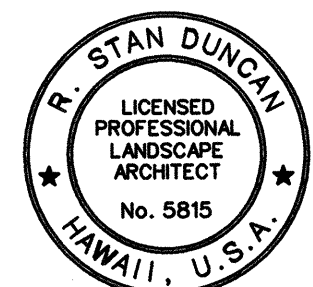

DESIGNED BY	DATE
DRAWN BY	
NOTED BY	
CHECKED BY	
ORIGINAL PLAN	
NOTE BOOK	
QUANTITIES BY	
CHECKED BY	

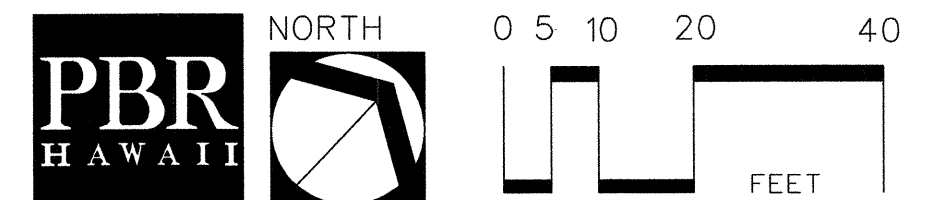

THIS WORK WAS PREPARED BY
ME OR UNDER MY SUPERVISION AND
CONSTRUCTION OF THIS PROJECT
WILL BE UNDER MY OBSERVATION


STATE OF HAWAII
DEPARTMENT OF TRANSPORTATION
HIGHWAYS DIVISION

IRRIGATION PLAN


KAMEHAMEHA HIGHWAY
LANDSCAPE IMPROVEMENTS,
VICINITY OF ARIZONA MEMORIAL

SCALE: 1"=20'-0"
DATE: MAY 1999

FED. ROAD DIST. NO.	STATE	FED. AID PROJ. NO.	FISCAL YEAR	SHEET NO.	TOTAL SHEETS
HAWAII	HAW.	99E-01-98	2000	4	14

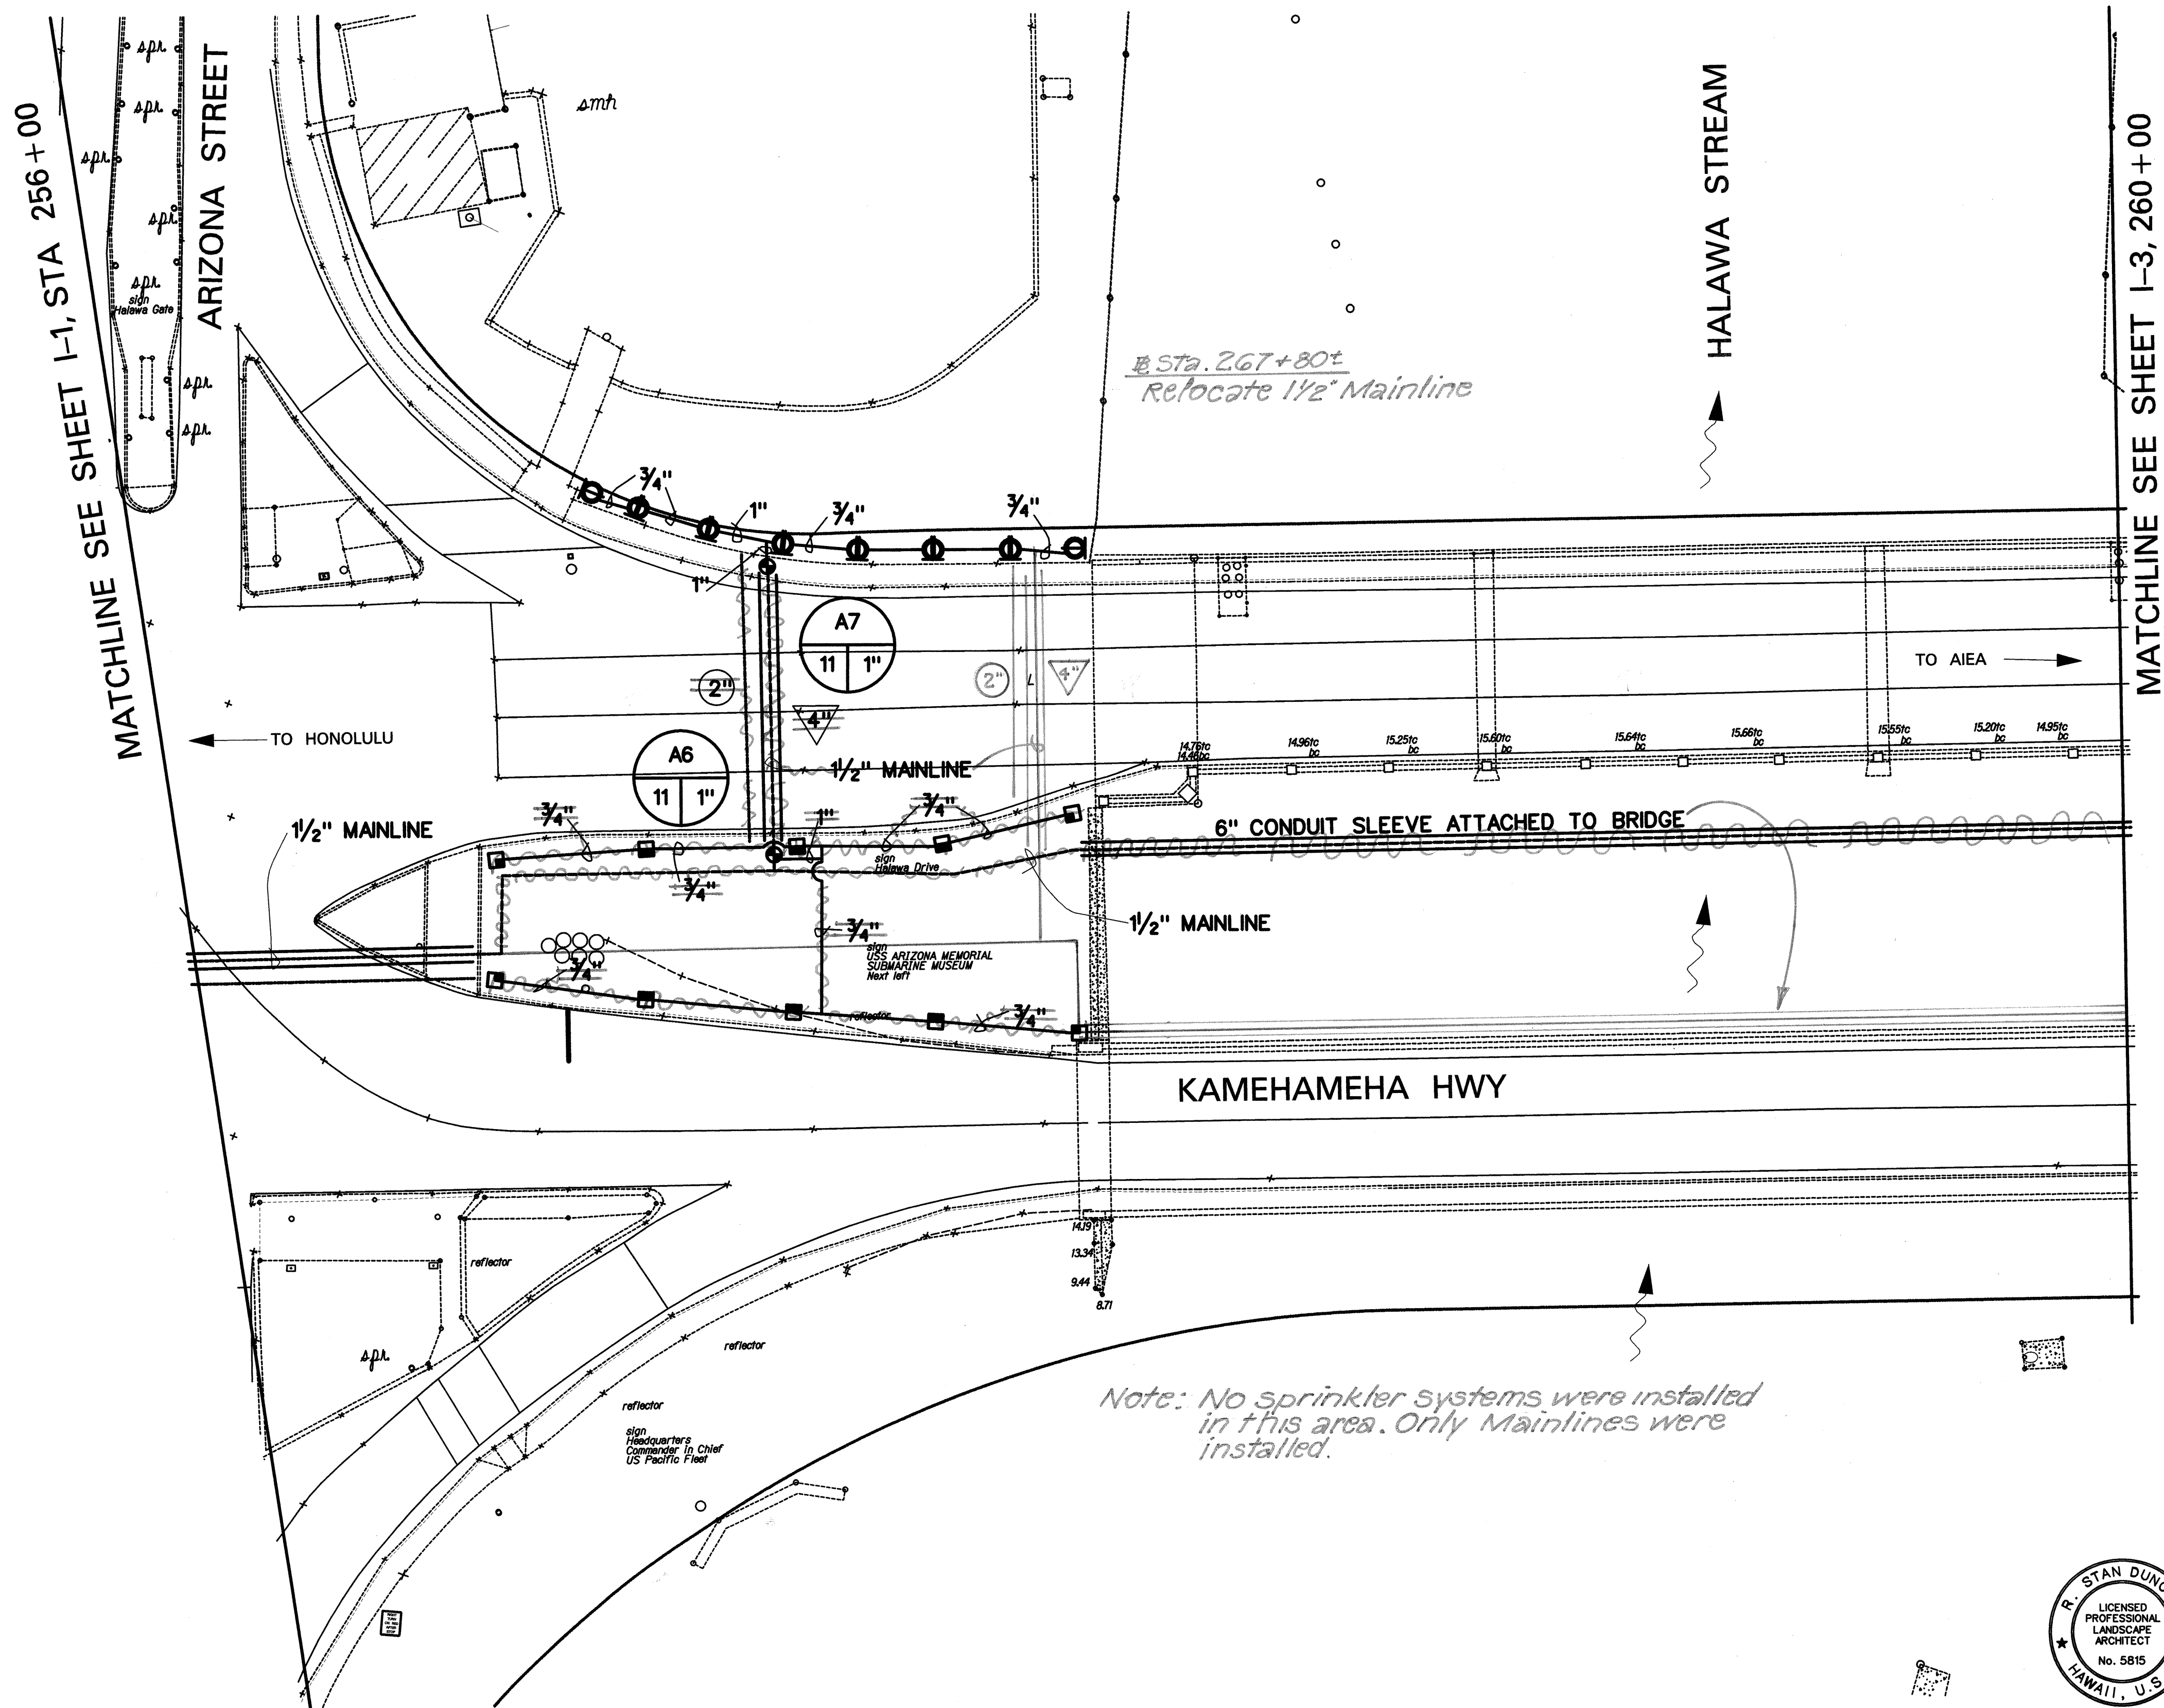


ORIGINAL PLAN	SURVEY PLOTTED BY	DATE
NOTE BOOK	DRAWN BY	
	DESIGNED BY	
	CHECKED BY	

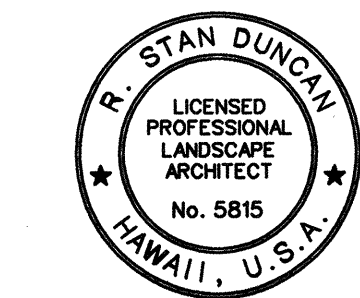

R. Stan Duncan
 THIS WORK WAS PREPARED BY
 ME OR UNDER MY SUPERVISION AND
 CONSTRUCTION OF THIS PROJECT
 WILL BE UNDER MY OBSERVATION

"AS-BUILT"

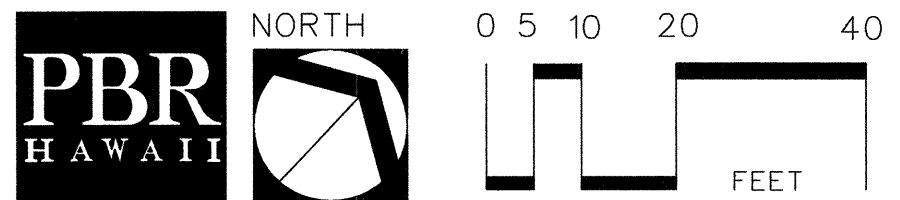

STATE OF HAWAII
 DEPARTMENT OF TRANSPORTATION
 HIGHWAYS DIVISION

IRRIGATION PLAN


KAMEHAMEHA HIGHWAY
 LANDSCAPE IMPROVEMENTS,
 VICINITY OF ARIZONA MEMORIAL

SCALE: 1"=20'-0"


DATE: MAY 15, 1999

SHEET No. I-2 OF 14 SHEETS


FED. ROAD DIST. NO.	STATE	FED. AID PROJ. NO.	FISCAL YEAR	SHEET NO.	TOTAL SHEETS
HAWAII	HAW.	99E-01-98	2000	5	14

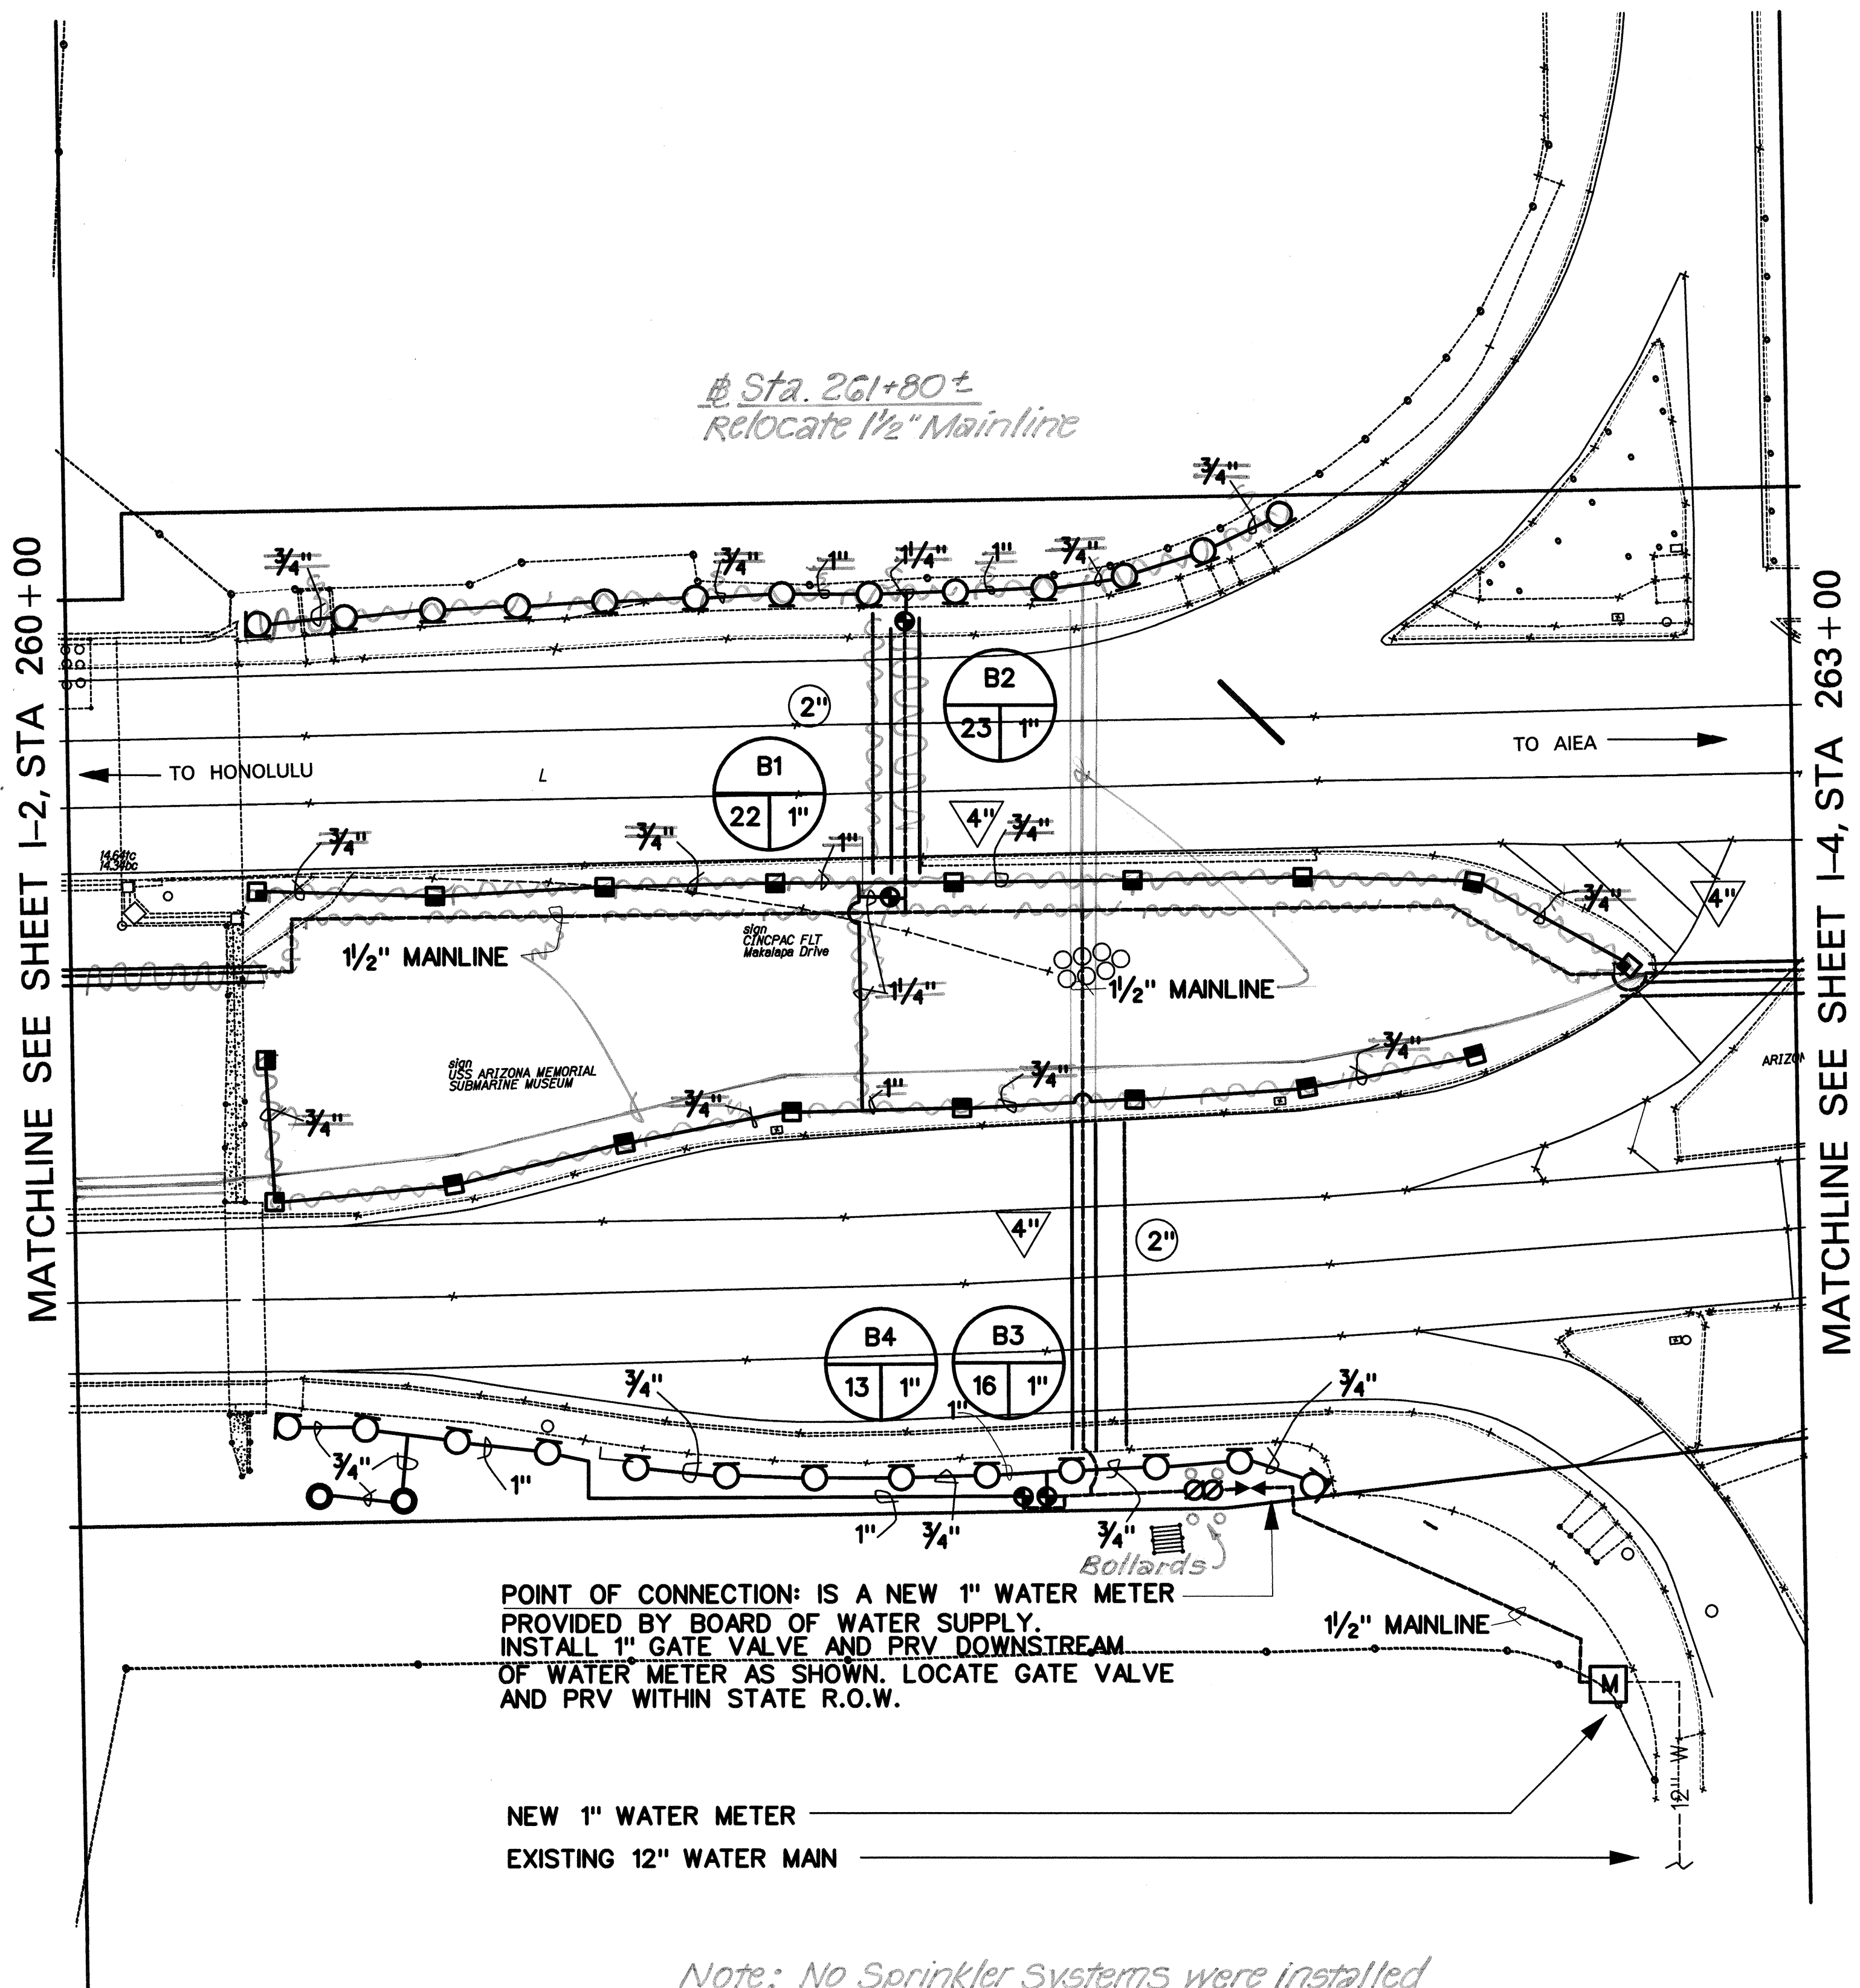

SURVEY PLOTTED BY	DATE
DRAWN BY	
DESIGNED BY	
QUANTITIES BY	
CHECKED BY	
ORIGINAL PLAN	
NOTE BOOK	

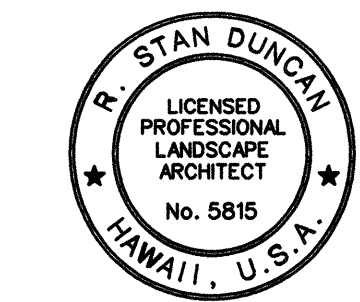

THIS WORK WAS PREPARED BY ME OR UNDER MY SUPERVISION AND CONSTRUCTION OF THIS PROJECT WILL BE UNDER MY OBSERVATION

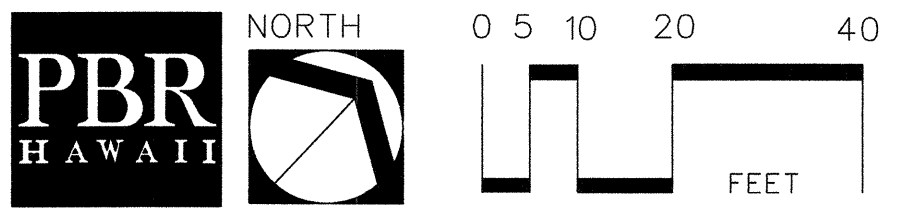

STATE OF HAWAII

DEPARTMENT OF TRANSPORTATION

HIGHWAYS DIVISION

IRRIGATION PLAN

KAMEHAMEHA HIGHWAY

LANDSCAPE IMPROVEMENTS,


VICINITY OF ARIZONA MEMORIAL

SCALE: 1"=20'-0"


DATE: MAY 1, 1999

FED. ROAD DIST. NO.	STATE	FED. AID PROJ. NO.	FISCAL YEAR	SHEET NO.	TOTAL SHEETS
HAWAII	HAW.	99E-01-98	2000	6	14


MATCHLINE SEE SHEET I-3, STA 263+00

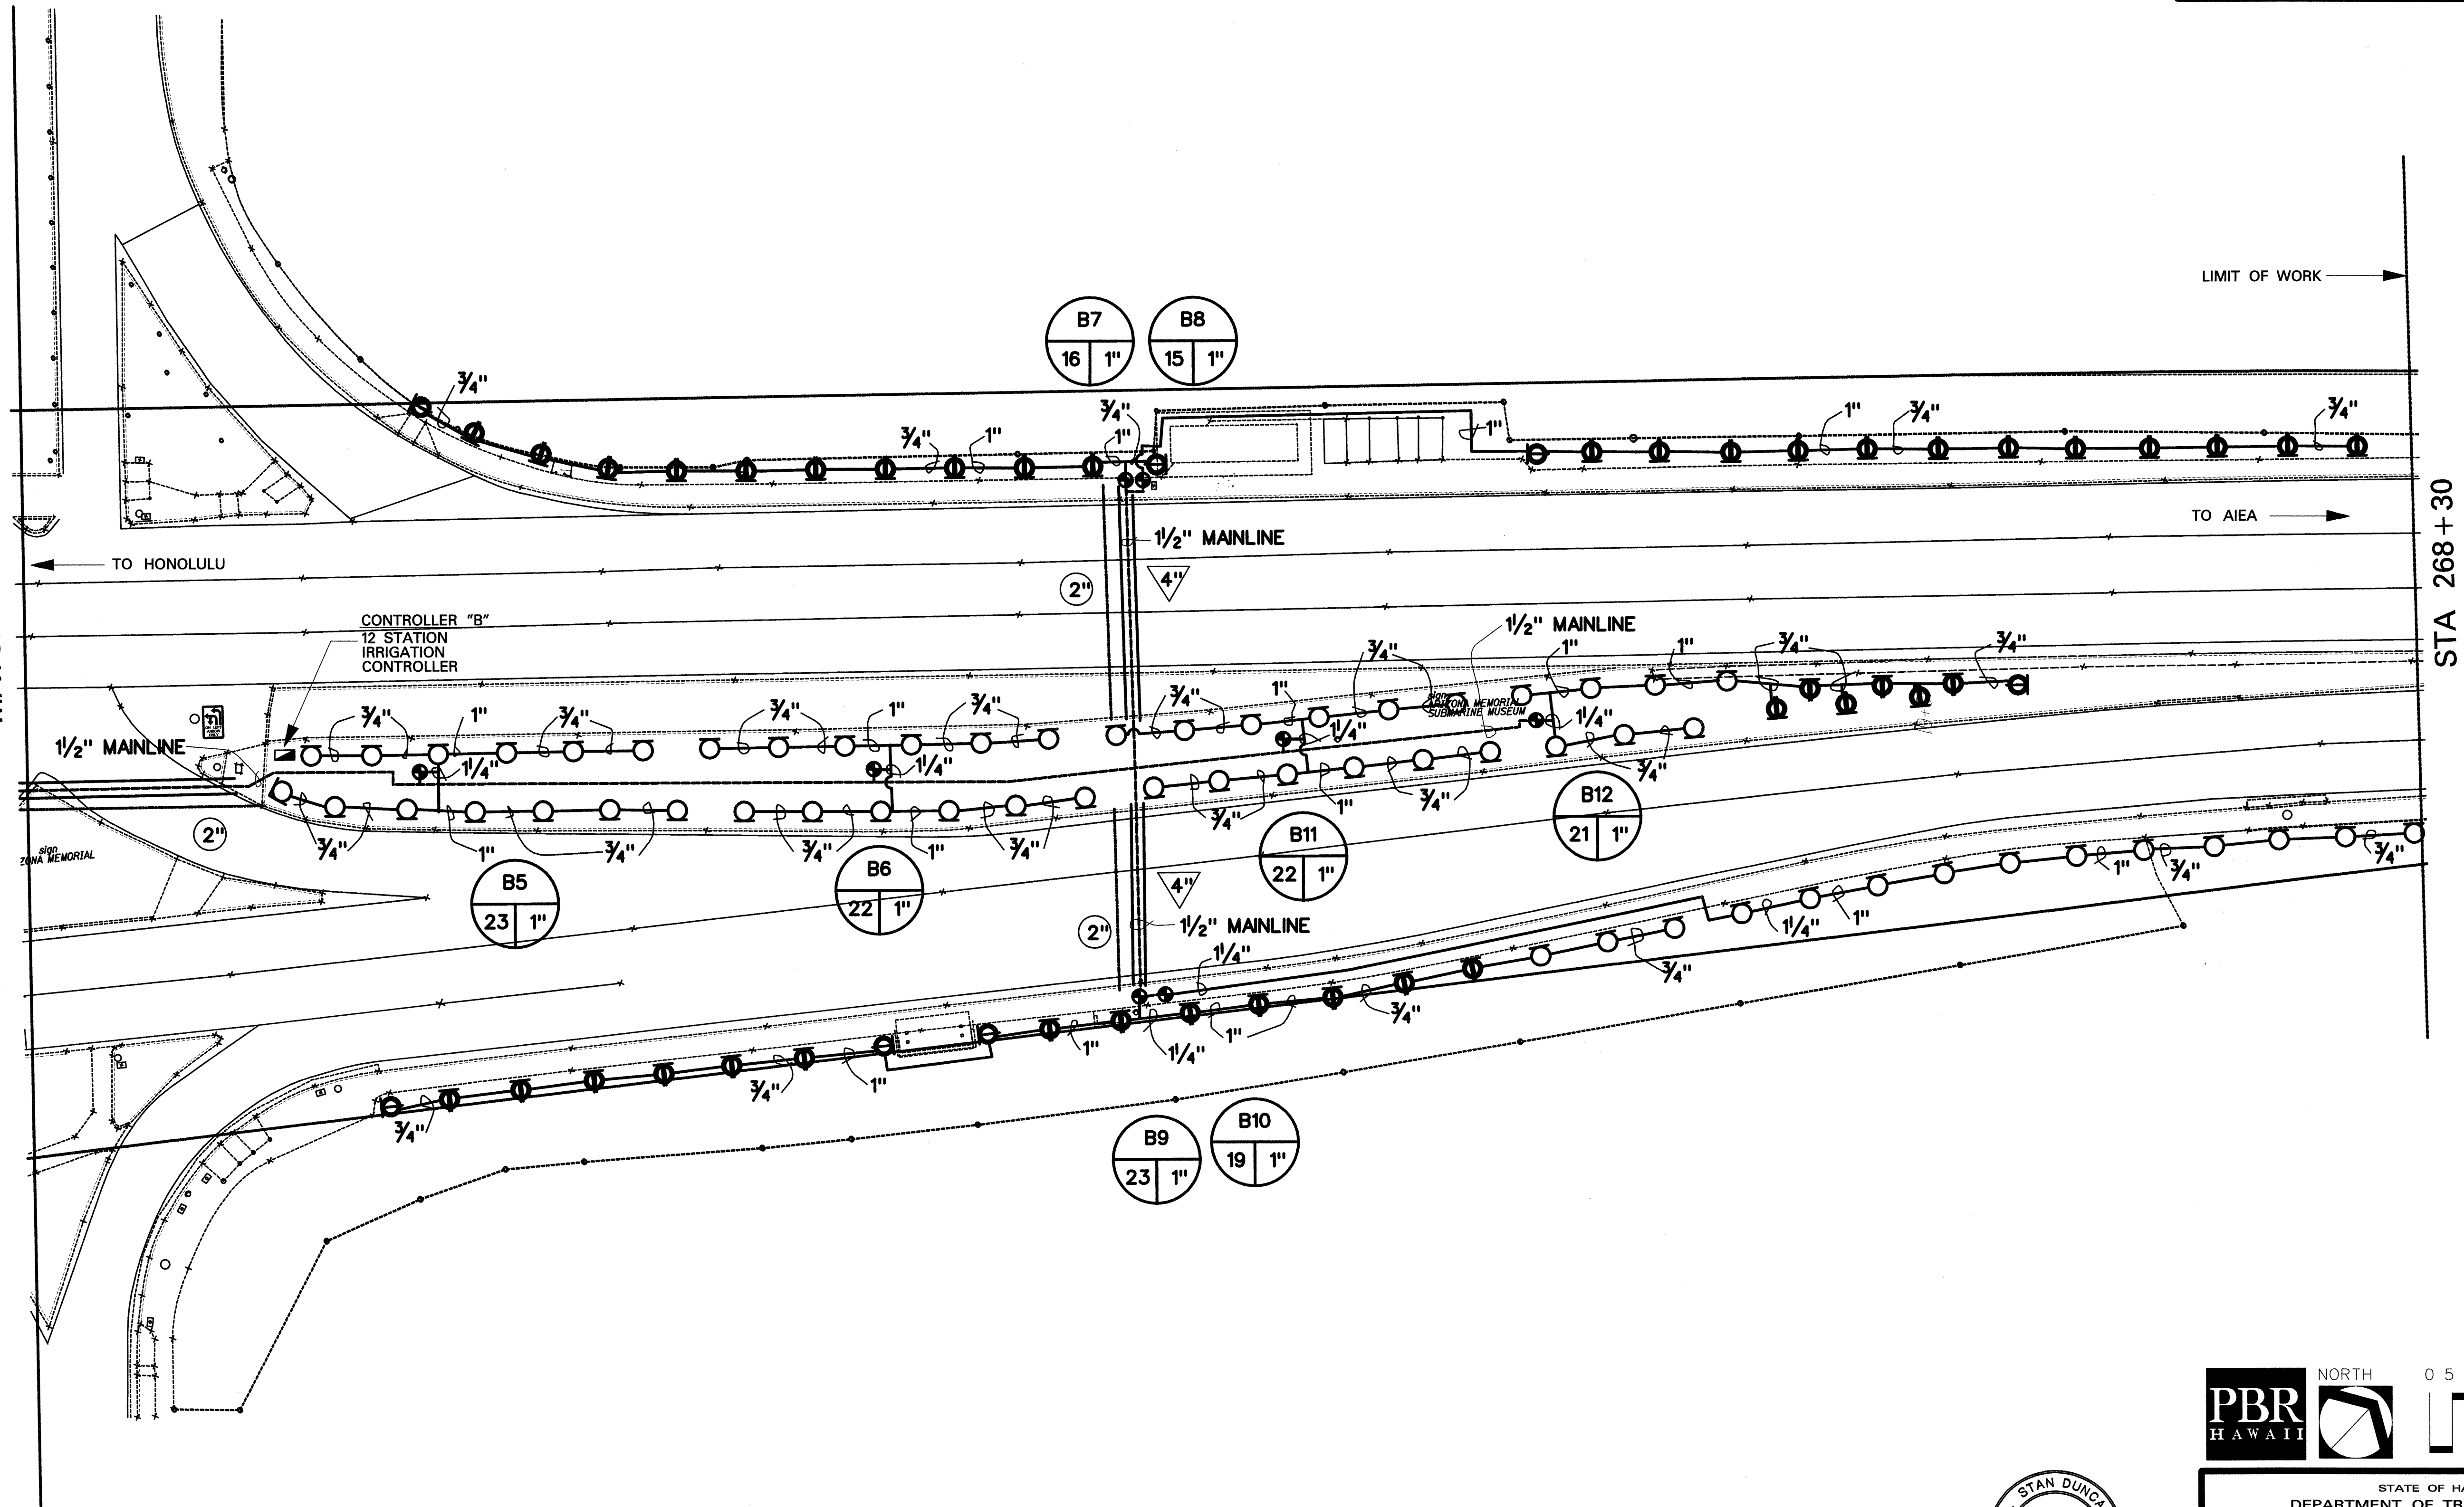

ORIGINAL PLAN	DATE
SURVEY PLOTTED BY	
DRAWN BY	
DESIGNED BY	
QUANTITIES BY	
CHECKED BY	

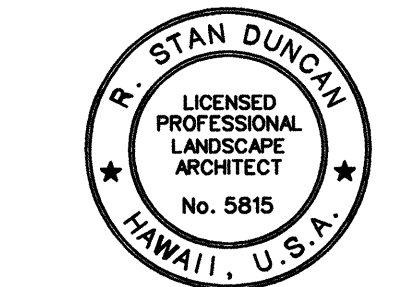

THIS WORK WAS PREPARED BY ME OR UNDER MY SUPERVISION AND CONSTRUCTION OF THIS PROJECT WILL BE UNDER MY OBSERVATION

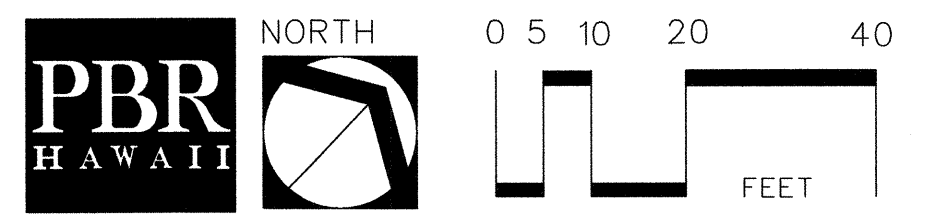

STATE OF HAWAII
DEPARTMENT OF TRANSPORTATION
HIGHWAYS DIVISION

IRRIGATION PLAN

KAMEHAMEHA HIGHWAY
LANDSCAPE IMPROVEMENTS,
VICINITY OF ARIZONA MEMORIAL

SCALE: 1"=20'-0"
DATE: MAY 11, 1999