INDEX TO DRAWINGS	
SHEET NO.	DESCRIPTION
1	TITLE SHEET
2	GENERAL NOTES
3 – 6	IRRIGATION PLANS
7 – 8	IRRIGATION DETAILS
9	IRRIGATION LEGEND & NOTES
10 – 13	PLANTING PLANS
14	PLANTING DETAILS, LEGEND & NOTES

STATE OF HAWAII

DEPARTMENT OF TRANSPORTATION

HIGHWAYS DIVISION HONOLULU, HAWAII


PLANS FOR

KAMEHAMEHA HIGHWAY

LANDSCAPE IMPROVEMENTS, VICINITY OF ARIZONA MEMORIAL

PROJECT NO. 99E-01-98


DISTRICT OF EWA ISLAND OF OAHU

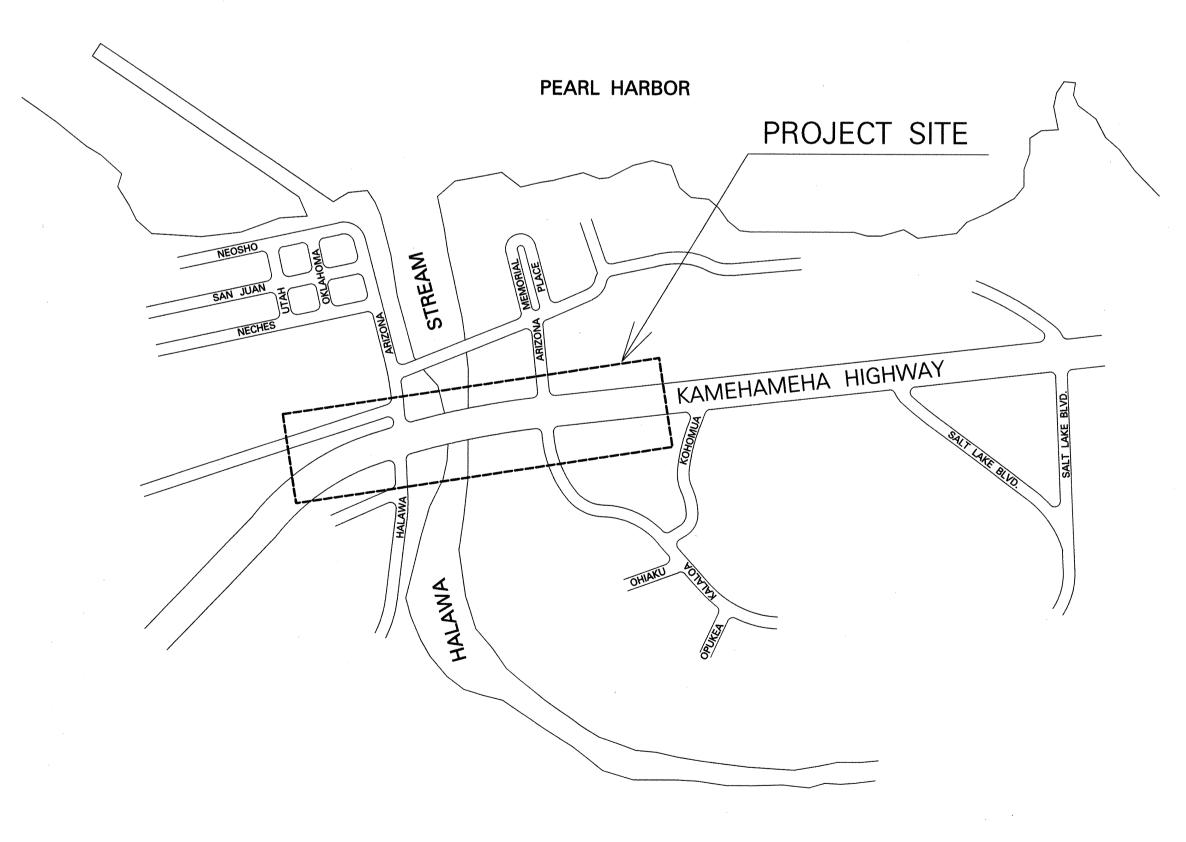

LOCATION PLAN





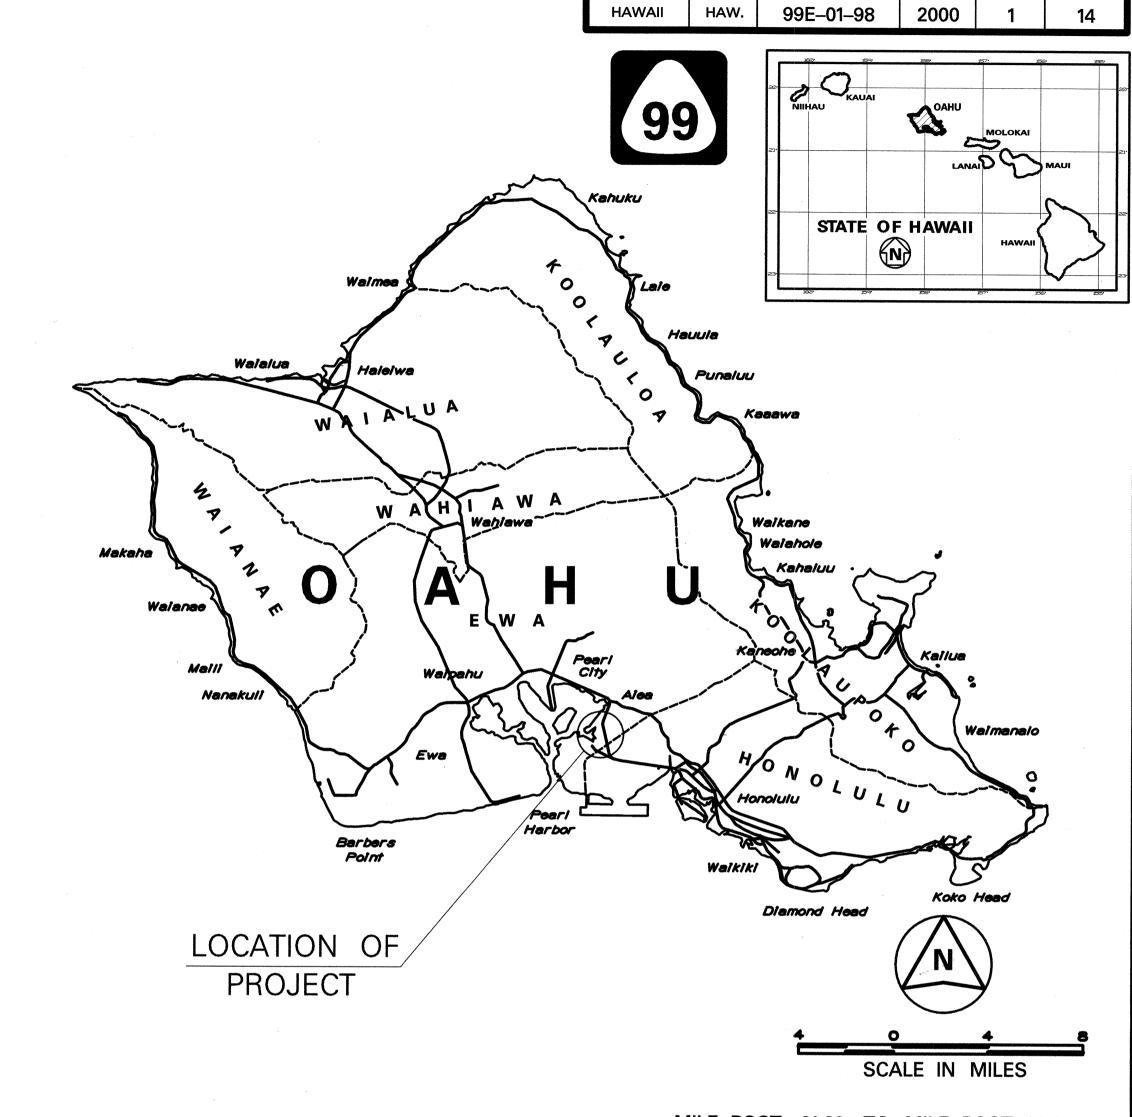

FED. ROAD DIST. NO. FISCAL SHEET YEAR NO.

MILE POST 21.89 TO MILE POST 22.18

CHANGES MADE DURING CONSTRUCTION HAVE BEEN INCORPORATED ON THESE PLANS EXCEPT CHANGES FOR ACTUAL CHANTITIES, FOR ACTUAL CHANTITIES, REPORT TO PROSECT LEGISM 2-26-09

DEPARTMENT OF TRANSPORTATION
STATE OF HAWAII

APPROVED:

DIR. OF TRANSPORTATION