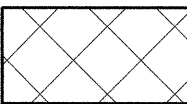
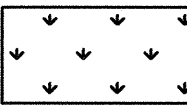


Legend

-  New 3" Thick A.C. Pavement, Mix IV
-  New 6" Top Soil and Grass Landscaping

Notes:

- Wilikina Drive Baseline Sta. from DOT Project:
"Wilikina Drive - Intersection Improvements
at Kamananui Road." FAP No. STP-099-1(18)
- For Geometrics, See Sheet 10.

United States Military Reservation
Schofield Barracks
TMK: 7-7-01:1

MATCH LINE @ STA. 23+00

FED. ROAD DIST. NO.	STATE	PROJ. NO.	FISCAL YEAR	SHEET NO.	TOTAL SHEETS
HAWAII	HAW.	99C-02-00	2001	13	51

True North
Scale: 1" = 20'

Construct Reinforced Concrete Beam over Exist. 24" Drain Line. (See Det. on Sht. 24)

Match Exist. Pavement. Provide Smooth Riding Connection. Typical All Edges. (See Det. on Sht. 24)

24+63.73 (o/s 8' RT) Match Exist. Conc. Curb

Provide 6" (Min.) Top Soil and Grass

Construct 3" Thick A.C. Pavement, Mix IV (See Detail on Sht. 24)

25+25 Match Exist. Pavement

Construct Type 2D Conc. Curb

24+50 Match Exist. Pavement

Construct Type 2D Conc. Curb

Provide 6" (Min.) Top Soil and Grass

SDMH

MATCH LINE @ STA. 15+00

WILIKINA DRIVE

To Waialua

BEGIN PROJECT
Project No. 99C-02-00
@ Sta. 9+53.52

Construct 3" Thick A.C. Pavement, Mix IV (See Detail on Sht. 24)

Parcel 8
T.M.K.: 7-3-13: 8
Owner: State of Hawaii

13+80.45 Wilikina Drive = 25+83 McCornack Road (CE)
Install Standard Street Survey Monument

Construct 3" Thick A.C. Pavement, Mix IV (See Detail on Sht. 24)



THIS WORK WAS PREPARED BY ME OR UNDER MY SUPERVISION.
PETER L. NOW
ENGINEERS SURVEYORS HAWAII, INC.

STATE OF HAWAII
DEPARTMENT OF TRANSPORTATION
HIGHWAYS DIVISION

ROADWAY PLAN

WILIKINA DR INTERSECTION IMPROVEMENTS
AT McNAIR GATE

Project No. 99C-02-00

Scale: 1" = 20' Date: Sep 2000

SHEET No. 1 OF 3 SHEETS

