



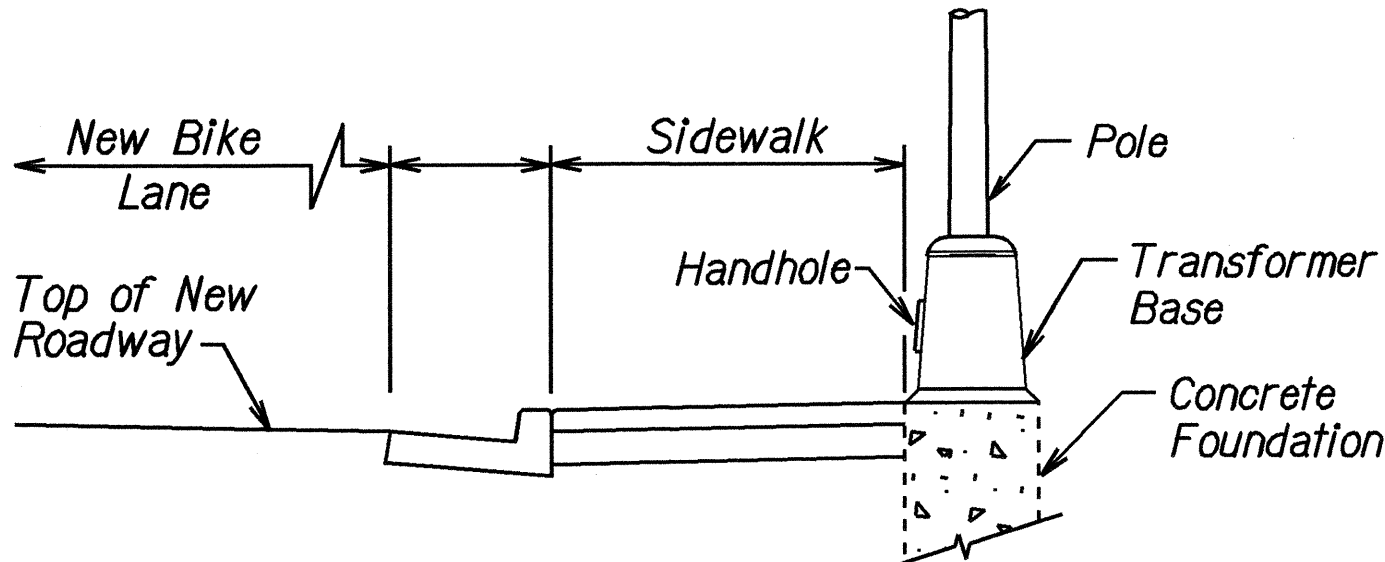


FED. ROAD DIST. NO.	STATE	FED. AID PROJ. NO.	FISCAL YEAR	SHEET NO.	TOTAL SHEETS
HAWAII	HAW.	CMAQ-099-1(22)	2005	50	60

**CITY CAMERA NOTE**

Install salvaged City traffic surveillance camera and pole on new Type I Foundation.  
Install Type A pullbox. Reconnect existing conduit to Type A pullbox. Install existing cable in new system and connect.

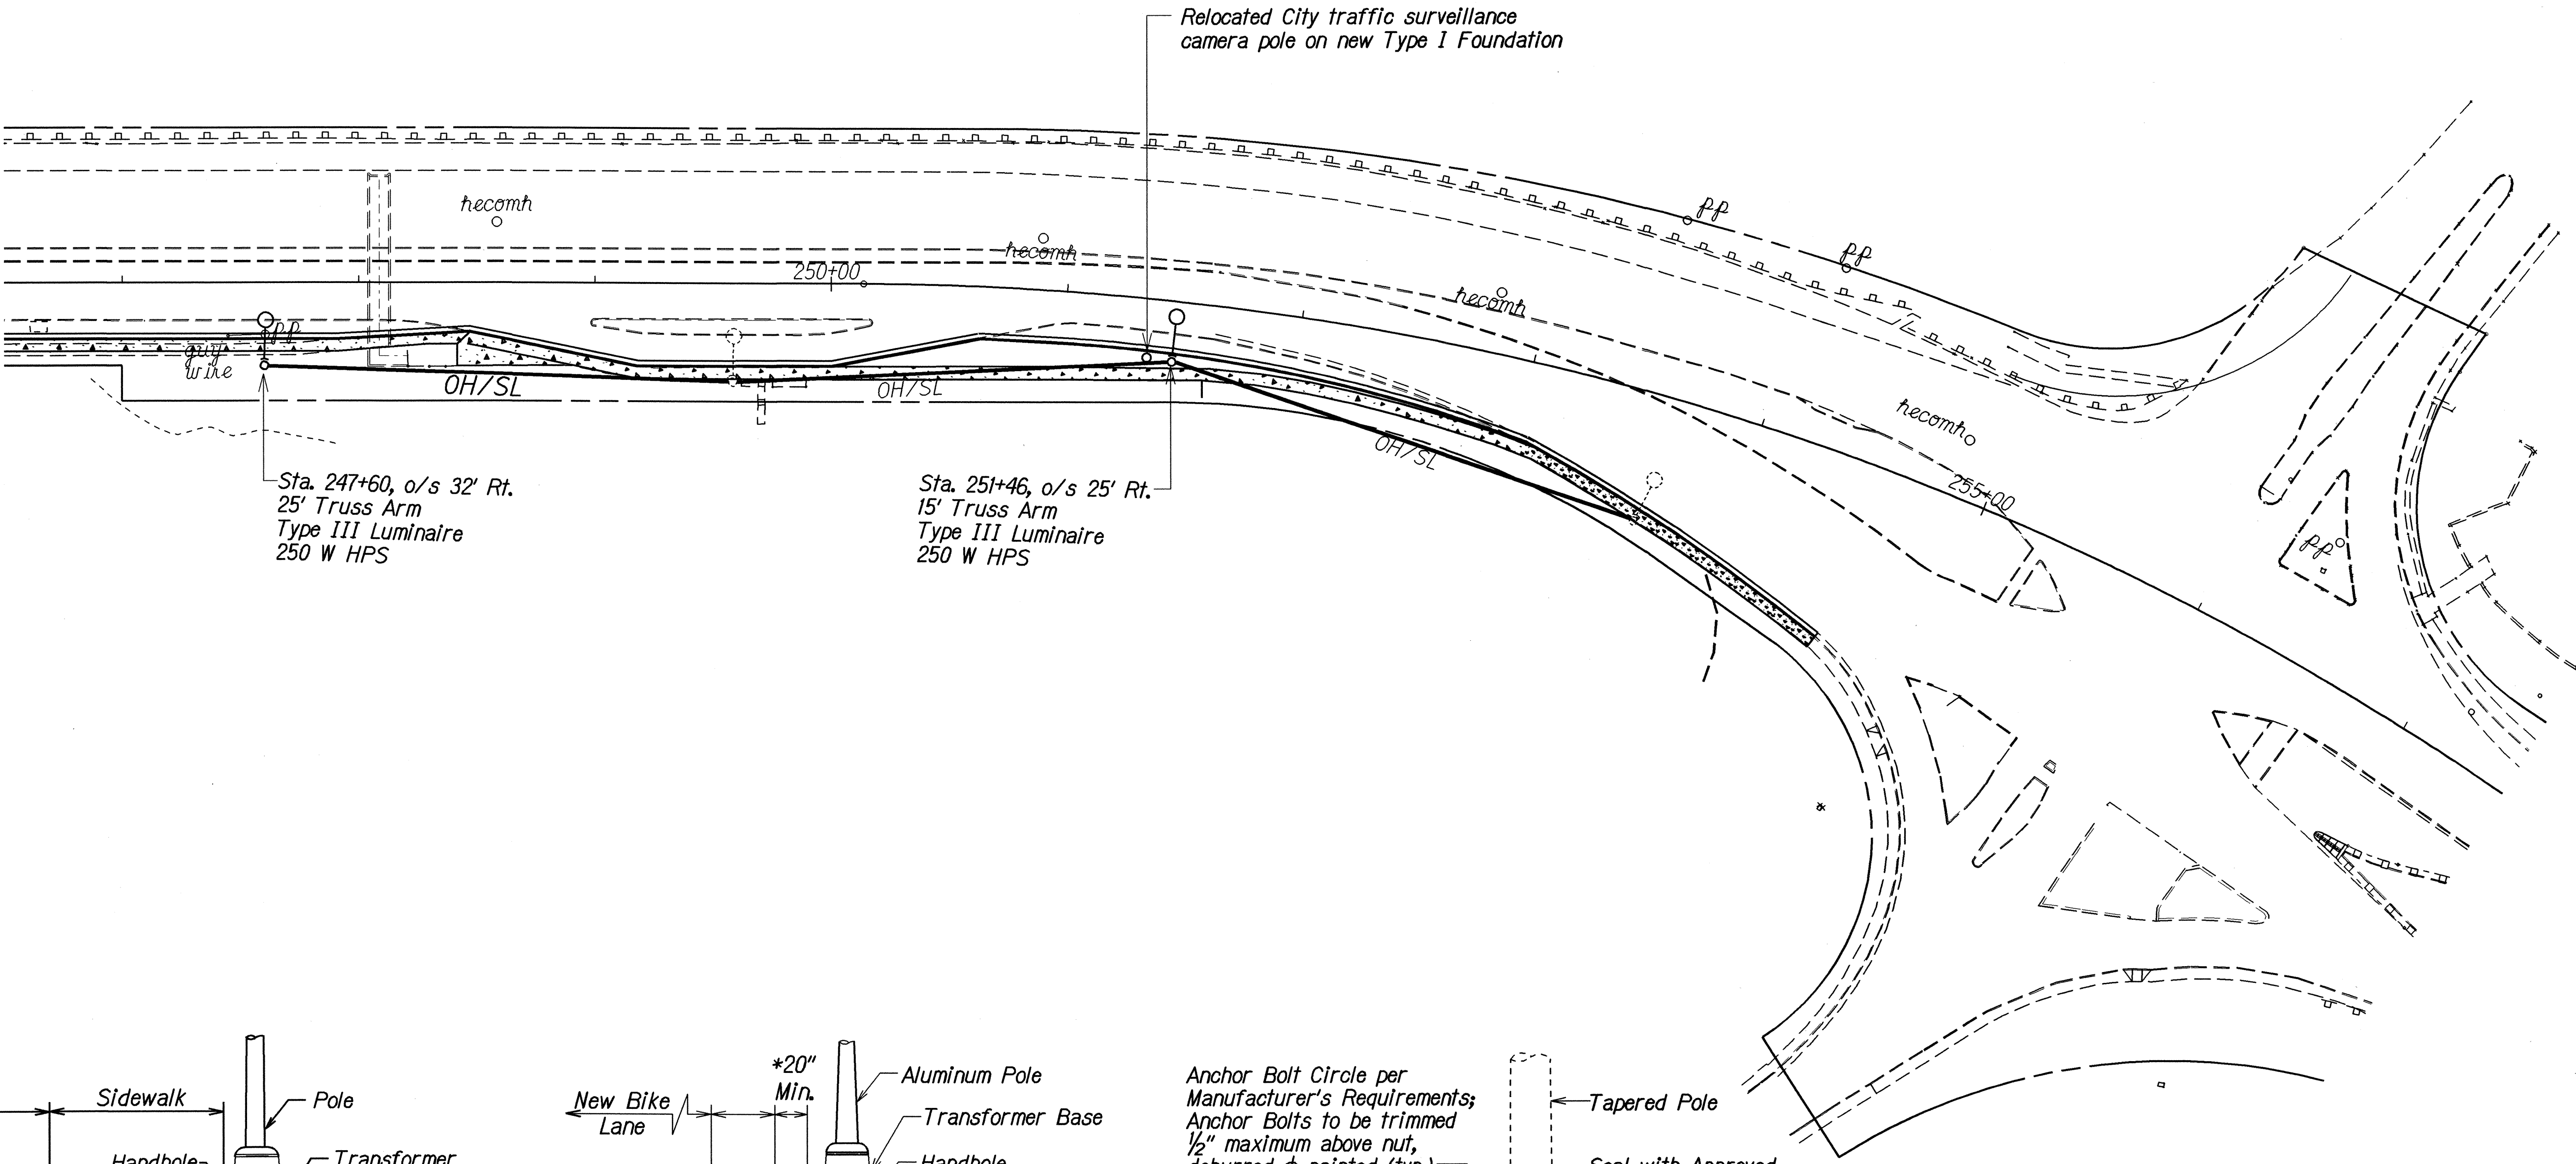


**RELOCATED HIGHWAY LIGHTING DETAIL  
AT STA. 247+60 RT.**  
Not to Scale

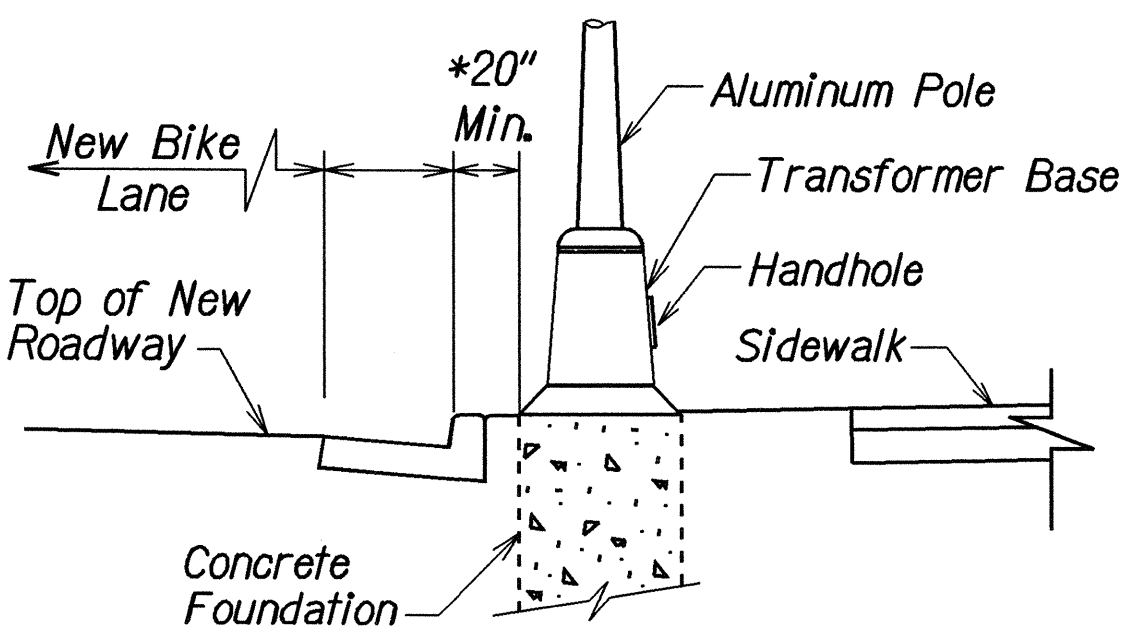

\* - If 20" min. cannot be maintained due to conflict with other utilities, coordinate field adjustments with Engineer.

**RELOCATED HIGHWAY LIGHTING DETAIL  
AT STA. 251+46 RT.**  
Not to Scale

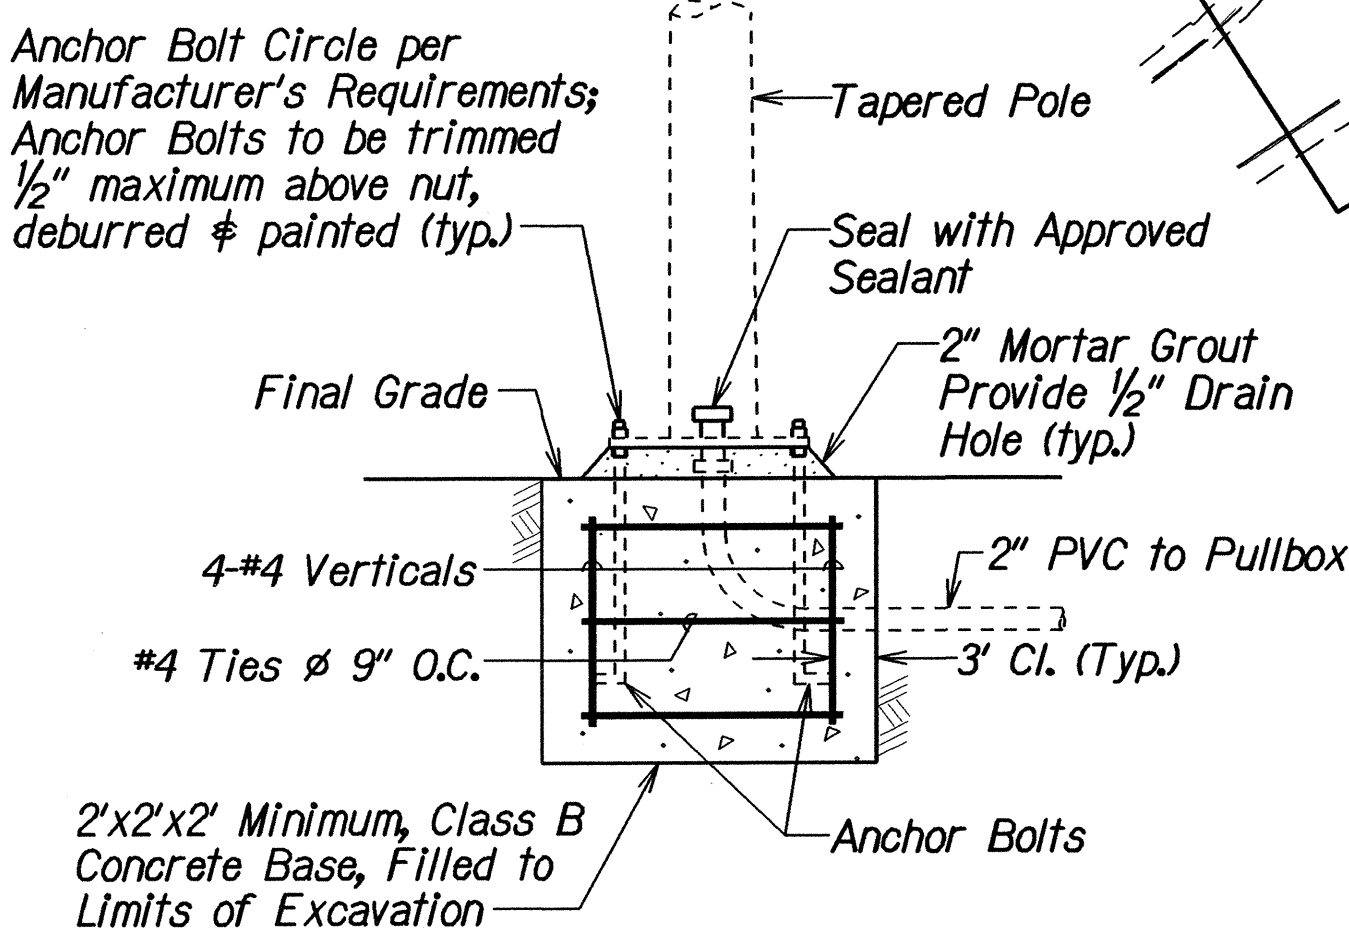

**TYPE I FOUNDATION DETAIL**

SURVEY PLOTTED BY	DATE
DRAWN BY	
DESIGNED BY	
QUANTITIES BY	
CHECKED BY	
ORIGINAL PLAN	
NOTE BOOK	
102 may	
No. 04/11/04	


STATE OF HAWAII  
DEPARTMENT OF TRANSPORTATION  
HIGHWAYS DIVISION

**HIGHWAY LIGHTING PLAN**  
KAMEHAMEHA HIGHWAY BIKEWAY  
Vicinity of Radford Drive to Arizona Memorial  
Federal Aid Project No. CMAQ-099-1(22)  
Scale: 1"=40'      Date: November 2004  
SHEET No. **E2** OF **4** SHEETS








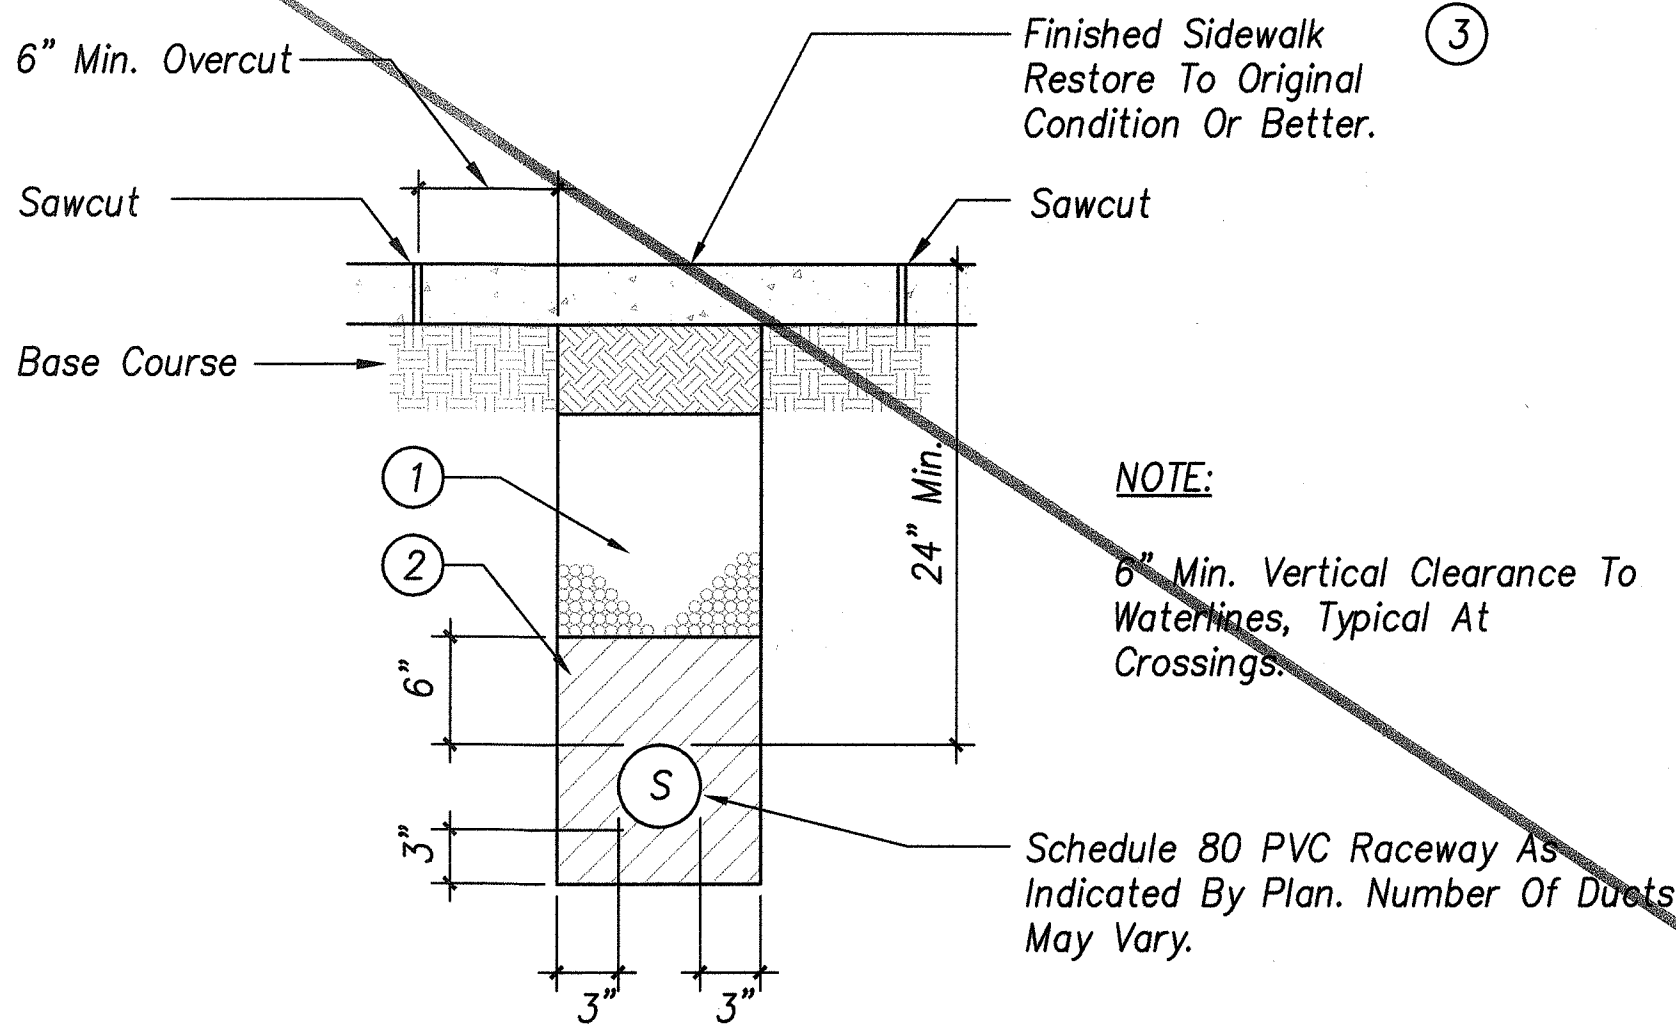

DIRECT BURIED DUCT TYPE [A]

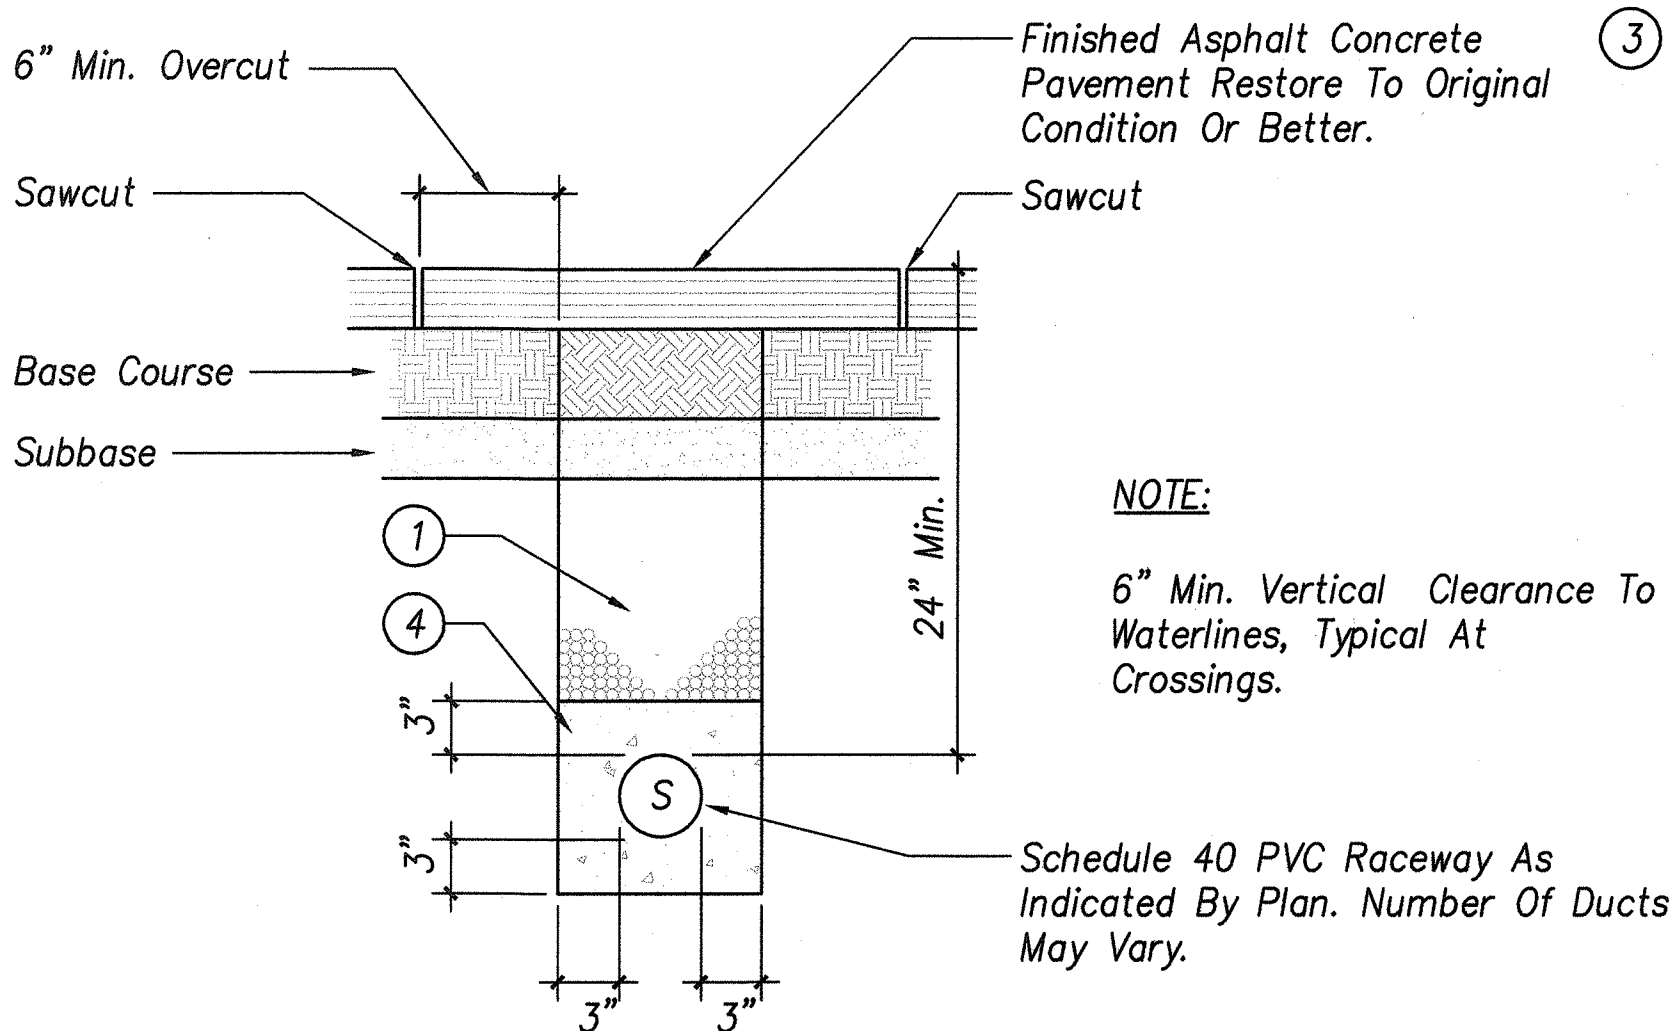

ENCASED DUCT TYPE [B]

A  
S-1  
TYPICAL DUCT SECTIONS  
Not to Scale

NOTES:

- Type "A" backfill - beach sand, earth, or earth and gravel. If earth and gravel, the maximum rock size shall be 1" and the mixture shall not contain more than 50% by volume of rock particles.
- Type "B" backfill - beach sand, earth, or earth and gravel. If earth and gravel, the mixture must pass a 1/2" mesh screen and contain not more than 20% by volume of rock particles.
- Concrete structure/pavement shall be equivalent or better than existing in thickness and quality.
- Provide 3" concrete jacket for schedule 40 PVC conduits under roadway conditions.

TRAFFIC SIGNAL NOTES:

- The locations of the traffic signal standards, pedestrian push buttons, pullboxes, conduits shall be staked out in the field by the Contractor and approval of the locations shall be obtained from the Engineer prior to construction and installation.
- All splicing shall be done in the pullboxes.
- Should any defect be encountered during the warranty period, the manufacturer will be notified and he shall promptly correct such defect. Service call (by factory qualified representative) during the warranty period for repairs or other maintenance shall be answered within 24 hours and shall be done at no expense to the State. All repairs shall be done as soon as possible.
- All traffic signal work shall conform to the requirements of the "Manual on uniform traffic control devices for streets and highway", Federal Highway Administration (1988) and amendments.
- All conduits between pullboxes and traffic signal standards shall be considered incidental to various contract items.
- After installing all the traffic signal cables, the Contractor shall duct seal all conduits in the pullboxes and traffic signal standards. The duct seal material shall be approved by the Traffic Signal Inspector/Engineer and shall be considered incidental to the direct buried and/or concrete encased conduits.
- Connecting into existing traffic signal system and making all necessary adjustments shall not be paid for separately, but considered incidental to the various traffic signal contract items.
- The Contractor shall notify the Traffic Control Branch, department of Transportation Services, City & County of Honolulu, (phone no. 523-4589) three (3) working days prior to commencing any work on the traffic signal system.
- The Department of Transportation Services, City & County of Honolulu, will assist the engineer in construction inspection for the traffic signal system.
- The traffic signal system shall be kept operational during construction. Any relocation required shall be approved by the Traffic Control Branch, Department of Transportation Services, and paid for by the contractor.
- The Contractor shall be responsible for any damages to the existing traffic signal facilities, including the traffic signal interconnect system. Any and all damages to these facilities shall be repaired by the Contractor at his cost in accordance with the requirements of the City and County of Honolulu.
- The Contractor shall be responsible for any damages to the existing traffic signal fiber optic cable system. Any and all damages to these facilities shall be repaired by the contractor at his cost in accordance with the requirements of the City and County of Honolulu.

HIGHWAY LIGHTING NOTES:

- The Contractor shall notify the State Highways, Highway Lighting and Traffic Supervisor 72 hours in advance before commencing any work on the highway lighting system. Phone: 837-8056.
- The Contractor shall have one set of approved plans at the job site at all times during the construction work and record all changes which occur during construction of the highway lighting system.
- Final acceptance and inspection will be undertaken only after all work has been completed.
- The Contractor shall maintain existing circuiting and operation of the lighting system during the hours of darkness.
- The Contractor shall locate existing buried utility lines in the vicinity of the excavation work prior to commencing excavation. As a minimum, an electronic magnetic device for detection of buried lines shall be utilized prior to excavation. Trenches shall be excavated with care. The Contractor shall be responsible for damages to existing utilities resulting from his negligence and shall bear cost of repairs to the utilities. Method of repair shall be determined by the State.

ELECTRICAL SYMBOLS

Symbol		Description	Remarks
Exist	New		
		Traffic Light Pole	
		Mast Arm	
		Traffic Signal Head-Red, Yellow, Green Arrow	
		Traffic Signal Head-Red, Yellow, Green Left Turn Arrow	
		Push Button	
		Traffic Light Pole, Type I	
		Traffic Signal Head-Red, Yellow, Green, Green Left Turn Arrow	
		Pedestrian Signal	
		Pullbox (Type As Indicated)	
		Pedestrian Push Button (Arrow Denotes Direction Of Crossing)	
		Pedestrian Signal	
		Underground Traffic Signal Ductlines And Cables	
		Underground Street Light Ductlines	
		Underground Fiber Optic Ductlines And Cable	
		Removal/Demolition	
		Detail Indicator Top Half: Detail Number Bottom Half: Sheet On Which Shown	
		Note Indicator, Note #1 Indicated	
		Indicates Duct Section Type.	
		Street Light Pullbox	
		Traffic Signal Pullbox	



THIS WORK WAS PREPARED BY ME OR UNDER MY SUPERVISION AND CONSTRUCTION OF THIS PROJECT WILL BE UNDER MY OBSERVATION.  
Jenny K. Nishimura  
PROJECT ENGINEER for ECS, Inc.  
APRIL 30, 2006  
EXPIRATION DATE OF THE LICENSE

STATE OF HAWAII  
DEPARTMENT OF TRANSPORTATION  
HIGHWAYS DIVISION  
ELECTRICAL NOTES AND  
SYMBOL LIST

KAMEHAMEHA HIGHWAY BIKEWAY  
Vicinity of Radford Drive to Arizona Memorial  
Federal Aid Project No. CMAQ-099-1(22)  
Scale: As Shown Date: June 2005  
SHEET No. 1 OF 5 SHEETS




FED. ROAD DIST. NO.	STATE	FED. AID PROJ. NO.	FISCAL YEAR	SHEET NO.	TOTAL SHEETS
HAWAII	HAW.	CMAQ-099-1(22)	2005	C.O. 51 S-2	60


# NOTES:

- Sawcut and trench to install new conduits. Restore to match existing.  
1-2"C with 1-26/C #14  
1-2"C spare
- Sawcut and trench to install new conduits. Restore to match existing.  
1-2"C with 1-26/C #14  
1-2"C with 1-2/C #14
- Sawcut and trench to install new conduits. Restore to match existing.  
1-2"C with 1-4/C #14
- Sawcut and trench to install new conduits. Restore to match existing.  
1-2"C with 3-4/C #14 and 1-2/C #14
- Remove existing TSPB and replace with new TSPB flush with finished grade. Maintain existing circuiting and ductlines unless otherwise noted.
- Remove existing pedestrian push button and replace with new push button. Reconnect push button circuit to new push button. Plug any holes in existing pole. See C.O. 52 1  
S-3
- Provide new concrete foundation and relocate existing traffic signal standard. Intercept existing circuits in TSPB and extend to traffic signal heads, pedestrian signal heads and push button. Demolish existing concrete foundation and conduit to 12" below finished grade. See C.O. 51 1  
S-5
- Demolish existing traffic signal pullbox. Remove all cables, wiring and conduit.

DATE	_____
SURVEY OBTAINED BY	_____
DESIGNED BY	_____
QUANTITIES BY	_____
CHECKED BY	_____
NOTE BOOK	_____
No.	_____

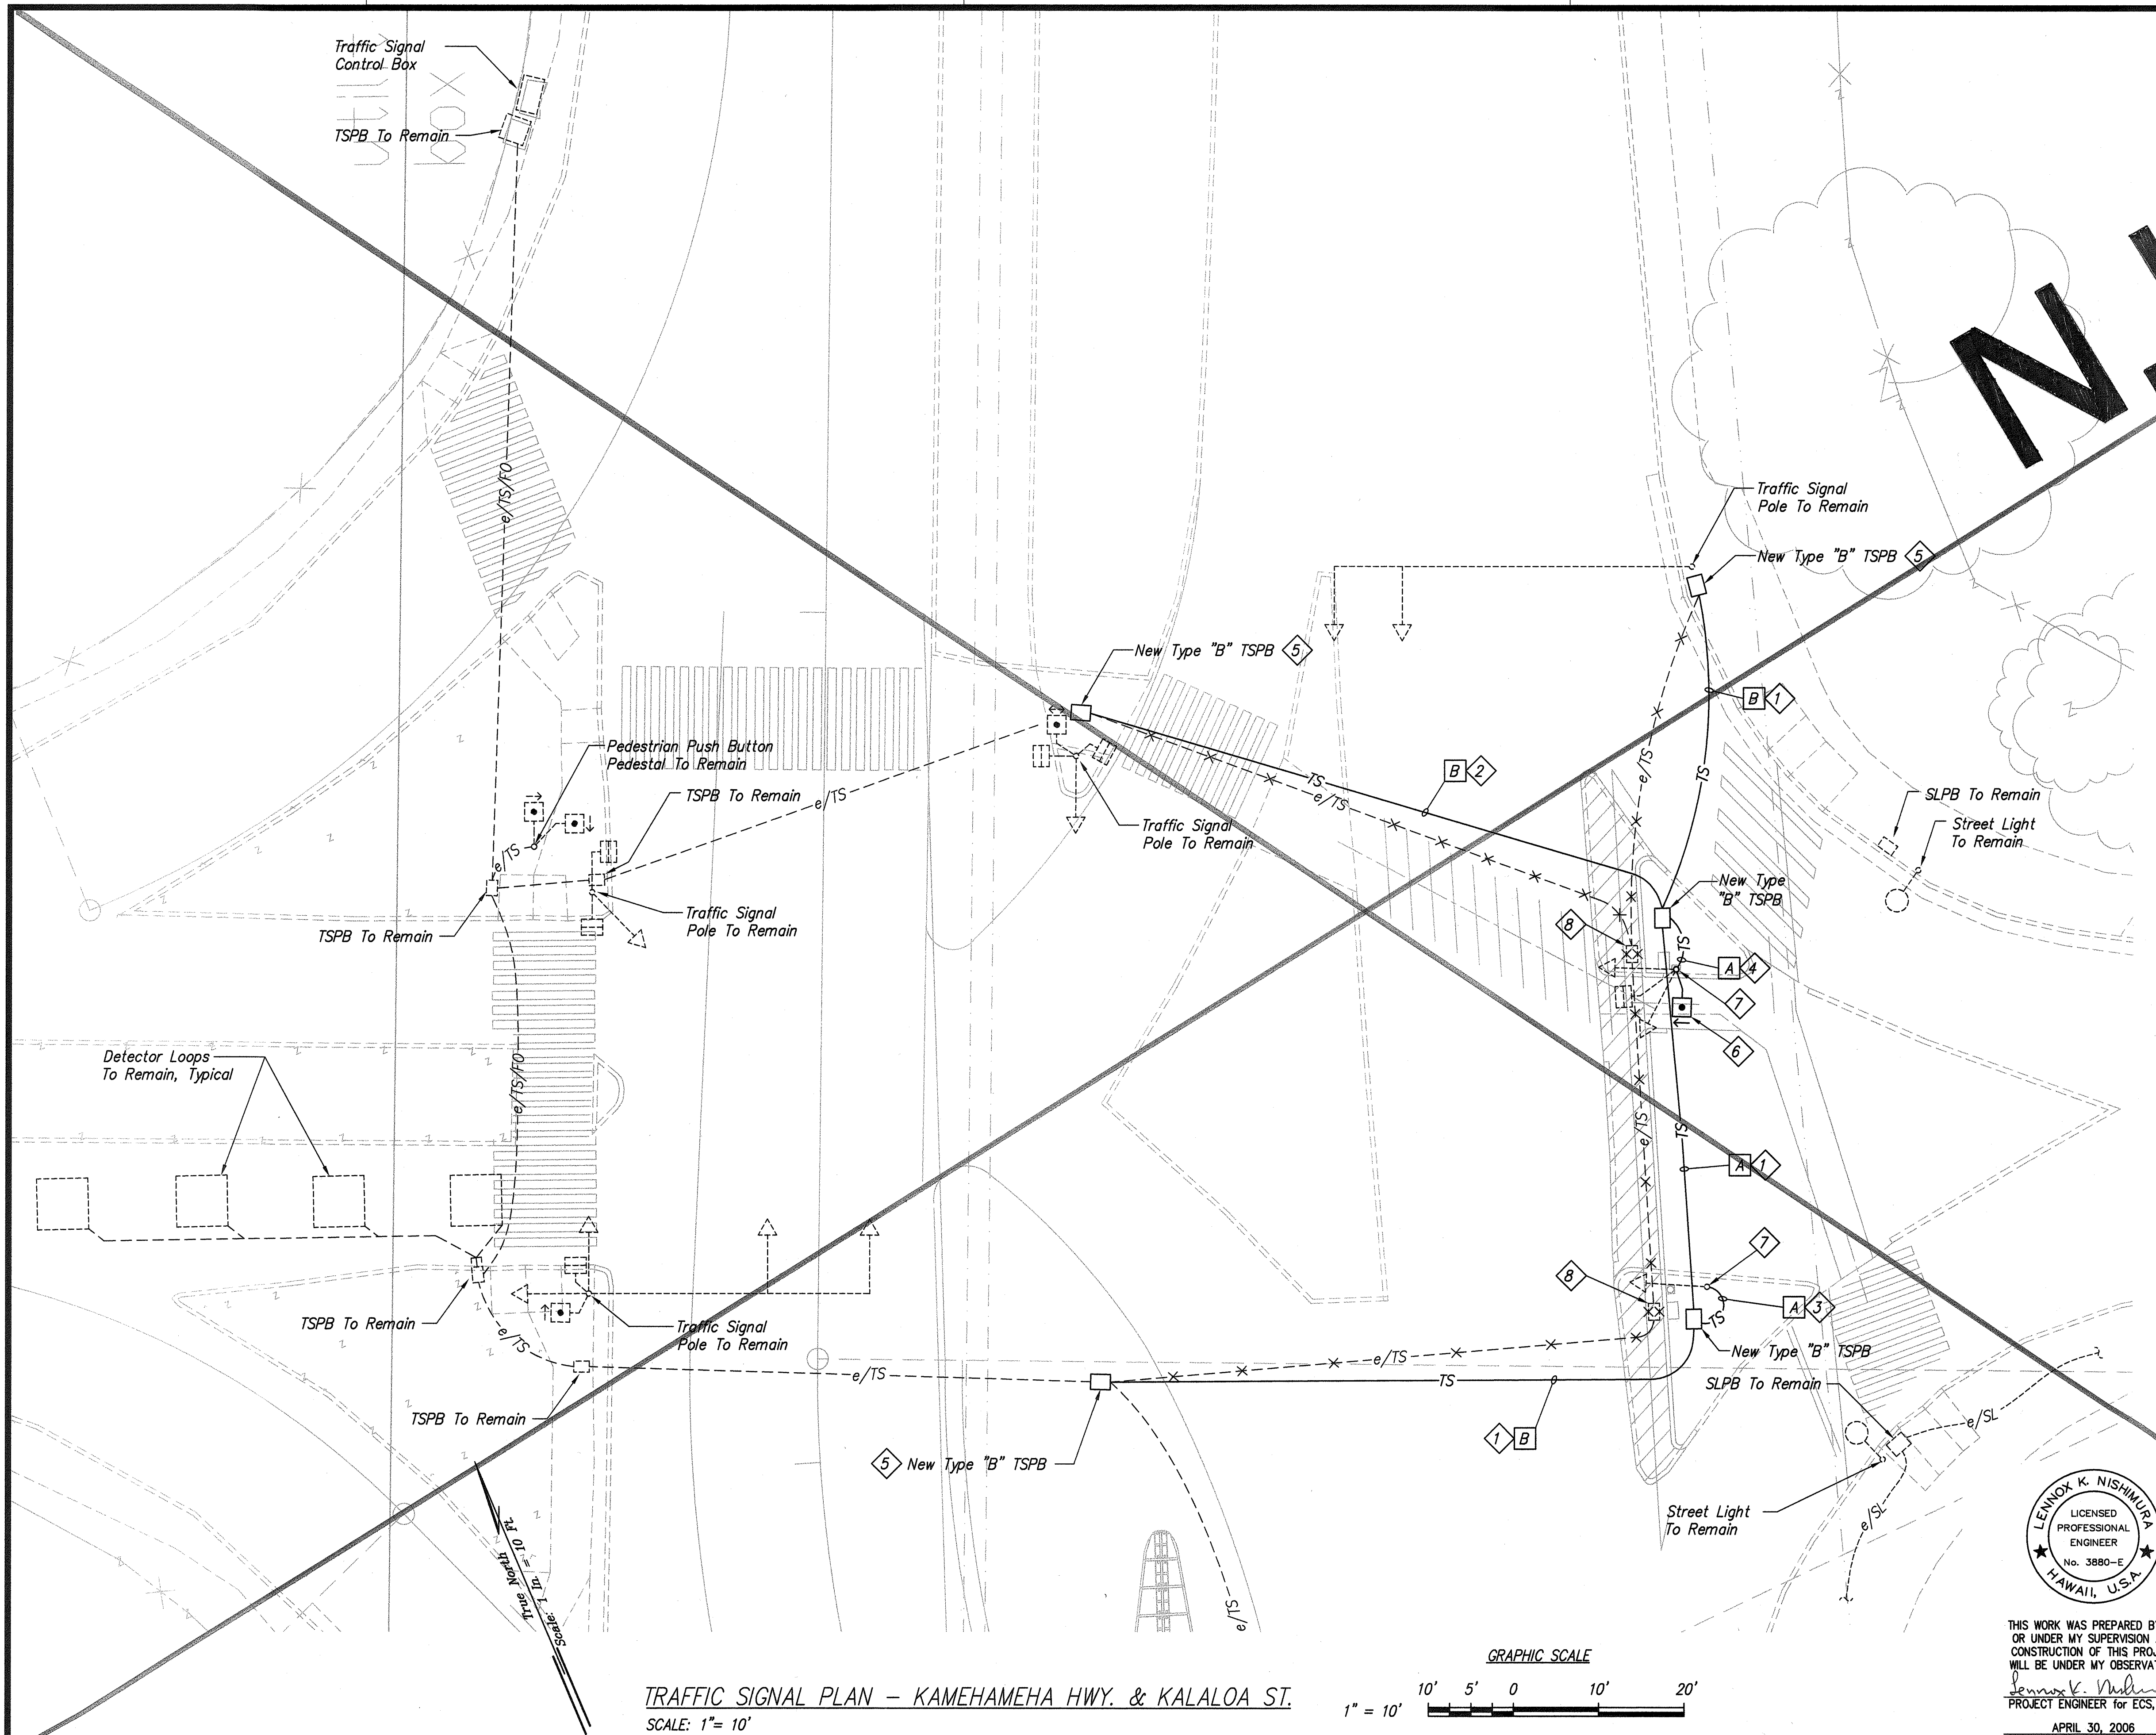

TRAFFIC SIGNAL PLAN - KAMEHAMEHA HWY. & KALALOA ST.  
SCALE: 1" = 10'

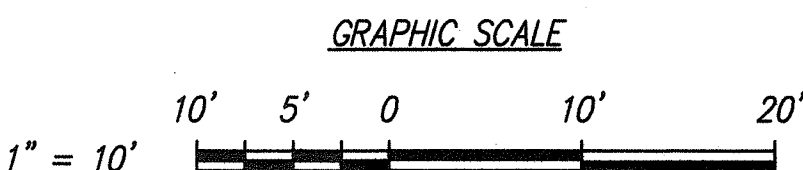

LENNOX K. NISHIMURA  
LICENSED PROFESSIONAL ENGINEER  
No. 3880-E  
HAWAII, U.S.A.

THIS WORK WAS PREPARED BY ME OR UNDER MY SUPERVISION AND CONSTRUCTION OF THIS PROJECT WILL BE UNDER MY OBSERVATION.

PROJECT ENGINEER for ECS, Inc.

APRIL 30, 2006  
EXPIRATION DATE OF THE LICENSE

STATE OF HAWAII  
DEPARTMENT OF TRANSPORTATION  
HIGHWAYS DIVISION  
TRAFFIC SIGNAL PLAN  
KAMEHAMEHA HWY. & KALALOA ST.

KAMEHAMEHA HIGHWAY BIKEWAY  
Vicinity of Radford Drive to Arizona Memorial  
Federal Aid Project No. CMAQ-099-1(22)

Scale: As Shown Date: June 2005

SHEET No. 2 OF 5 SHEETS

"AS-BUILT"


C.O. 51 S-2



FED. ROAD DIST. NO.	STATE	FED. AID PROJ. NO.	FISCAL YEAR	SHEET NO.	TOTAL SHEETS
HAWAII	HAW.	CMAQ-099-1(22)	2005	C.O. 51 S-3	60


NOTES:

- Adjust existing pullbox frame and cover to be flush with new sidewalk. See C.O. 52
- Sawcut and trench to install new conduits. Restore to match existing. 1-2"C with 3-4/C #14 and 1-2/C #14
- Sawcut and trench to install new conduits. Restore to match existing. 1-2"C with 4-4/C #14 and 1-2/C #14
- Remove existing pedestrian push button and replace with new push button. Reconnect push button circuit to new push button. Plug any holes in existing pole. See C.O. 52
- Provide new concrete foundation and relocate existing traffic signal standard. Intercept existing circuits in TSPB and extend to traffic signal heads, pedestrian signal heads and push button.
- Provide new detector loops. Abandon existing detector loops in place. See C.O. 37
- Provide microwave detector on existing traffic signal light pole. Provide new conductors in existing conduits from the microwave detector to the traffic signal control box. See C.O. 52
- Provide new pedestrian push button pedestal with pedestrian push button. Extend existing circuits and connect to pedestrian push button. See C.O. 52
- Trench to install new conduit. 1-2"C with 1-2/C#14
- Remove pedestrian push button and associated conductors. Plug any holes in existing pole.

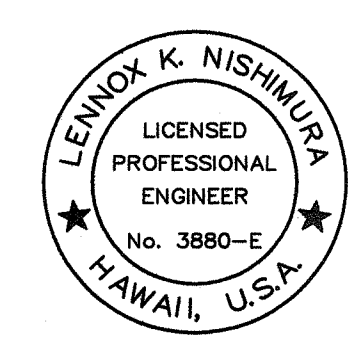


THIS WORK WAS PREPARED BY ME OR UNDER MY SUPERVISION AND CONSTRUCTION OF THIS PROJECT WILL BE UNDER MY OBSERVATION.  
Jennex V. Nishimura  
PROJECT ENGINEER for ECS, Inc.  
APRIL 30, 2005  
EXPIRATION DATE OF THE LICENSE

STATE OF HAWAII  
DEPARTMENT OF TRANSPORTATION  
HIGHWAYS DIVISION  
**TRAFFIC SIGNAL PLAN**  
**KAMEHAMEHA HWY. & HALAWA DR.**  
  
KAMEHAMEHA HIGHWAY BIKEWAY  
Vicinity of Radford Drive to Arizona Memorial  
Federal Aid Project No. CMAQ-099-1(22)  
Scale: As Shown Date: June 2005  
**SHEET No. 3 OF 5 SHEETS**

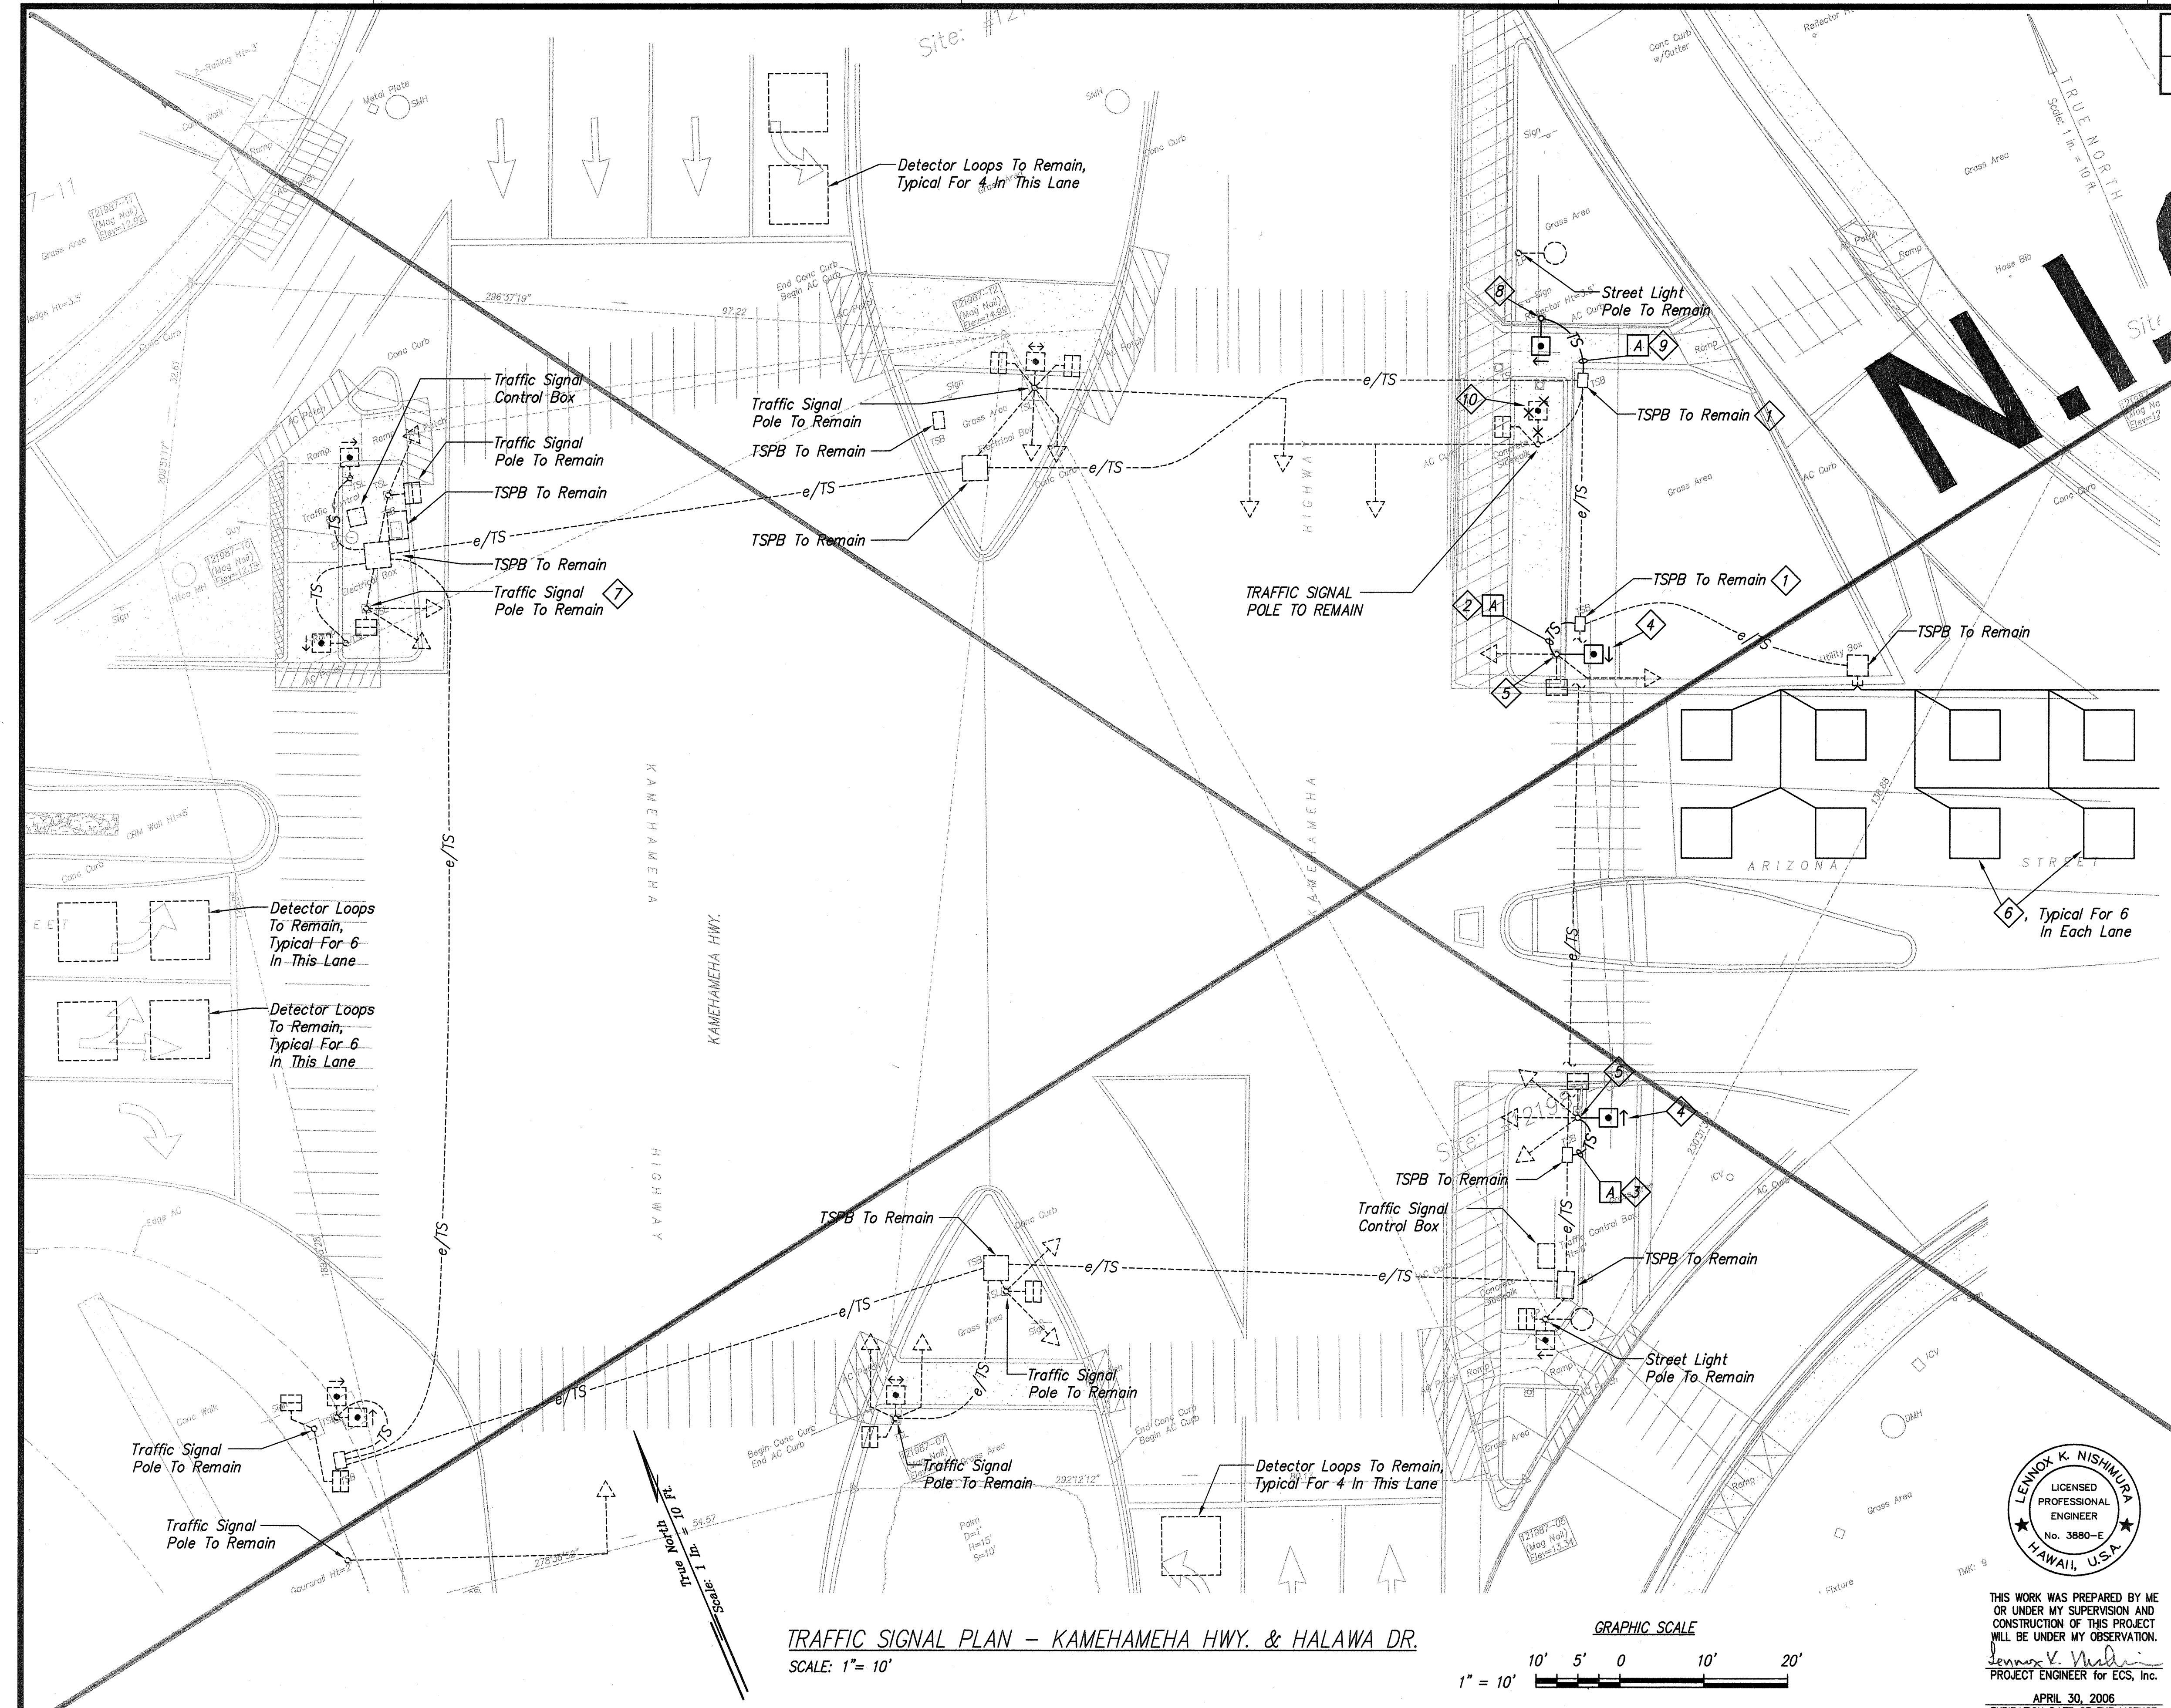

TRAFFIC SIGNAL PLAN - KAMEHAMEHA HWY. & HALAWA DR.  
SCALE: 1" = 10'

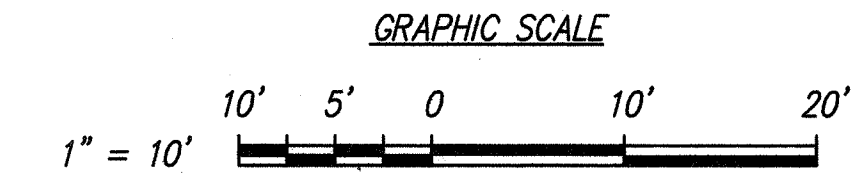

DATE	_____
SURVEY PLANNED BY	_____
DRAWN BY	_____
DESIGNED BY	_____
QUANTITIES BY	_____
CHECKED BY	_____
ORIGINAL PLAN	_____
NOTE BOOK	_____
No.	_____





FED. ROAD DIST. NO.	STATE	FED. AID PROJ. NO.	FISCAL YEAR	SHEET NO.	TOTAL SHEETS
HAWAII	HAW.	CMAQ-099-1(22)	2005	C.O. 51 S-4	60

# NOTES:

- Provide new pedestrian push button pedestal with pedestrian push button. Extend existing circuits and connect to push buttons. See C.O. 52  $\frac{2}{S-3}$
- Trench to install new conduit. 1-2" C with 1-2/C #14
- Trench to install new conduit. 1-2" C with 4-4/C #14 and 1-2/C #14.
- Remove pedestrian push buttons and associated conductors. Plug any holes in existing pole.
- Remove existing pedestrian push buttons and replace with new pushbuttons. Reconnect push button circuits to new push buttons. Plug any holes in existing pole. See C.O. 52  $\frac{1}{S-3}$
- Provide new concrete foundation and relocate existing traffic signal standard. Intercept existing circuits in TSPB and extend to traffic signal heads, pedestrian signal heads and push button.
- Provide new detector loops. Abandon existing detector loops in place. See C.O. 37  $\frac{1}{S-1}$
- Provide microwave detector on existing traffic signal light pole. Provide new conductors in existing conduits from the microwave detector to the traffic signal control box. See C.O. 52  $\frac{1}{S-4}$


## TRAFFIC SIGNAL PLAN - KAMEHAMEHA HWY. & RADFORD DR.

SCALE: 1" = 10'

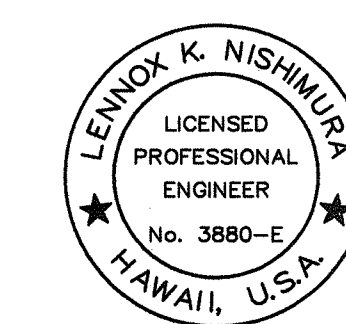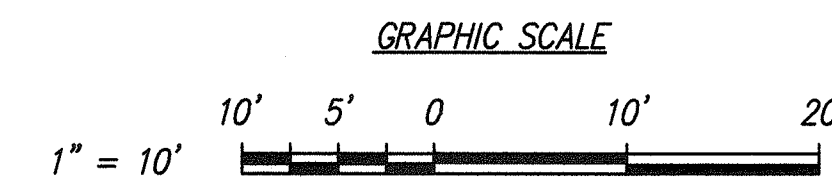

THIS WORK WAS PREPARED BY ME OR UNDER MY SUPERVISION AND CONSTRUCTION OF THIS PROJECT WILL BE UNDER MY OBSERVATION.  
**Lennox K. Nishimura**  
PROJECT ENGINEER for ECS, Inc.  
APRIL 30, 2005  
EXPIRATION DATE OF THE LICENSE

STATE OF HAWAII  
DEPARTMENT OF TRANSPORTATION  
HIGHWAYS DIVISION  
**TRAFFIC SIGNAL PLAN**  
**KAMEHAMEHA HWY. & RADFORD DR.**  
  
**KAMEHAMEHA HIGHWAY BIKEWAY**  
**Vicinity of Radford Drive to Arizona Memorial**  
**Federal Aid Project No. CMAQ-099-1(22)**  
Scale: As Shown Date: June 2005  
**SHEET No. 4 OF 5 SHEETS**

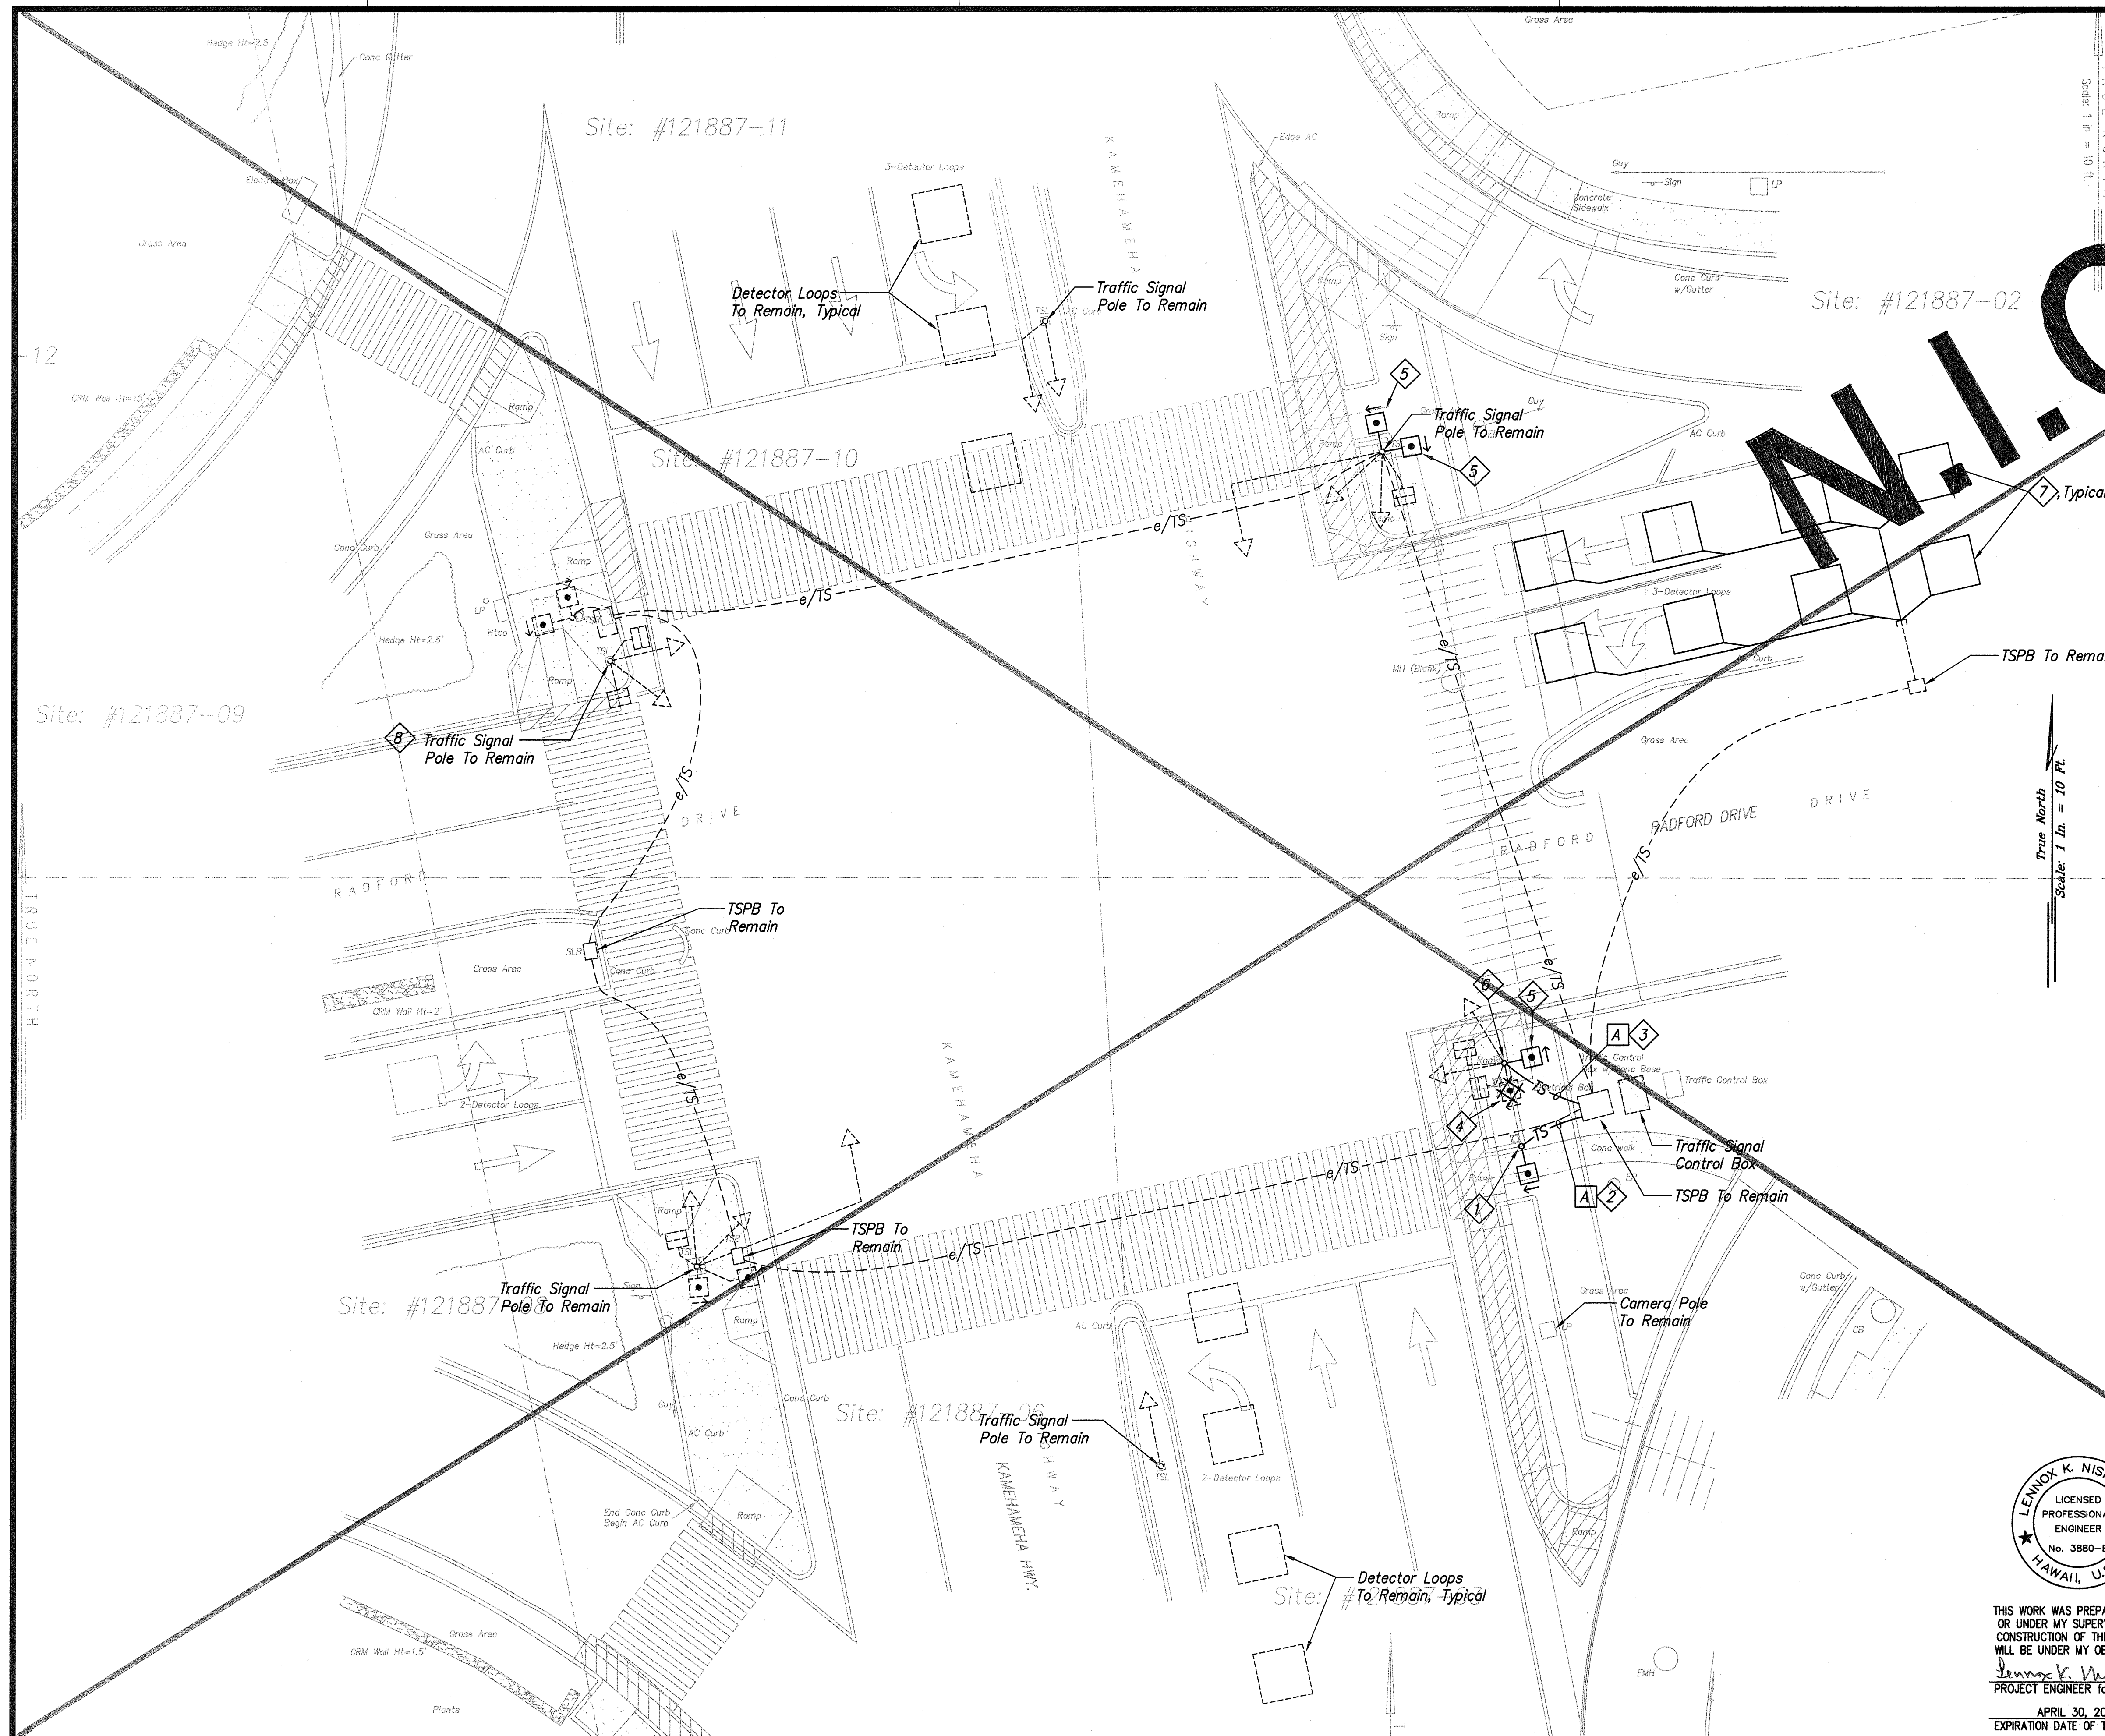


ORIGINAL PLAN	DATE
SURVEY PLOTTED BY	
DRAWN BY	
DESIGNED BY	
QUANTITIES BY	
CHECKED BY	
NOTE BOOK	
No.	




FED. ROAD DIST. NO.	STATE	FED. AID PROJ. NO.	FISCAL YEAR	SHEET NO.	TOTAL SHEETS
HAWAII	HAW.	CMAQ-099-1(22)	2005	C.O. 51 S-5	60

NOTES:


- Concrete shall be Class "B".
- Type "1" concrete base shall be used for Type 1, traffic signal standards.
- Conduit bend is incidental to concrete base.

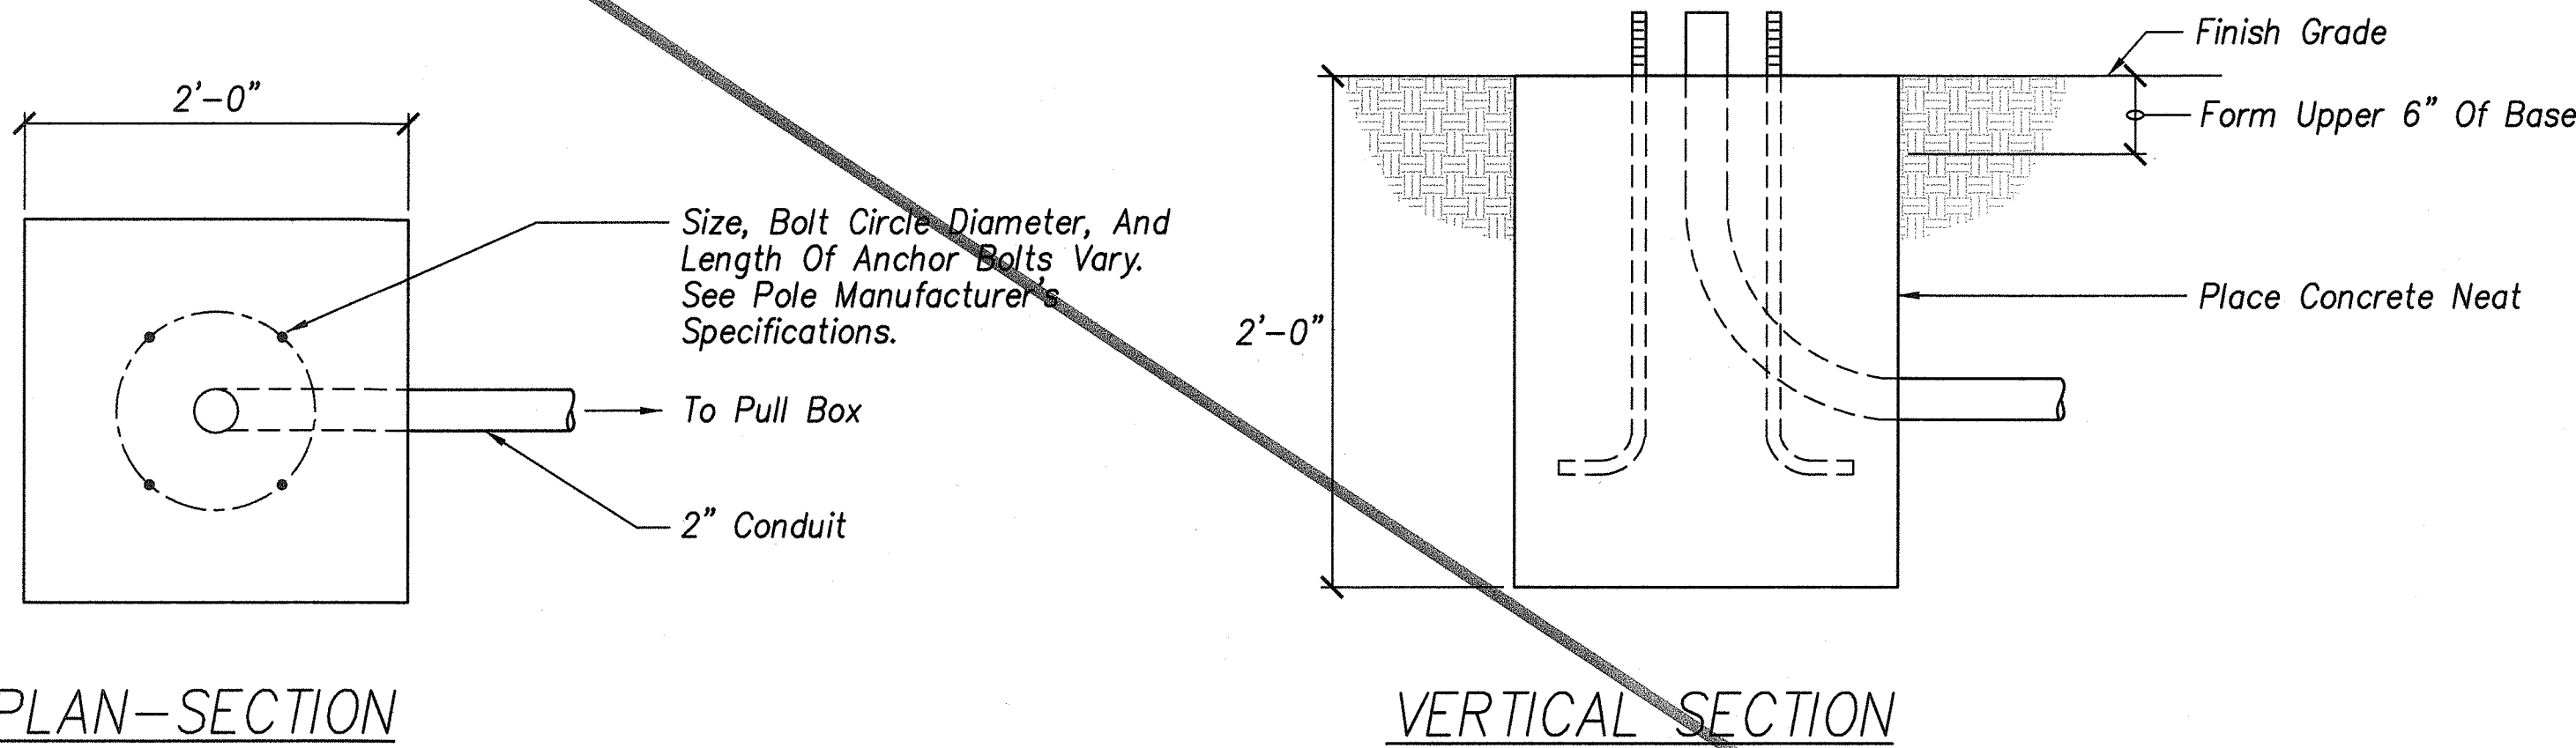


1 TYPE "A" CONCRETE BASE  
S-5 Not to Scale

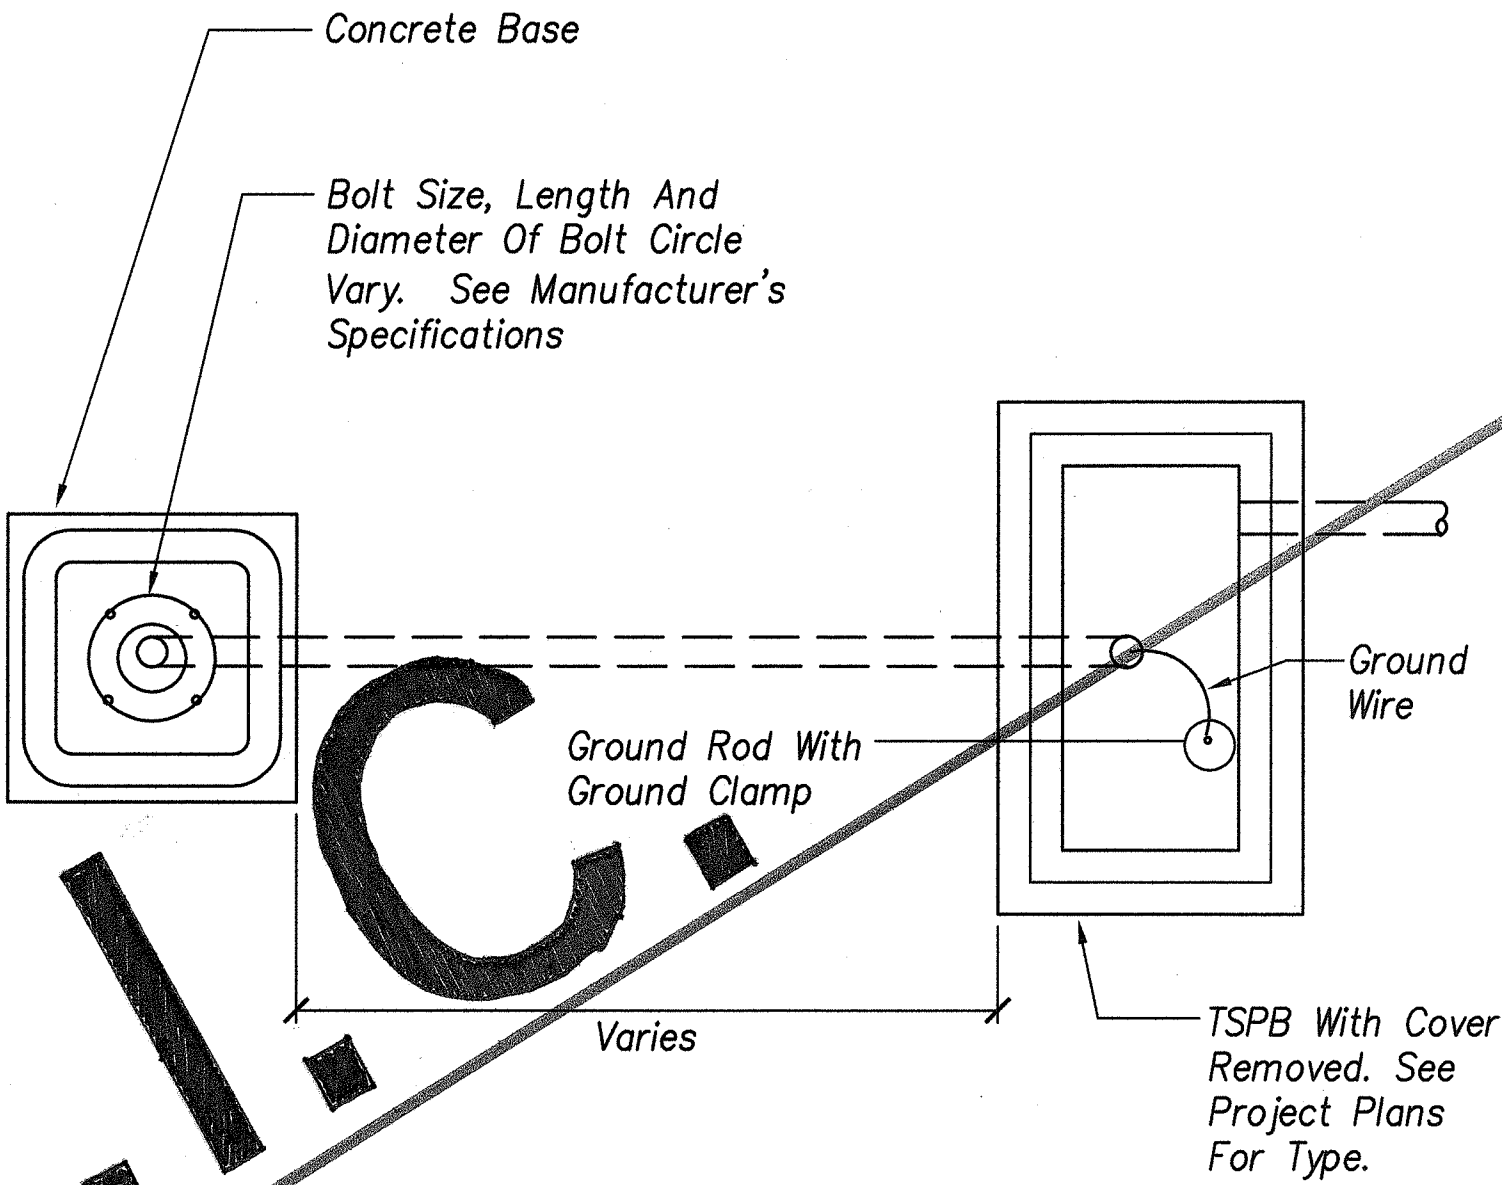

2 TYPICAL STANDARD AND PEDESTAL INSTALLATION  
S-5 Not to Scale

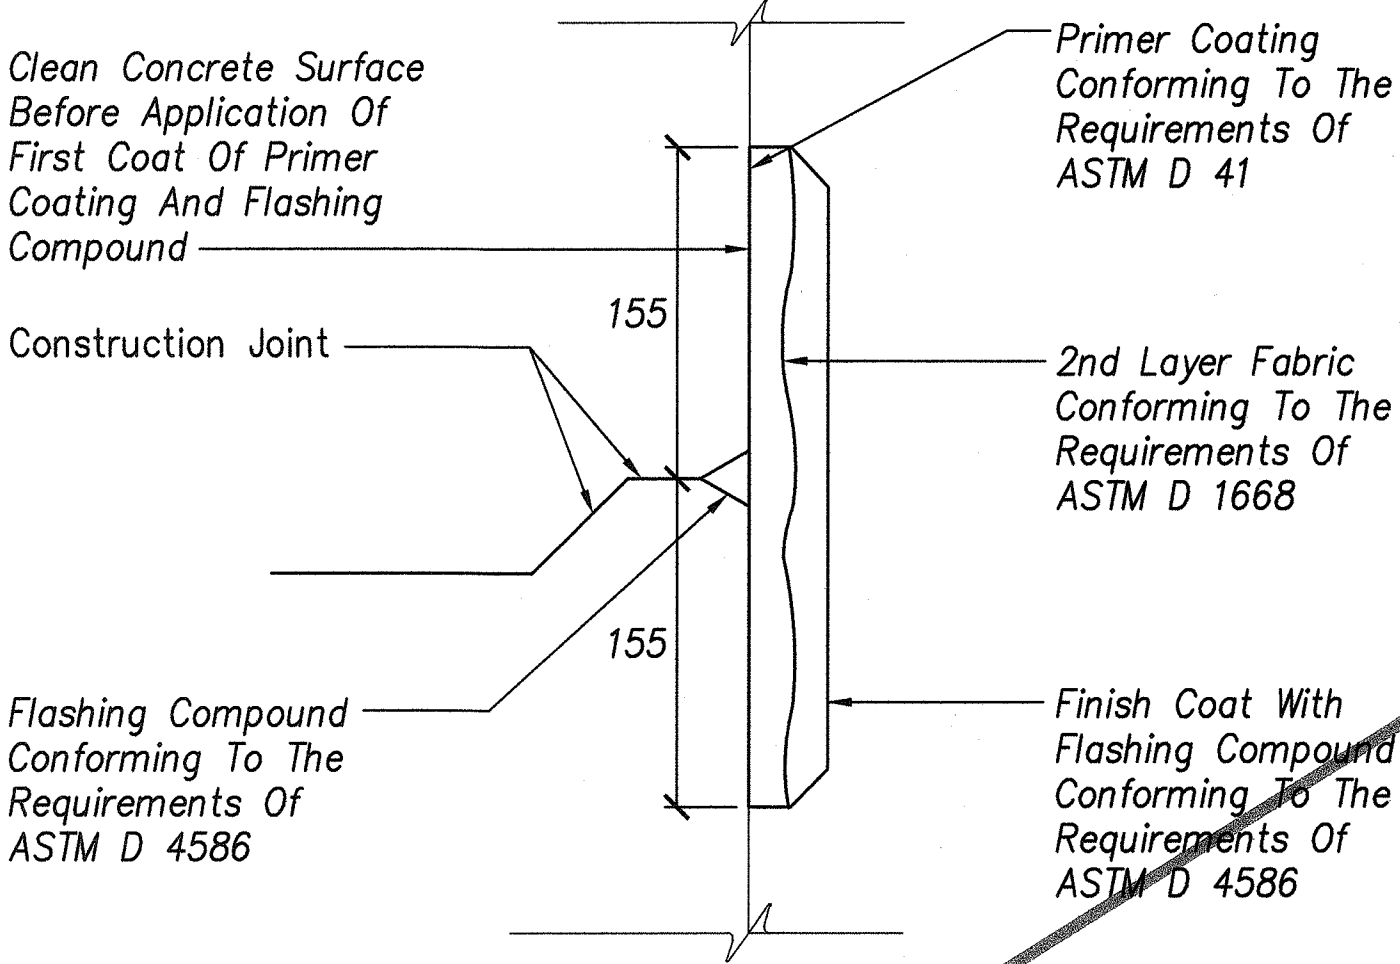

3 TYPICAL FLASHING COMPOUND WATERPROOFING DETAILS  
S-5 Not to Scale

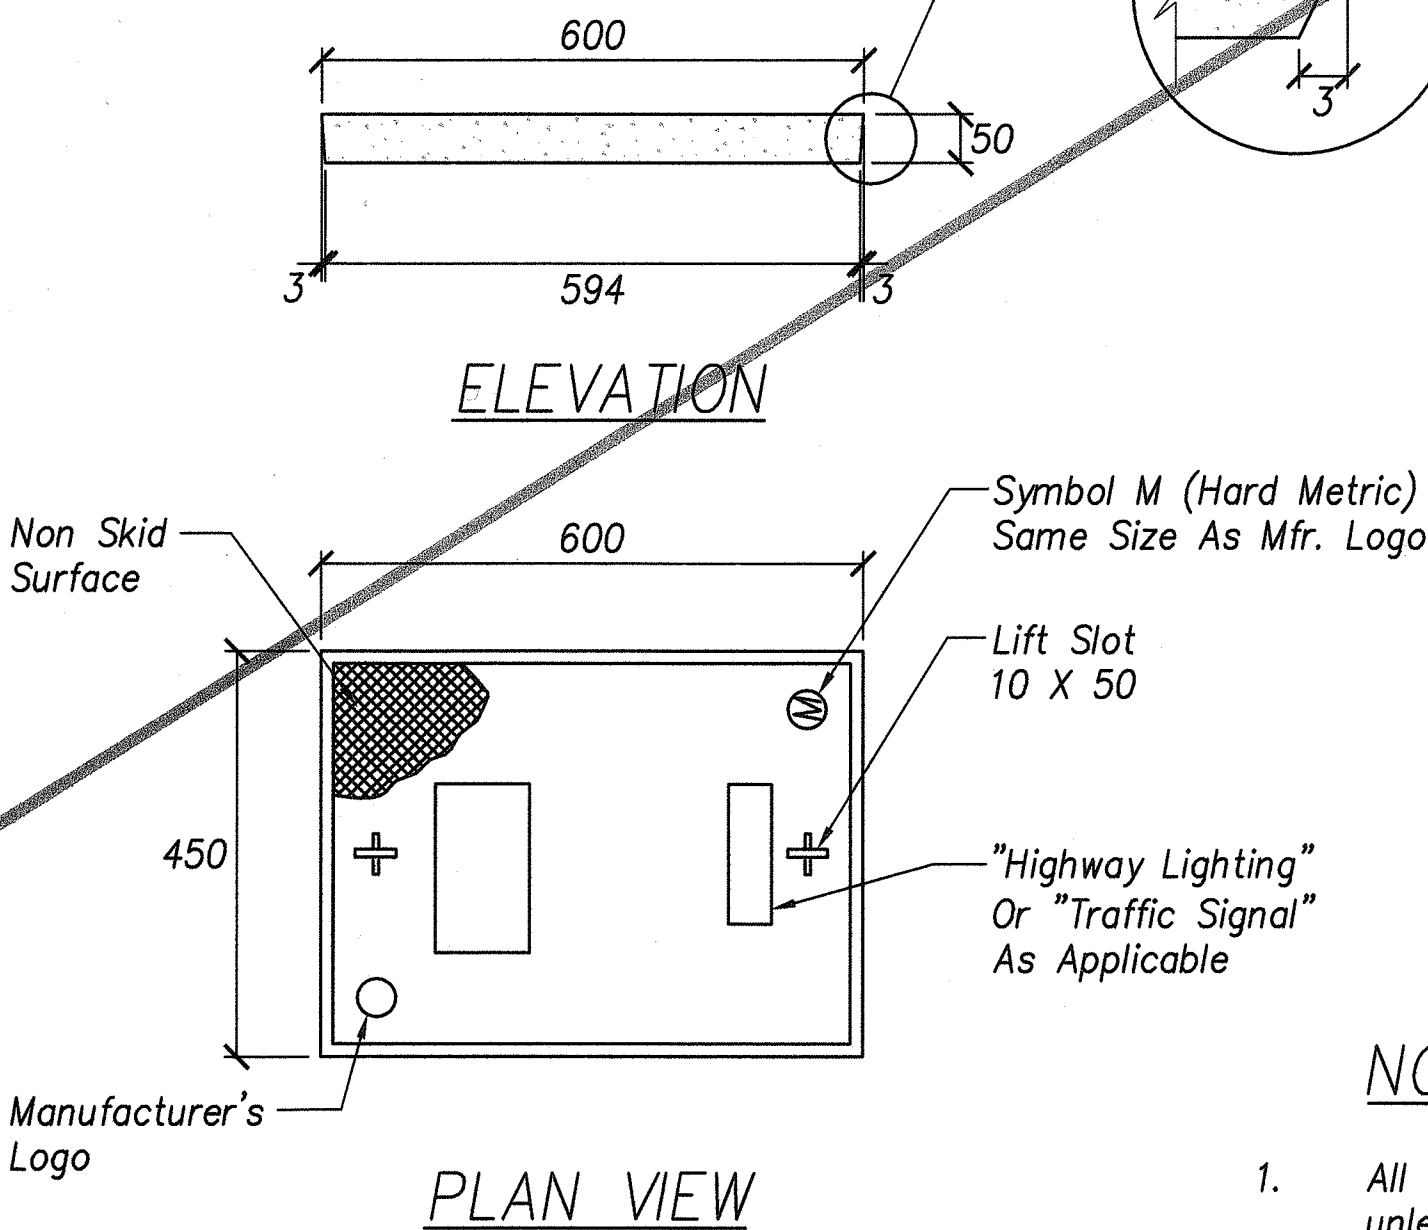


4 POLYMER CONCRETE COVER  
S-5 Not to Scale

NOTES:

- All units on this sheet are indicated in metric unless otherwise noted.
- Cover shall be labeled to identify the system for which the box is apart of.

SURVEY PLANNED BY	DATE
DRAWN BY	
TRACED BY	
DESIGNED BY	
QUANTITIES BY	
CHECKED BY	
ORIGINAL PLAN	
NOTE BOOK	
No.	

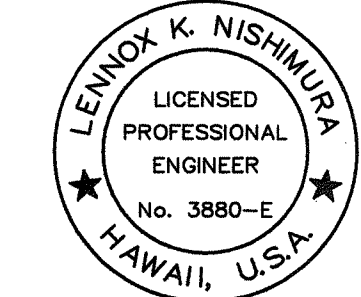

THIS WORK WAS PREPARED BY ME OR UNDER MY SUPERVISION AND CONSTRUCTION OF THIS PROJECT WILL BE UNDER MY OBSERVATION.

*Lennox K. Nishimura*  
PROJECT ENGINEER for ECS, Inc.

APRIL 30, 2006  
EXPIRATION DATE OF THE LICENSE

STATE OF HAWAII  
DEPARTMENT OF TRANSPORTATION  
HIGHWAYS DIVISION  
TRAFFIC SIGNAL  
MISCELLANEOUS DETAILS

KAMEHAMEHA HIGHWAY BIKEWAY  
Vicinity of Radford Drive to Arizona Memorial  
Federal Aid Project No. CMAQ-099-1(22)

Scale: As Shown Date: June 2005


SHEET No. 5 OF 5 SHEETS



FED. ROAD DIST. NO.	STATE	FED. AID PROJ. NO.	FISCAL YEAR	SHEET NO.	TOTAL SHEETS
HAWAII	HAW.	CMAQ-099-1(22)	2005	52	60

GENERAL NOTES

1. Provide a minimum of one 16  $\phi$  x 2.5m Copperweld Ground Rod in each pullbox. When directed by the Traffic Signal Inspector/Engineer, install additional Ground Rods. Cost of Ground Rods shall be incidental to the pullboxes.
2. All pre-cast concrete pullboxes shall be manufactured in two pieces.
3. The pullbox with cover shall be capable of supporting an MS 18 Loading.
4. The maximum weight of the pullbox cover shall not exceed 27 kilograms.
5. The openings for the conduits on all pullboxes shall be pre-cast concrete knockouts.
6. After installing the conduits in the openings of the pullboxes, the Contractor shall fill the excess opening in the pre-cast knockouts with concrete mortar.
7. Prior to installing the pullboxes, the Contractor shall level the bottom of the trench and achieve a minimum of 95% relative compaction of the bottom of the trench.
8. All concrete shall be Class A (21 MPa (3,000 psi), min.)
9. Rebars shall be Grade 300 and all lapped splices shall be 360mm minimum.
10. The #57 or #67 size aggregate shall conform to latest version of AASHTO M43 (ASTM D 448).
11. Type "C" Pullbox shall be installed in a location protected from vehicular traffic (i.e. raised sidewalk, behind A.C. curbs, traffic signal standard or pipe guards).

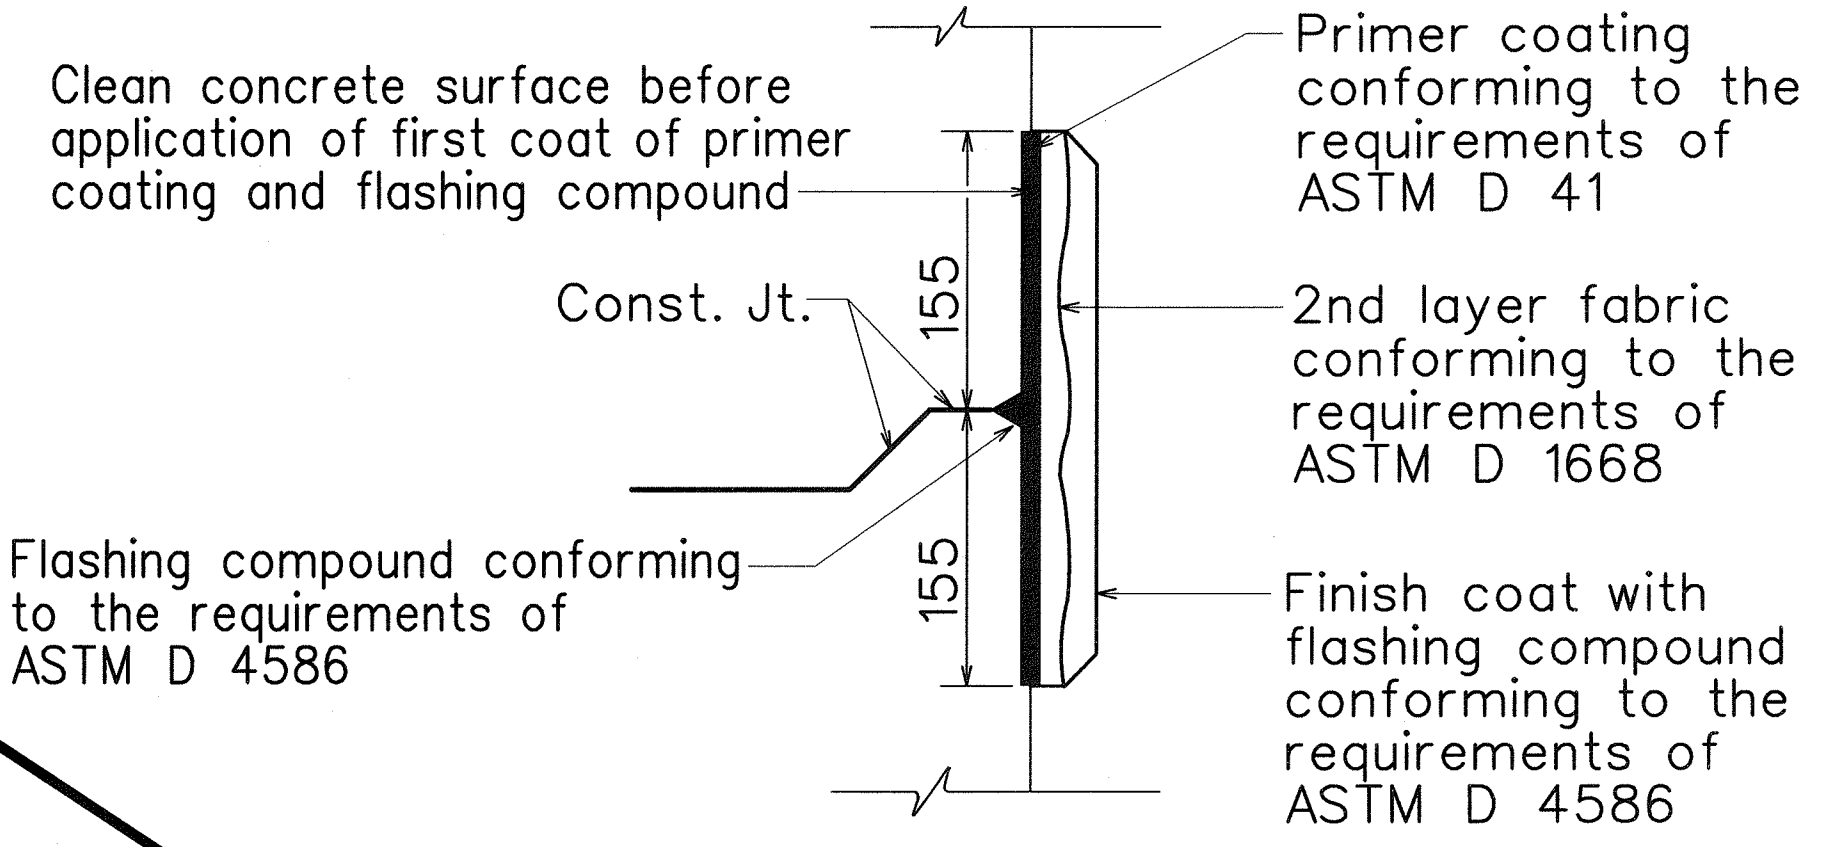

TYPICAL FLASHING COMPOUND WATERPROOFING DETAILS

ALL DIMENSIONS ARE IN MILLIMETERS UNLESS OTHERWISE SHOWN



LEGEND FOR AS-BUILT POSTINGS	
	Squiggly line for as-built deletion
	Double line for as-built deletion
Roadway	Text for as-built posting

STATE OF HAWAII  
DEPARTMENT OF TRANSPORTATION  
HIGHWAYS DIVISION

**PULLBOX & COVER DETAILS**  
*KAMEHAMEHA HIGHWAY BIKEWAY*  
*Vicinity of Radford Drive to Arizona Memorial*  
*Federal Aid Project No. CMAQ-099-1(22)*

Scale: As Shown      Date: November 2004

SHEET No. **E4** OF 4 SHEETS

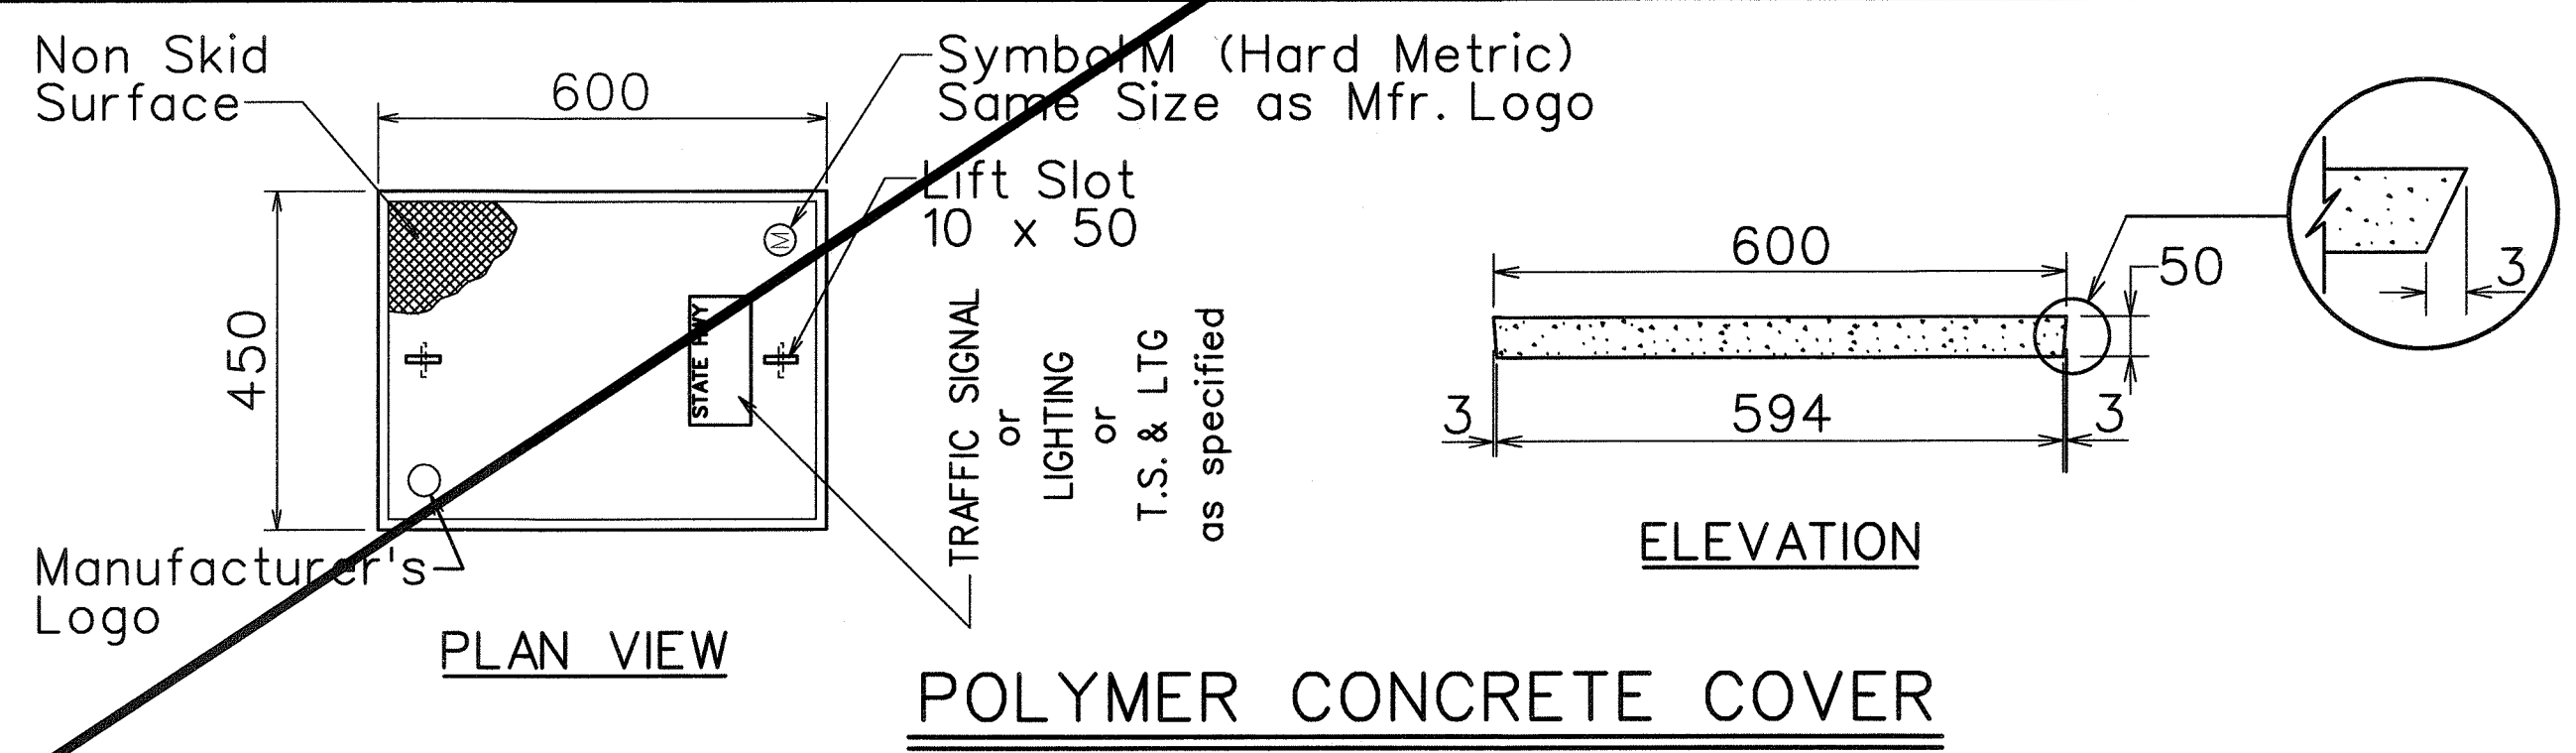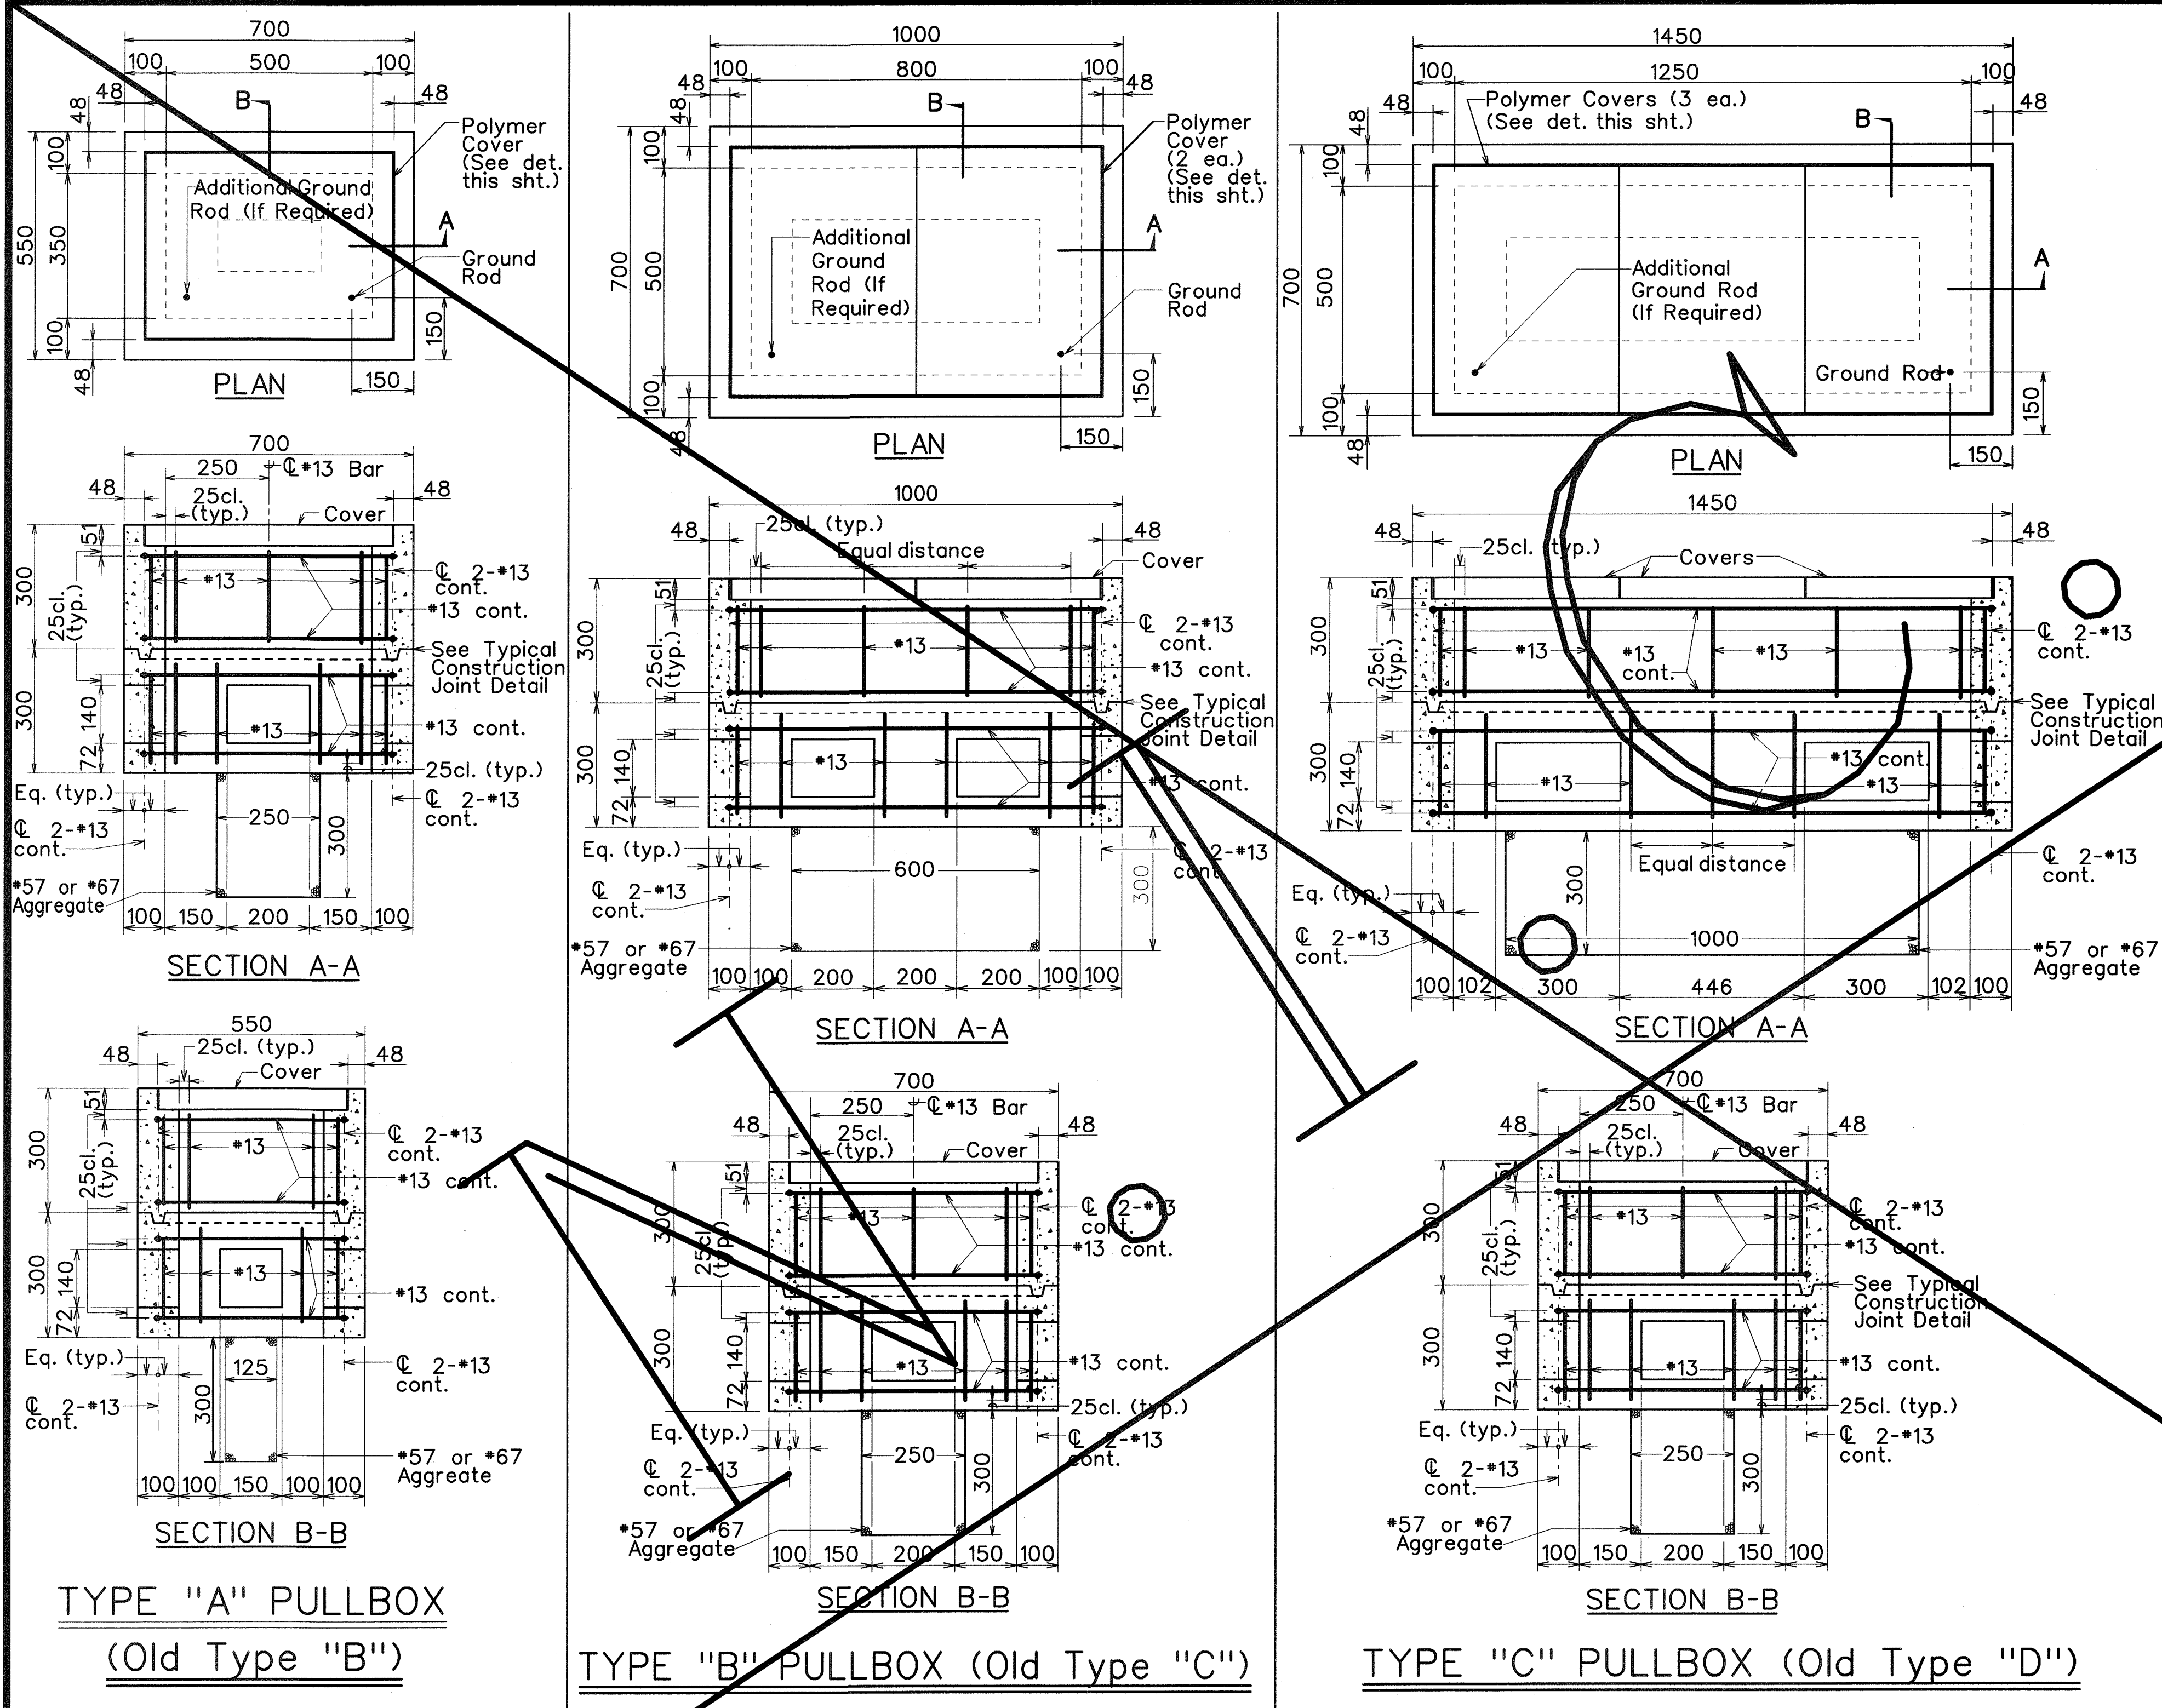




SURVEY PLOTTED BY: DATE: \_\_\_\_\_  
DESIGNED BY: \_\_\_\_\_  
CHECKED BY: \_\_\_\_\_  
NOTE BOOK: \_\_\_\_\_  
QUANTITIES BY: \_\_\_\_\_  
ORIGINAL: \_\_\_\_\_




FED. ROAD DIST. NO.	STATE	FED. AID PROJ. NO.	FISCAL YEAR	SHEET NO.	TOTAL SHEETS
HAWAII	HAW.	CMAQ-099-1(22)	2005	C.O. 52 S-1	60

# GENERAL HANDHOLE NOTES:

- Provide a minimum of one 16Ø x 3.0m copperclad ground rod in each handhole. When directed by the Traffic Signal Inspector/Engineer, install additional ground rods. Cost of ground rods shall be incidental to the handholes.
- All pre-cast concrete handholes shall be manufactured in two pieces.
- The handhole with cover shall be capable of supporting an MS 18 loading.
- The maximum weight of the handhole cover shall not exceed 27 kilograms.
- The openings for the conduits on all handholes shall be pre-cast concrete knockouts.
- After installing the conduits in the openings of the handholes, the Contractor shall fill the excess opening in the pre-cast knockouts with concrete mortar.
- Prior to installing the handholes, the Contractor shall level the bottom of the trench and achieve a minimum of 95% relative compaction of the bottom of the trench.
- All concrete shall be Class A (25MPA, min.)
- Rebars shall be grade 300 and all lapped splices shall be 360mm minimum.
- The #57 or #67 size aggregate shall conform to latest version of AASHTO M43 (ASTM D 448).

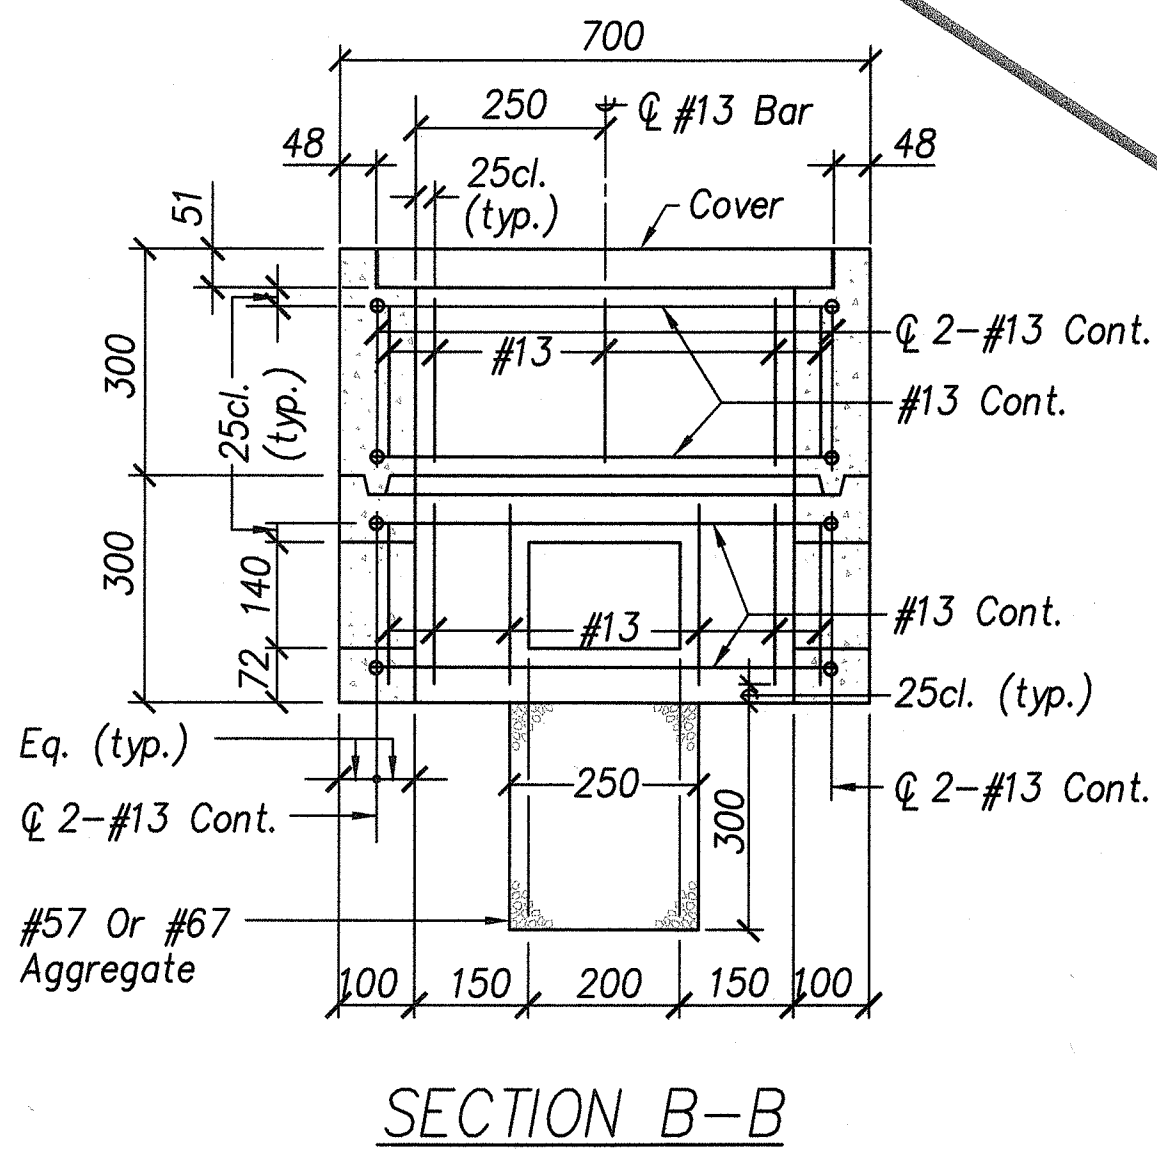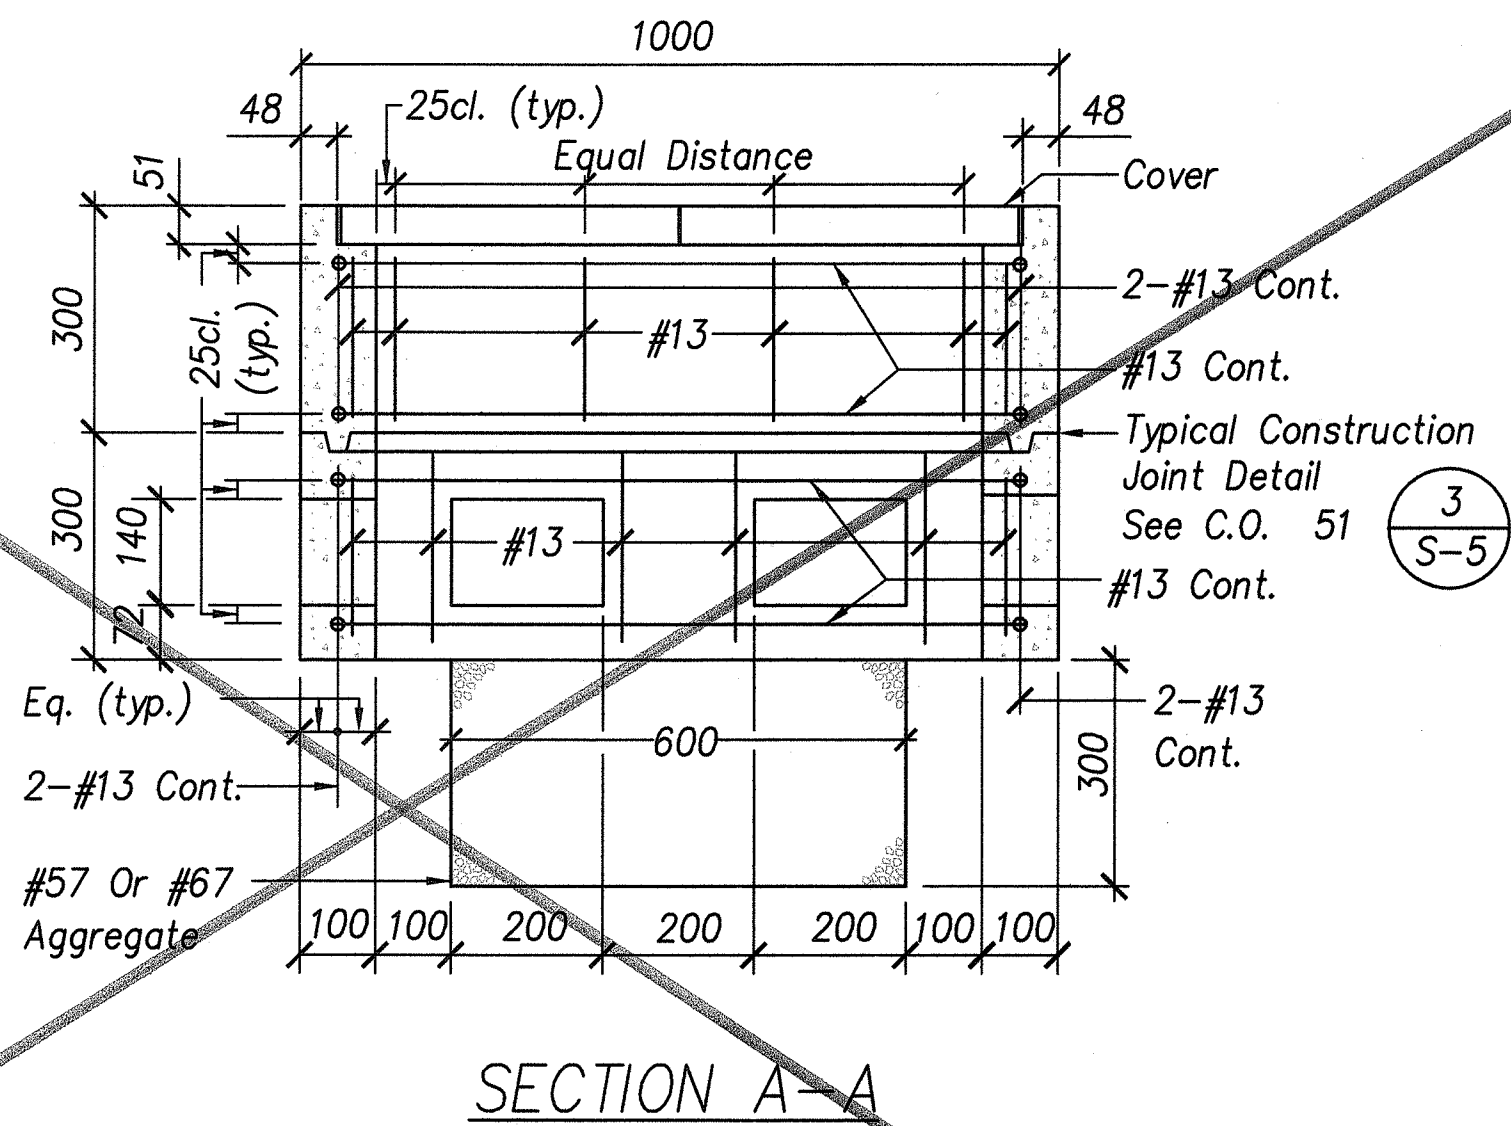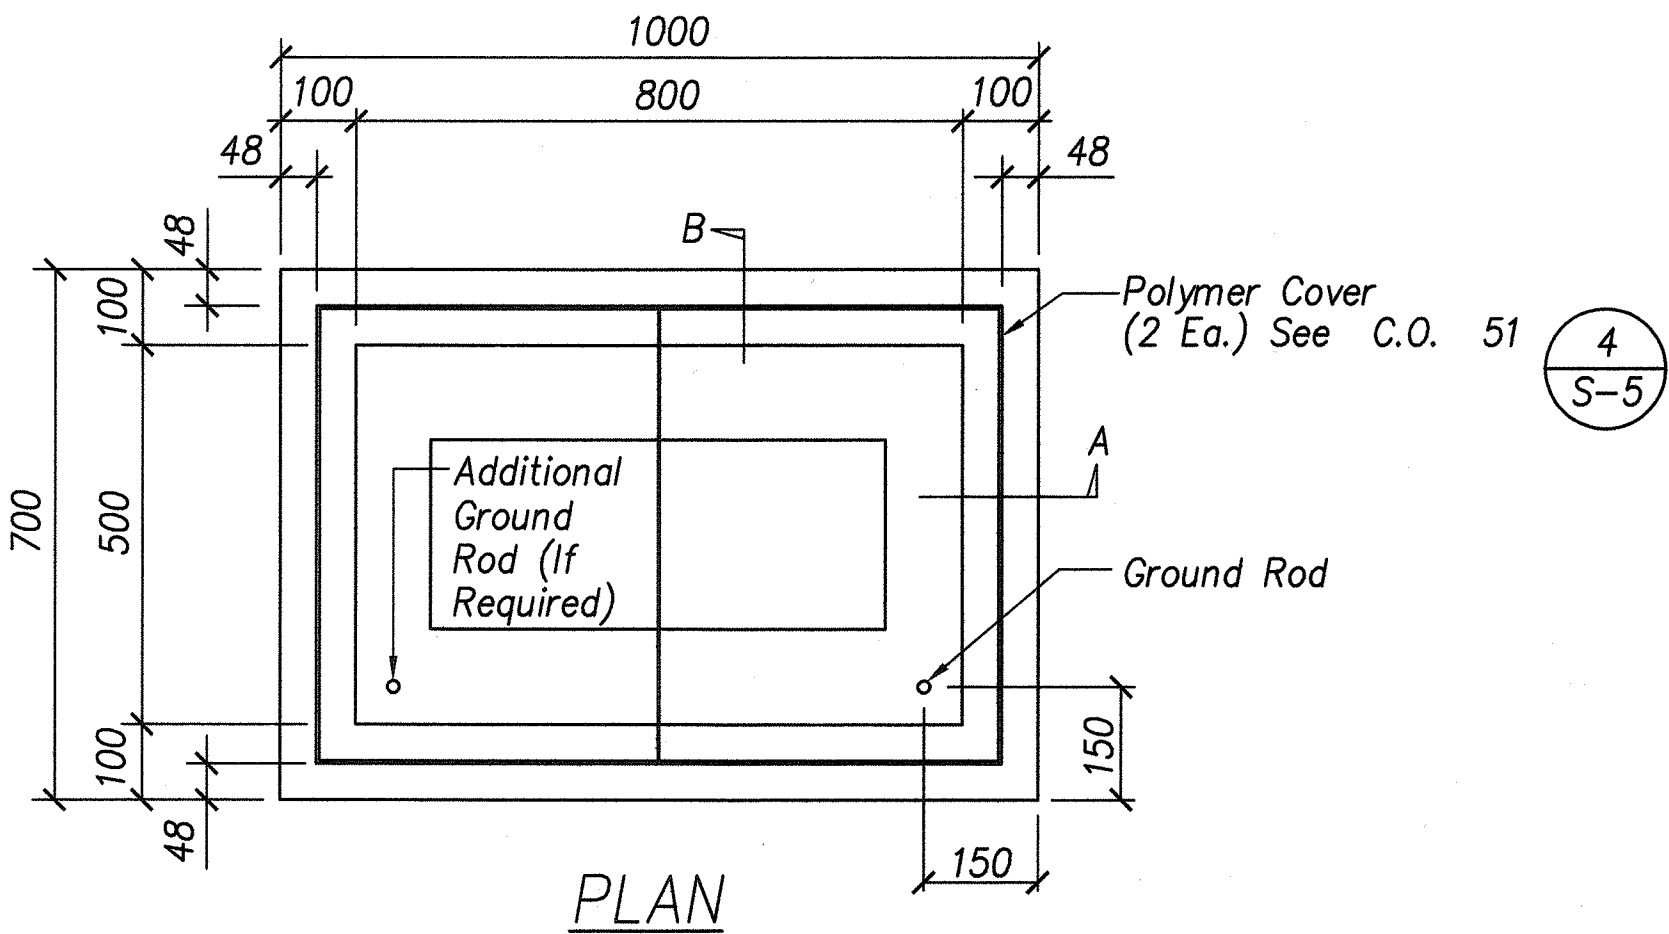

1  
S-1 TYPE "B" HANDHOLE  
Not to Scale

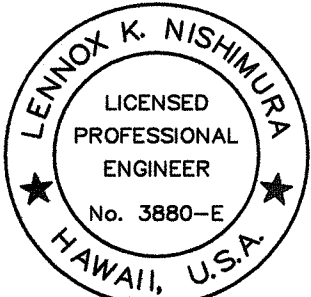

THIS WORK WAS PREPARED BY ME  
OR UNDER MY SUPERVISION AND  
CONSTRUCTION OF THIS PROJECT  
WILL BE UNDER MY OBSERVATION.  
*Lennox K. Nishimura*  
PROJECT ENGINEER for ECS, Inc.  
APRIL 30, 2006  
EXPIRATION DATE OF THE LICENSE

STATE OF HAWAII  
DEPARTMENT OF TRANSPORTATION  
HIGHWAYS DIVISION  
PULLBOX DETAILS

KAMEHAMEHA HIGHWAY BIKEWAY  
Vicinity of Radford Drive to Arizona Memorial  
Federal Aid Project No. CMAQ-099-1(22)

Scale: As Shown Date: June 2005

SHEET No. 1 OF 4 SHEETS

C.O. 52 S-1


ORIGINAL PLAN	SURVEY PLOTTED BY	DATE
NOTE BOOK	DRAWN BY	
No.	DESIGNED BY	
	CHECKED BY	








FED. ROAD DIST. NO.	STATE	FED. AID PROJ. NO.	FISCAL YEAR	SHEET NO.	TOTAL SHEETS
HAWAII	HAW.	CMAQ-099-1(22)	2005	C.O. 52 S-3	60

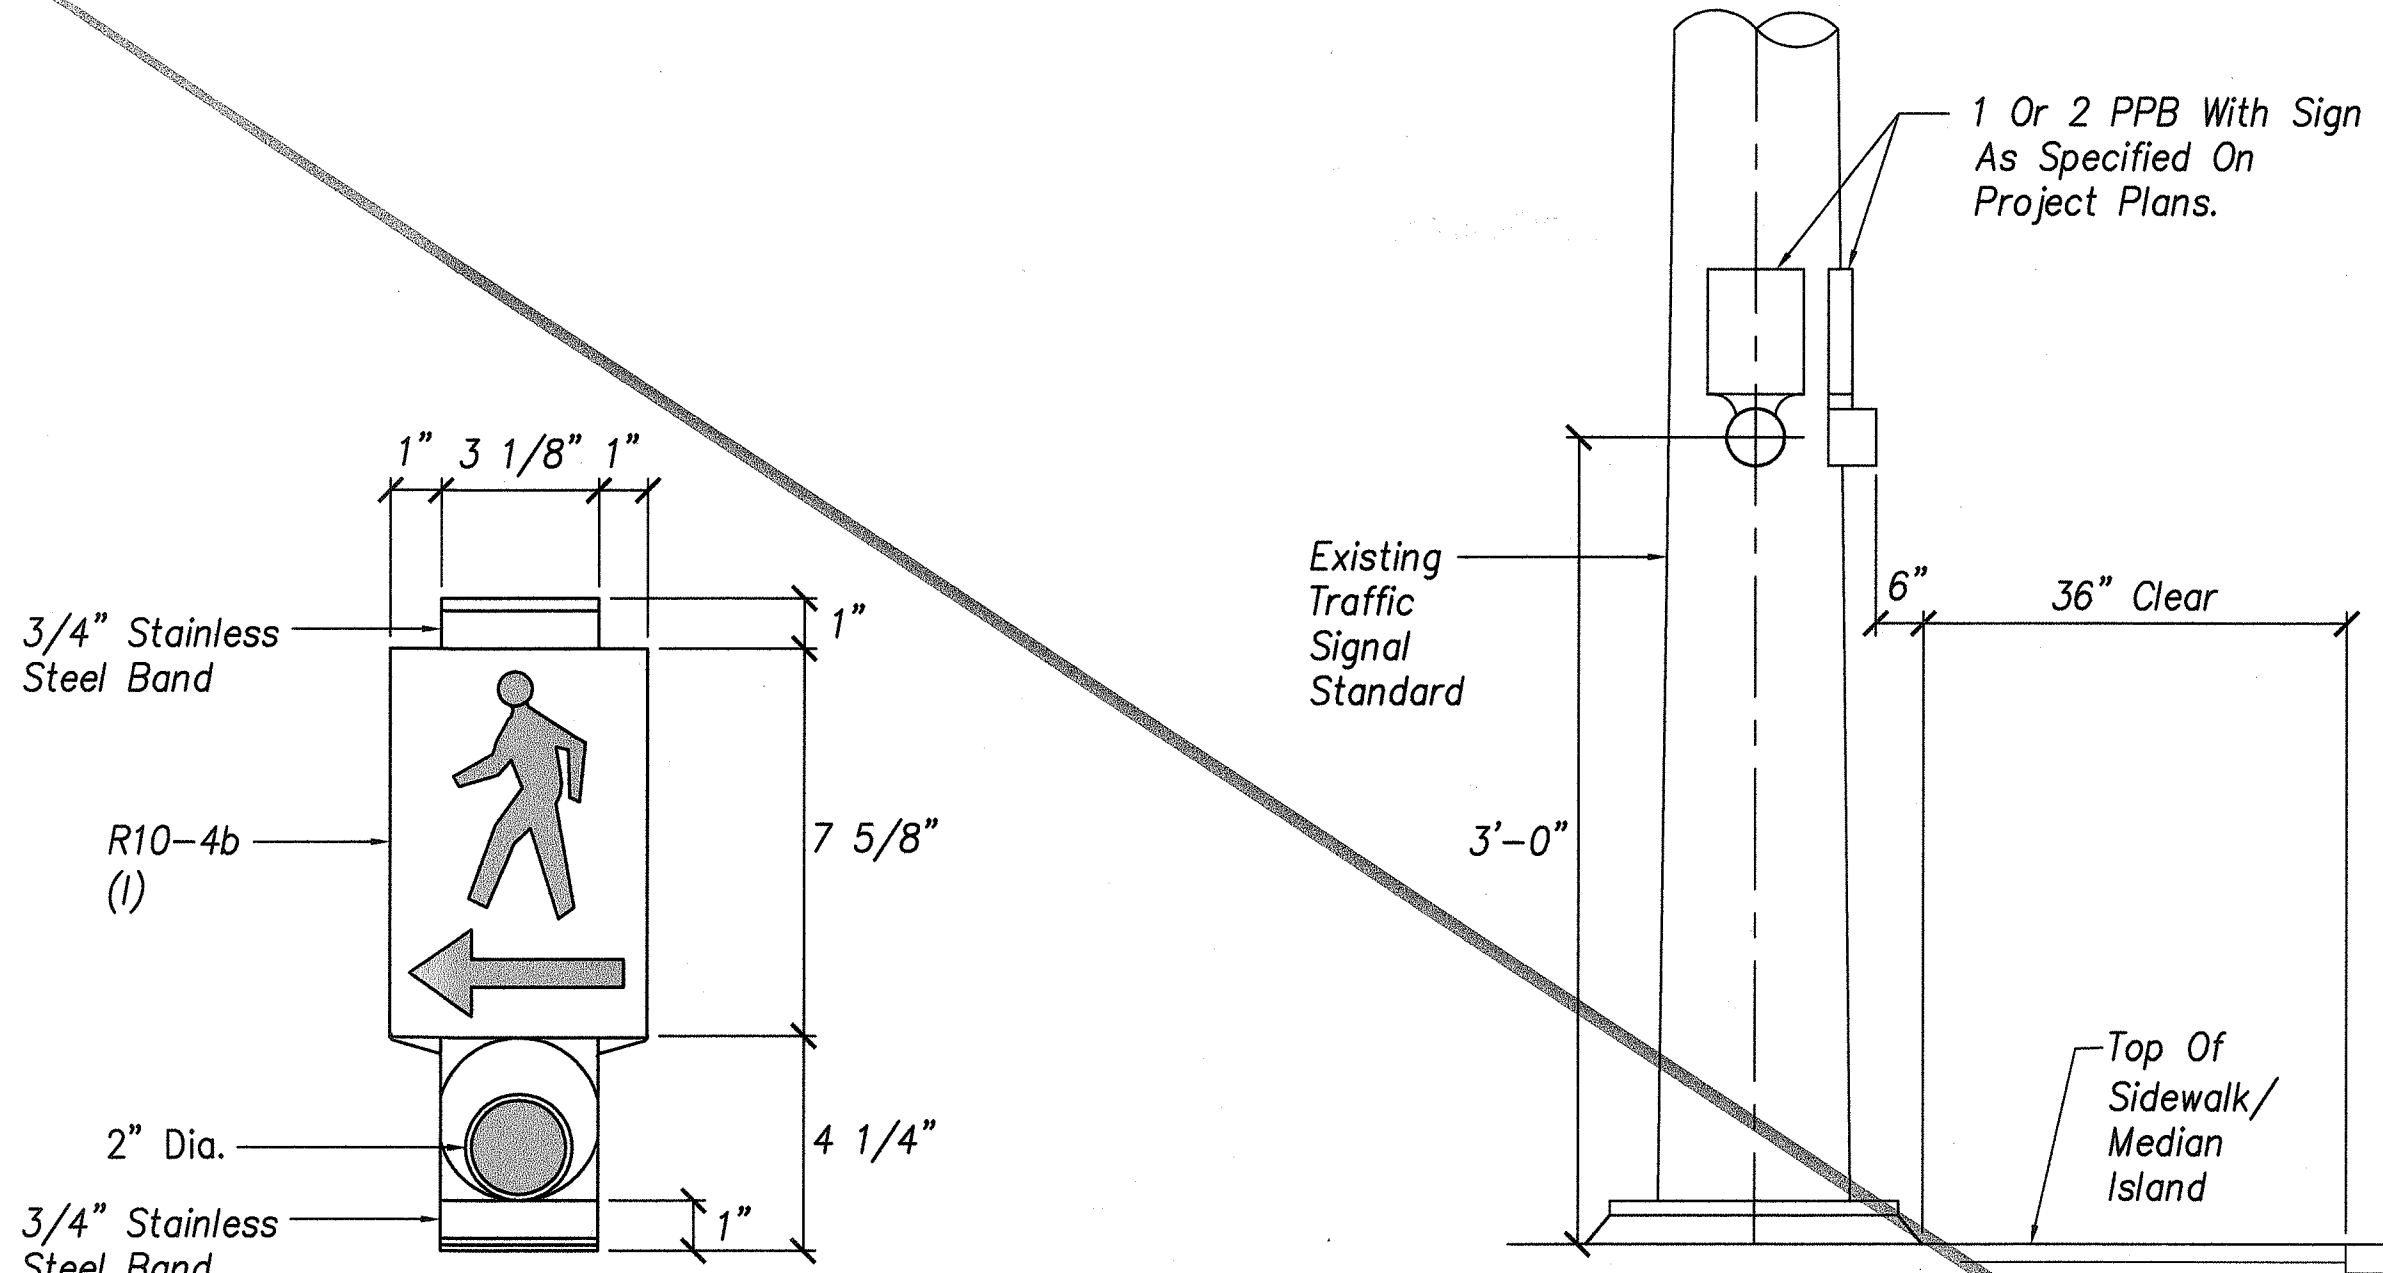


LEFT

PPB ON EXISTING TSS

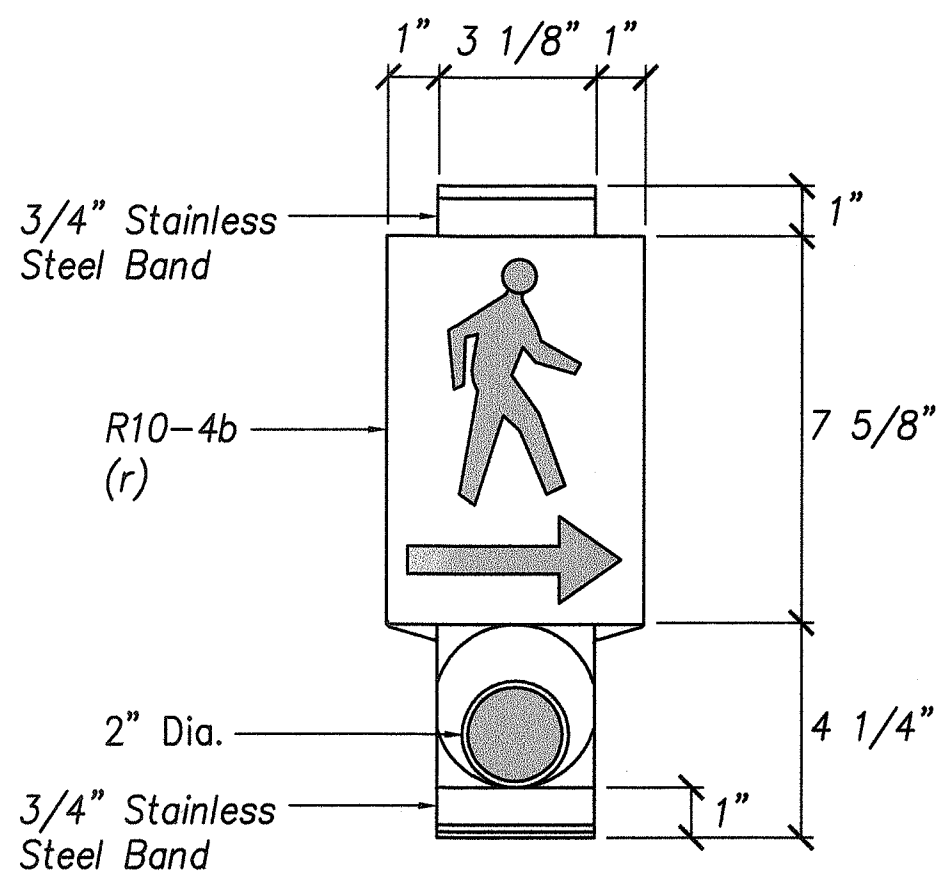

RIGHT

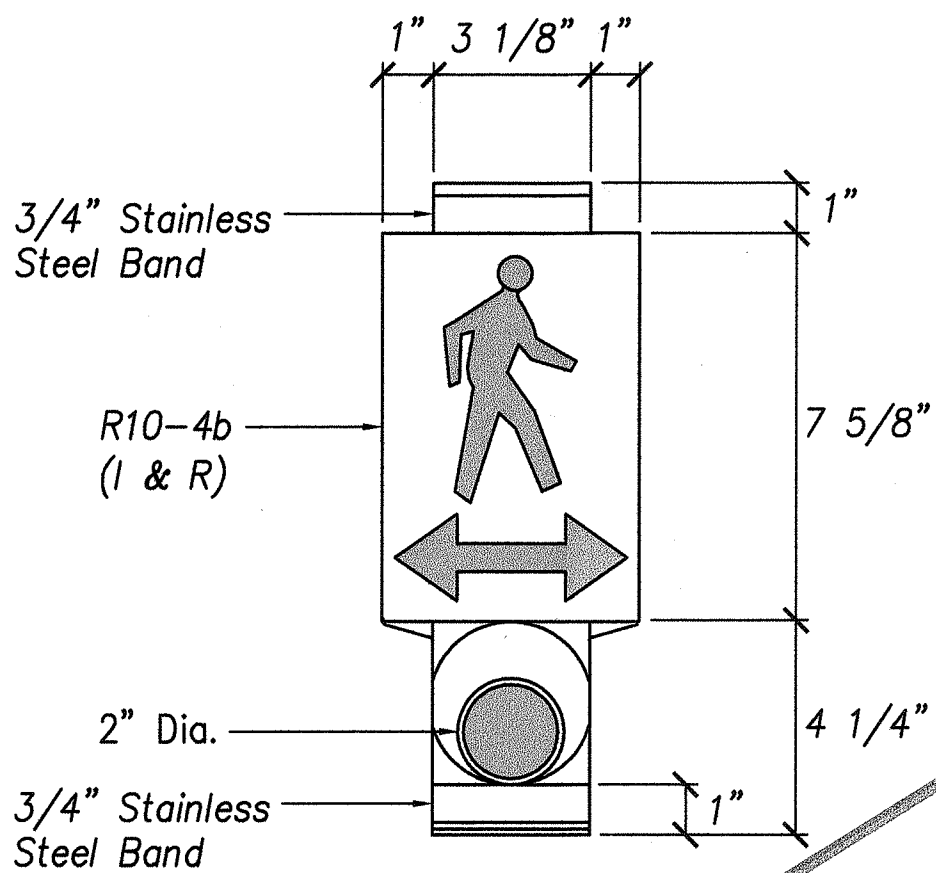


LEFT & RIGHT

NOTES:

The color scheme shall be:  
white - man, arrow and push button  
black - background

1 PEDESTRIAN PUSH BUTTON (PPB) DETAILS  
S-3 Not to Scale

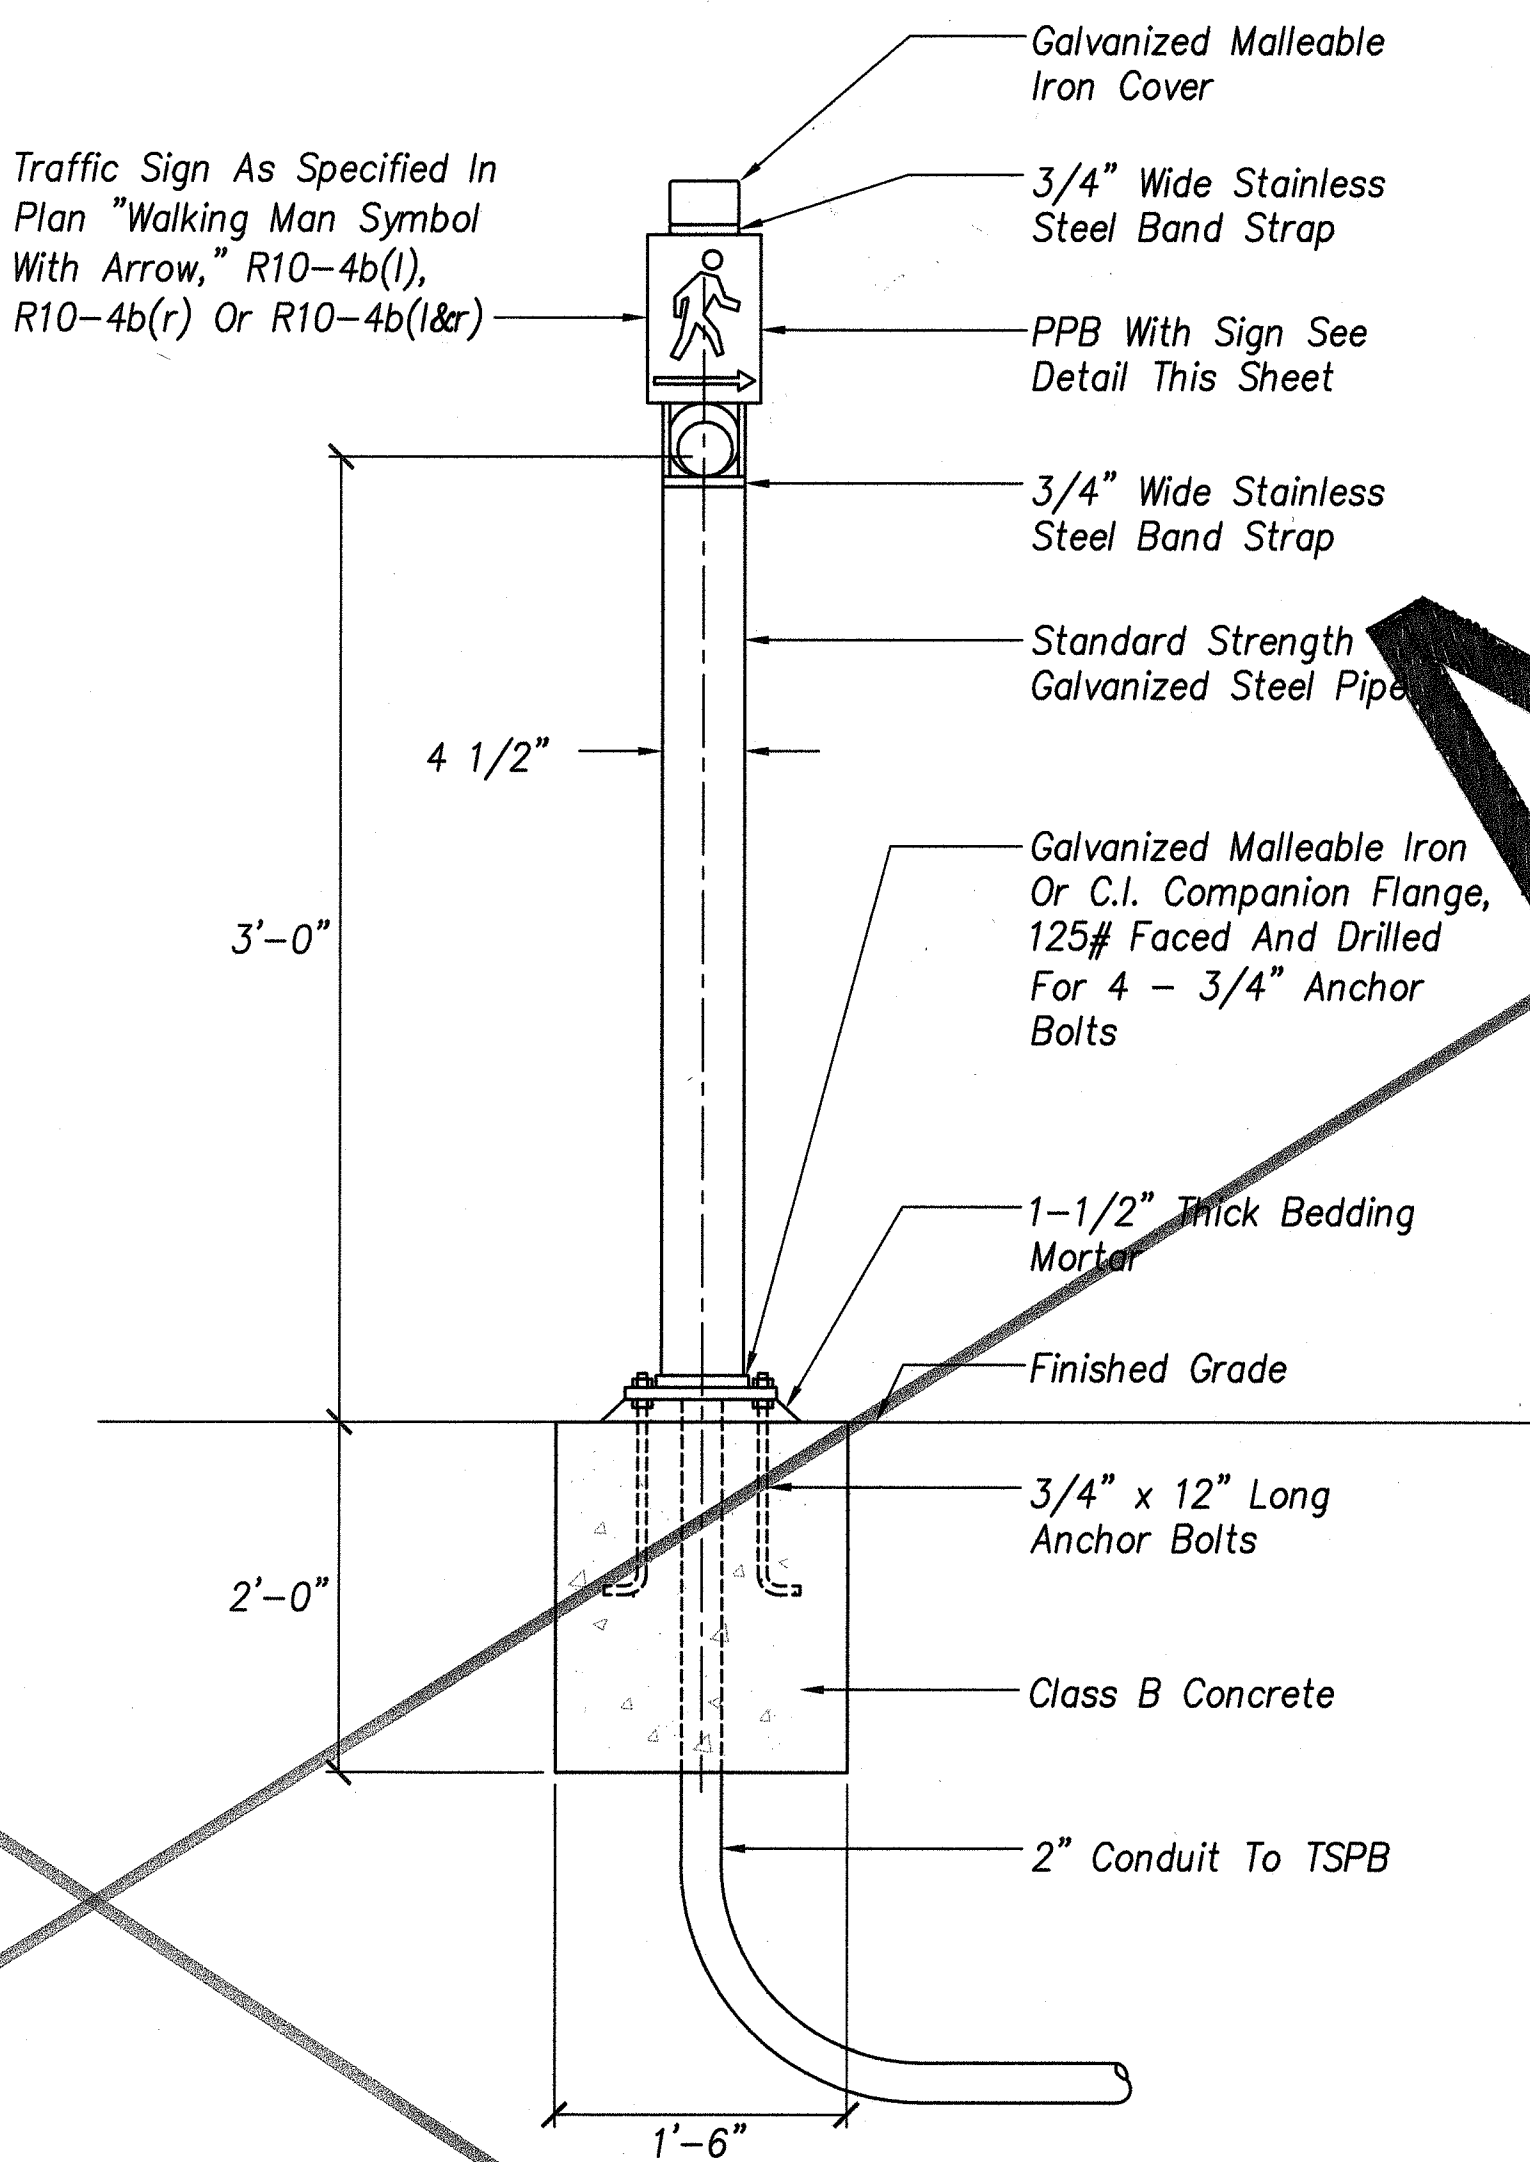


NOTES:

1. Conduits shall protrude 2" max. Above finished surface of foundation.
2. Conduits shall slope away from post foundation.
3. Refer to traffic signal plan(s) for number of pedestrian push buttons to be provided.

2 PPB POST AND FOOTING DETAIL  
S-3 Not to Scale

SURVEY PLATTED BY	DATE
DRAWN BY	
DESIGNED BY	
CHECKED BY	
ORIGINAL PLAN	
NOTE BOOK	
No.	

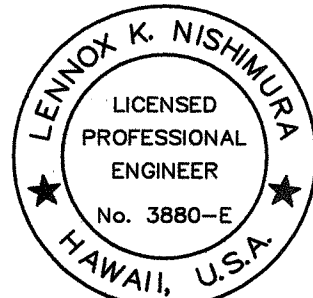


THIS WORK WAS PREPARED BY ME OR UNDER MY SUPERVISION AND CONSTRUCTION OF THIS PROJECT WILL BE UNDER MY OBSERVATION.  
*Lennox K. Nishimura*  
PROJECT ENGINEER for ECS, Inc.  
APRIL 30, 2008  
EXPIRATION DATE OF THE LICENSE

STATE OF HAWAII  
DEPARTMENT OF TRANSPORTATION  
HIGHWAYS DIVISION  
  
PUSH BUTTON DETAILS  
  
KAMEHAMEHA HIGHWAY BIKEWAY  
Vicinity of Radford Drive to Arizona Memorial  
Federal Aid Project No. CMAQ-099-1(22)  
Scale: As Shown Date: June 2005  
  
SHEET No. 3 OF 4 SHEETS



FED. ROAD DIST. NO.	STATE	FED. AID PROJ. NO.	FISCAL YEAR	SHEET NO.	TOTAL SHEETS
HAWAII	HAW.	CMAQ-099-1(22)	2005	C.O. 52 S-4	60

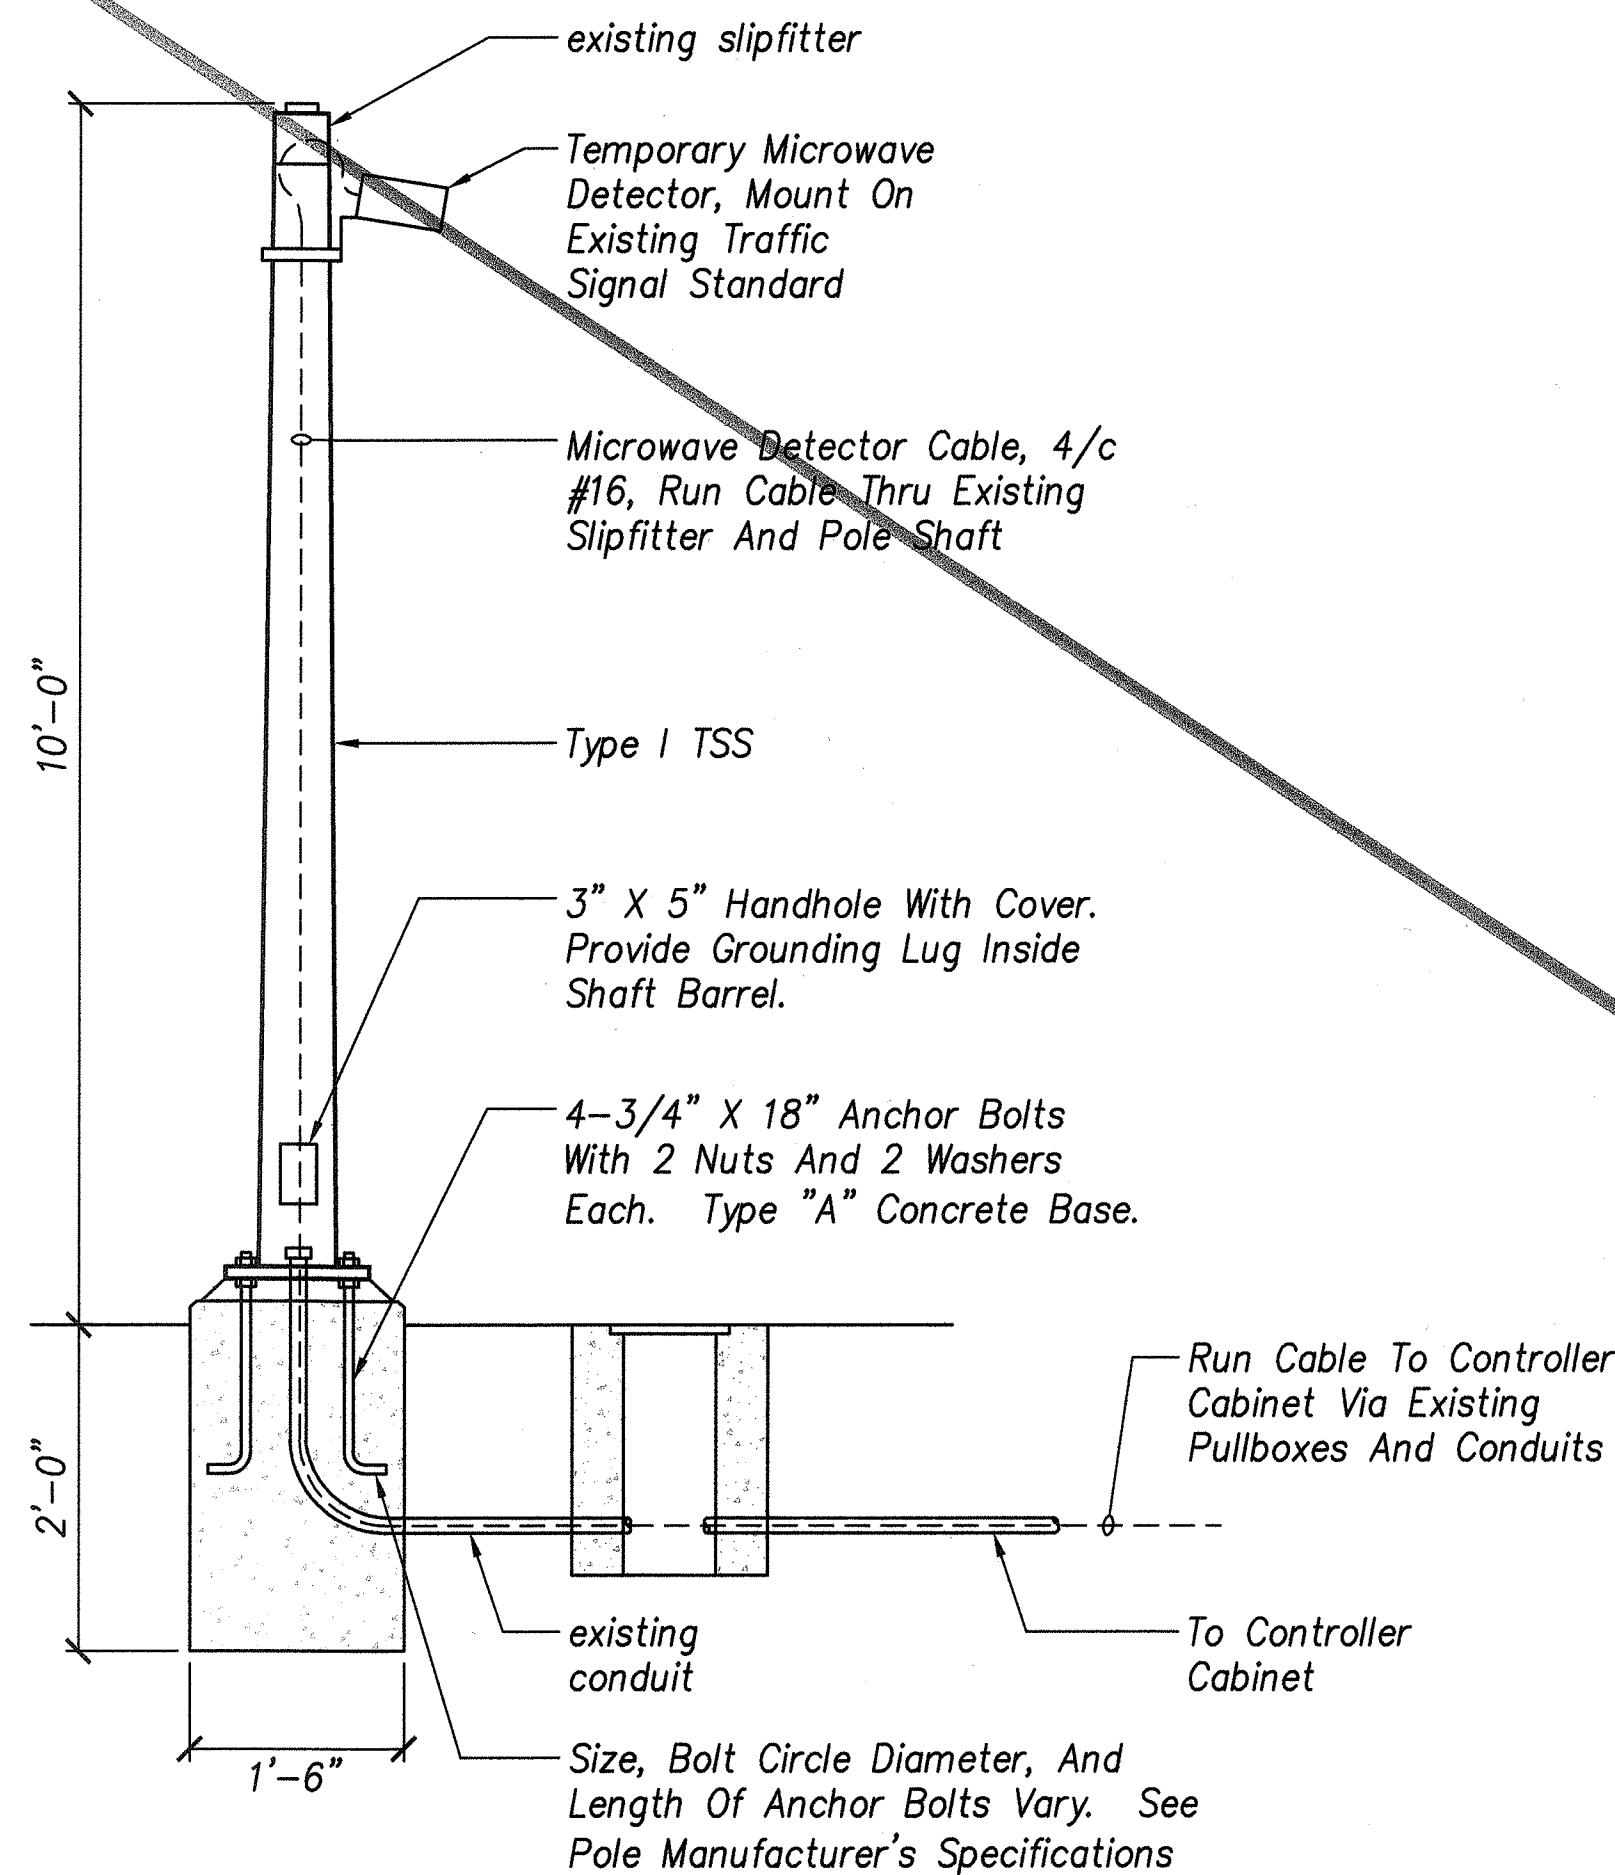


AT EXISTING TRAFFIC SIGNAL STANDARD

NOTES:

- Standards shall be designed in accordance with standard specifications for structural supports.
- Concrete shall be Class "B".
- Type "A" concrete base shall be used for type I-10, traffic signal standards.
- Conduit bend is incidental to concrete base.


1 TEMPORARY MICROWAVE DETECTOR DETAIL  
S-4 Not to Scale

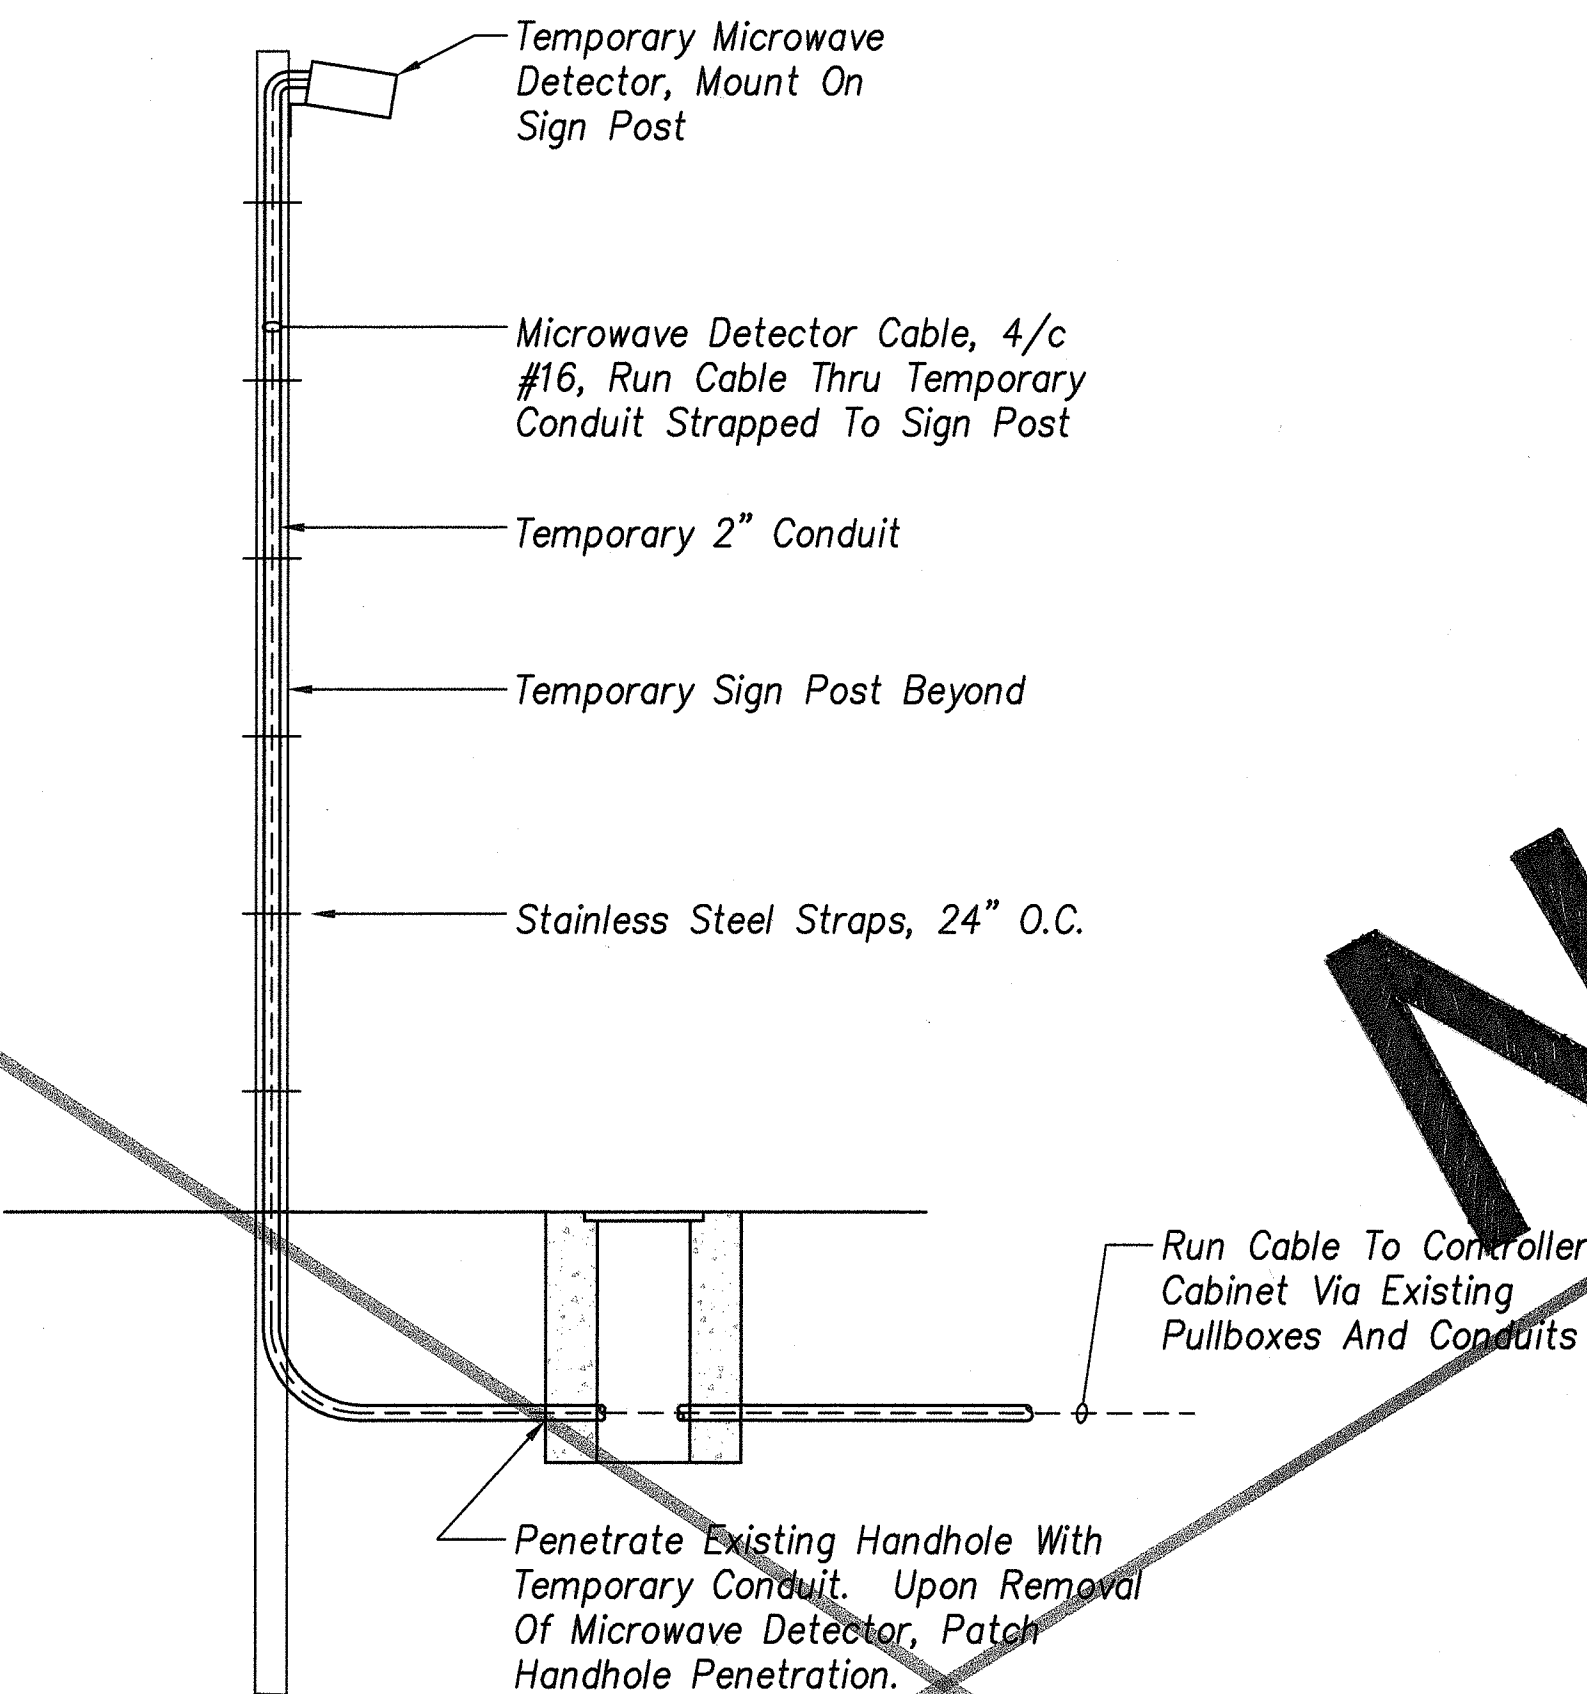

AT TEMP SIGN POST

NOTES:

- Microwave detector shall be operational before existing loop detectors are deactivated. Aim microwave vehicle detector towards affected lane(s).
- Remove microwave detector and all associated cables after new loop detectors are installed and operational.

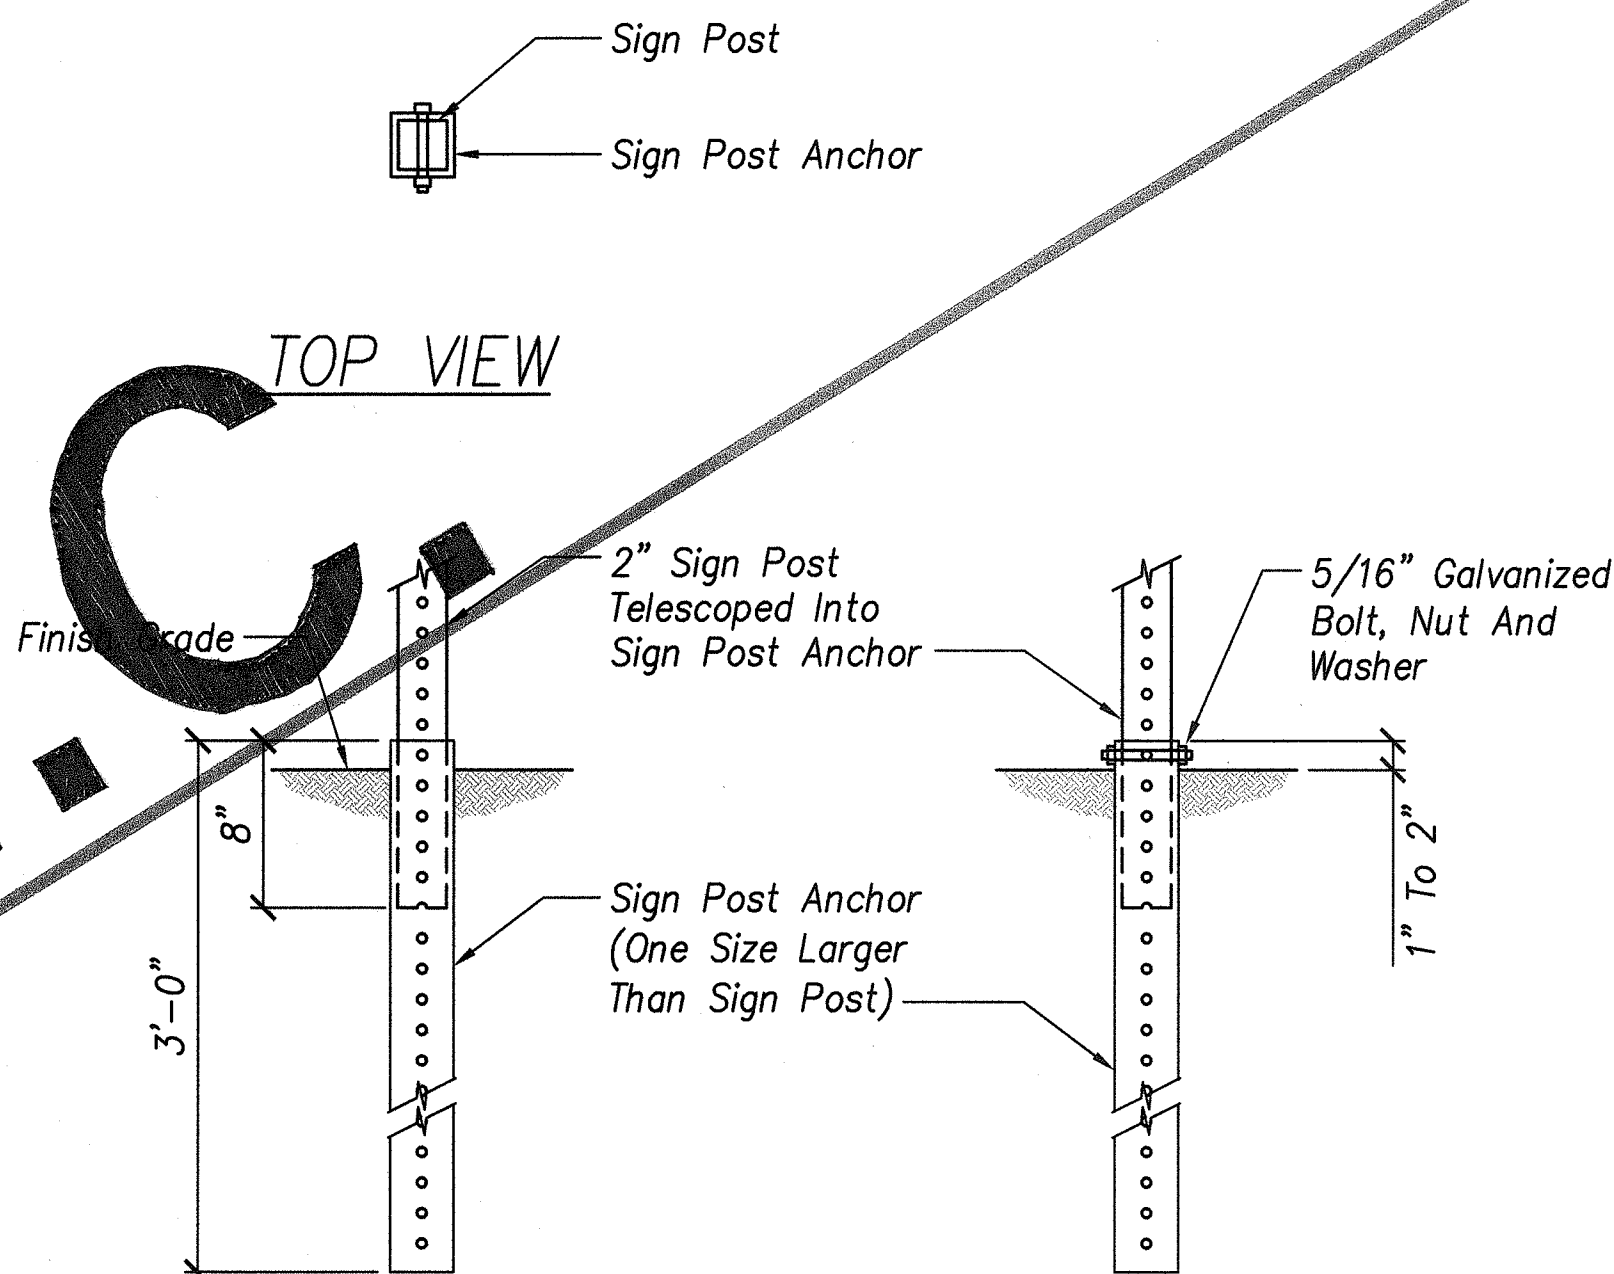


BACK VIEW

FRONT VIEW

2 TEMPORARY SIGN POST DETAIL  
S-4 Not to Scale

SURVEY PLOTTED BY	DATE
DRAWN BY	
DESIGNED BY	
CHECKED BY	
ORIGINAL PLAN	
NOTE BOOK	
No.	

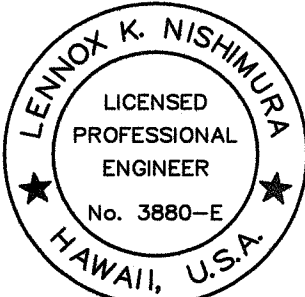

THIS WORK WAS PREPARED BY ME OR UNDER MY SUPERVISION AND CONSTRUCTION OF THIS PROJECT WILL BE UNDER MY OBSERVATION.  
PROJECT ENGINEER for ECS, Inc.  
APRIL 30, 2006  
EXPIRATION DATE OF THE LICENSE

STATE OF HAWAII  
DEPARTMENT OF TRANSPORTATION  
HIGHWAYS DIVISION  
**TEMPORARY MICROWAVE DETECTOR DETAIL**  
  
KAMEHAMEHA HIGHWAY BIKEWAY  
Vicinity of Radford Drive to Arizona Memorial  
Federal Aid Project No. CMAQ-099-1(22)  
Scale: As Shown Date: June 2005  
SHEET No. 4 OF 4 SHEETS