


FED. ROAD DIST. NO.	STATE	FED. AID PROJ. NO.	FISCAL YEAR	SHEET NO.	TOTAL SHEETS
HAWAII	HAW.	CMAQ-099-1(22)	2005	ADD. 30	60

GENERAL NOTES FOR TRAFFIC CONTROL PLAN

- All lane closures and traffic pattern changes (detours) not shown on the plan shall be submitted to the Engineer for approval in accordance with Specifications Section 645 - Traffic Control. For restrictions on lane closures, detours, construction work during peak hours, and other requirements regarding maintaining vehicular and pedestrian traffic, see Section 107.13 - Public Convenience and Safety, Section 645 - Traffic Control, and Section 104.04 - Maintenance of Traffic.
- The Contractor shall make minor adjustments at intersections, driveways, bridges, structures, etc., to fit field conditions.
- Cones or delineators shall be extended to a point where they are visible to approaching traffic.
- Traffic control devices shall be installed such that the sign or device farthest from the work area shall be placed first. The others shall then be placed progressively toward the work area.
- Flaggers and/or police officers shall be in sight of each other or in direct communications at all times.
- Sign spacings (L), taper lengths (T), and spacings of cones or delineators shall be as shown in Table 1 of Section 645 in the Specifications, unless otherwise noted on the Traffic Control Plans.
- All traffic lanes shall be minimum of 10 feet wide.
- All construction warning signs shall be promptly removed or covered whenever the message is not applicable or not in use.
- The backs of all signs for traffic control shall be appropriately covered to preclude the display of inapplicable sign messages (i.e., when signs have messages on both faces).
- At the end of each day's work or as soon as the work is completed, the Contractor shall remove all traffic control devices no longer needed to permit free and safe passage of public traffic. Removal shall be in the reverse order of installation.
- Replace permanent pavement markings and traffic signs upon completion of each phase of work.
- Existing conflicting pavement markings shall be removed and temporary pavement markings shall be installed before traffic patterns are changed. After completion of the work, temporary pavement markings shall be removed. Payment for removal of existing pavement markings and furnishing, installing, and removal of temporary pavement markings, whether or not shown on the Traffic Control Plans shall be considered incidental to the various contract items.
- The locations of pavement markings, signs, and delineators used in the Traffic Control shall be as shown on the Plans and/or as determined in the field by the Engineer.
- During working and non-working hours, the Contractor shall furnish, install, and maintain Type II Barricades at 10' spacing in new and existing pavement areas closed to public vehicles.

- The Contractor shall provide sand bags or other accepted weights for the Type II Barricades, when used. The Contractor shall provide steady burn amber lamps during hours of darkness. The lamps shall be attached on the Type II Barricade end closest to the traveled way. The lamp should be visible to the motorist. Payment for Type II Barricades with amber lamps shall be considered incidental to the various contract items.
- Contractor shall maintain access to adjacent properties at all times.
- Cones and signs for night work shall be retroreflective.
- The Contractor shall provide a transition taper during non-construction hours for open trenches adjacent to the travelway. See Transition Taper Detail on this sheet.
- Steel plates for covering trenches shall have a skid resistant surface. Payment for steel plates shall be considered incidental to the various contract items.
- The Contractor shall limit the extent of trench and excavation work for pavement reconstruction to an area that can be satisfactorily backfilled in one work day.

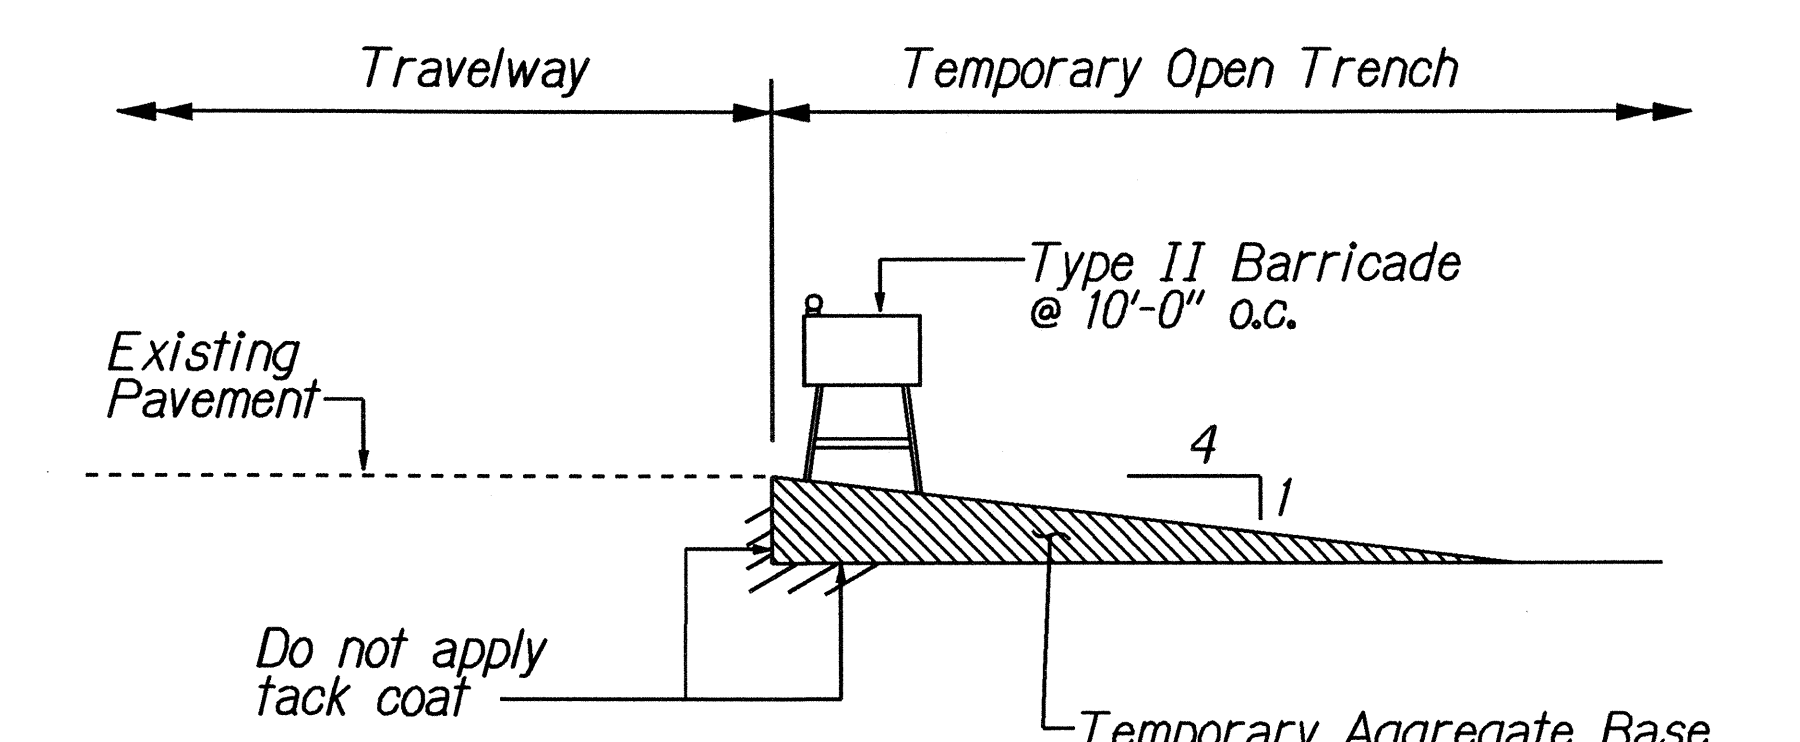

NOTE:
Contractor shall install & maintain appropriate construction warning signs. Payment for furnishing, installing and removing construction warning signs shall be considered incidental to the various contract items.

Remove prior to pavement construction) Payment for Temporary Aggregate Base shall be considered incidental to the various contract items.

TRANSITION TAPER
Not to Scale


LEGEND

- • • Cones
- ⊙ Tubular Delineator
- ⊠ Portable Arrow Board
- ▩ Portable Electronic Message Board
- ➔ Direction of Traffic
- New Sign
- ◡ Existing Sign
- H Type II Barricade
- ||-|| Type III Barricade
- ▣ Work Area

ORIGINAL PLAN	DATE
REVISED BY	
DRAWN BY	
TRACED BY	
DESIGNED BY	
QUANTITIES BY	
CHECKED BY	

1/14/05	Revised transition taper
DATE	REVISION
STATE OF HAWAII DEPARTMENT OF TRANSPORTATION HIGHWAYS DIVISION	
TRAFFIC CONTROL NOTES & LEGEND	
<u>KAMEHAMEHA HIGHWAY BIKEWAY</u> Vicinity of Radford Drive to Arizona Memorial Federal Aid Project No. CMAQ-099-1(22)	
Not to Scale	Date: February 2004
SHEET No. 11 OF 8 SHEETS	

FED. ROAD DIST. NO.	STATE	FED. AID PROJ. NO.	FISCAL YEAR	SHEET NO.	TOTAL SHEETS
HAWAII	HAW.	CMAQ-099-1(22)	2005	31	60

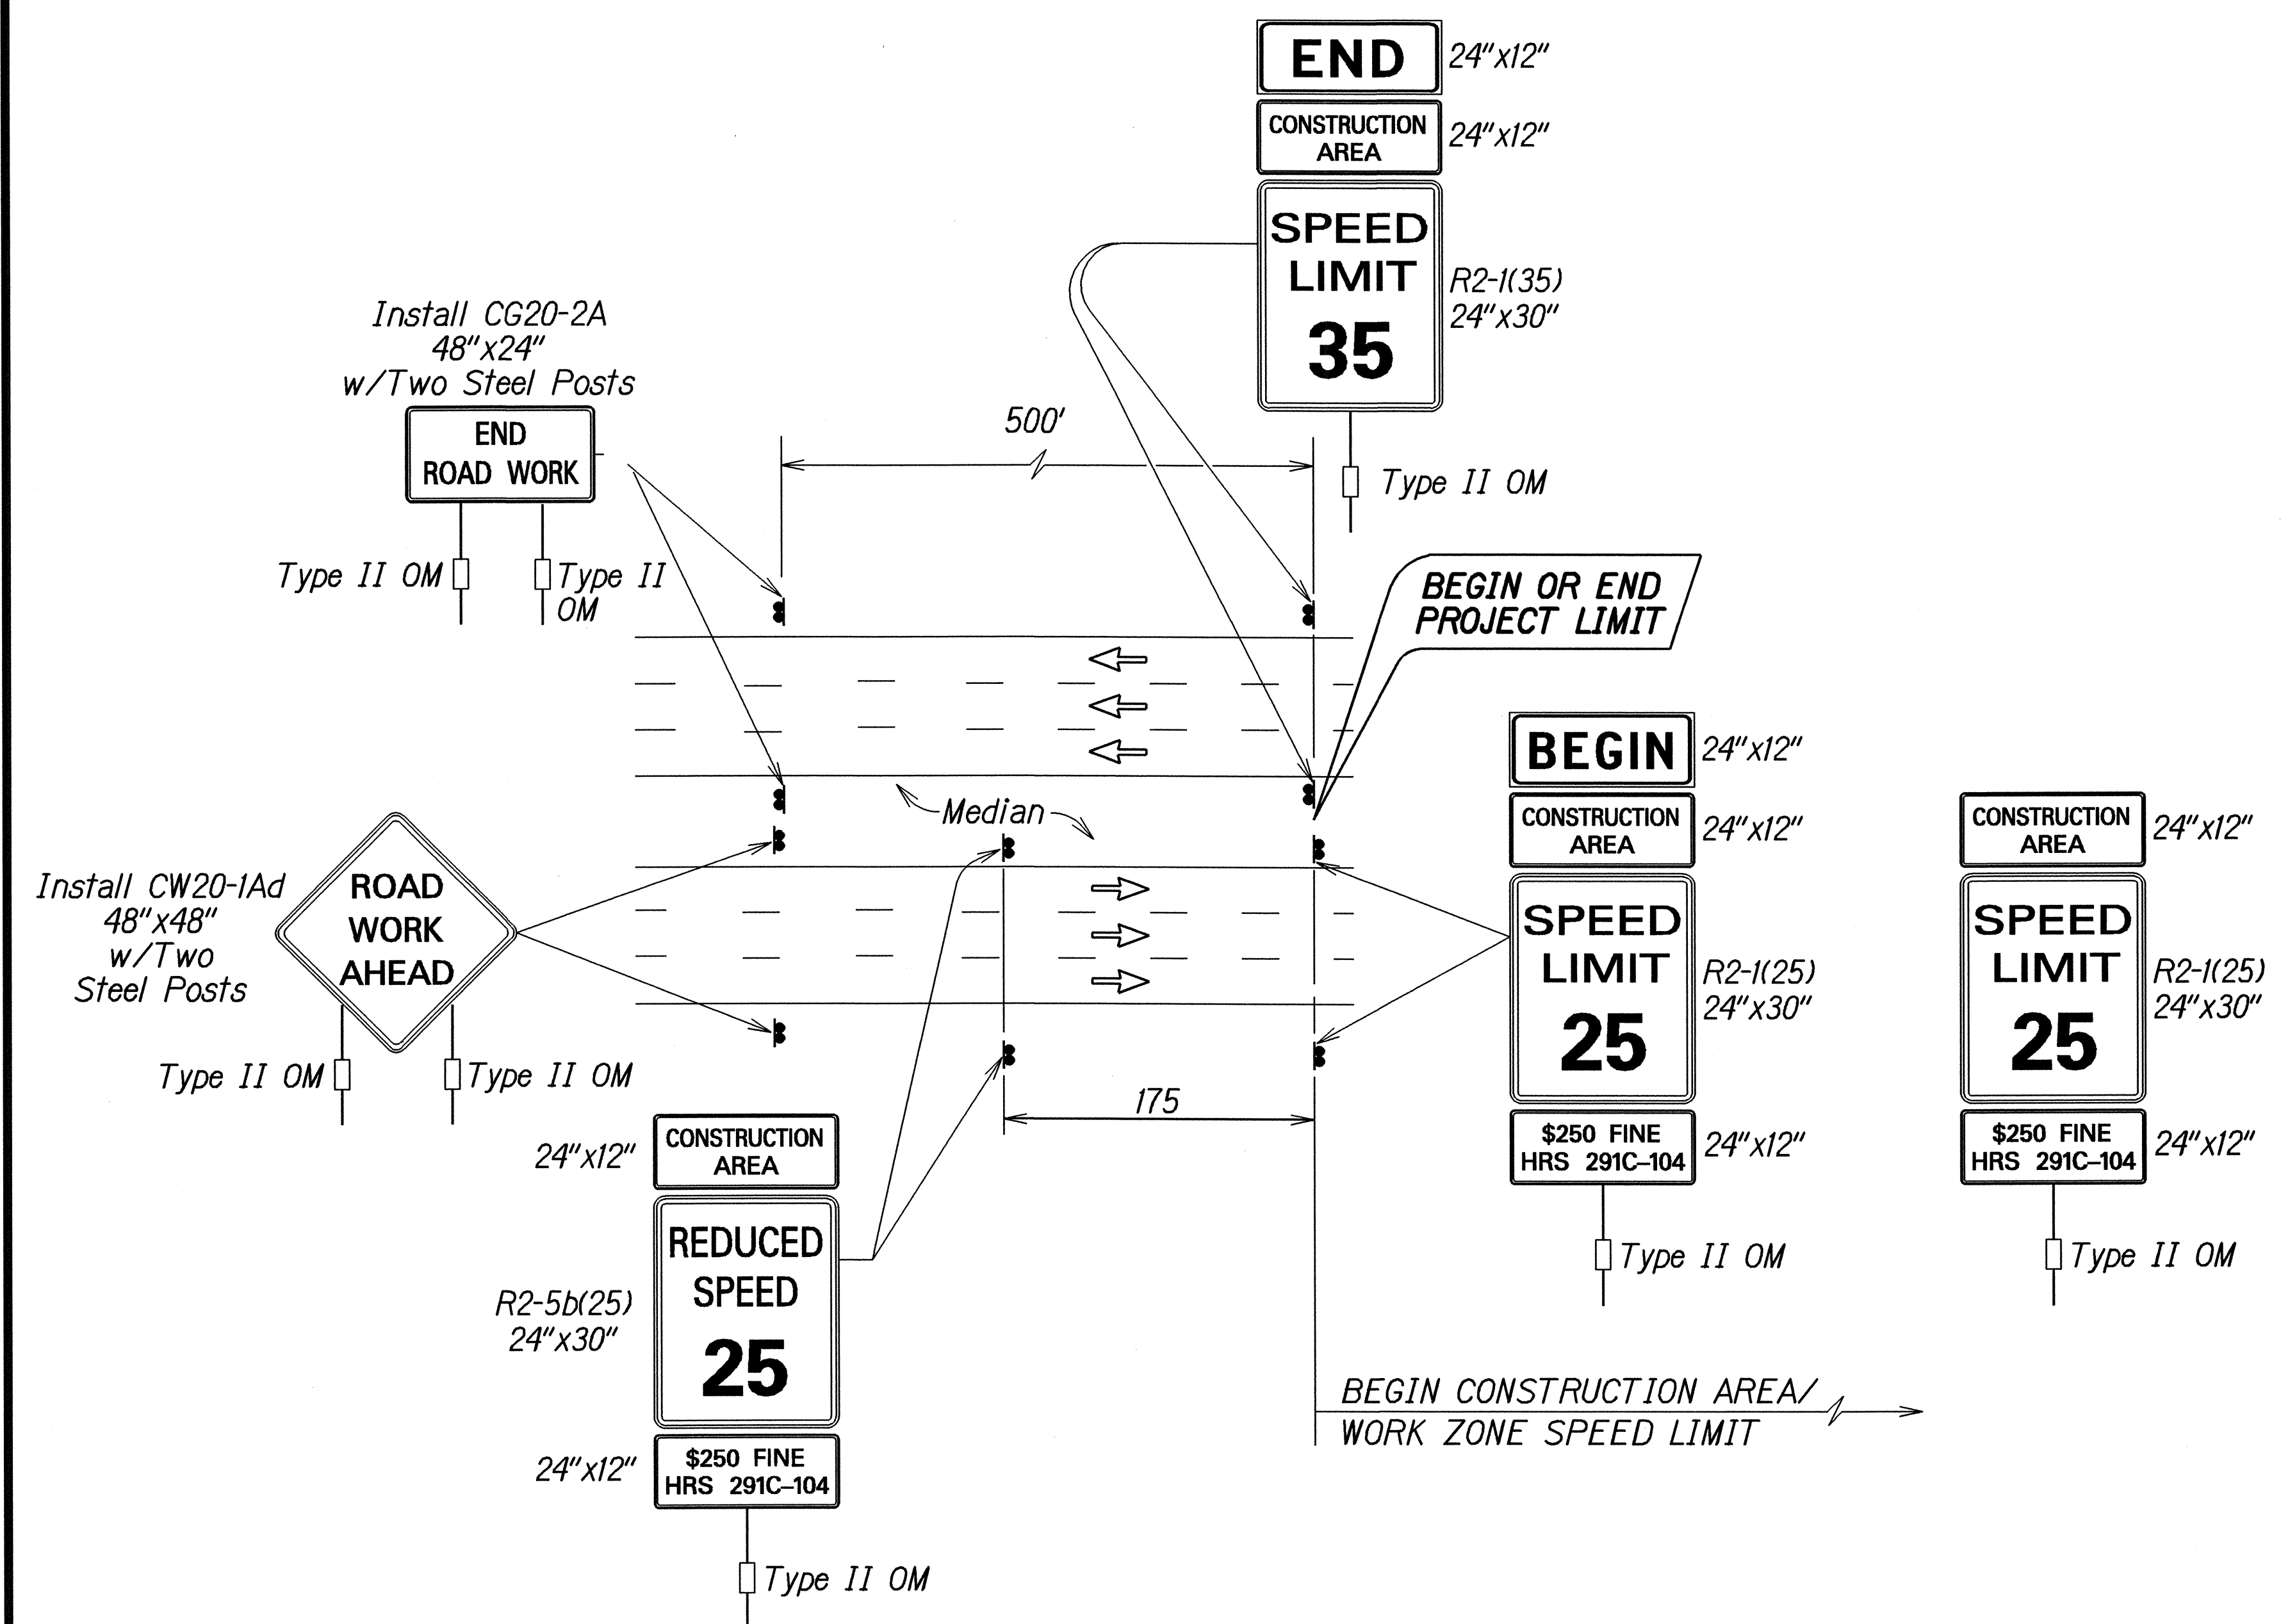


TYPICAL DETAIL FOR CONSTRUCTION SIGNS ON MULTILANE DIVIDED LOW SPEED HIGHWAY


Work Zone Notes:

1. This Work Zone Sign Plan is intended for use on long-term stationary work zones/construction phases (3 days or more). All work zones or construction phases less than 3 days duration will use Traffic Control Plans shown in Section 645 of the Special Provisions.
2. All existing regulatory speed limit signs with posts within the work zone/project limits shall be removed and replaced with work zone speed limit sign assemblies (R2-1(XX) and R2-5b(XX) with "CONSTRUCTION AREA" and "\$250 FINE HRS 291C-104" Supplemental Signs).
3. Construction sign assemblies shall be installed on both the approaching and trailing ends of each work zone as shown on this plan.
4. Each construction warning sign shall have a minimum of two (2) Type II OM. Each work zone speed limit assembly shall have a minimum of one (1) Type II OM. Installation of each Type II OM shall be considered incidental to Item No. 621.7100, Construction Sign with Posts.
5. Upon the completion of all physical work or as directed by the Engineer, all construction signs and work zone speed limit assemblies shall be removed. All speed limit signs and posts that were existing at the start of the project within the work zone/project limits shall be restored back to their original locations and configurations.
6. Placement of construction signs shall not obstruct the path of pedestrians and bicyclists.
7. The removal and restoration of existing regulatory speed limit signs shall be considered incidental to Item No. 621.7100, Construction Sign with Posts.
8. The fabrication and initial installation of work zone speed limit sign assemblies shall be paid for under Item No. 621.7100, Construction Sign with Posts.
9. The subsequent relocation, maintenance and removal of work zone speed limit sign assemblies shall be considered incidental to Item No. 621.7100, Construction Sign with Posts.
10. The work zone speed limit signs shall be new and become property of the Contractor at completion of project.


SURVEY PLOTTED BY	DATE
DRAWN BY	
NOTED BY	
DESIGNED BY	
QUANTITIES BY	
CHECKED BY	

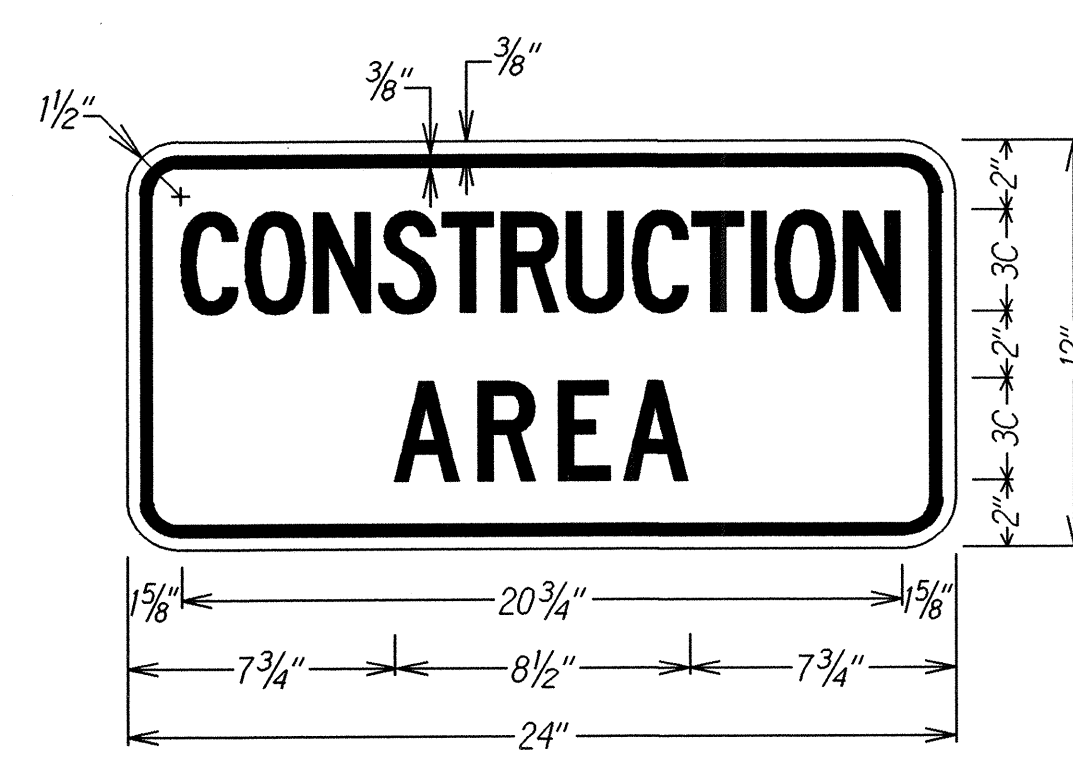


LEGEND: BLACK
BACKGROUND: ORANGE

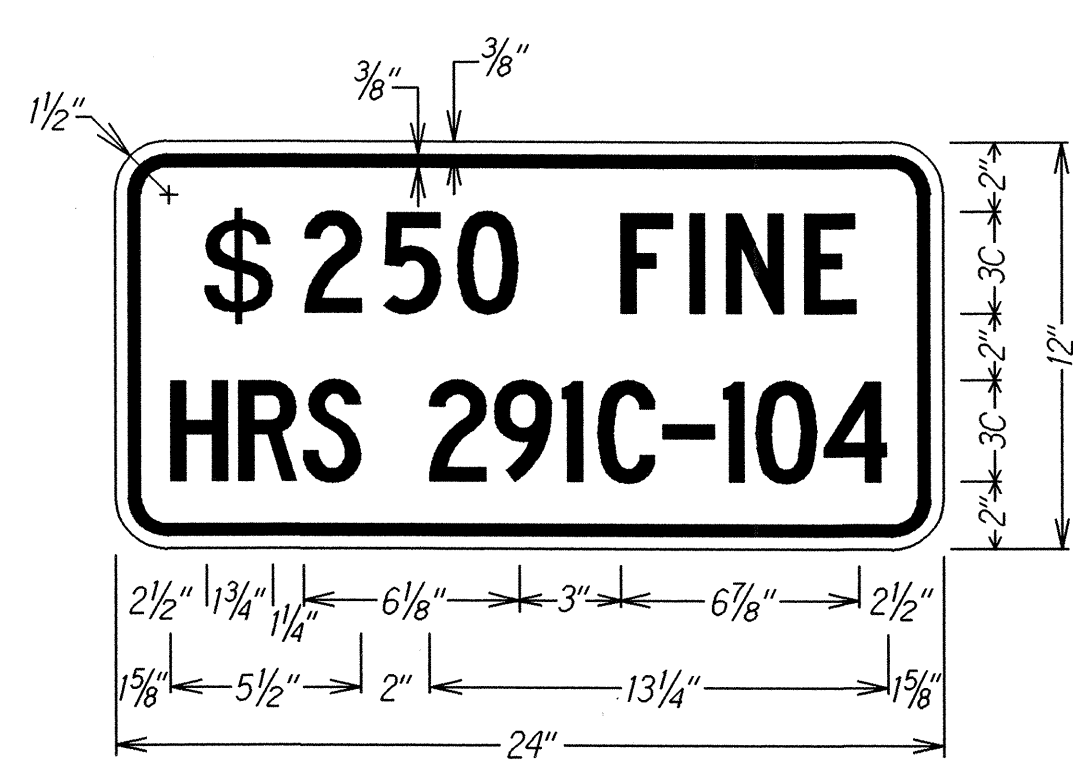

LEGEND: BLACK
BACKGROUND: WHITE

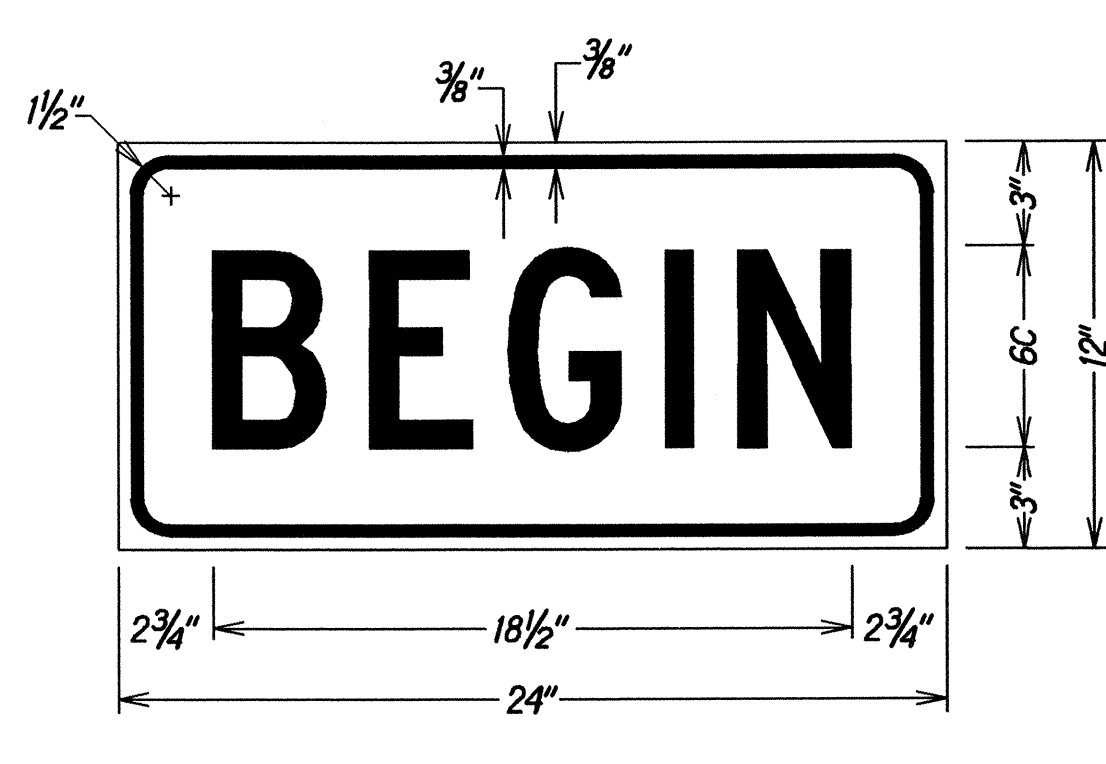


LEGEND: BLACK
BACKGROUND: ORANGE

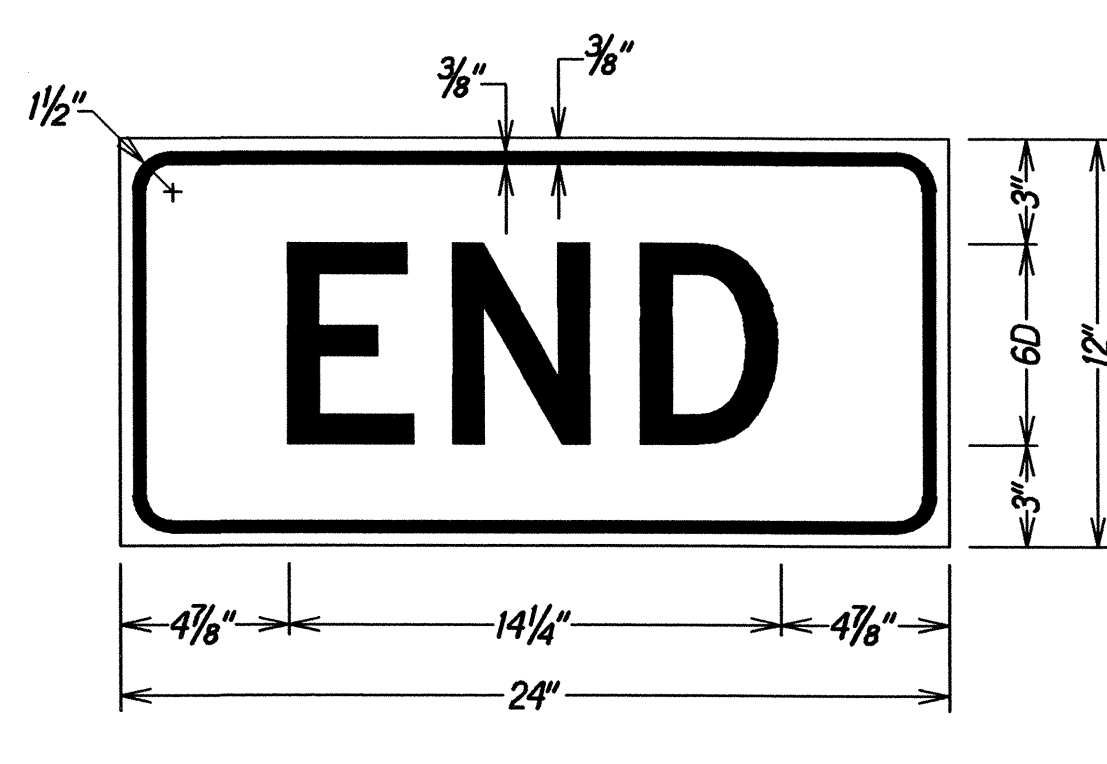


LEGEND: BLACK
BACKGROUND: ORANGE

STATE OF HAWAII
DEPARTMENT OF TRANSPORTATION
HIGHWAYS DIVISION
WORK ZONE SIGNING PLAN
NOTES & DETAILS
KAMEHAMEHA HIGHWAY BIKEWAY
Vicinity of Radford Drive to Arizona Memorial
Federal Aid Project No. CMAQ-099-1(22)
Not to Scale Date: February 2004
SHEET No. T2 OF 8 SHEETS


FED. ROAD DIST. NO.	STATE	FED. AID PROJ. NO.	FISCAL YEAR	SHEET NO.	TOTAL SHEETS
HAWAII	HAW.	CMAQ-099-1(22)	2005	C.O. ADD. 32 S-1	60

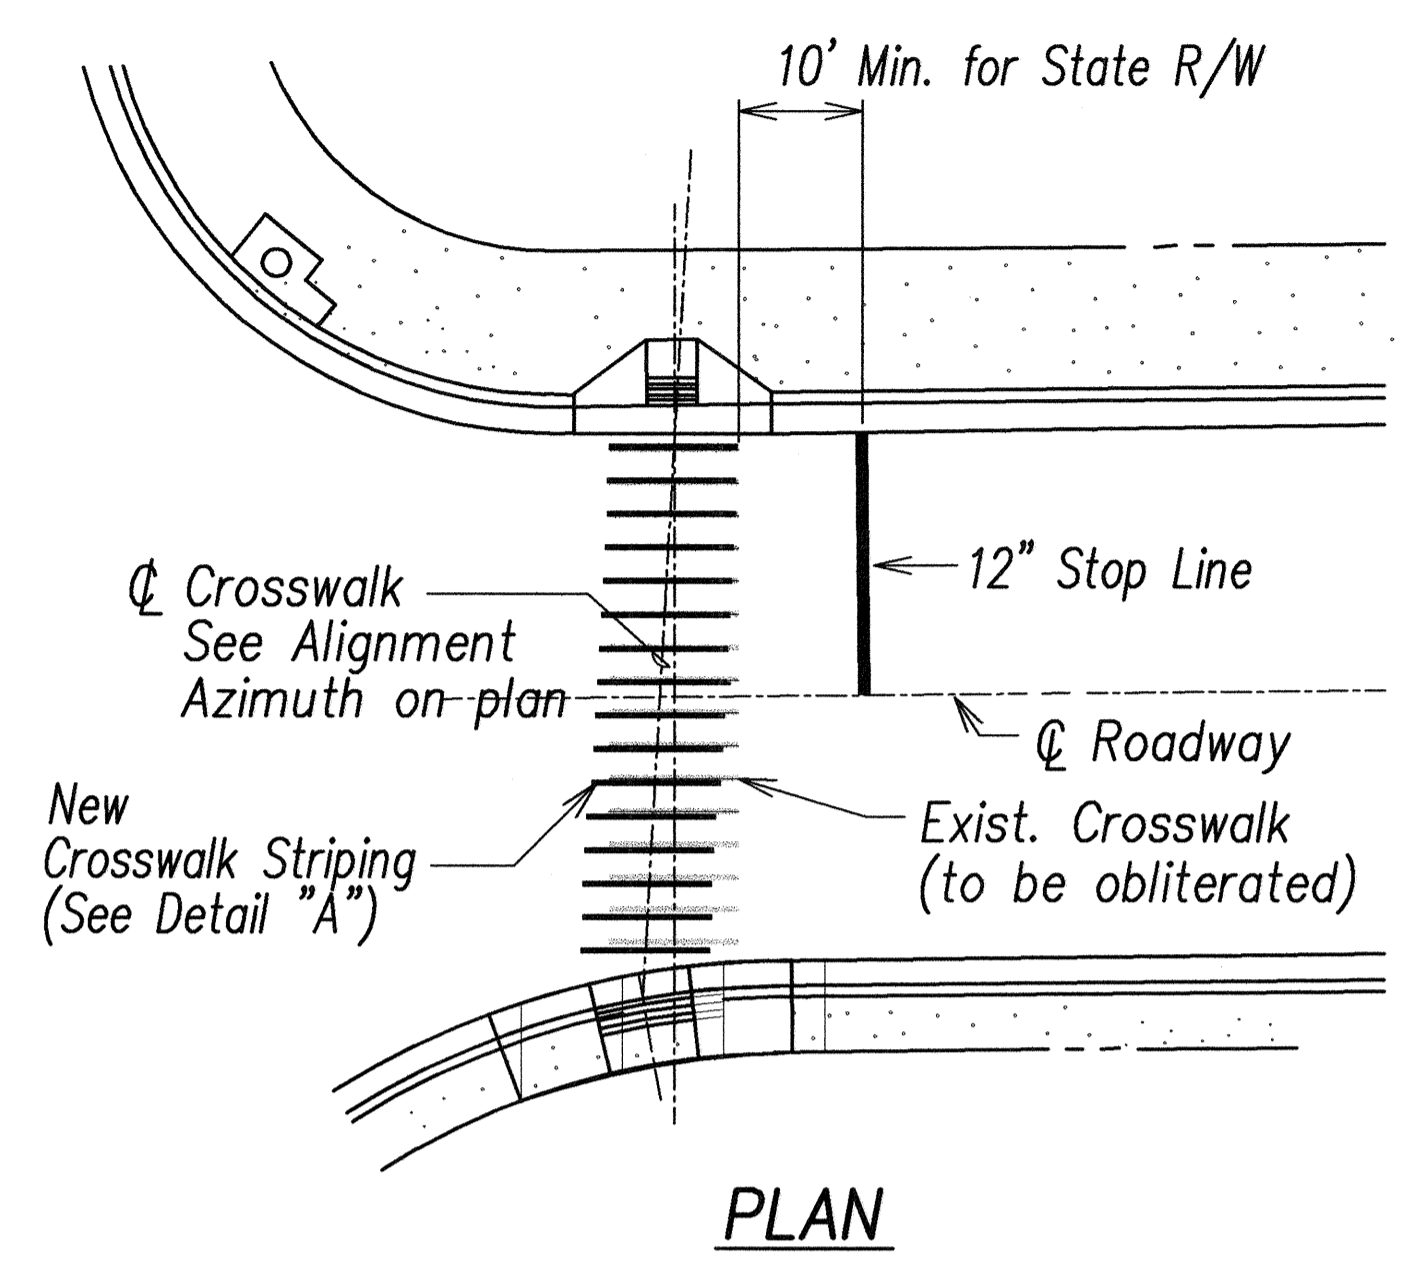


PLAN

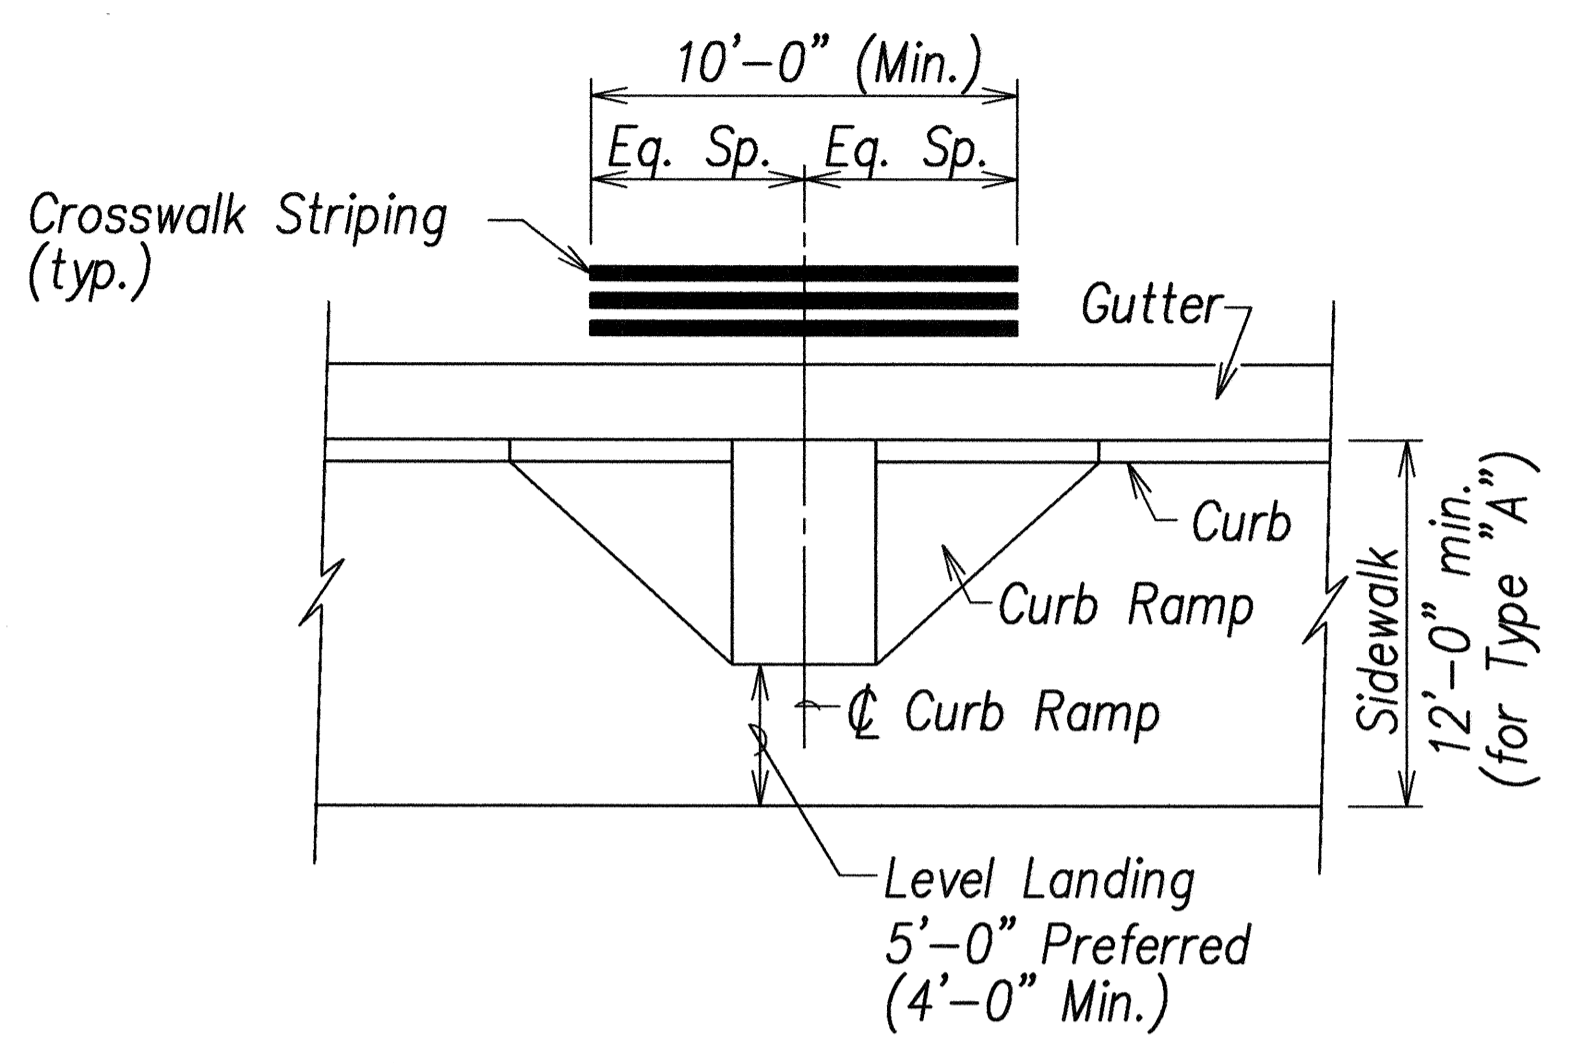

TYPICAL CROSSWALK STRIPING AT CURB RAMP

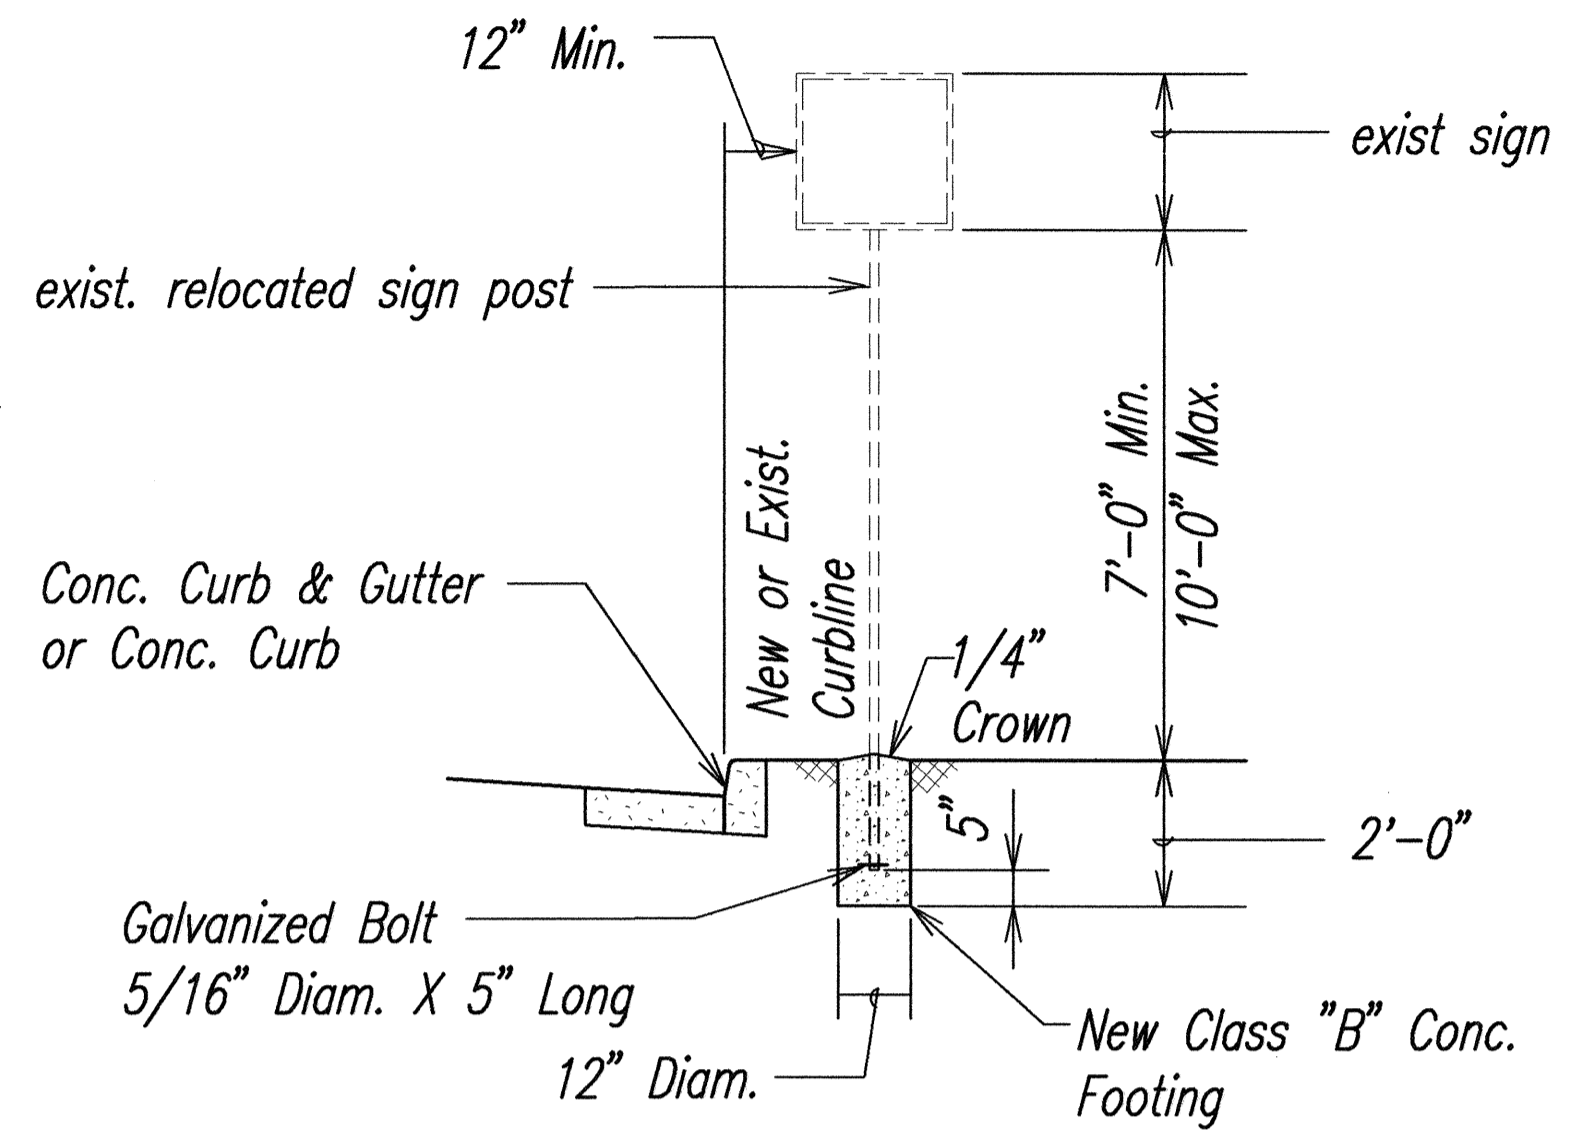


TYPICAL SIGN RELOCATION DETAIL
Not to scale

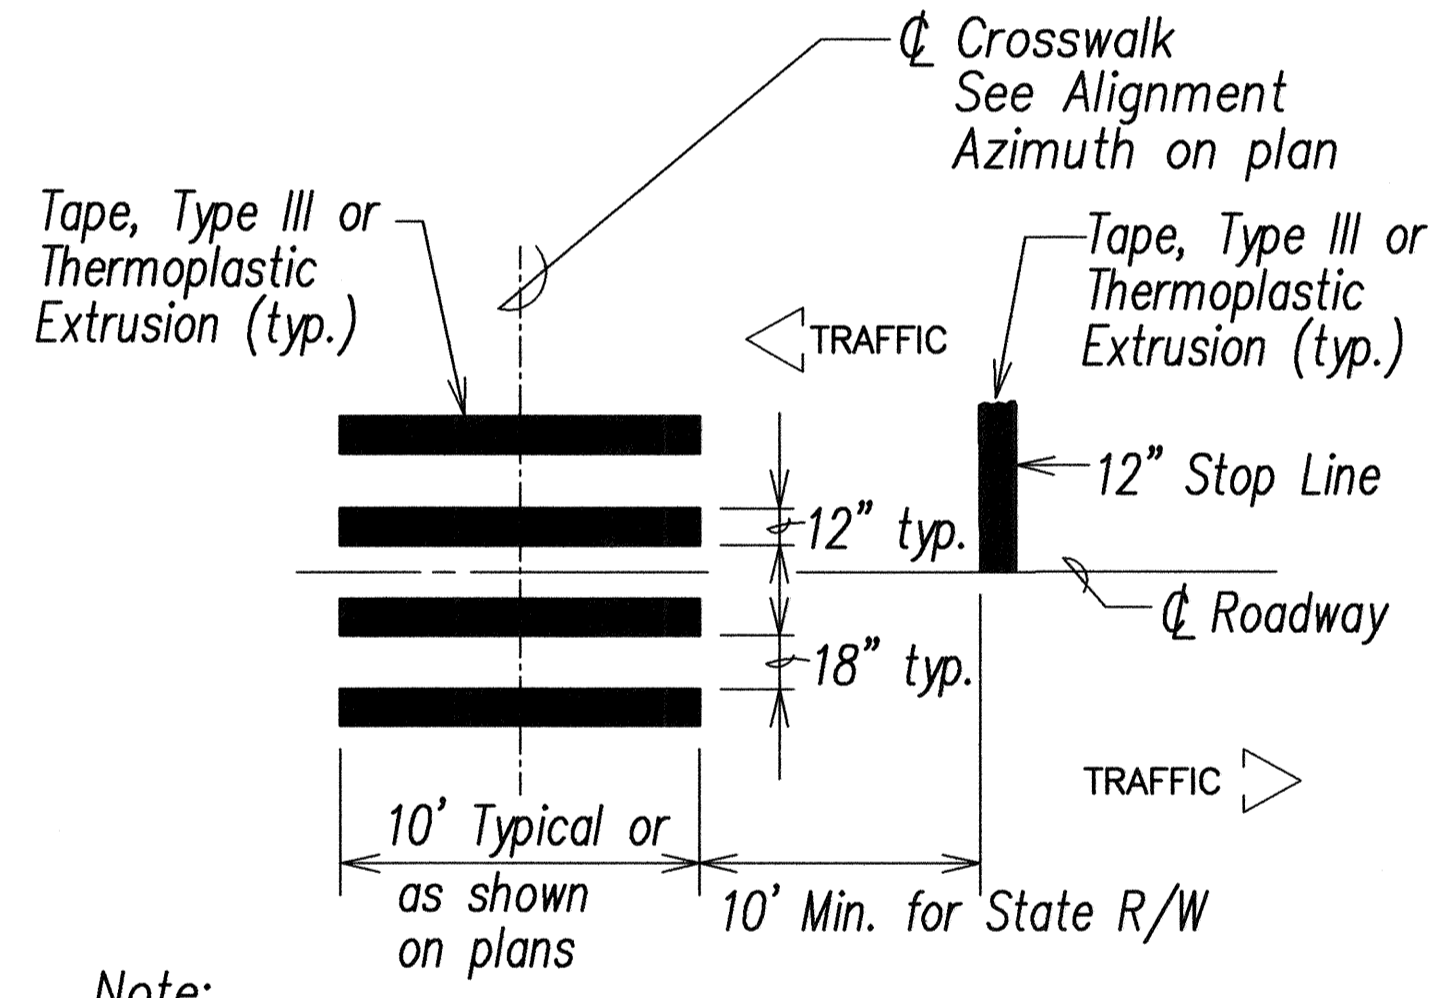


Note:
Longitudinal lines shall be parallel to traffic flow.

DETAIL "A"
CROSSWALK STRIPING DETAIL

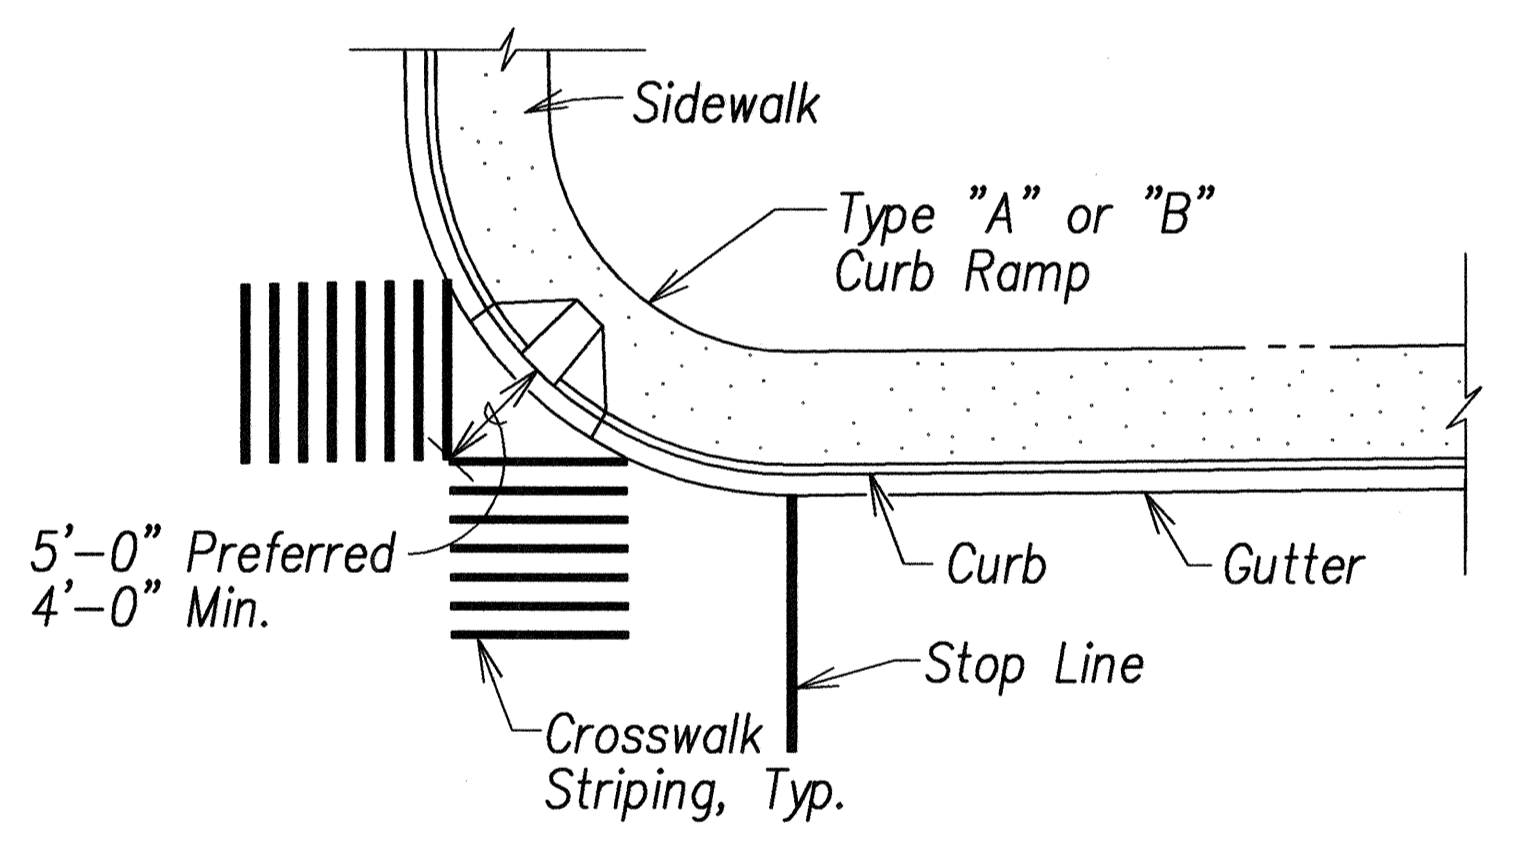


TYPICAL CROSSWALK STRIPING AT DIAGONAL CURB RAMP

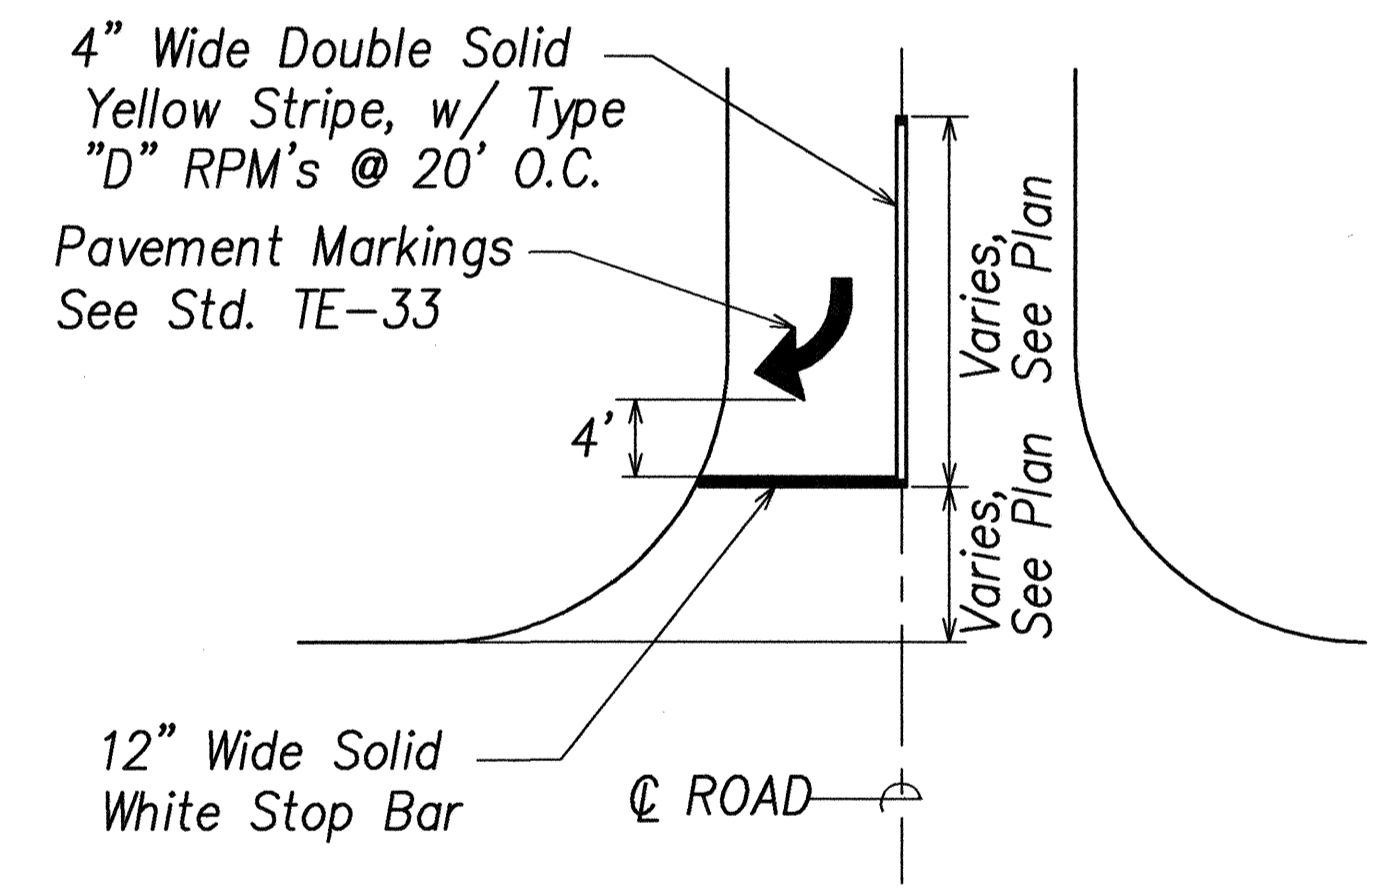

MINOR ROAD STRIPING PAVEMENT ARROW
NOT TO SCALE

DATE	_____
SURVEY PLOTTED BY	_____
DRAWN BY	_____
DESIGNED BY	_____
QUANTITIES BY	_____
CHECKED BY	_____
NO.	_____

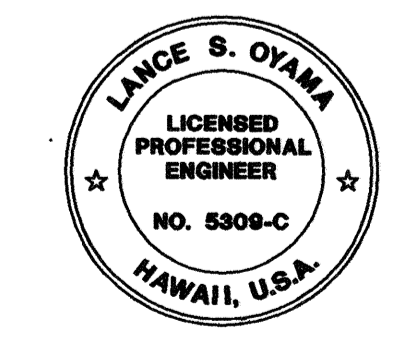

THIS WORK WAS PREPARED BY ME OR UNDER MY SUPERVISION AND CONSTRUCTION OF THIS PROJECT WILL BE UNDER MY OBSERVATION.
Lance S. Oyama
SIGNATURE DATE
"OBSERVATION OF CONSTRUCTION" IS DEFINED IN CHAPTER 16-115, HAWAII ADMINISTRATIVE RULES ENTITLED "PROFESSIONAL ENGINEERS, ARCHITECTS, SURVEYORS AND LANDSCAPE ARCHITECTS."

STATE OF HAWAII
DEPARTMENT OF TRANSPORTATION
HIGHWAYS DIVISION

STRIPING DETAILS


KAMEHAMEHA HIGHWAY BIKEWAY
Vicinity of Radford Drive to Arizona Memorial
Federal Aid Project No. CMAQ-099-1(22)

Scale: _____ Date: August 2005

SHEET No. 1 OF 1 SHEETS

Path: Q:\WOC\7282-01 Kam Hwy Redesign\ Filename: C.O. ADD. 32 S-1 Plot date: Aug 26, 2005-05:32:45pm CAD User: eredeable. Xref Filename: | bdr-dothwy | AUTODATE

FED. ROAD DIST. NO.	STATE	FED. AID PROJ. NO.	FISCAL YEAR	SHEET NO.	TOTAL SHEETS
HAWAII	HAW.	CMAQ-099-1(22)	2005	ADD. 33	60

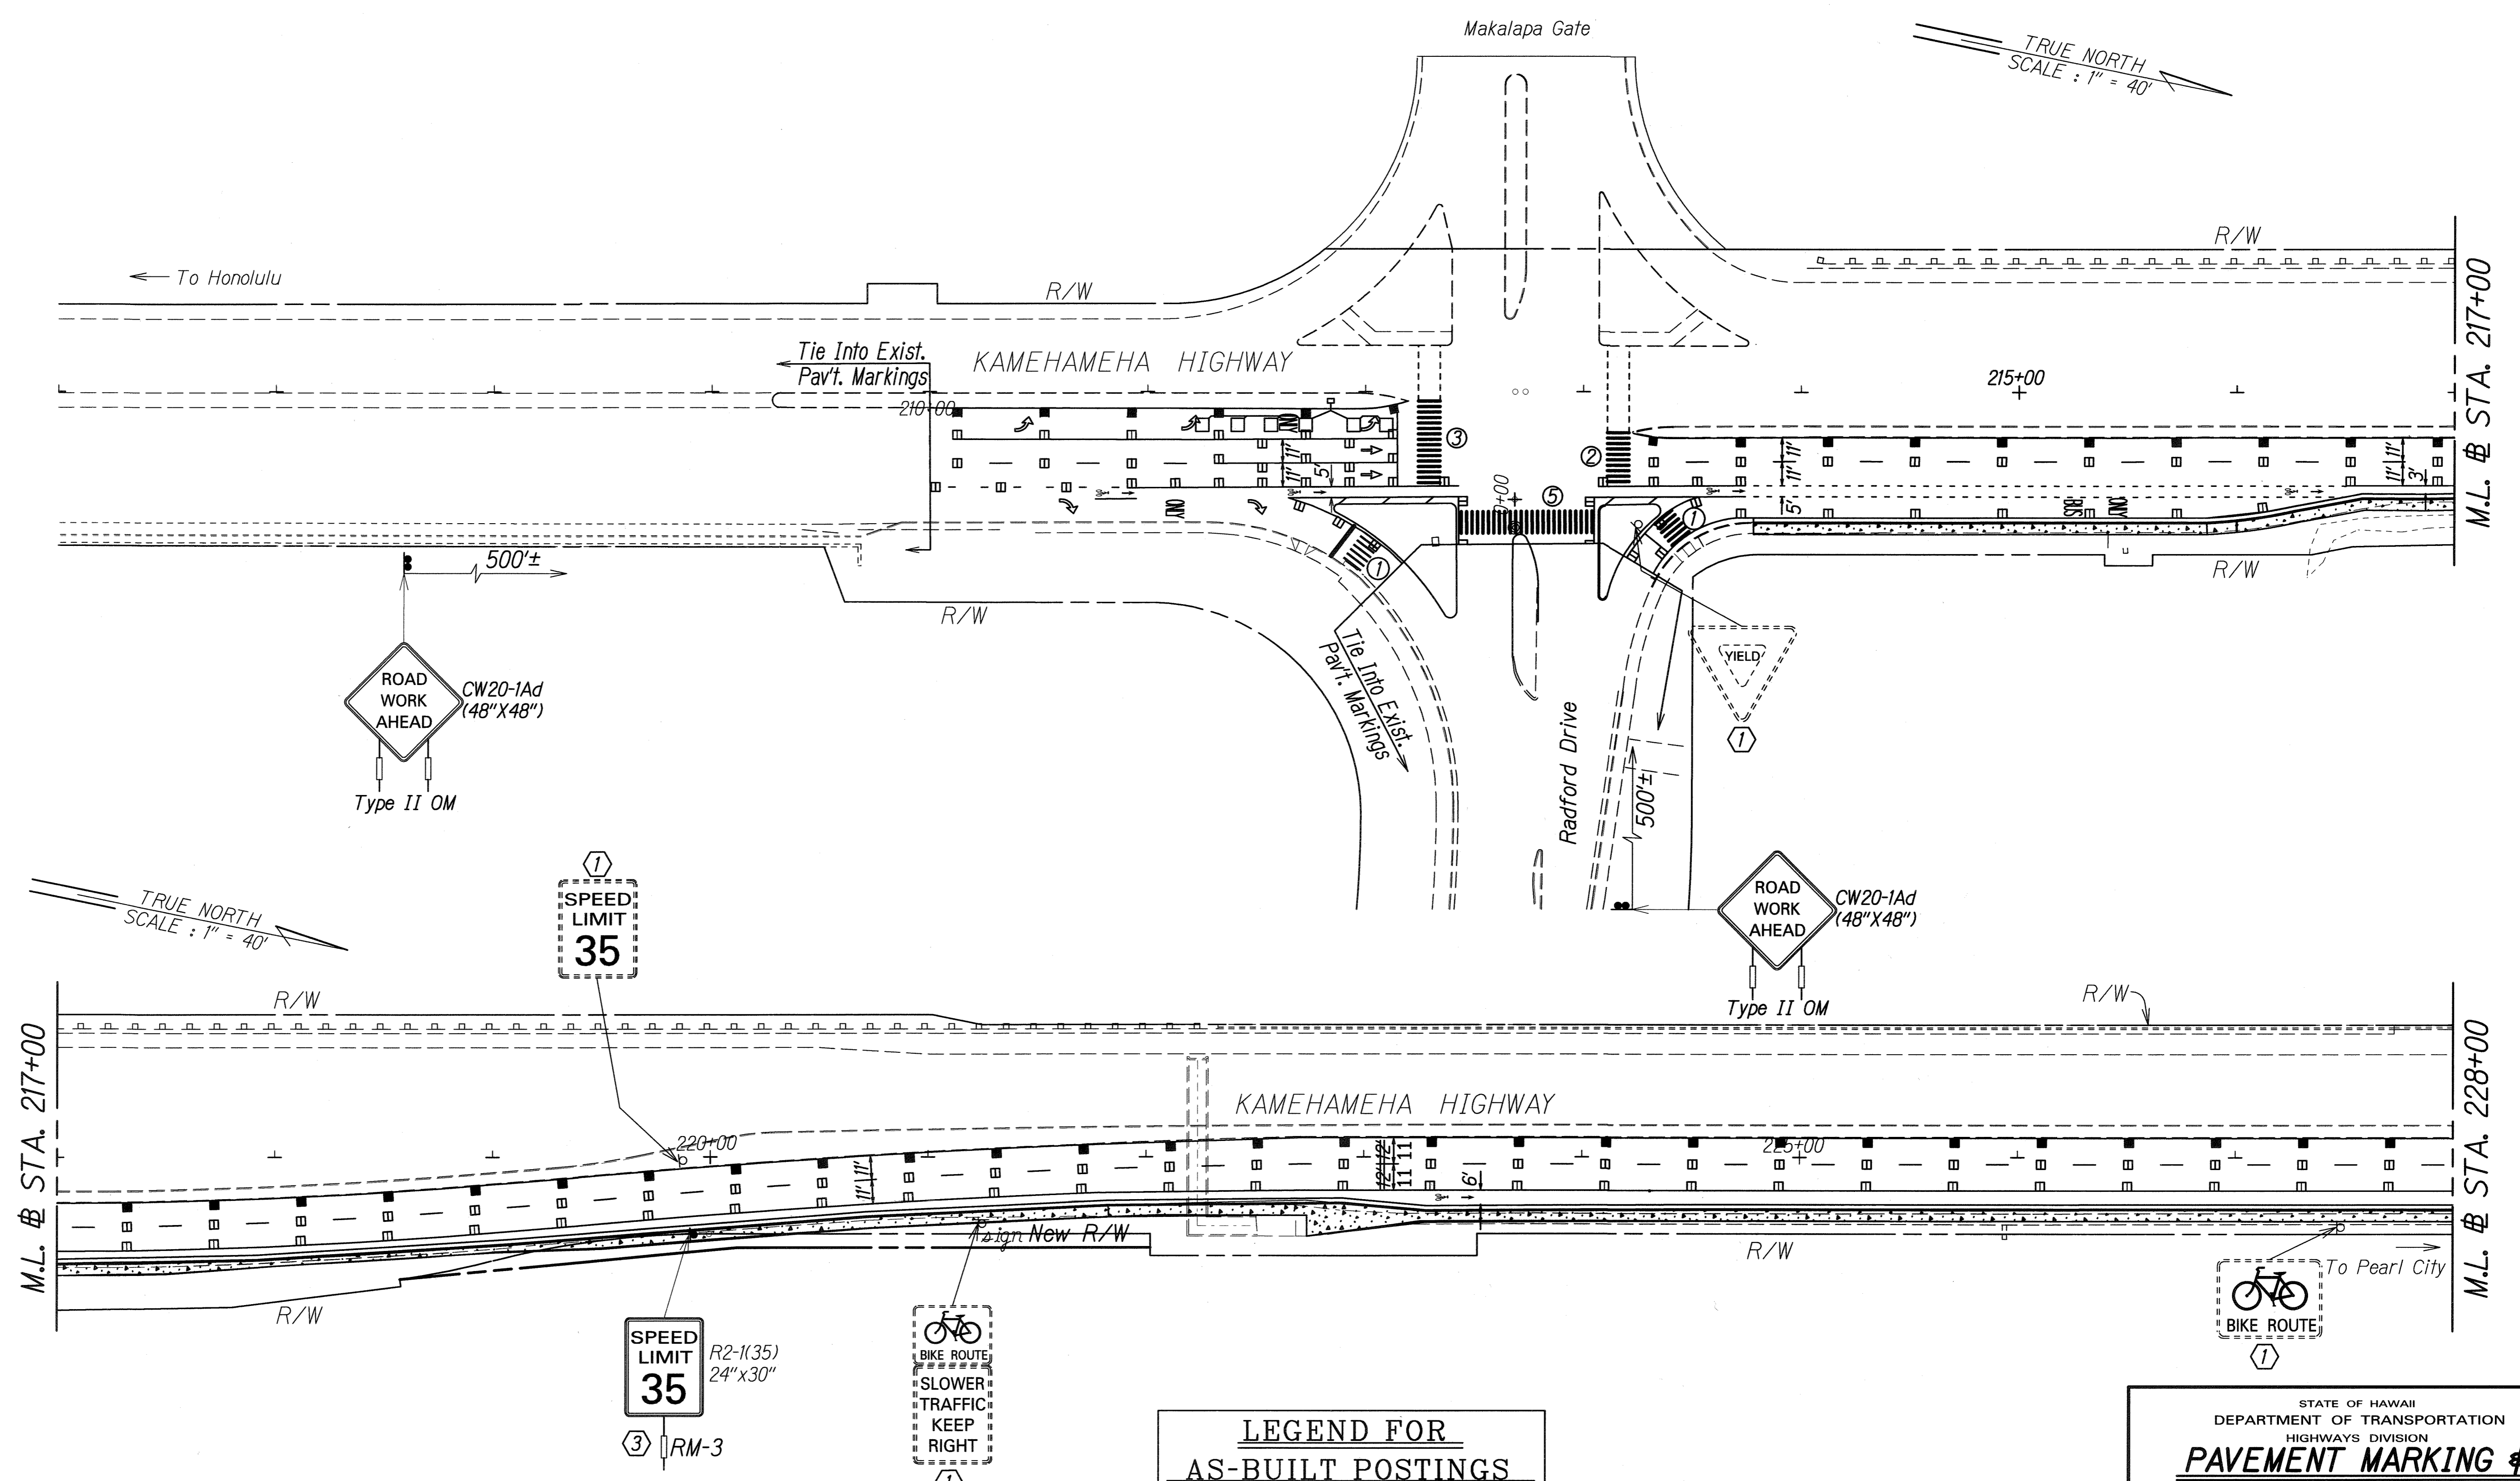

- KEY:**
- ① Exist. Sign(s) & Post(s) to Remain
 - ② Remove Exist. Sign(s) w/ Post(s)
 - ③ Install New Sign(s) w/Post(s)
 - ④ Remove Exist. Sign(s) & Post(s) & Install New Sign(s) w/Post(s)

LEGEND FOR AS-BUILT POSTINGS

	Squiggly line for as-built deletion
	Double line for as-built deletion
Roadway	Text for as-built posting

DATE	REVISION
1/14/05	Revised object markers on construction signs.

STATE OF HAWAII
DEPARTMENT OF TRANSPORTATION
HIGHWAYS DIVISION



PAVEMENT MARKING & SIGNING PLAN

KAMEHAMEHA HIGHWAY BIKEWAY
Vicinity of Radford Drive to Arizona Memorial
Federal Aid Project No. CMAQ-099-1(22)

Scale: 1"=40' Date: Feb., 2004
SHEET No. T4 OF 8 SHEETS


SURVEY PLOTTED BY	DATE
TRACED BY	
DESIGNED BY	
QUANTITIES BY	
CHECKED BY	

FED. ROAD DIST. NO.	STATE	FED. AID PROJ. NO.	FISCAL YEAR	SHEET NO.	TOTAL SHEETS
HAWAII	HAW.	CMAQ-099-1(22)	2005	34	60

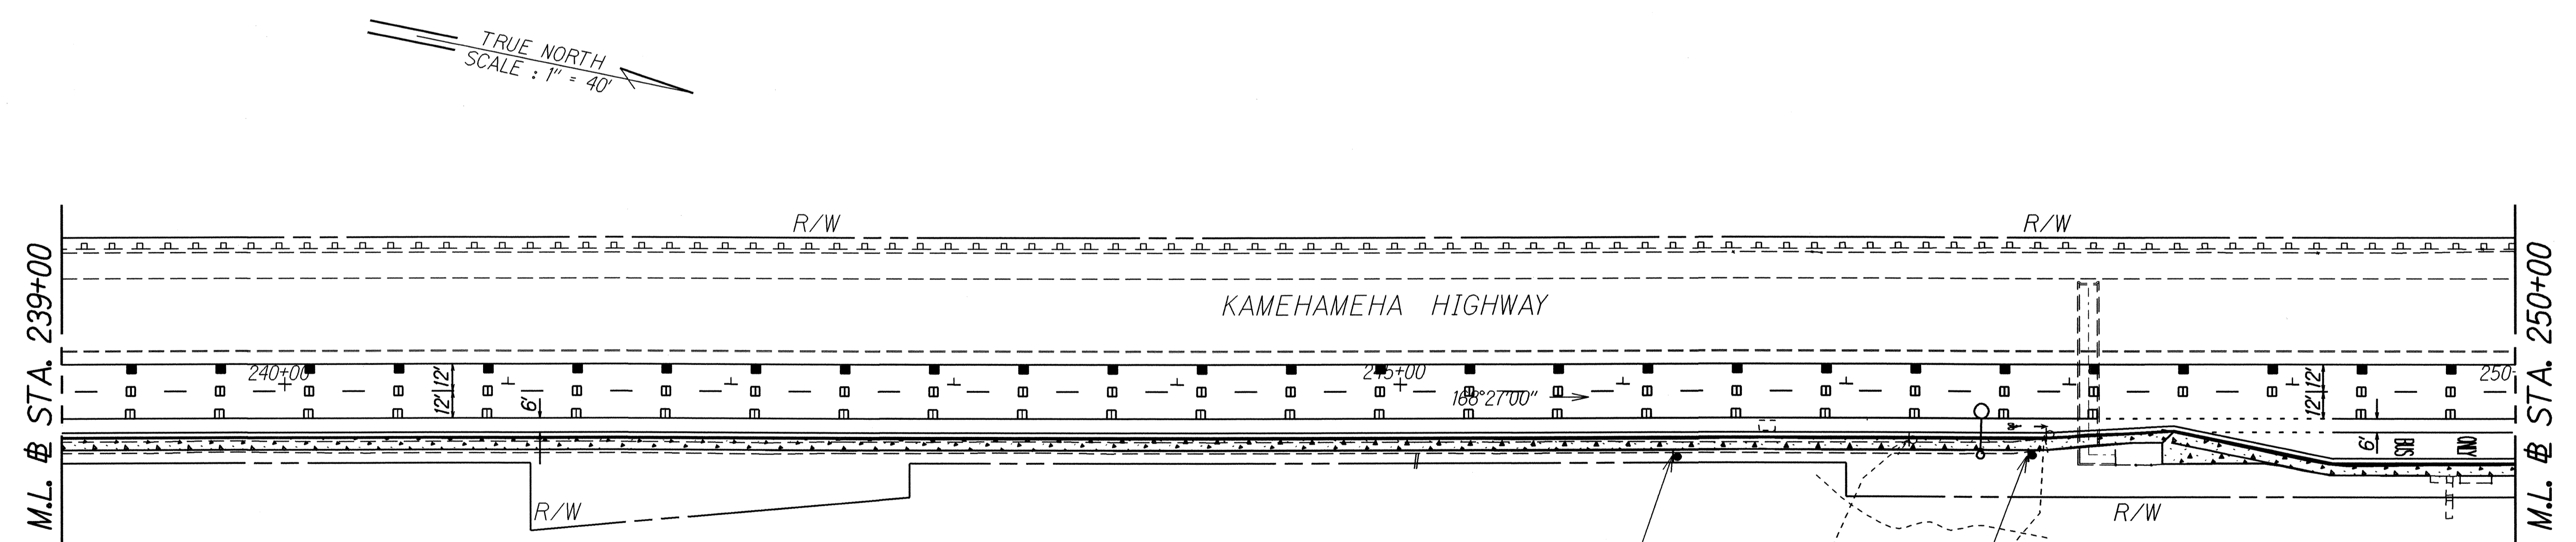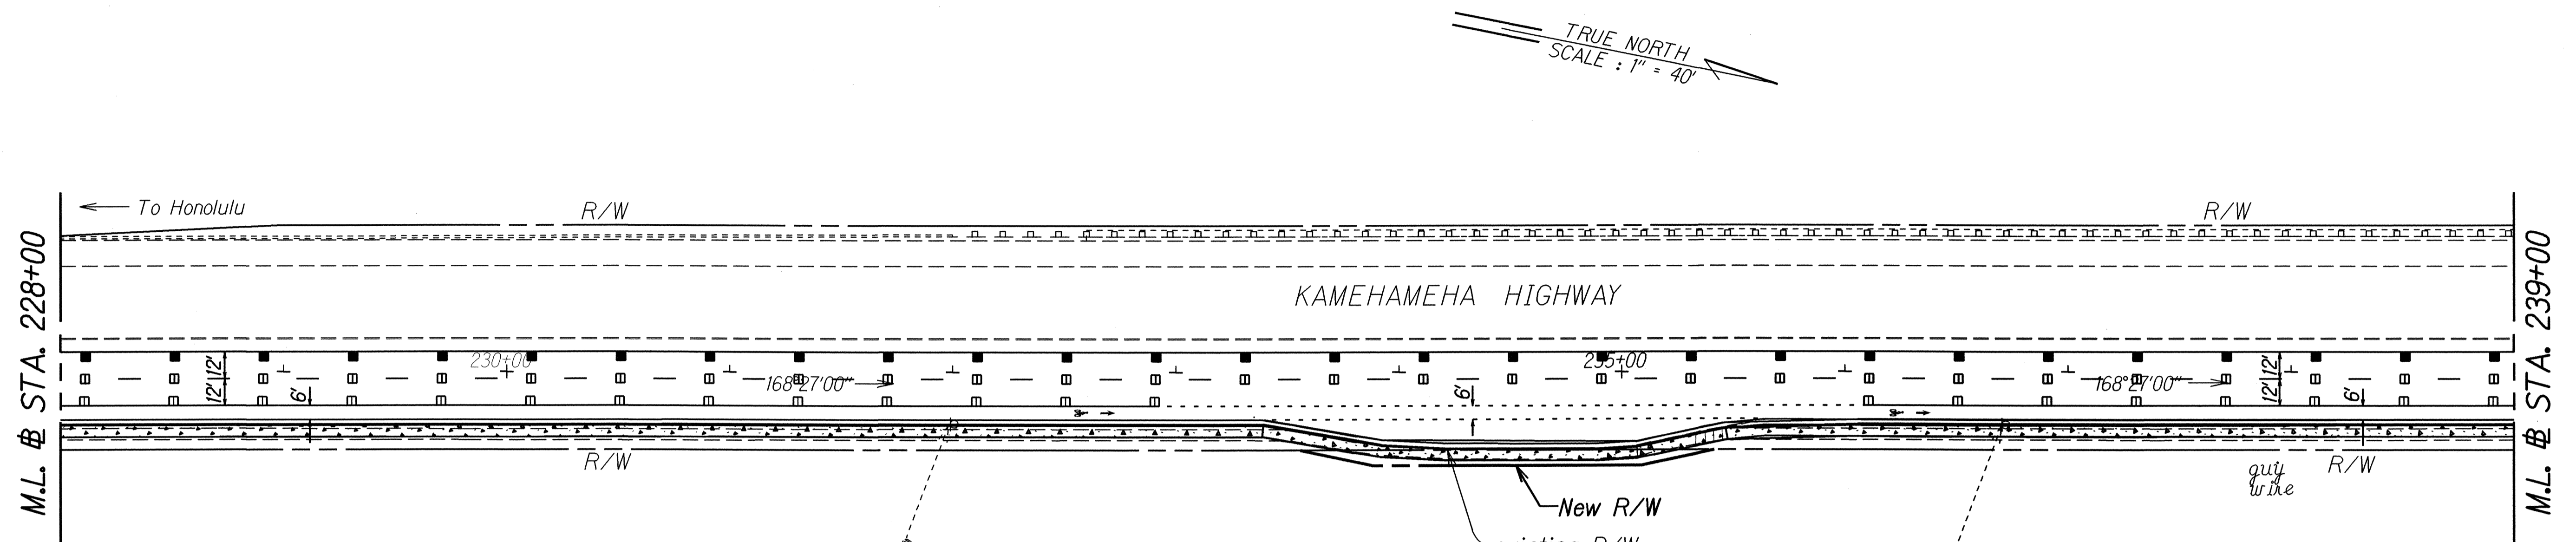

SURVEY PLOTTED BY	DATE
DRAWN BY	1/23/04
DESIGNED BY	
QUANTITIES BY	
CHECKED BY	

- KEY:**
- ① Exist. Sign(s) & Post(s) to Remain
 - ② Remove Exist. Sign(s) w/ Post(s)
 - ③ Install New Sign(s) w/Post(s)
 - ④ Remove Exist. Sign(s) & Post(s) & Install New Sign(s) w/Post(s)

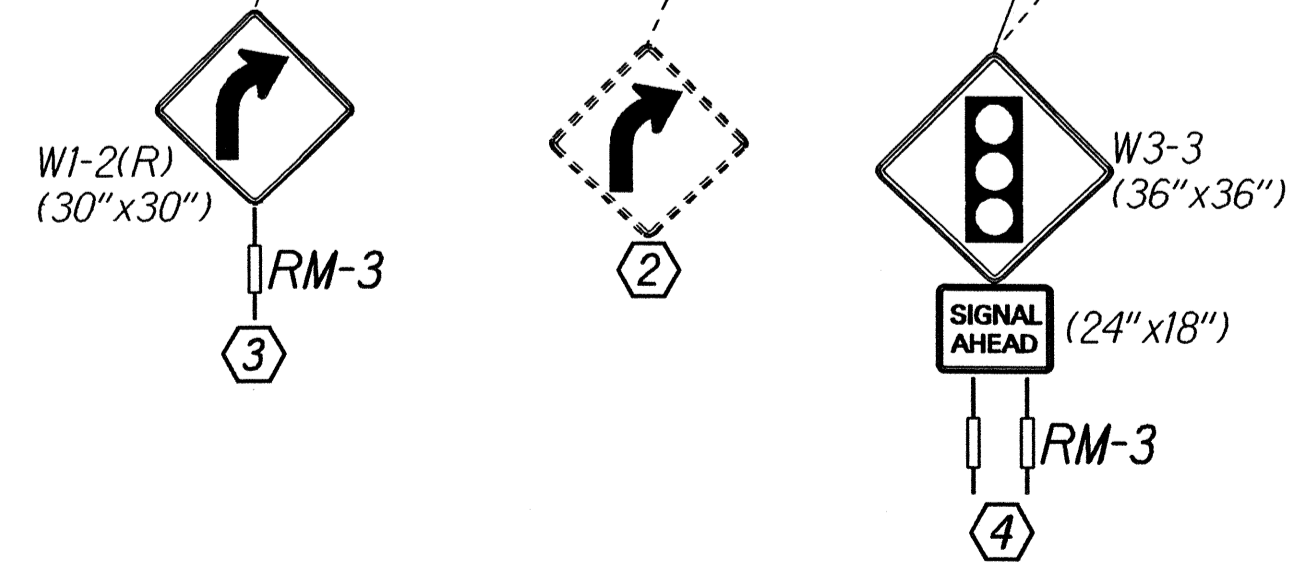

STATE OF HAWAII
DEPARTMENT OF TRANSPORTATION
HIGHWAYS DIVISION


PAVEMENT MARKING & SIGNING PLAN

KAMEHAMEHA HIGHWAY BIKEWAY
Vicinity of Radford Drive to Arizona Memorial
Federal Aid Project No. CMAQ-099-1(22)

Scale: 1"=40' Date: Feb., 2004

SHEET No. T5 OF 8 SHEETS

FED. ROAD DIST. NO.	STATE	FED. AID PROJ. NO.	FISCAL YEAR	SHEET NO.	TOTAL SHEETS
HAWAII	HAW.	CMAQ-099-1(22)	2005	ADD. 35	60

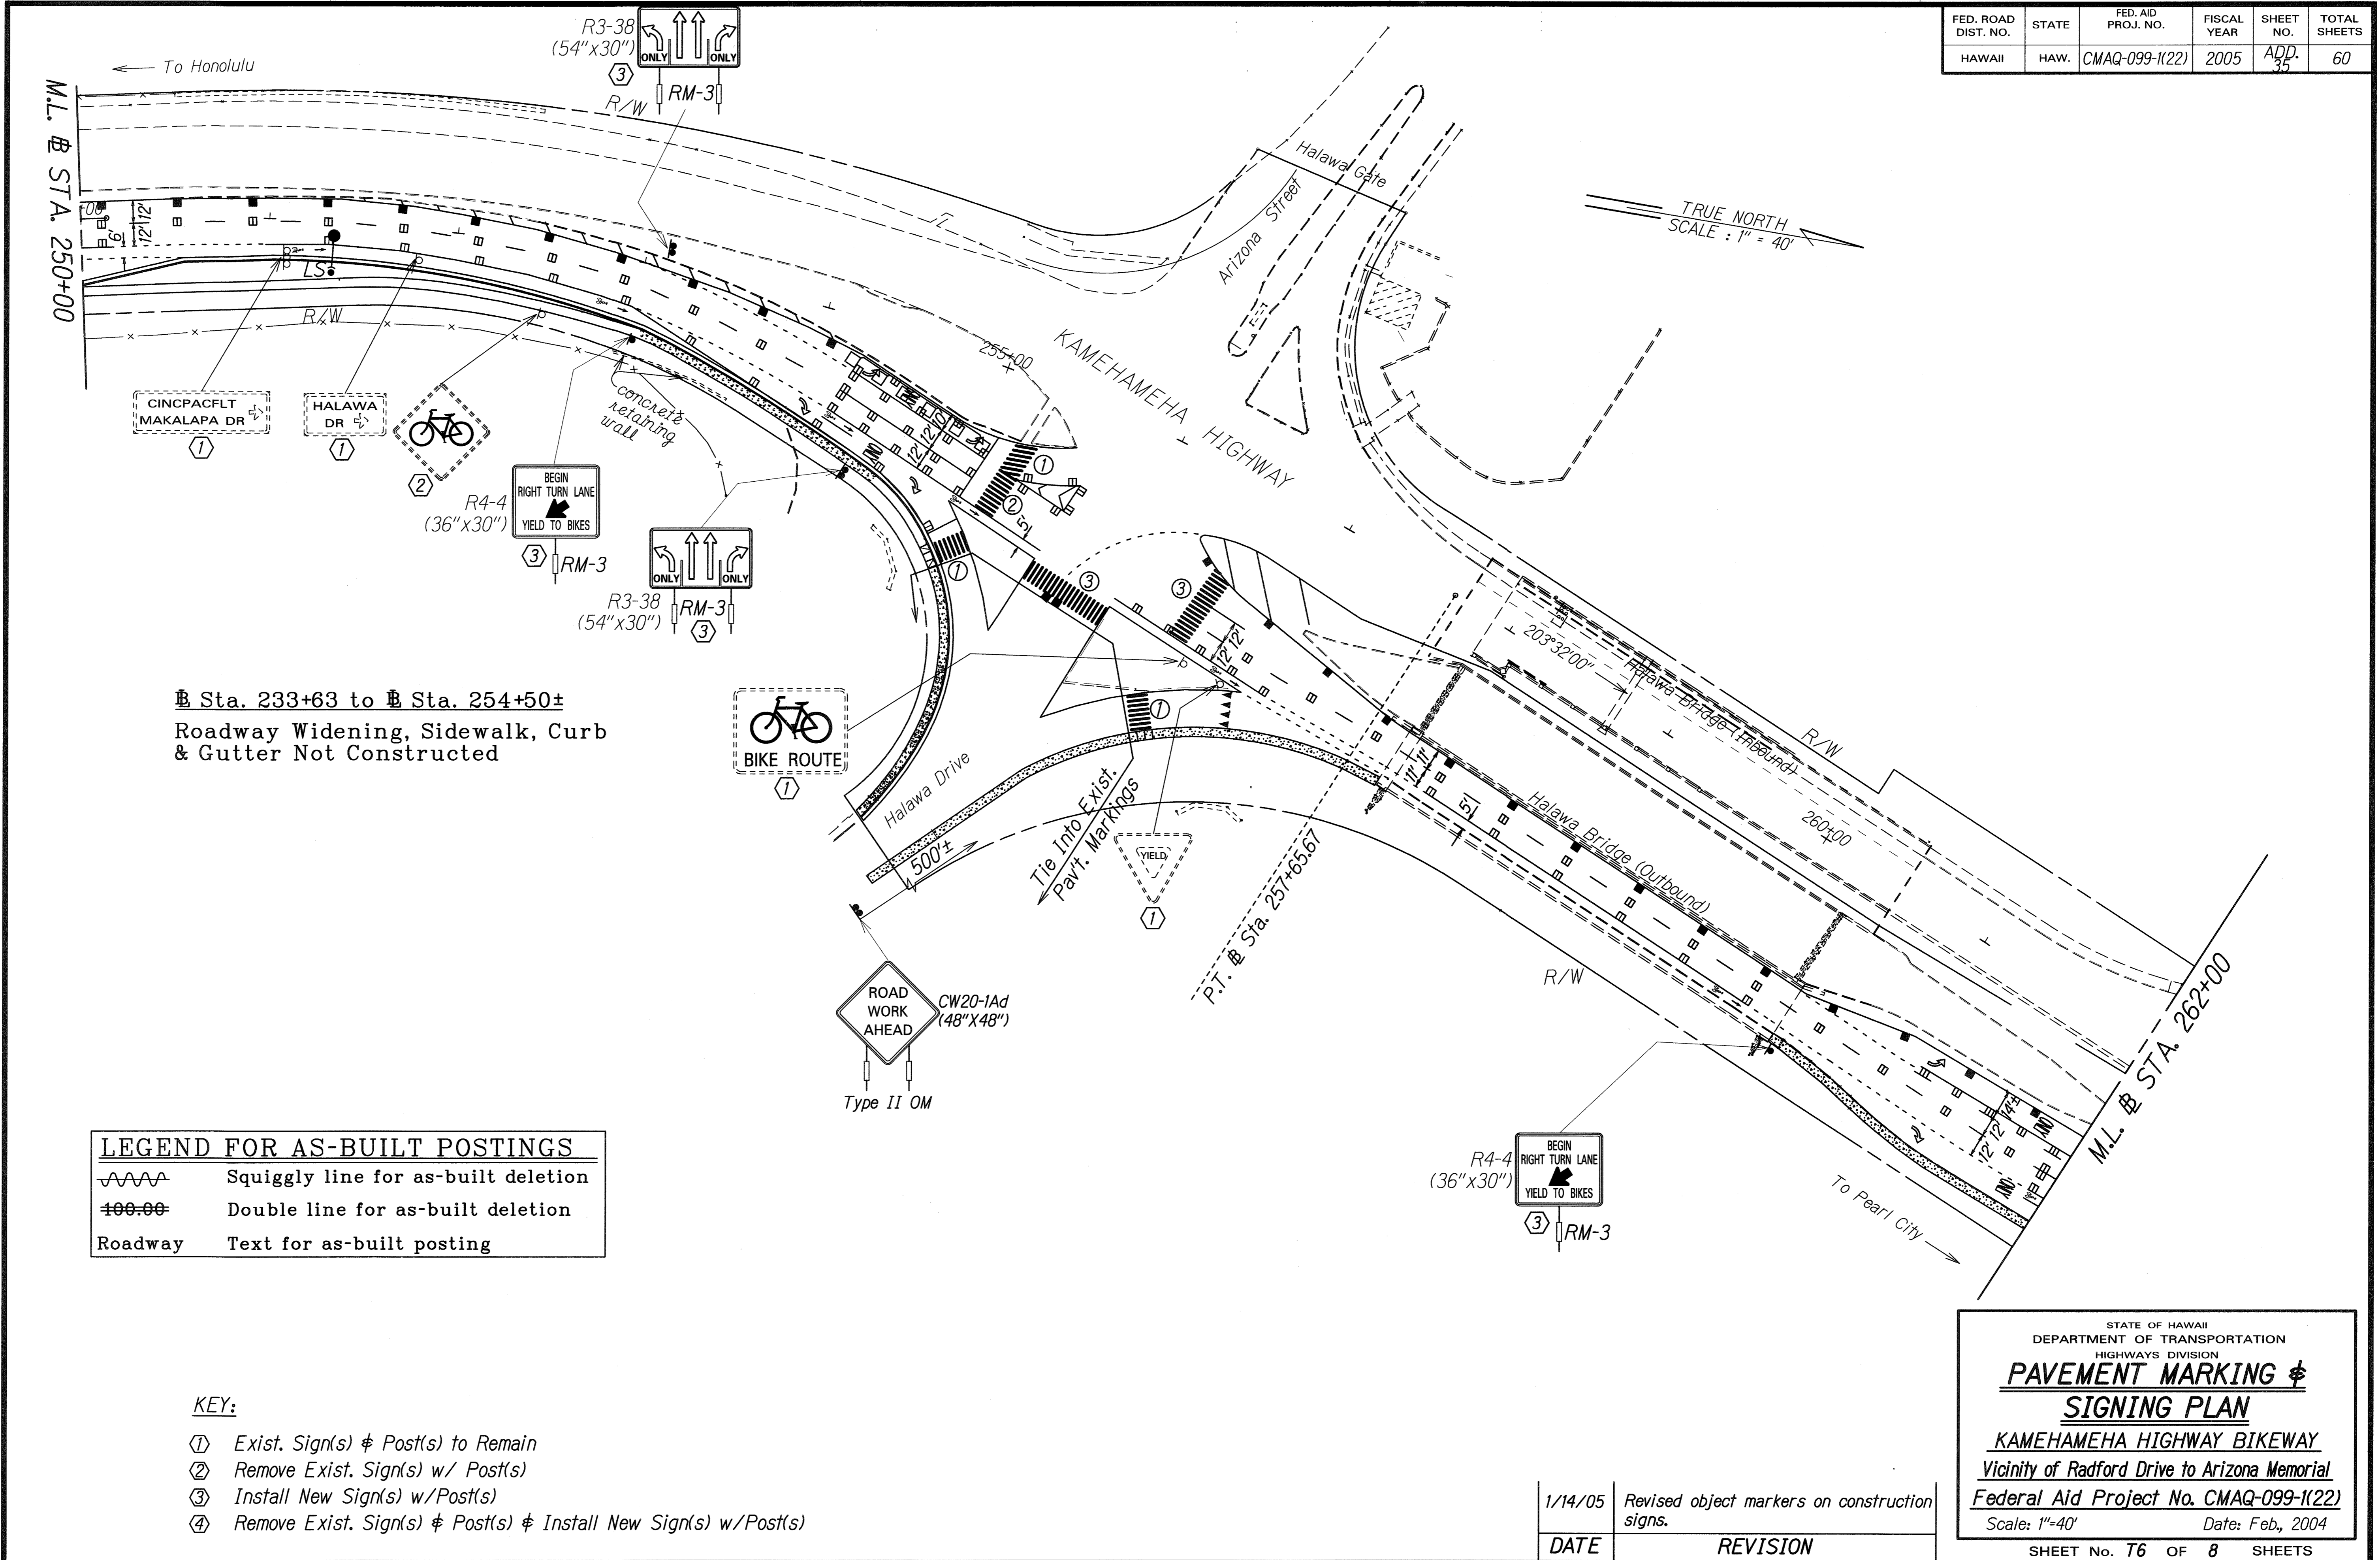

Sta. 233+63 to Sta. 254+50±
 Roadway Widening, Sidewalk, Curb & Gutter Not Constructed

LEGEND FOR AS-BUILT POSTINGS	
	Squiggly line for as-built deletion
	Double line for as-built deletion
Roadway	Text for as-built posting


- KEY:**
- ① Exist. Sign(s) & Post(s) to Remain
 - ② Remove Exist. Sign(s) w/ Post(s)
 - ③ Install New Sign(s) w/Post(s)
 - ④ Remove Exist. Sign(s) & Post(s) & Install New Sign(s) w/Post(s)

SURVEY PLOTTED BY	DATE
TRACED BY	
DESIGNED BY	
QUANTITIES BY	
CHECKED BY	

1/14/05	Revised object markers on construction signs.
DATE	REVISION

STATE OF HAWAII
 DEPARTMENT OF TRANSPORTATION
 HIGHWAYS DIVISION
PAVEMENT MARKING & SIGNING PLAN
KAMEHAMEHA HIGHWAY BIKEWAY
 Vicinity of Radford Drive to Arizona Memorial
 Federal Aid Project No. CMAQ-099-1(22)
 Scale: 1"=40' Date: Feb., 2004
 SHEET No. T6 OF 8 SHEETS

FED. ROAD DIST. NO.	STATE	FED. AID PROJ. NO.	FISCAL YEAR	SHEET NO.	TOTAL SHEETS
HAWAII	HAW.	CMAQ-099-1(22)	2005	ADD. 36	60

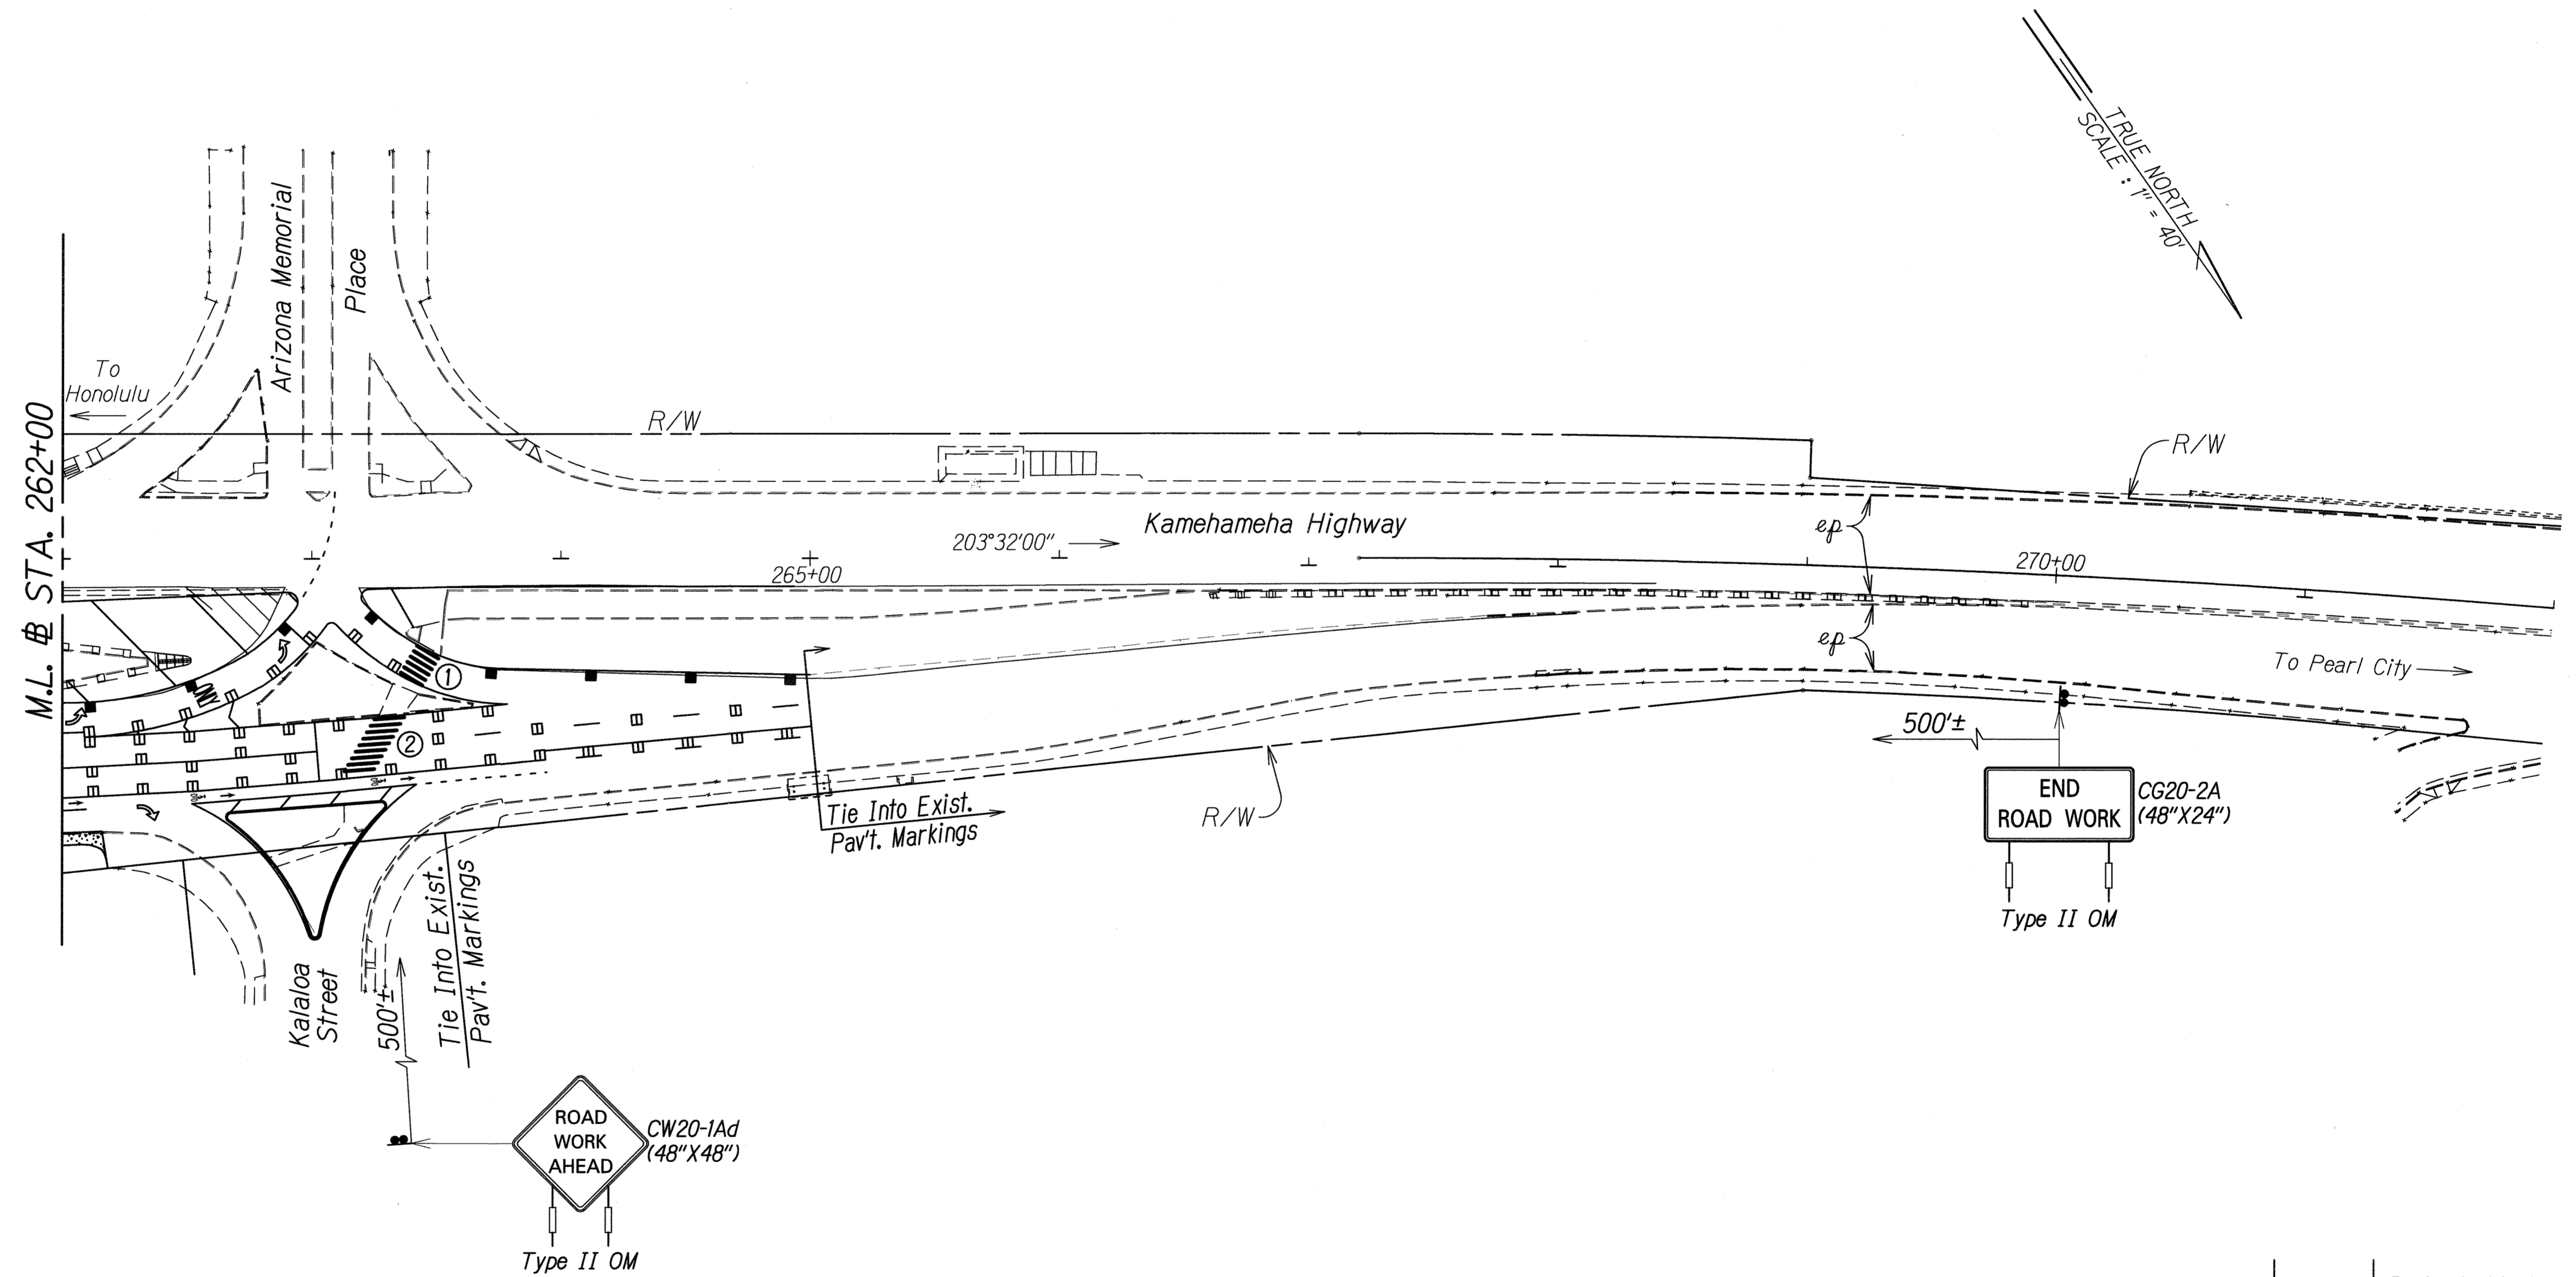


TRUE NORTH
SCALE: 1" = 40'

ORIGINAL PLAN	SURVEY PLOTTED BY	DATE
	TRACED BY	1/23/04
	DESIGNED BY	
	QUANTITIES BY	
	CHECKED BY	

LEGEND FOR AS-BUILT POSTINGS	
	Squiggly line for as-built deletion
	Double line for as-built deletion
Roadway	Text for as-built posting


1/14/05	Revised object markers on construction signs.
DATE	REVISION
STATE OF HAWAII DEPARTMENT OF TRANSPORTATION HIGHWAYS DIVISION PAVEMENT MARKING & SIGNING PLAN KAMEHAMEHA HIGHWAY BIKEWAY Vicinity of Radford Drive to Arizona Memorial Federal Aid Project No. CMAQ-099-1(22) Scale: 1"=40' Date: Feb., 2004 SHEET No. 77 OF 8 SHEETS	

FED. ROAD DIST. NO.	STATE	FED. AID PROJ. NO.	FISCAL YEAR	SHEET NO.	TOTAL SHEETS
HAWAII	HAW.	CMAQ-099-1(22)	2005	37	60

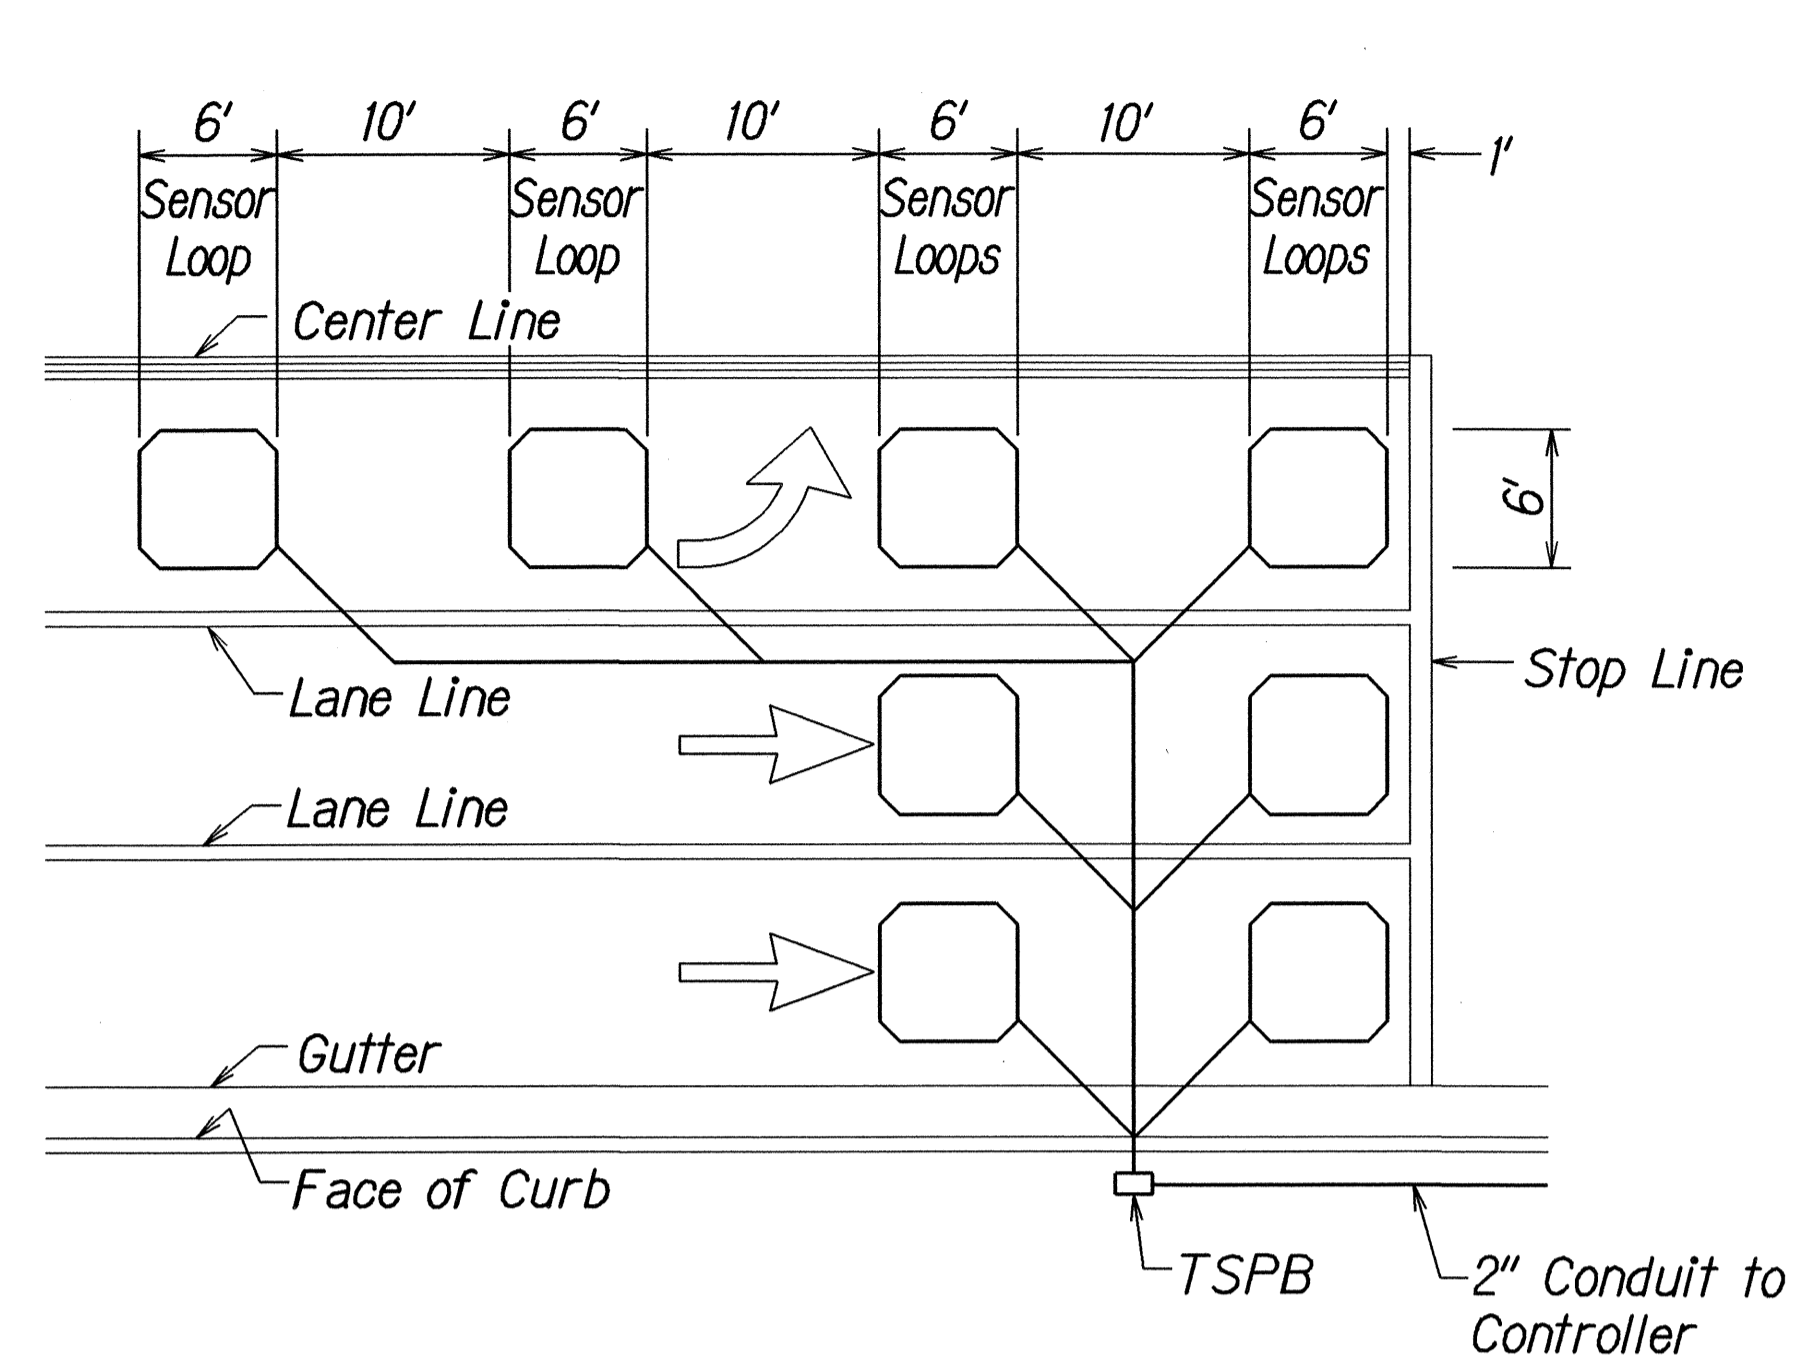


- NOTES:**
- Center sensor loops in lanes.
 - Collector cables shall be twisted 2 turns per foot.
 - Number of loops and locations vary. See project plans.
 - Number and locations of collector sawcuts may be varied in the field to suit.

TYPICAL SENSOR LOOP LAYOUT

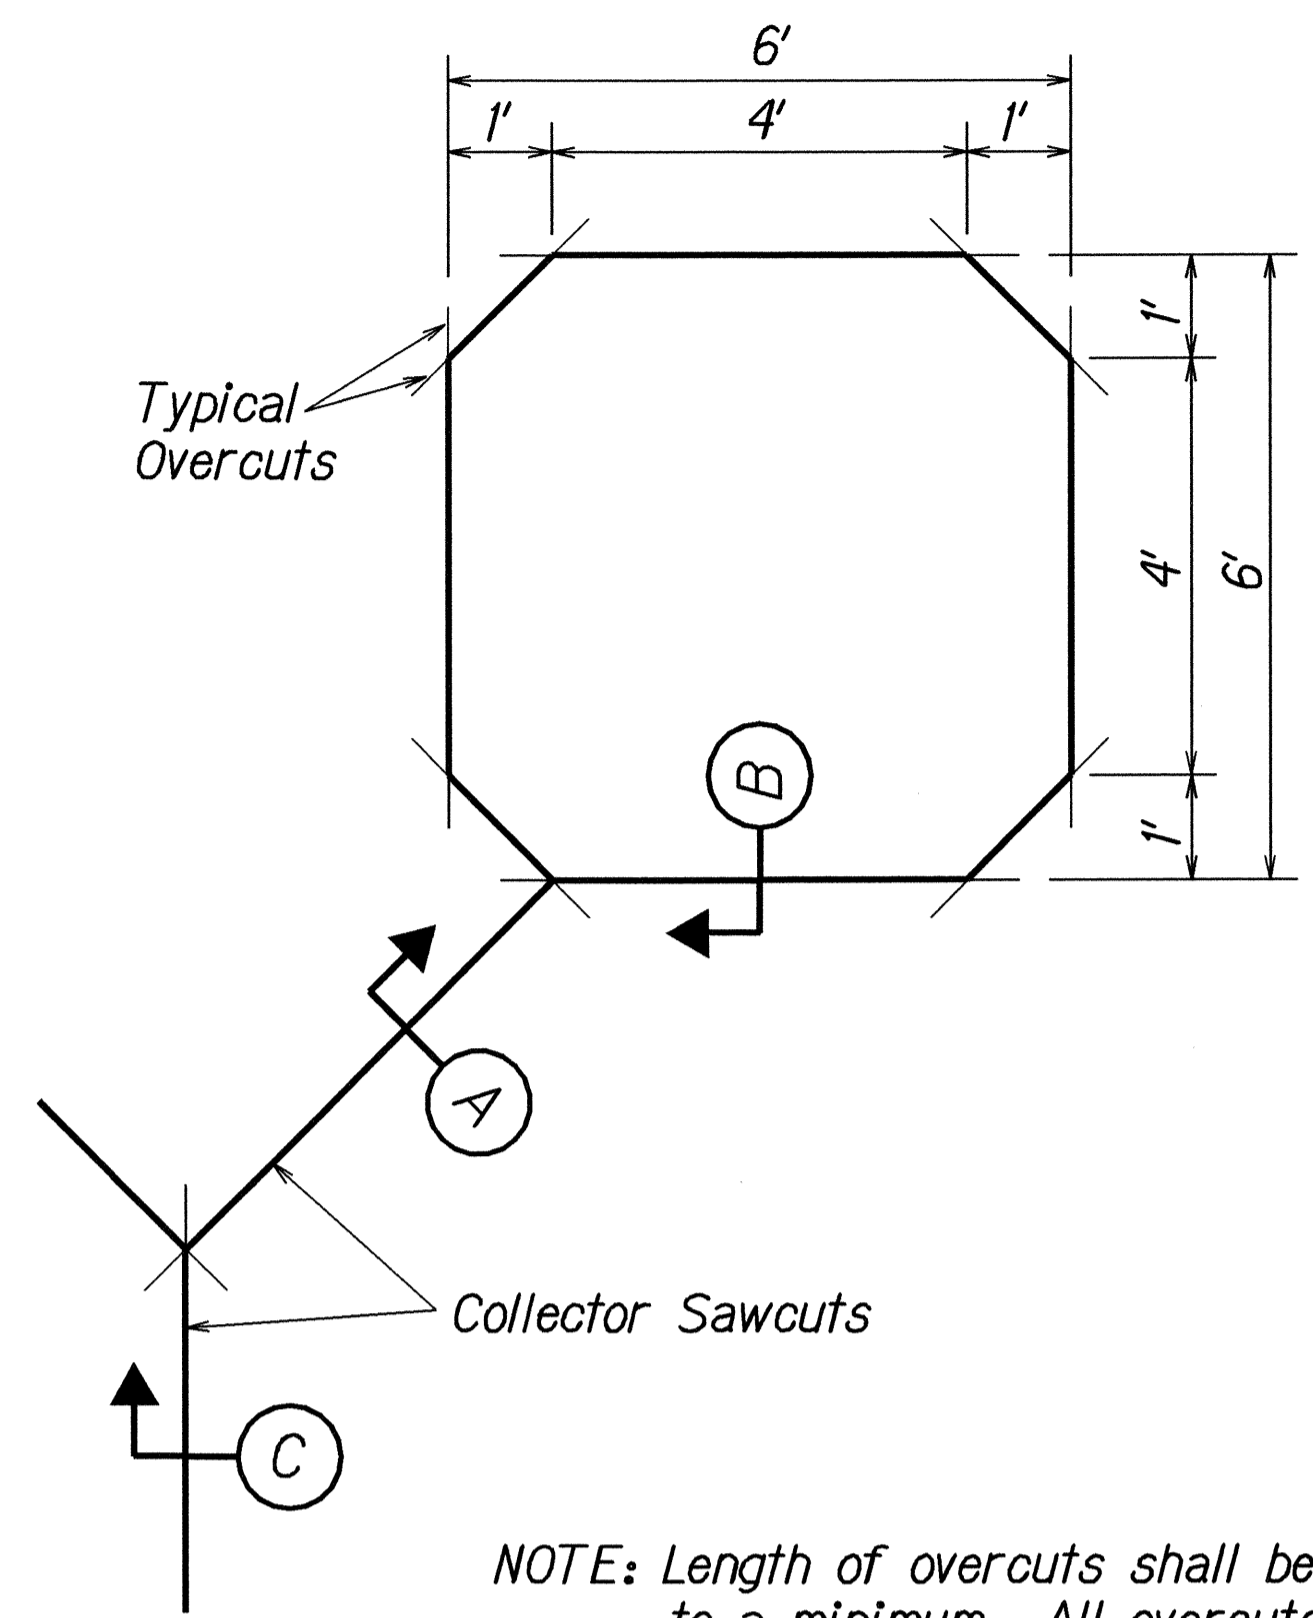


NOTE: Length of overcuts shall be kept to a minimum. All overcuts shall be back filled with hot tar.

TYPICAL SENSOR LOOP SAWCUT DETAIL

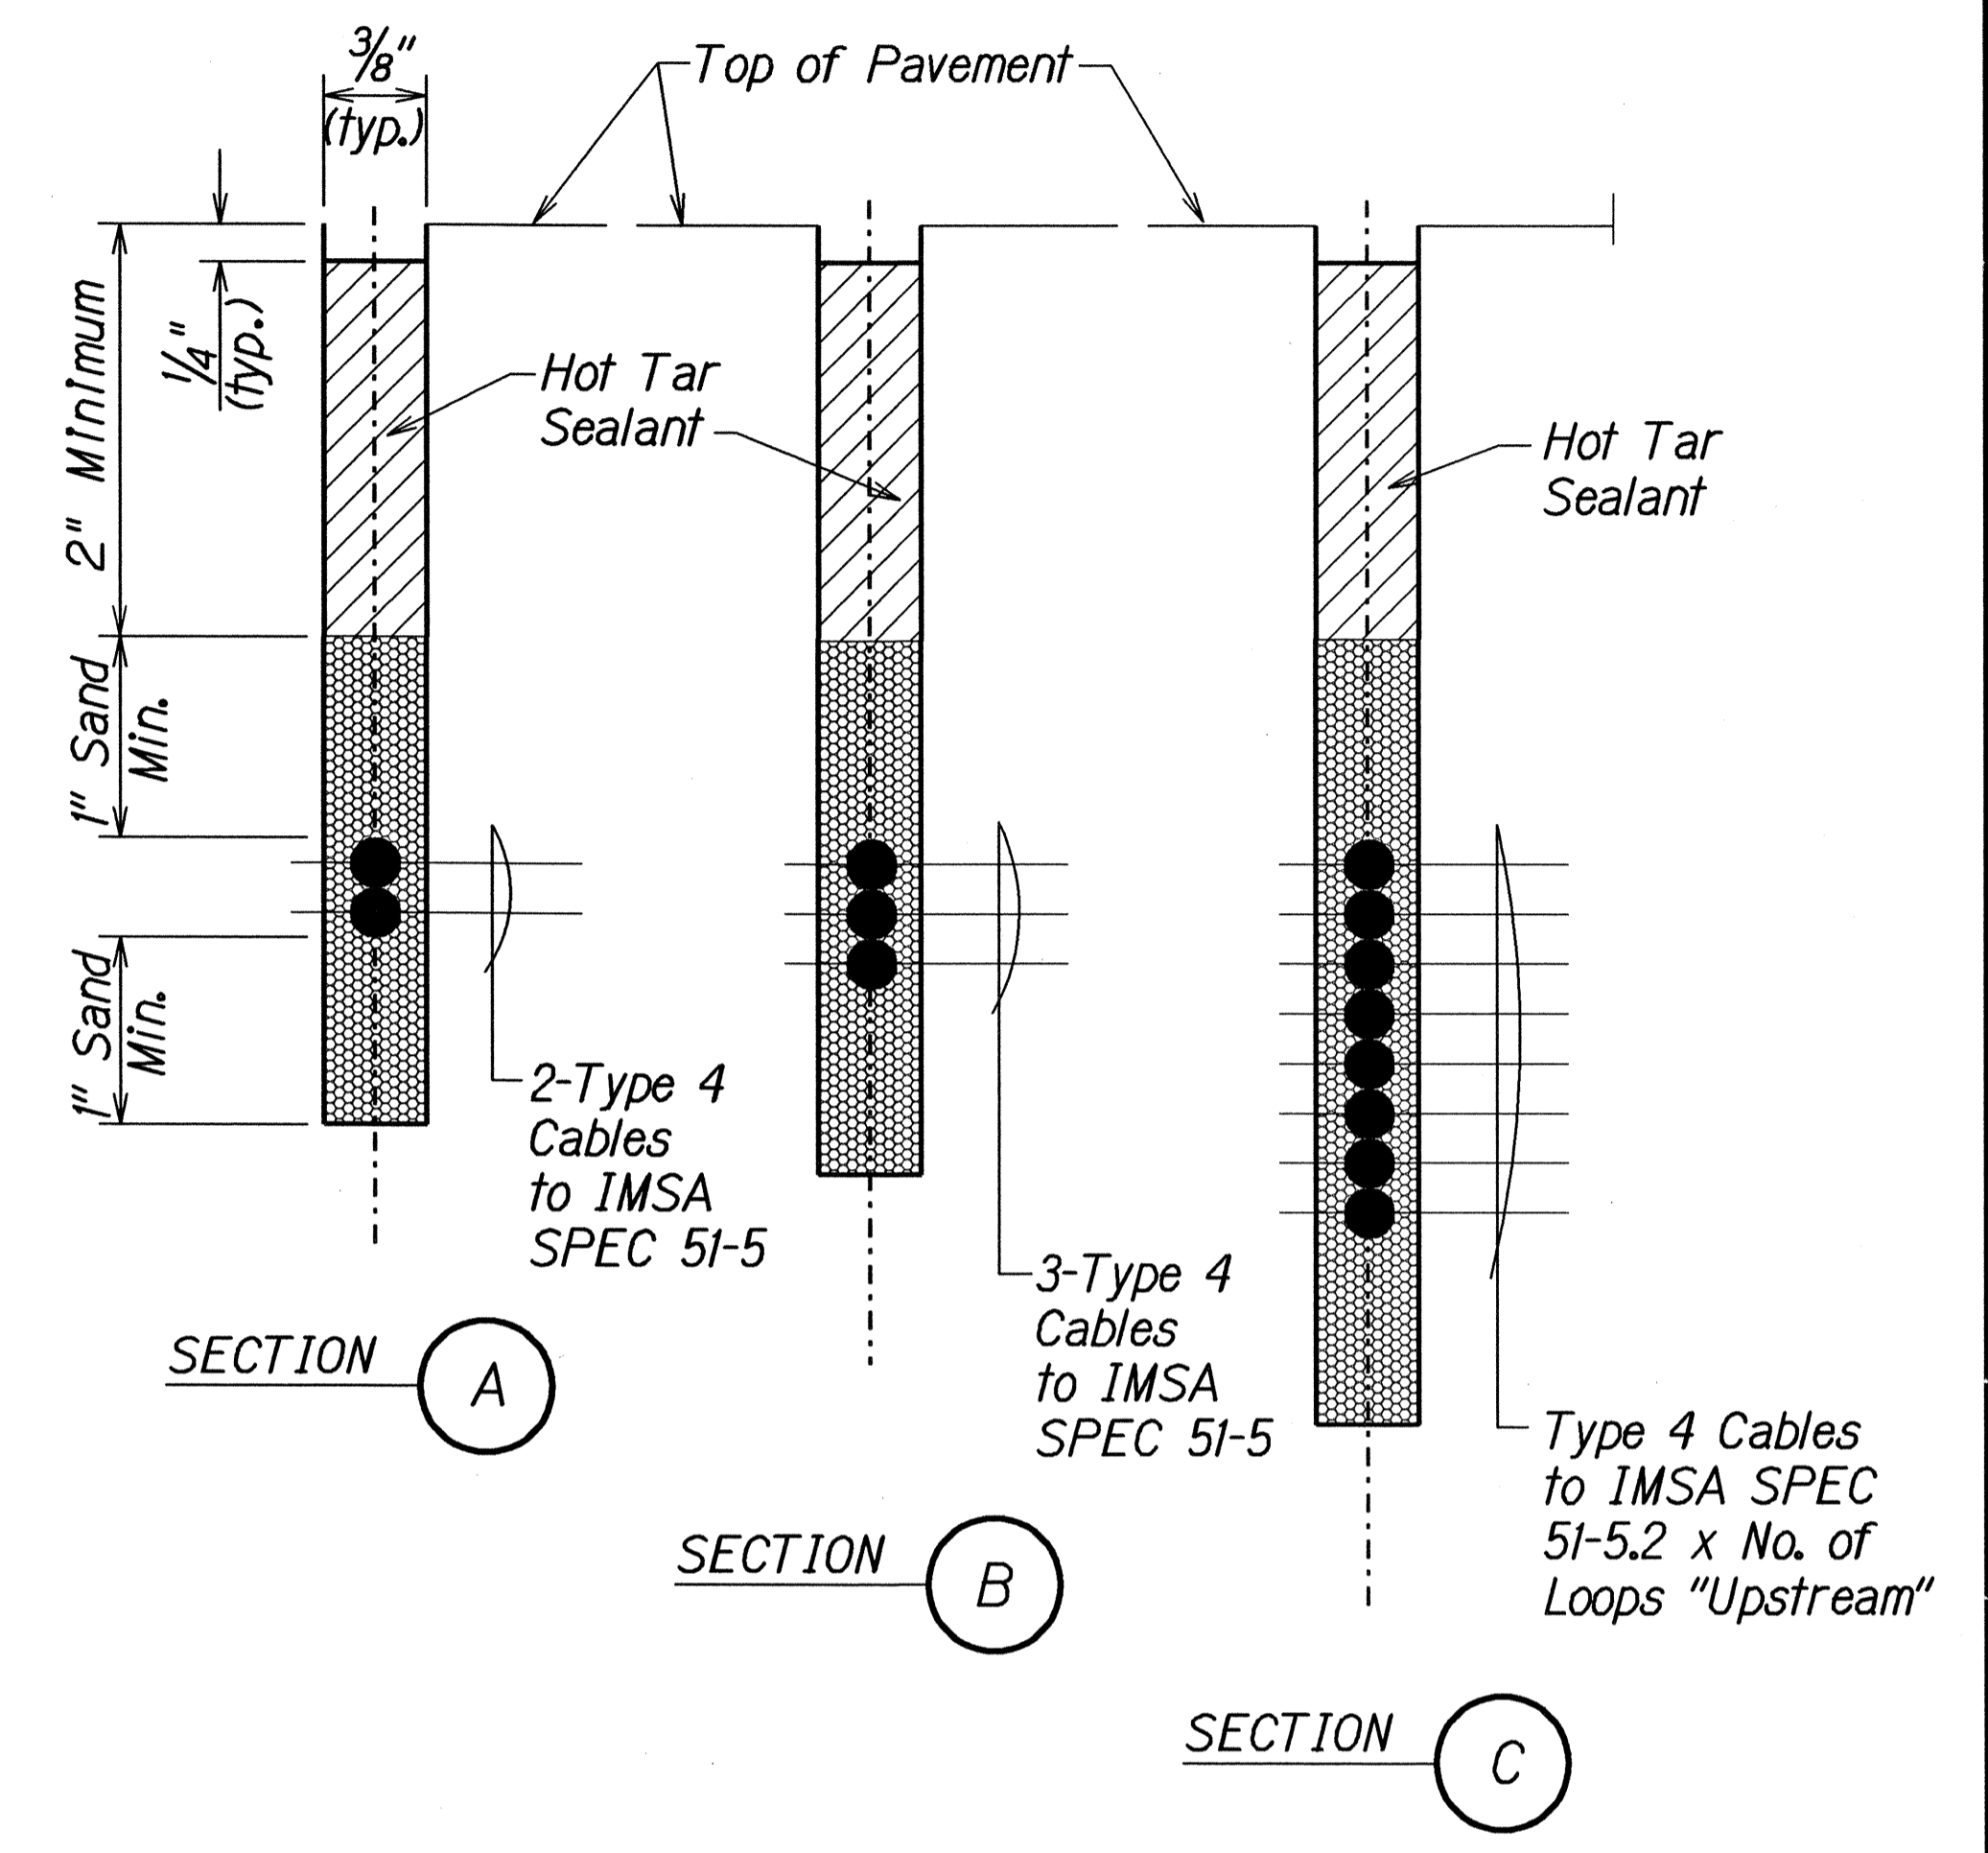


TYPICAL SECTION THROUGH SENSOR LOOP

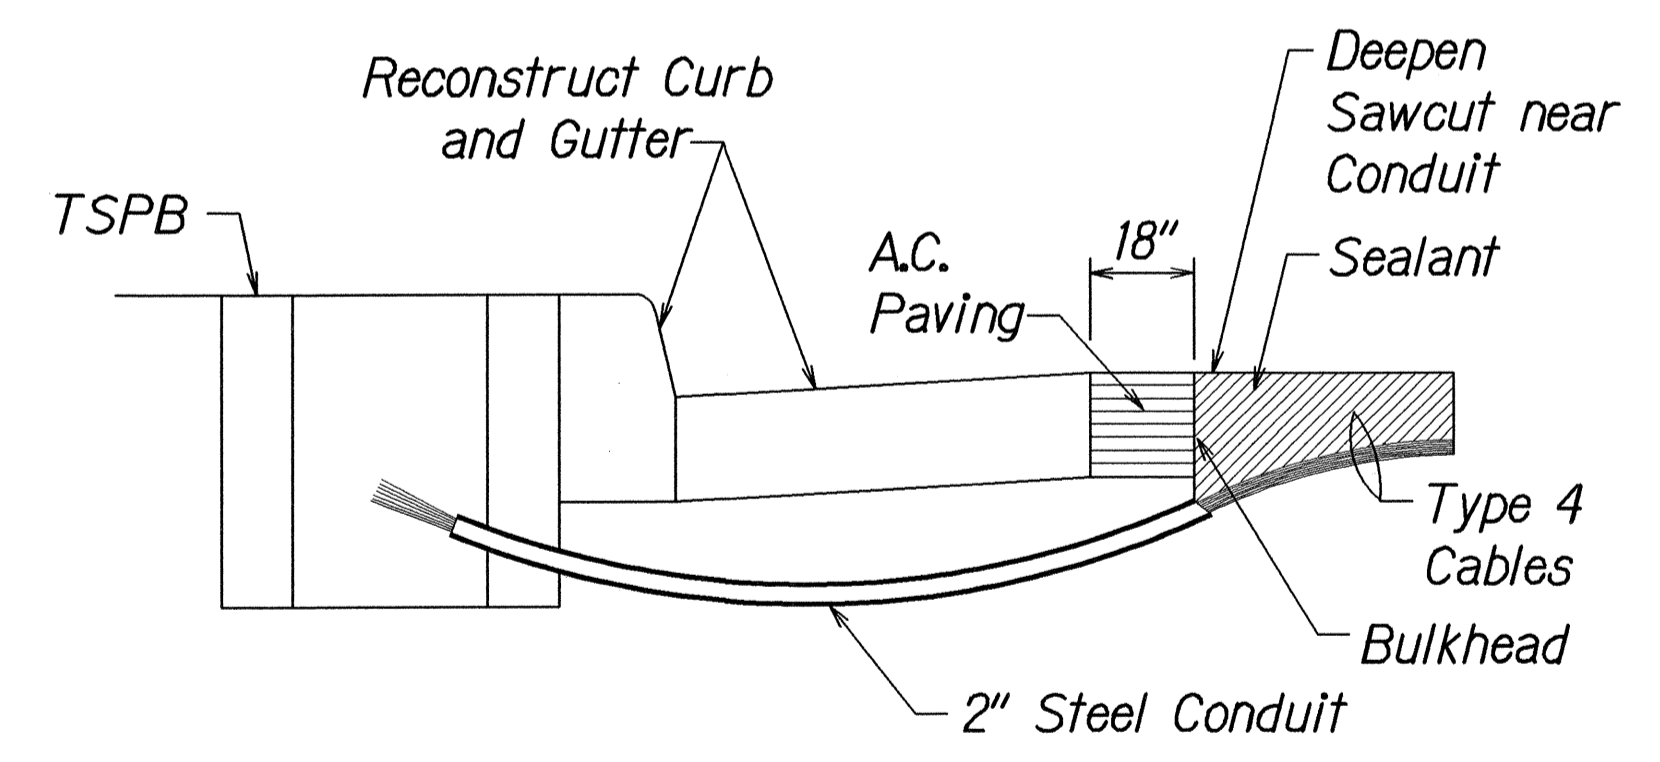

- NOTES ON CONSTRUCTION AT END OF SAWCUT**
- Seal roadway end of conduit after installation of conductors.
 - Install bulkhead across conduit trench.
 - Place hot tar in sawcut.
 - Backfill over conduit with new A.C.
 - Reconstruct curb and gutter as required.

DETAIL OF SENSOR LOOP INSTALLATION AT EDGE OF ROADWAY

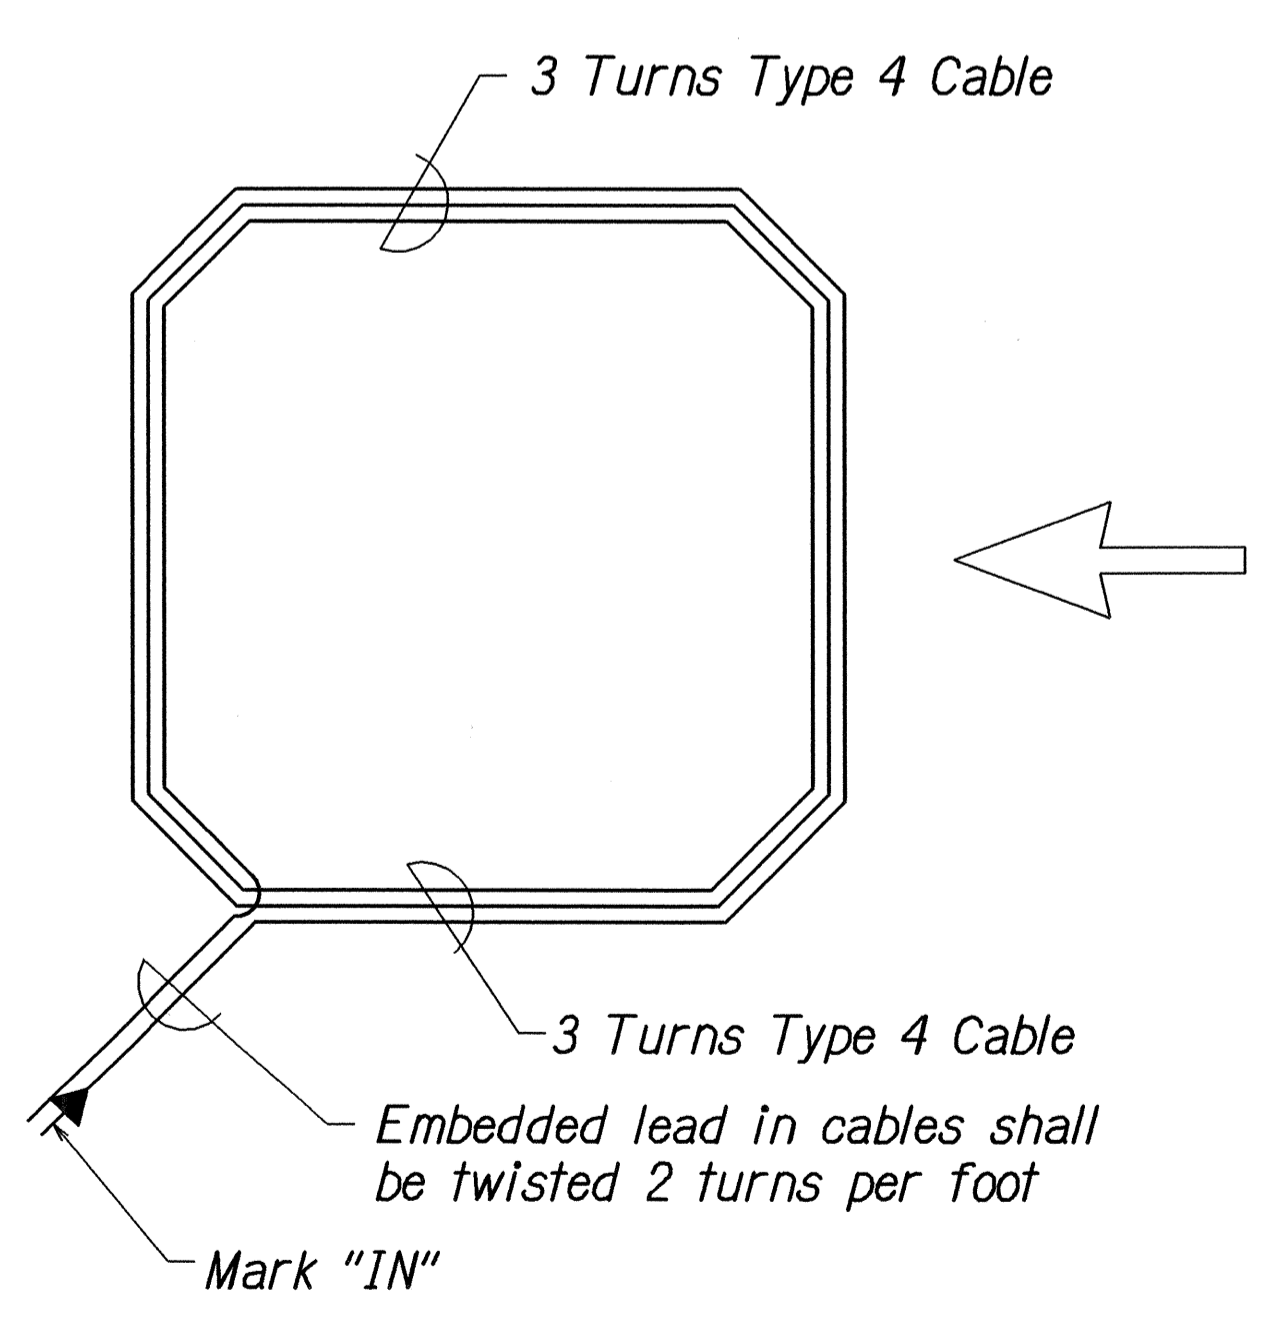

TYPICAL SENSOR LOOP WIRING DIAGRAM

SURVEY PLOTTED BY	DATE
DRAWN BY	
DESIGNED BY	
QUANTITIES BY	
CHECKED BY	
ORIGINAL PLAN	
NOTE BOOK	
1/22/04	
1/22/04	

STATE OF HAWAII
DEPARTMENT OF TRANSPORTATION
HIGHWAYS DIVISION


LOOP DETECTOR DETAILS

KAMEHAMEHA HIGHWAY BIKEWAY
Vicinity of Radford Drive to Arizona Memorial
Federal Aid Project No. CMAQ-099-1(22)

Not to Scale Date: February 2004

SHEET No. 78 OF 8 SHEETS


FED. ROAD DIST. NO.	STATE	FED. AID PROJ. NO.	FISCAL YEAR	SHEET NO.	TOTAL SHEETS
HAWAII	HAW.	CMAQ-099-1(22)	2005	C.O. 37 S-1	60

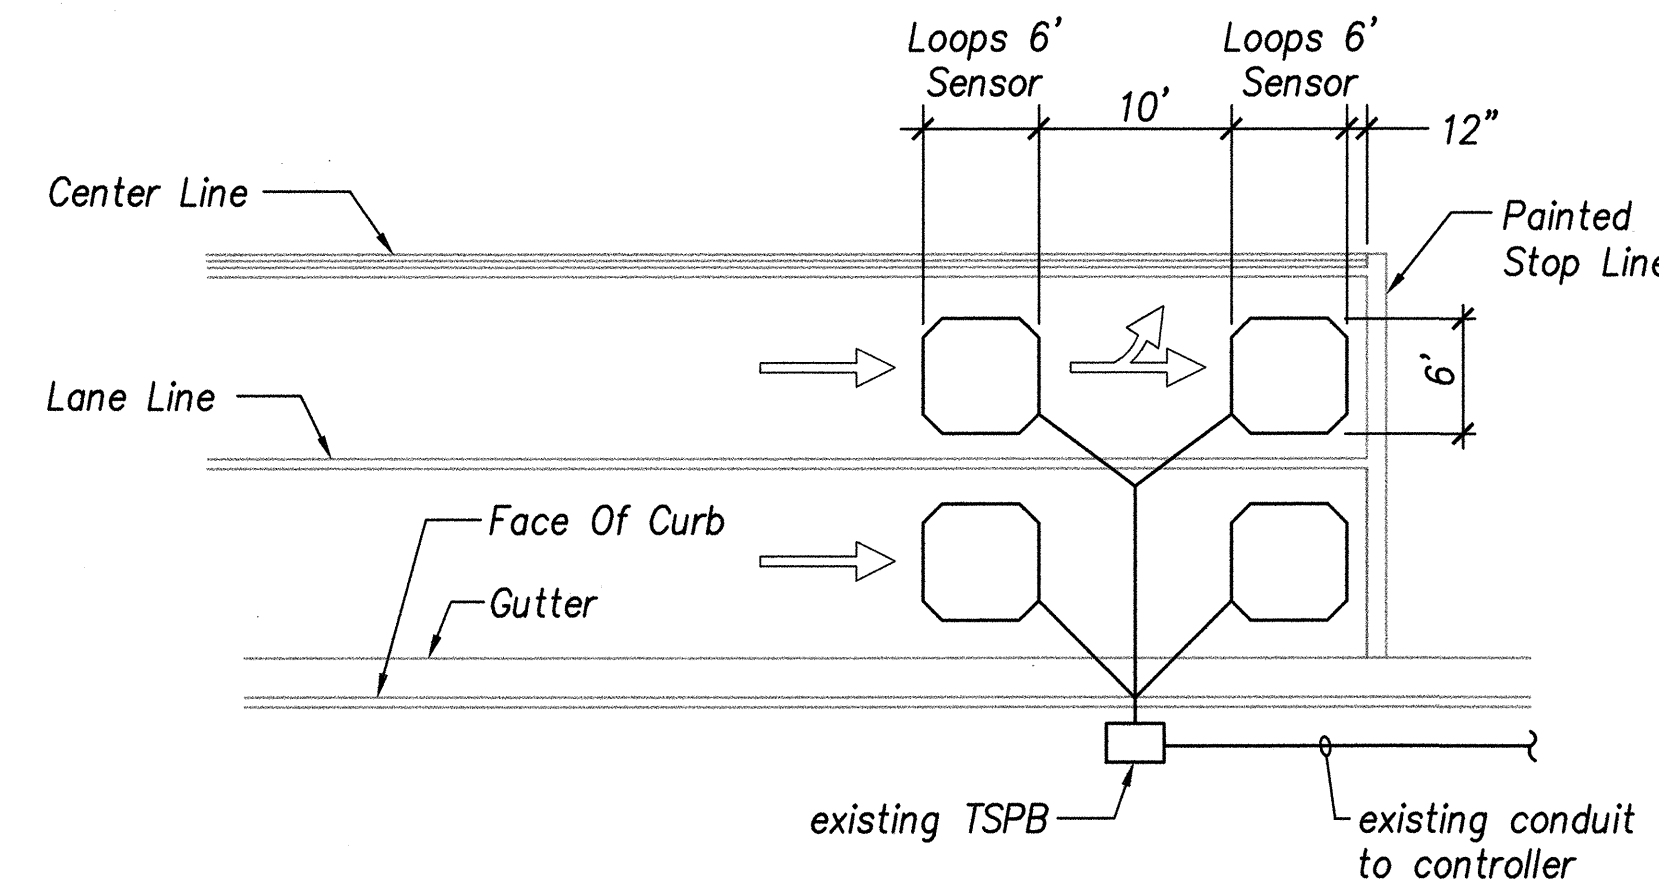

NOTES:

- Center sensor loops in lanes.
- Collector cables shall be twisted 2 turns per foot.
- Number of loops and locations vary. See project plans.
- Number and locations of collector sawcuts may be varied in the field to suit.
- Coordinate final location of sensors with civil striping plan.



1 TYPICAL SENSOR LOOP LAYOUT
S-1 Not to scale

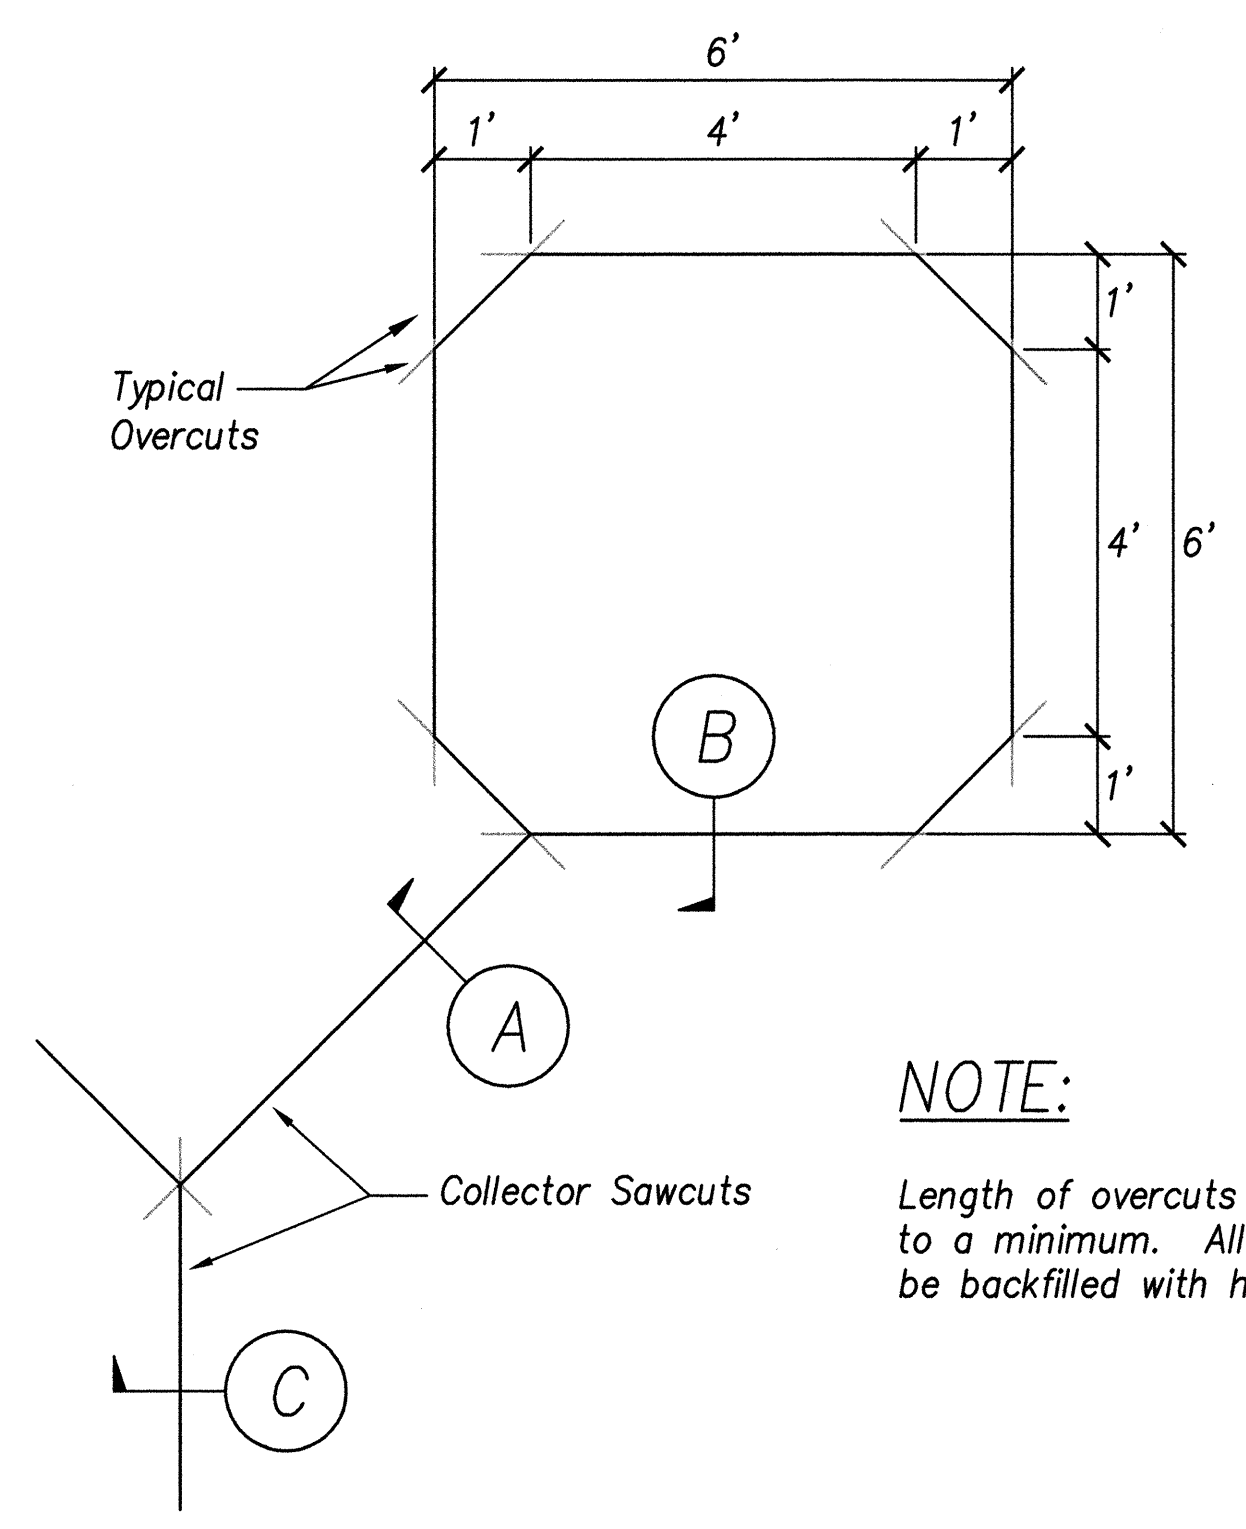

NOTE:

Length of overcuts shall be kept to a minimum. All overcuts shall be backfilled with hot tar.


TYPICAL SENSOR LOOP SAWCUT DETAIL

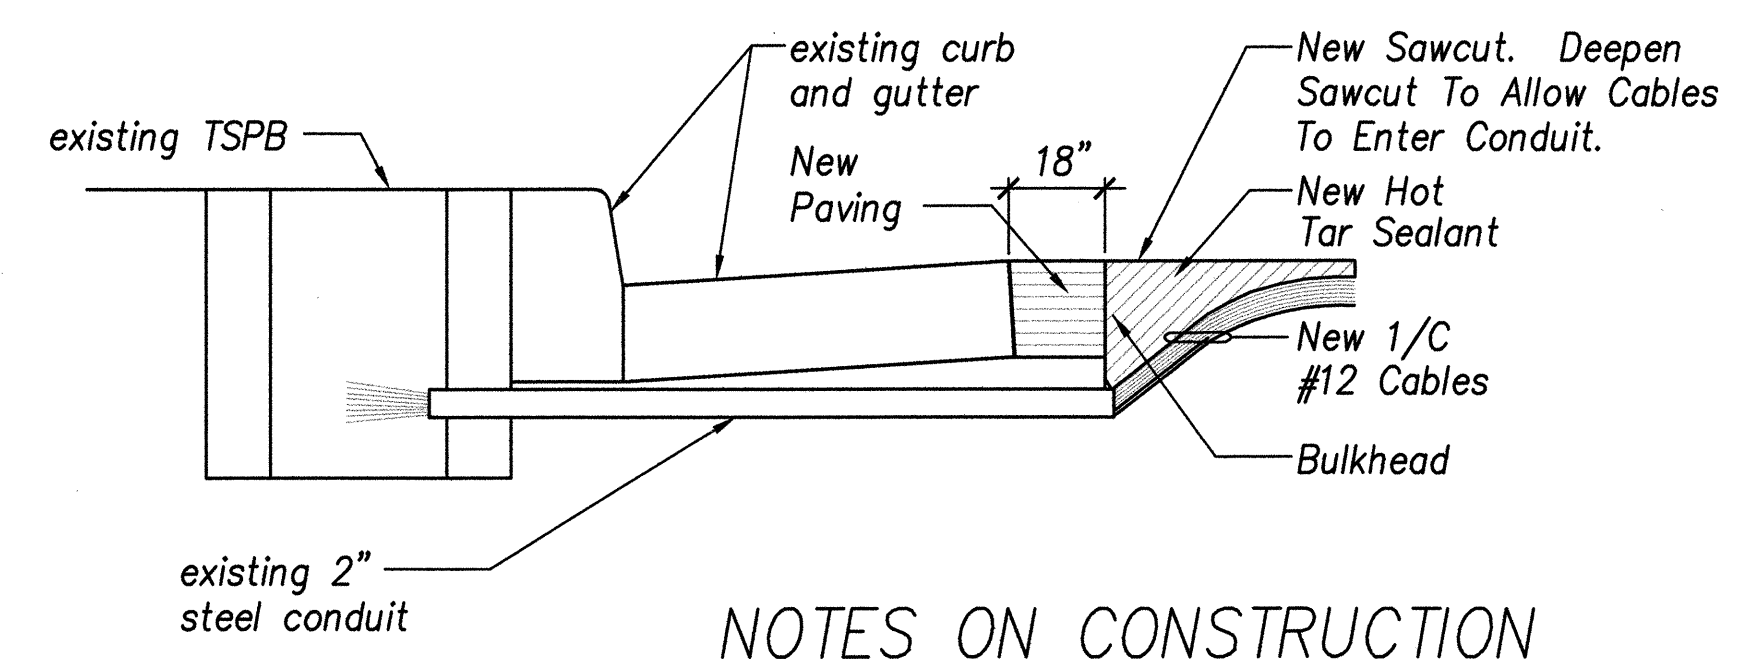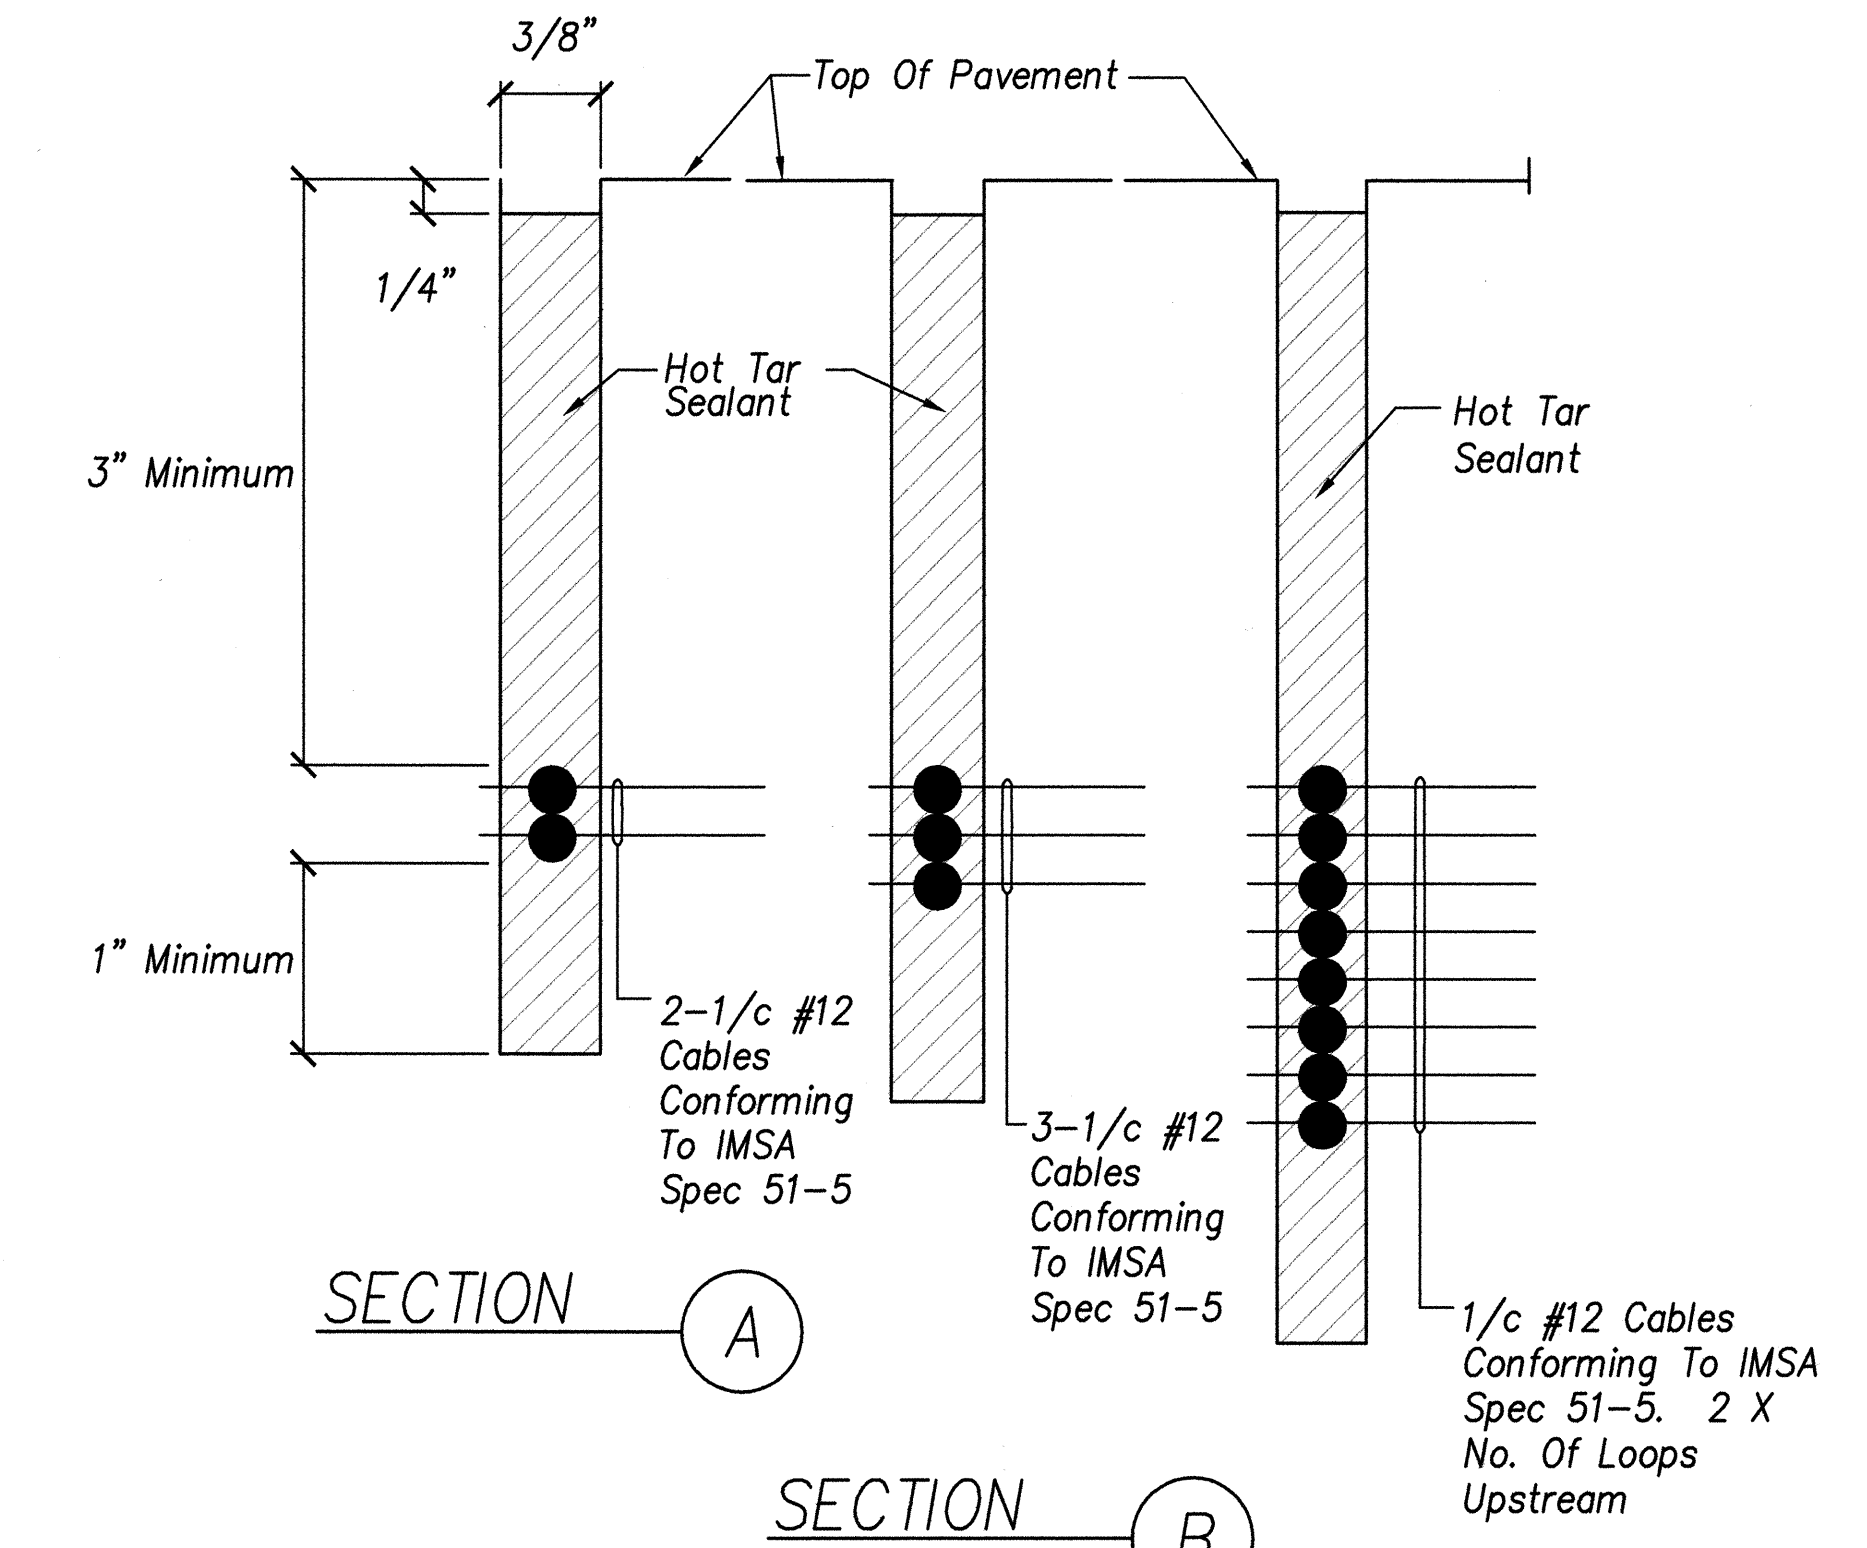

NOTES ON CONSTRUCTION AT END OF SAWCUT


- Seal roadway end of conduit after installation of conductors
- Install bulkhead across conduit trench.
- Place hot tar in sawcut.
- Backfill over conduit with new paving.
- Reconstruct curb and gutter as required.

DETAIL OF SENSOR LOOP INSTALLATION AT EDGE OF ROADWAY

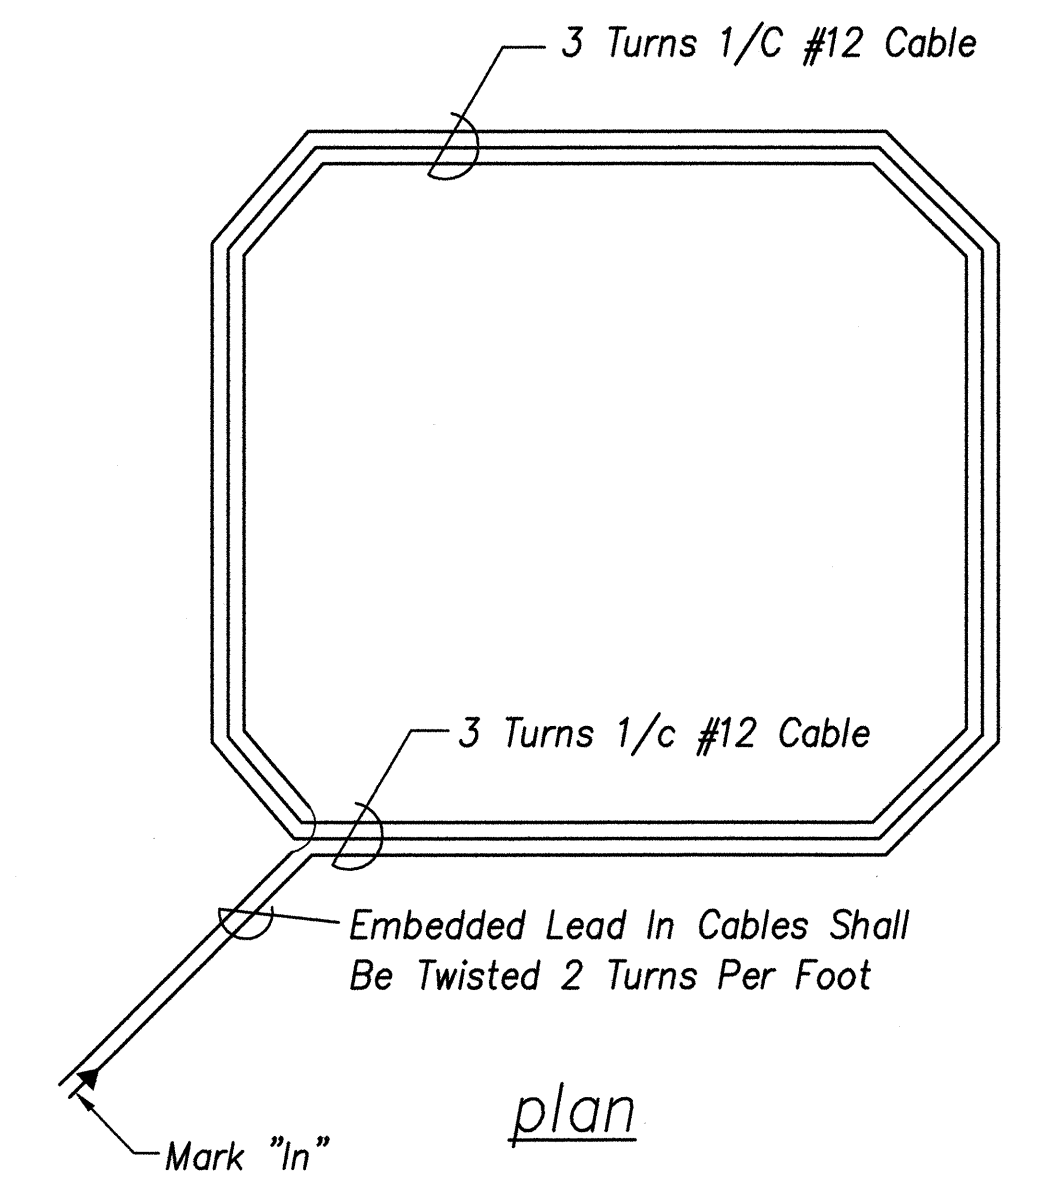

TYPICAL SENSOR LOOP WIRING DIAGRAM
Not to scale

DATE	_____
SURVEY PLOTTED BY	_____
DRAWN BY	_____
TRACED BY	_____
DESIGNED BY	_____
QUANTITIES BY	_____
CHECKED BY	_____
NO.	_____

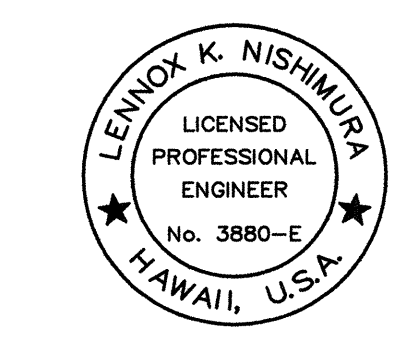

THIS WORK WAS PREPARED BY ME OR UNDER MY SUPERVISION AND CONSTRUCTION OF THIS PROJECT WILL BE UNDER MY OBSERVATION.
Lennox K. Nishimura
PROJECT ENGINEER for ECS, Inc.
APRIL 30, 2006
EXPIRATION DATE OF THE LICENSE

STATE OF HAWAII
DEPARTMENT OF TRANSPORTATION
HIGHWAYS DIVISION

DETECTOR LOOP DETAILS

KAMEHAMEHA HIGHWAY BIKEWAY
Vicinity of Radford Drive to Arizona Memorial
Federal Aid Project No. CMAQ-099-1(22)

Scale: As Shown Date: June 2005

SHEET No. 1 OF 1 SHEETS