
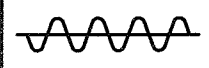
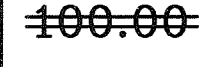
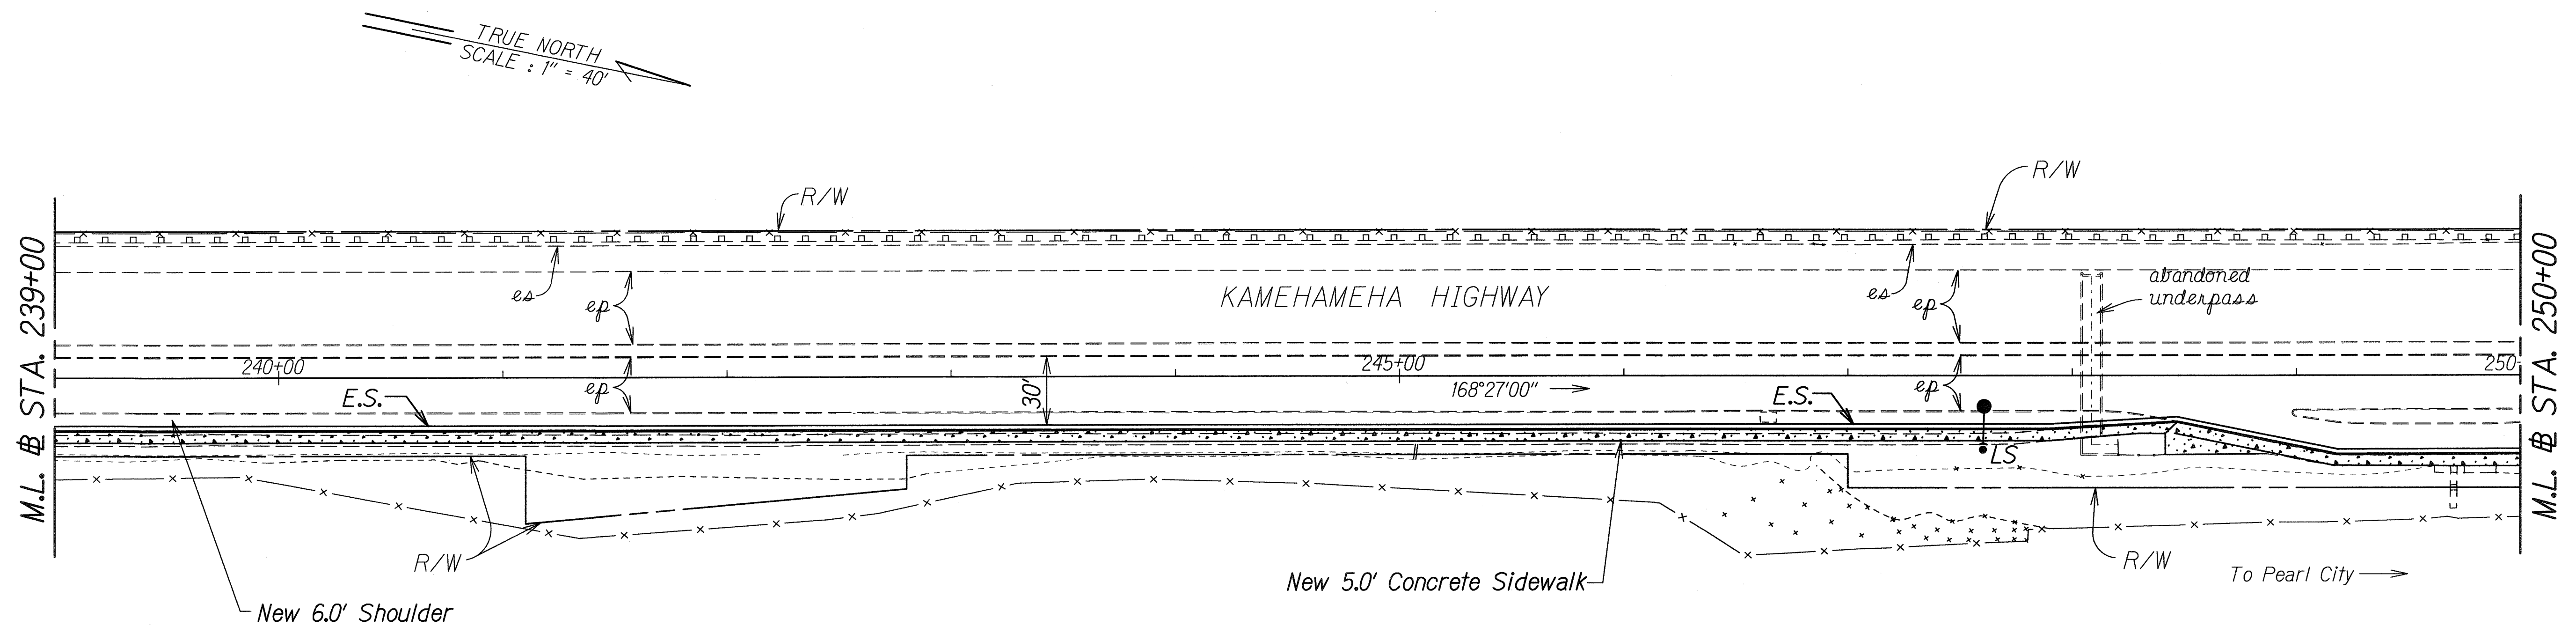


FED. ROAD DIST. NO.	STATE	FED. AID PROJ. NO.	FISCAL YEAR	SHEET NO.	TOTAL SHEETS
HAWAII	HAW.	CMAQ-099-1(22)	2005	ADD.11	60

LEGEND FOR
AS-BUILT POSTINGS

 Squiggly line for as-built deletion
 Double line for as-built deletion
Roadway Text for as-built posting

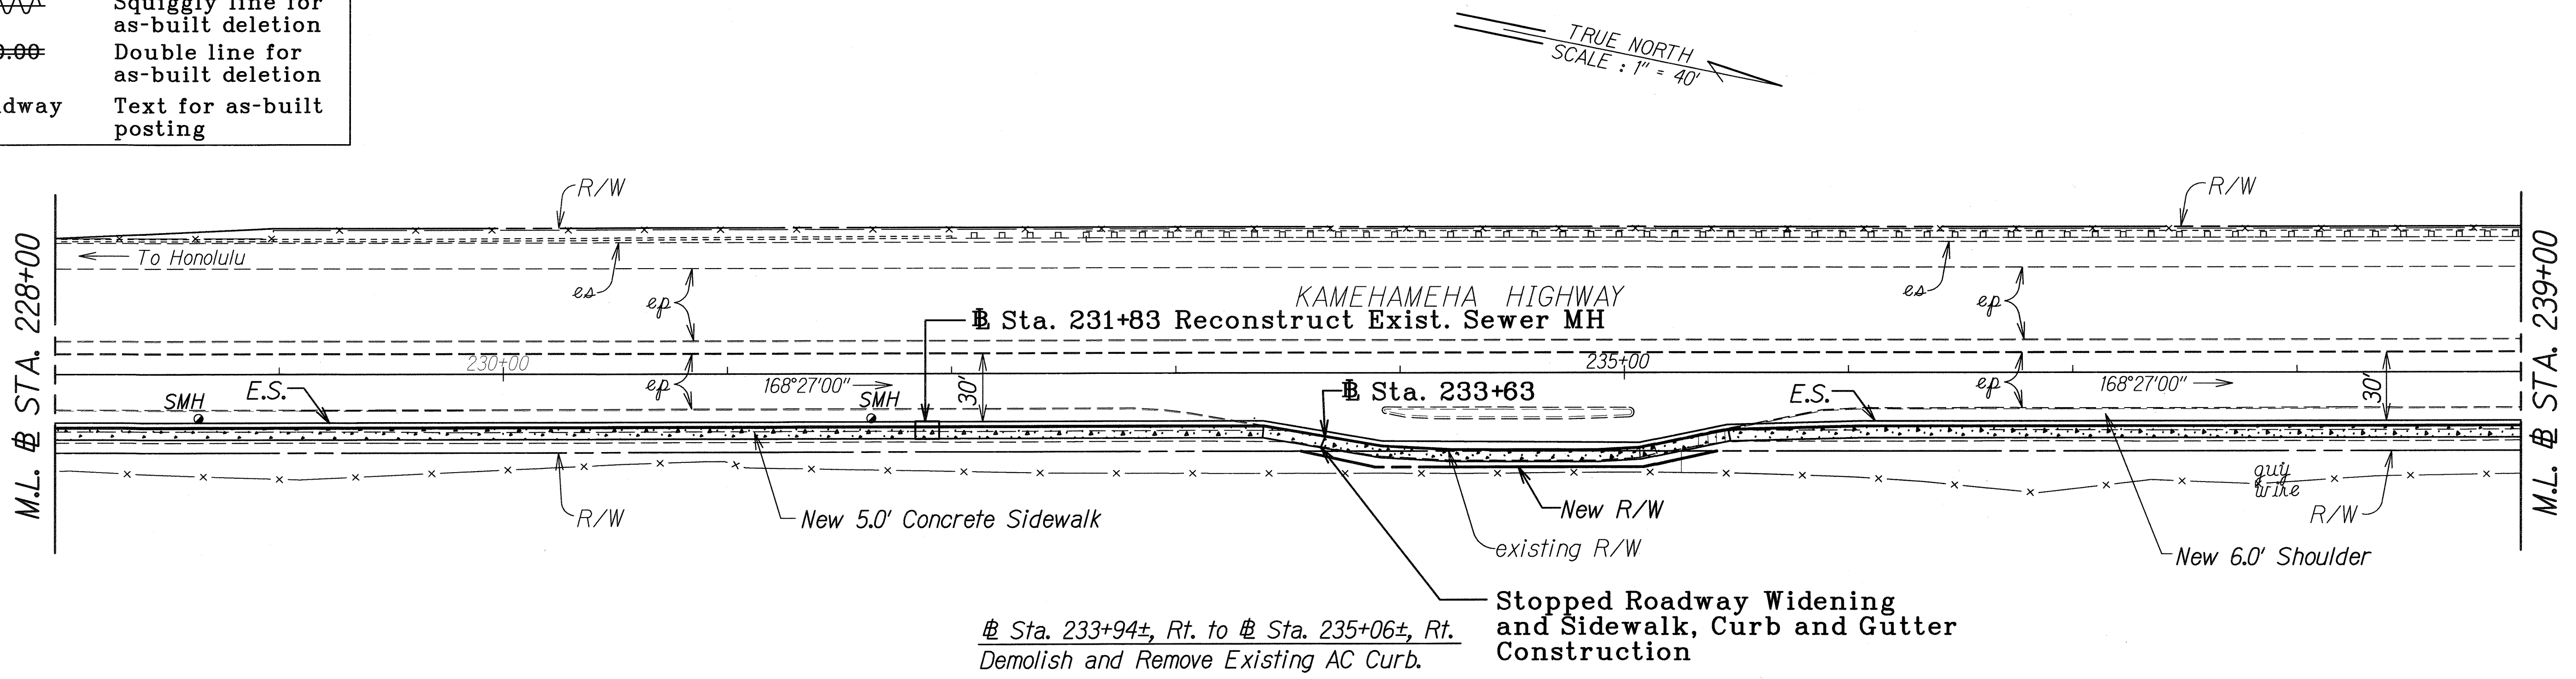

SURVEY PLOTTED BY	DATE
DESIGNED BY	
CHECKED BY	
NOTED BY	
QUANTITIES BY	
CHECKED BY	

Note: Limits of paving shown are approximate, actual limits shall be verified in the field.

01/11/05	Revised construction notes.
DATE	REVISION


STATE OF HAWAII
DEPARTMENT OF TRANSPORTATION
HIGHWAYS DIVISION

ROADWAY PLAN
KAMEHAMEHA HIGHWAY BIKEWAY
Vicinity of Radford Drive to Arizona Memorial
Federal Aid Project No. CMAQ-099-1(22)

Scale: 1"=40'
Date: Aug., 2004

SHEET No. 2 OF 4 SHEETS

FED. ROAD DIST. NO.	STATE	FED. AID PROJ. NO.	FISCAL YEAR	SHEET NO.	TOTAL SHEETS
HAWAII	HAW.	CMAQ-099-1(22)	2005	C.O.ADD.12	60

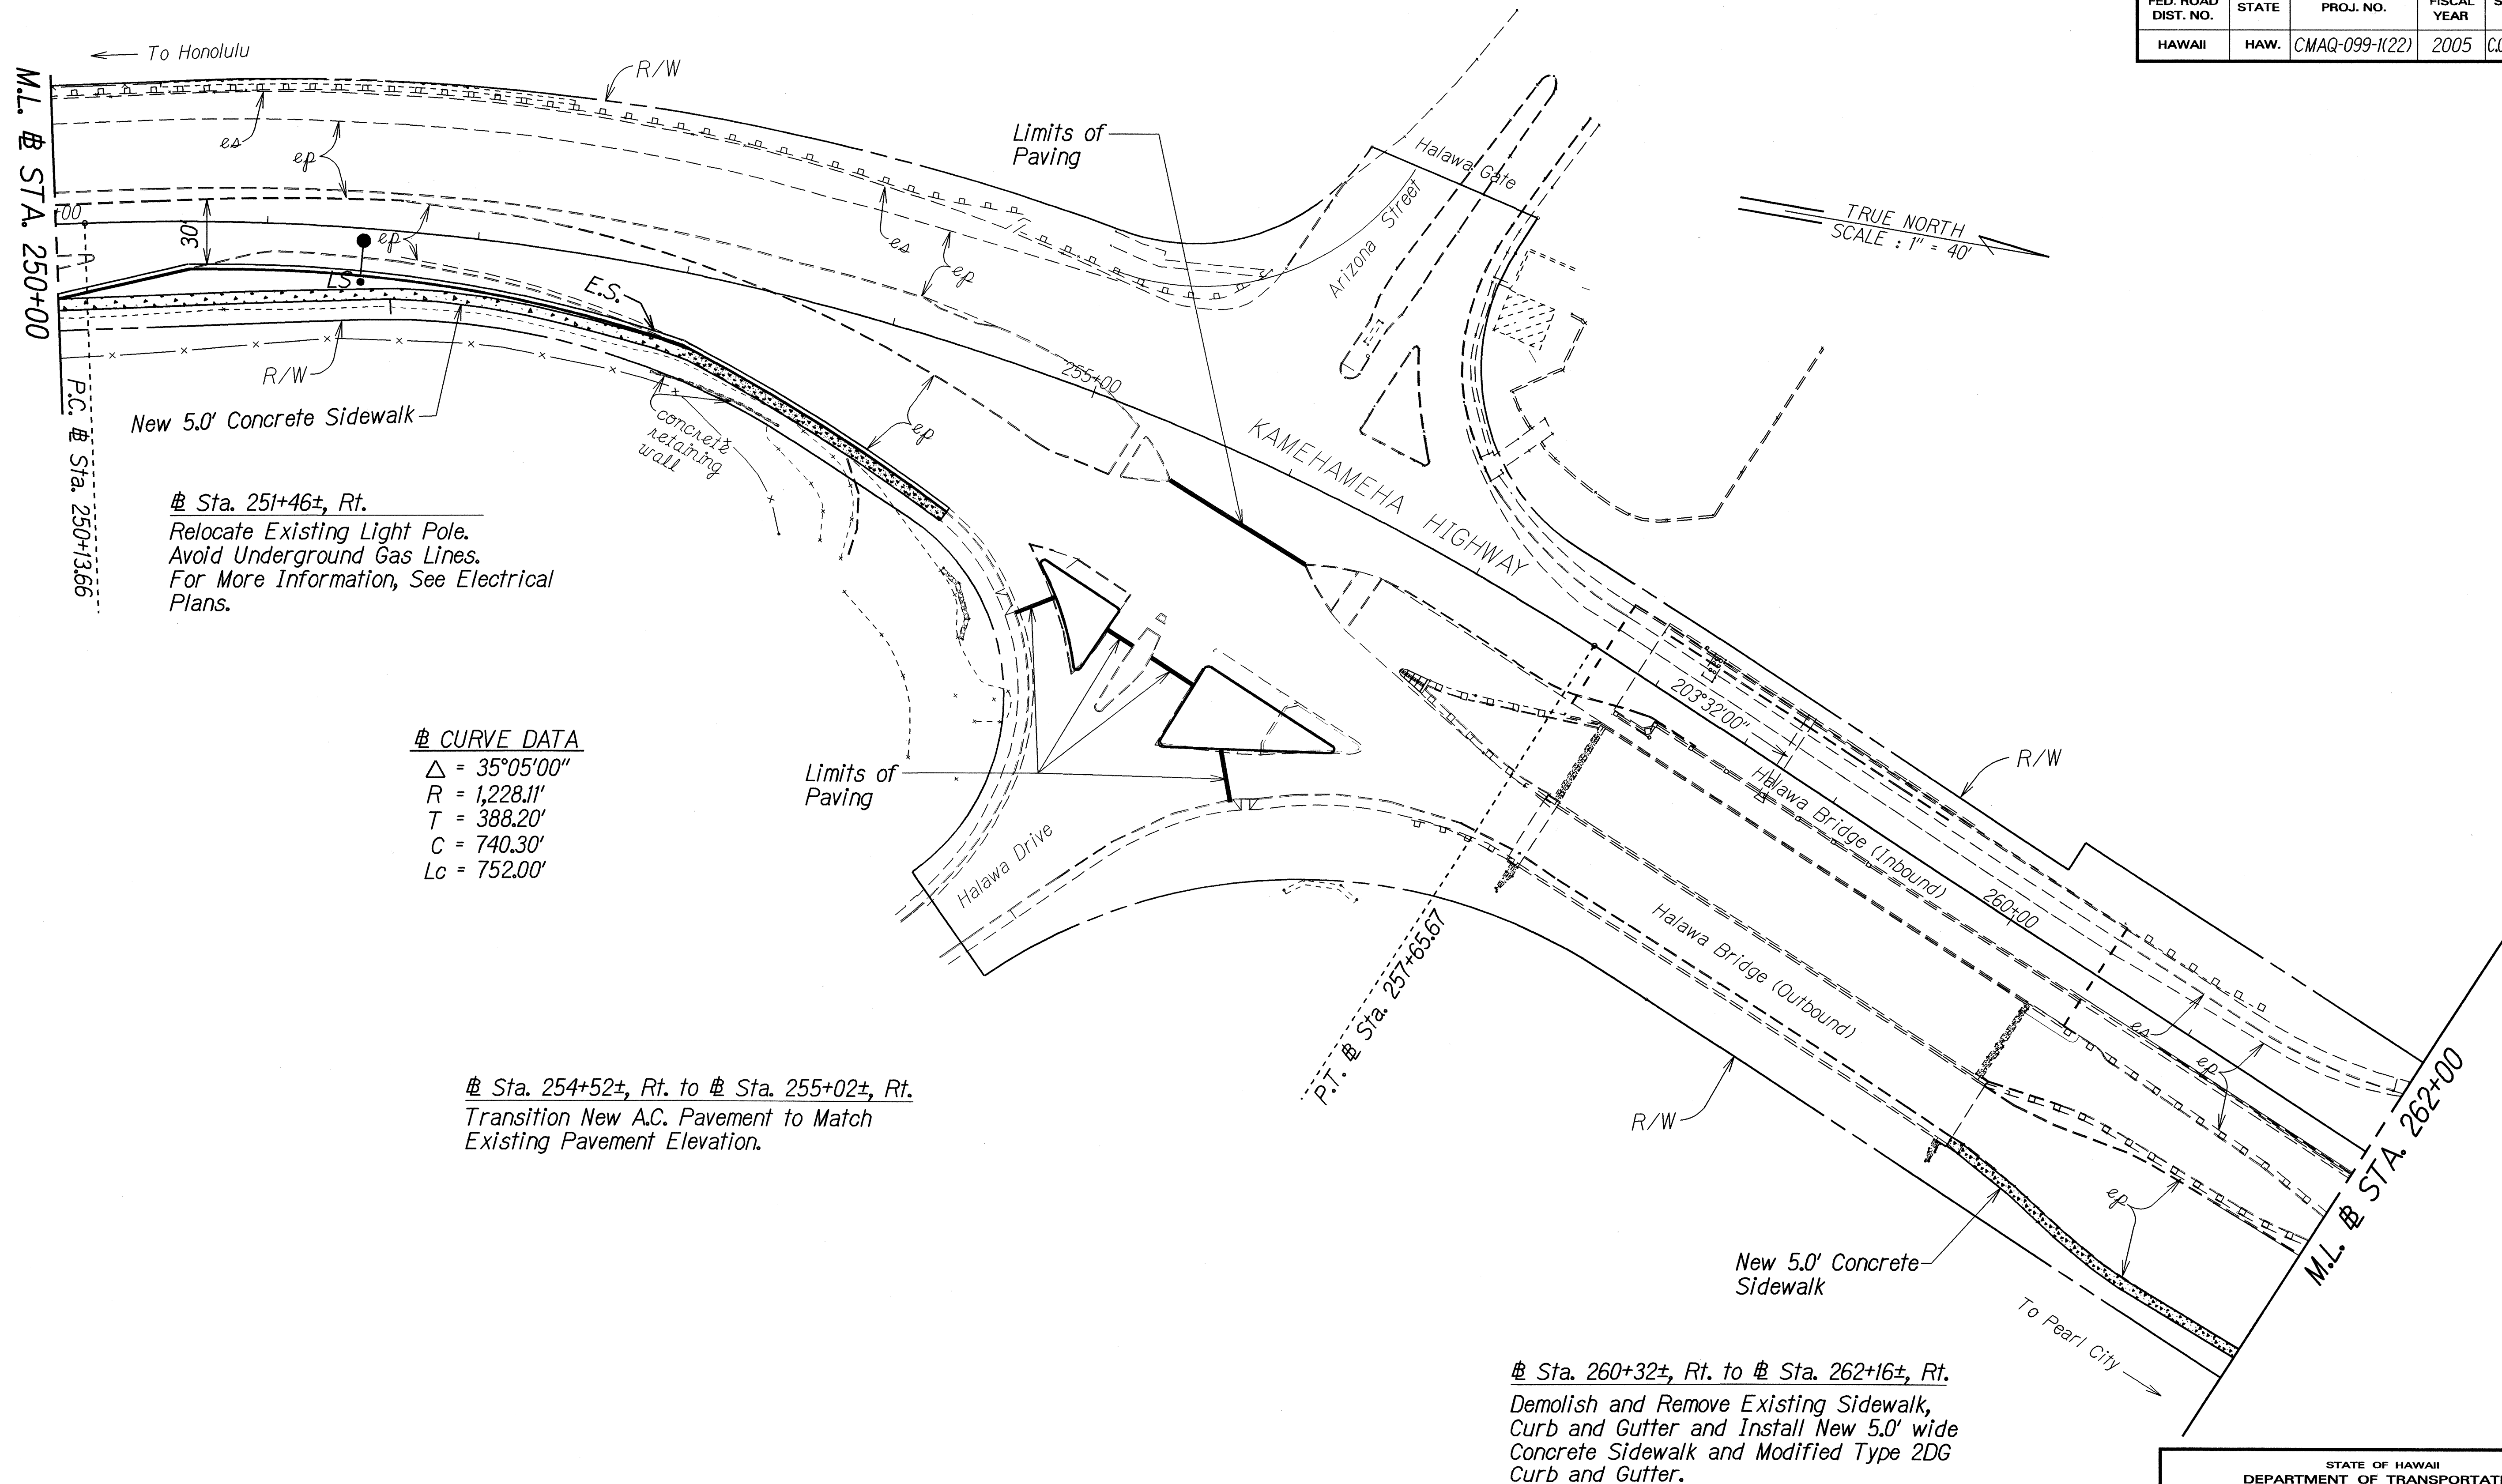


Note: Limits of paving shown are approximate, actual limits shall be verified in the field.

ORIGINAL PLAN	SURVEY LOCATED BY	DATE
NOTE BOOK	DRAWN BY	
	DESIGNED BY	
	QUANTITIES BY	
	CHECKED BY	

9/26/06	Added Transition Note.
01/11/05	Added Limits of Paving.
DATE	REVISION

STATE OF HAWAII
DEPARTMENT OF TRANSPORTATION
HIGHWAYS DIVISION
ROADWAY PLAN
KAMEHAMEHA HIGHWAY BIKEWAY
Vicinity of Radford Drive to Arizona Memorial
Federal Aid Project No. CMAQ-099-1(22)
Scale: 1"=40' Date: Aug., 2004
SHEET No. 3 OF 4 SHEETS

FED. ROAD DIST. NO.	STATE	FED. AID PROJ. NO.	FISCAL YEAR	SHEET NO.	TOTAL SHEETS
HAWAII	HAW.	CMAQ-099-1(22)	2005	ADD.13	60

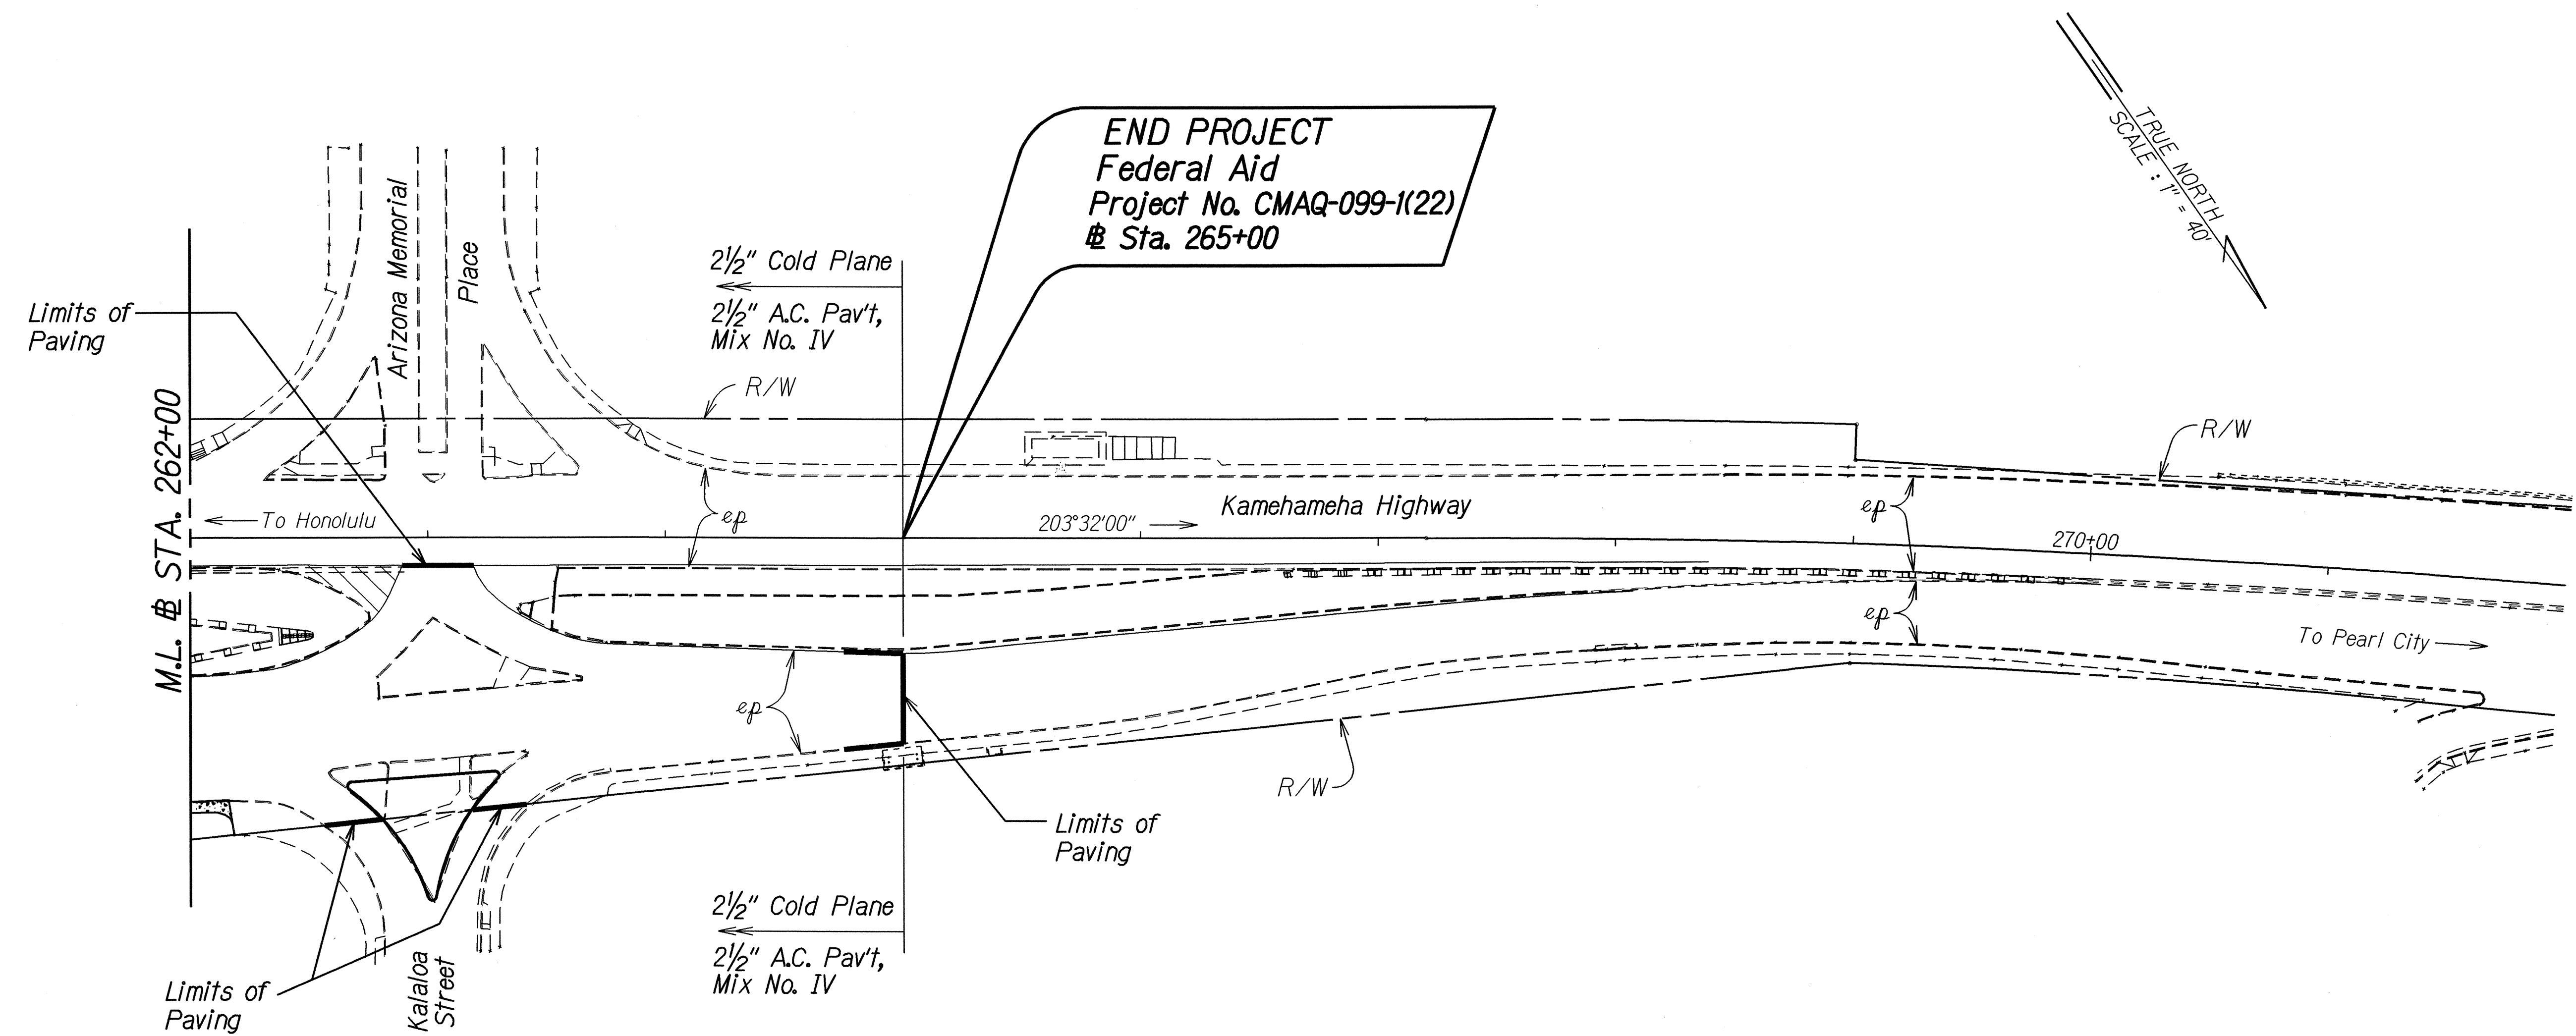

Note: Limits of paving shown are approximate, actual limits shall be verified in the field.

ORIGINAL PLAN	SURVEY PLOTTED BY	DATE
NOTE BOOK	DRAWN BY	
	DESIGNED BY	
	CHECKED BY	

01/11/05	Added limits of paving.
DATE	REVISION
STATE OF HAWAII DEPARTMENT OF TRANSPORTATION HIGHWAYS DIVISION ROADWAY PLAN KAMEHAMEHA HIGHWAY BIKEWAY Vicinity of Radford Drive to Arizona Memorial Federal Aid Project No. CMAQ-099-1(22) Scale: 1"=40' Date: Aug., 2004	
SHEET No. 4 OF 4 SHEETS	