

STANDARD PLANS SUMMARY

FED. ROAD DIST. NO.	STATE	FED. AID PROJ. NO.	FISCAL YEAR	SHEET NO.	TOTAL SHEETS
HAWAII	HAW.	CMAQ-099-1(22)	2005	2	60

STANDARD PLAN NO.	TITLE	DATE
B-01	Notes and Miscellaneous Details	07/01/86
B-02		
B-03	Typical Structure Excavation and Backfill Pay Limits	07/01/86
B-04		
B-05		
B-06	Concrete Box Girder	07/01/86
B-07	Concrete Box Girder	07/01/86
B-08	Concrete Box Girder	07/01/86
B-09		
B-10		
B-11		
B-12	Prestressed Concrete Piles	r07/16/90
B-13	Prestressed Concrete Piles	r07/16/90

D-01	Chain Link Fence With Toprail	r03/06/87
D-02	Chain Link Fence Without Toprail	r07/26/90
D-03	Wire Fence With Metal Posts	07/01/86
D-04	Typical Details of Curbs and/or Gutters	07/01/86
D-05	Typical Details of Reinforced Concrete Drop Driveway	07/01/86
D-06	Centerline and Reference Survey Monument	07/01/86
D-07	Street Survey Monument	07/01/86
D-08	Landscaping Shrub and Tree Planting	07/01/86
D-09	Field Office	07/01/86
D-10	Field Office	07/01/86
D-11	Project Site Laboratory	07/01/86
D-12	Project Site Laboratory	07/01/86
D-13	Field Office & Project Site Laboratory	07/01/86

H-01	Type A, B, C and D Catch Basin	07/01/86
H-02	Type A1, B1, C1 and D1 Catch Basin	07/01/86
H-03	Type A2, B2, C2 and D2 Catch Basin	07/01/86
H-04	Typical Reinforcing Details for Catch Basins	07/01/86
H-05	Type A, B and C Storm Drain Manhole	07/01/86
H-06	Type D and E Storm Drain Manhole	07/01/86
H-07	Type F Storm Drain Manhole	07/01/86
H-08	Catch Basin and Manhole Casting	07/01/86
H-09	Type A-9 and A-9P Frames and Grates	07/01/86
H-10	Type A-9B Frames and Grates	07/01/86
H-11	Type 61614 and 61214 Grated Drop Inlet	07/01/86
H-12	Type 61616 Grated Drop Inlet	07/01/86
H-13	61214, 61614 & 61616 Steel Frames and Grates	07/01/86
H-14	61214B Steel Frame and Grates	07/01/86
H-15	61614B Steel Frame and Grates	07/01/86
H-16	Concrete and Cement Rubble Masonry Structures	r10/16/90
H-17	Inlet Structures	r10/16/90
H-18	Flared End Section for Culverts	07/01/86
H-19	Outlet Structures	r02/15/91
H-20	Concrete Spillway Inlet	07/01/86
H-21	18" Slotted C.M.P. Drain	07/01/86
H-22	C.M.P. Coupling Details Standard Joint	r10/16/90
H-23	Hat Shaped Coupling Band	r10/16/90

STANDARD PLAN NO.	TITLE	DATE
TE-01	Miscellaneous Sign Details	07/01/86
TE-02	Galvanized Flanged Channel Sign Post Mounting	07/01/86
TE-03	Galvanized Square Tube Sign Post Mounting	07/01/86
TE-04	Regulatory Signs	r09/01/87
TE-05	Warning Signs	07/01/86
TE-06	Miscellaneous Signs	r11/03/89
TE-07	Reserved	07/01/86
TE-08	Construction Signs	r09/01/87
TE-09	Miscellaneous Intersection Signs	r03/06/87
TE-10	Reserved	07/01/86
TE-11	Bike Route Sign and Supplementary Plates	07/01/86
TE-12	State Route Marker and Auxiliary Markers	07/01/86
TE-13	Interstate Route Marker	07/01/86
TE-14	State Route Marker and Border Detail for Guide Signs	07/01/86
TE-15	Route Marker Assemblies	07/01/86
TE-16	Miscellaneous Reflector Markers	07/01/86
TE-17	Type II Object Markers	07/01/86
TE-18	Mileposts	07/01/86
TE-19	Reserved	07/01/86
TE-20	Overhead Sign Supports	07/01/86
TE-21	Overhead Sign Support, Box Truss Type, Aluminum	07/01/86
TE-22	Foundation Details and Schedules	07/01/86
TE-23	Supports for Ground Mounted Guide Sign	r11/03/89
TE-24	Breakaway Sign Supports for Ground Mounted Guide Signs	07/01/86
TE-25	Laminated Aluminum Sign Panels (Overhead)	07/01/86
TE-26	Laminated Aluminum Sign Panels (Ground Mounted)	07/01/86
TE-27	Solid Aluminum Extruded Sign Panel and Accessory Details	07/01/86
TE-28	Guide Signs Luminaire Mountings	07/01/86
TE-29	Reserved	07/01/86
TE-30	Raised Pavement Markers and Striping	r05/09/90
TE-31	Miscellaneous Pavement Markings	r05/09/90
TE-32	Miscellaneous Pavement Markings	r05/09/90
TE-33	Miscellaneous Pavement Markings	r11/03/89
TE-34	Reserved	07/01/86
TE-35	Pavement Alphabets, Numbers & Symbols	07/01/86
TE-36	Pavement Alphabets, Numbers & Symbols	07/01/86
TE-37	Reserved	07/01/86
TE-38	Traffic Signal System, Miscellaneous Details	r11/03/89
TE-39	Traffic Signal System, Miscellaneous Details	07/01/86
TE-40	Loop Detectors	r11/03/89
TE-41	Pullboxes	07/01/86
TE-42	Type III Traffic Signal Standard	07/01/86
TE-43	Concrete Pullbox (2' x 3')	07/01/86
TE-44	Reserved	07/01/86

STANDARD PLAN NO.	TITLE	DATE
TE-45	Reserved	07/01/86
TE-46	Reserved	07/01/86
TE-47	Reserved	07/01/86
TE-48	Reserved	07/01/86
TE-49	Reserved	07/01/86
TE-50	Metal Guardrail	r03/06/87
TE-51	Metal Guardrail	r09/01/87
TE-52	Metal Guardrail with Rubrail	r11/03/89
TE-53	Metal Guardrail with Rubrail at Obstruction	r09/01/87
TE-54	Beam Type Guardrail with Rubrail at Obstruction (Shoulder Installation)	r11/03/89
TE-55	Metal Guardrail Connection to Concrete Barrier	r11/03/89
TE-56	Concrete Barrier Transition	07/01/86
TE-57	Guardrail Type 3, Thrie Beam	r11/03/89
TE-57A	Guardrail Type 3, Modified Thrie Beam	11/03/89
TE-58	Approach End Flare, One & Two Way Roadway	07/01/86
TE-59	Trailing End Flare, One & Two Way Roadway	r11/03/89
TE-60	Anchor Block Details	07/01/86
TE-61	Breakaway Cable Terminal (BCT)	r11/03/89
TE-62	Breakaway Cable Terminal (BCT)	r09/01/87
TE-63	Guardrail Type 4 (Rigid Barrier)	r09/01/87
TE-64	Portable Concrete Barrier	r11/03/89
TE-65	Guardrail Type 4, Miscellaneous	r09/01/87
TE-66	Barriacades	07/01/86
TE-67	Delineation & Pavement Markings at Bridges	07/01/86
TE-68	Wheelchair Ramps	r07/18/94
TE-69	Wheelchair Ramps	r07/18/94

07/18/94	REVISED TE-68 & TE-69
02/15/91	REVISED H-19
10/16/90	REVISED H-16,H-17, H-22 & H-23
07/26/90	REVISED D-02
07/16/90	REVISED B-12,B-13
05/09/90	REVISED TE-30,TE-31 & TE-32
11/03/89	REVISED TE-06,TE-23, TE-30, TE-31, TE-32, TE-33, TE-38, TE-40, TE-52, TE-54, TE-55, TE-57, TE-59, TE-61, TE-64, TE-68 & TE-69, ADDED TE-57A
09/01/87	REVISED TE-04,TE-06, TE-08, TE-32, TE-51, TE-53, TE-54, TE-55, TE-57, TE-59, TE-62, TE-63, TE-65 & TE-69
03/06/87	REVISED D-01, TE-09, TE-40, TE-50, TE-51, TE-57, TE-59, TE-61, TE-63 & TE-64
DATE	REVISION

NOTE:
STANDARD PLANS APPLICABLE TO THIS PROJECT ARE INDICATED BY A " ● " NEXT TO THE STANDARD PLAN NO. (FOR EXAMPLE: D-07 ●)

STATE OF HAWAII
DEPARTMENT OF TRANSPORTATION
HIGHWAYS DIVISION
STANDARD PLANS SUMMARY
KAMEHAMEHA HIGHWAY BIKEWAY
Vicinity of Radford Drive to Arizona Memorial
Project No. CMAQ-099-1(22)
Date: Jun., 2004
SHEET No. 1 OF 1 SHEETS

SURVEY PLOTTED BY _____ DATE _____
DRAWN BY _____
CHECKED BY _____
NOTE BOOK _____
QUANTITIES BY _____
Nc _____

GENERAL NOTES

1. The scope of work for this project includes constructing a new shoulder, curb, gutter, and sidewalk; cold planing; paving; relocating existing drainage structures and utilities; slope excavation; and installing traffic signs, pavement markings and striping.
2. The Contractor's attention is directed to the following Sections of the Special Provisions : Subsection 105.06 - Coordination Between the Contractors; Subsection 107.13 - Public Convenience and Safety; Subsection 107.21 - Contractor's Responsibility For Utility Property And Services; and Section 645 -Traffic Control.
3. The existence and location of underground utilities, manholes, monuments and structures as shown on the plans are from the latest available data but the accuracy is not guaranteed. The encountering of other obstacles during the course of work is possible. The Contractor shall tone for all utility lines before starting any work. The Contractor shall be held liable for any damages incurred to the existing facilities and/or improvements as a result of his operations.
4. The exact locations and limits or areas to be filled with leveling course, reconstructed and cold planed shall be determined in the field by the Engineer.
5. The Contractor shall notify in writing the Fire and Police Department, Ambulance and Oahu Transit Services, seven (7) days prior to any paving operations.
6. The Contractor shall notify the Engineer in writing, two (2) weeks prior to starting paving operations.
7. Smooth riding connections shall be constructed at all limits of resurfacing, including the beginning and end of project, connecting approaches, side streets and driveways as shown on the plans and/or as directed by the Engineer.
8. Existing drainage system shall be functional at all times during construction. The Contractor is to furnish materials, equipment, labor, tools and incidentals necessary to maintain flow. This work shall be considered incidental to various contract items.
9. The Contractor shall provide for access to and from all existing side streets and adjacent properties at all times.
10. All saw cutting work shall be considered incidental to Roadway Excavation. The Contractor shall clean up any cuttings and shall not wash down material into the storm drain or sewer systems.
11. All construction signs shall be left in place until all construction items have been completed unless otherwise directed by the Engineer. The Contractor shall obtain prior approval from the Engineer to remove construction signs.
12. All work to remove temporary facilities by the Contractor shall be considered incidental to the various contract items in the proposal.
13. After major excavations and installations of abutments, channels and embankments, the areas of exposed ground shall be immediately hydromulched to prevent erosion.
14. The utility relocations are scheduled to be started and completed within the first 4 months of the contract time period. The Contractor shall coordinate the work of the utility companies so as not to interfere within the State's Contractor's work for the remainder of the contract.

15. After the project is completed, the Contractor shall restore grades and groundcover within the project limits to a condition equal or better than the existing condition prior to construction.
16. No material and/or equipment shall be stockpiled or otherwise stored within the Highway Right-of-Way except at locations designated in writing and approved by the Engineer.
17. All work specified in the contract but not listed separately in the proposal schedule shall be considered incidental to other various contract items and shall not be paid for separately.
18. Any damage to existing C#C monument at Station 212+70± shall be repaired by a Professional Surveyor licensed in the State of Hawaii at no cost to the State.
19. Existing C#GS brass disk, BM "J 13", at Station 224+35± shall be referenced and replaced by a Professional Surveyor licensed in the State of Hawaii. Coordinate with the Engineer prior to construction.
20. Existing traffic camera near Station 251+00 shall be relocated. For more information, see electrical plans.
21. All traffic islands and curb ramps within the project limits shall be reconstructed by others through Project Number CMAQ-0300(97), Pedestrian Facilities and ADA Compliance at Various Locations on Oahu, Unit 6. All work shall be completed by June 30, 2005.

FED. ROAD DIST. NO.	STATE	FED. AID PROJ. NO.	FISCAL YEAR	SHEET NO.	TOTAL SHEETS
HAWAII	HAW.	CMAQ-099-1(22)	2005	3	60

LEGEND

- [] Resurfacing Limits
- °_{uan} Existing U.S. Navy Electric Manhole
- °_{emh} Existing Electric Manhole
- e— Existing Electrical Line
- °_{jp} Existing Joint Pole
- °_{pp} Existing Power Pole
- °_{emh} Existing Electric Manhole
- nt— Existing U.S. Navy Telephone Line
- t— Existing Telephone Line
- °_{tp} Existing Telephone Pole
- °_{tmh} Existing Telephone Manhole
- ac— Existing Signal Corps Line
- tv— Existing TV Cable
- w-24— Existing 24" Water Line
- °_{wmh} Existing Water Manhole
- °_{av} Existing Water Air Valve
- °_{wv} Existing Water Valve Box
- °_{wrm} Existing Water Meter
- °_{fh} Existing Fire Hydrant

- s-12— Existing Sewer Line
- °_{smh} Existing Sewer Manhole
- °_{SMH} Adjusted Sewer MH Frame/Cover
- g-4— Existing 4" Gas Line
- °_{gv} Existing Gas Valve Box
- °_{gmh} Existing Gas Manhole
- °_{mon.} Existing Monument
- °_{admh} Existing Storm Drain Manhole
- °_{gdi} Existing Grated Drop Inlet
- °_{cb} Existing Catch Basin
- ° Existing Traffic Sign Wtih 1 Post
- ° Existing Traffic Sign Wtih 2 Posts
- ° Existing Traffic Sign Wtih 3 Posts
- ° Existing Highway Lighting Standard
- ° Relocated Highway Lighting Standard
- H— Existing Single Metal Guardrail
- HH— Existing Double Metal Guardrail
- x— Existing Fence
- °_{isp} Existing Traffic Signal Pole
- °_{ispb} Existing Traffic Signal Pullbox
- °_{utility box} Existing Utility Pullbox

ORIGINAL PLAN	SURVEY PLOTTED BY	DATE
NOTE BOOK	DRAWN BY	
062	DESIGNED BY	
06/06/04	CHECKED BY	

STATE OF HAWAII
DEPARTMENT OF TRANSPORTATION
HIGHWAYS DIVISION

GENERAL NOTES AND LEGEND

KAMEHAMEHA HIGHWAY BIKEWAY
Vicinity of Radford Drive to Arizona Memorial
Federal Aid Project No. CMAQ-099-1(22)

Scale: None Date: Aug, 2004

SHEET No. 1 OF 1 SHEETS


FED. ROAD DIST. NO.	STATE	FED. AID PROJ. NO.	FISCAL YEAR	SHEET NO.	TOTAL SHEETS
HAWAII	HAW.	CMAQ-099-1(22)	2005	C.O. 3 S-1	60

ADDITIONAL GENERAL NOTES

- Temporary bench marks indicated on the plans may fall within the new curb ramps. The Contractor shall establish new temporary benchmarks, under the supervision of a licensed surveyor, outside the limits of the new work. This work shall be considered incidental to Section 650 – Curb Ramps.
- Removal and disposal of existing curb and gutter, curb, sidewalk and asphalt concrete pavement, curb, sidewalk and any debris shall be considered incidental to Section 650 – Curb Ramps and will not be paid for separately.
- Concrete sidewalk shall be reinforced with 6x6 W1.4xW1.4 welded wire fabric.
- Dressing of sidewalk shall consist of clearing and grubbing, grading, reshaping and compacting with suitable material the area adjacent to the improvement as shown on the plans and/or as directed by the Engineer and shall be considered incidental to sidewalk.
- Provide smooth transition where new sidewalk construction meets the existing grade or sidewalk.
- All curb angle points within the curb ramps shall be rounded with R=6”.
- The Contractor shall provide and maintain a temporary pedestrian–safe and easily accessible route or detour with barricades in or near the work zone. This temporary route or detour shall be stable, firm and slip–resistant and shall be American With Disabilities Act compliant (This only applies if existing surface in non–ADA compliant). This work shall be incidental to all contract items and will not be paid for separately.
- All curb ramp transitions (walkways, curbs, gutter) shall be considered incidental to Section 650 – Curb Ramps.
- Existing utilities shall remain in service and in place at all times. If relocation of the existing utilities is required by the Contract Documents or for the Contractor’s convenience, interruption of service shall be kept to a minimum and shall be done at the Contractor’s expense with the approval of the affected utility company.
- The Contractor shall verify all dimensions and details shown on the drawings prior to the start of construction. Any discrepancy shall be immediately brought to the attention of the Engineer.
- Construction outside the Hawaii Department of Transportation (HDOT) right–of–way and State acquired parcels are subject to approval by HDOT and the affected owner.
- All construction work shall be done in accordance with the standards and specifications of the HDOT as amended, unless otherwise specified by the contract plans and specifications.
- No Contractor shall perform any construction operation so as to cause falling rocks, soil or debris in any form to fall, slide or flow into existing State drainage systems, or adjoining properties, streets or natural watercourses. Should such violations occur, the Contractor may be cited and the Contractor shall immediately make all remedial actions necessary.
- Bench mark and elev. are indicated on each sheet.
- Tack coat shall be incidental to the various asphalt concrete pavement items.

- The Contractor shall be held liable for any damages incurred to the existing landscaping as a result of his operations.
- Contractor to remove and salvage existing lava rock curbs within construction areas. Clean and deliver salvaged lava rock curbs to City’s Maintenance baseyard at Sand Island (next to 348 Hookela Pl.) Contact Mel Miyata (484–7630) 1–week prior to delivery.
- The Contractor shall hire a professional surveyor with a current license to practice in the State of Hawaii to establish and verify boundary lines.
- Contractor shall notify the State construction inspector before commencement of work on any site with trees in close proximity (20’±).
- Contractor shall comply with conditions as stated in the project NPDES Notice of General Permit Coverage (NGPC).
- The Contractor must notify the Cadastral Section prior to removal of any State Survey Monument (Brass Disk) so that Cadastral can reference the monument prior to demolition of the existing monument. The Contractor shall be bear all costs involved in restoring the State Survey Monuments which are affected by their work.

ORIGINAL PLAN	SURVEY PLOTTED BY	DATE
NOTE BOOK	DRAWN BY	
No.	DESIGNED BY	
	QUANTITIES BY	
	CHECKED BY	

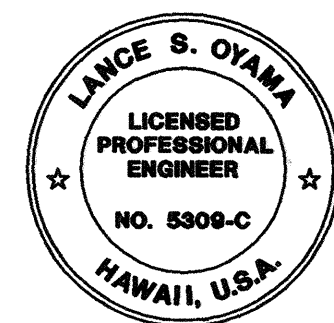

THIS WORK WAS PREPARED BY ME OR UNDER
MY SUPERVISION AND CONSTRUCTION OF THIS
PROJECT WILL BE UNDER MY OBSERVATION.

Signature: *Lance S. Oyama* 4/30/06
DATE

"OBSERVATION OF CONSTRUCTION" IS DEFINED
IN CHAPTER 16-115, HAWAII ADMINISTRATIVE
RULES ENTITLED "PROFESSIONAL ENGINEERS,
ARCHITECTS, SURVEYORS AND LANDSCAPE
ARCHITECTS".

STATE OF HAWAII DEPARTMENT OF TRANSPORTATION HIGHWAYS DIVISION	
NOTES – 1	
KAMEHAMEHA HIGHWAY BIKEWAY Vicinity of Radford Drive to Arizona Memorial Federal Aid Project No. CMAQ-099-1(22)	
Scale:	Date: August 2005
SHEET No. 1 OF 3 SHEETS	


CO. 3 S-1

FED. ROAD DIST. NO.	STATE	FED. AID PROJ. NO.	FISCAL YEAR	SHEET NO.	TOTAL SHEETS
HAWAII	HAW.	CMAQ-099-1(22)	2005	C.O. 3 S-2	60

CURB RAMP AND SIDEWALK NOTES:

- These typical details are intended as curb ramp guidelines for design and construction.
- A 2% maximum cross slope shall be maintained in the direction of pedestrian traffic.
- Subject to field conditions, the Engineer shall determine the final location of curb ramps.
- All pullboxes shall be installed away from the curb ramp and within the sidewalk/unpaved area to the maximum extent feasible.
- Where necessary, existing pullboxes, handholes, manholes, etc. shall be adjusted to match curb ramp grade. Adjustments shall not be paid for separately but shall be considered incidental to the various curb ramp items unless indicated otherwise.
- Transitions from ramps to gutters and roadways shall be flush.
- Curb ramps and sidewalks shall be constructed to eliminate ponding to the maximum extent feasible.
- The pedestrian push button shall meet operational and reach requirements of the American with Disabilities Act Accessibility Guidelines (ADAAG):
 - Forward Reach. The maximum height for forward reach shall be 48".
 - Side Reach. The maximum height for side reach shall be 54".
 - Operation. Controls and operating mechanisms shall be operable with one hand and shall not require tight grasping, pinching, or twisting of the wrist. The force required to activate controls shall be no greater than 5 lbf.
- The maximum slopes of adjoining gutters or road surface immediately fronting the curb ramp shall not exceed 5% for Type A, D, and Combination ramps and 8.33% for Type B, C, and E ramps.
- There shall be a 30"x48" level ground surface (2% max. cross slope, both directions) for a forward or side approach, as appropriate, to a pedestrian push button.
- Construction joints are required to join curb ramps with sidewalks.
- Unless otherwise noted, new gutters are required as shown.
- All curb ramps shall be reinforced with 6x6 W1.4/W1.4 welded wire fabric.
- Surface of sidewalks and curb ramps shall be firm, stable, and slip-resistant. This includes the surfaces of pullboxes, valve covers, manhole covers, etc.
- Bed course material is required for curb ramps, sidewalks, and gutters.
- All sidewalks shall provide a minimum clear width of 3'-0" (excluding curb) for pedestrian circulation. If this cannot be met, a minimum 32-inch clear width is allowed for a distance of 24-inches.
- Passing spaces along new sidewalks with 5' clear width or less shall be provided at maximum 200' intervals as required by ADA guidelines. The passing area shall be a minimum 5' wide by 5' long as feasible.
- If possible, install utility poles, fire hydrants, light poles, sign posts, pullboxes, etc. off of sidewalk but within the right-of-way.
- Objects protruding from utility poles and walls adjacent to the sidewalks (i.e. wall mounted fire hydrants, telephones, meters on poles, etc.) shall be mounted to meet the current American with Disabilities Act Accessibility Guidelines (ADAAG) and will be subject to Engineer's approval.
- If a curb ramp is not constructed according to the plans, the Contractor shall reconstruct the curb ramp at no cost to the State. Construction tolerance for Portland Cement Concrete shall be based on 1/4 inch per 10 ft. (0.2%). Remedial measures will not be accepted.
- Additional information is available from:
 - American with Disabilities Act Accessibility Guidelines (ADAAG), Jan. 1998, The Access Board.
 - Accessible Rights-of-Way: A Design Guide, Nov. 1999, The Access Board.
 - Designing Sidewalks and Trails for Access, Part 1, July 1999, FHWA.
 - Designing Sidewalks and Trails for Access, Part 2, Sept. 2001, FHWA.
- Pay limits for the various types of curb ramps are as shown on these typical details.
- For curb ramps at curb returns, install Construction Joints per Standard Detail D-04 (Detail C), full width sidewalk at curb return.
- When directed by the Engineer, Sidewalk Transition Area shall be extended beyond shown plan limits to match the nearest scoreline.

ORIGINAL PLAN	SURVEY PLOTTED BY	DATE
NOTE BOOK	DRAWN BY	
	DESIGNED BY	
	QUANTITIES BY	
	CHECKED BY	
No.		

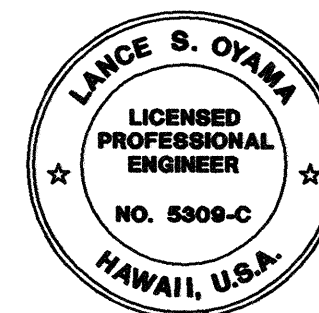

THIS WORK WAS PREPARED BY ME OR UNDER MY SUPERVISION AND CONSTRUCTION OF THIS PROJECT WILL BE UNDER MY OBSERVATION.

Lance S. Oyama 4/30/06
SIGNATURE DATE

"OBSERVATION OF CONSTRUCTION" IS DEFINED IN CHAPTER 16-115, HAWAII ADMINISTRATIVE RULES ENTITLED "PROFESSIONAL ENGINEERS, ARCHITECTS, SURVEYORS AND LANDSCAPE ARCHITECTS".

STATE OF HAWAII
DEPARTMENT OF TRANSPORTATION
HIGHWAYS DIVISION

NOTES - 2

KAMEHAMEHA HIGHWAY BIKEWAY
Vicinity of Radford Drive to Arizona Memorial
Federal Aid Project No. CMAQ-099-1(22)

Scale: Date: August 2005

SHEET No. 2 OF 3 SHEETS

CO 3 S-2

FED. ROAD DIST. NO.	STATE	FED. AID PROJ. NO.	FISCAL YEAR	SHEET NO.	TOTAL SHEETS
HAWAII	HAW.	CMAQ-099-1(22)	2005	C.O. 3 S-3	60


TRAFFIC SIGNAL AND TECHNOLOGY DIVISION NOTES:

1. The contractor shall notify the Traffic Signal and Technology Division, Department of Transportation services, five (5) calander days prior to commencing work on the traffic signal system (phone: 523-4589)
2. The traffic signal system shall be kept operational during construction. Any relocation required shall be approved by the traffic signal and technology division, department of transportation services, and paid for by the contractor.
3. The contractor shall be responsible for any damages to the existing traffic signal facilities, including the traffic signal interconnect system. Any and all damages to these facilities shall be repaired by the contractor at his cost in accordance with the requirements of the City and County of Honolulu.
4. The contractor shall be responsible for any damages to the existing traffic signal fiber optic cable system. Any and all damages to these facilities shall be repaired by the contractor at his cost in accordance with the requirements of the City and County of Honolulu.

PAVING AROUND MANHOLES

1. The Contractor shall place hot asphalt concrete around manholes and compact properly with a vibrating plate compactor.
2. If a plate compactor is not used, the Contractor shall use a pneumatic roller to roll the area around the manhole which is not rolled by the steel roller.
3. The Contractor shall fog seal or brush emulsion seal on the material placed as backfill on the area around the manhole that was not compacted by the roller. Black sand shall be used to blot out the area if the fog is too heavy.

ORIGINAL PLAN	SURVEY PLOTTED BY	DATE
NOTE BOOK	DRAWN BY	
No.	DESIGNED BY	
	QUANTITIES BY	
	CHECKED BY	

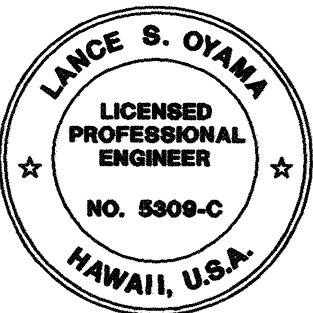

THIS WORK WAS PREPARED BY ME OR UNDER MY SUPERVISION AND CONSTRUCTION OF THIS PROJECT WILL BE UNDER MY OBSERVATION.

Signature: *Lance S. Oyama* Date: *4/30/06*

"OBSERVATION OF CONSTRUCTION" IS DEFINED IN CHAPTER 16-115, HAWAII ADMINISTRATIVE RULES ENTITLED "PROFESSIONAL ENGINEERS, ARCHITECTS, SURVEYORS AND LANDSCAPE ARCHITECTS".

STATE OF HAWAII DEPARTMENT OF TRANSPORTATION HIGHWAYS DIVISION	
NOTES - 3	
KAMEHAMEHA HIGHWAY BIKEWAY	
Vicinity of Radford Drive to Arizona Memorial	
Federal Aid Project No. CMAQ-099-1(22)	
Scale:	Date: August 2005
SHEET No. 3 OF 3 SHEETS	

C.O. 3 S-3

UTILITY NOTES

- 1. All existing utilities, whether or not shown on the plans, shall be protected at all times by the Contractor during construction. Any damage to the existing utilities shall be replaced and paid for by the Contractor.
- 2. Unless relocation is called for on the plans, existing utilities shall remain in service and in place at all times. If relocation of an existing utility is required, the Contractor shall stop work and notify the Engineer and the affected utility company.
- 3. Existing underground 10-inch gas line is inactive and may conflict with the State's relocated drainage system. If existing gas lines needs to be cut, the Contractor shall notify the Hickam Air Force Base Environmental Office (Mr. Rick McComb at 449-1584, ext. 224) prior to performing any contruction work.
- 4. Existing underground telephone line conflicts with the State's relocated drainage system. AT&T HITS shall relocate the telephone line at no cost to the State. The Contractor shall notify AT&T at least two (2) weeks before the start of any construction work.

NAVY UTILITY NOTES

- 1. Prior to performing any site construction work, the Contractor shall field-locate and mark the locations of all Navy sewer lines within the project site. If not provided in the design plans, the Contractor shall field verify the depths of existing sewer lines prior to performing any excavation work.
- 2. All Navy sewer lines, whether or not shown on the drawings, shall be protected at all times by the Contractor during construction operations.
- 3. The Contractor shall be responsible for any damage to Navy sewer lines. Any damage shall be reported immediately to the Contracting Officer. Any repair to damaged sewer lines shall be performed by the Contractor and shall be inspected and approved by the Line Section of the Navy Public Works Center (PWC), Utilities Department, Wastewater Division, prior to back-filling.
- 4. The Contractor shall be responsible for any regulatory fines or penalties that may be imposed by environmental regulatory agencies in the event of a sewage overflow or spill resulting from construction operations.
- 5. The Contractor shall reimburse the Navy PWC for any emergency response effort that may be required by the Navy to mitigate the adverse effects of any sewage overflow or spill resulting from construction operations.
- 6. Any manhole frame and cover affected by the construction work shall be adjusted to the new finish grade.
- 7. Any Navy sewer manhole frame and cover located within the new 6-ft. shoulder shall be traffic rated and adjusted to the new finish grade.
- 8. Construction dewatering into the Navy Sewer system is prohibited.
- 9. The Contractor shall notify the Navy at least two (2) weeks prior to the start of construction. Navy Region Hawaii points of contact are Ms. Shayne Hirayama at 471-1170, extension 243 and Mr. Vernon Sato at 368-3155.

FED. ROAD DIST. NO.	STATE	FED. AID PROJ. NO.	FISCAL YEAR	SHEET NO.	TOTAL SHEETS
HAWAII	HAW.	CMAQ-099-1(22)	2005	4	60

ORIGINAL PLAN	SURVEY PLOTTED BY	DATE
NOTED BOOK	DRAWN BY	
NOTED BOOK	DESIGNED BY	
NOTED BOOK	CHECKED BY	
NOTED BOOK	CHECKED BY	

STATE OF HAWAII
DEPARTMENT OF TRANSPORTATION
HIGHWAYS DIVISION

UTILITY NOTES

KAMEHAMEHA HIGHWAY BIKEWAY
Vicinity of Radford Drive to Arizona Memorial
Federal Aid Project No. CMAQ-099-1(22)

Scale: None Date: Aug, 2004

SHEET No. 1 OF 1 SHEETS

FED. ROAD DIST. NO.	STATE	FED. AID PROJ. NO.	FISCAL YEAR	SHEET NO.	TOTAL SHEETS
HAWAII	HAW.	CMAQ-099-1(22)	2005	C.O. 4 S-1	60

HECO NOTES

1. Location of HECO Facilities

The location of HECO's overhead and underground facilities shown on the plans are from existing records with varying degrees of accuracy and are not guaranteed as shown. The contractor shall verify in the field the locations of the facilities and shall exercise proper care in excavating and working in the area. The contractor shall be responsible for any damages to HECO's facilities whether shown or not shown on the plans.

2. Compliance with Hawaii Occupational Safety and Health Laws

The contractor shall comply with the state of Hawaii's Occupational Safety and Health laws and regulations, including without limitation, those related to working on or near exposed or energized exposed or energized electrical lines and equipment.

3. Excavation Permit

The contractor shall obtain an excavation permit from HECO's Technical Division (543-5654) located at 820 Ward Avenue, 4th floor, two weeks prior to starting construction. Please refer to our request number at that time.

4. Caution!!! Electrical Hazard!!!

Existing HECO overhead and underground lines are energized and will remain energized during construction unless prior special arrangements have been made with HECO. Only HECO personnel are to handle these energized lines and erect temporary guards to protect these lines from damage. the contractor shall work cautiously at all times to avoid accidents and damage to existing HECO facilities, which can result in electrocution.

5. Overhead Lines

State law requires that a worker and the longest object he or she may contact cannot come closer than a minimum radial clearance of 10 feet when working close to or under any overhead lines rated 50KV and below. For each additional KV above 50KV, an additional 0.4 inch shall be added to the 10-foot clearance requirement. The preceding information on line clearance requirements is provided as a convenience and it is the contractor's responsibility to be informed of and comply with any revisions or amendments to the law.

Should the contractor anticipate that his work will result in the need to encroach within the minimum required clearance at any time, the contractor shall notify HECO at least four (4) weeks prior to the planned encroachment so that, if feasible, the necessary protections (e.g. relocate, de-energize, or blanket HECO lines) can be put in place. HECO's cost of safeguarding its lines will be charged to the contractor.

Contact HECO's customer installations department at 543-7846 for assistance in identifying and safeguarding overhead power lines.

Refer to Section X of HECO's Electric Service Installation Manual for additional guidelines when working around HECO's facilities. A copy may be obtained from HECO's Customer Installations Department.

6. Pole Bracing

A minimum clearance of 10 feet must be maintained when excavating around utility poles and/or their anchor system to prevent weakening or pole support failure. Should work require excavating within 10 feet of a pole and/or its anchor system, the contractor shall protect, support, secure, and take all other precautions to prevent damage to or leaning of these poles. The contractor is responsible for all associated costs to brace, repair, or straighten poles. All means of structural support for the pole proposed by the contractor shall first be reviewed by HECO before implementation. For pole bracing instructions, the contractor shall call the HECO Construction and Maintenance Dept., customer & system superintendent at 543-4223 a minimum of two (2) weeks in advance.

7. Underground Lines

The contractor shall exercise extreme caution whenever construction crosses or is in close proximity of underground lines. HECO's existing electrical cables in the area are energized and will remain energized during construction. Only HECO personnel are to handle these cables and erect temporary guards to protect these cables from damage. The cost of HECO's assistance in providing proper support and protection of its underground lines will be charged to the contractor. The contractor shall exercise due care and precautions to avoid disturbing any energized cables and temporary guards and shall work cautiously at all times to avoid accidents. For verification of underground lines or for assistance in providing proper support and protection of these lines, the contractor shall call HECO's Construction & Maintenance Dept., Customer & System Superintendent, at 543-4223, a minimum of two (2) weeks in advance.

8. Underground Fuel Pipelines

The contractor shall exercise extreme caution whenever Construction Crosses or is in close proximity of HECO's Underground fuel oil pipelines. Special precautions are required when excavating near HECO's underground fuel oil pipeline (see HECO instruction consultants / contractors on "excavation near HECO's underground fuel pipeline

9. Excavations

When trench excavation is adjacent to or beneath HECO's existing structures or facilities, the contractor is responsible for:

- Sheeting and bracing the excavation to prevent slides, cave-ins, and settlements.
- Protecting existing structures or facilities with beams, struts, or under-pinnings.
- Backfilling with proper backfill material including special thermal backfill where existing (refer to engineering department for thermal backfill specifications). borne by the contractor.


10. Relocation of HECO facilities

Any work required to relocate or modify HECO facilities shall be done by HECO, or by the contractor under HECO's supervision. The contractor shall be responsible for all coordination, and shall provide necessary support for HECO's work, which may include, but not be limited to, excavation and backfill, permits and traffic control, and restoration of pavement, sidewalks, and other facilities.

All costs associated with any relocation or modification (either temporary or permanent) for the convenience of the contractor, or to enable the contractor to perform his work in a safe and expeditious manner in fulfilling his contract obligations shall be borne by the contractor.

11. Conflicts

The contractor acknowledges that HECO is not responsible for any delay or damage that may arise as a result of any conflicts discovered or identified with respect to the location or construction of HECO's electrical facilities in the field, regardless of whether the contractor has met the requested minimum advance notices. In order to minimize any delay or impact arising from such conflicts, the contractor shall notify HECO immediately upon discovery or identification of such conflict.

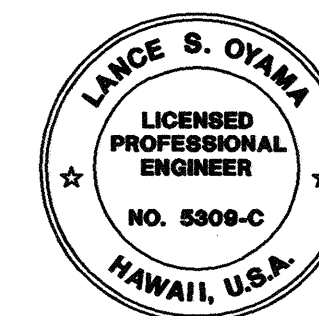

THIS WORK WAS PREPARED BY ME OR UNDER MY SUPERVISION AND CONSTRUCTION OF THIS PROJECT WILL BE UNDER MY OBSERVATION.

Lance S. Oyama 4/30/06
SIGNATURE DATE

"OBSERVATION OF CONSTRUCTION" IS DEFINED IN CHAPTER 16-115, HAWAII ADMINISTRATIVE RULES ENTITLED "PROFESSIONAL ENGINEERS, ARCHITECTS, SURVEYORS AND LANDSCAPE ARCHITECTS".

STATE OF HAWAII DEPARTMENT OF TRANSPORTATION HIGHWAYS DIVISION	
NOTES - 4	
KAMEHAMEHA HIGHWAY BIKEWAY Vicinity of Radford Drive to Arizona Memorial Federal Aid Project No. CMAQ-099-1(22)	
Scale:	Date: August 2005
SHEET No. 1 OF 2 SHEETS	

C.O. 4 S-1

ORIGINAL PLAN	DATE
CHECKED BY	
DESIGNED BY	
TRACED BY	
NOTE BOOK	
QUANTITIES BY	
CHECKED BY	

HECO NOTES (CONT'D)

12. Damage to HECO facilities

The Contractor shall be responsible for the protection of all HECO surface and subsurface utilities and shall be responsible for any damages to HECO's facilities as a result of his operations. The Contractor shall immediately report such damages to HECO's trouble dispatcher at 548-7961. Repair work shall be done by HECO or by the contractor under HECO's supervision. Costs for damages to HECO's facilities shall be borne by the contractor.

13. HECO Stand-By Personnel

The Contractor may request HECO to provide an inspector to stand-by during Construction near HECO facilities. The cost of such inspection will be charged to the Contractor.

The Contractor shall call HECO Construction and Maintenance Dept., Customer & systems superintendent at 543-4223 a minimum of seven (7) calander days in advance to arrange for HECO stand-by-personnel.

14. Clearances

The following clearances shall be maintained between HECO's ductline and all adjacent structures (charted and uncharted) in the trench:

Structure Type	Minimum Clearance (Inches)
Water lines, parallel	36
Water lines, crossing	12(a)
Sewer lines, parallel	36(b)
Sewer lines, crossing	24(c)
Drain lines, parallel	12
Drain lines, crossing	6(d)
Electrical and gas lines, parallel	12
Electrical and gas lines, crossing	12
Telephone lines, parallel	6(d)
Telephone lines, crossing	6(d)
Chevron oil lines, parallel	36
Chevron oil lines, crossing	48 below oil line (e)

- A. The minimum vertical clearances to water lines crossing electrical ductlines can be reduced to 6 inches if the electrical ductline structure is smaller than 16 inches, is concrete encased, and is below the water line.
- B. A minimum horizontal clearance of 36 inches is required between new handholes and existing sewer laterals.
- C. The minimum vertical clearances to sewer pipes crossing electrical ductlines can be reduced to 12 inches if the sewer pipe is jacketed in concrete.
- D. The minimum clearances shall be increased to 12 inches if the electrical ductline is direct buried.
- E. The minimum vertical clearances to oil lines crossing electrical ductlines can be reduced to 24 inches below oil lines if the crossings are encased in 6 inches of concrete.
- F. The contractor shall notify the construction manager & HECO of any heat sources (power cable duct bank, steamline, etc.) encountered that are not properly identified on the drawing.

The following clearance shall be maintained between HECO's fuel oil pipelines and all adjacent structures: 24-inches, parallel or crossing. The minimum clearance can be reduced to 12 inches (parallel and below only) if the structure is jacketed in concrete.

15. Indemnity

The contractor shall indemnify, defend and hold harmless HECO from and against all losses, damages, claims, and actions, including but not limited to reasonable attorney's fees and costs based upon or arising out of damage to property or injuries to persons, or other tortious acts caused or contributed to by contractor or anyone acting under its direction or control or on its behalf; provided contractor's indemnity shall not be applicable to any liability based upon the sole negligence of HECO.

Additional Notes When Work Involves Constr. of HECO Facilities

16. Schedule

Contractor shall furnish his construction schedule _ working days prior to starting work on HECO facilities. Contractor shall give HECO, in writing, _ working days notice to proceed with HECO's portion of work.

17. Authority

All construction, restoration work, and inspection shall be subject to whichever governmental agency has authority over the work.

18. Specifications

Construction of HECO's underground facilities shall be constructed in accordance with the latest revisions of HECO specifications cs7001, cs7003, cs7202, cs9301, and cs9401 and applicable HECO standards.

19. Construction

Contractor shall furnish all labor, materials, equipment, and services to properly perform and fully complete all work shown on the contract, drawings, and specifications. All materials shall be new and manufactured in the United States of America. All manhole, handhole, and ductline installations shall be inspected and approved by HECO prior to excavation and prior to placing concrete. Contractor shall notify HECO's Inspection Division at 543-4356 at least 48 hours prior to placing concrete.

20. Stakeout

The contractor shall stakeout all proposed HECO facilities within the project area so as to not conflict with any utility (existing or proposed) and any proposed construction or improvement work for verification by HECO before proceeding with HECO work.

21. Ductlines


All ductline installations shall be pvc schedule 40 encased in concrete, unless otherwise noted. All completed ductlines shall be mandrel tested by the contractor in the presence of HECO's inspector using HECO's standard practice. The contractor shall install a 1/8" polyolefin pull line in all completed ductlines after mandrel testing is complete.

22. Joint Pole Removal

The last joint pole occupant off the poles shall remove the poles.

FED. ROAD DIST. NO.	STATE	FED. AID PROJ. NO.	FISCAL YEAR	SHEET NO.	TOTAL SHEETS
HAWAII	HAW.	CMAQ-099-1(22)	2005	C.O. 4 S-2	60

SURVEY PLOTTED BY	DATE
DRAWN BY	
TRACED BY	
NOTED BY	
CHECKED BY	
ORIGINAL PLAN	
NOTE BOOK	
No.	

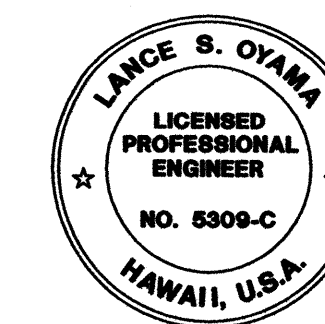

THIS WORK WAS PREPARED BY ME OR UNDER MY SUPERVISION AND CONSTRUCTION OF THIS PROJECT WILL BE UNDER MY OBSERVATION.

Signature: Lance S. Oyama, Date: 4/30/06

"OBSERVATION OF CONSTRUCTION" IS DEFINED IN CHAPTER 16-115, HAWAII ADMINISTRATIVE RULES ENTITLED "PROFESSIONAL ENGINEERS, ARCHITECTS, SURVEYORS AND LANDSCAPE ARCHITECTS".

STATE OF HAWAII DEPARTMENT OF TRANSPORTATION HIGHWAYS DIVISION	
NOTES - 5	
KAMEHAMEHA HIGHWAY BIKEWAY Vicinity of Radford Drive to Arizona Memorial Federal Aid Project No. CMAQ-099-1(22)	
Scale:	Date: August 2005
SHEET No. 2 OF 2 SHEETS	

C.O. 4 S-2

WATER POLLUTION AND EROSION CONTROL NOTES:

6. A maintenance inspection report shall be made promptly after each inspection by the Contractor.
7. The Contractor shall select a minimum of three personnel who shall be responsible for inspections, maintenance and repair activities and filling out the inspection and maintenance report.
8. Personnel selected for the inspection and maintenance responsibilities shall receive training from the Contractor. They shall be trained in all the inspection and maintenance practices necessary for keeping the erosion and sediment controls used onsite in good working order.

- D. GOOD HOUSEKEEPING BEST MANAGEMENT PRACTICES:*

a. Applicable materials or substances listed below are expected to be present onsite during construction. Other materials and substances not listed below shall be added to the inventory.

b. Material Management Practices shall be used to reduce the risk of spills or other accidental exposure of materials and substances to storm water runoff. An effort shall be made to store only enough product as is required to do the job.

- c. All materials stored onsite shall be stored in a neat, orderly manner in their appropriate containers and if possible under a roof or other enclosure.
- d. Products shall be kept in their original containers with the original manufacturer's label.
- e. Substances shall not be mixed with one another unless recommended by the manufacturer.
- f. Whenever possible, a product shall be used up completely before disposing of the container.
- g. Manufacturer's recommendations for proper use and disposal shall be followed.
- h. The Contractor shall conduct a daily inspection to ensure proper use and disposal of materials onsite.

- a. Products shall be kept in original containers unless they are not resealable.
- b. Original labels and material safety data sheets (MSDS) shall be retained.
- c. Surplus products shall be disposed of according to manufacturers' instructions or local and State recommended methods.

a. The following product specific practices shall be followed onsite:

- 1) *Petroleum Based Products:*
All onsite vehicles shall be monitored for leaks and receive regular preventive maintenance to reduce the chance of leakage. Petroleum products shall be stored in tightly sealed containers which are clearly labeled. Any asphalt substances used onsite shall be applied according to the manufacturer's recommendation.
- 2) *Fertilizers:*
Fertilizers used shall be applied only in the minimum amounts recommended by the manufacturer. Once applied, fertilizer shall be worked into the soil to limit exposure to storm water. Storage shall be in a covered shed. The contents of any partially used bags of fertilizer shall be transferred to a sealable plastic bin to avoid spills.

1. Waste Materials

All waste material

All waste materials shall be collected and stored in a securely lidded metal dumpster. The dumpster shall meet all local and State solid waste management regulations. All trash and construction debris from the site shall be deposited in the dumpster. The dumpster shall be emptied a minimum of twice per week or as often as is deemed necessary. No construction waste materials shall be buried onsite. The Contractor's supervisory personnel shall be instructed regarding the correct procedure for waste disposal. Notices stating these practices shall be posted in the office trailer and the Contractor shall be responsible for seeing that these procedures are followed.

All hazardous waste materials shall be disposed of in the manner specified by local or State regulations or by the manufacturer. The Contractor's site personnel shall be instructed in these practices and shall be responsible for seeing that these practices are followed.

All sanitary waste shall be collected from the portable units a minimum of once per week, or as required.

1. All control measures shall be inspected at least once each week and following any rainfall event of 0.5 inches or greater.
2. All measures shall be maintained in good working order. If repair is necessary, it shall be initiated within 24 hours after the inspection.
3. Built-up sediment shall be removed from silt fence when it has reached one-third the height of the fence.
4. Silt screen or fence shall be inspected for depth of sediment, tears, to verify that the fabric is securely attached to the fence posts or concrete slab and to verify that the fence posts are firmly in the ground. The bottom of the silt screen shall be inspected and verified that it is buried a minimum of 6 inches below the existing ground.
5. Temporary and permanent seeding and planting shall be inspected for bare spots, washouts and healthy growth.

STATE OF HAWAII
DEPARTMENT OF TRANSPORTATION
HIGHWAYS DIVISION

WATER POLLUTION & EROSION CONTROL NOTES

KAMEHAMEHA HIGHWAY BIKEWAY
Vicinity of Radford Drive to Arizona Memorial
Federal Aid Project No. CMAQ-099-(K22)

Date: Oct, 2003

WATER POLLUTION AND EROSION CONTROL NOTES: -Cont.

FED. ROAD DIST. NO.	STATE	FED. AID PROJ. NO.	FISCAL YEAR	SHEET NO.	TOTAL SHEETS
HAWAII	HAW.	CMAQ-099-1(22)	2005	6	60

a. The following product specific practices shall be followed onsite: -Cont.

3) Paints:

All containers shall be tightly sealed and stored when not required for use. Excess paint shall not be discharged to the highway drainage system but shall be properly disposed of according to manufacturers' instructions or State and local regulations.

4) Concrete Trucks:

Concrete trucks shall be allowed to wash out or discharge drum wash water only at a designated site. Water shall not be discharged in the highway drainage system or waters of the United States. The Contractor shall contact Drinking Water Branch, Department of Health at 586-4258 to receive permission to designate a disposal site. The Contractor shall clean disposal site as required or as requested by the Owner's representative.

b. Offsite Vehicle Tracking:

A stabilized construction entrance shall be provided to help reduce vehicle tracking of sediments. The paved street adjacent to the site entrance shall be cleaned daily or as required to remove any excess mud, cold planed materials, dirt or rock tracked from the site. Dump trucks hauling material from the construction site shall be covered with a tarpaulin.

4. Spill Control Plan

a. A spill prevention plan shall be posted to include measures to prevent and clean up each spill.

b. The Contractor shall be the spill prevention and cleanup coordinator. The Contractor shall designate at least three site personnel who shall receive spill prevention and cleanup training. These individuals shall each become responsible for a particular phase of prevention and cleanup. The names of responsible spill personnel shall be posted in the material storage area and in the office trailer onsite.

c. Manufacturers' recommended methods for spill cleanup shall be clearly posted and site personnel shall be made aware of the procedures and the location of the information and cleanup supplies.

d. Materials and equipment necessary for spill cleanup shall be kept in the material storage area onsite.

e. All spills shall be cleaned up immediately after discovery.

f. The spill area shall be kept well ventilated and personnel shall wear appropriate protective clothing to prevent injury from contact with a hazardous substance.

g. Spills of toxic hazardous material shall be reported to the appropriate State or local government agency, regardless of the size.

E. PERMIT REQUIREMENTS:

1. A National Pollutant Discharge Elimination System (NPDES) Permit is required for Construction Activities of one acre or more. The Contractor shall submit to the Engineer four sets of the Water Pollution and Erosion Control Submittals as detailed in Subsection 209.04 of the specifications.

ORIGINAL PLAN	SURVEY PLOTTED BY	DATE
NOTE BOOK	DESIGNED BY	9/11/03
QUANTITIES BY	CHECKED BY	

STATE OF HAWAII DEPARTMENT OF TRANSPORTATION HIGHWAYS DIVISION
WATER POLLUTION & EROSION CONTROL NOTES
KAMEHAMEHA HIGHWAY BIKEWAY
Vicinity of Radford Drive to Arizona Memorial
Federal Aid Project No. CMAQ-099-1(22)
Date: Oct, 2003