


INDEX TO DRAWINGS	
SHEET NO.	DESCRIPTION
1	TITLE SHEET
2	STANDARD PLANS SUMMARY
3	GENERAL NOTES AND LEGEND
4	UTILITY NOTES
5 - 6	NPDES GENERAL NOTES
7 - 9	TYPICAL SECTION AND DETAILS
10 - 13	ROADWAY PLANS
14 - 22	SIDEWALK GRADE CONTROL PLANS
23 - 27	DRAINAGE PLAN AND DETAILS
28 - 29	MANHOLE DETAILS
30 - 32	PAVEMENT MARKING, LEGEND, DETAILS AND NOTES
33 - 36	PAVEMENT MARKINGS AND SIGNING PLANS
37	LOOP DETECTOR DETAILS
38 - 48	EXISTING UTILITIES
49 - 52	ELECTRICAL PLANS
53 - 60	CROSS SECTIONS


STATE OF HAWAII
DEPARTMENT OF TRANSPORTATION
HIGHWAYS DIVISION
HONOLULU, HAWAII
"AS-BUILT"
PLANS FOR
KAMEHAMEHA HIGHWAY BIKEWAY
VICINITY OF RADFORD DRIVE TO ARIZONA MEMORIAL
FEDERAL AID PROJECT NO. CMAQ-099-1(22)

DISTRICT OF EWA
ISLAND OF OAHU
PROJECT LIMITS

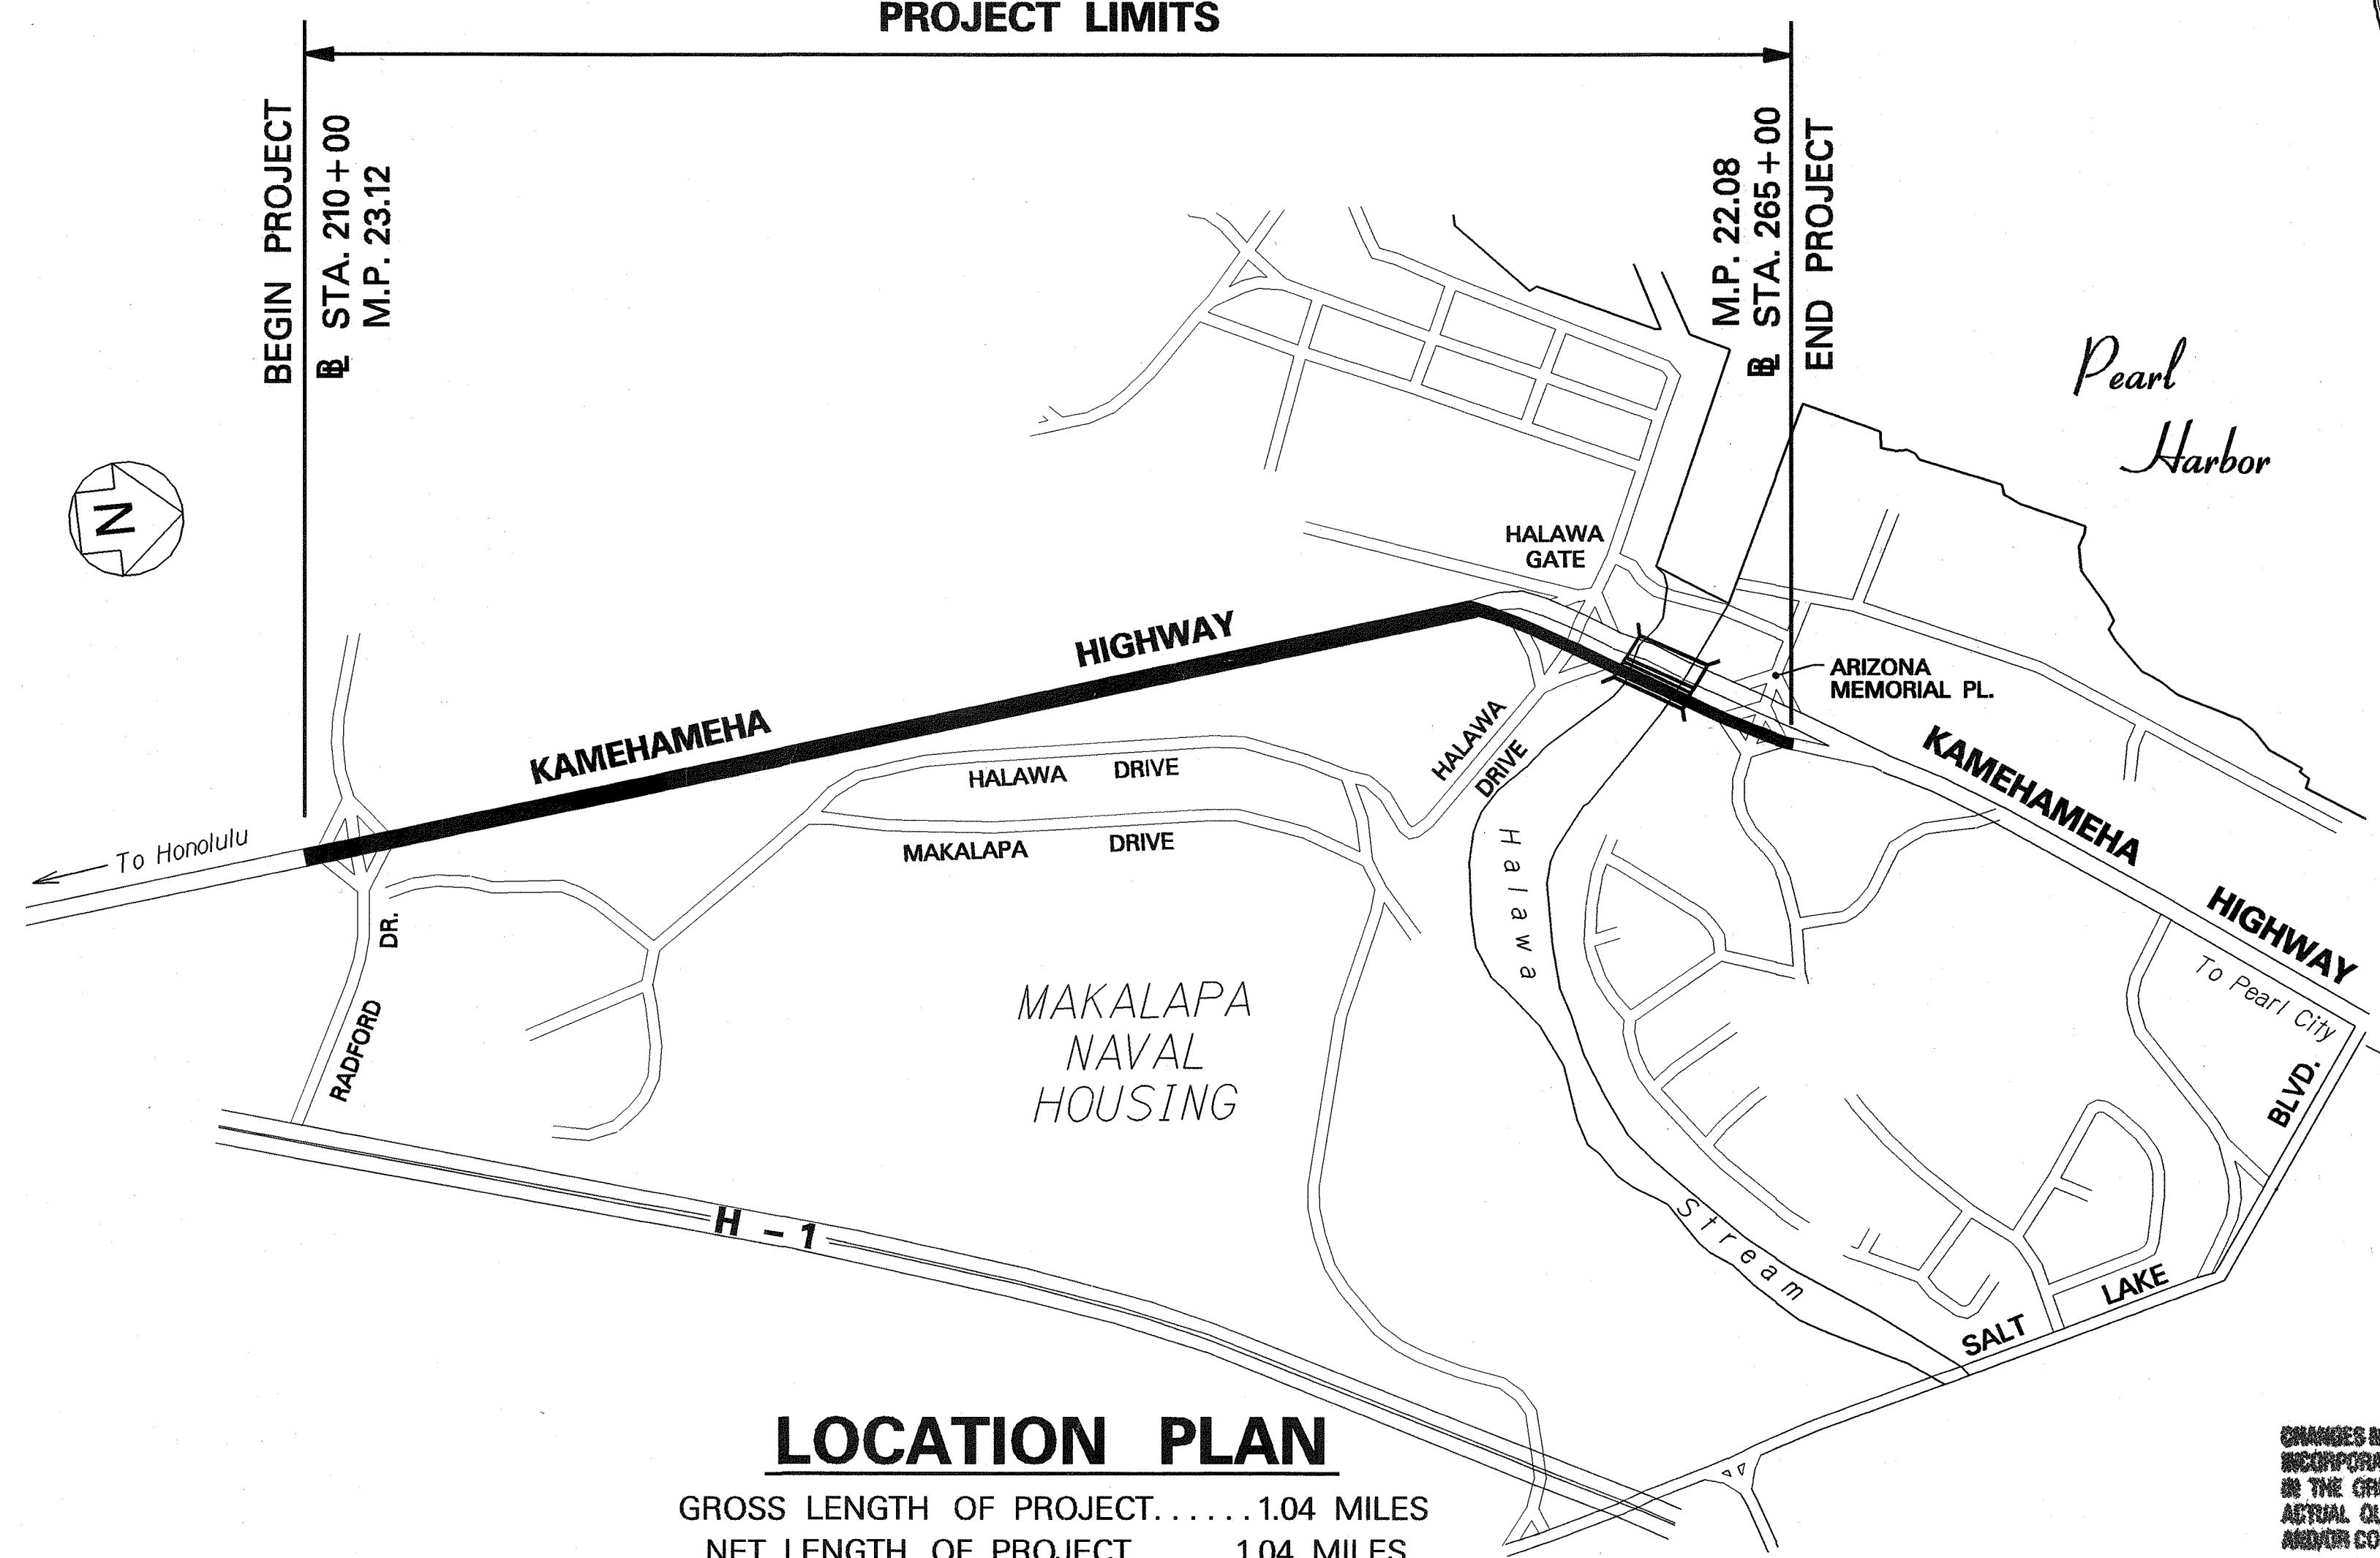




LOCATION PLAN

GROSS LENGTH OF PROJECT.....1.04 MILES
NET LENGTH OF PROJECT.....1.04 MILES

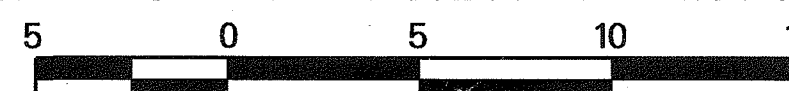


SCALE IN HUNDRED FEET

FED. ROAD DIST. NO.	STATE	FED. AID PROJ. NO.	FISCAL YEAR	SHEET NO.	TOTAL SHEETS
HAWAII	HAW.	CMAQ-099-1(22)	2005	1	60

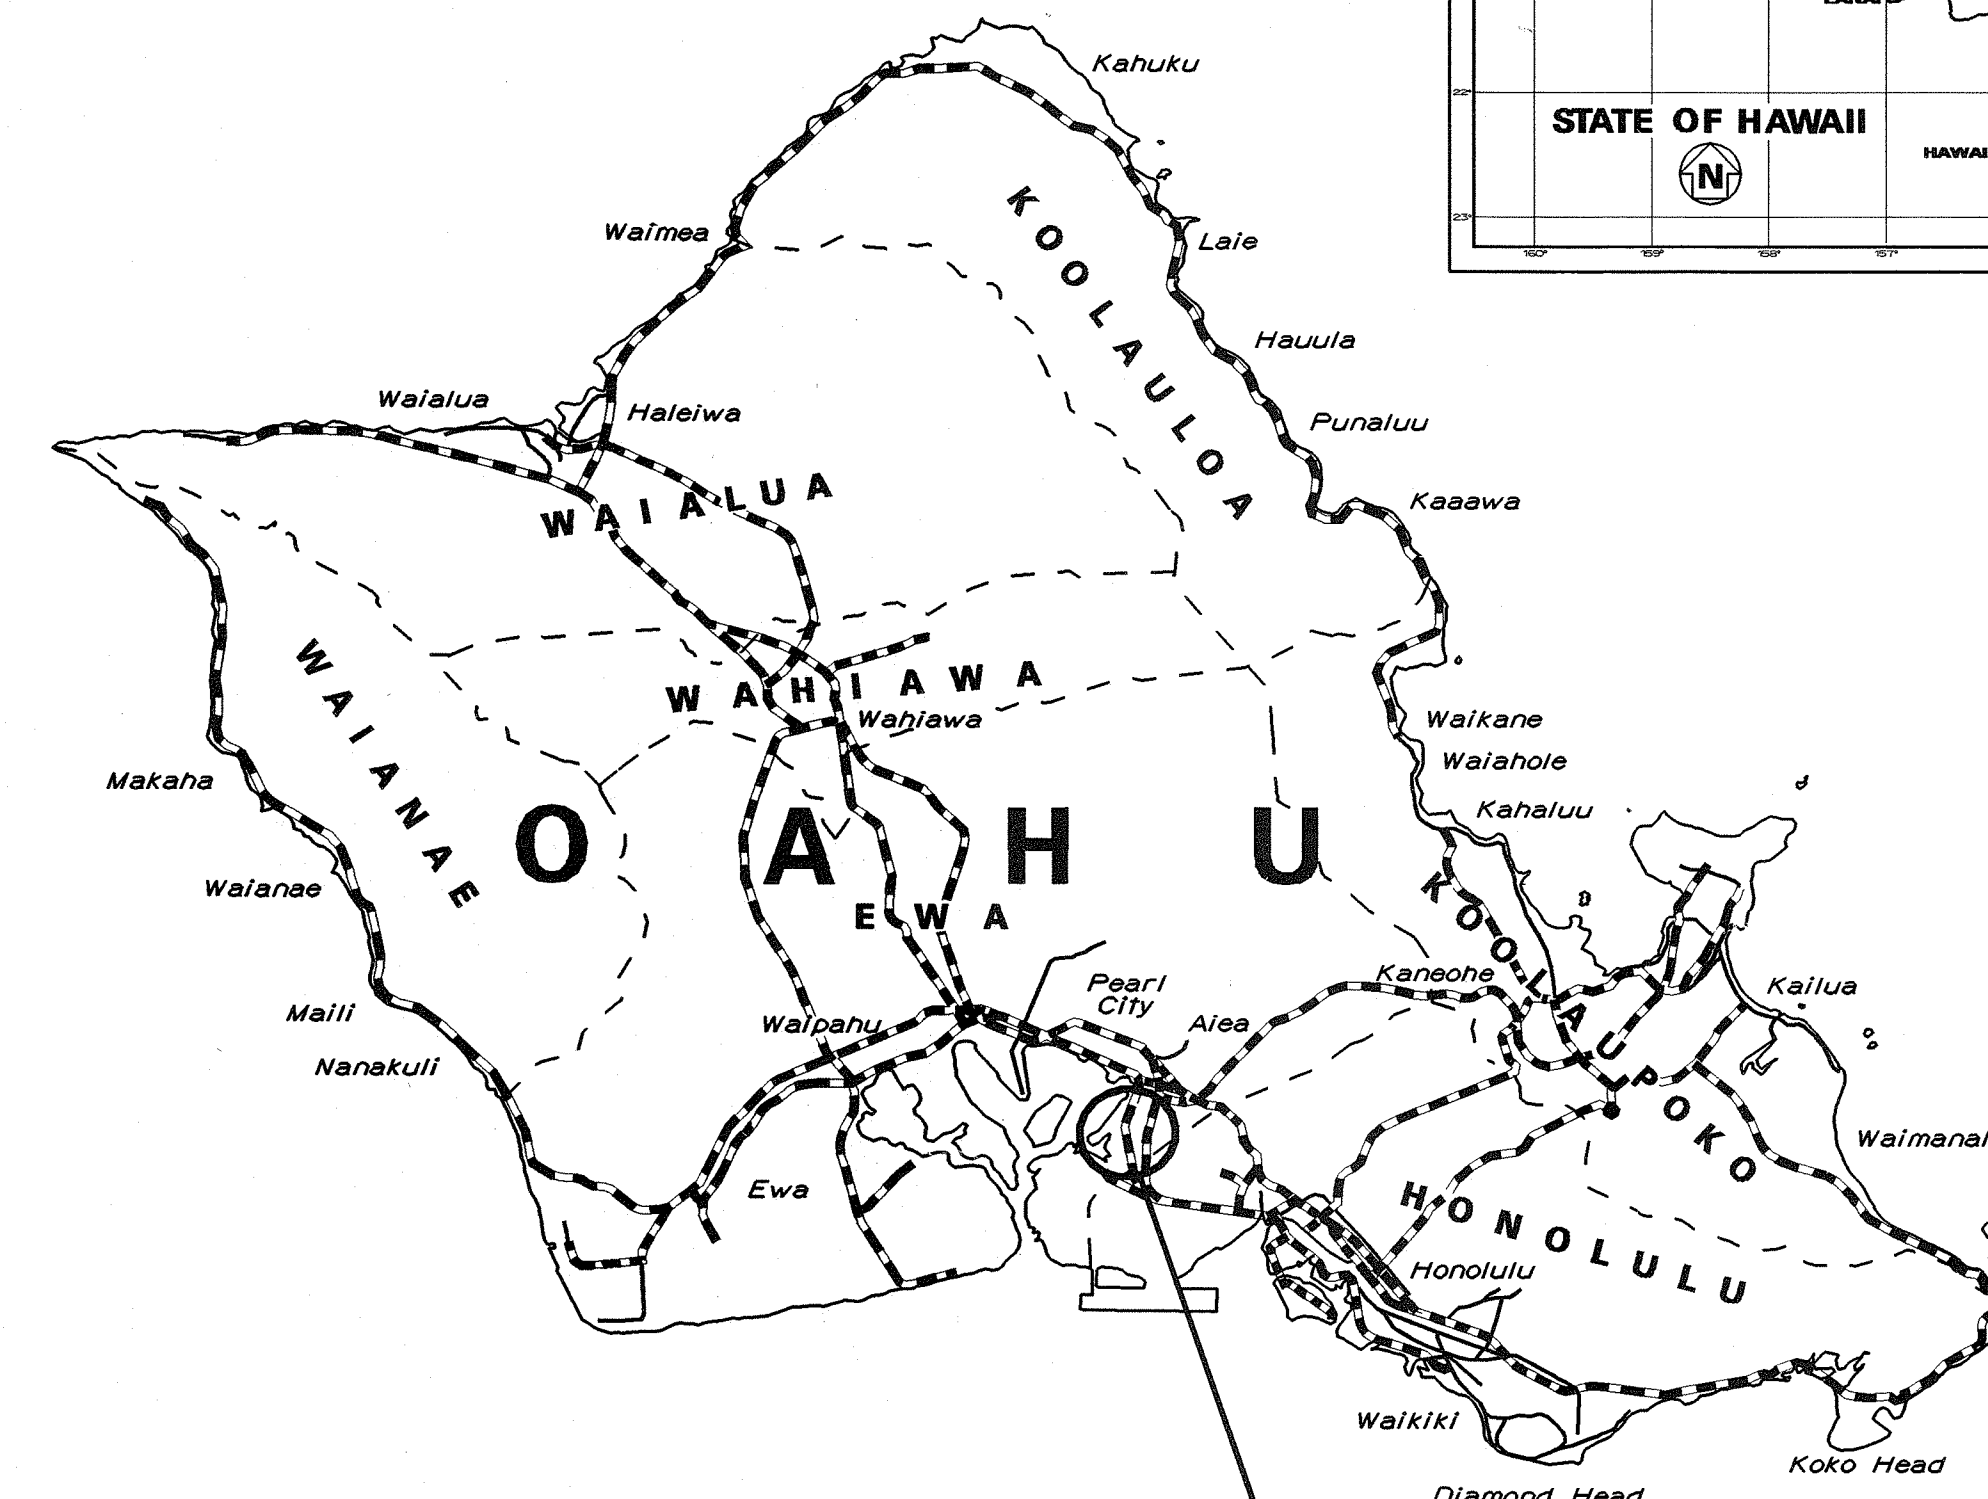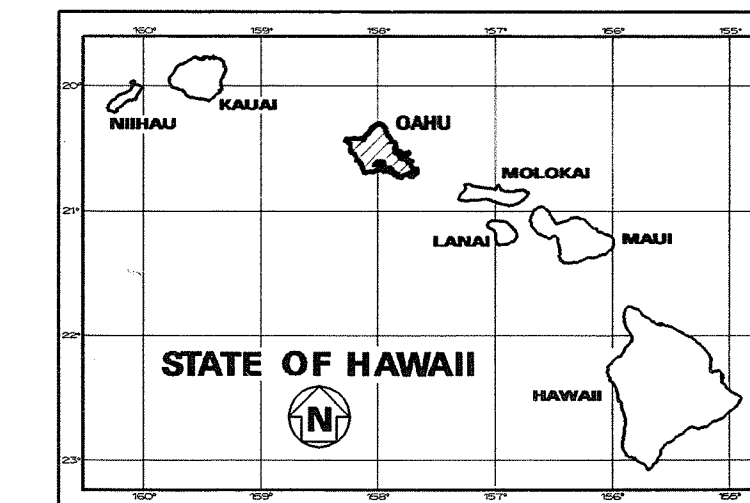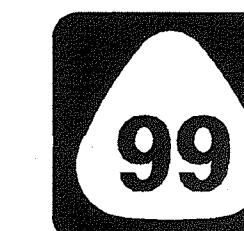

LOCATION OF PROJECT

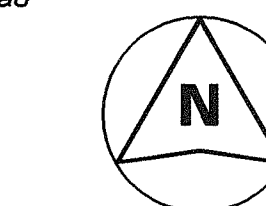

SCALE IN MILES

----- FEDERAL AID INTERSTATE PROJECTS PREVIOUSLY CONSTRUCTED OR UNDER CONSTRUCTION

MILE POST 22.08 TO MILE POST 23.12

DESIGN DESIGNATION

ADT (2001).....30,700
ADT (2021).....32,700
DHV2,950
D70/30
T2.0 %
T₂₄.....3.5 %
V45 M.P.H.

CHANGES MADE DURING CONSTRUCTION HAVE BEEN INCORPORATED ON THESE PLANS EXCEPT CHANGES IN THE ORIGINAL THEORETICAL QUANTITIES. FOR ACTUAL QUANTITIES, REFER TO PROJECT LEDGER AND/OR COMPUTATION BOOK.

[Signature] 23 AUG 2011
RESIDENT ENGINEER DATE

DEPARTMENT OF TRANSPORTATION
STATE OF HAWAII
APPROVED:
[Signature] 11-19-04
for DIR. OF TRANSPORTATION DATE

HWY-D DESIGNED BY
HWY-DD MANAGED BY
692-7570 PHONE
NOV. 2004 DATE