

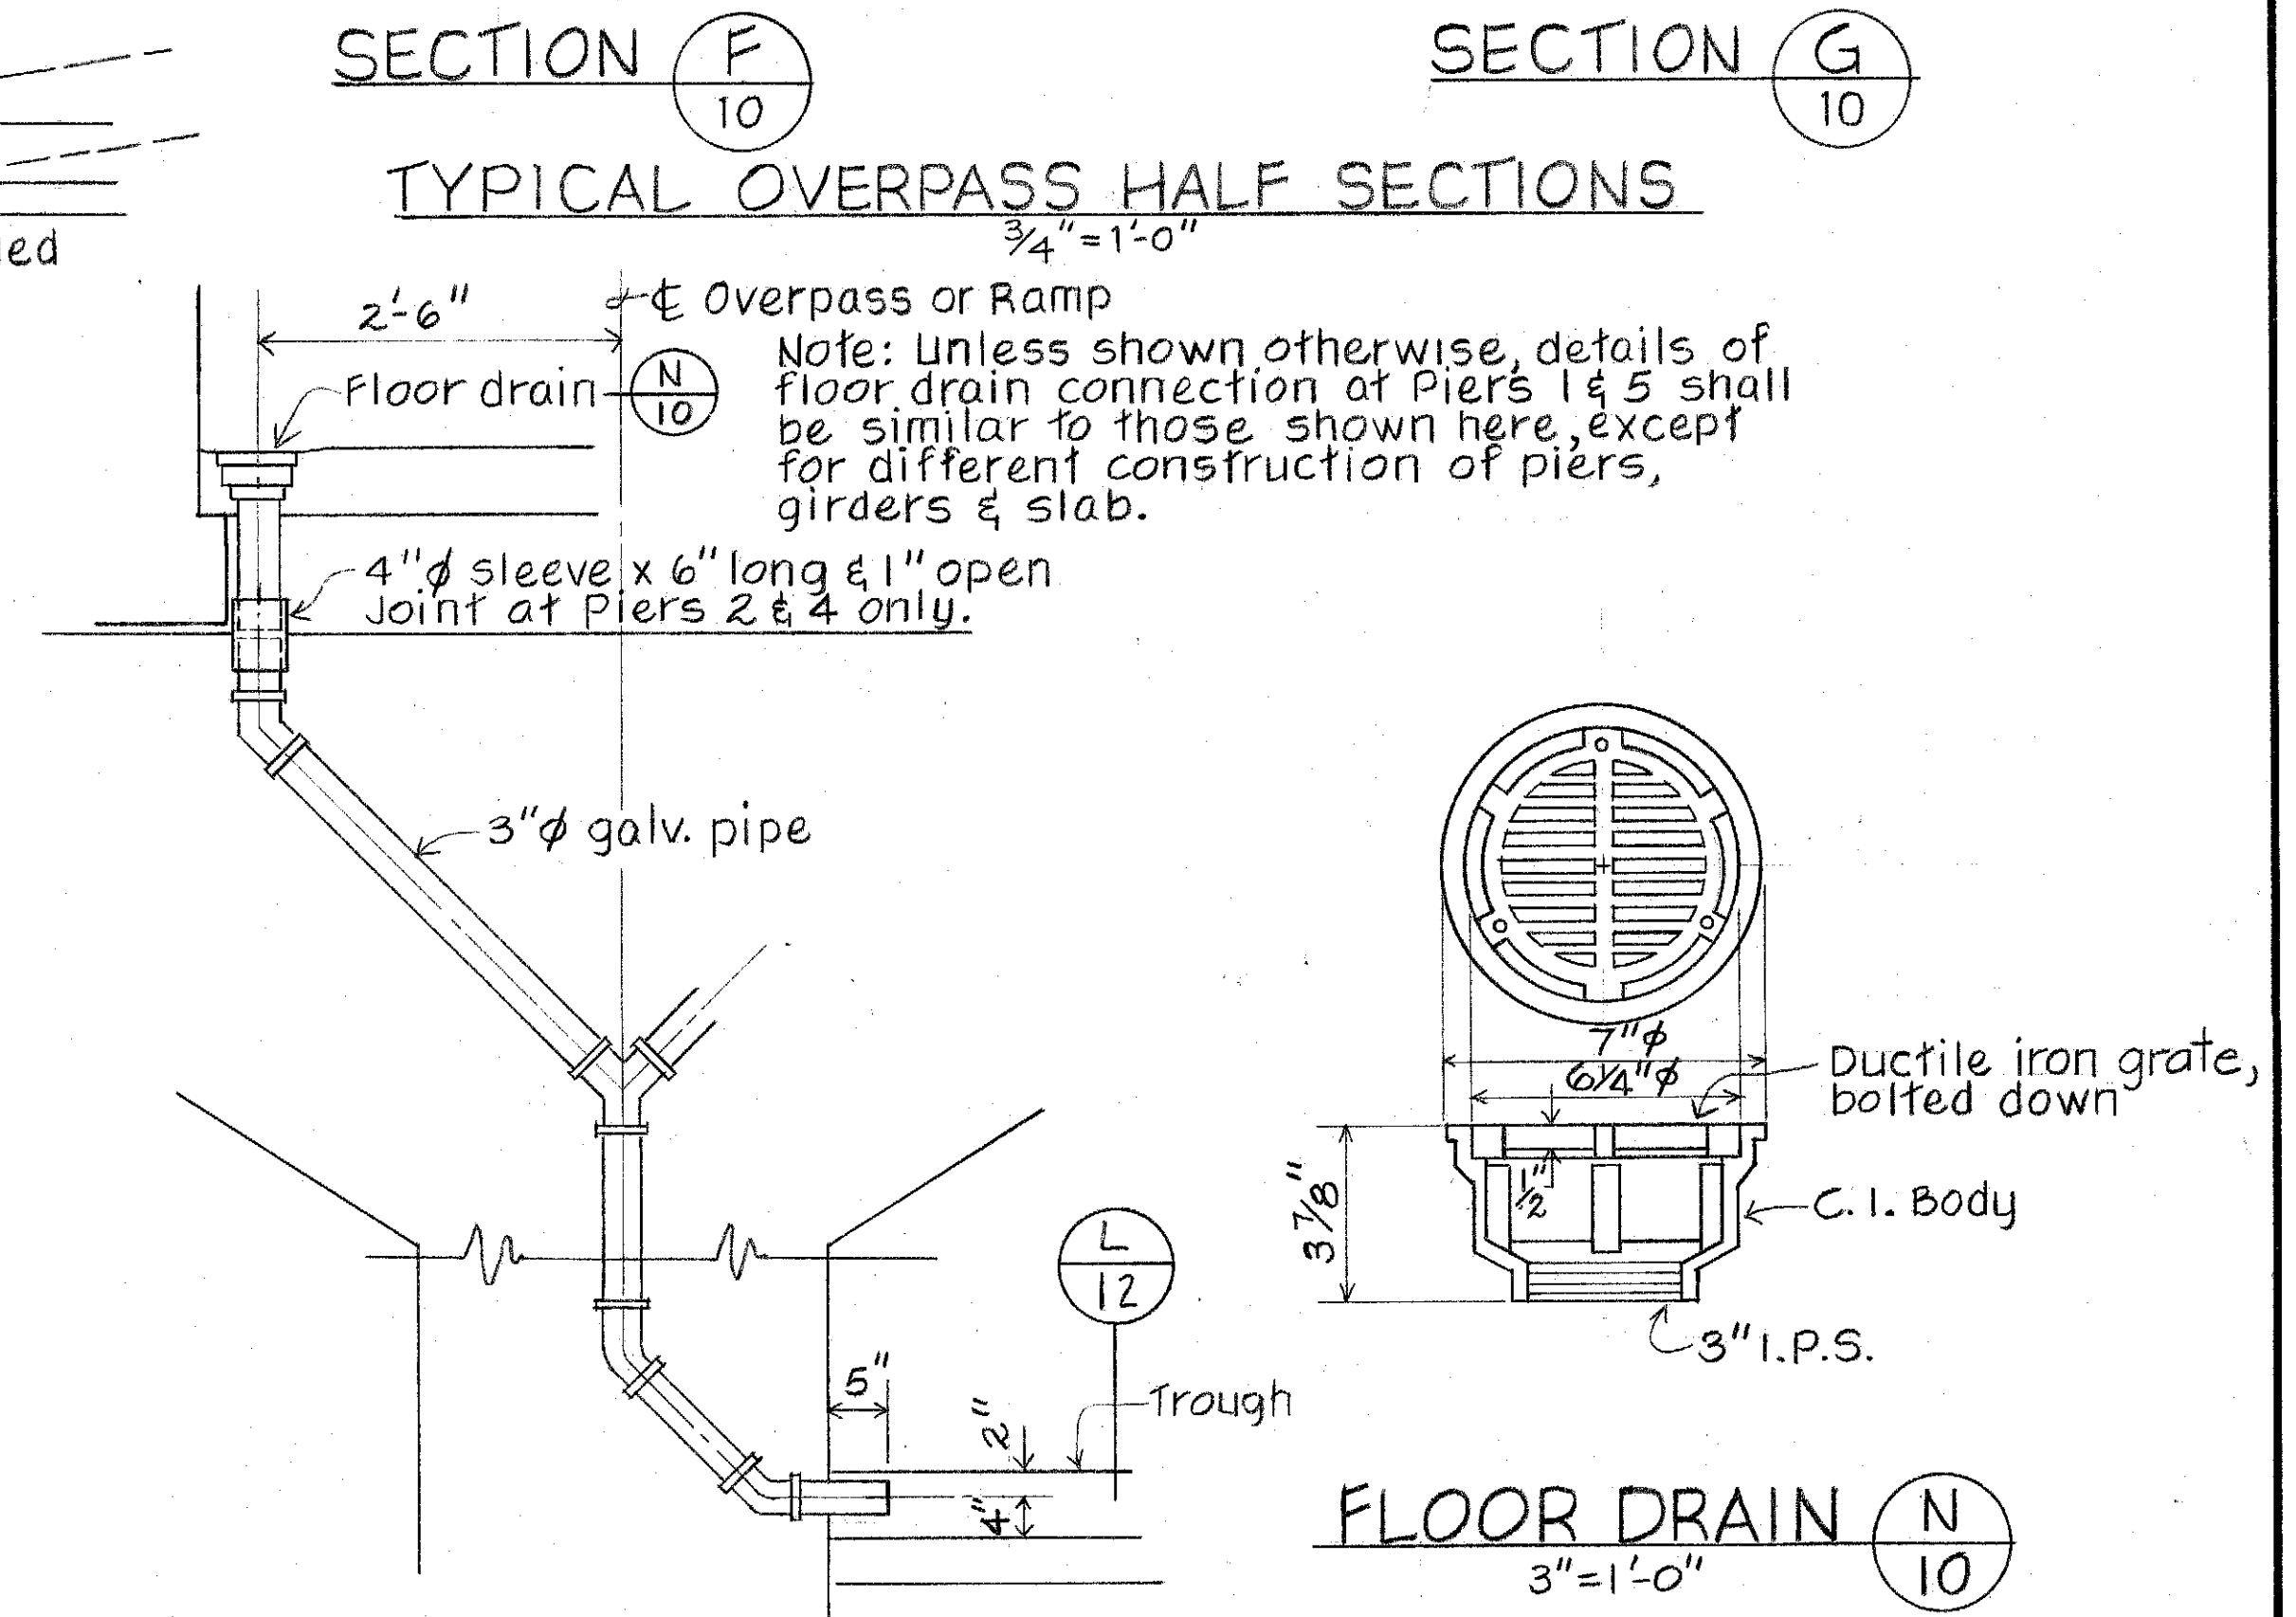
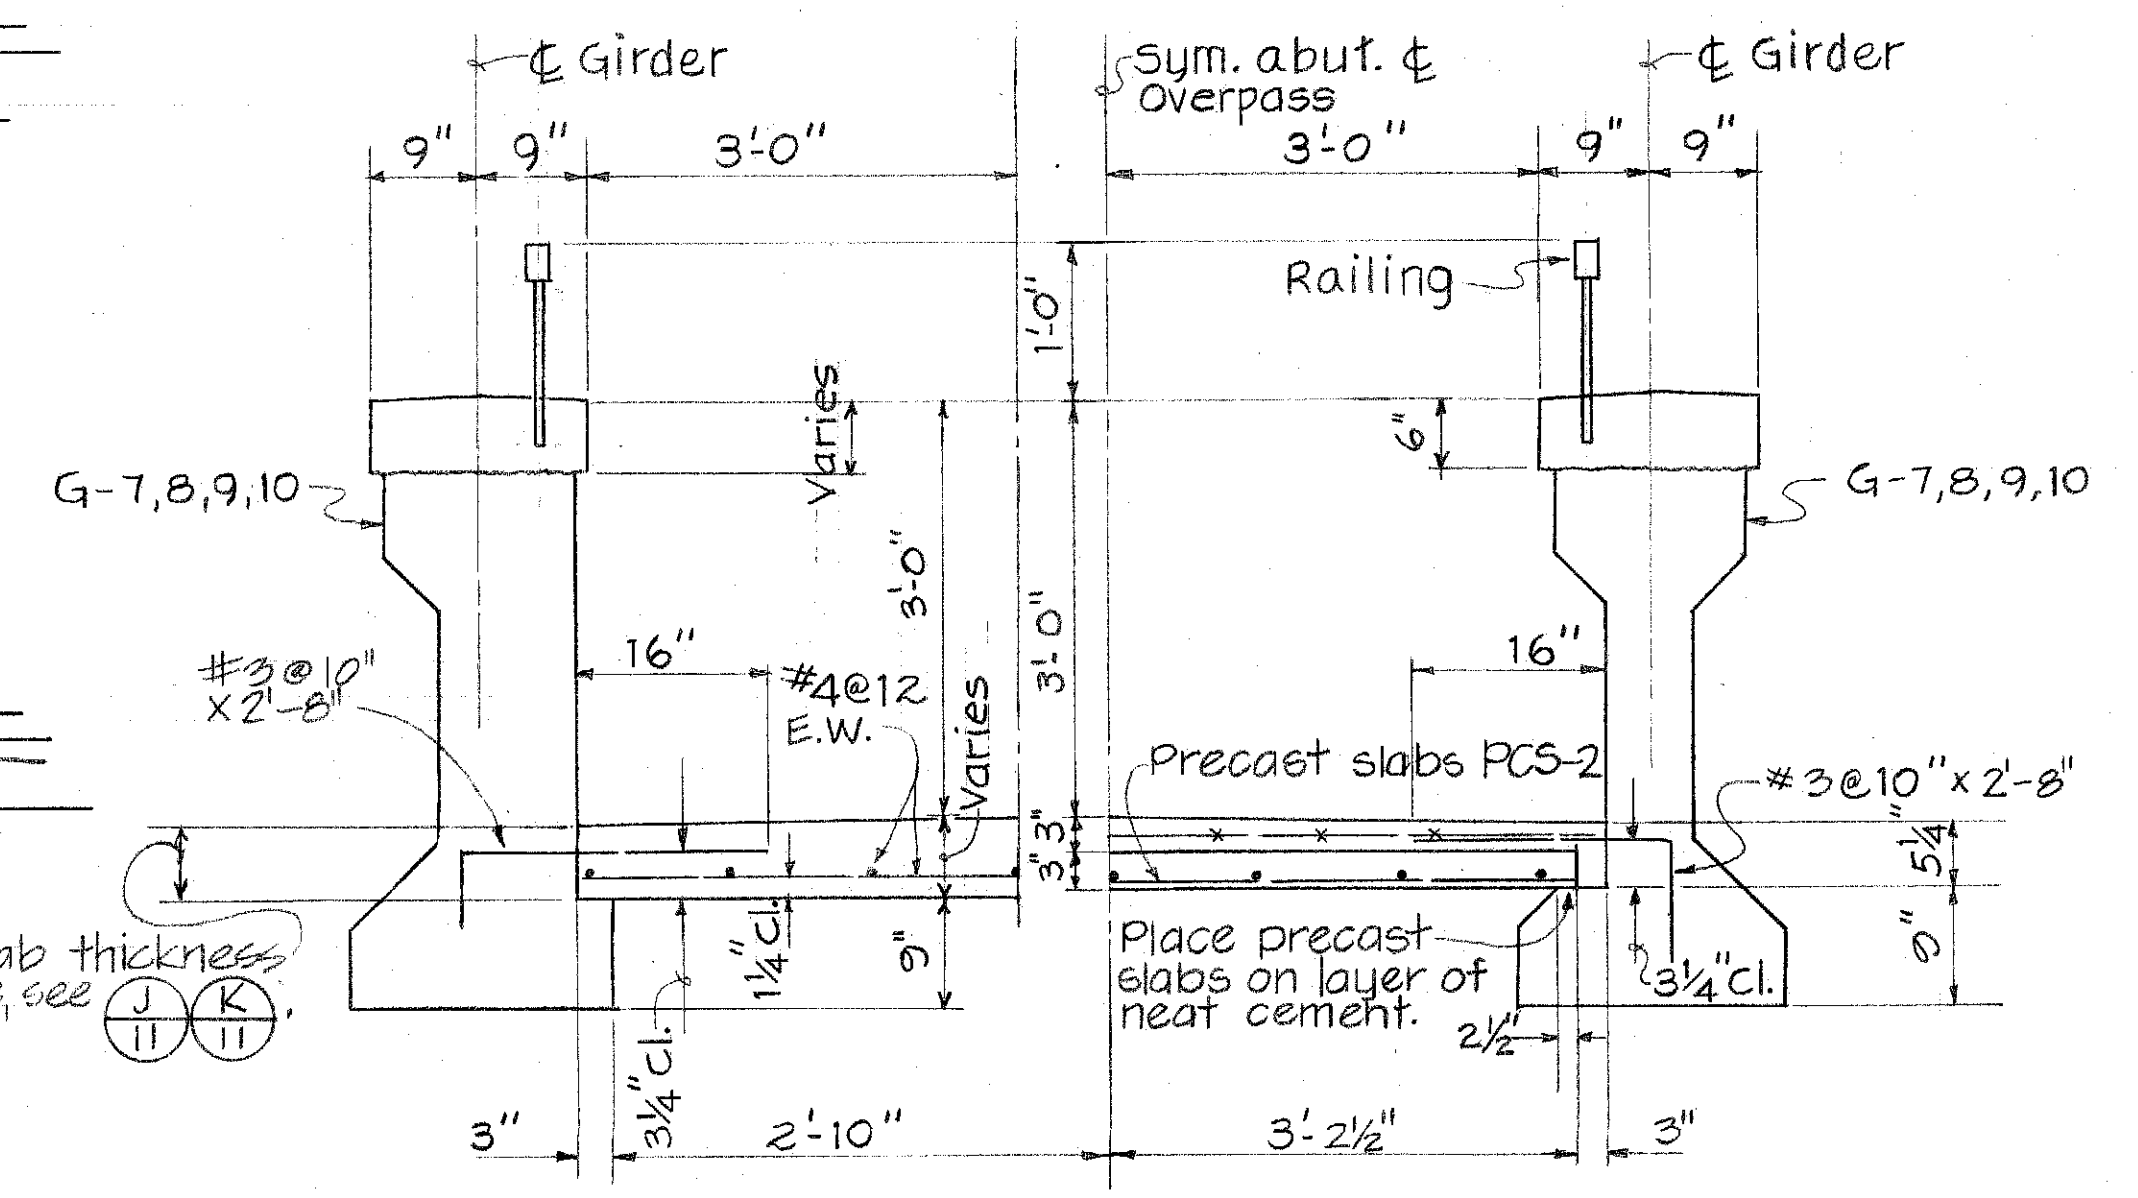
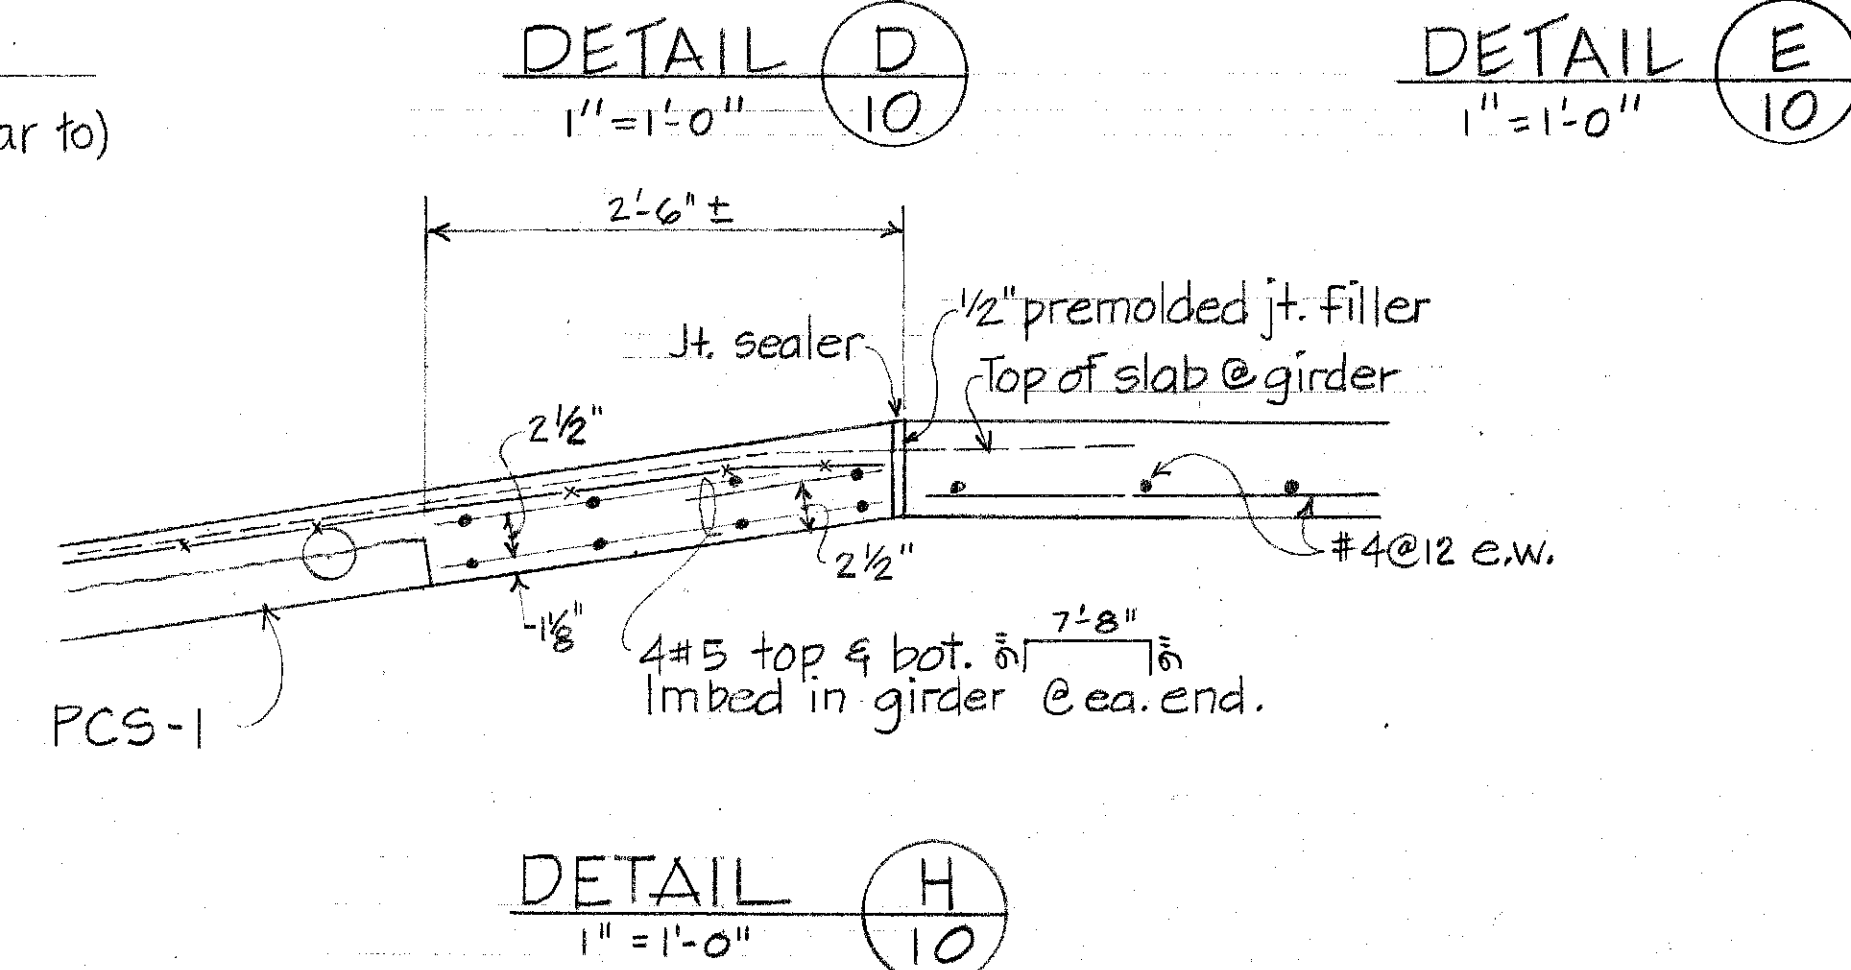
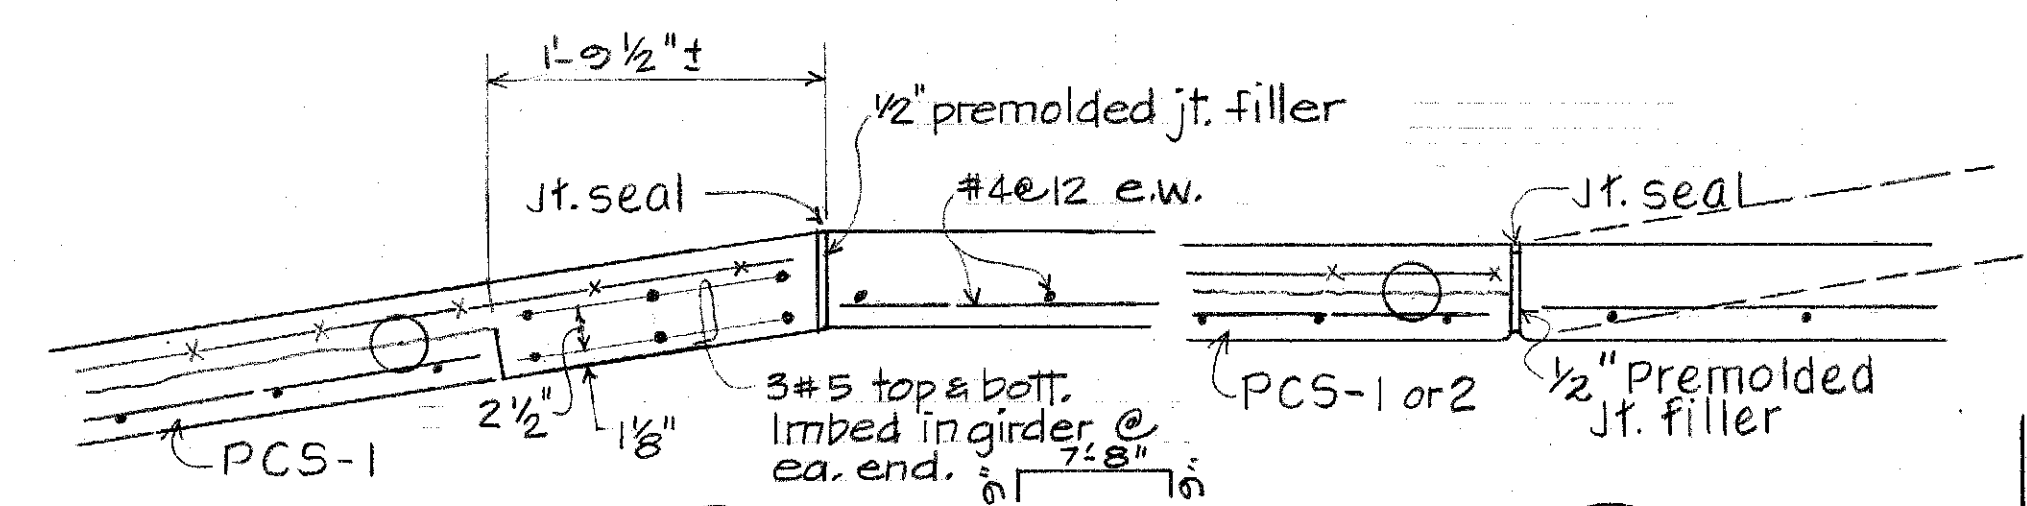
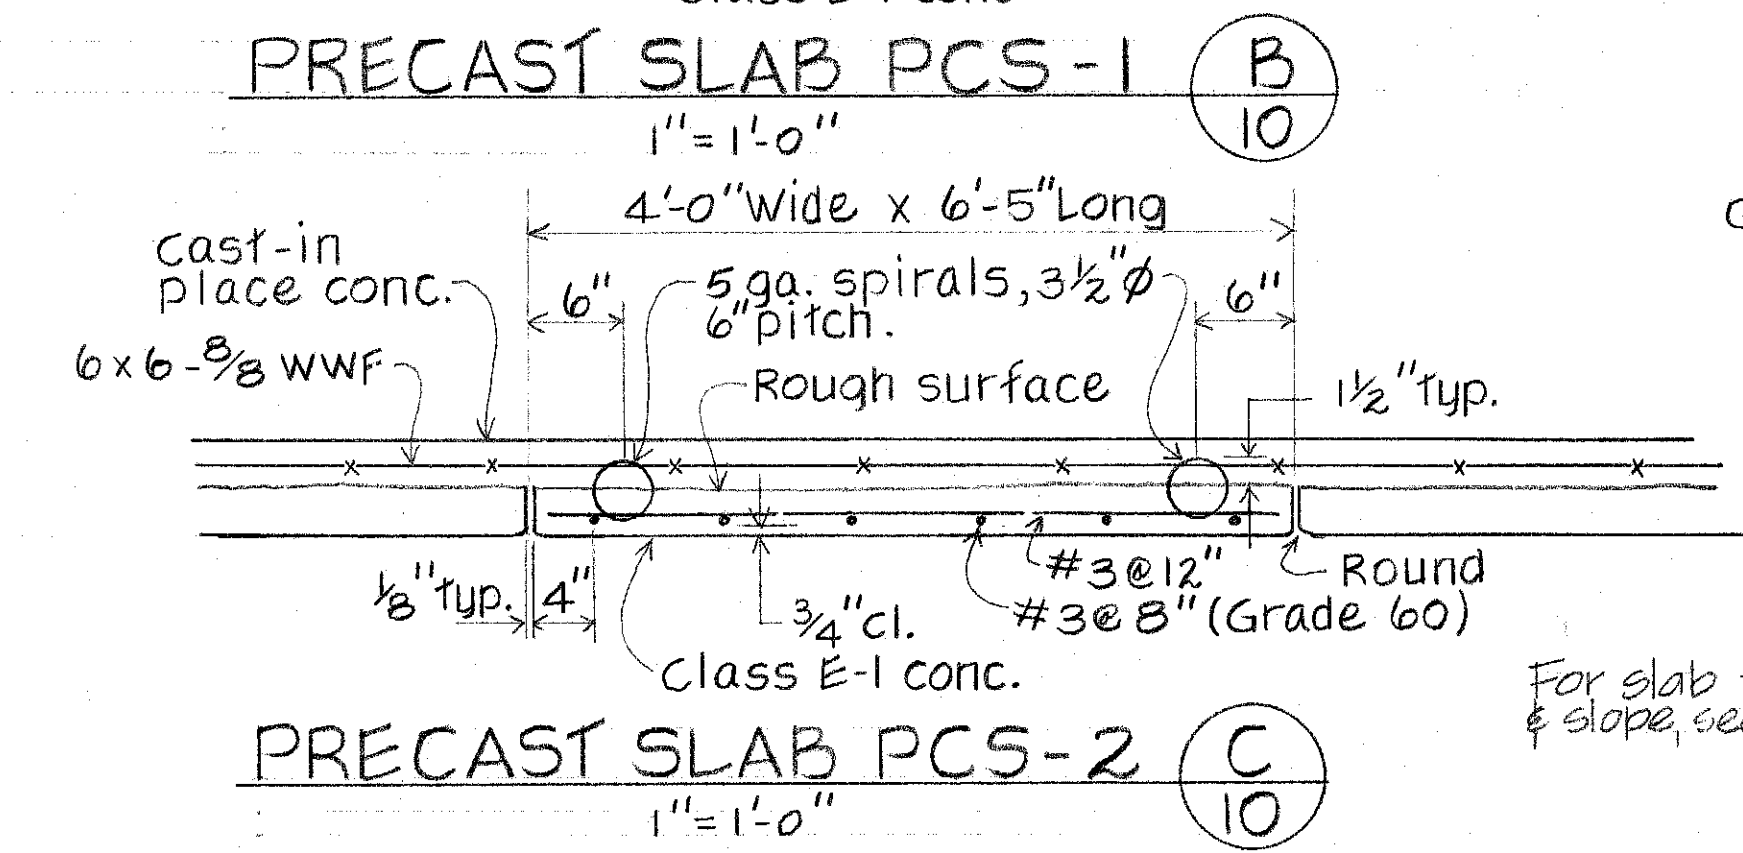
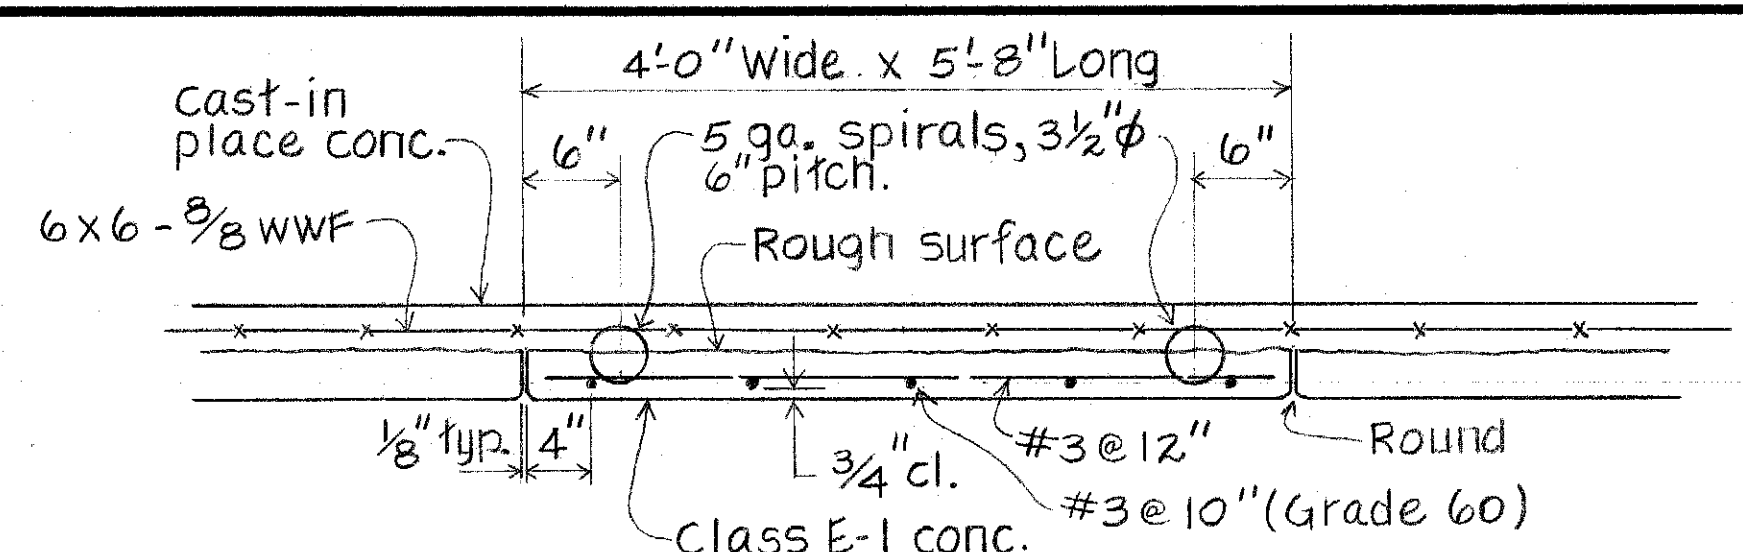


Unless indicated otherwise, Ramp #3 shall be similar to Ramp #1; & Ramp #4 shall be similar to Ramp #2.

FED. ROAD DIST. NO.	STATE	PROJ. NO.	FISCAL YEAR	SHEET NO.	TOTAL SHEETS
HAWAII	HAW.	90B-01-70	1971	10	16

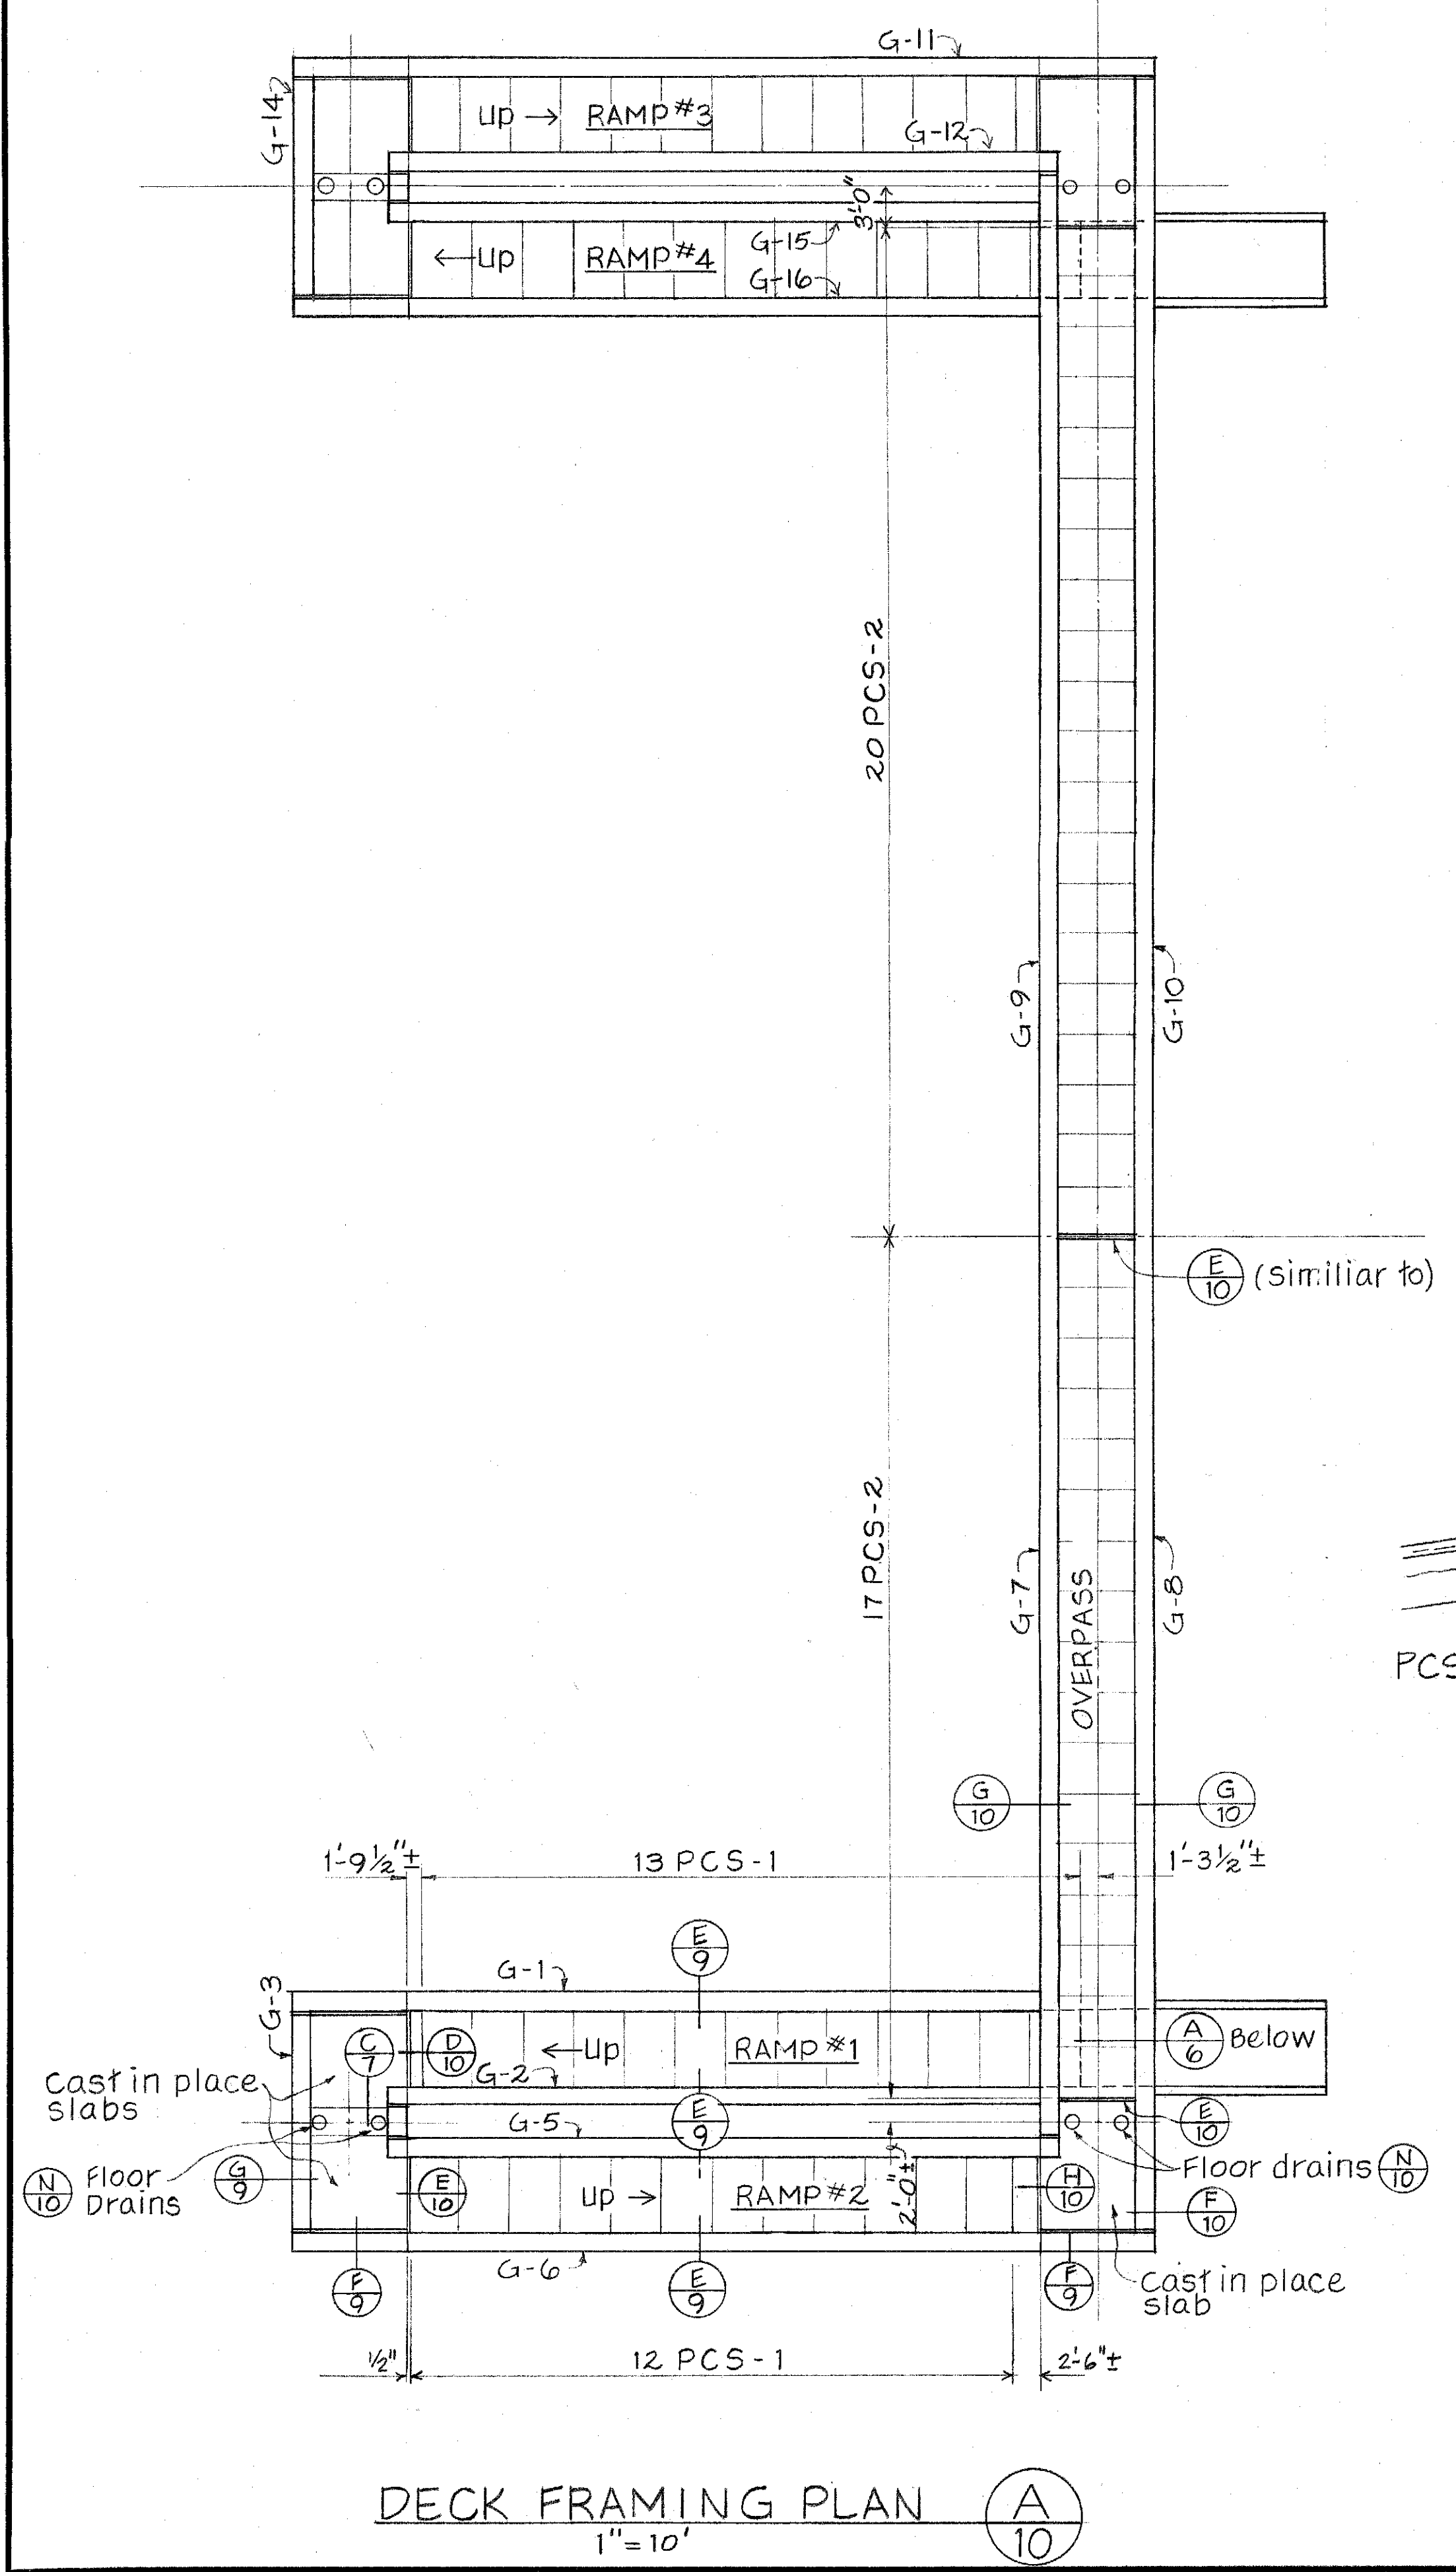

FLOOR DRAIN CONNECTION (M/10)
 Note: Floor drain and piping shall be incidental to concrete and will not be paid for separately.

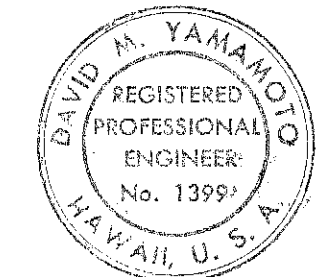

STATE OF HAWAII
 DEPARTMENT OF TRANSPORTATION
 HIGHWAYS DIVISION

**DECK FRAMING
 PLAN AND DETAILS**

WAIMALU PEDESTRIAN OVERPASS
 PROJECT NO. 90B-01-70

SHEET No. 1 OF 16 SHEETS

DESIGNED BY	DATE
DRIVEN BY	
NOTED BY	
CHECKED BY	
ORIGINAL PLAN	
NOTE BOOK	