



FED. ROAD DIST. NO.	STATE	PROJ. NO.	FISCAL YEAR	SHEET NO.	TOTAL SHEETS
HAWAII	HAW.	90B-01-70	1971	7	16

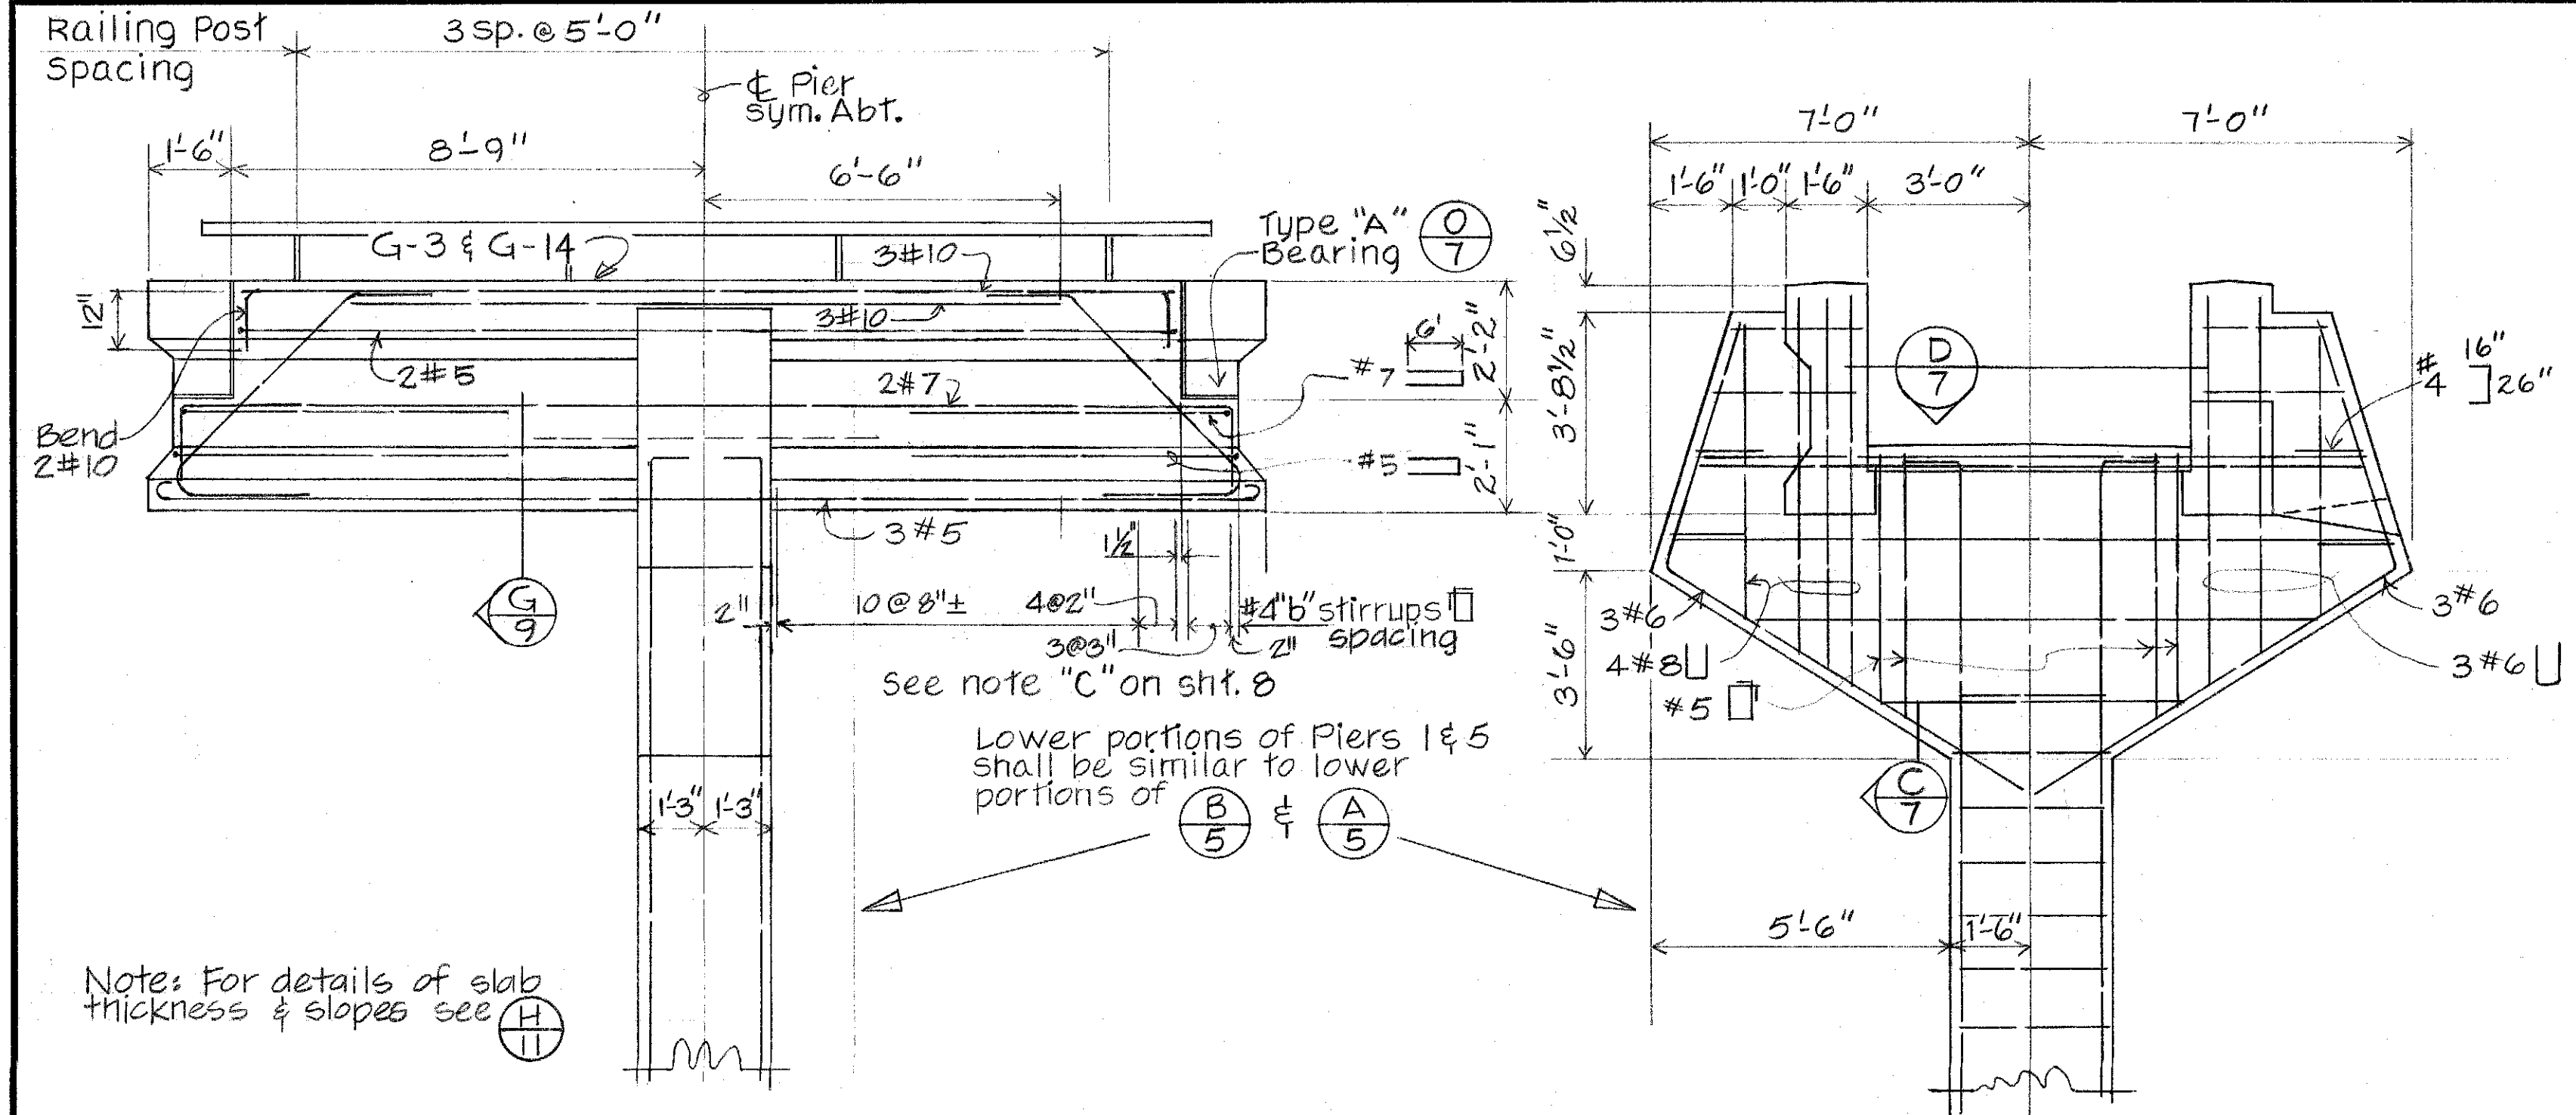


PIER #1 & #5 ELEV. (A)
3/8" = 1'-0"

PIER #1 & #5 ELEV. (B)
3/8" = 1'-0"

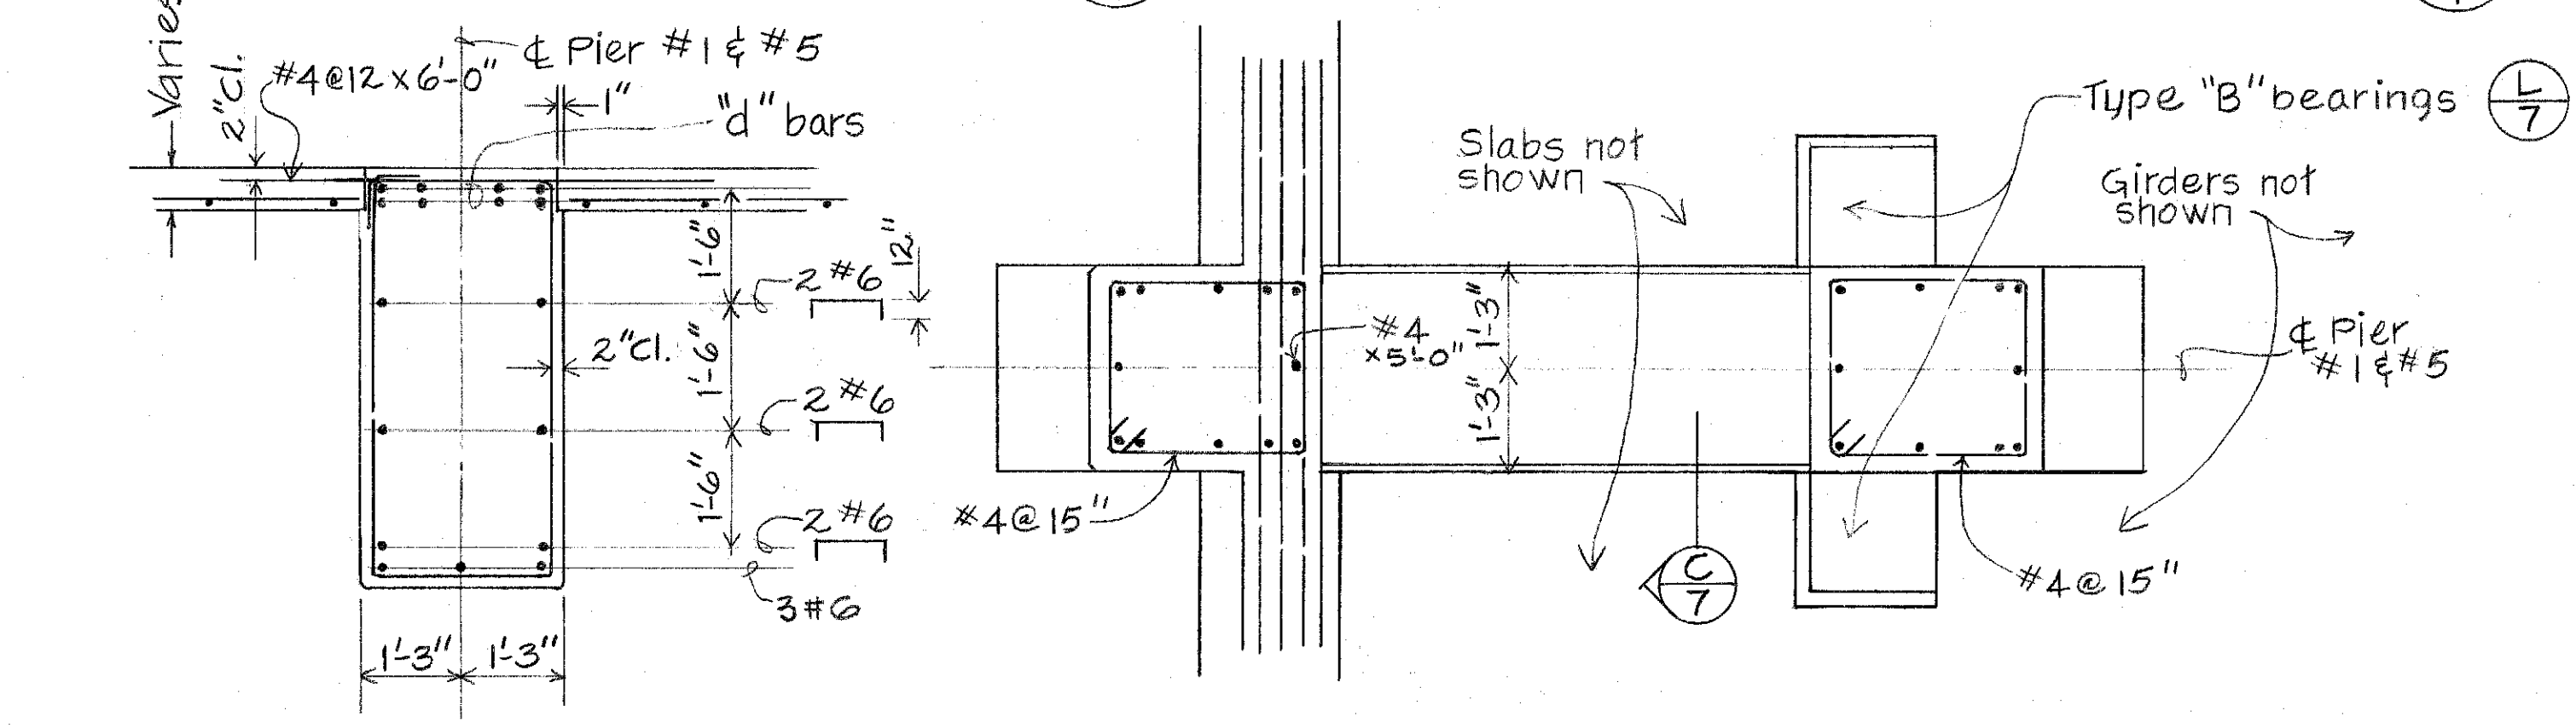

PIER CAP SECTION (C)
1/2" = 1'-0"


SECTION (D)
1/2" = 1'-0"

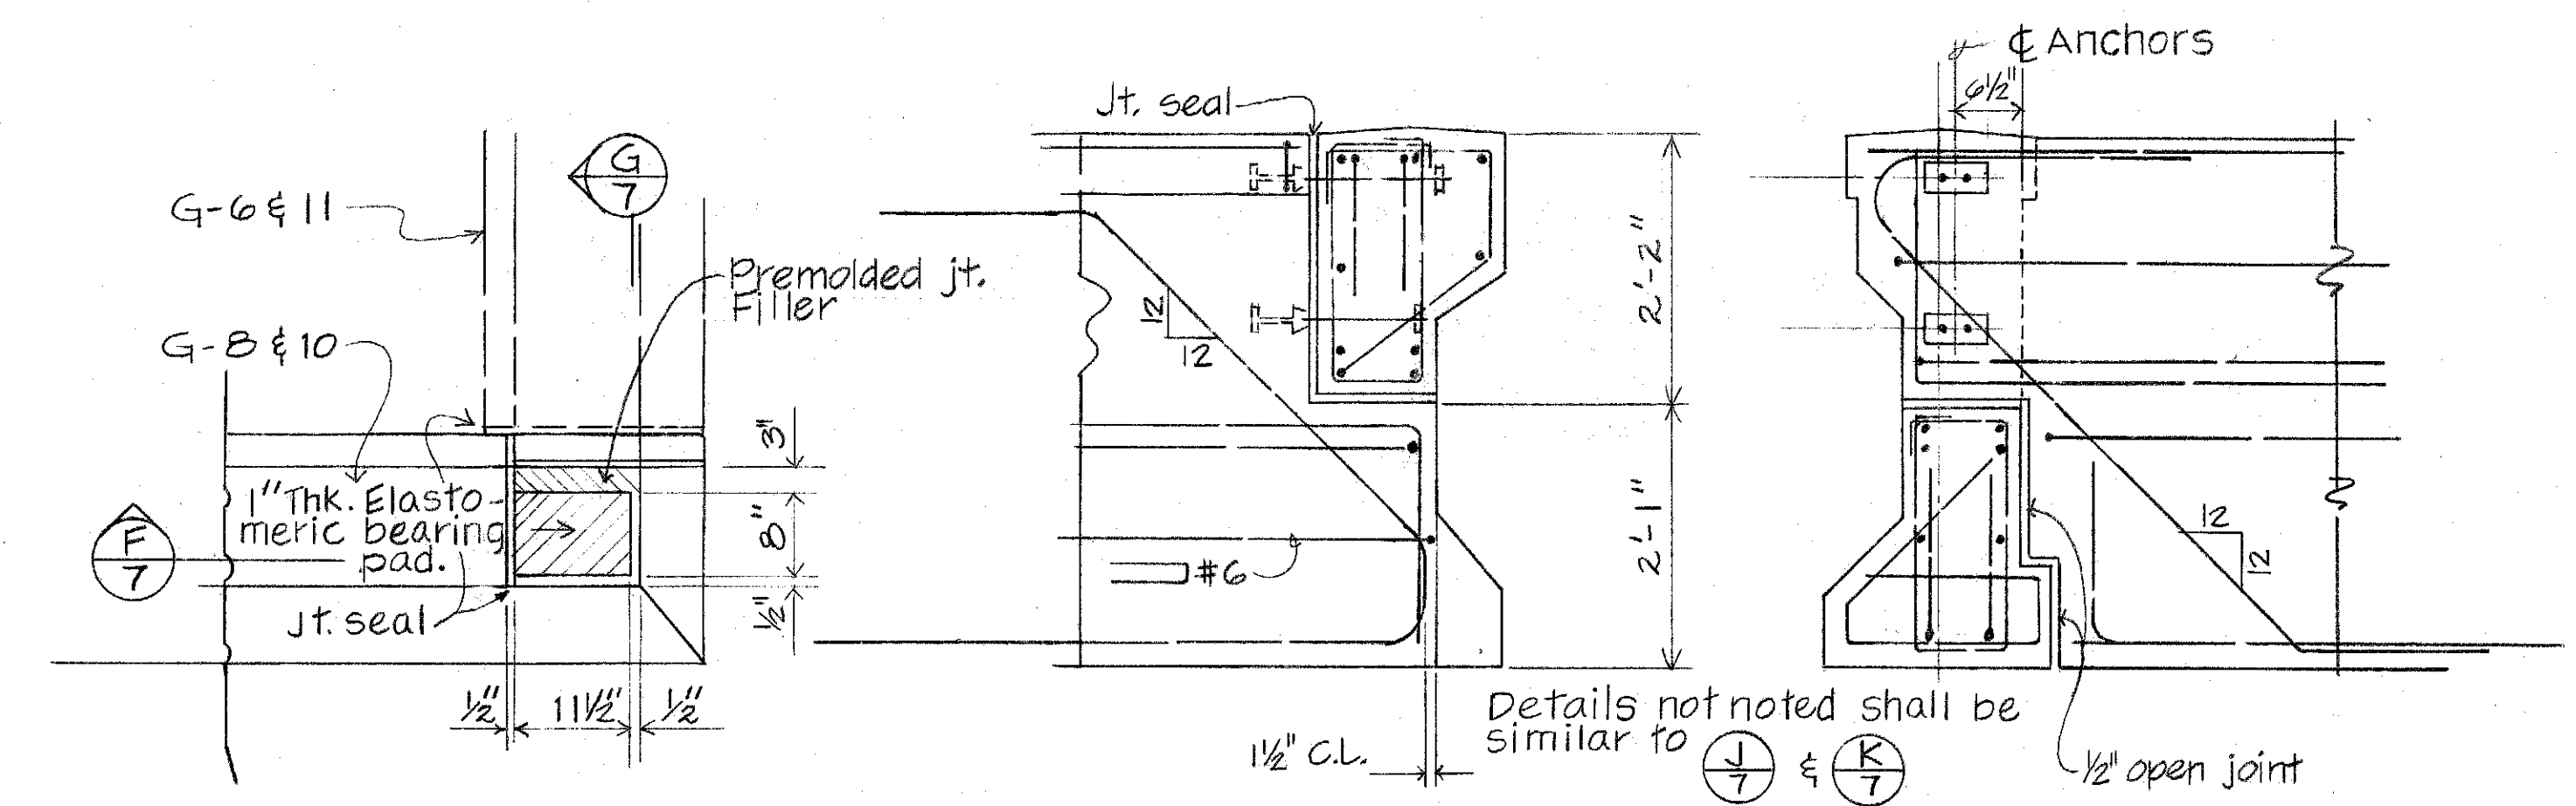

PLAN-TYPE "D" BEARING (E)
3/4" = 1'-0"

SECTION (F)
3/4" = 1'-0"


SECTION (G)
3/4" = 1'-0"

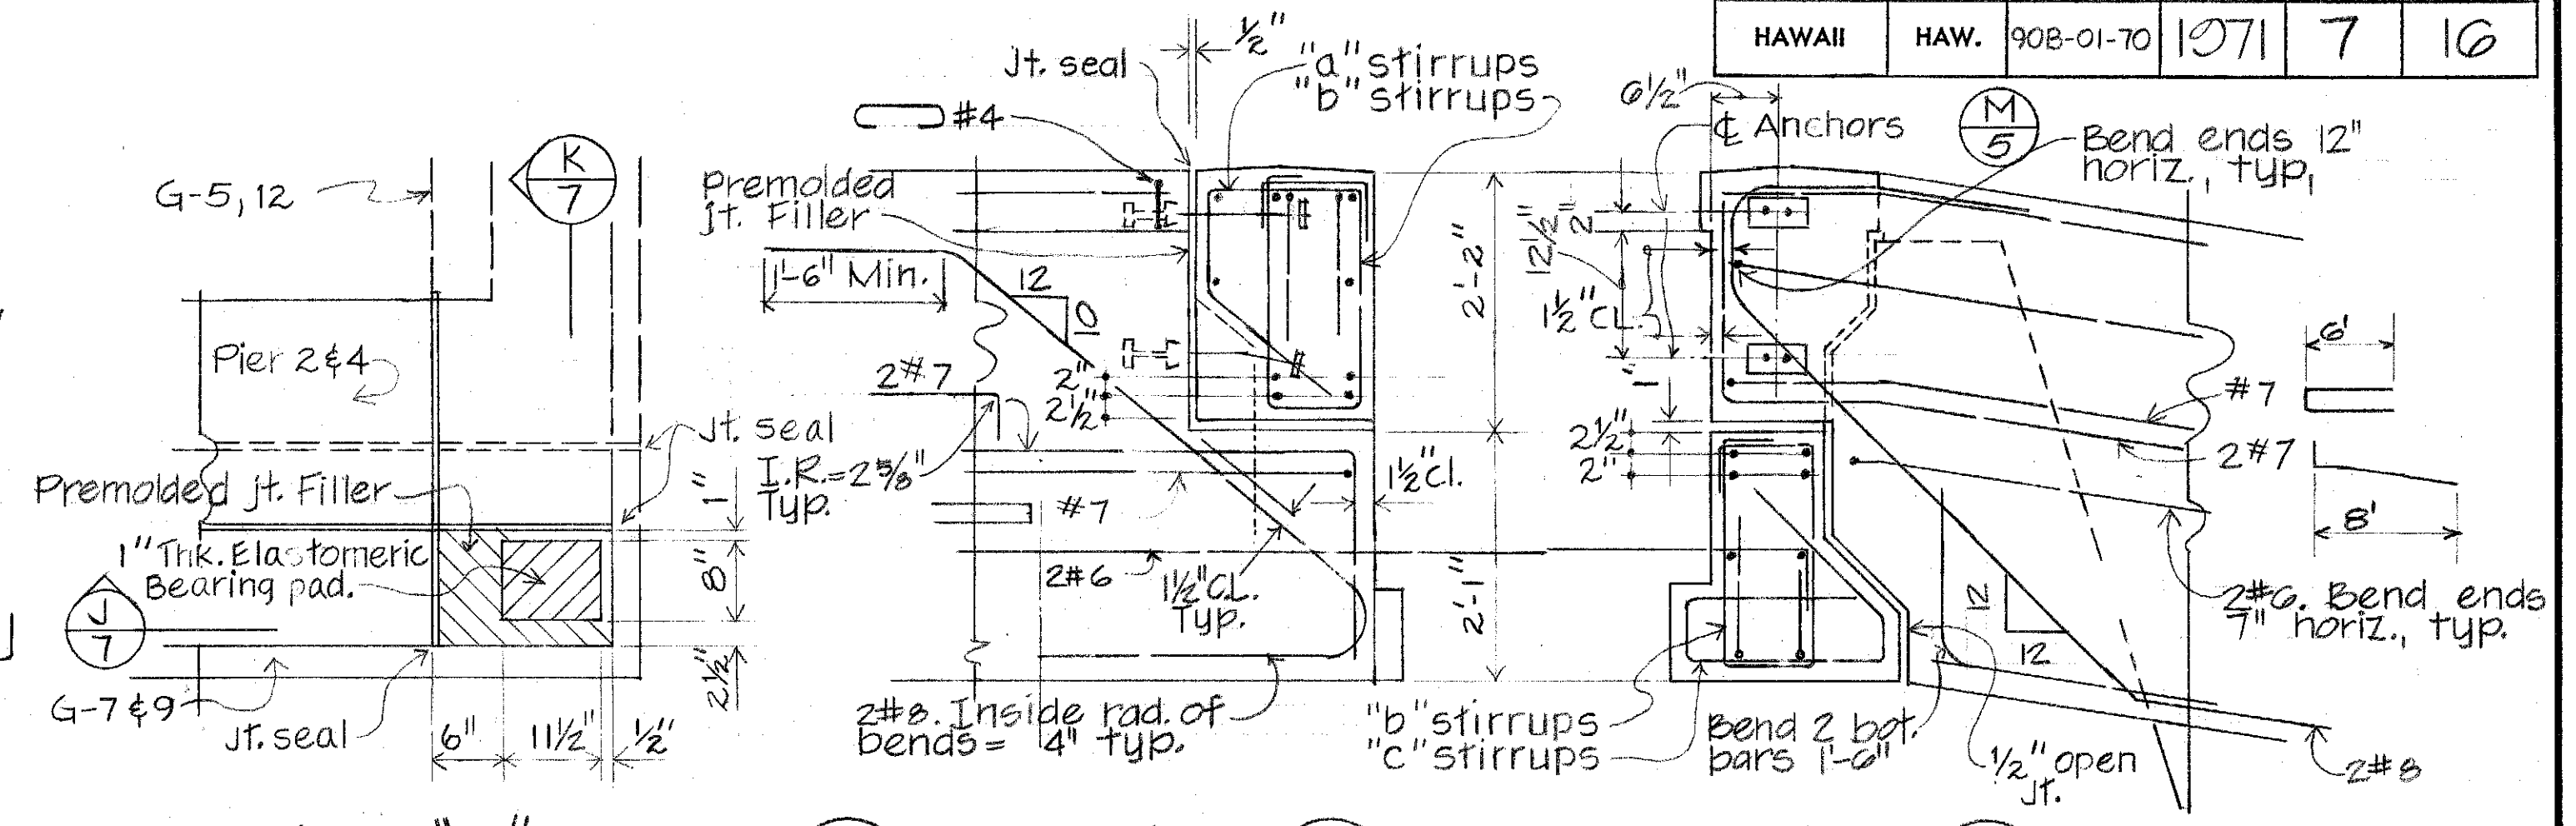

PLAN-TYPE "C" BEARING (H)
3/4" = 1'-0"

SECTION (J)
3/4" = 1'-0"


SECTION (K)
3/4" = 1'-0"

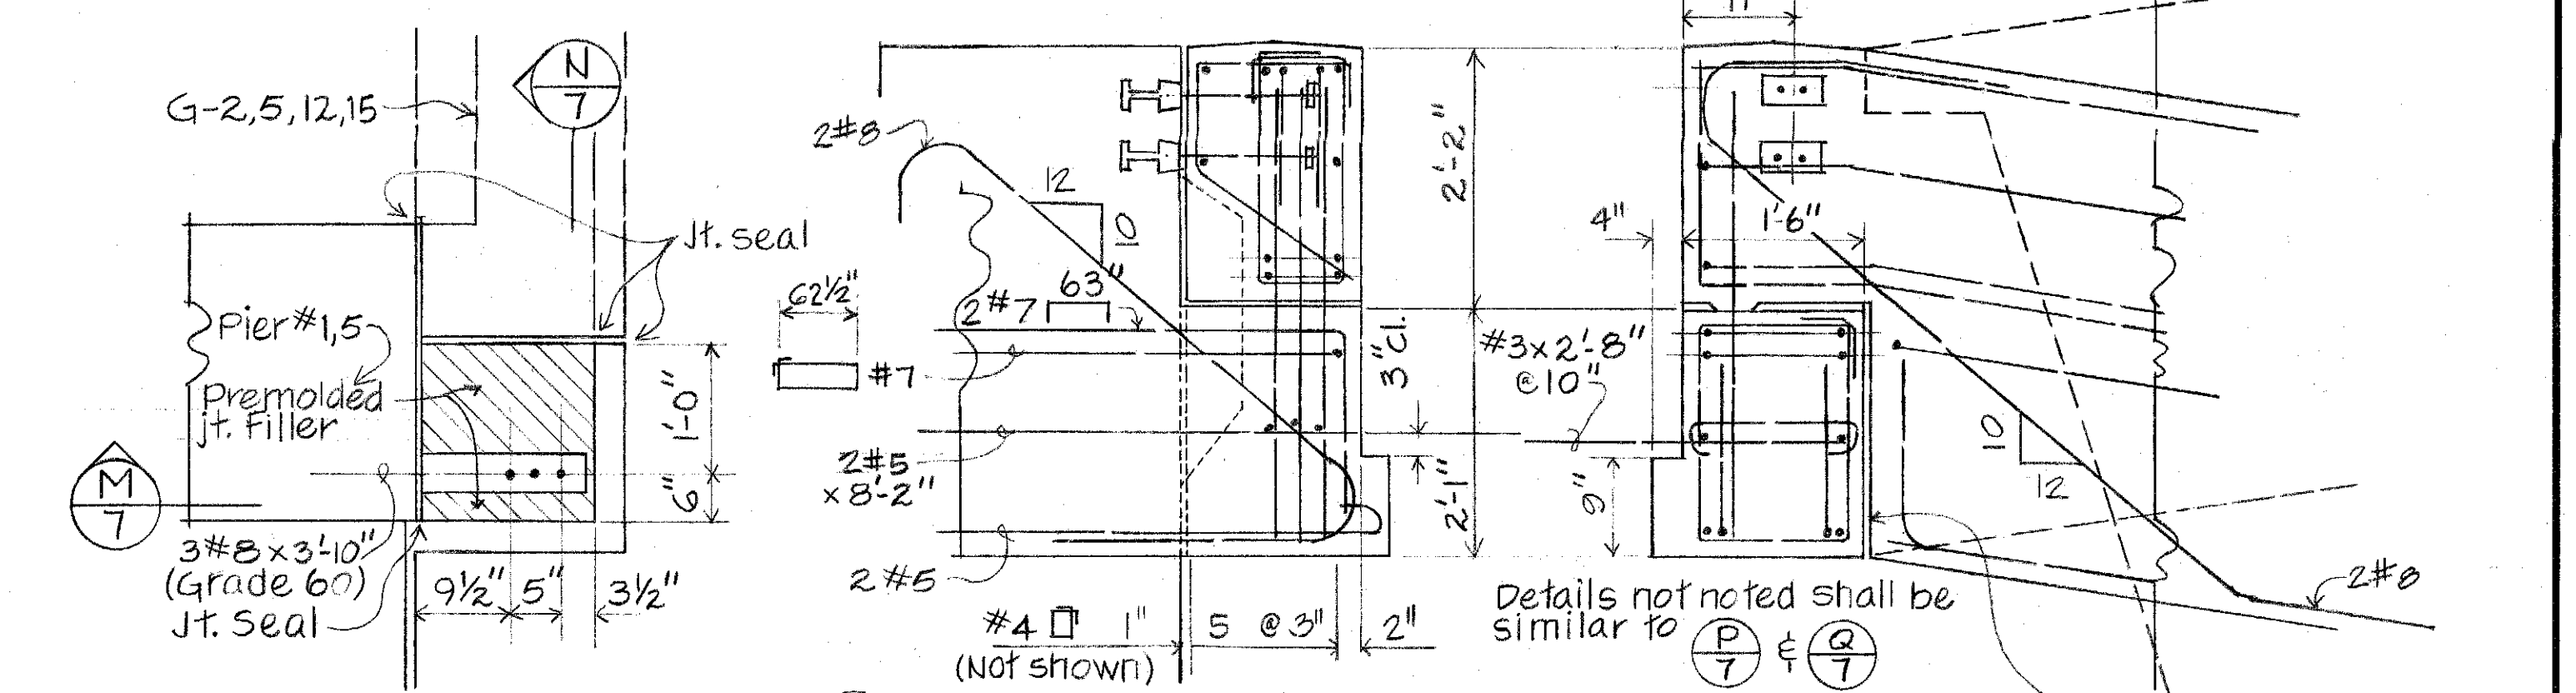

PLAN-TYPE "B" BEARING (L)
3/4" = 1'-0"

SECTION (M)
3/4" = 1'-0"

SECTION (N)
3/4" = 1'-0"

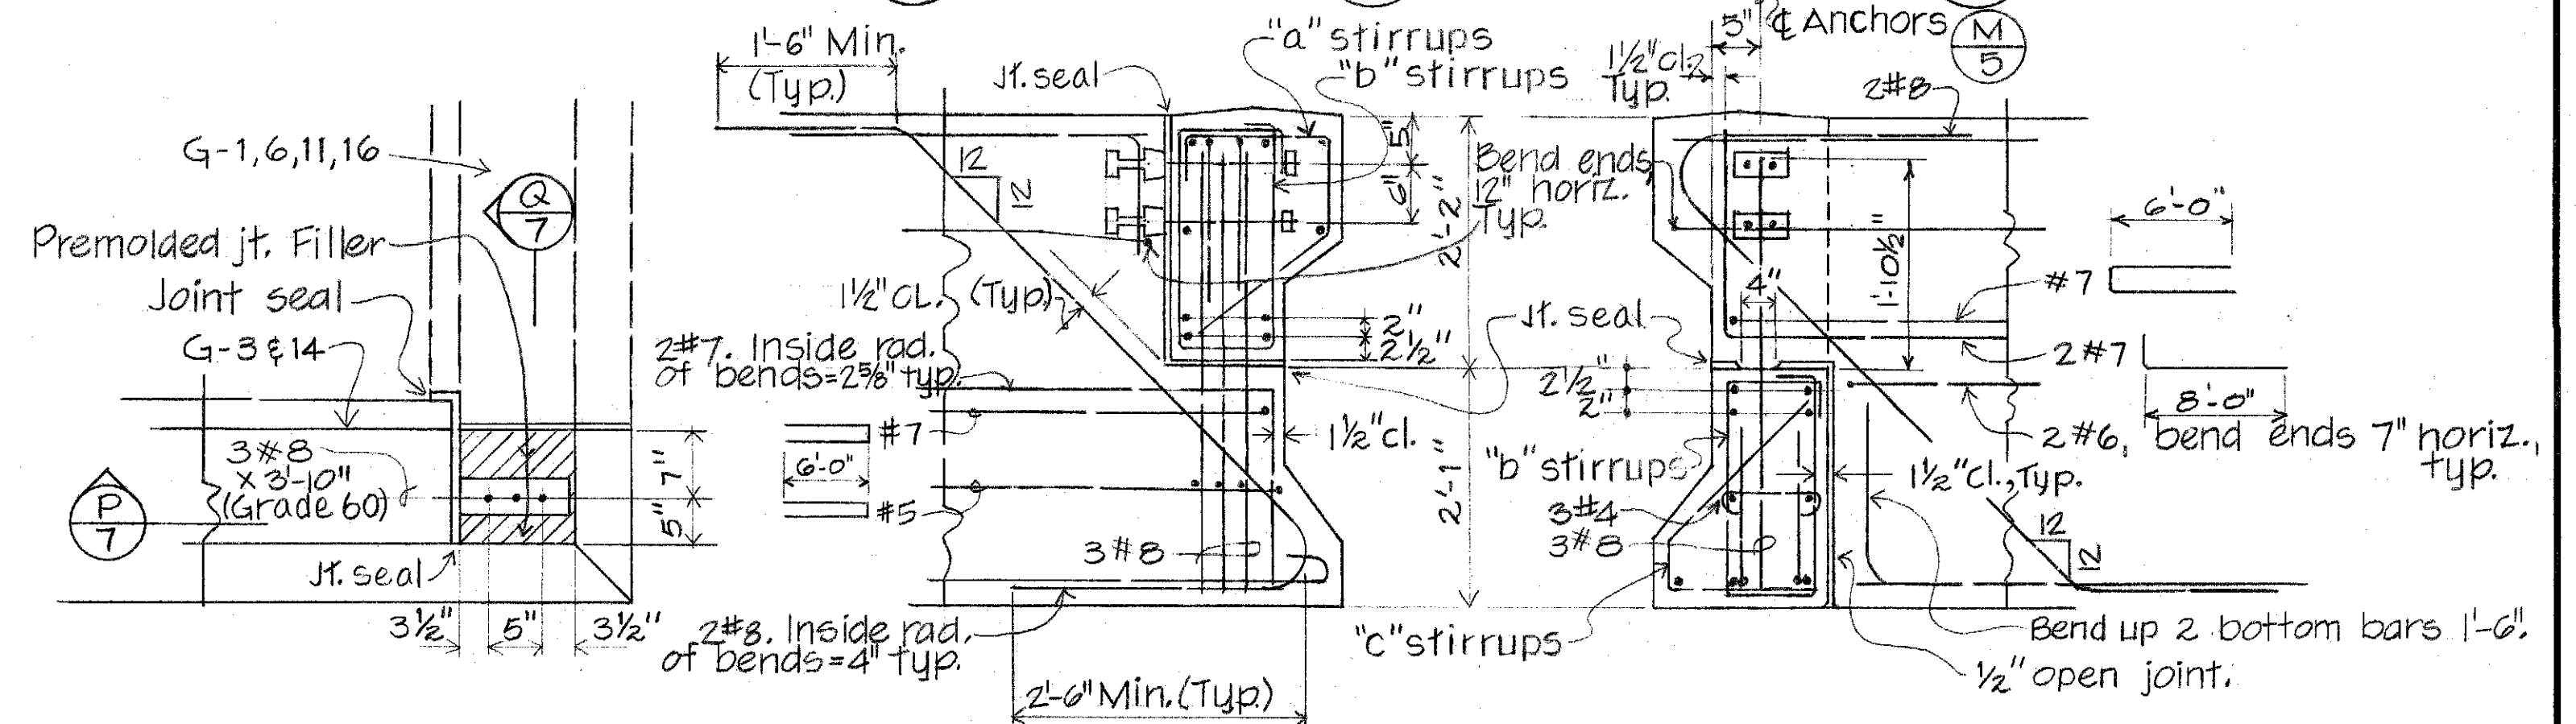


PLAN-TYPE "A" BEARING (O)
3/4" = 1'-0"

SECTION (P)
3/4" = 1'-0"

SECTION (Q)
3/4" = 1'-0"

DATE	DESIGNED BY
TRACED BY	CHECKED BY
NOTED BY	QUANTITIES BY
ORIGINAL PLAN	NO.

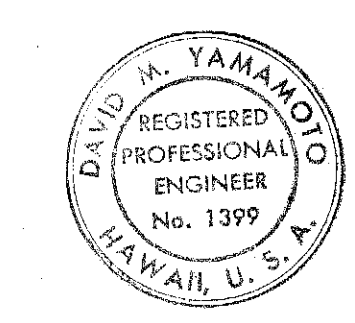

STATE OF HAWAII
DEPARTMENT OF TRANSPORTATION
HIGHWAYS DIVISION

PIERS 1 & 5 AND BEARINGS
WAIMALU PEDESTRIAN OVERPASS
PROJECT NO. 90B-01-70

SHEET No. 7 OF 16 SHEETS