

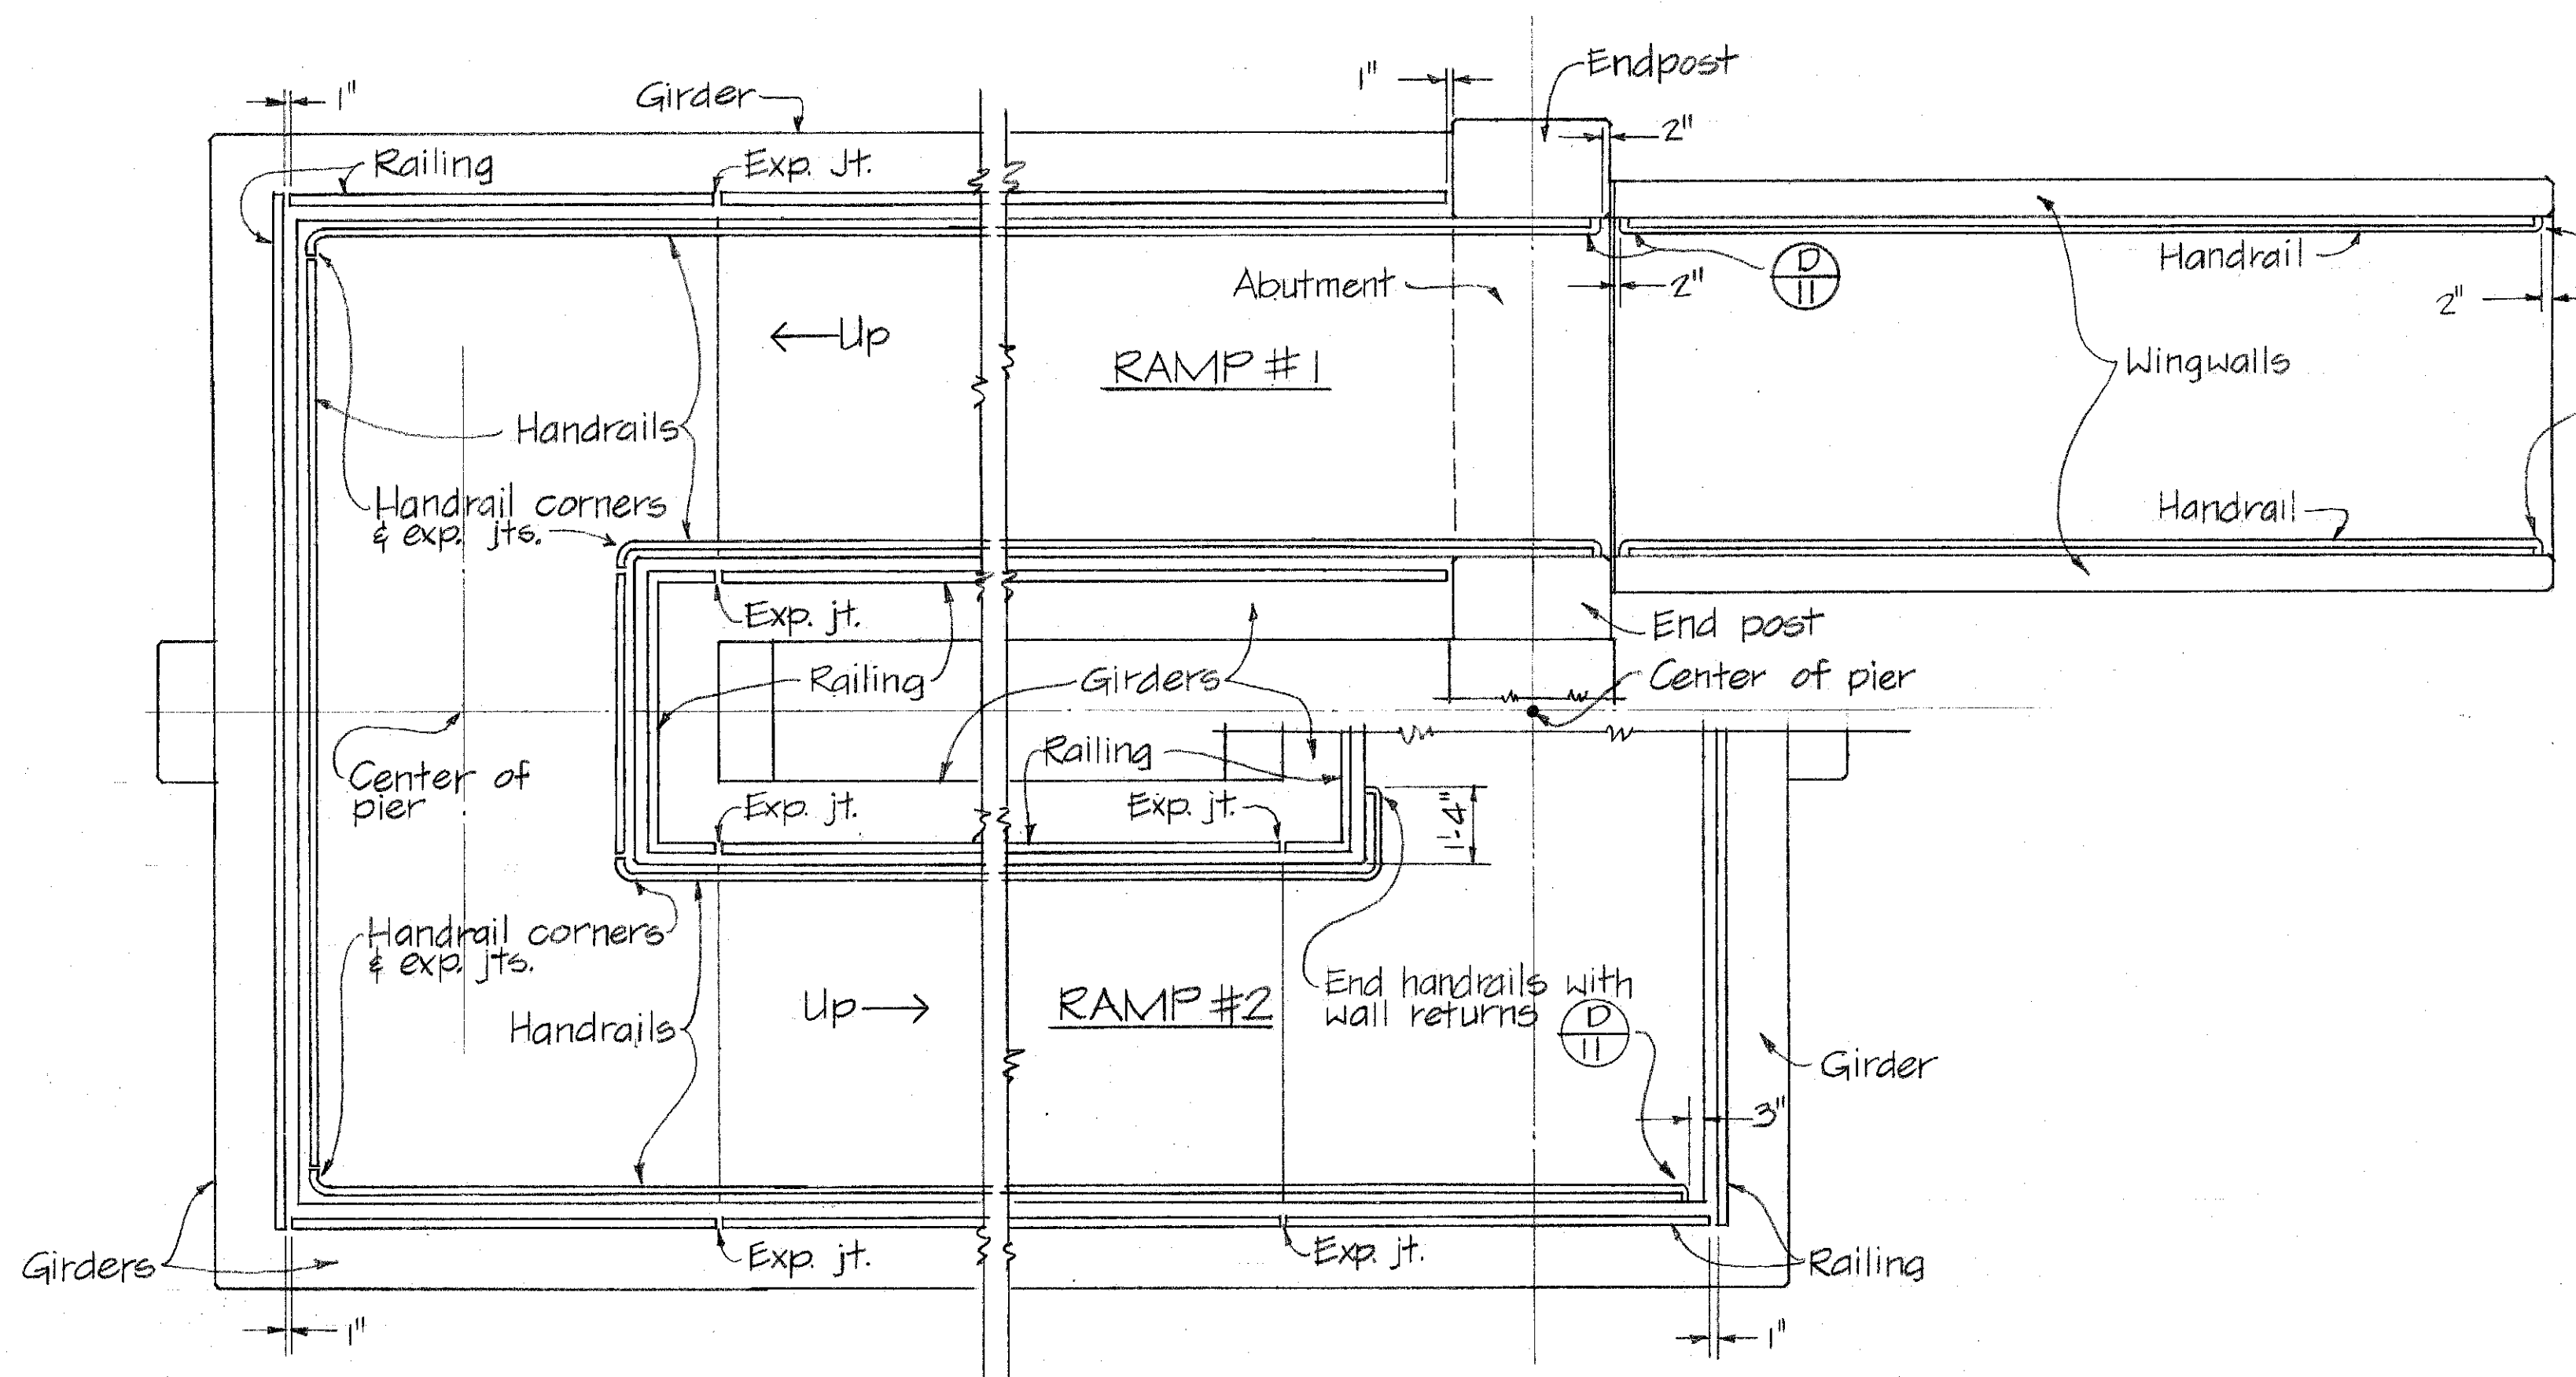
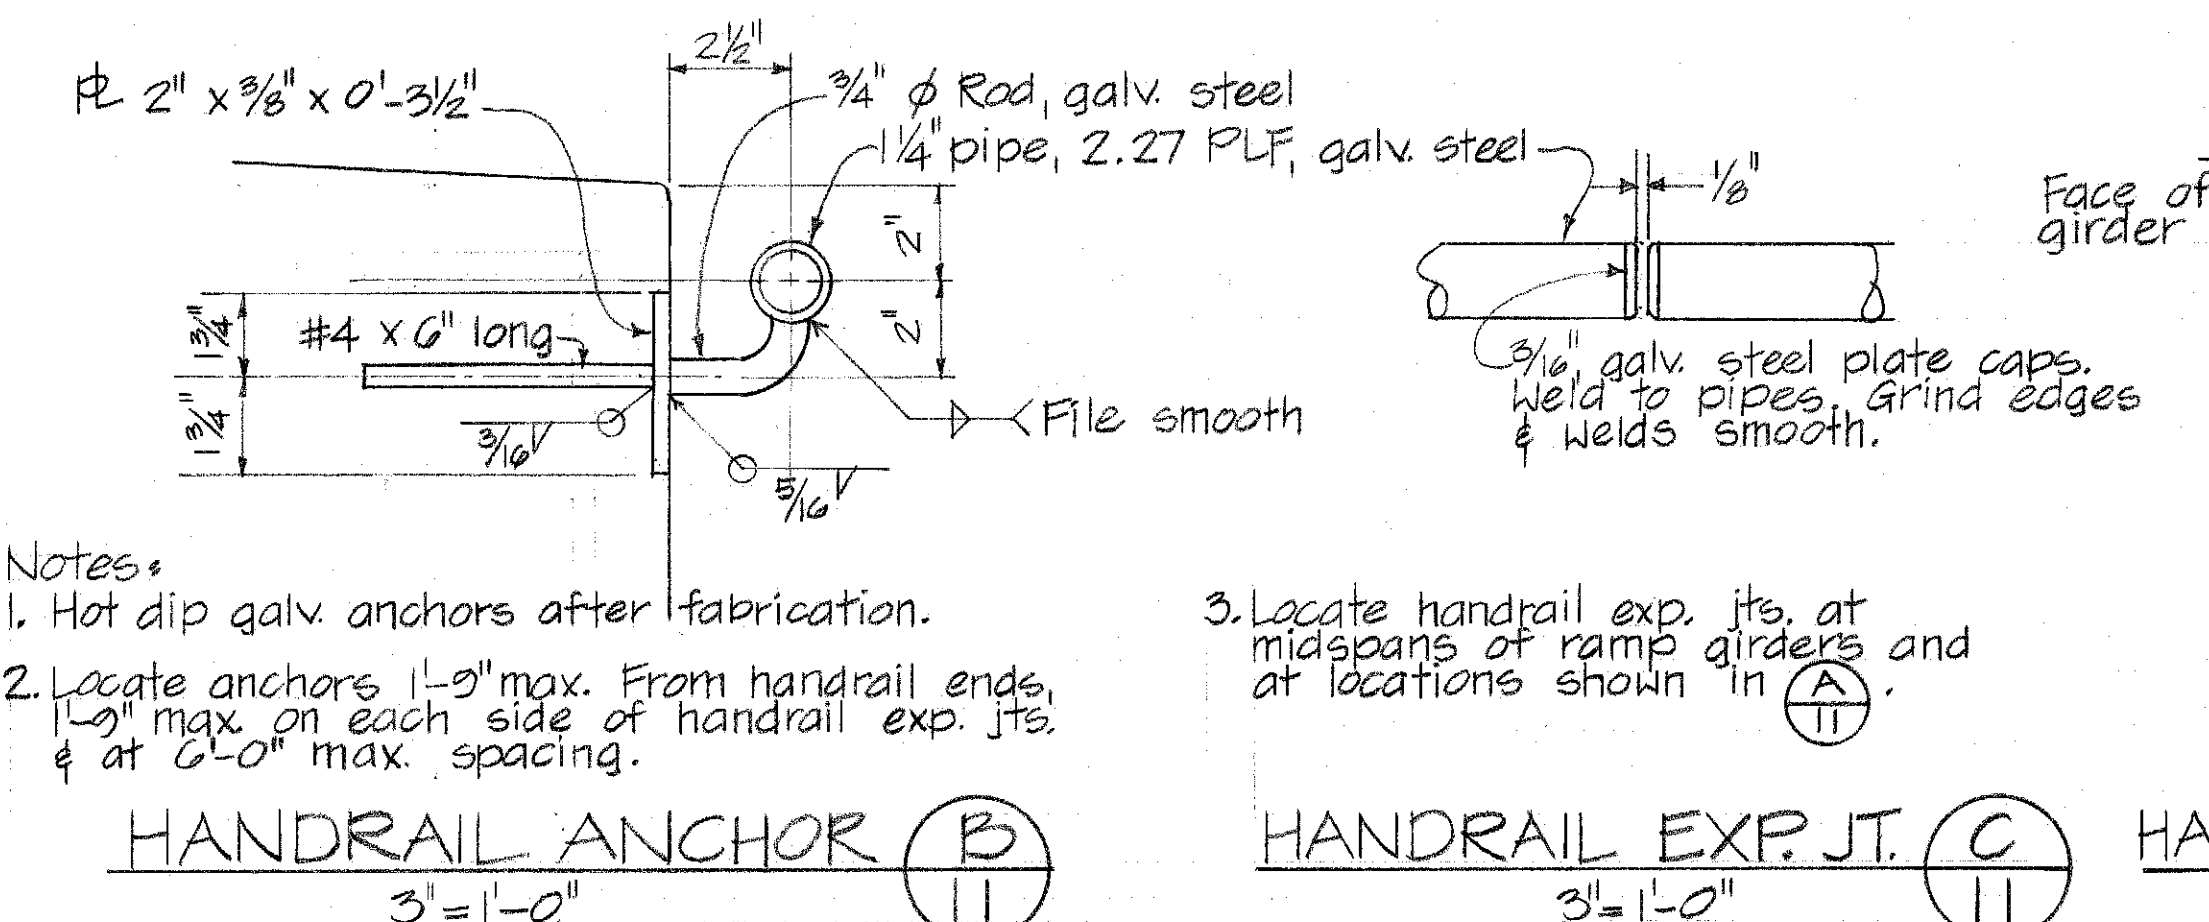
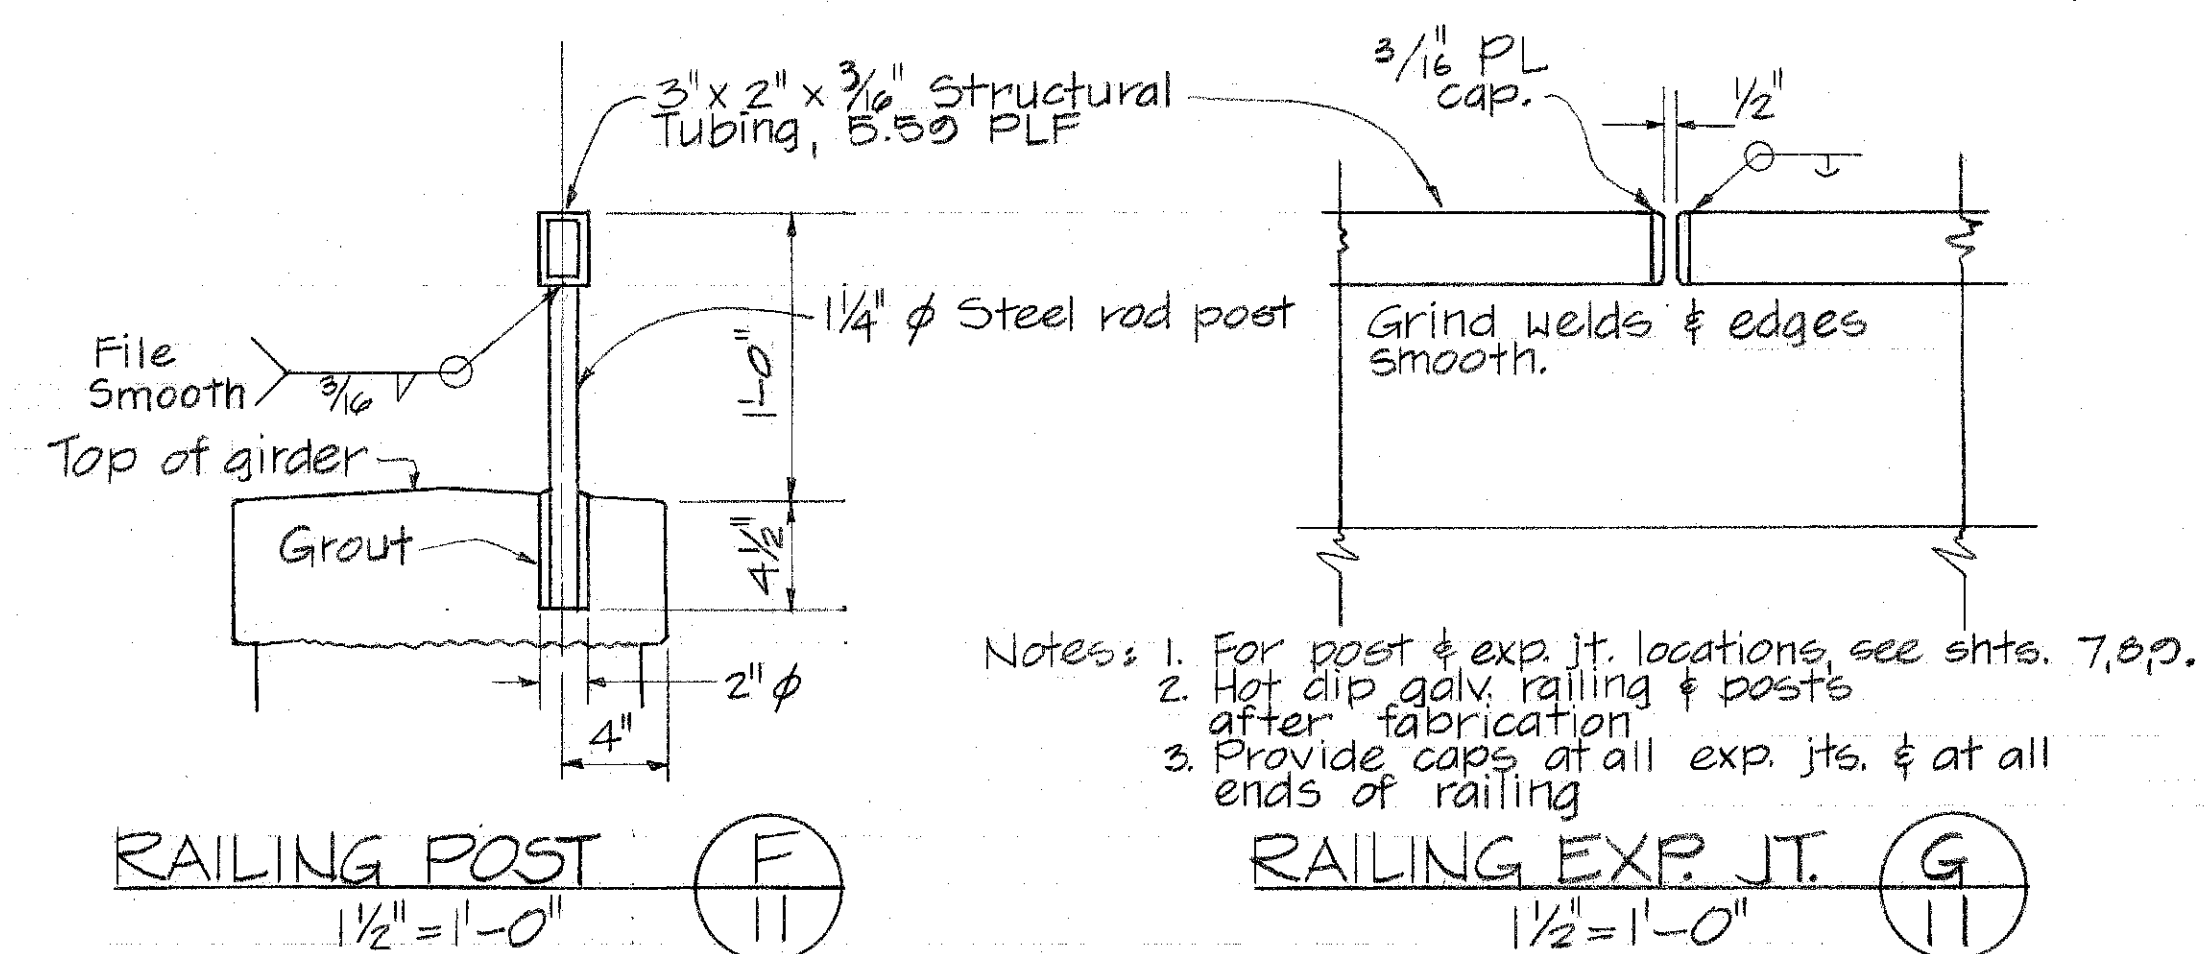
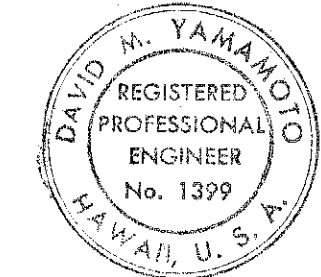


FED. ROAD DIST. NO.	STATE	FED. AID PROJ. NO.	FISCAL YEAR	SHEET NO.	TOTAL SHEETS
HAWAII	HAW.	208-01-70	1971	11	16

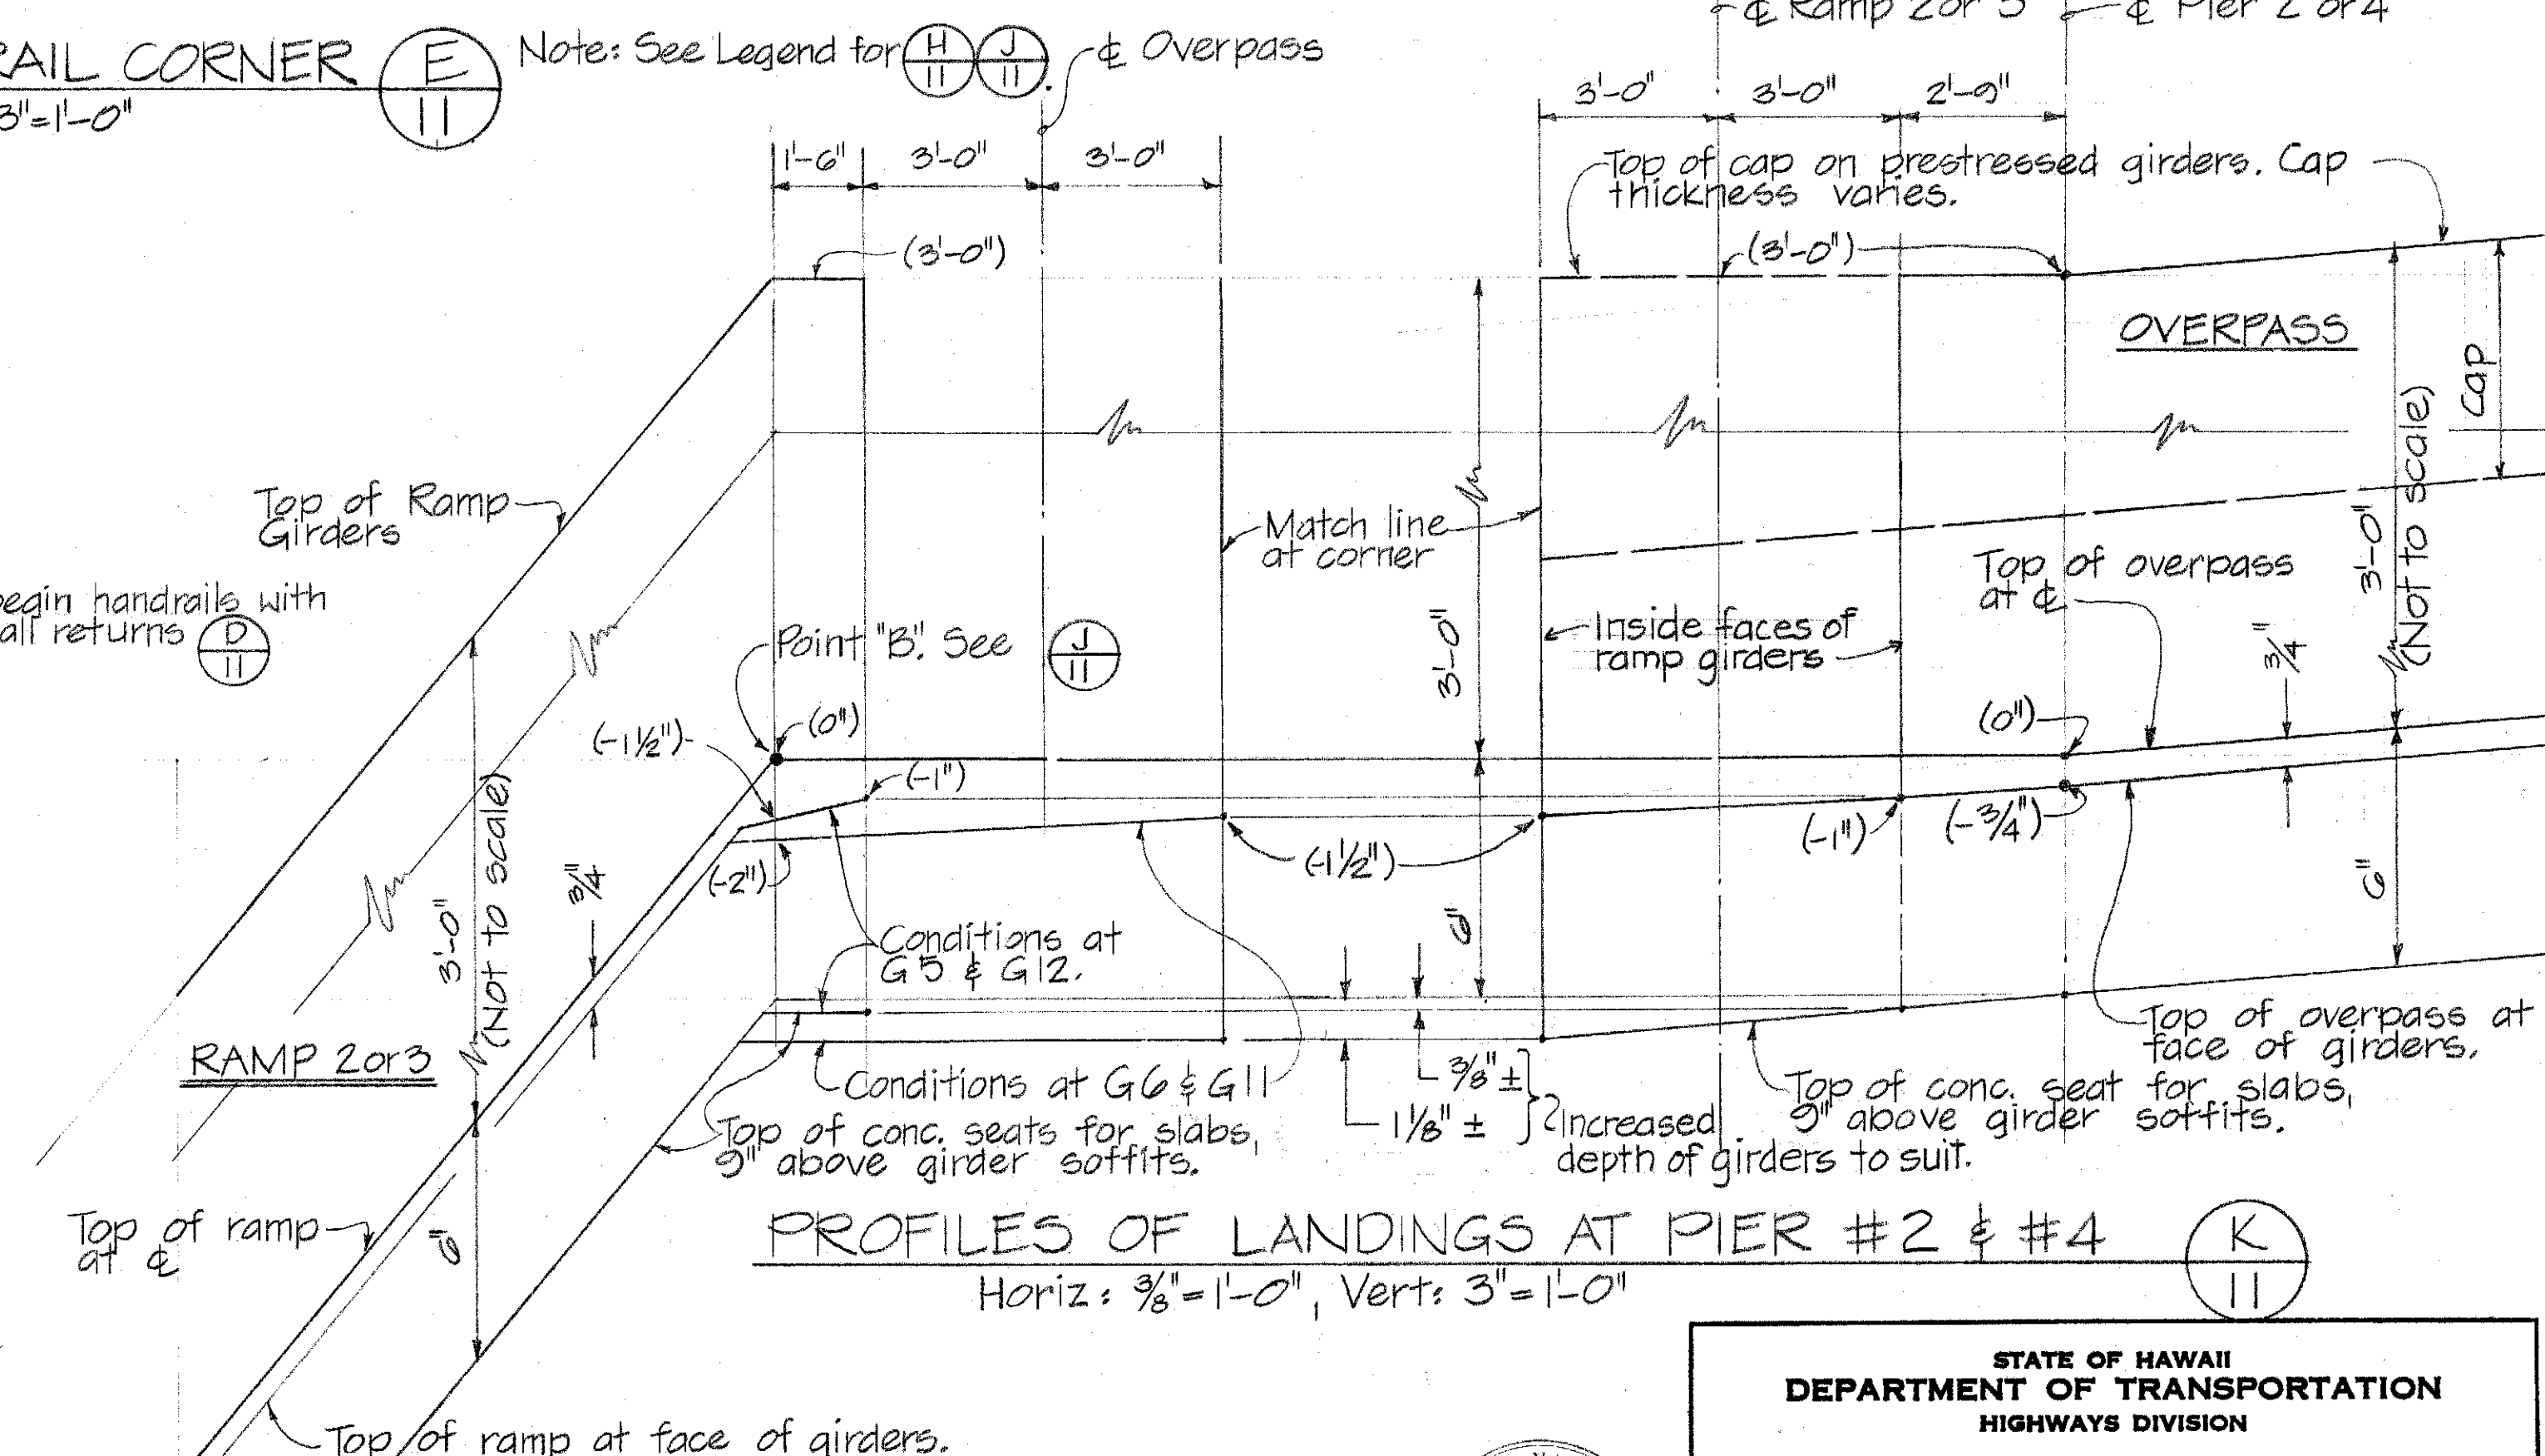

Note: Conditions at Piers 3 & 4 shall be similar.

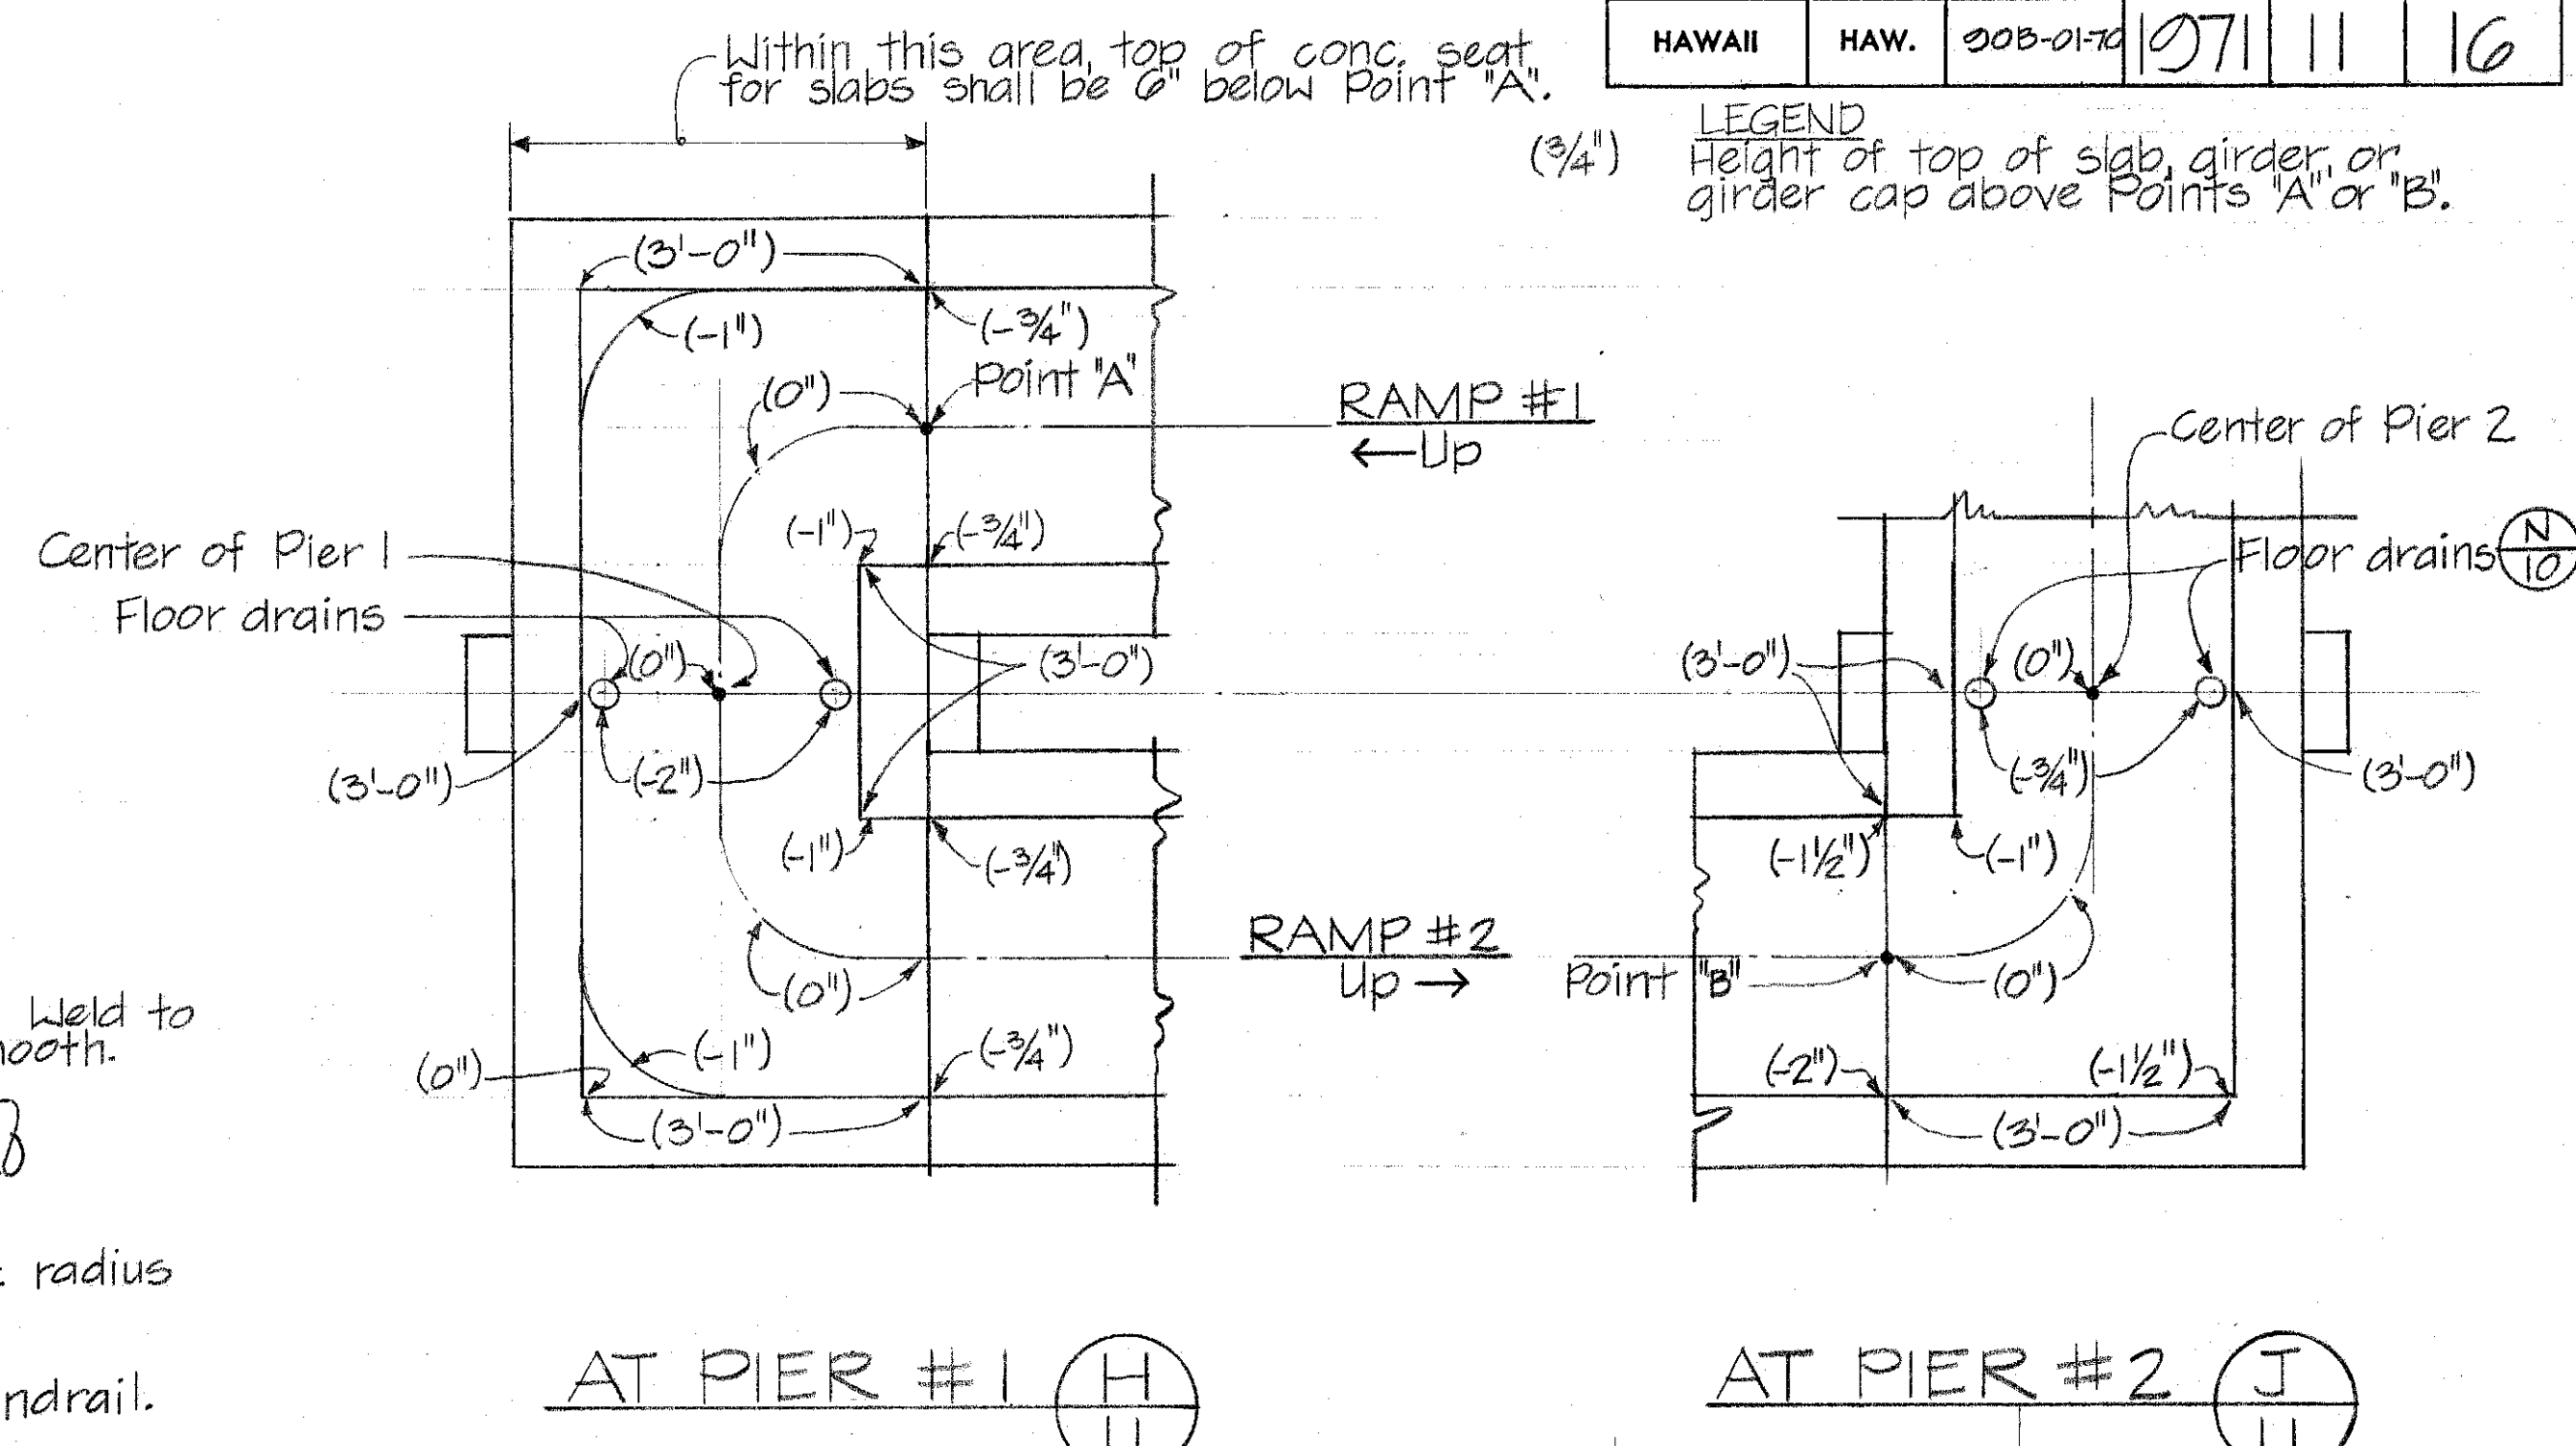

STATE OF HAWAII
DEPARTMENT OF TRANSPORTATION
HIGHWAYS DIVISION

RAILING, HANDRAILS
AND OTHER DETAILS

WAIMALU PEDESTRIAN OVERPASS
PROJECT NO. 208-01-70

SHEET No. 11 OF 16 SHEETS

DESIGNED BY	DATE
TRACED BY	
NOTED BY	
CHECKED BY	