


FED. ROAD DIST. NO.	STATE	FED. AID PROJ. NO.	FISCAL YEAR	SHEET NO.	TOTAL SHEETS
HAWAII	HAW	S.G.20(1)	1946	2	3

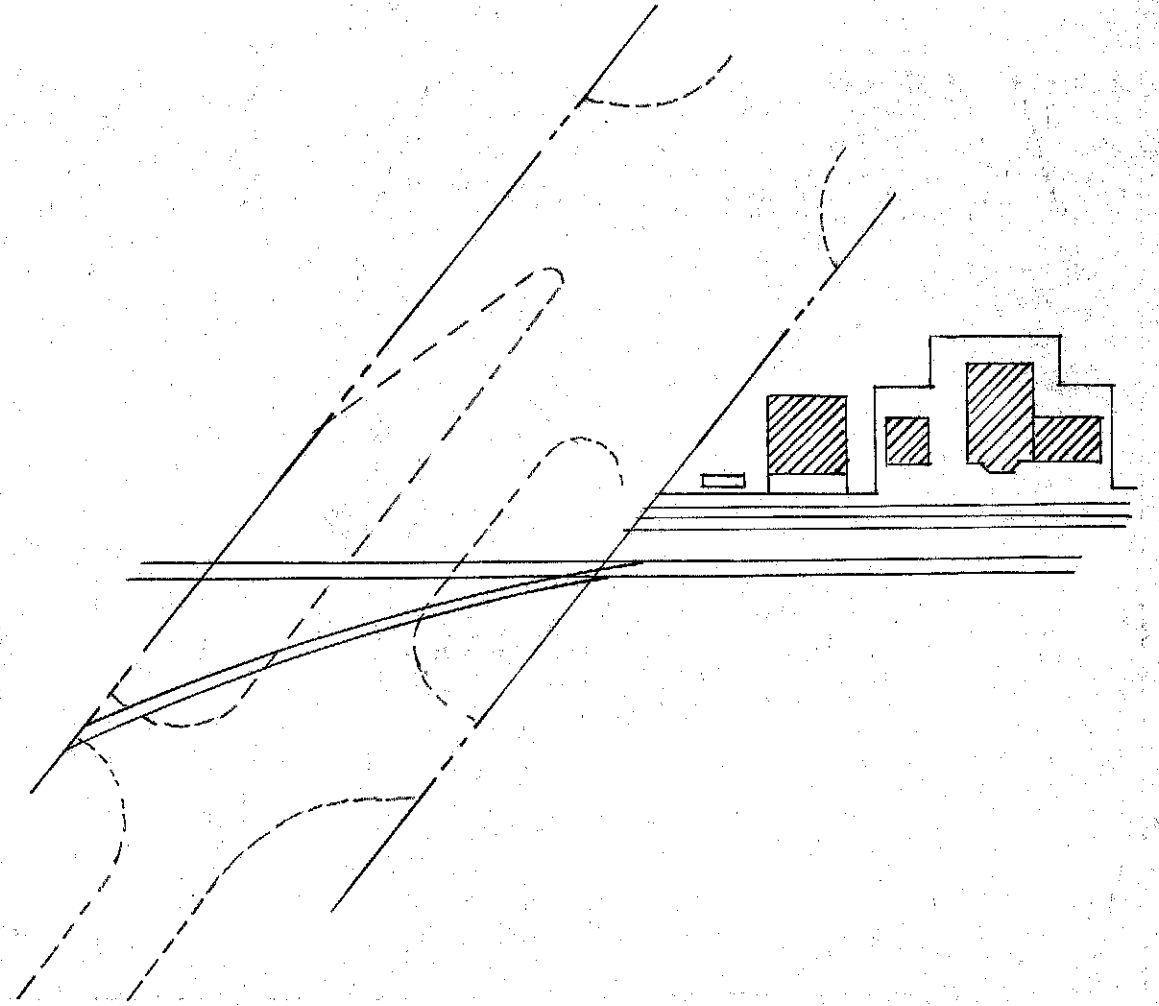

TERRITORIAL HIGHWAY DEPARTMENT

FEDERAL AID GRADE CROSSING PROJECT NO. S.G.20(1)

JUNE 14, 1946

5219.2

FED. ROAD DIST. NO.	STATE	FED. AID PROJ. NO.	FISCAL YEAR	SHEET NO.	TOTAL SHEETS
HAWAII	HAW	9.6.200	1946	3	3

TERRITORIAL HIGHWAY DEPARTMENT

FEDERAL AID GRADE CROSSING PROJECT NO. S.G. 20 (I)

JUNE 14, 1946

5219.3