
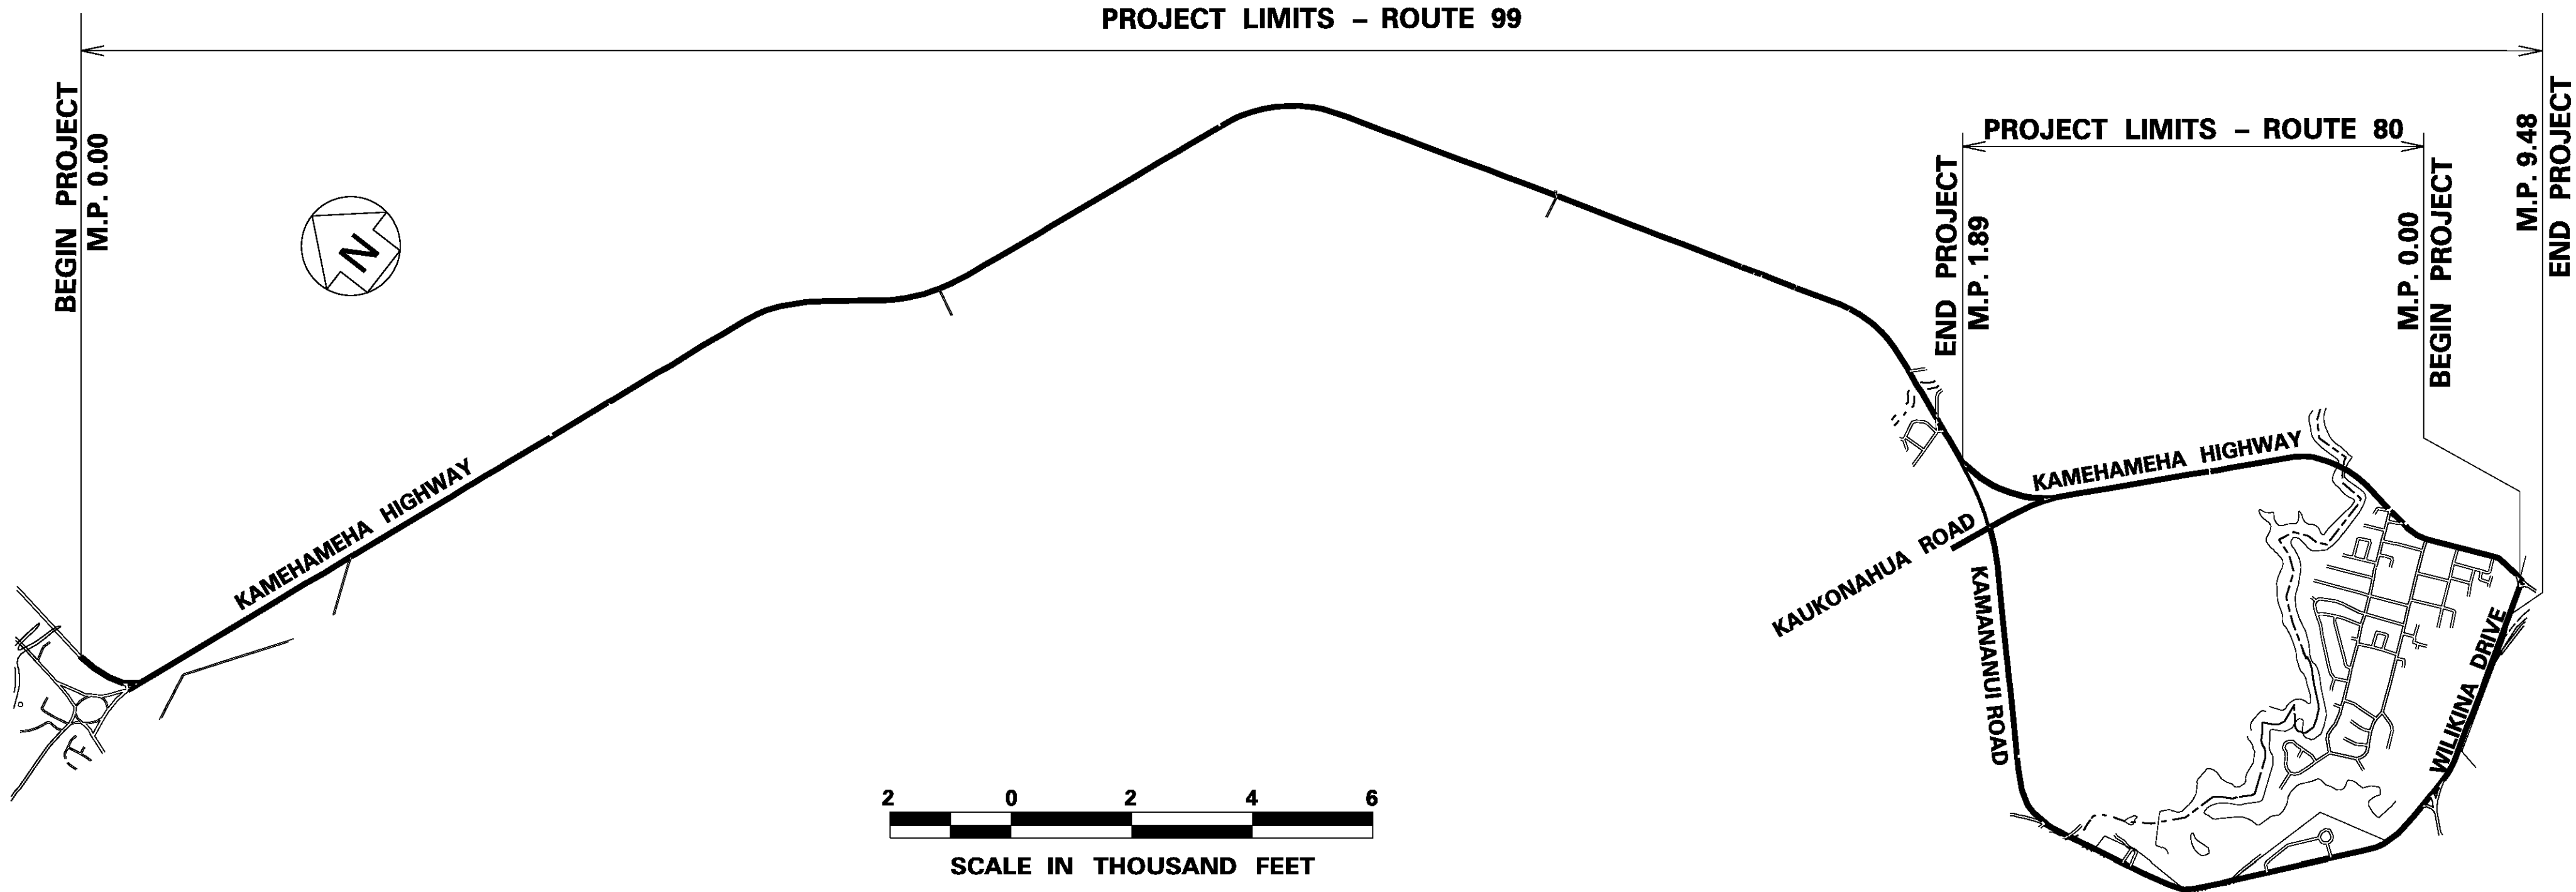


INDEX TO DRAWINGS	
SHEET NO.	DESCRIPTION
1	TITLE SHEET
2	STANDARD PLANS SUMMARY
3 – 4	GENERAL NOTES AND LEGEND
5 – 7	WATER POLLUTION & EROSION CONTROL NOTES
8 – 10	TYPICAL SECTIONS
11	OVERALL SITE PLAN
12 – 45	ROADWAY PLANS
46	PAVEMENT MARKINGS
47 – 80	STRIPING PLANS
81	SHOULDER RUMBLE STRIP DETAILS AND NOTES
82	CENTERLINE RUMBLE STRIP DETAILS AND NOTES
83 – 84	STRIPING AND PAVEMENT MARKING SCHEDULE
85 – 87	MISCELLANEOUS SCHEDULES
88 – 89	EROSION CONTROL PLAN
90	EROSION CONTROL DETAILS
91 – 94	CONSTRUCTION SIGN DETAILS
95 – 125	TRAFFIC CONTROL PLANS

STATE OF HAWAII
DEPARTMENT OF TRANSPORTATION
HIGHWAYS DIVISION
HONOLULU, HAWAII
PLANS FOR
**KAMEHAMEHA HIGHWAY, KAMANANUI ROAD
AND WILIKINA DRIVE REHABILITATION
VICINITY OF WEED CIRCLE TO H-2
FEDERAL-AID PROJECT NO. NH-099-1(031)**
DISTRICTS OF WAHIWA AND WAIALUA
ISLAND OF OAHU

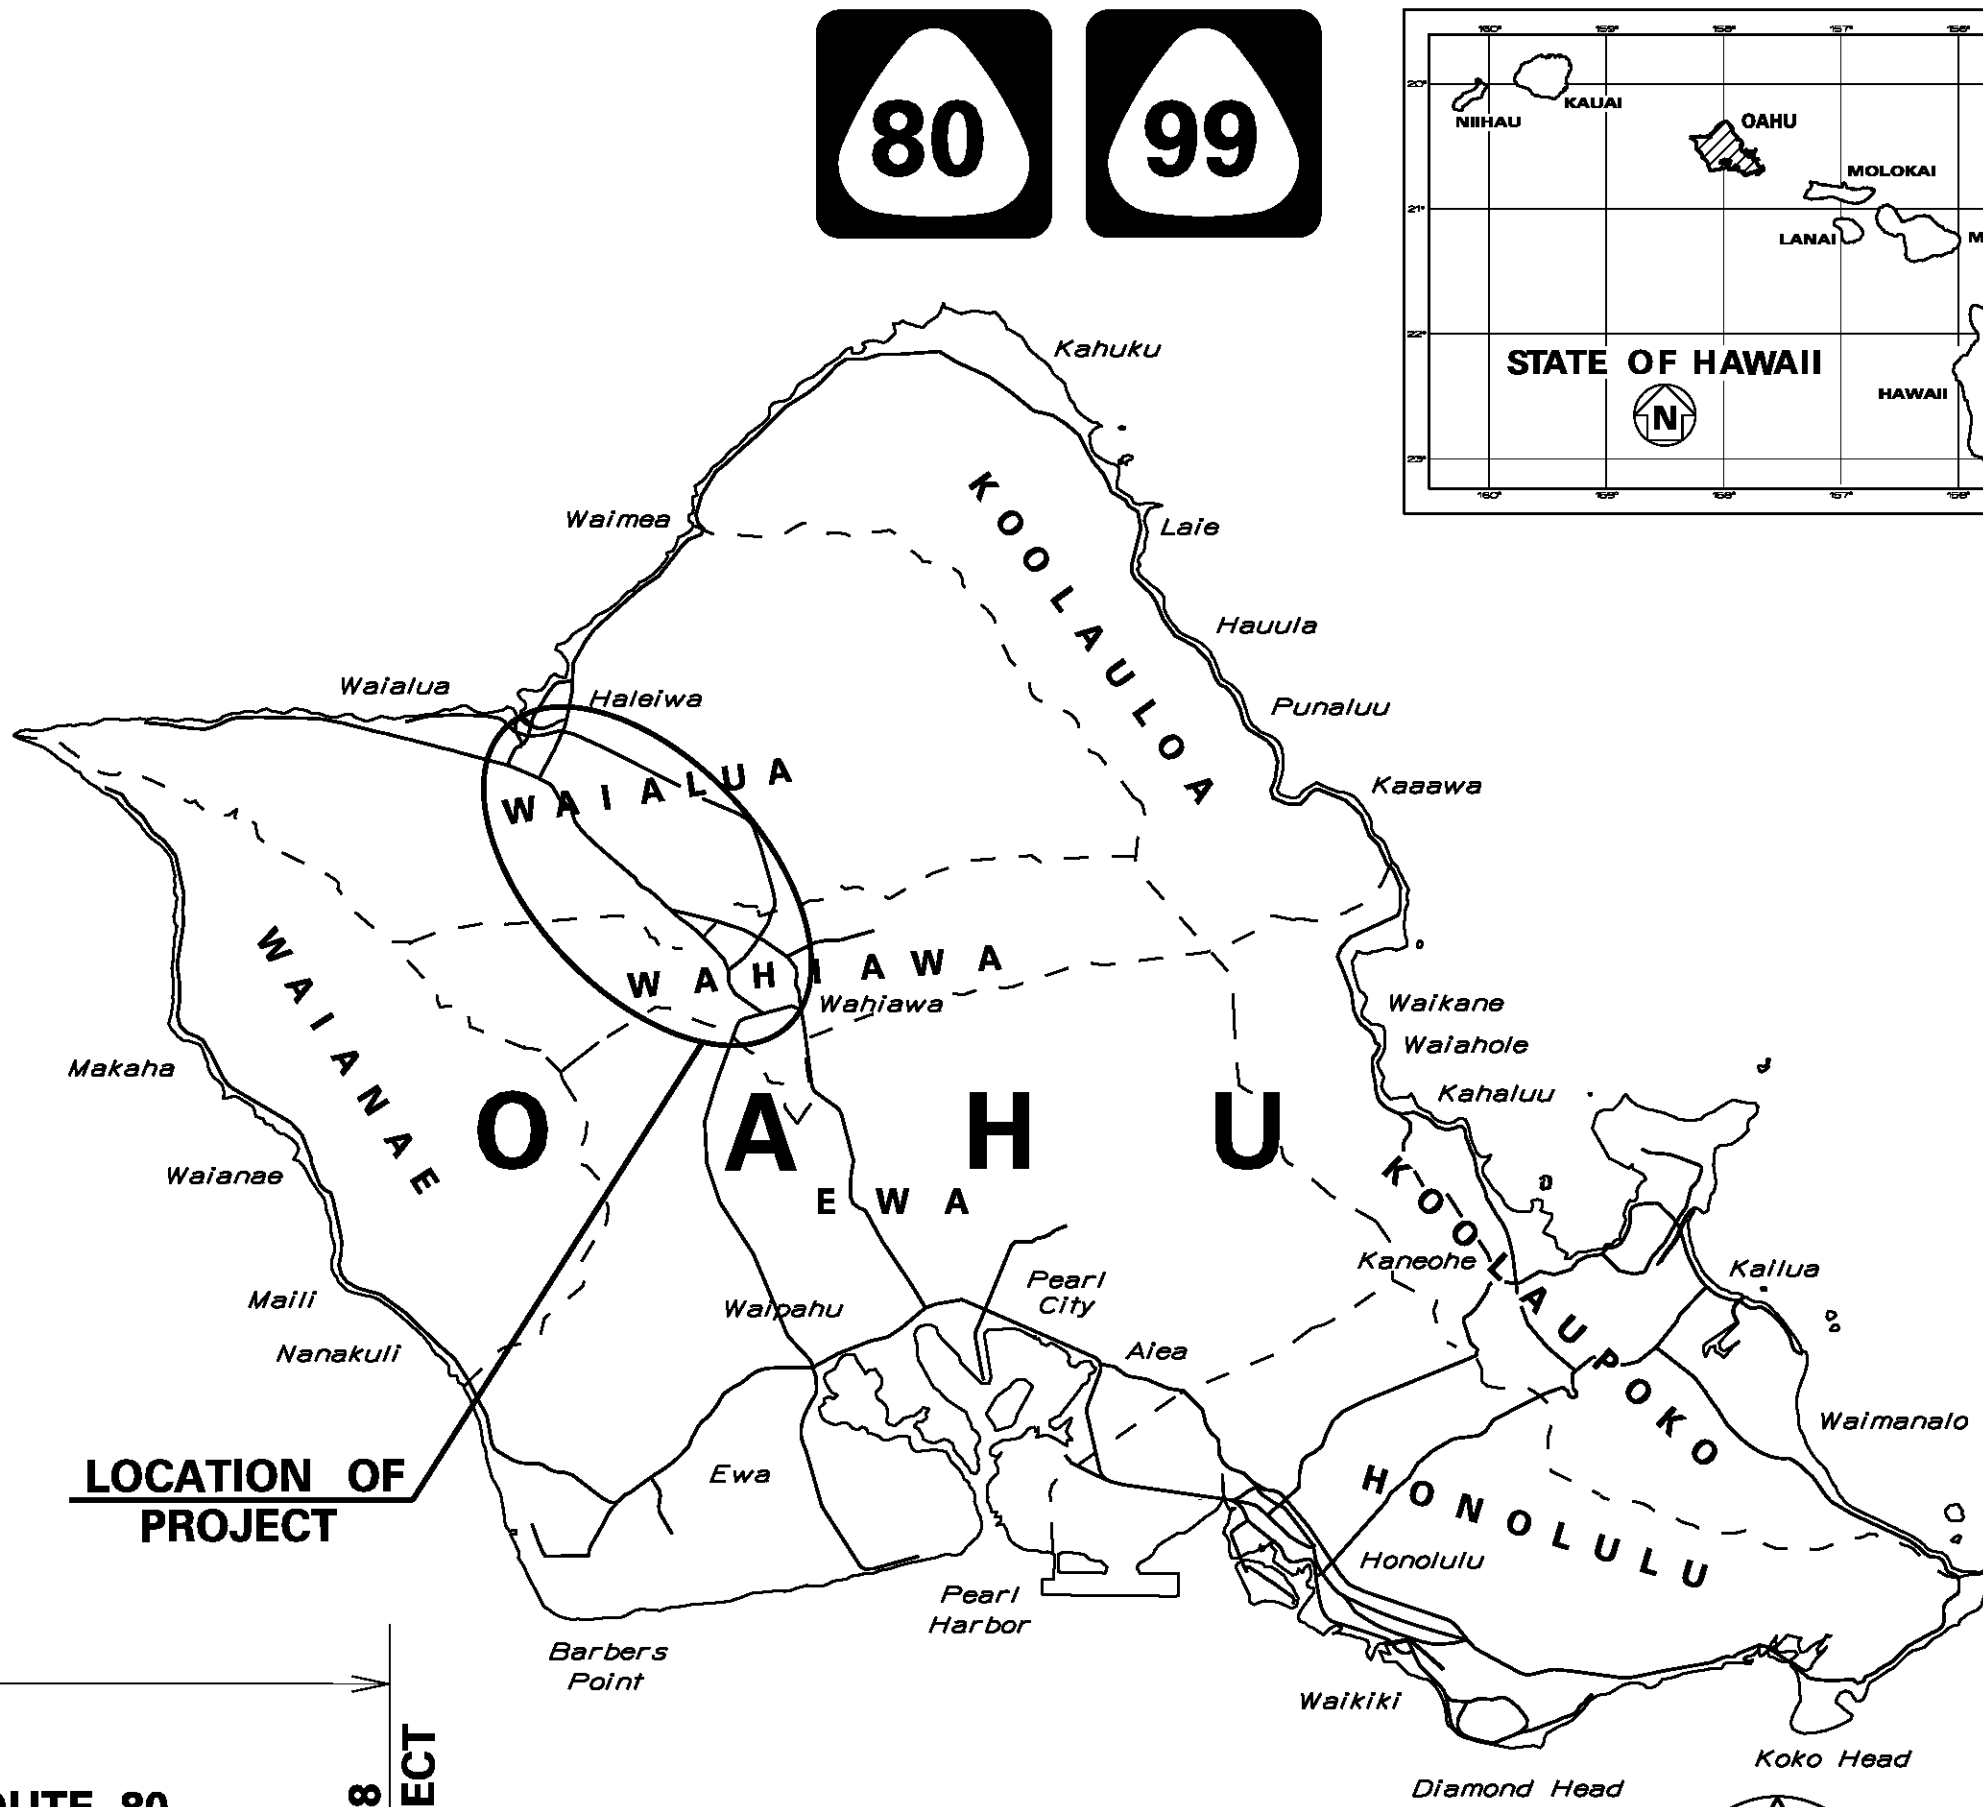

ROUTE 80: MILE POST 0.00 TO MILE POST 1.89
ROUTE 99: MILE POST 0.00 TO MILE POST 9.48


MITSUNAGA & ASSOCIATES
DESIGNED BY
HWY-DS
MANAGED BY
692-7548
AUGUST, 2020
PHONE
DATE

DESIGN DESIGNATION	ROUTE 80			ROUTE 99						
	M.P. 0.00 TO M.P. 0.33	M.P. 0.33 TO M.P. 1.10	M.P. 1.10 TO M.P. 1.89	M.P. 0.00 TO M.P. 5.66	M.P. 5.66 TO M.P. 6.56	M.P. 6.56 TO M.P. 6.77	M.P. 6.77 TO M.P. 7.70	M.P. 7.70 TO M.P. 8.36	M.P. 8.36 TO M.P. 9.08	M.P. 9.08 TO M.P. 9.48
ADT (2020)	62,100	29,100	16,400	23,600	24,500	11,100	15,100	24,600	31,000	55,200
ADT (2040)	73,800	34,000	19,200	31,000	30,300	14,000	19,600	26,800	33,800	60,300
DHV	5,170	2,550	1,440	2,480	2,270	1,120	1,670	2,280	2,700	4,820
K	7.0	7.5	7.5	8.0	7.5	8.0	8.5	8.5	8.0	8.0
D	55/45	55/45	55/45	55/45	55/45	55/45	55/45	60/40	55/45	55/45
T	5.0	7.0	7.0	4.0	4.0	4.5	4.0	3.0	4.0	4.5
T ₂₄	4.5	5.0	6.0	4.5	4.5	5.0	4.5	4.5	4.5	4.5


8/19/20	Revised Fed. Road Dist. No. from Oahu to Hawaii
DATE	REVISION

DEPARTMENT OF TRANSPORTATION STATE OF HAWAII	
APPROVED:	SEP 11, 2020
DIR. OF TRANSPORTATION	DATE

FED. ROAD DIST. NO.	STATE	FED. AID PROJ. NO.	FISCAL YEAR	SHEET NO.	TOTAL SHEETS
HAWAII	HAW	NH-099-1(031)	2020	ADD.13	125

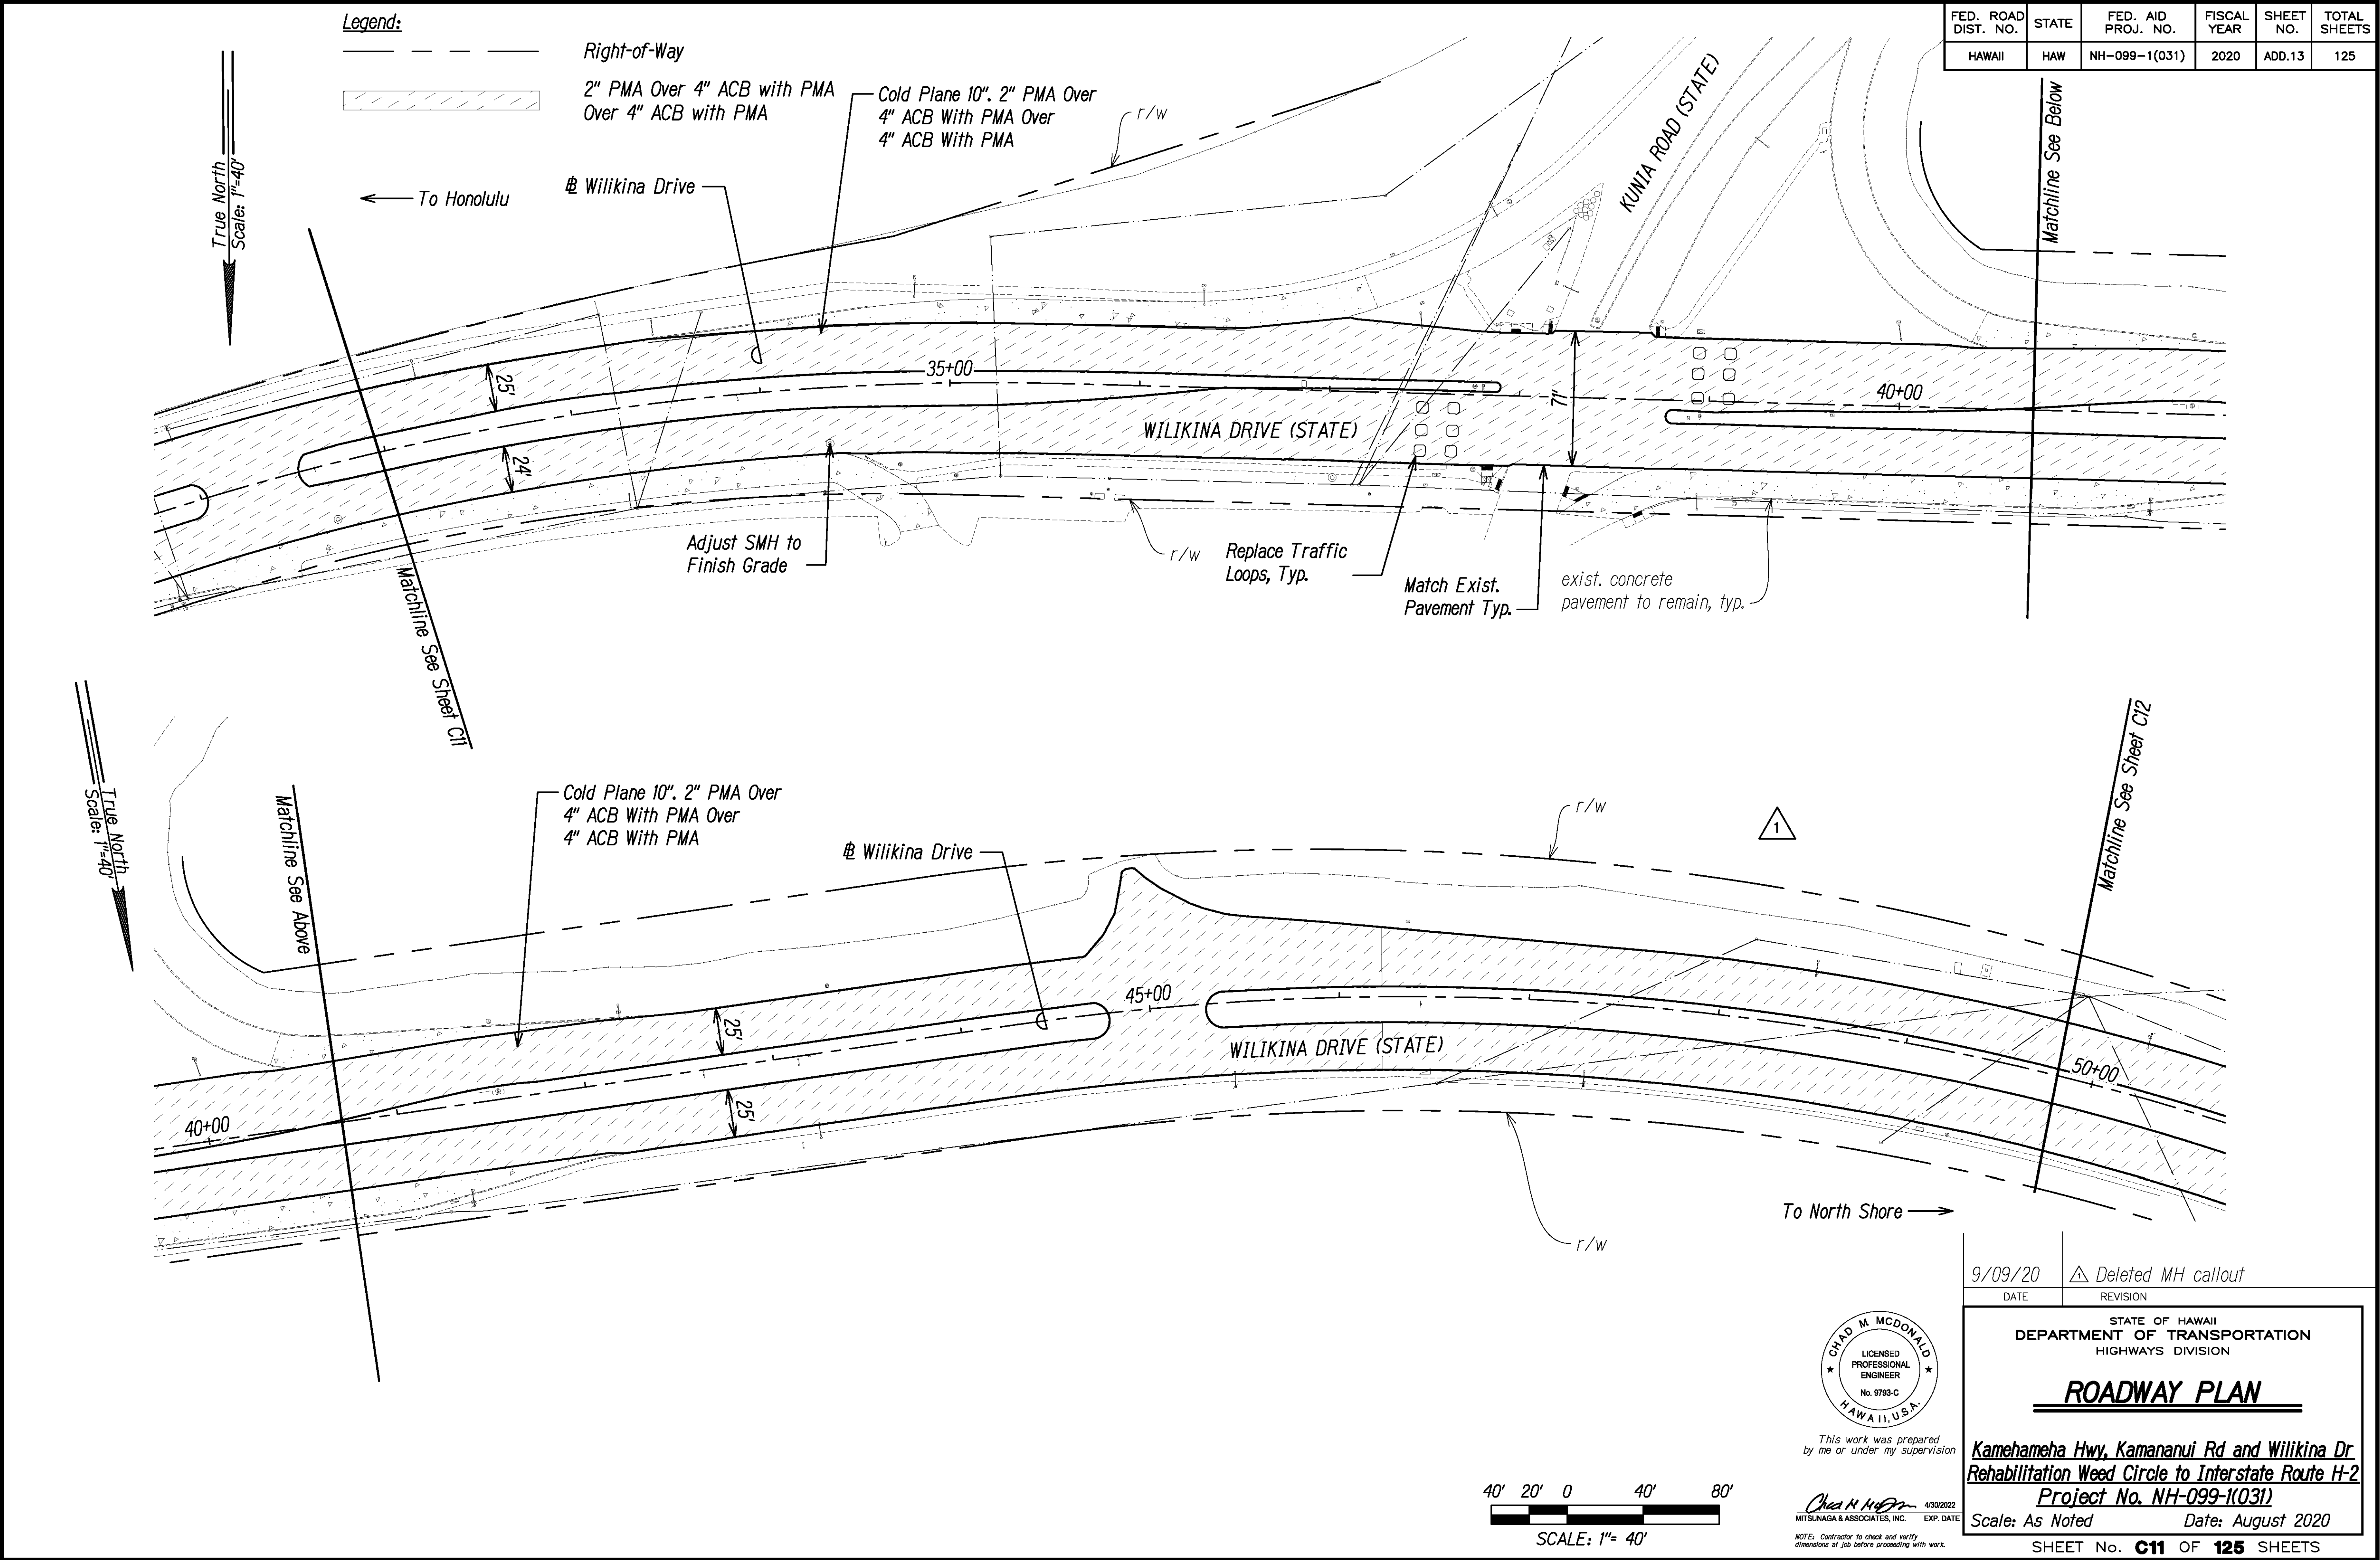

SURVEY PLOTTED BY	DATE
DESIGNED BY	
TRACED BY	
DESIGNED BY	
QUANTITIES BY	
CHECKED BY	
NO.	

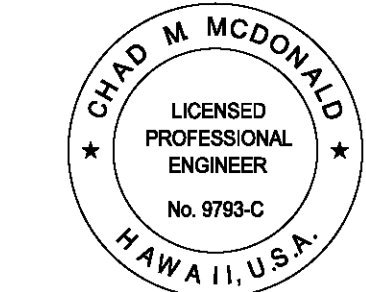

This work was prepared by me or under my supervision


Chad M. McDonald
MITSUNAGA & ASSOCIATES, INC. EXP. DATE 4/30/2022

NOTE: Contractor to check and verify dimensions at job before proceeding with work.

9/09/20	△ Deleted MH callout
DATE	REVISION
STATE OF HAWAII DEPARTMENT OF TRANSPORTATION HIGHWAYS DIVISION	
ROADWAY PLAN	
Kamehameha Hwy, Kanananui Rd and Wilikina Dr Rehabilitation Weed Circle to Interstate Route H-2 Project No. NH-099-1(031)	
Scale: As Noted	Date: August 2020
SHEET No. C11 OF 125 SHEETS	


FED. ROAD DIST. NO.	STATE	FED. AID PROJ. NO.	FISCAL YEAR	SHEET NO.	TOTAL SHEETS
HAWAII	HAW	NH-099-1(031)	2020	ADD.15	125

Legend:
 Right-of-Way
 2" PMA Over 4" ACB with PMA
 Over 4" ACB with PMA

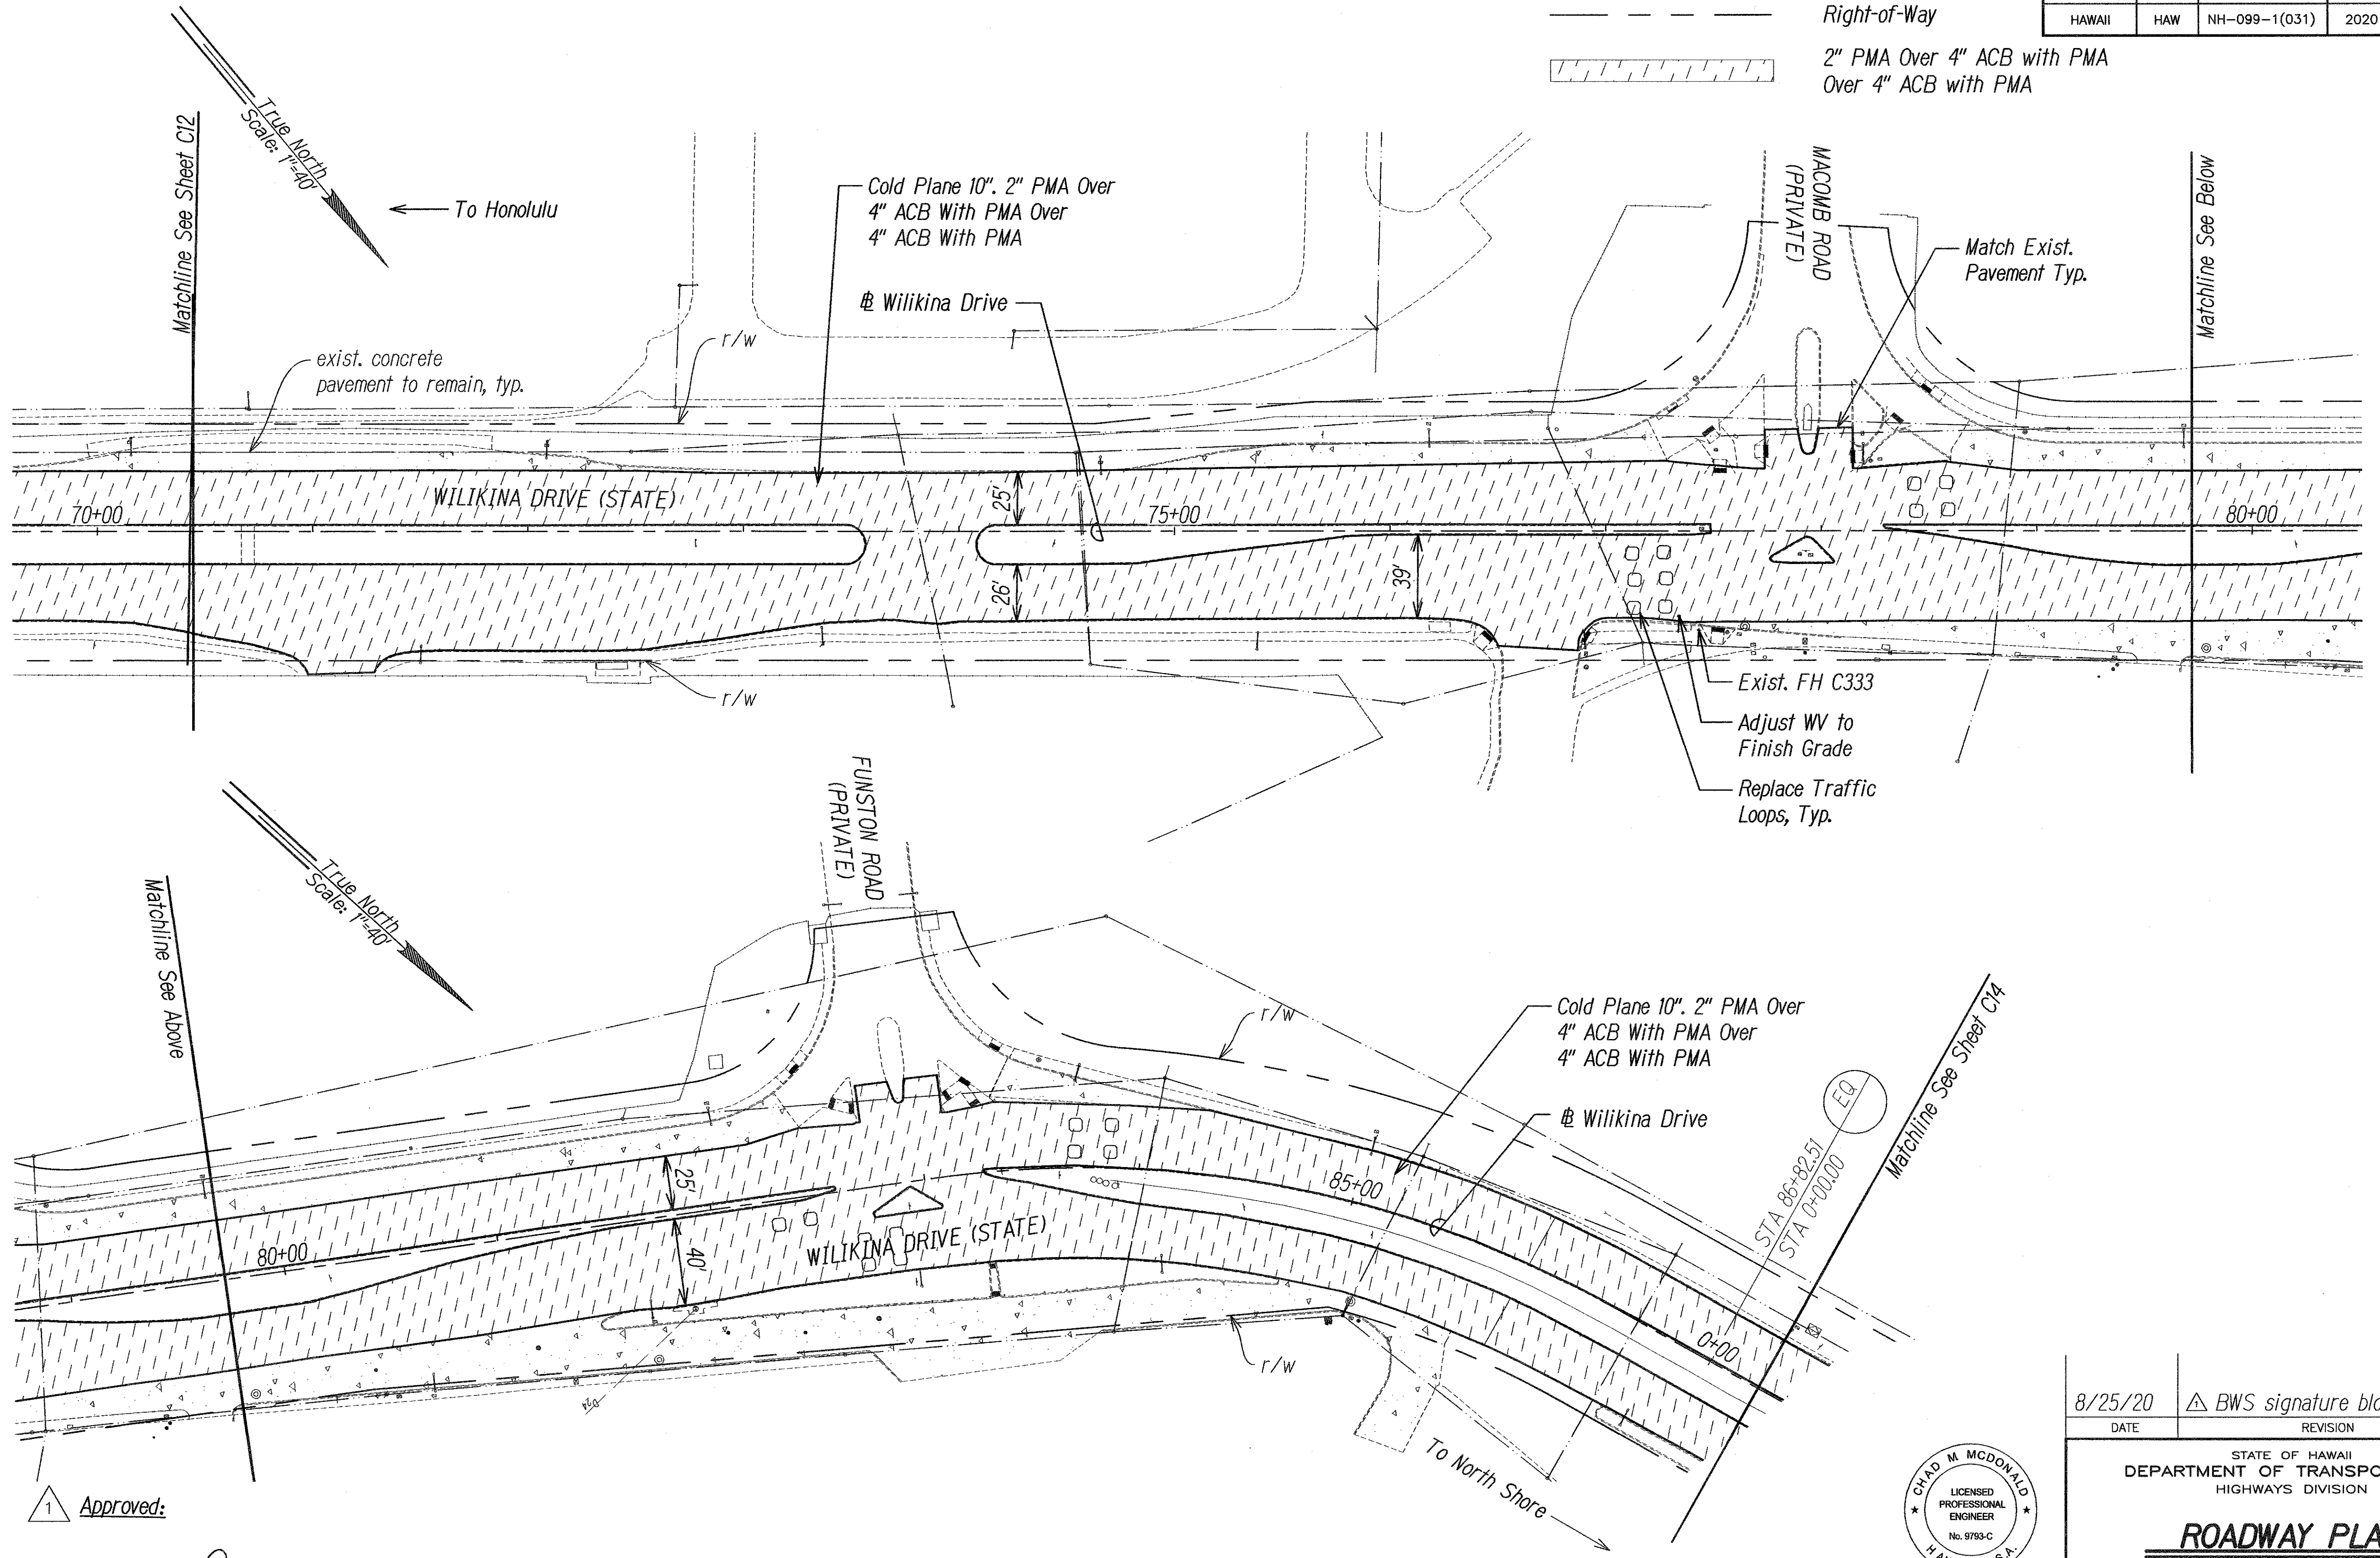

Approved:

FOR Manager and Chief Engineer, BWS
 (For work affecting BWS facilities in City/State
 R/W and BWS Easements only)
 AUG 27 2020
 Date

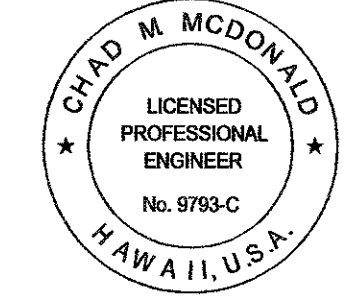


This work was prepared
 by me or under my supervision


NOTES: Contractor to check and verify
 dimensions of job before proceeding with work.

8/25/20 DATE
 REVISION
 STATE OF HAWAII
 DEPARTMENT OF TRANSPORTATION
 HIGHWAYS DIVISION
ROADWAY PLAN
 Kamehameha Hwy, Kananui Rd and Wilikina Dr
 Rehabilitation Weed Circle to Interstate Route H-2
 Project No. NH-099-1(031)
 Scale: As Noted Date: August 2020
 SHEET No. C13 OF 125 SHEETS


FED. ROAD DIST. NO.	STATE	FED. AID PROJ. NO.	FISCAL YEAR	SHEET NO.	TOTAL SHEETS
HAWAII	HAW	NH-099-1(031)	2020	ADD.22	125

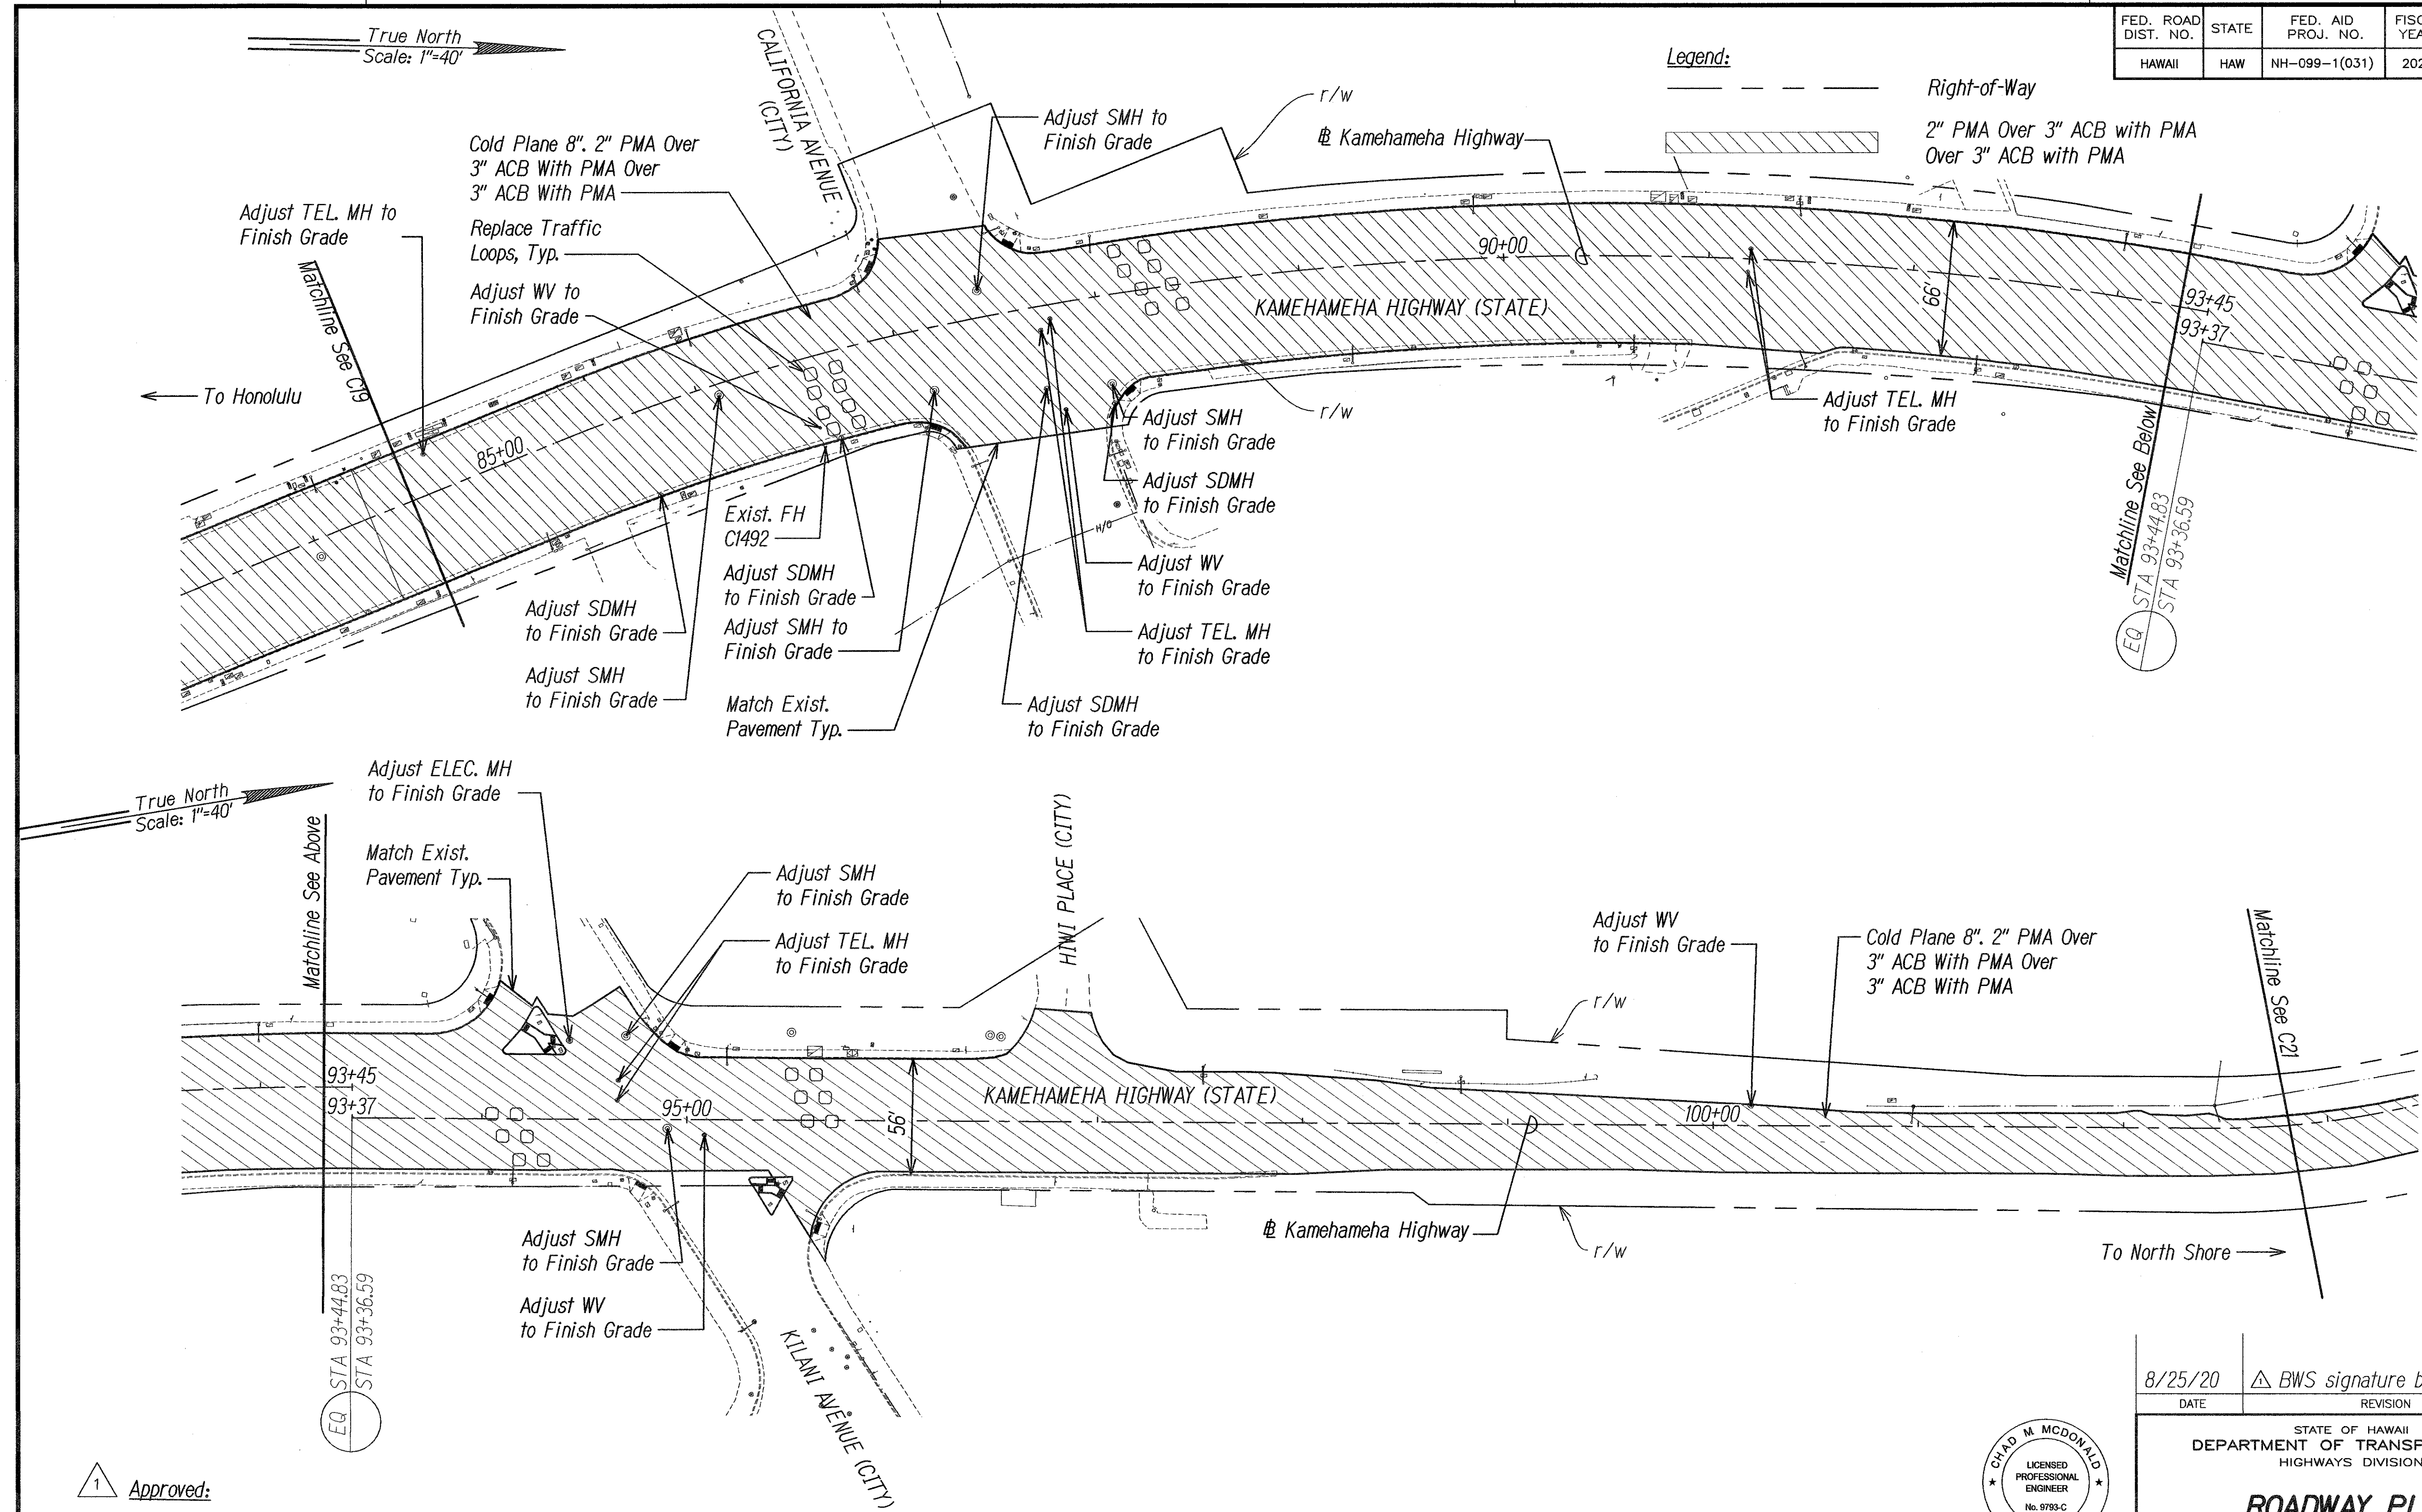


ORIGINAL PLAN	DATE
SURVEY PLOTTED BY	
DRAWN BY	
DESIGNED BY	
CHECKED BY	
NOTE BOOK	
No.	

1 Approved:  AUG 27 2020 Date

for Manager and Chief Engineer, BWS
(For work affecting BWS facilities in City/State
R/W and BWS Easements only)

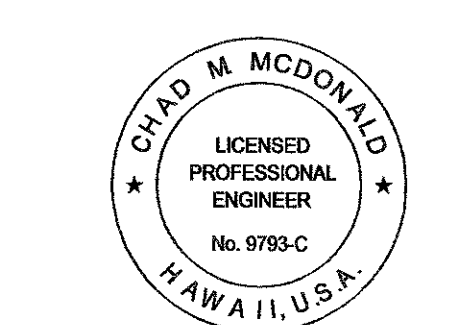

This work was prepared
by me or under my supervision

 4/30/2022
MITSUNAGA & ASSOCIATES, INC. EXP. DATE

NOTE: Contractor to check and verify
dimensions at job before proceeding with work.

8/25/20 DATE REVISION






△ BWS signature block added.


STATE OF HAWAII
DEPARTMENT OF TRANSPORTATION
HIGHWAYS DIVISION

ROADWAY PLAN

Kamehameha Hwy, Kamananui Rd and Wilikina Dr.
Rehabilitation Weed Circle to Interstate Route H-2
Project No. NH-099-1(031)
Scale: As Noted Date: August 2020

SHEET No. **C20** OF **125** SHEETS

<u>Legend:</u> 		FED. ROAD DIST. NO.
		HAWAII
		<i>Right-of-Way</i>
		2" PMA Over 3" ACB with PMA Over 3" ACB with PMA
		2" PMA Over 3" ACB with PMA

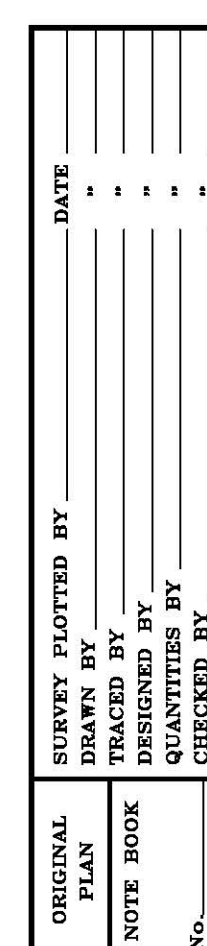

A circular professional engineer seal for Chad M. McDonald, State of Hawaii. The outer ring contains the text "CHAD M. MCDONALD" at the top and "HAWAII, U.S.A." at the bottom, separated by a star on the left. The inner circle contains the text "LICENSED PROFESSIONAL ENGINEER" and "No. 9793-C".


Chad N. McGinn 4/30/2022
 MITSUBISHI & ASSOCIATES, INC. EXP. DA

ROADWAY PLAN

Scale: As Noted Date: August 2020

SHEET No. **C21** OF **125** SHEETS

40' 20' 0 40' 80'



SCALE: 1" = 40'

ADD.23

FED. ROAD DIST. NO.	STATE	FED. AID PROJ. NO.	FISCAL YEAR	SHEET NO.	TOTAL SHEETS
HAWAII	HAW	NH-099-1(031)	2020	ADD.125 S-1	125


ENHANCED VEHICLE CLASSIFICATION (EVC) SYSTEM NOTES

- The location of new loop sensors and piezo sensors shall be staked out in the field by the Contractor and approved by the Engineer prior to installation.
- The Contractor shall inform the Engineer at least three days prior to saw cutting pavement and installing loop sensors and piezo sensors.
- Pull loop sensor cables and piezo sensor lead cables into conduit where indicated. Cables shall be tested for acceptance before and after installation into conduit.
- Piezo lead cables shall be continuous with no splices.
- The Contractor shall restore all affected areas to their original condition. This item of work shall not be paid for separately, but shall be considered incidental to work of other paid items.
- The Contractor shall verify the location of the existing utilities and underground structures whether or not shown on the plans.
- The Contractor shall assume that underground utilities not shown on the plans may exist. The Contractor shall be responsible for contacting the different utility companies for information and toning.
- The Contractor shall be held liable for any damages incurred to the existing utilities and underground structures as a result of his operations. All damaged portions shall be replaced in accordance with the standards and specifications of the affected utility company at no cost to the State.
- Changes to the contract plans and specifications will not be permitted, unless approved by the Engineer in writing.
- All cables are to be terminated within the EVC cabinet and shall have a minimum 12" additional slack.
- Highway crossing conduit shall be provided with 36" cover.
- Saw cuts shall be made by wet cutting only.
- Clean away collected dust, dirt, and refuse after saw cutting is done. The saw cuts shall be cleared by water applied by pressure washer. Residual water within the saw cuts shall be vacuumed by use of a wet/dry vacuum. The saw cuts shall then be dried by air compressor.
- After saw cuts are dried, any remaining debris stuck within the cut shall be removed. The saw cuts must be completely clean and dry before inserting the sensors and filling the voids with Loop Sealant (for loop sensors) or PU200 Piezo Installation Resin or equivalent (for piezo sensors).

ENHANCED VEHICLE CLASSIFICATION (EVC) SYSTEM NOTES CONTINUED

- The collected slurry shall be disposed of appropriately (i.e., either placed in a Filter Fabric Lined Filtration Box or in a Filter Fabric Lined Dug Up Retention/Percolation Basin, and after Filtration/Percolation, the Filter Fabric and the retained sediments, disposed of appropriately).
- LOOP SENSOR LAYOUT NOTES
- Loop sensors shall consist of four turns of 1C #14 cable (meeting IMSA Spec 51-3 or equivalent) embedded in a 3/8" wide by 4" deep saw cut, except as noted. Loop sensors shall be provided a minimum 2" cover.
 - After laying the loop sensor cable in four (4) turns within the 4" deep cut, press 1"-long pieces of backer rod in each foot of the loop and the loop lead saw cut, to anchor the wire in the bottom of the cut before applying the Loop Sealant. Backer rod shall be embedded at least 2" below the top of pavement. The backer rod shall be placed into the saw cut with a blunt object, such as a wooden paint stir stick. No sharp objects (such as a screw driver) shall be used to place the backer rod into the saw cuts.
 - Loop sensor and lead cable shall be one continuous wire. Lead wires from the same loop shall be twisted in pairs, five twists per foot, from the edge of paved shoulder to the pull box. Do not twist one loop pair with another loop pair.
 - Continuity of loop sensors and lead-in wires shall be tested and warrantied for one year from the date of acceptance by the Engineer.
 - Loop sensor lead cables shall be spliced only at the closest pull box to the loop. Splice points of cables shall be suspended near the top of the pull box with a j-hook.
 - Splices shall be made by use of a splice kit.
 - Stagger loop sensors on roadways with lanes that are less than 12 feet in width, as shown on contract plans or by direction of the Engineer.
 - The Contractor shall label the loop and piezo sensor leads clearly to identify traffic direction, lane number, and sequence of loop and piezo sensors in each lane per direction.
 - The left-most lane in the direction of traffic flow is designated as Lane 1, and the next lane to its right as Lane 2, and so on as indicated on plans.

SURVEY PLOTTED BY _____	DATE _____
DESIGNED BY _____	TRACED BY _____
NOTE BOOK _____	DESIGNED BY _____
QUANTITIES BY _____	CHECKED BY _____
NO. _____	

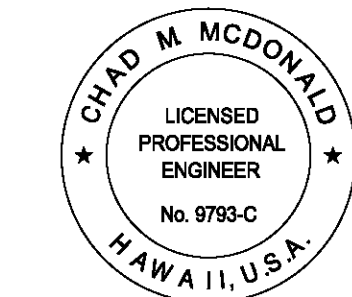

This work was prepared by me or under my supervision

Chad M. McDonald
MITSUNAGA & ASSOCIATES, INC. EXP. DATE 4/30/2022

NOTE: Contractor to check and verify dimensions at job before proceeding with work.


9/09/20 Δ New Sheet added
DATE REVISION

STATE OF HAWAII DEPARTMENT OF TRANSPORTATION HIGHWAYS DIVISION	
EVC TRAFFIC COUNTING SYSTEM NOTES	
STATION 080000, 080008 REPAIRS	
Kamehameha Hwy, Kamananui Rd and Wilikina Dr Rehabilitation Weed Circle to Interstate Route H-2 Project No. NH-099-1(031)	
Scale: As Noted	Date: August 2020

SHEET No. --- OF 125 SHEETS

ADD.125 S-1


FED. ROAD DIST. NO.	STATE	FED. AID PROJ. NO.	FISCAL YEAR	SHEET NO.	TOTAL SHEETS
HAWAII	HAW	NH-099-1(031)	2020	ADD.125 S-4	125

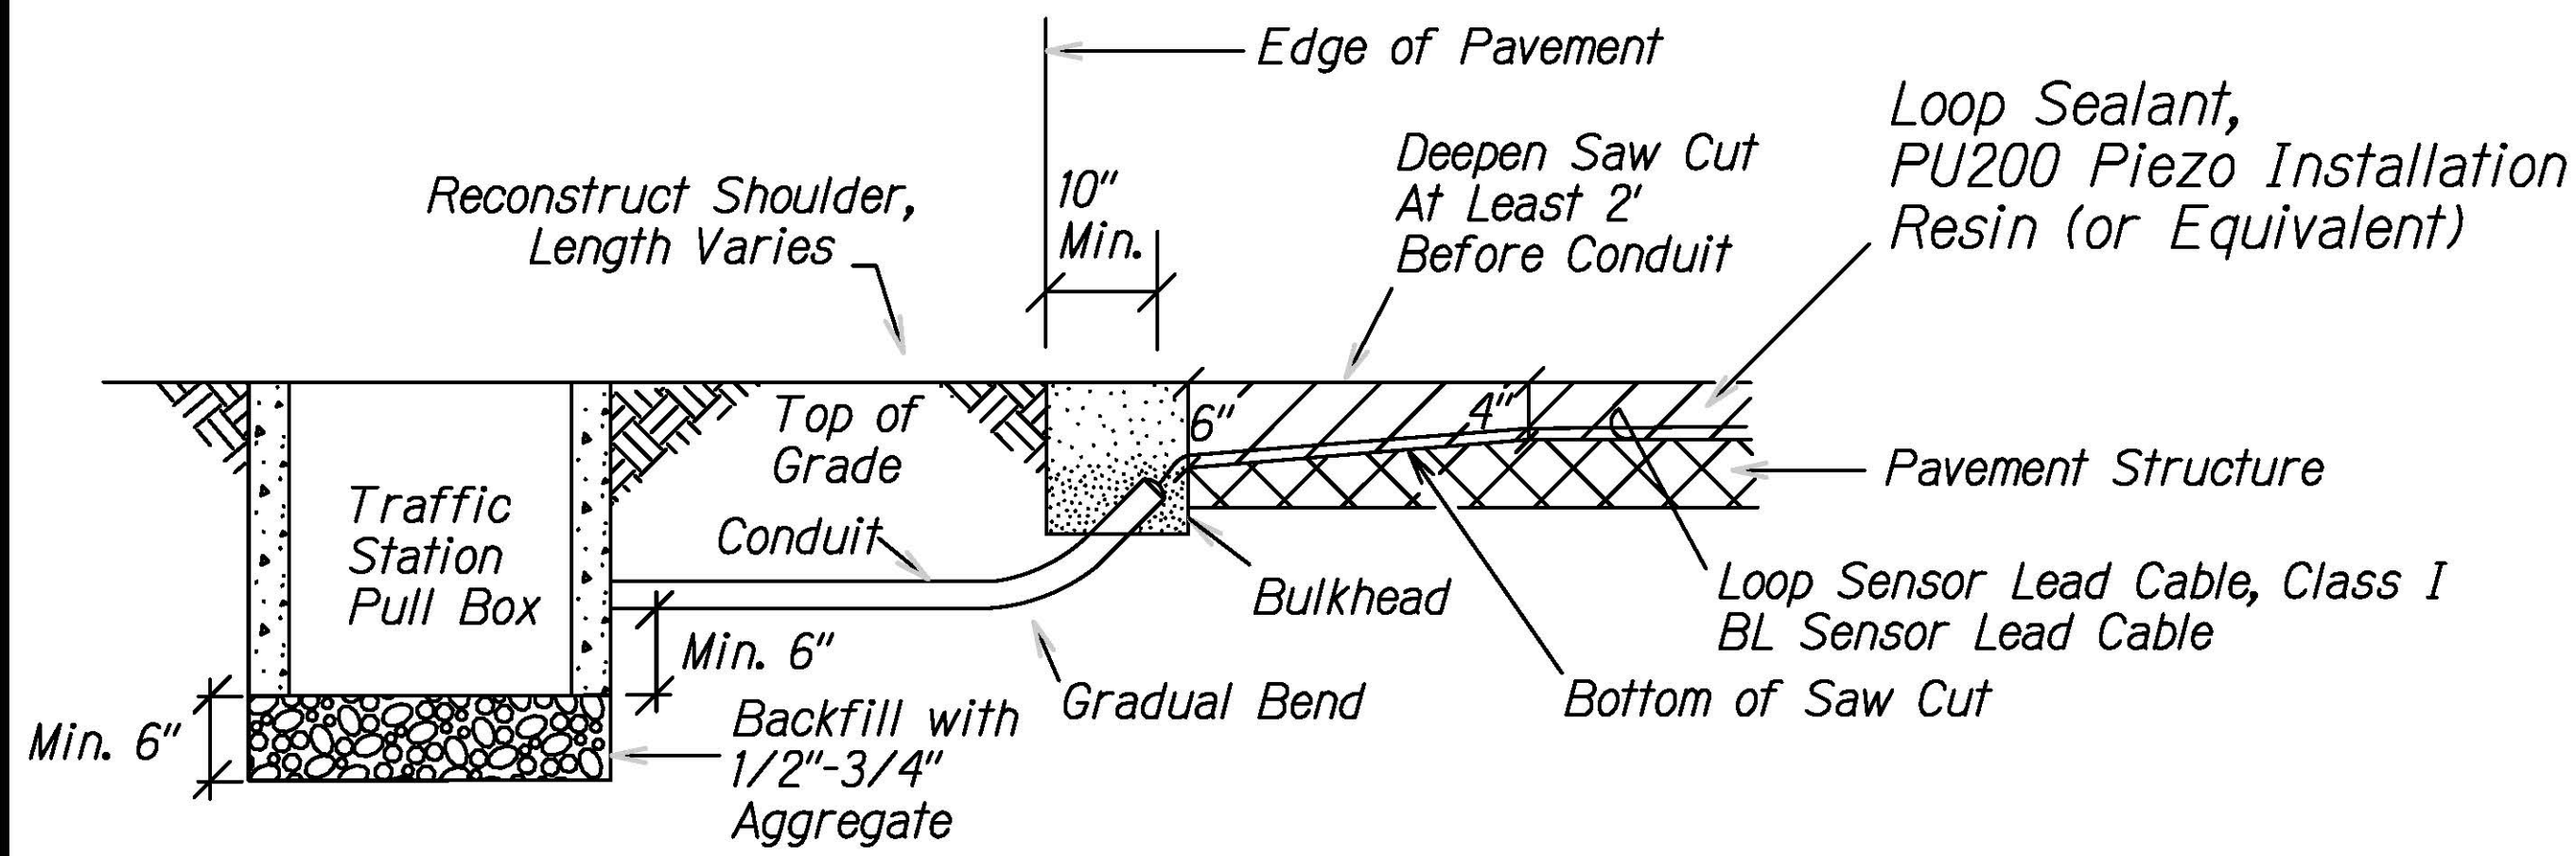


EDGE OF ROADWAY DETAILS
Not to Scale

NOTES ON CONSTRUCTION AT END OF SAW CUT:


1. Seal roadway end of conduit with duct seal compound after installation of conductor.
2. Install bulkhead across saw cut to keep sealant in saw cut as it is placed..
3. Place Loop Sealant, PU200 Piezo Installation Resin (or Equivalent) in saw cut.
4. Place sand to cover exposed lead cables and protect and separate them from backfill.
5. Backfill over sand with new A.C. cold mix.
6. Reconstruct shoulder, curb, and gutter as required.
7. Conduit should be installed at least 10 inches from the edge of pavement.
If the depth of pavement is 4 inches or less at the edge, conduit should be installed at least 12 inches from the edge of pavement.

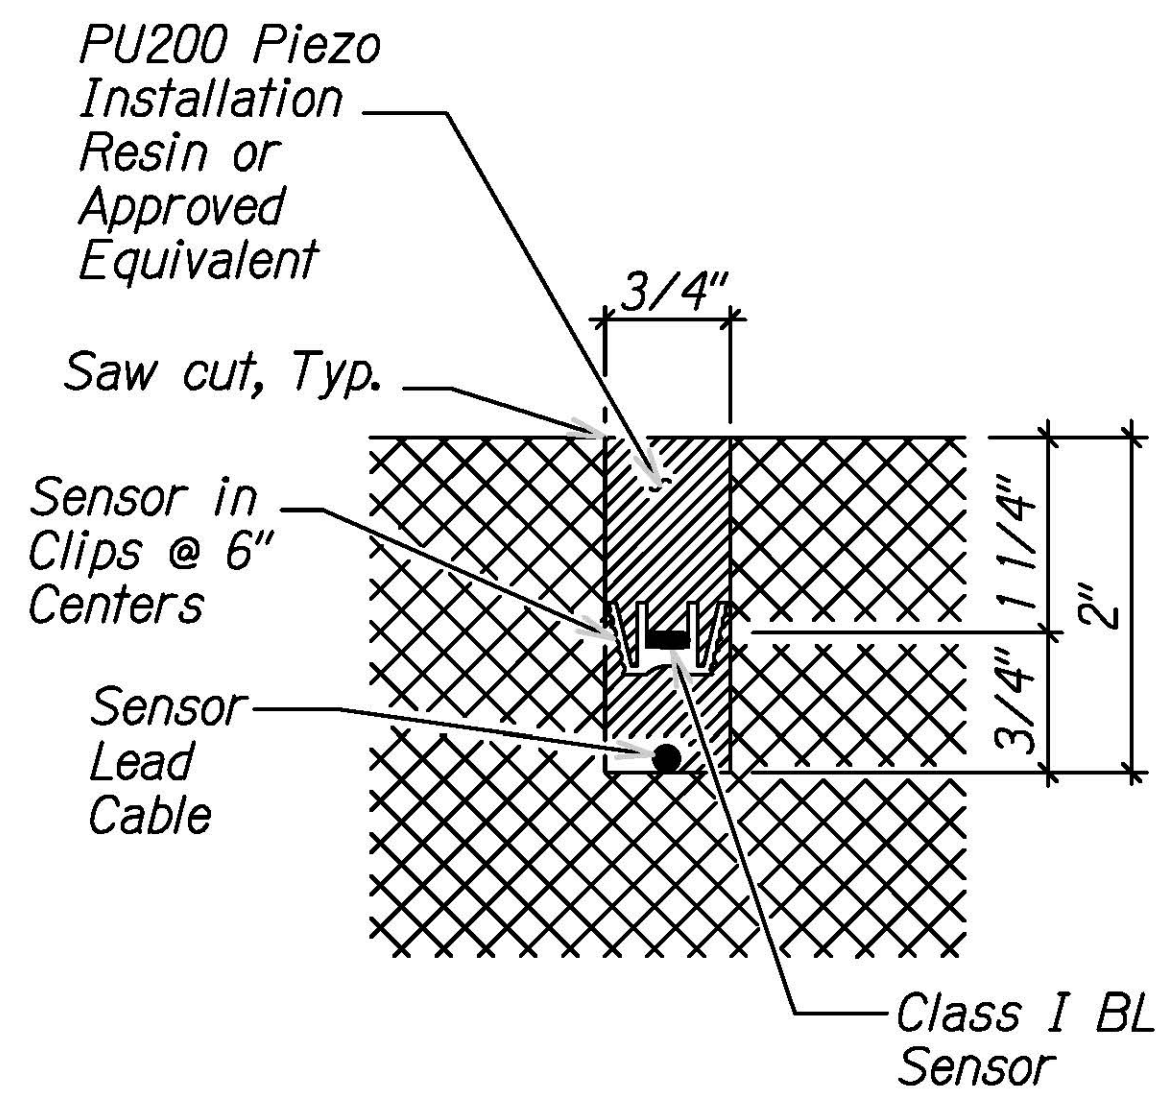

PIEZO SENSOR SAW CUT
SECTION DETAIL
Not to Scale

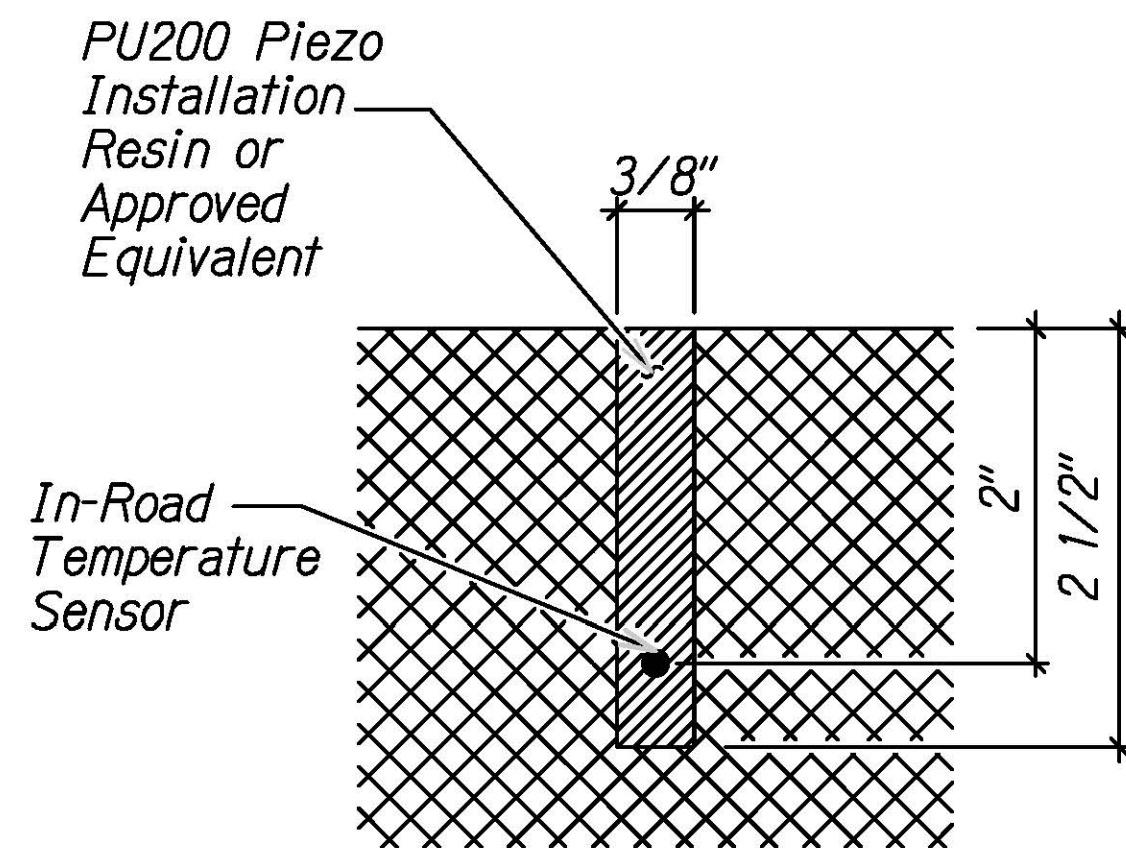

TEMPERATURE SENSOR SAW CUT
SECTION DETAIL
Not to Scale

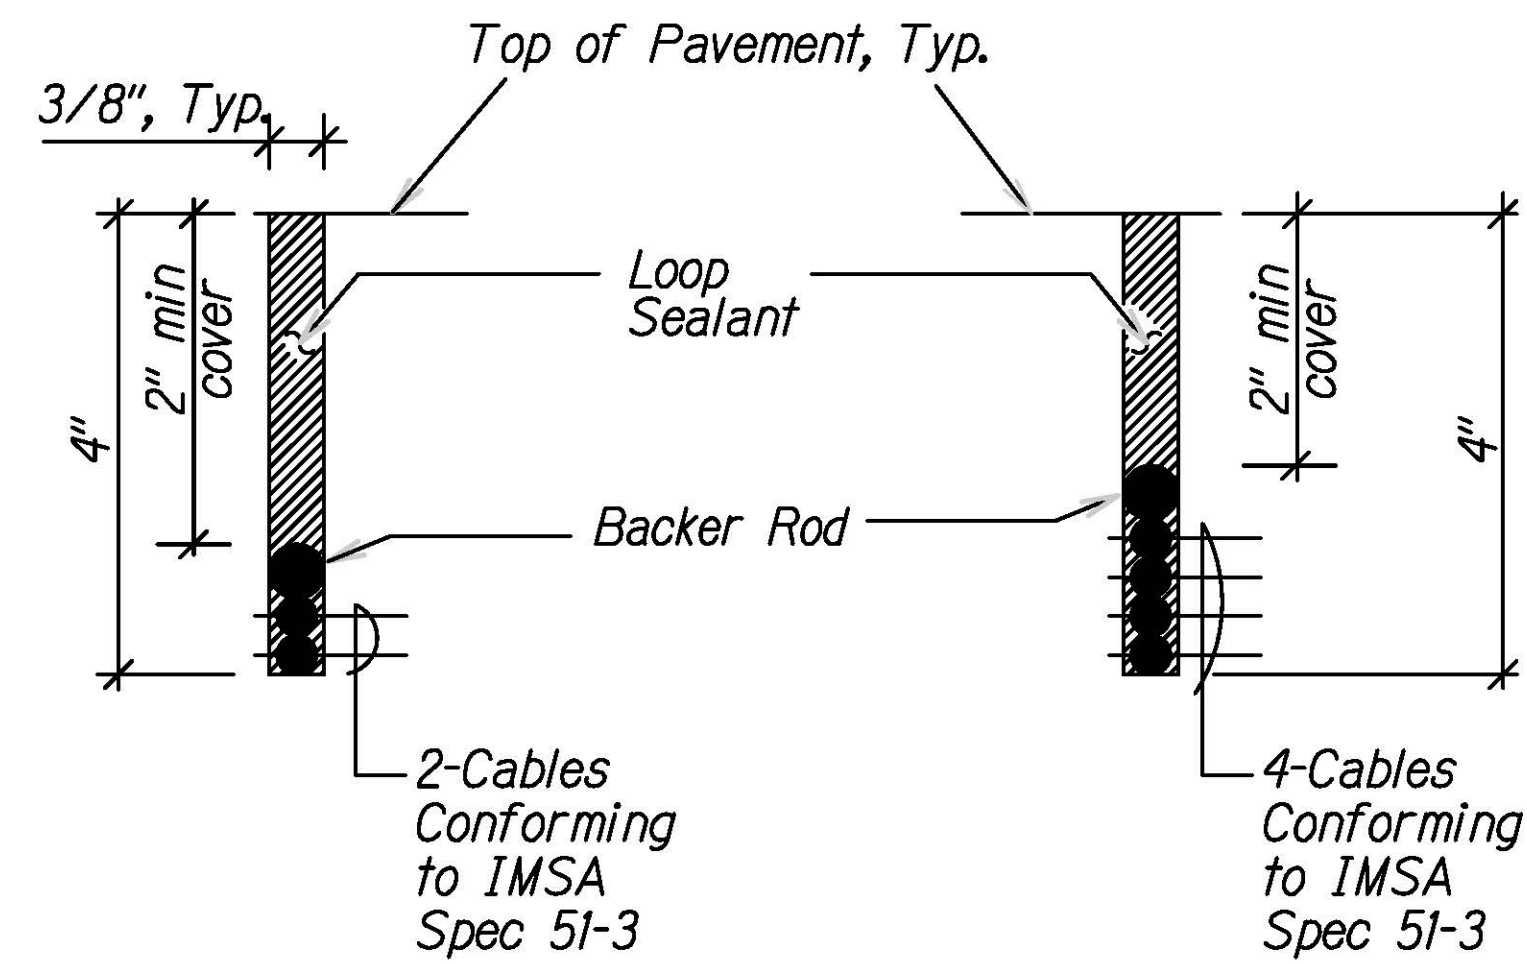


SECTION A
Not to Scale


SECTION B
Not to Scale

TYPICAL SECTIONS
LOOP SENSORS
Not to Scale


LOOP SENSOR SAW CUT NOTES:
Length of overcuts shall be kept to a minimum. All overcuts shall be backfilled with Loop Sealant.

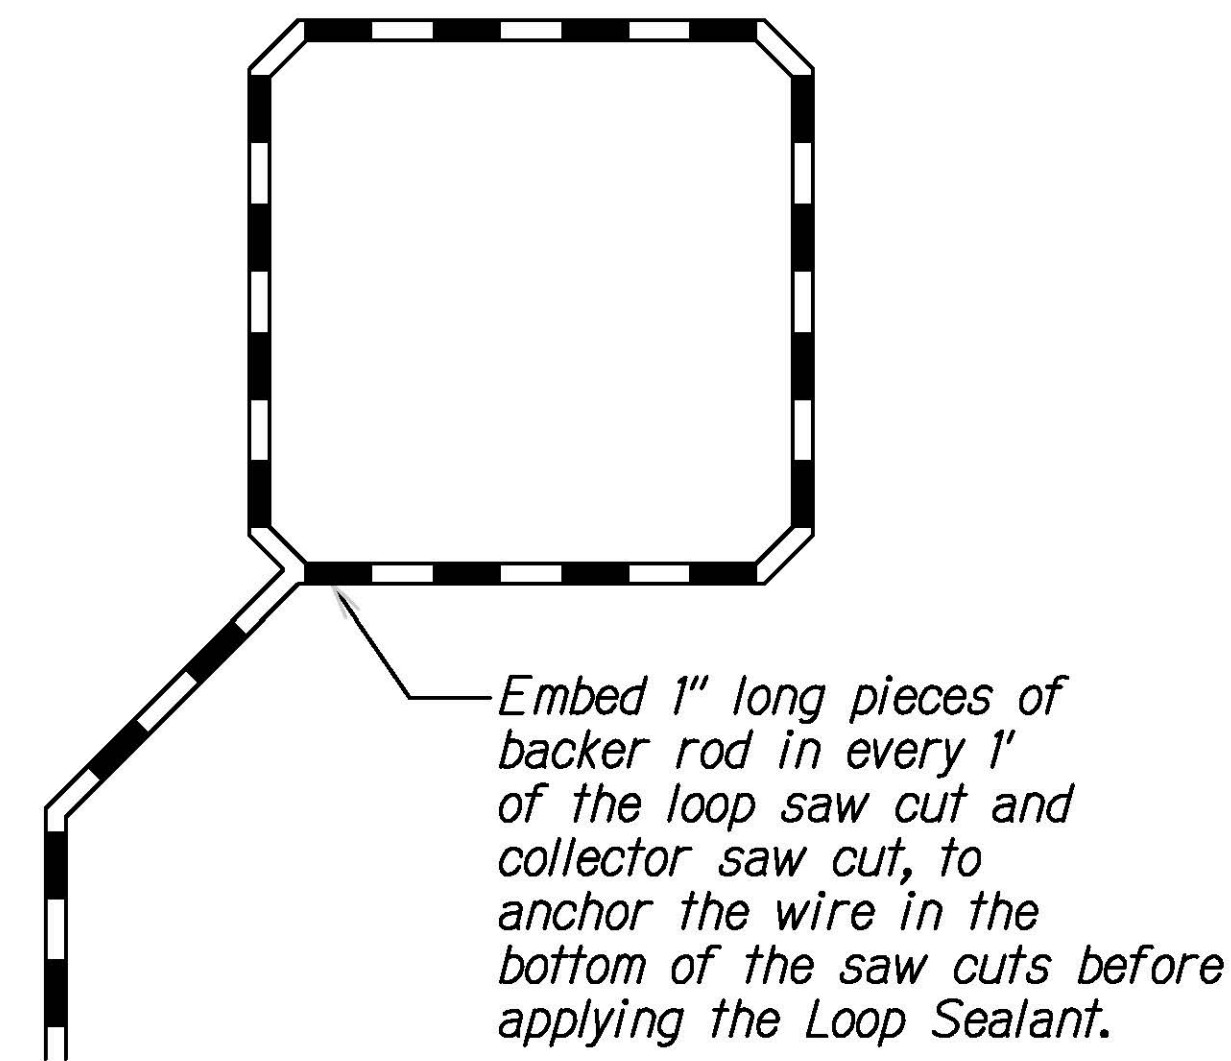

TYPICAL LOOP SENSOR BACKER
ROD PLACEMENT DIAGRAM
Not to Scale

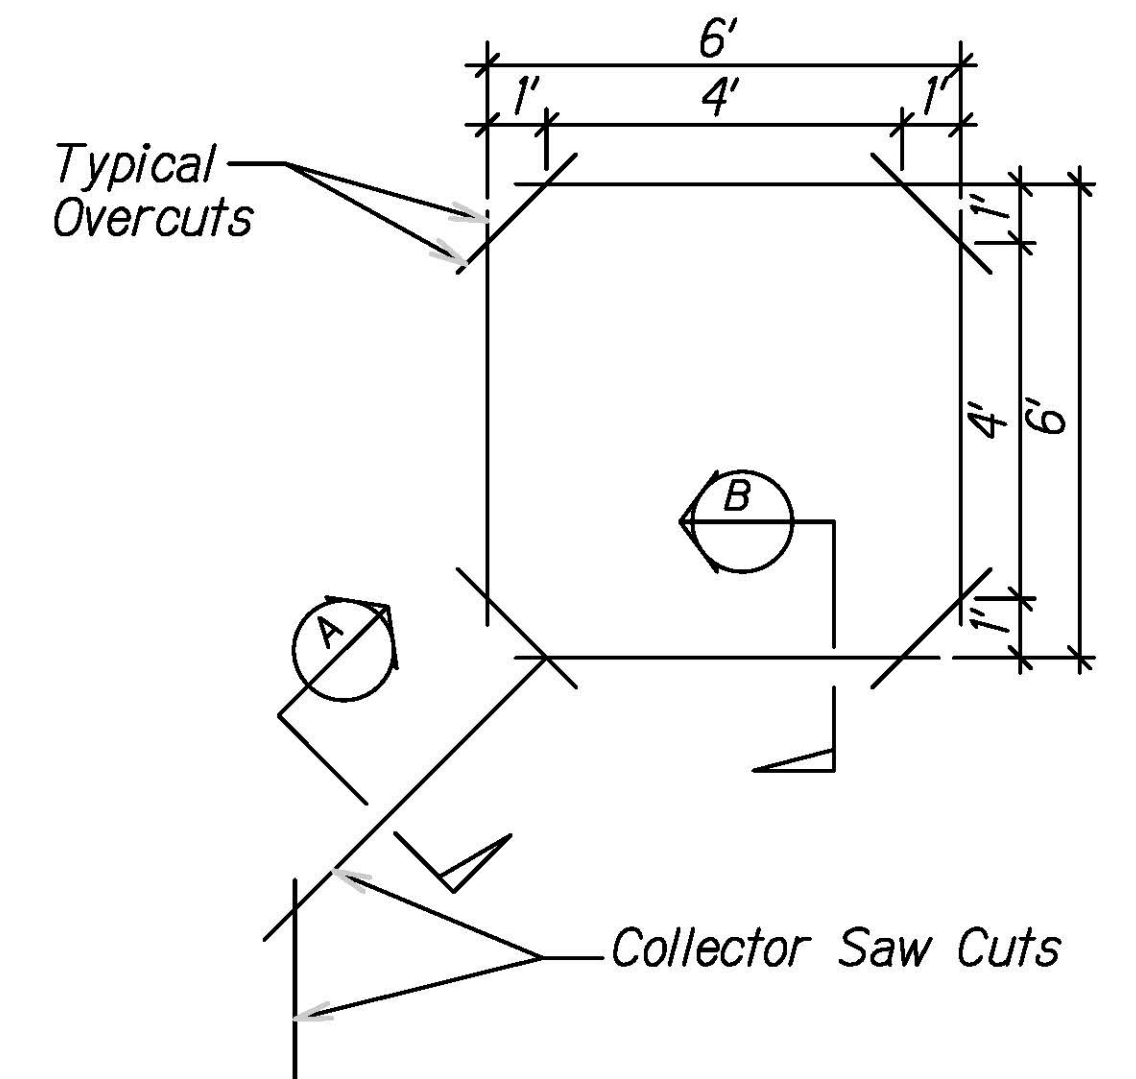


TYPICAL LOOP SENSOR
SAW CUT DETAIL
Not to Scale

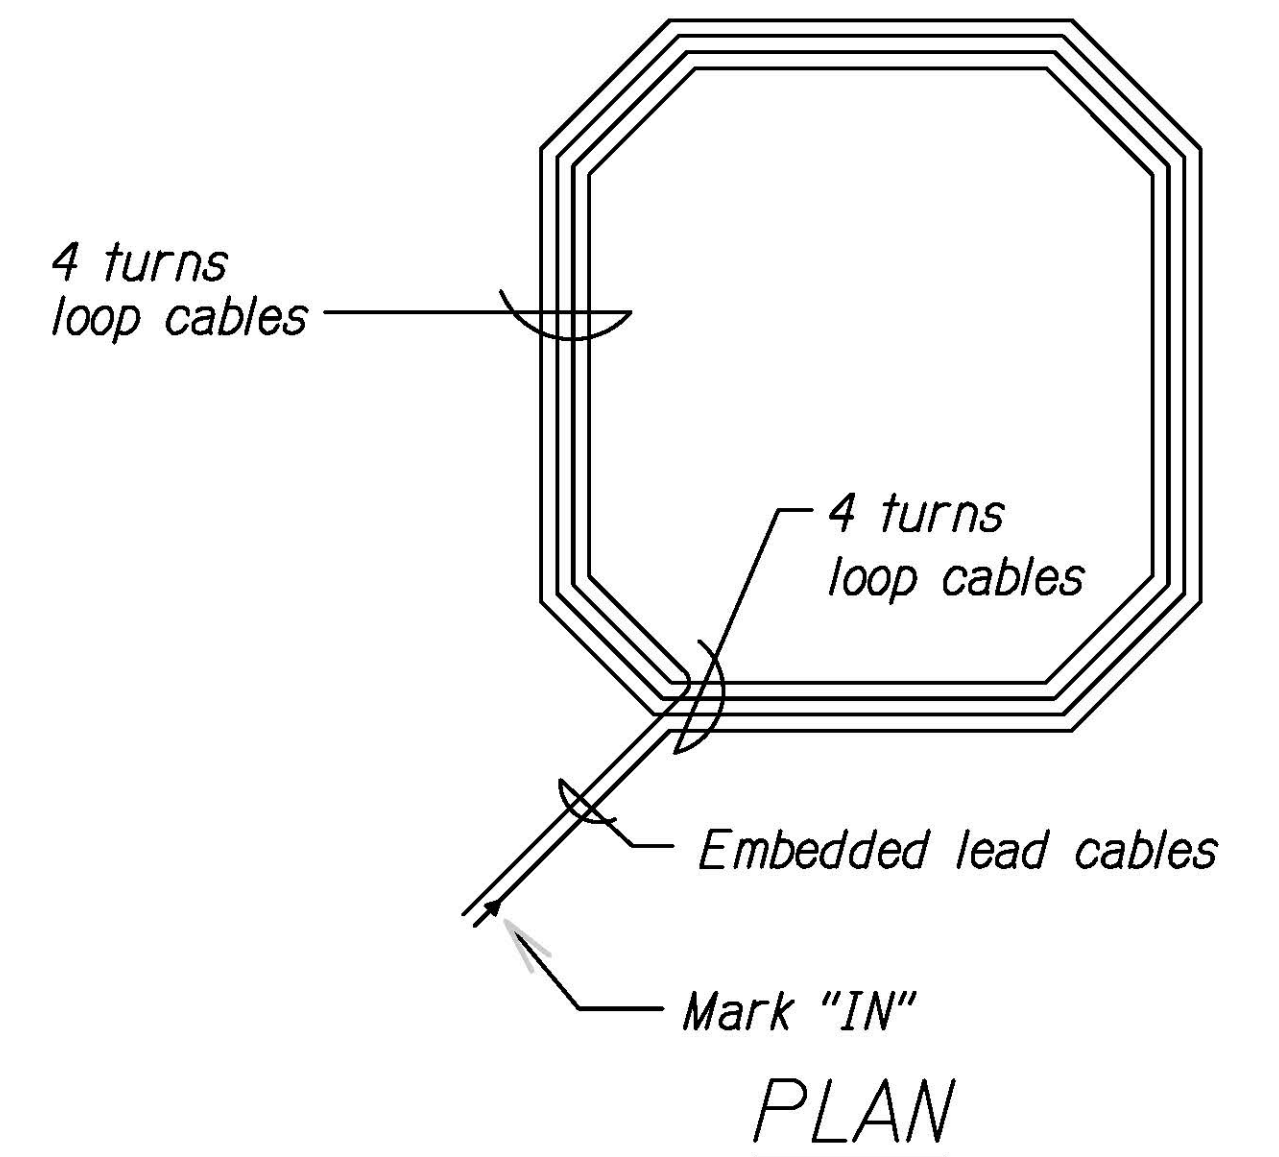

TYPICAL LOOP SENSOR
WIRING DIAGRAM
Not to Scale

9/09/20	△ New Sheet added
DATE	REVISION

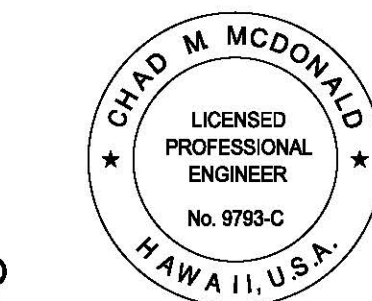

This work was prepared by me or under my supervision

Chad M. McDonald
MITSUNAGA & ASSOCIATES, INC. 4/30/2022
EXP. DATE

NOTE: Contractor to check and verify dimensions at job before proceeding with work.

STATE OF HAWAII DEPARTMENT OF TRANSPORTATION HIGHWAYS DIVISION	
EVC TRAFFIC COUNTING SYSTEM SENSOR DETAILS	
Kamehameha Hwy, Kamananui Rd and Wilikina Dr Rehabilitation Weed Circle to Interstate Route H-2 Project No. NH-099-1(031)	
Scale: As Noted	Date: August 2020

SHEET No. --- OF 125 SHEETS

ADD.125 S-4

FED. ROAD DIST. NO.	STATE	FED. AID PROJ. NO.	FISCAL YEAR	SHEET NO.	TOTAL SHEETS
HAWAII	HAW	NH-099-1(031)	2020	ADD.125 S-5	125




Radius Corners, Typ.

- NOTES:**
1. For sign post detail, see State Standard Plans TE-03A and TE-03B.
 2. Two (2) warning signs shall be placed on each sign post "Back-to-Back".
 3. Text on sign shall be centered both ways and shall be black text on yellow background.
 4. Bottom edge of sign shall be 8' above grade.

EXCAVATION WARNING SIGN DETAIL
Not to Scale

ORIGINAL PLAN	SURVEY PLOTTED BY	DATE
NOTE BOOK	DESIGNED BY	
No.	CHECKED BY	

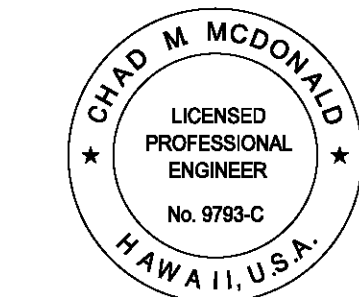

This work was prepared
by me or under my supervision

Chad M. McDonald
MITSUNAGA & ASSOCIATES, INC. EXP. DATE 4/30/2022

NOTE: Contractor to check and verify
dimensions at job before proceeding with work.

9/09/20	△ New Sheet added
DATE	REVISION
STATE OF HAWAII DEPARTMENT OF TRANSPORTATION HIGHWAYS DIVISION EVC TRAFFIC COUNTING SYSTEM REPLACEMENT WARNING SIGN DETAILS <i>Kamehameha Hwy, Kahananui Rd and Wilikina Dr</i> <i>Rehabilitation Weed Circle to Interstate Route H-2</i> <i>Project No. NH-099-1(031)</i> Scale: As Noted Date: August 2020	
SHEET No. --- OF 125 SHEETS	