




FED. ROAD DIST. NO.	STATE	FED. AID PROJ. NO.	FISCAL YEAR	SHEET NO.	TOTAL SHEETS
HAWAII	HAW	NH-099-1(031)	2020	ADD.8	125

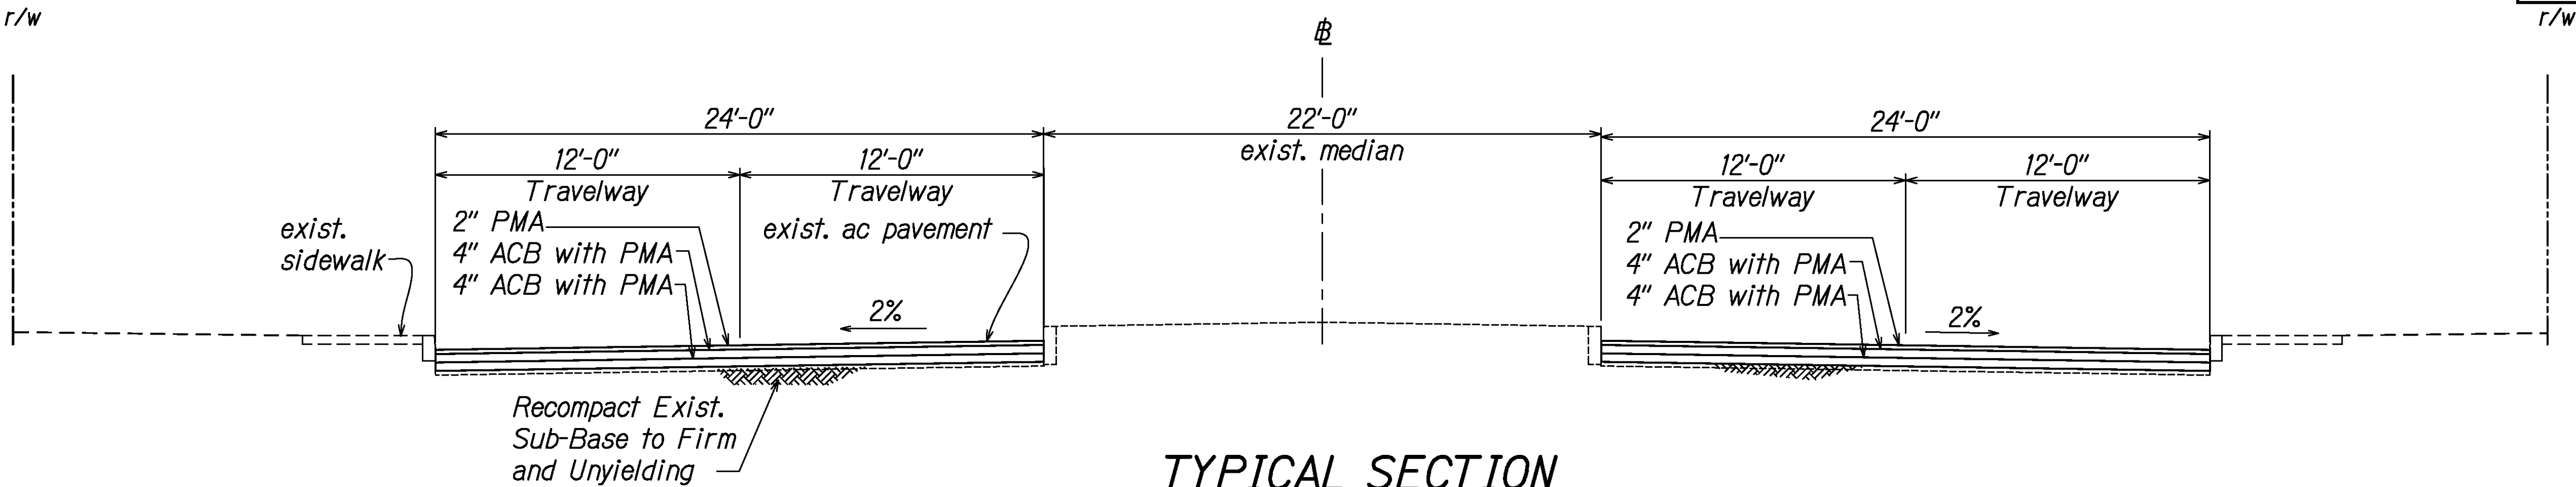

TYPICAL SECTION
WILIKINA DRIVE Sta 16+88 TO 7+40

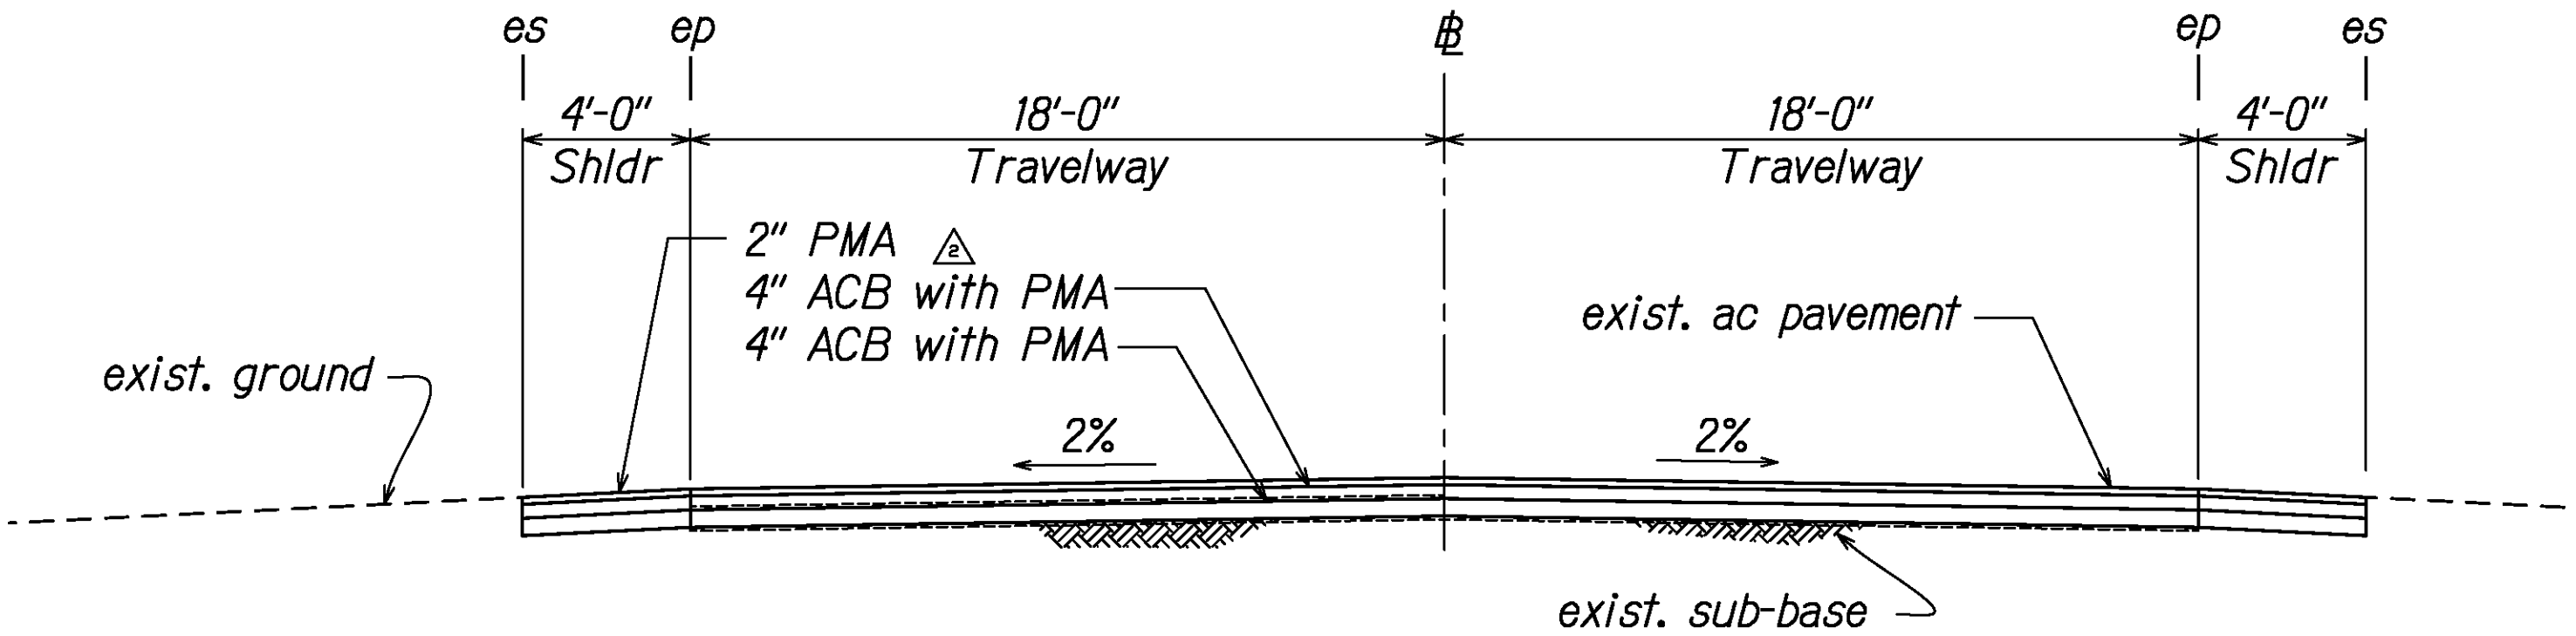

TYPICAL SECTION
WILIKINA DRIVE Sta 7+40 TO 31+20

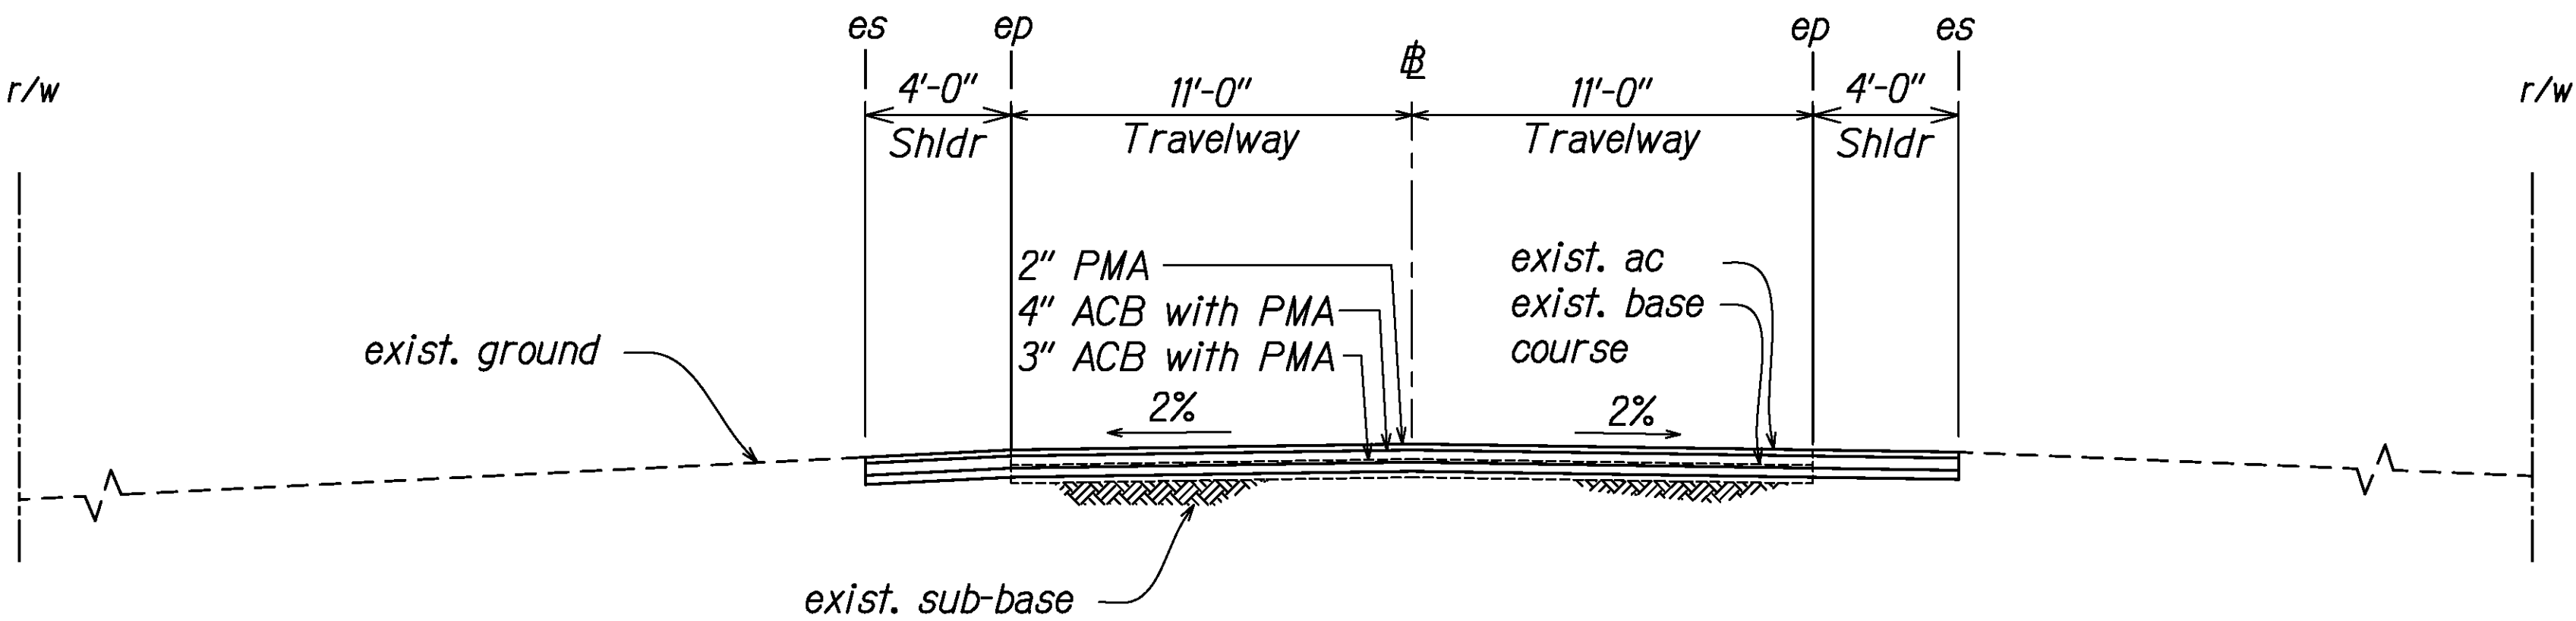

TYPICAL SECTION
KAMANANUI ROAD Sta 31+20 to 83+59

9/17/20 Updated pavement callout
DATE


STATE OF HAWAII
DEPARTMENT OF TRANSPORTATION
HIGHWAYS DIVISION

TYPICAL SECTIONS

Kamehameha Hwy, Kamananui Rd and Wilikina Dr
Rehabilitation Weed Circle to Interstate Route H-2
Project No. NH-099-1(031)

Scale: As Noted Date: August 2020

SHEET No. **C06** OF **125** SHEETS

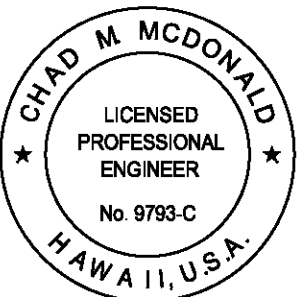

This work was prepared
by me or under my supervision

Chad M. McDonald
MITSUNAGA & ASSOCIATES, INC. EXP. DATE 4/30/2022

NOTE: Contractor to check and verify
dimensions at job before proceeding with work.

SURVEY PLOTTED BY	DATE
DESIGNED BY	
TRACED BY	
DESIGNED BY	
QUANTITIES BY	
CHECKED BY	
NO.	