

**STATE OF HAWAII  
DEPARTMENT OF TRANSPORTATION  
HIGHWAYS DIVISION**

**ADDENDUM NO. 3  
for  
KAMEHAMEHA HIGHWAY, KAMANANUI ROAD AND WILIKINA DRIVE  
REHABILITATION  
VICINITY OF WEED CIRCLE TO H-2**

**FEDERAL-AID PROJECT NO. NH-099-1(031)**

The following amendments shall be made to the Bid Documents:

**A. PLANS**

Replace Plan Sheet No. 8 with the attached Plan Sheet No. ADD.8.

**B. CONTRACTOR RFI's**

Attached are responses to Contractor RFI's for your information.

Please acknowledge receipt of this Addendum No. 3 by recording the date of its receipt in the space provided on page P-4 of the Proposal.



---

JADE T. BUTAY  
Director of Transportation

ADDENDUM NO. 3  
9/17/20

## **Contractor RFI's:**

1. Item 301.0100 Hot Mix Asphalt Base Course (66,400 tons) – actual theoretical quantity is approximately 29,400 tons.

### **Quantity revised in Addendum No. 2.**


2. Item 301.0200 Hot Mix Asphalt Base Course with PMA (28,500 tons) – actual theoretical quantity is approximately 64,300 tons, it seems the ACB and ACB w/ PMA quantities were reversed, there should be more ACB/ w/ PMA quantity since majority of locations call for ACB w/ PMA.

### **Quantity revised in Addendum No. 2.**


3. Item 414.0100 Excavation of Weakened Pavement Areas (45,100 CY) – actual theoretical quantity is approximately 60,600 CY, this quantity was calculated excavating from top of existing AC pavement to subgrade (e.g. “cold plane 10” means excavating 10” from top of existing AC pavement to subgrade) (this is also assuming new finish grades will match existing roadway grades).

### **Quantity revised in Addendum No. 2.**

4. See below, Typical Section Sta 7+40 to 31+20 shows ACB without PMA, yet plan sheet C-14 shows same location calling for ACB with PMA, please clarify.

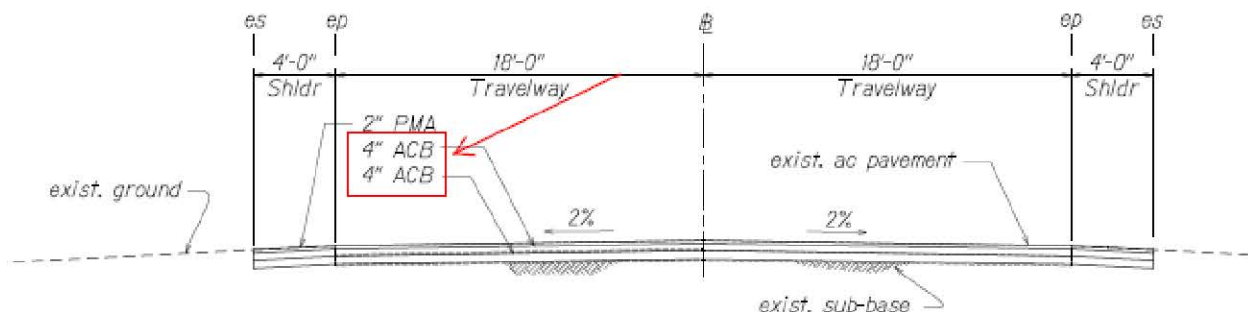

**TYPICAL SECTION**  
**WILIKINA DRIVE Sta 7+40 TO 31+20**

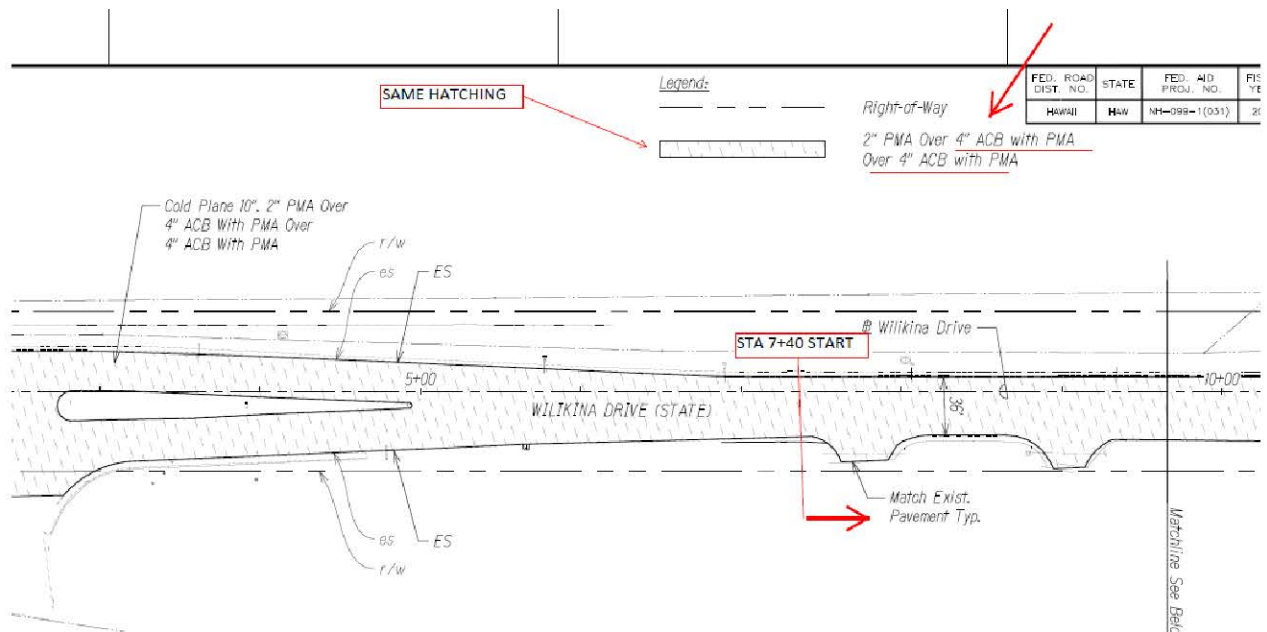

**Typical Section will be revised.**

- Is Hawaii Product Preference a part of this project? If so, there's no form enclosed with bid proposal and the spec section does not mention "shall not apply". See section 102-7a.

**Hawaii Product Preference does not apply. See special provisions section 102.15.**