


FED. ROAD DIST. NO.	STATE	FED. AID PROJ. NO.	FISCAL YEAR	SHEET NO.	TOTAL SHEETS
HAWAII	HAW	NH-099-1(031)	2020	83	125

STRIPING AND PAVEMENT MARKING SCHEDULE																							
	STATION	TRAFFIC REGIME		4" Double Yellow Hot Spray Thermoplastic	THERMOPLASTIC EXTRUSION (Lin. Ft.)															PAVEMENT MARKERS (EACH)			
		LEFT	RIGHT		4" Double Yellow	4" Yellow Stripe	4" Yellow C	12" Yellow Diagonal	6" White E.P. Stripe	4" White Stripe	8" White Stripe	12" White Diagonal	4" White Guide Lines	12" Stop Bar	Yield Line	SOLID WHITE ARROW			Pavement Words	Crosswalk Marking	C	D	H
																Left	Straight	Right					
WILIKINA DRIVE	16+88																						
	27+00	N	N		2984	14469		287	14610	3925	1361	323	6500	411		8	5	2	22	31	820	201	348
KAMANANUI ROAD	27+00	N	N		999	532		104	1756	188		184	187			4		5	3		79	36	6
	35+44	P	P			1163			7474												188	94	
	72+82	N	N		1189				3764			228		74	1						107	58	
	88+57																						
KAMEHAMEHA HIGHWAY	77+33	N	N		11699	2252		1631	17702	3197	888	222	1553	408		36	27	25	20	58	925	631	41
	15+50	N	N	4070	1614			312	10872	336	84	67	574	134		3	4	4	8	5	308	291	
	69+86	P	P			838			5344												134	66	
	96+58																						
CONTRACT ITEM NUMBER				629.1021	629.1020	629.1010	629.1010	629.1016	629.1012	629.1010	629.1013	629.1016	629.1010	629.1016	629.1060	629.1040	629.1040	629.1040	629.1050	629.1030	629.2011	629.2012	629.2013

ORIGINAL PLAN	SURVEY PLOTTED BY	DATE
	DESIGNED BY	
	DESIGNED BY	
	QUANTITIES BY	
NOTE BOOK	CHECKED BY	
No.		

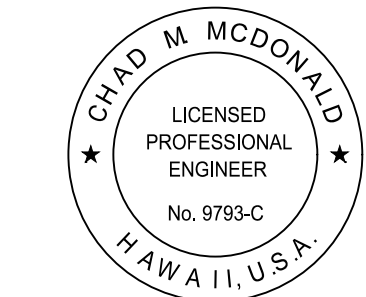

This work was prepared
by me or under my supervision

Chad M. McDonald
MITSUNAGA & ASSOCIATES, INC. 4/30/2022 EXP. DATE

NOTE: Contractor to check and verify
dimensions at job before proceeding with work.

STATE OF HAWAII
DEPARTMENT OF TRANSPORTATION
HIGHWAYS DIVISION

**STRIPING AND PAVEMENT
MARKING SCHEDULE**

Kamehameha Hwy, Kamananui Rd and Wilikina Dr
Rehabilitation Weed Circle to Interstate Route H-2
Project No. NH-099-1(031)


Scale: As Noted Date: August 2020

SHEET No. **C81** OF **125** SHEETS

FED. ROAD DIST. NO.	STATE	FED. AID PROJ. NO.	FISCAL YEAR	SHEET NO.	TOTAL SHEETS
HAWAII	HAW	NH-099-1(031)	2020	84	125

STRIPING AND PAVEMENT MARKING SCHEDULE - KAMEHAMEHA HIGHWAY																					
STATION	TRAFFIC REGIME			HOT SPRAY THERMOPLASTIC (Lin. Ft.)														PAVEMENT MARKERS (EACH)			
	LEFT	RIGHT	4" Double Yellow Hot Spray Thermoplastic	4" Double Yellow	4" Yellow Stripe	4" Yellow C	12" Yellow Diagonal	6" White E.P. Stripe	4" White Stripe	8" White Stripe	12" White Diagonal	4" White Guide Lines	12" Stop Bar	Pavement Lettering	SOLID WHITE ARROW			Crosswalk Marking	C	D	H
															Left	Straight	Right				
96+58																					
126+28	N	N	371	5023			1329	5940	999	129		721	55		5	10	5	6	271	150	
132+58	P	P				208		1260											32	11	
141+60	P	N				902		1804											45	45	
149+20	N	N	765					1520											38	38	
154+57	N	P				537		1074											27	27	
189+34	P	P				1001		6954											174	50	
194+86	P	N				566		1132											28	28	
196+97	N	N	211					446											12	11	
203+90	N	P				667		1334											34	34	
229+72/ 101+60	P	P				845		5164											130	42	
	P	P				182		2216											56	9	
112+68	N	N	717					1446											36	64	
119+91	P	P				221		1470											37	11	
127+09	N	N	2106					4202											105	103	
148+10	P	P				1122		6854											172	56	
182+37	P	N				747		1562											40	38	
190+18	N	N	1335					2578											65	63	
203+07	P	P				1378		7810											196	69	
242+12	N	N	659	1012		153	270	2430		147		244	24		6	5			61	93	
254+27																					
CONTRACT ITEM NUMBER			629.1021	629.1020	629.1010	629.1010	629.1016	629.1010	629.1010	629.1013	629.1016	629.1010	629.1016	629.1050	629.1040	629.1040	629.1040	629.1030	629.2011	629.2012	629.2013

ORIGINAL PLAN	SURVEY PLOTTED BY	DATE
	DESIGNED BY	
	TRACED BY	
	NOTED BY	
NOTE BOOK No.	DESIGNED BY	
	QUANTITIES BY	
	CHECKED BY	

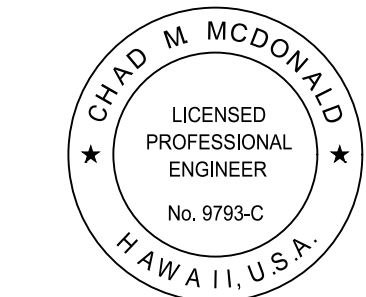

This work was prepared
by me or under my supervision

Chad M. McDonald
MITSUNAGA & ASSOCIATES, INC. 4/30/2022 EXP. DATE

NOTE: Contractor to check and verify
dimensions at job before proceeding with work.

STATE OF HAWAII
DEPARTMENT OF TRANSPORTATION
HIGHWAYS DIVISION

**STRIPING AND PAVEMENT
MARKING SCHEDULE**

Kamehameha Hwy, Kamananui Rd and Wilikina Dr
Rehabilitation Weed Circle to Interstate Route H-2
Project No. NH-099-1(031)

Scale: As Noted Date: August 2020