



PLAN	SURVEYED	BY	DATE
NOTE BOOK	PLOTTED		
NO.	RT. OF WAY CHECKED		

PROFILE	SURVEYED	BY	DATE
NOTE BOOK	GRADES CHECKED		
NO.	STRUCTURE NOTTING CHKD.		

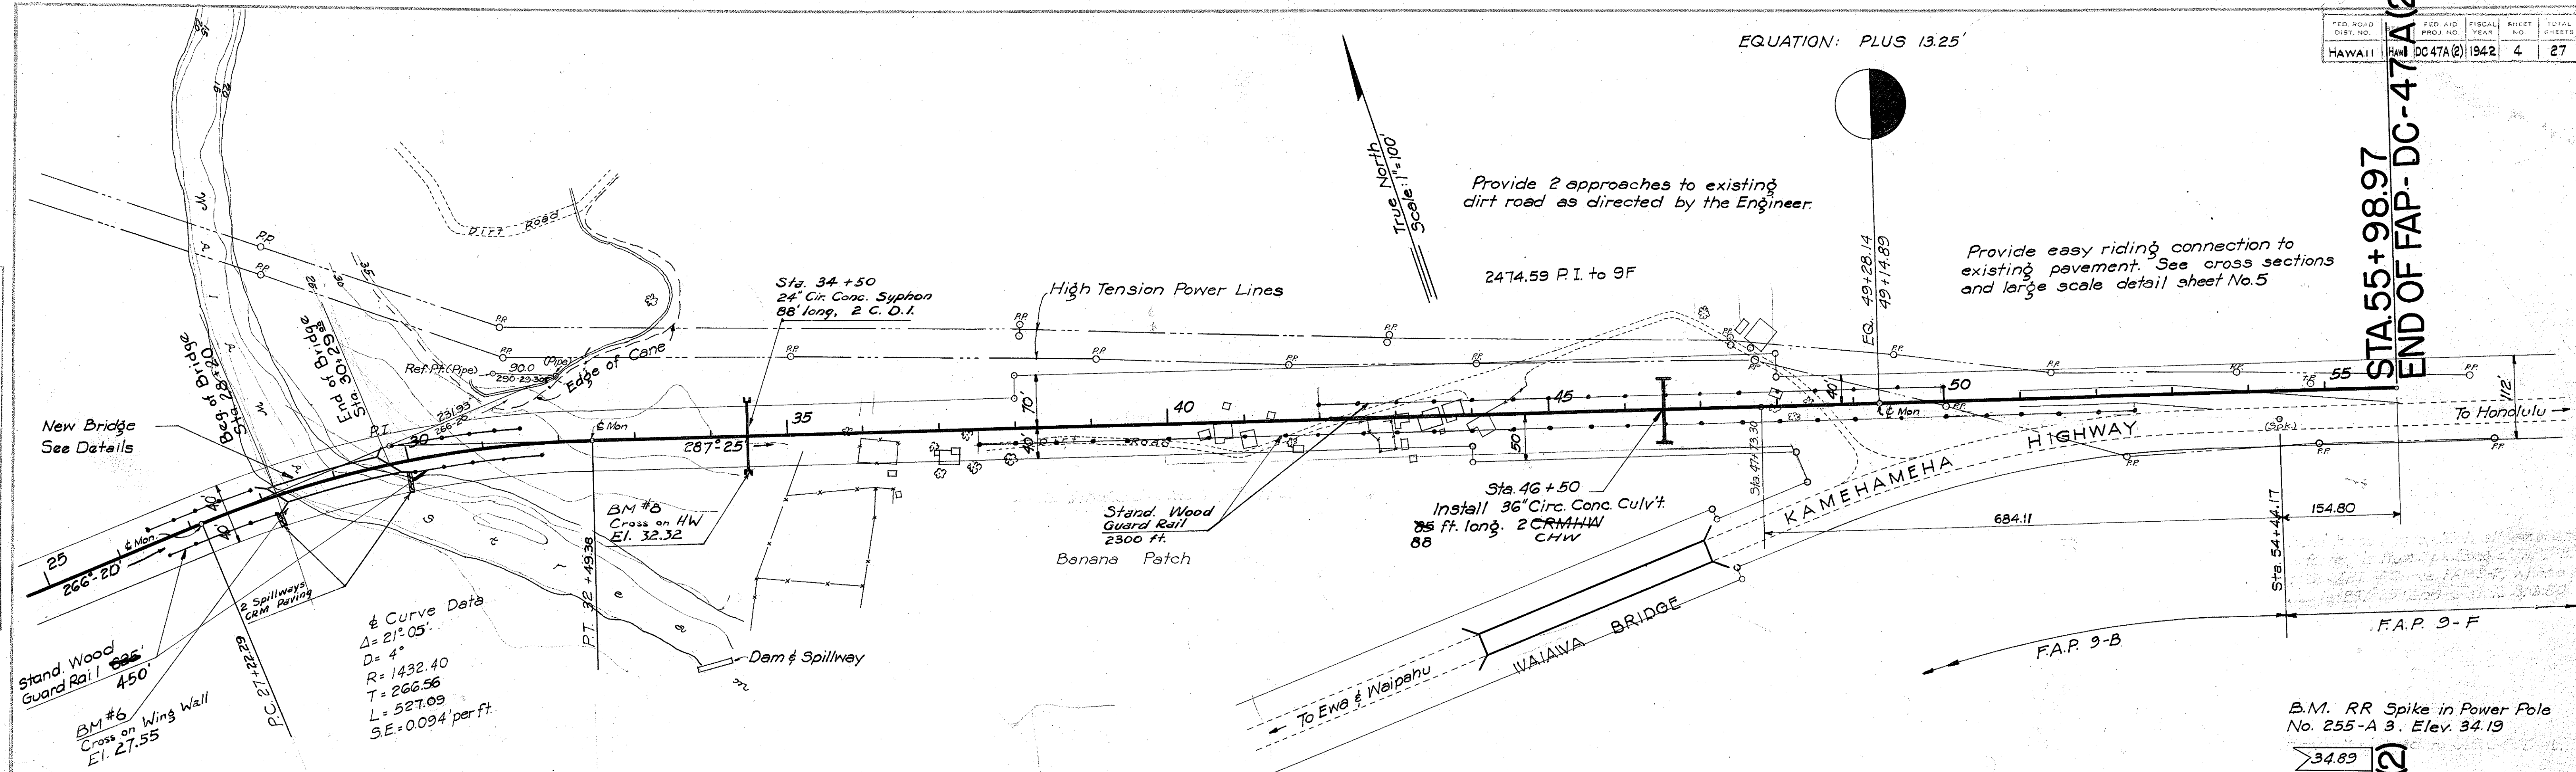

STA. 55+98.97
END OF FAP-DC-47-A(2)

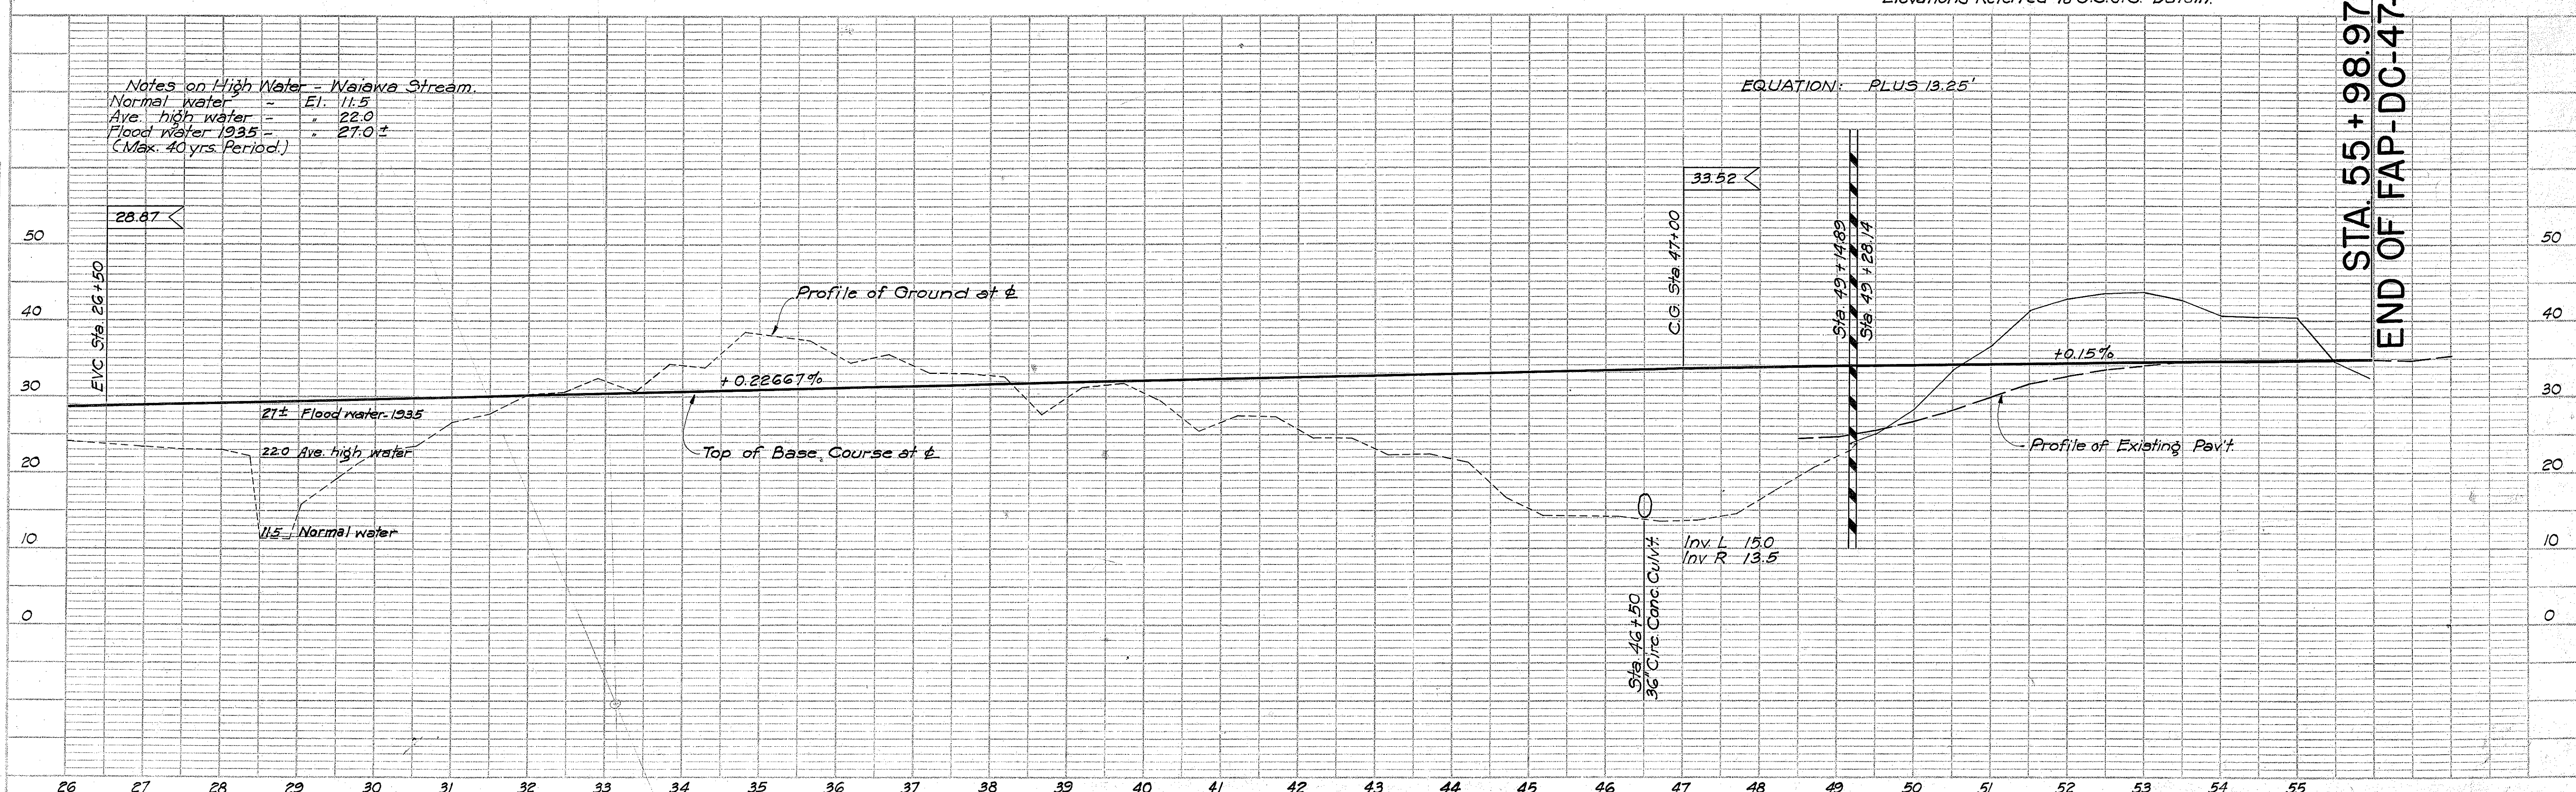

STA. 55+98.97
END OF FAP-DC-47-A(2)

SURVEY PLANNED BY: _____ DATE: _____
 ORIGINAL PLAN DESIGNED BY: _____
 DRAWN BY: _____
 CHECKED BY: _____
 NOTE BOOK NO. _____
 QUANTITIES CHECKED BY: _____
 No. _____

