

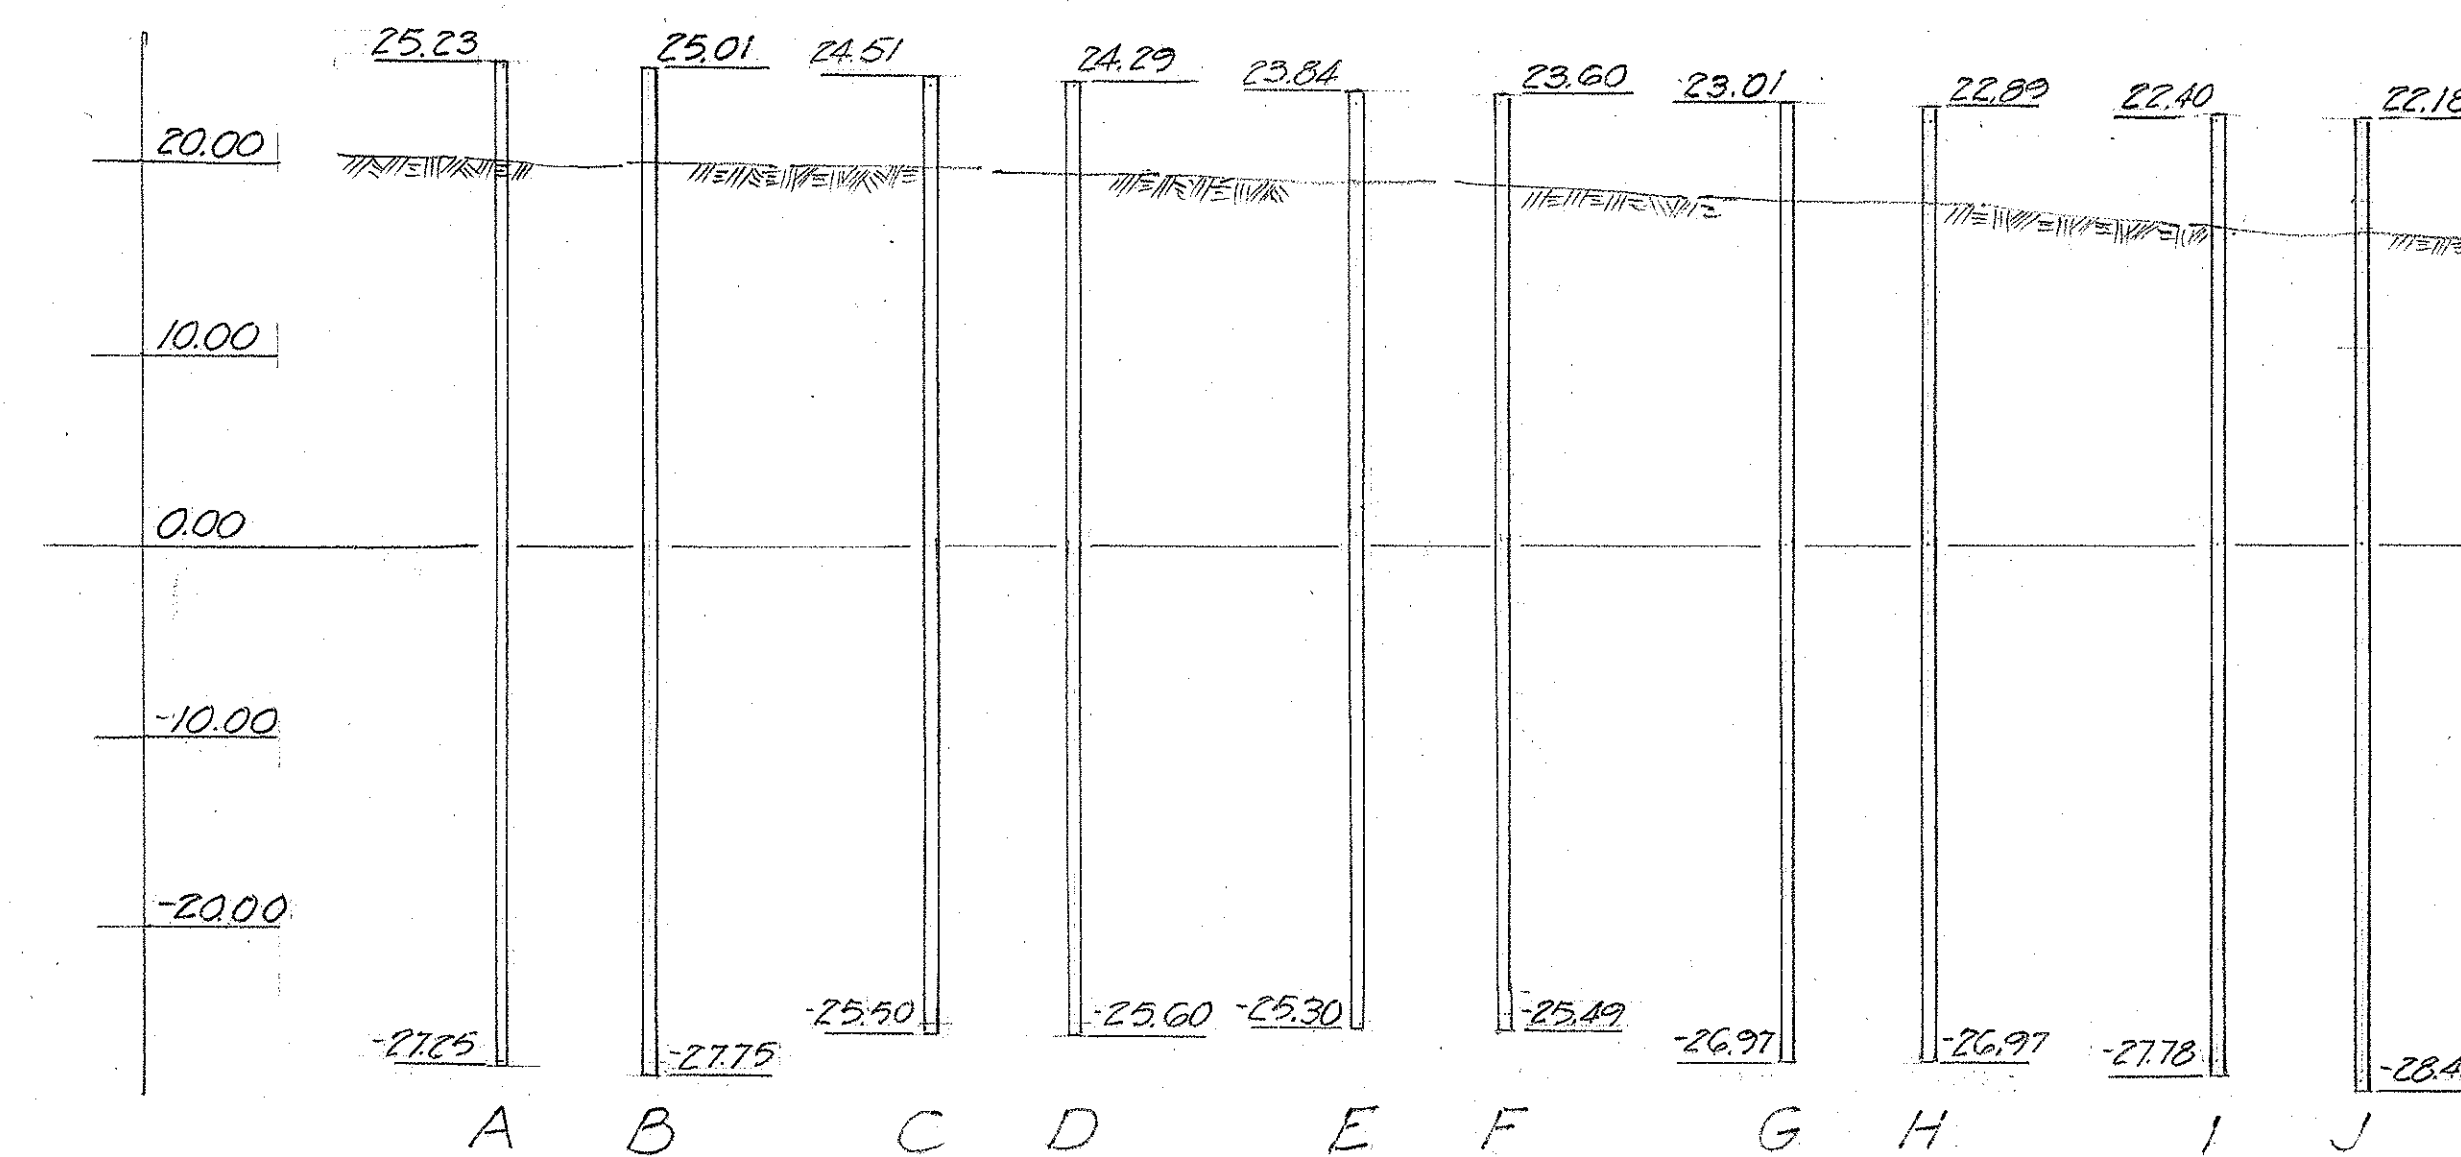



FED. ROAD DIST. NO.	STATE	FED. AID PROJ. NO.	FISCAL YEAR	SHEET NO.	TOTAL SHEETS
HAWAII	HAWAII	F47(3)	1950	1	1

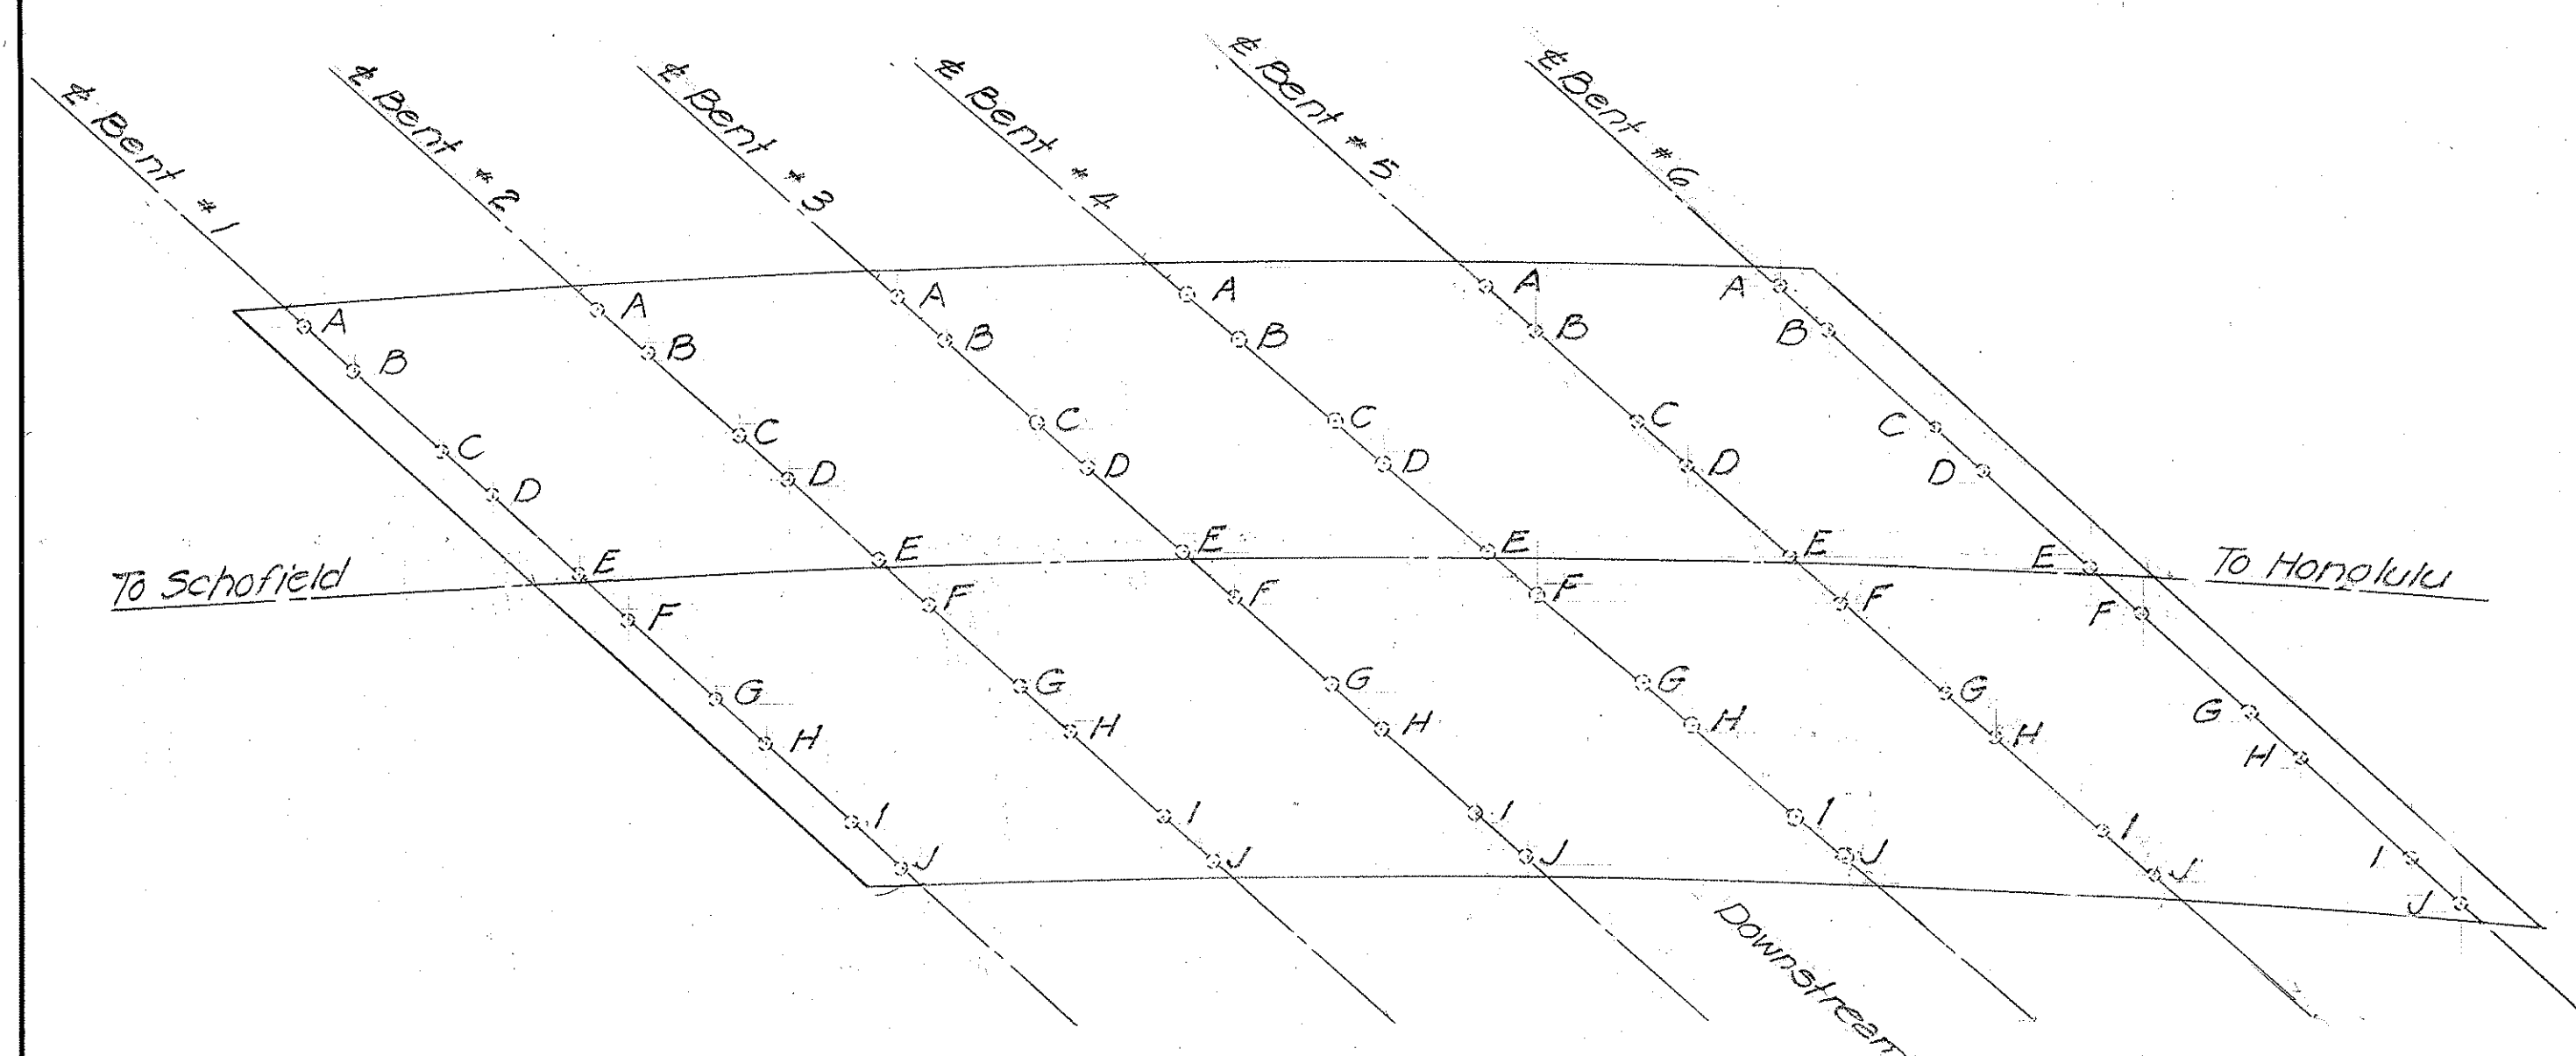


ELEVATION - BENT No 4

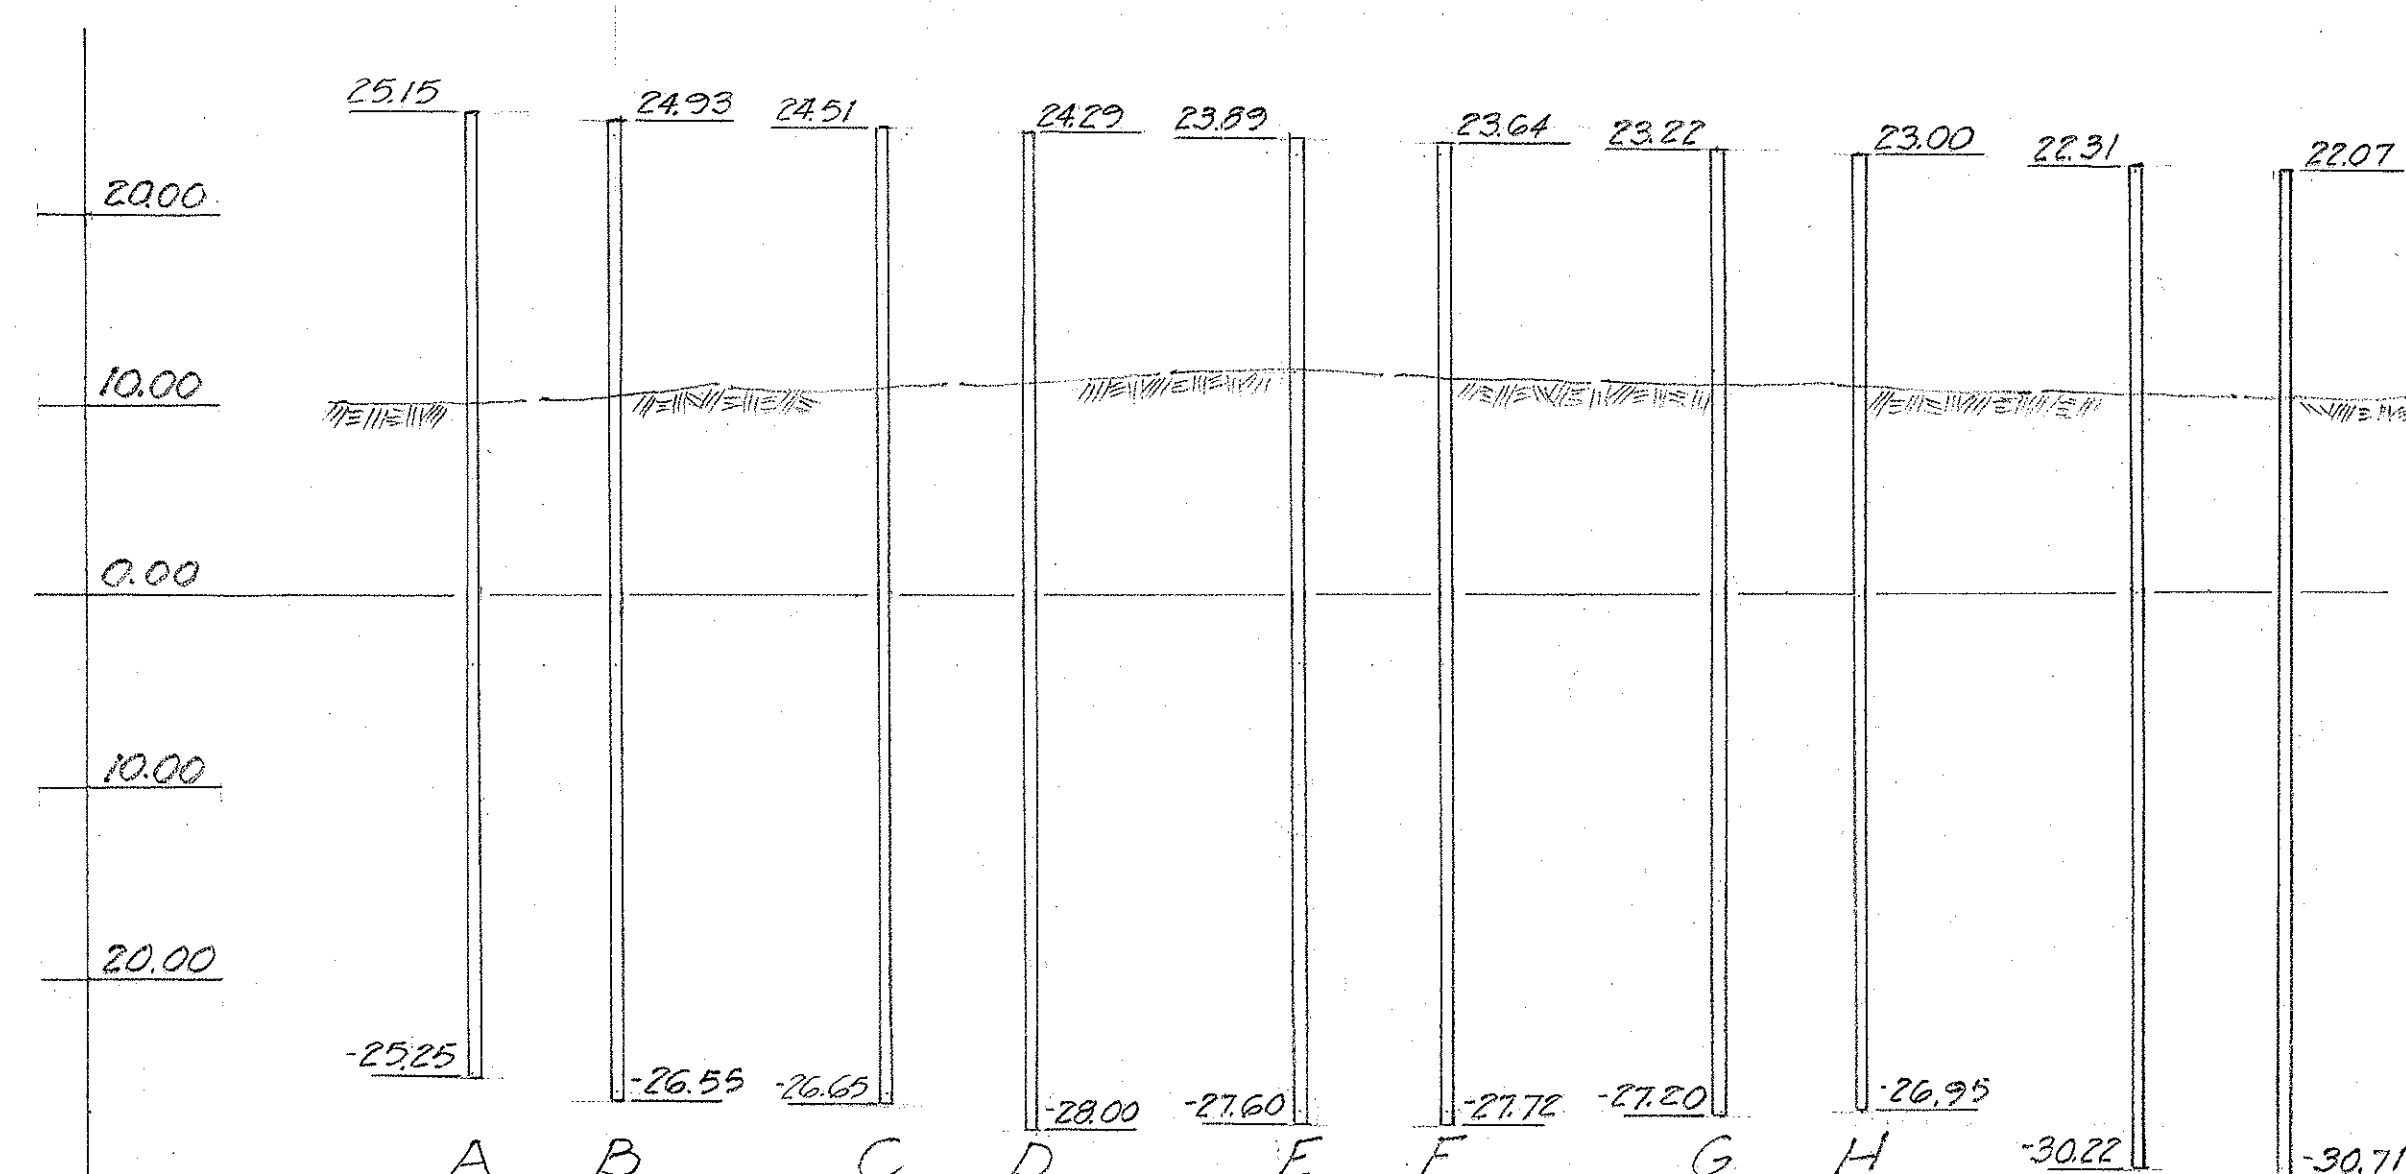


ELEVATION - BENT No 3

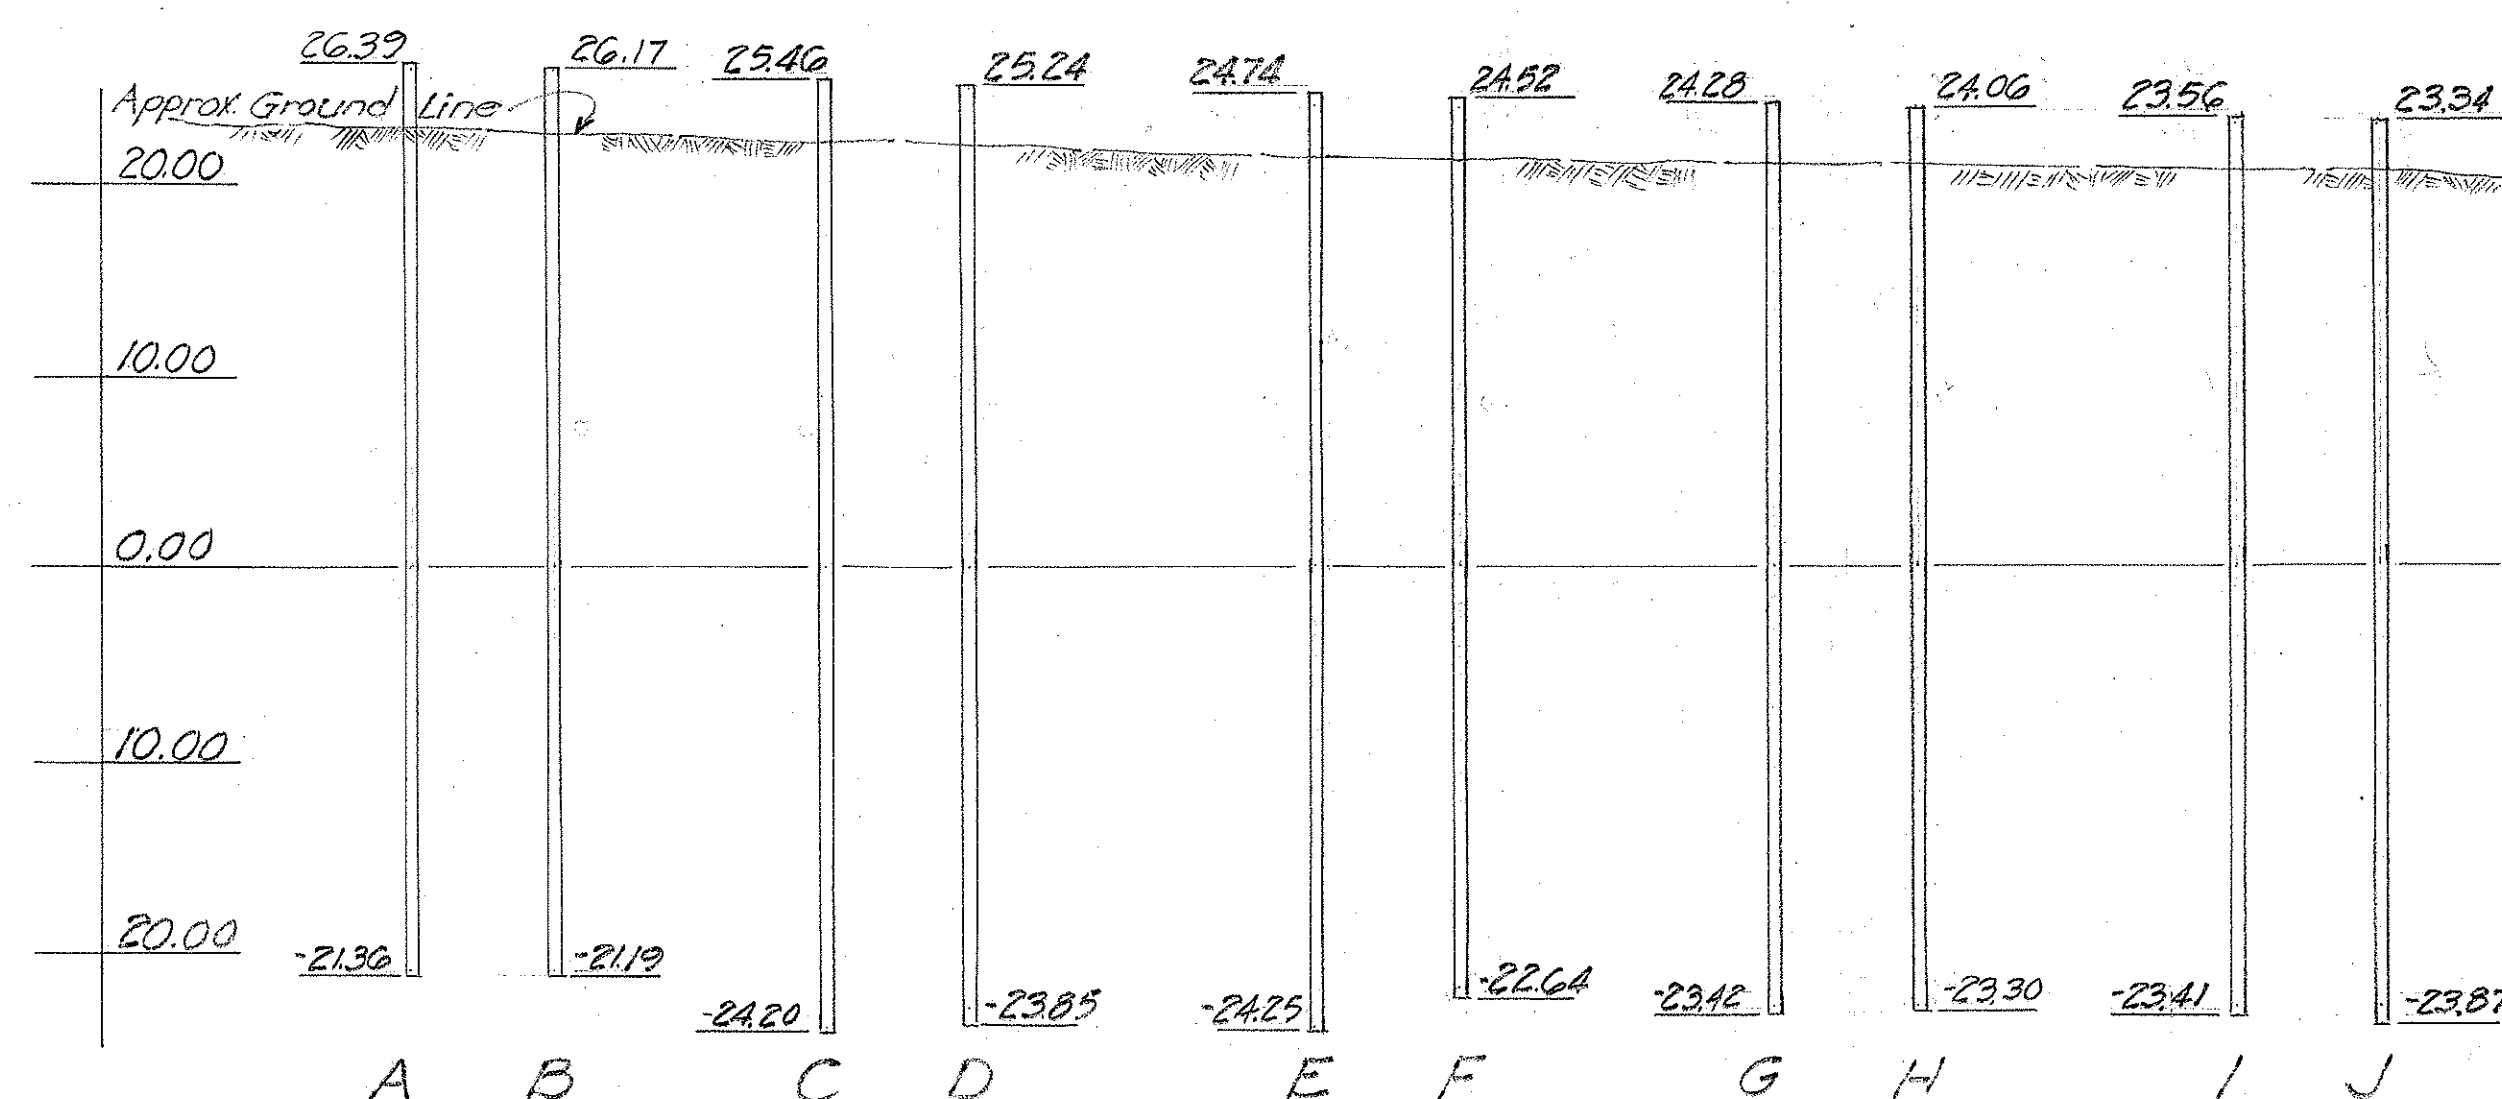

ELEVATION - BENT No 6

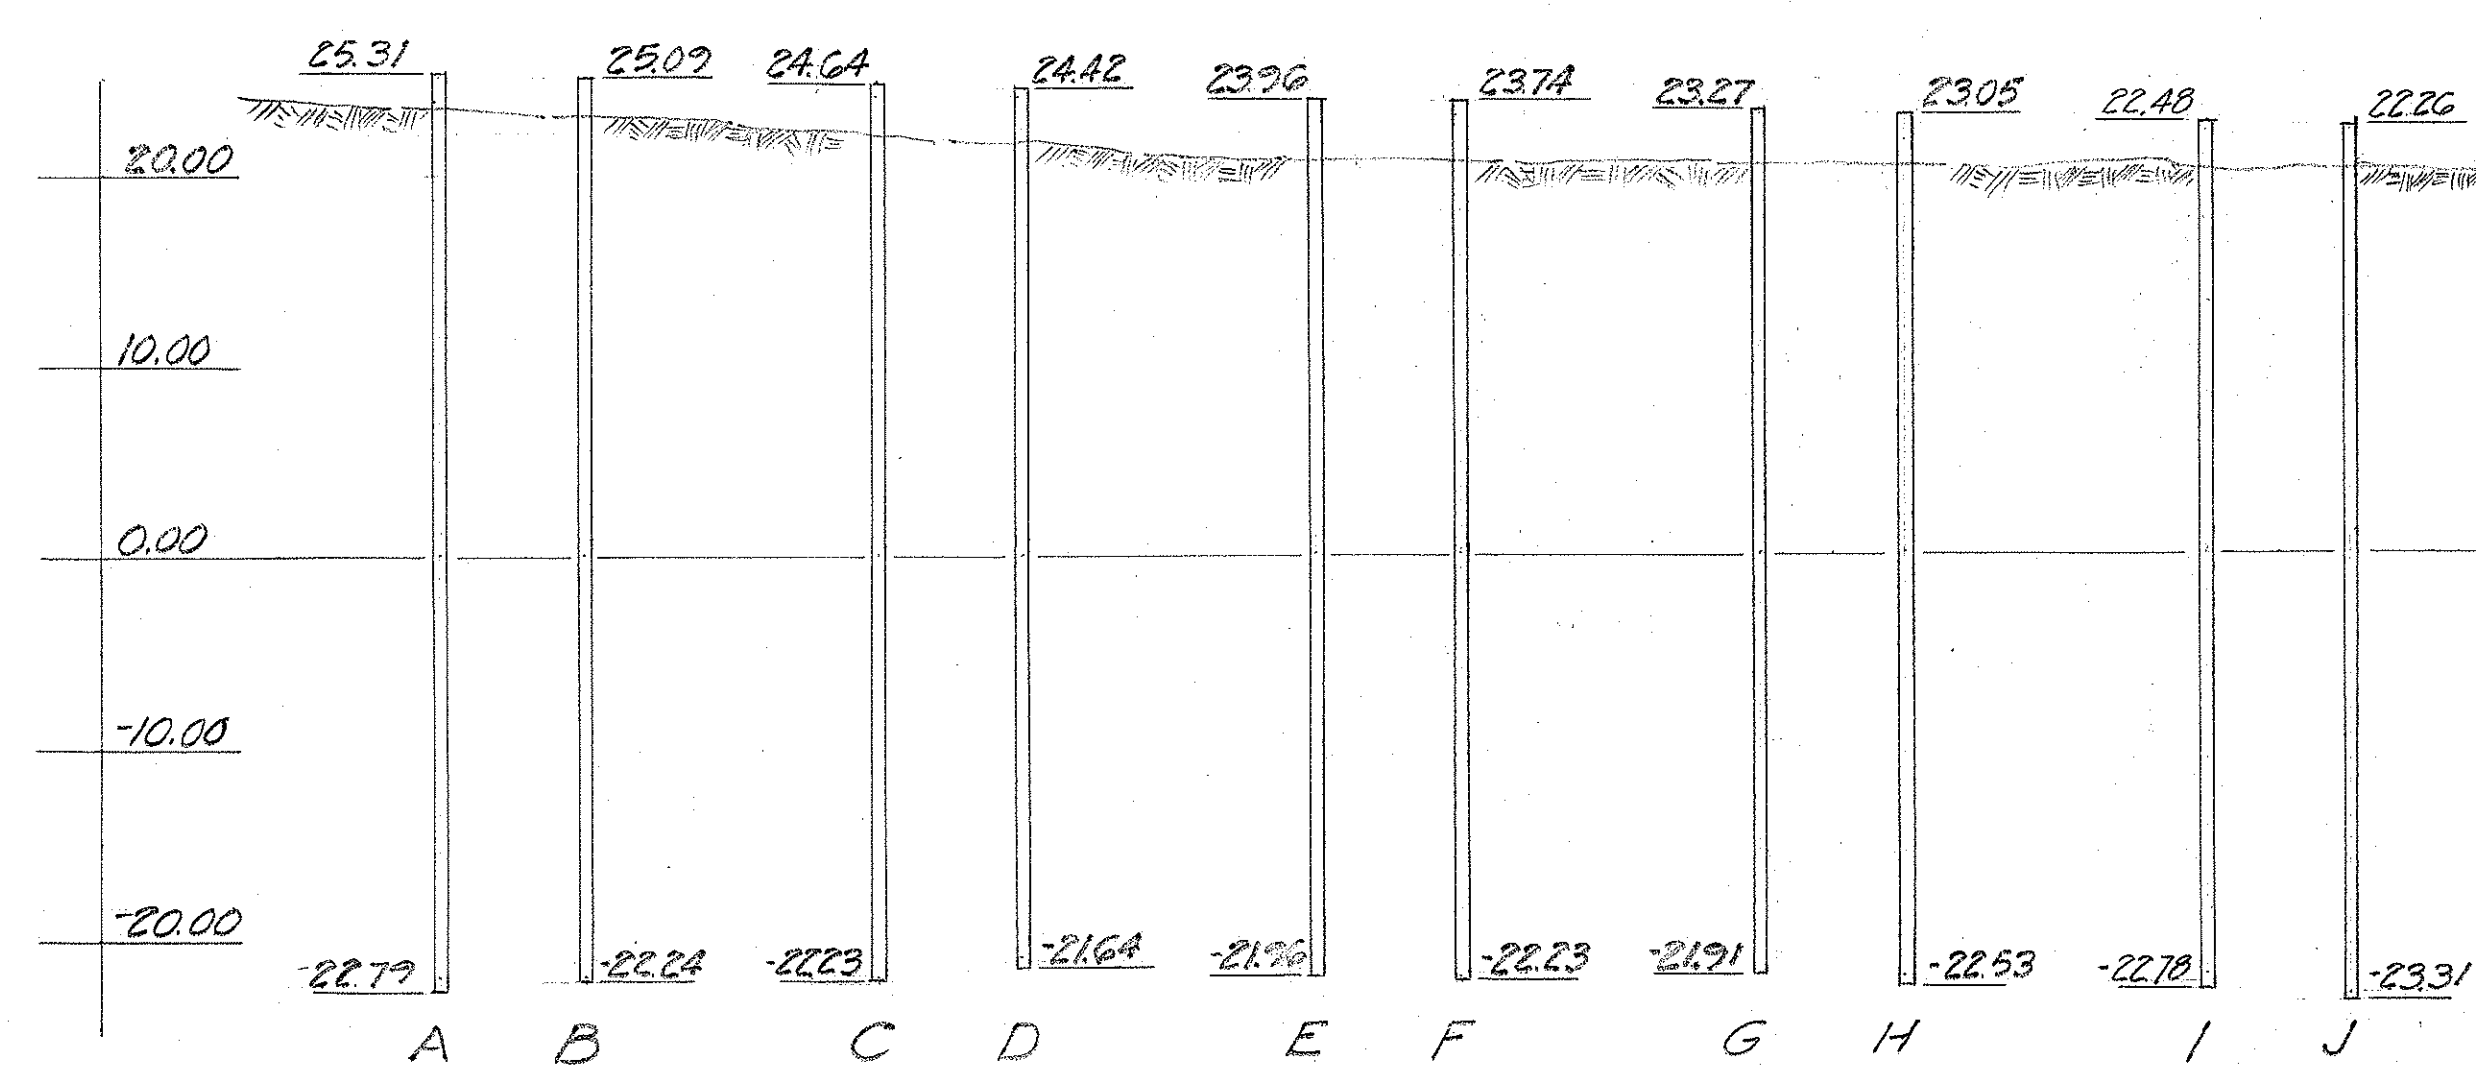

ELEVATION - BENT No 5

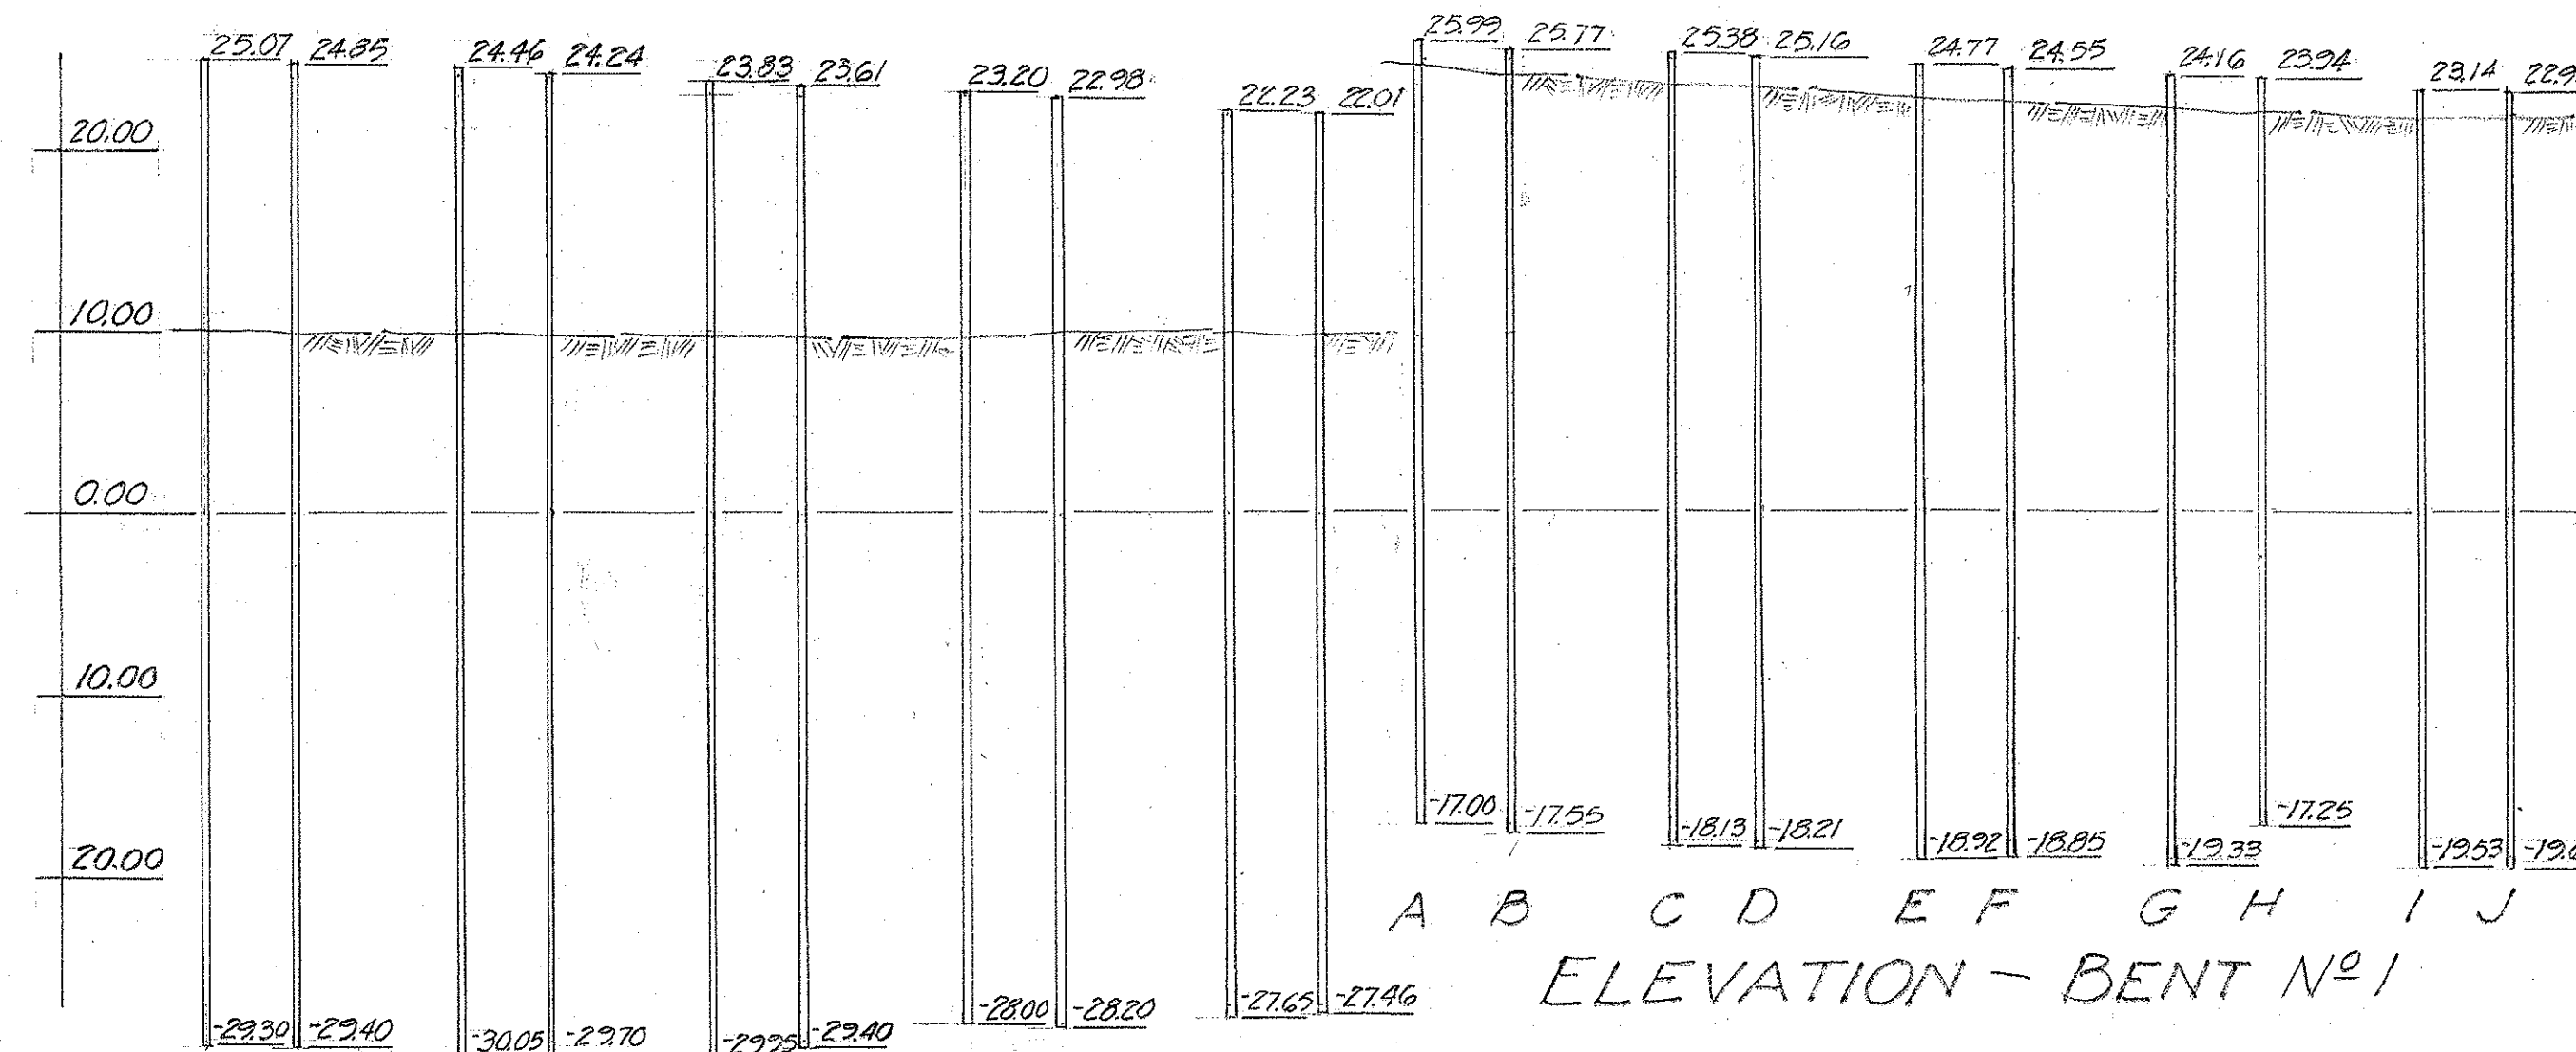

ELEVATION - BENT No 2

PILE TIP ELEVATION
AS DRIVEN
1" = 10'-0"

TERRITORIAL HIGHWAY DEPARTMENT
TERRITORY OF HAWAII
WAIKAWA CUTOFF BRIDGE
Sta 28+18.70 to Sta 30+18.27
WAIKAWA CUTOFF F47(3)
Feb. 1950

ORIGINAL
DESIGNED BY
PLAN
DESIGNED BY
QUANTITIES BY
NOTE BOOK
CHECKED BY
No.