

INDEX TO DRAWINGS	
SHEET NO.	DESCRIPTION
1	Title Sheet
2	Plan & Profile and Typical Roadway Section
3-9	Bridge Details
10	Std Bridge Details

CONVENTIONAL SIGNS	
Centerline.....	125
Boundary Lines.....	or
Fences (Named).....	
Existing Roadways.....	
Circular Culvert.....	
Box Culvert.....	
Bridge.....	
Telephone Pole.....	T.P.
Electric Power Pole.....	E.P.
Water Main.....	W ₂ W ₂ (W ₄ , 8, 12, Etc.)
Storm Drain.....	SD ₁₂ SD ₁₂ (SD ₁₈ , 24, Etc.)
Concrete Drop Intake.....	C.D.I.
Standard Catch Basin.....	S.C.B.
Standard Manhole.....	M.M.S.
Sewer Manhole.....	S.S. S.S. (S.S.)
Telephone Manhole.....	T.M.H.
Fire Hydrant.....	F.H.
Tree (Large, named).....	Mango Coco
Railroad.....	

TERRITORY OF HAWAII

TERRITORIAL HIGHWAY DEPARTMENT

HONOLULU, OAHU, T. H.

PLANS OF

KAMEHAMEHA HIGHWAY

WAIAWA CUTOFF BRIDGE

FEDERAL AID PROJECT NO F 47 (3)

WAIAWA SECTION

WAIPAHU DISTRICT


ISLAND OF OAHU

SCALE

PLAN 1 INCH = 100 FT.

PROFILE HOR 1 INCH = 100 "

VER 1 INCH = 10 "

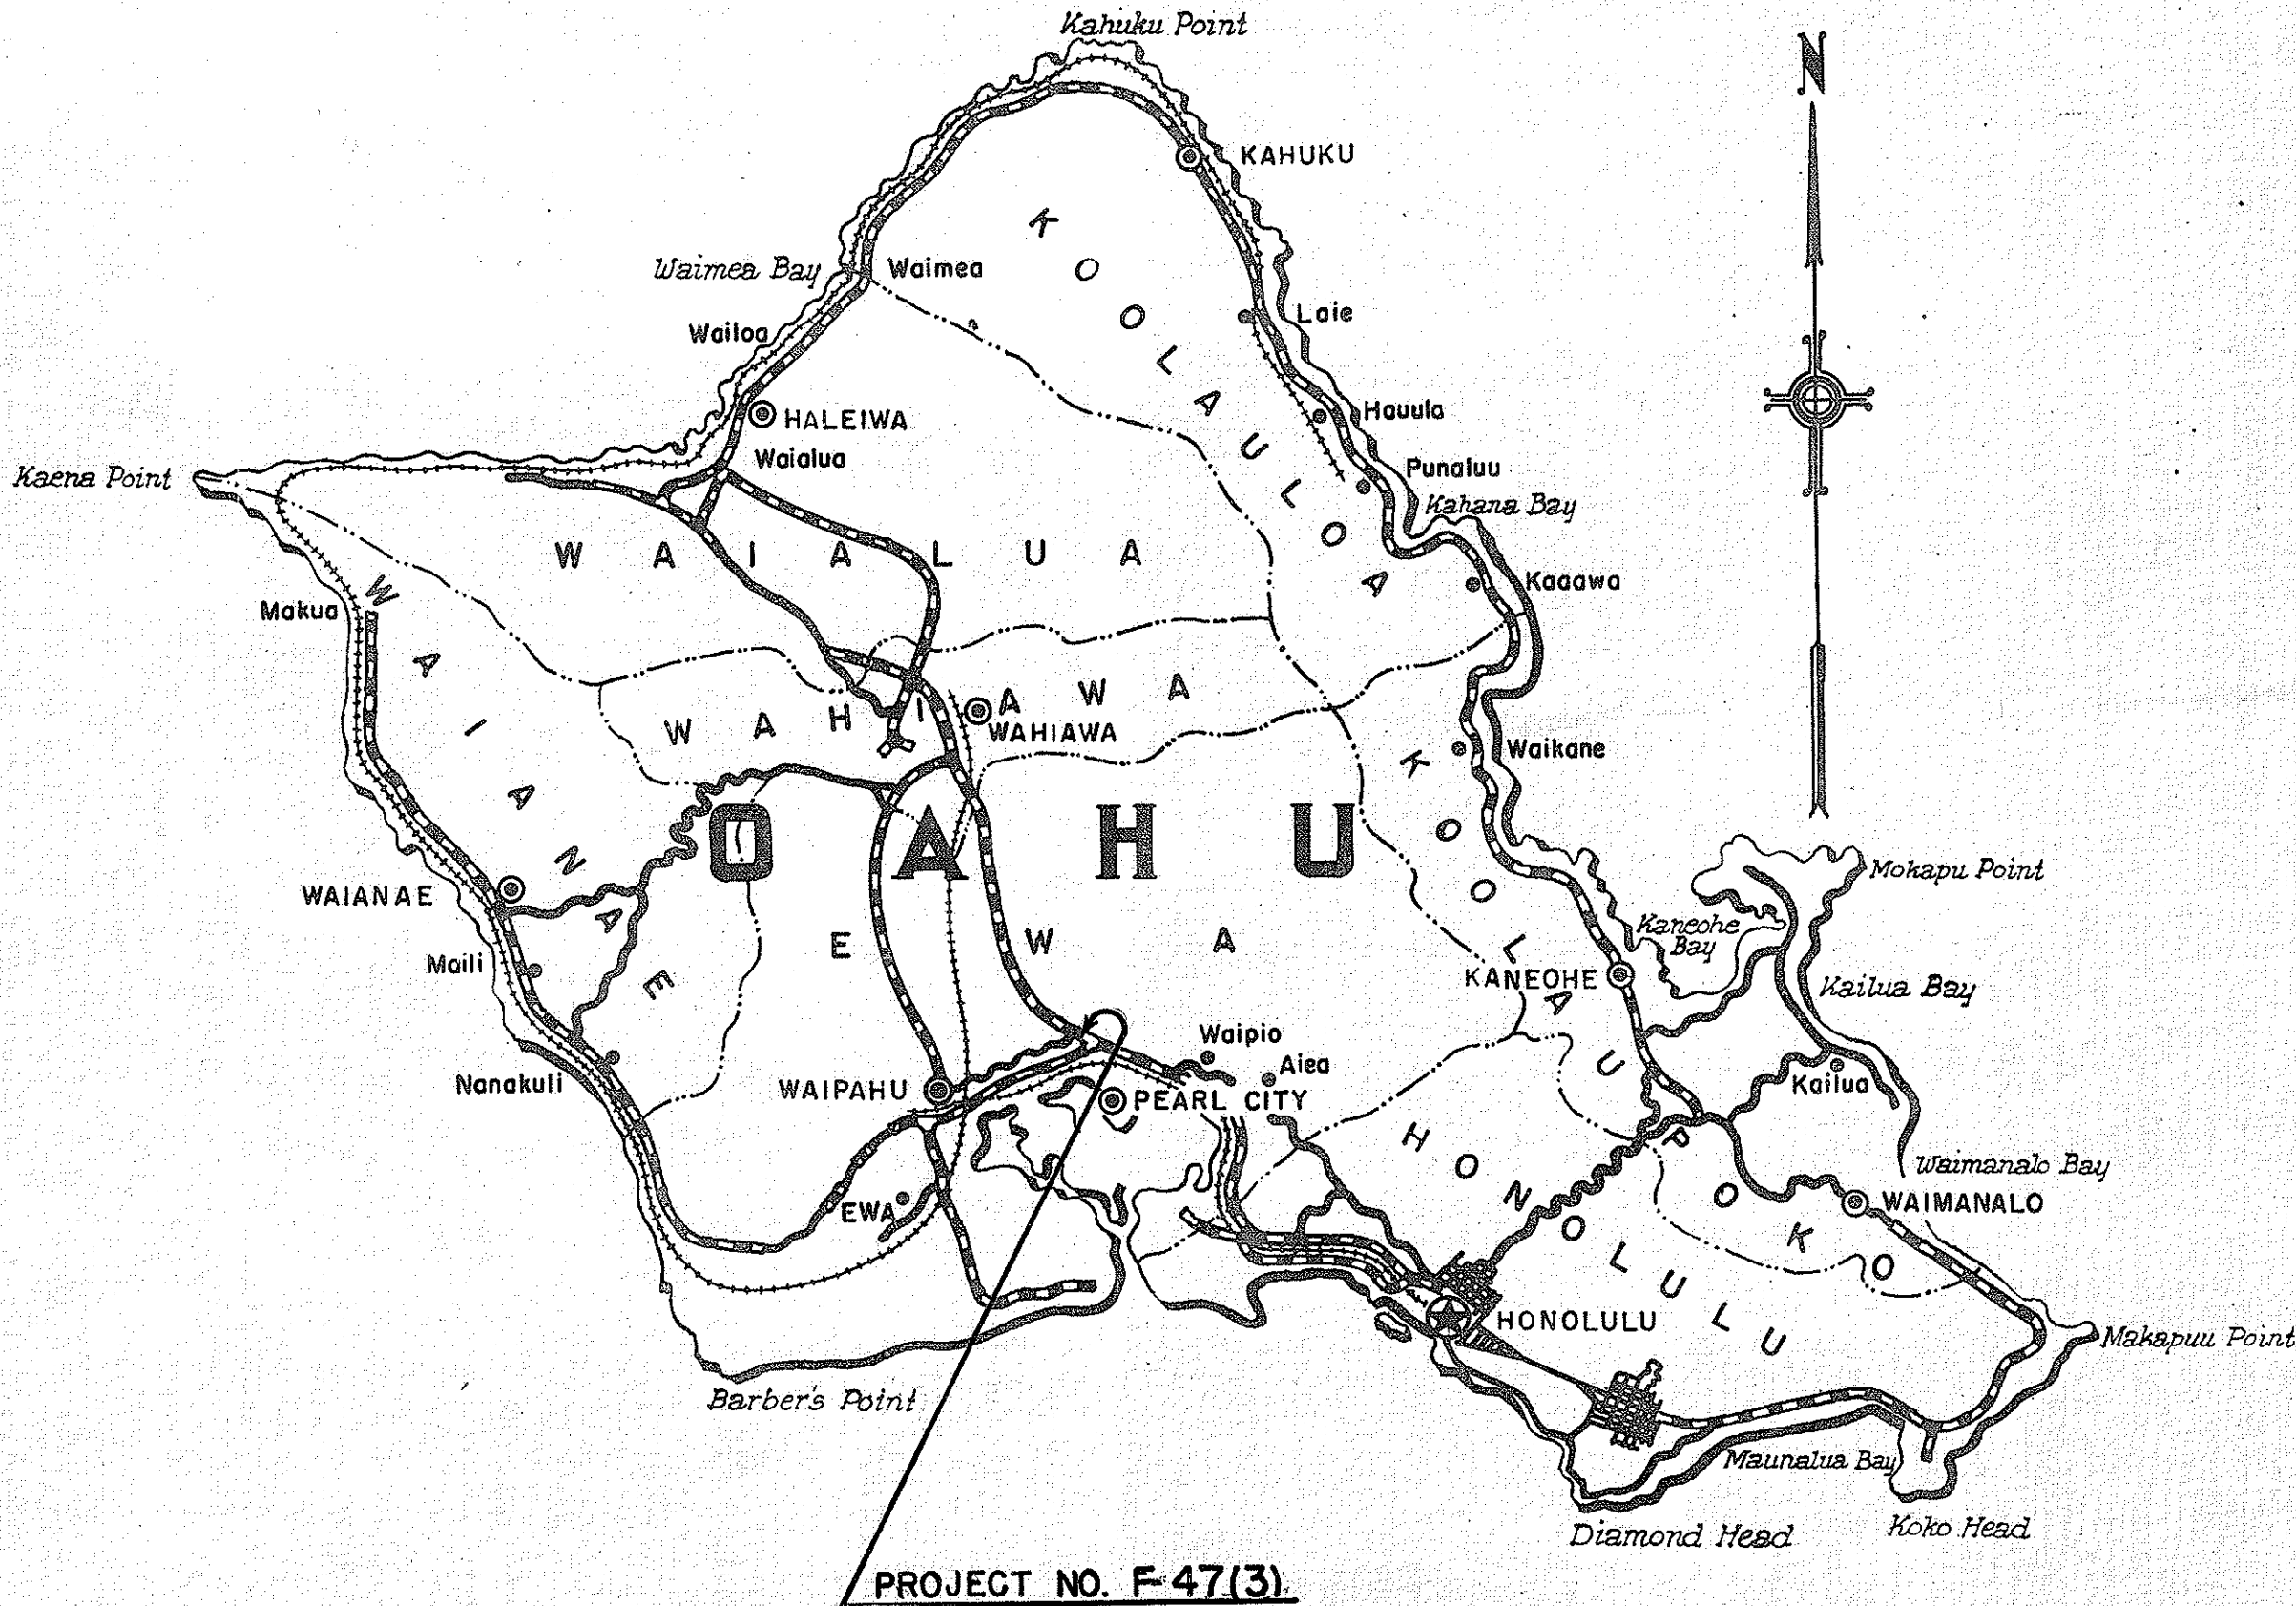


Federal Aid Projects Previously Constructed Or Under Construction

NOTE: All changes made during Construction Period have been noted in red on these tracing and checked by:

Resident Engineer
Date 5/16/50

DATE	
DESIGNED BY	
DRAWN BY	
CHECKED BY	
NOTE BOOK	

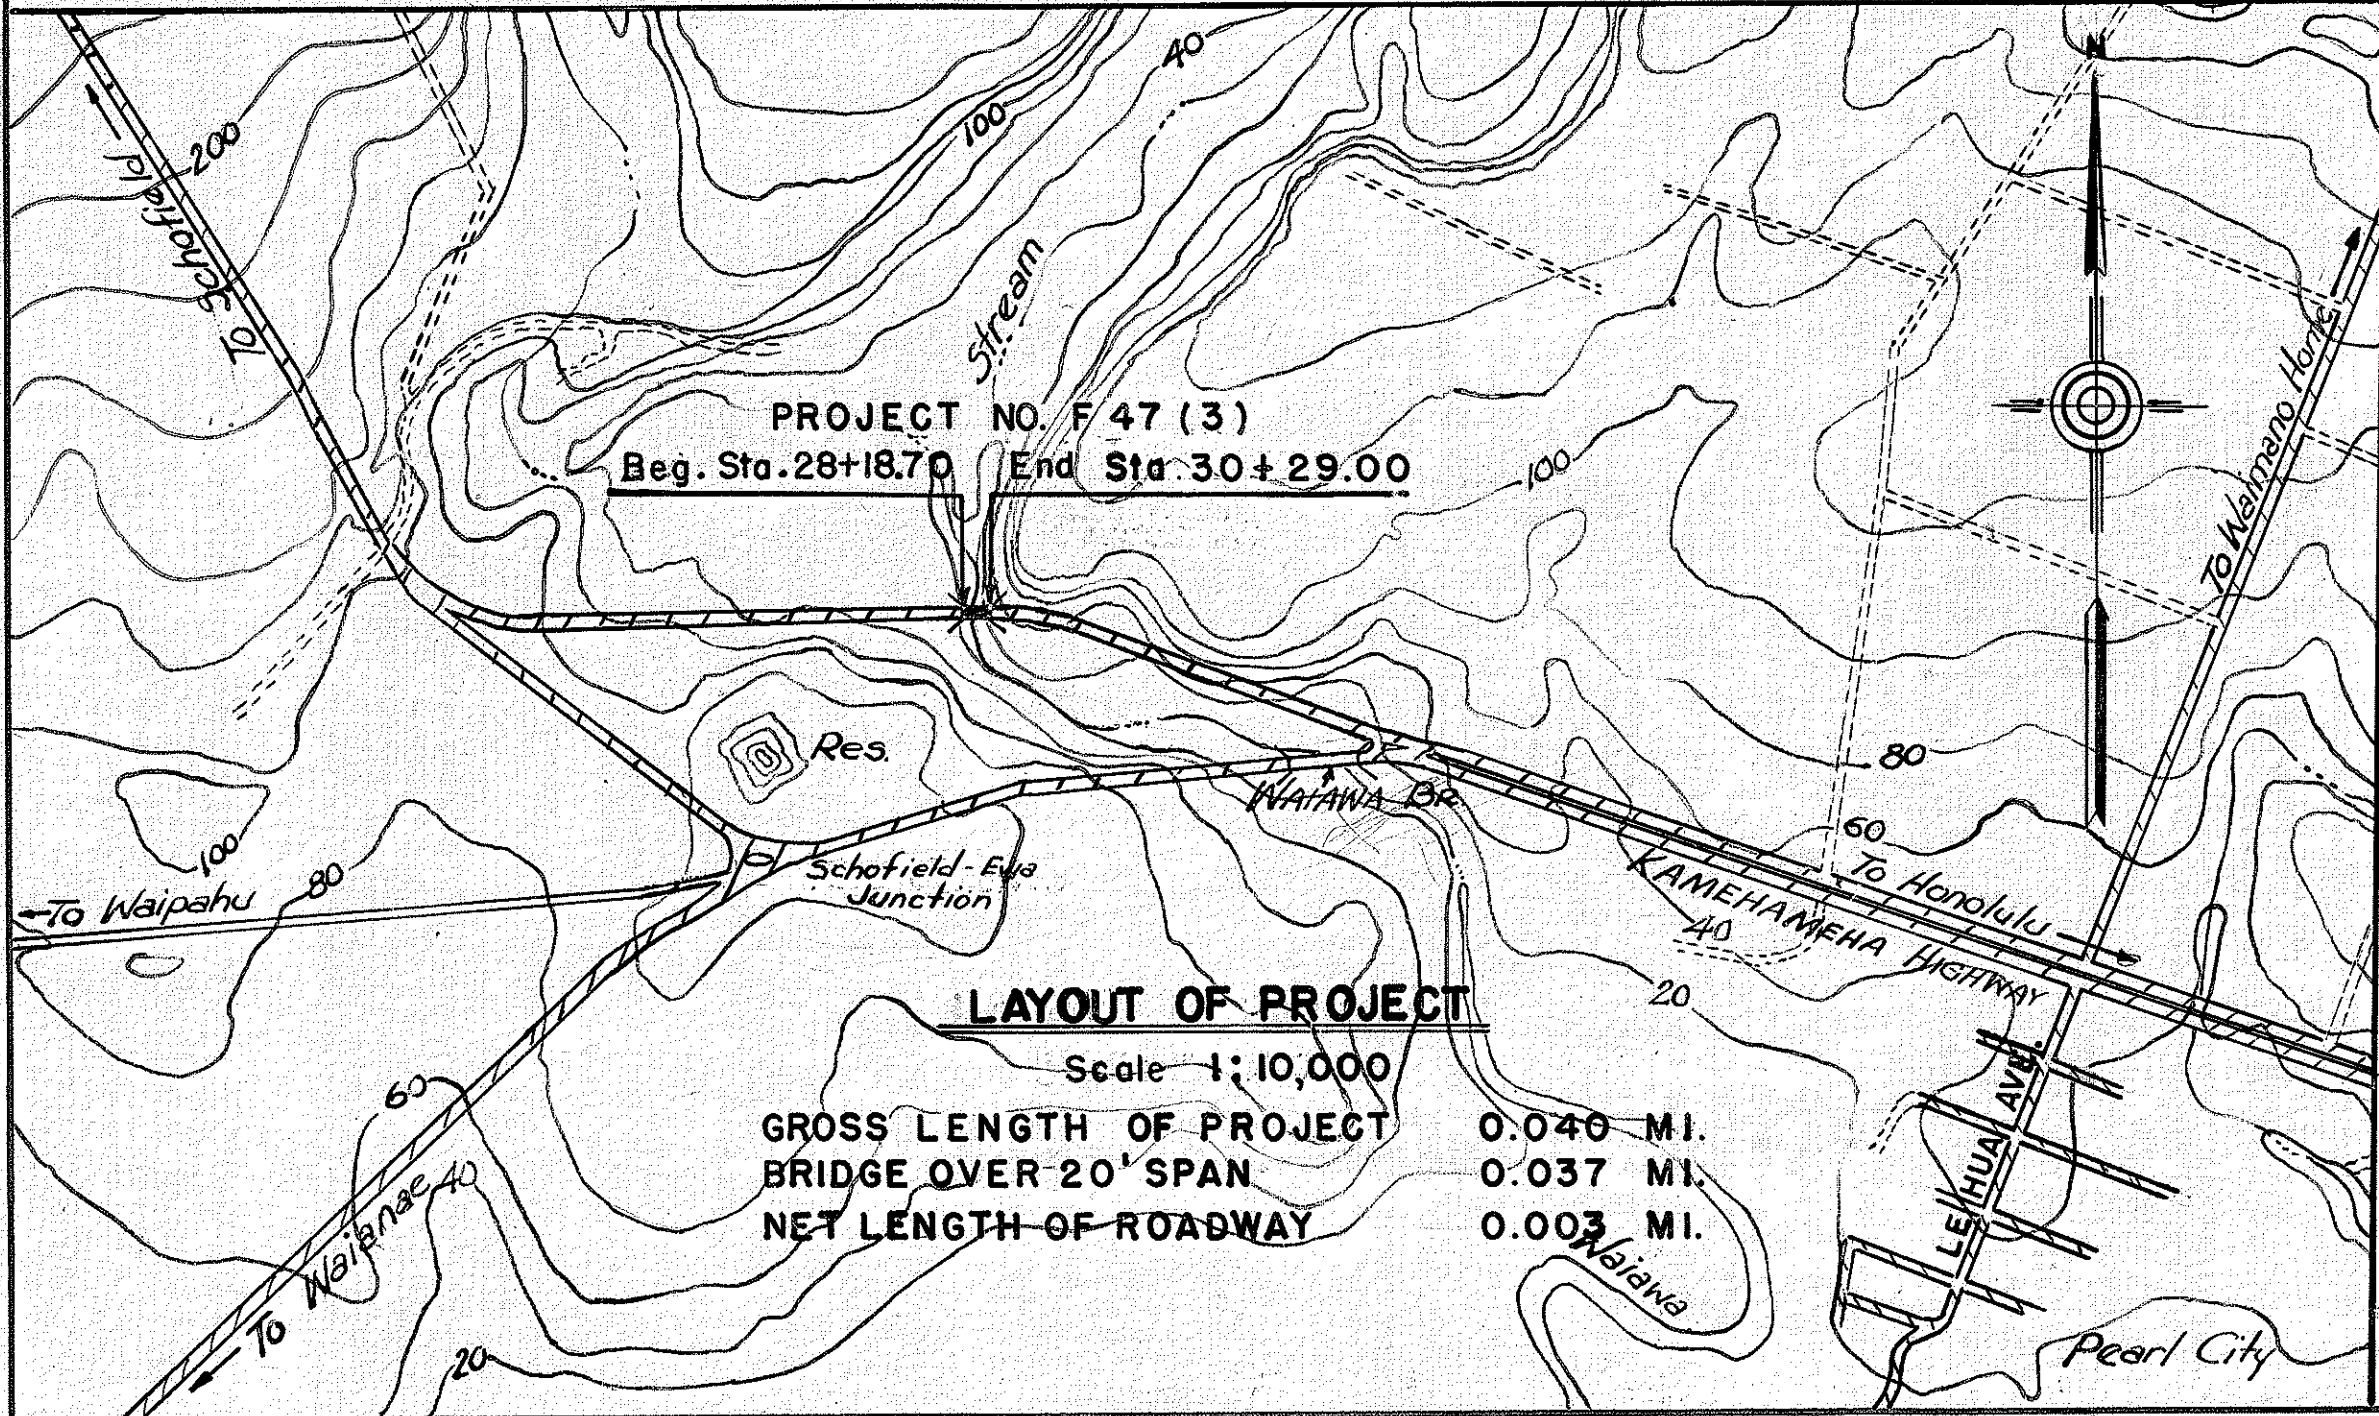

APPROVED DATE 8-10-49

Resident Engineer

TERRITORIAL HIGHWAY ENGINEER

RECOMMENDED FOR APPROVAL DATE

DISTRICT ENGINEER
PUBLIC ROADS ADMINISTRATION
FEDERAL WORKS AGENCY

APPROVED DATE

DIVISION ENGINEER
PUBLIC ROADS ADMINISTRATION
FEDERAL WORKS AGENCY