

INDEX TO DRAWINGS	
SHEET NO.	DESCRIPTION
1	Title sheet
2	Typical road sections
3-17	Plan and Profile
18-19	Standard detail
20-27	Culvert details
28-61	Cross Sections

TERRITORY OF HAWAII

TERRITORIAL HIGHWAY DEPARTMENT

HONOLULU T.H.

PLANS OF

KUNIA ROAD

NATIONAL RECOVERY HIGHWAY PROJECT NO. N.R.H 16-A

HAWAII F.A.P. NO. 16-A

DISTRICT OF WAHIAWA & EWA


ISLAND OF OAHU

CONVENTIONAL SIGNS

Present road	
Existing fence	
Boundary line(not fenced)	
Existing Stone fence	
Railroad	
Center Line	
Large tree	
Cement Rubble masonry Wall	
Box Culverts	
Pipe Culverts	


SCALE

PLAN	1 INCH = 100 FEET
PROFILE	HOR. 1 INCH = 100 FEET VER. 1 INCH = 20 FEET
CROSS SECTION	1 INCH = 10 FEET

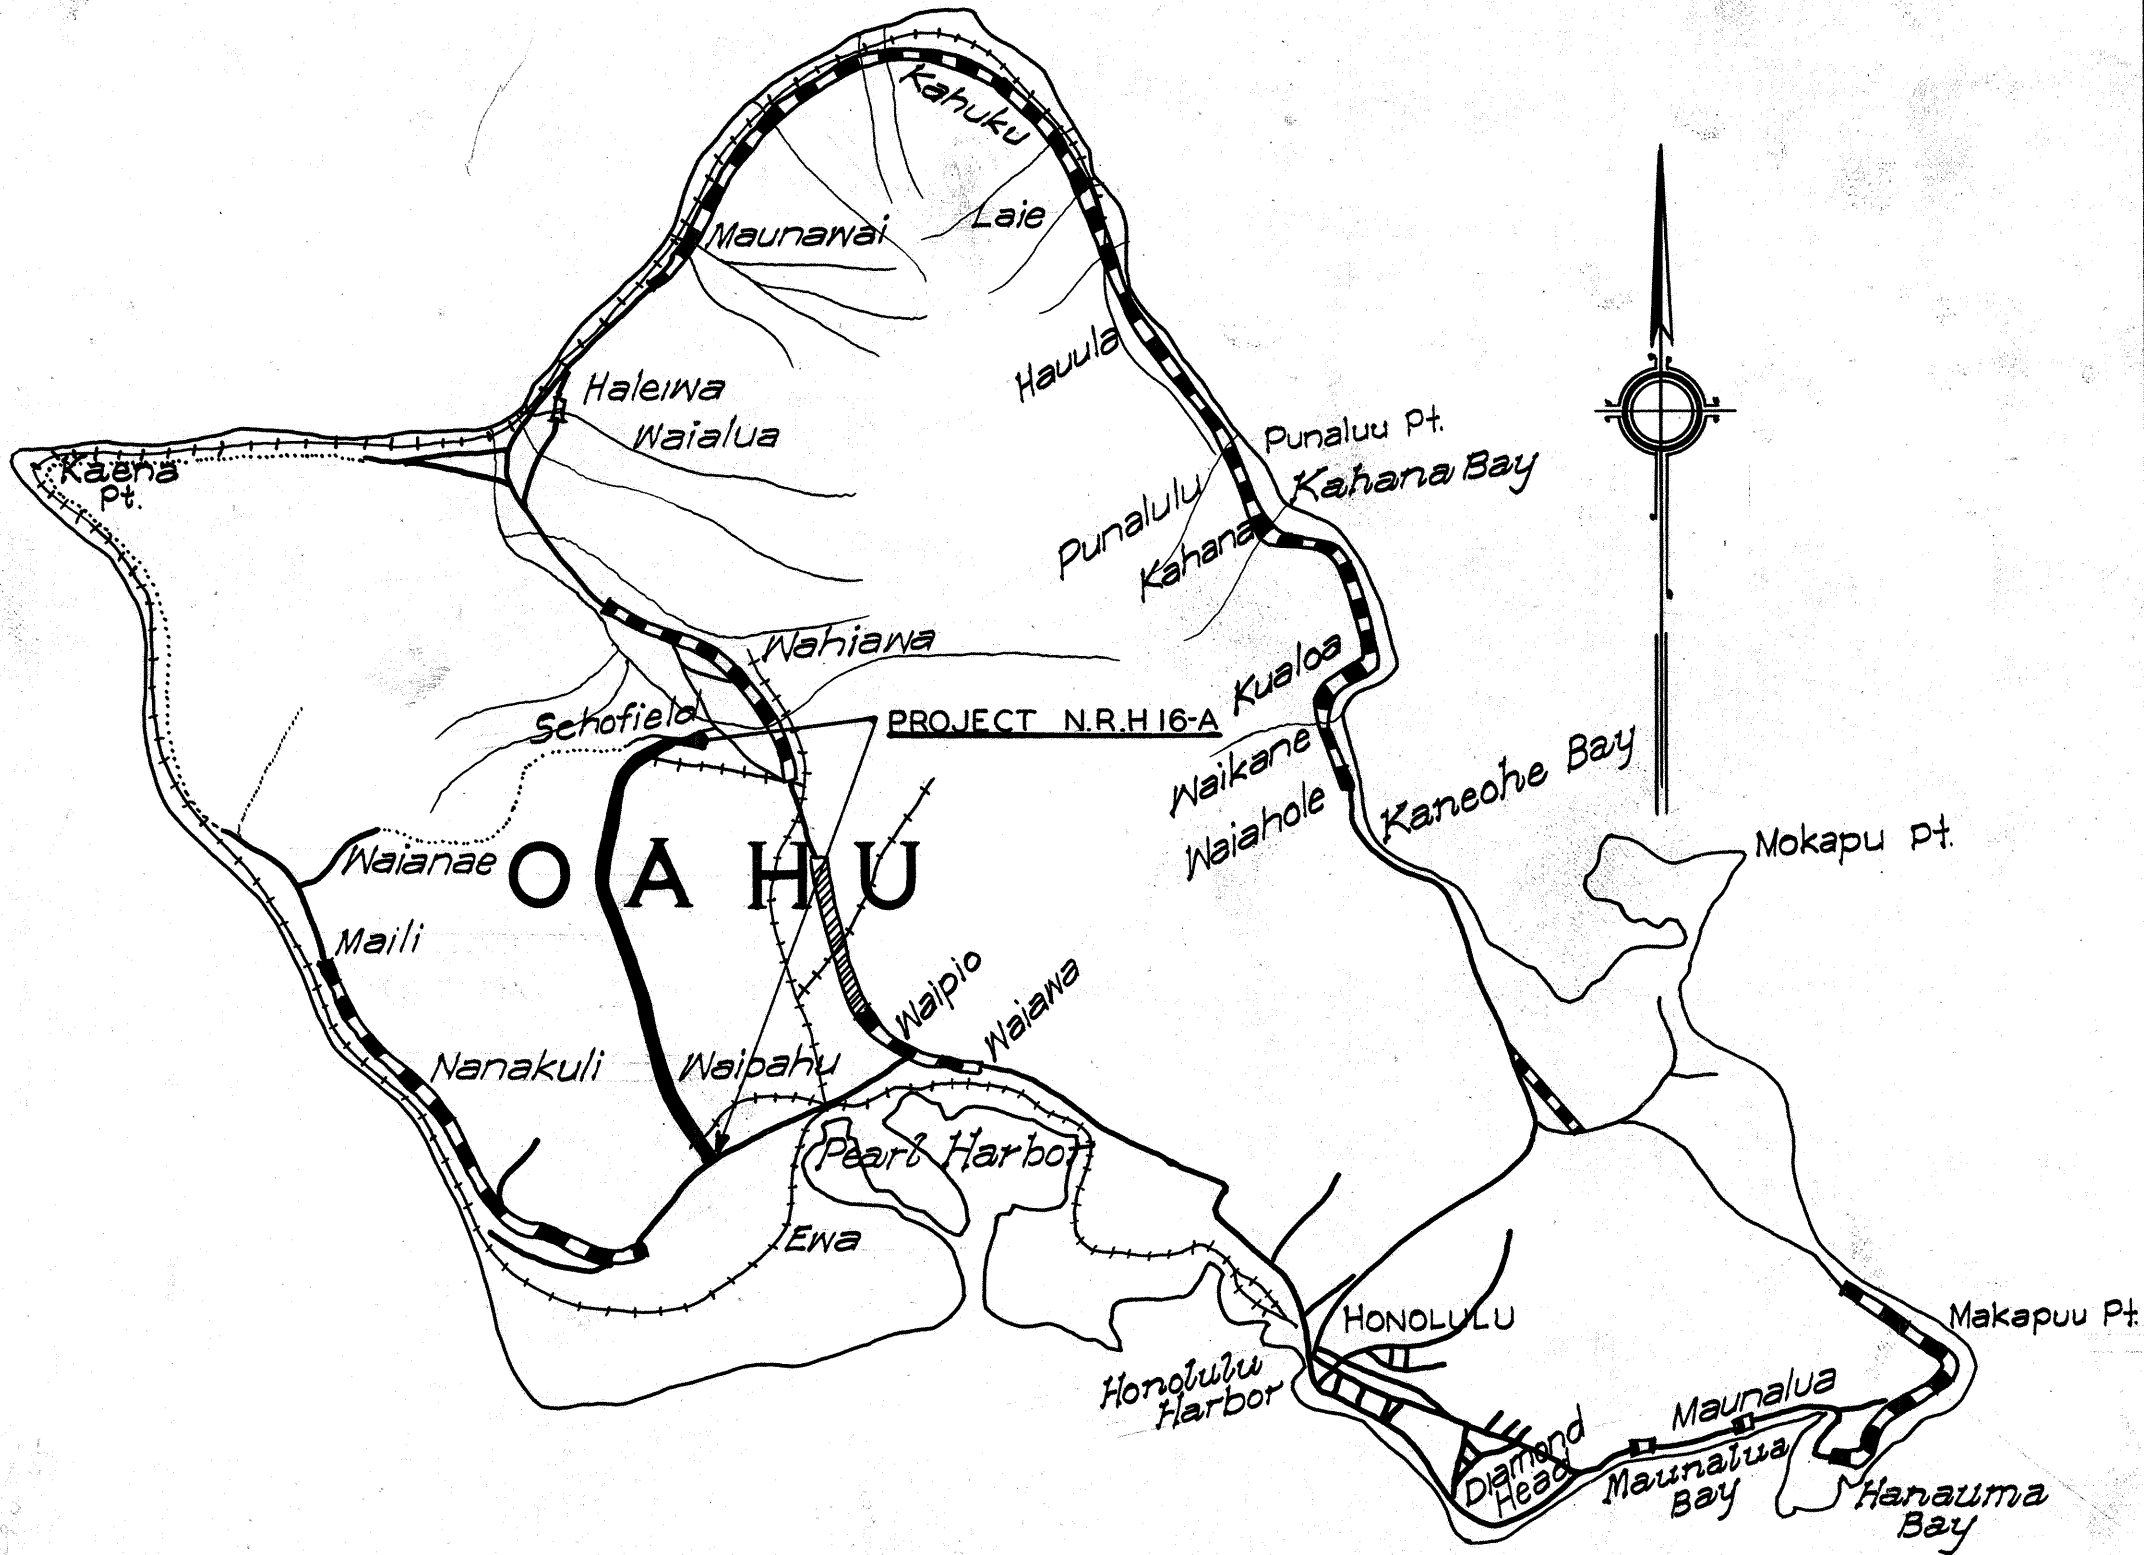

LEGEND

- Previously constructed Federal Aid Projects
- Federal Aid Projects under construction.

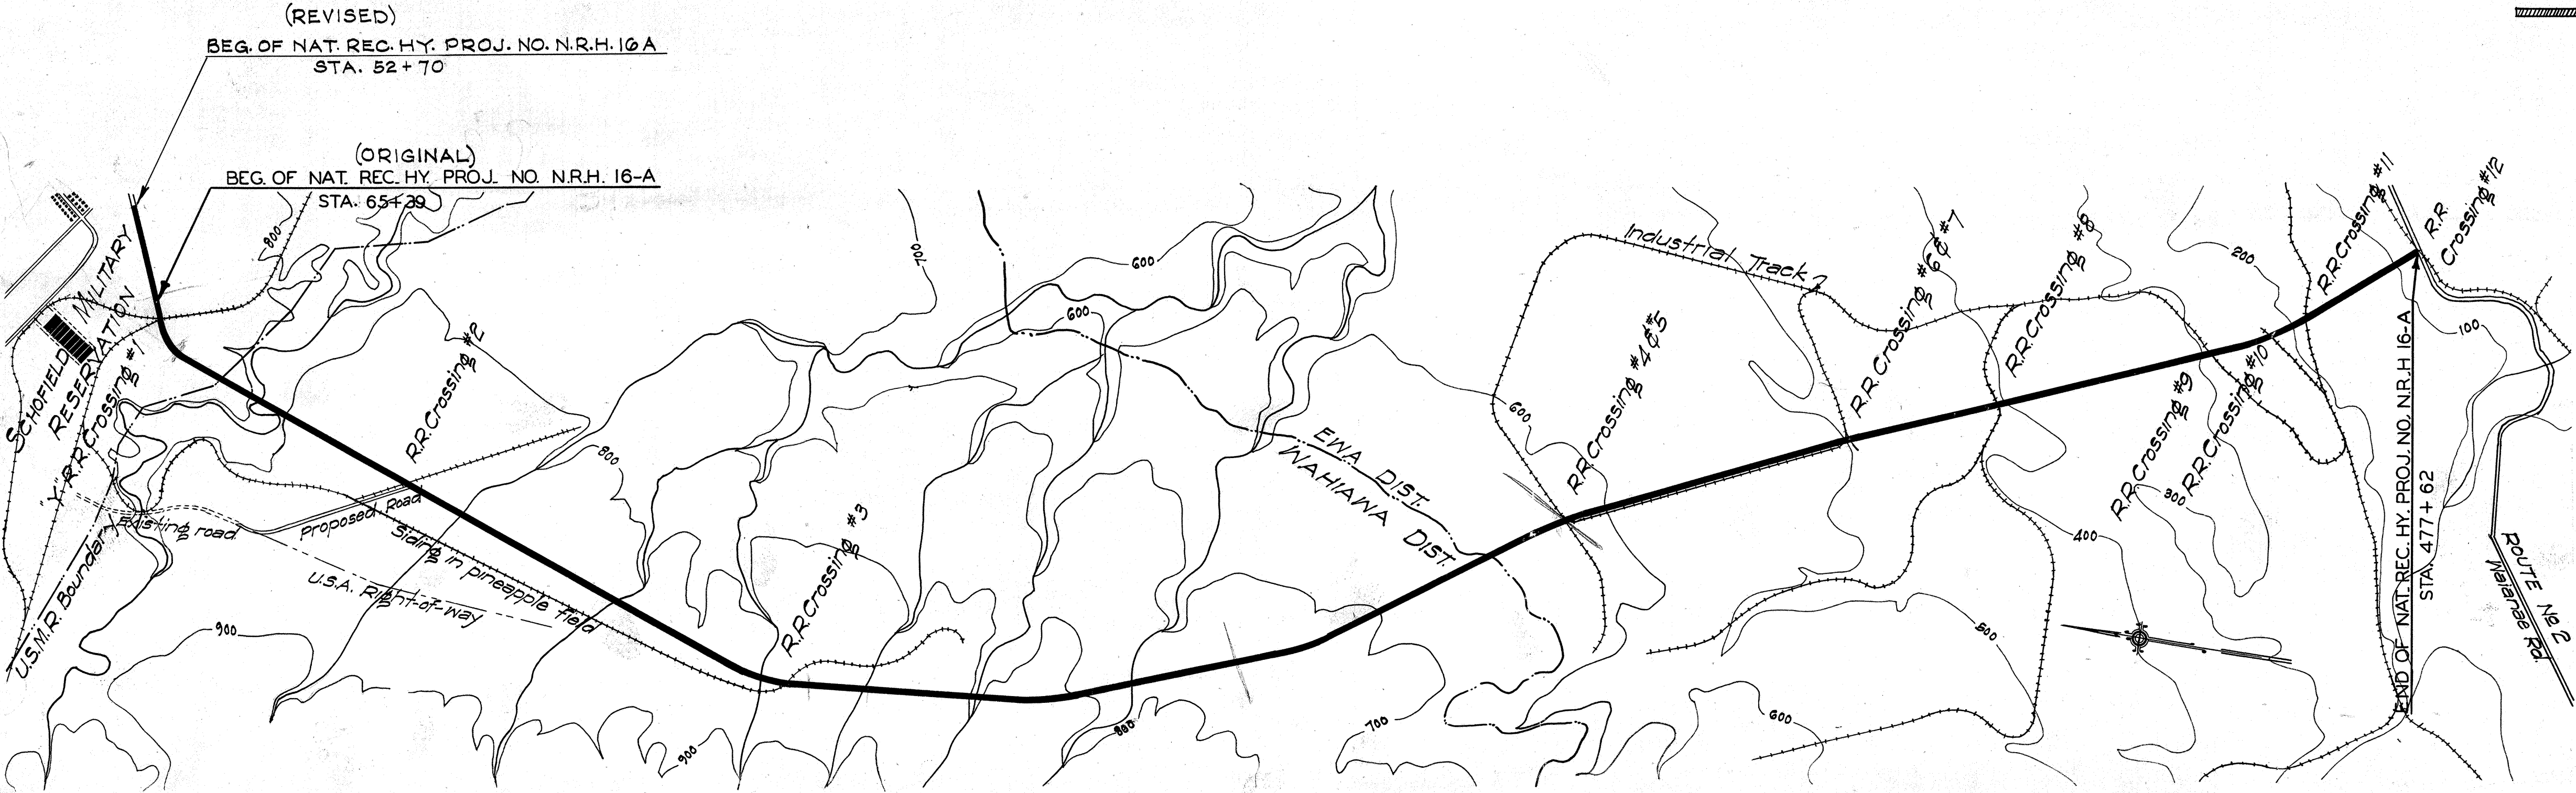

LAYOUT OF PROJECT

SCALE 1"=20,000

	ORIGINAL	REVISED
GROSS LENGTH OF PROJECT =	7.807 MILES	8.048 MILES
BRIDGES =	0.00	0.00
NET LENGTH =	7.807 MILES	8.048 MILES

APPROVED

Nov 13, 1933

TERRITORIAL HIGHWAY ENGINEER

RECOMMENDED FOR APPROVAL

Nov 13, 1933

PRINCIPAL HIGHWAY ENGINEER

Bureau of Public Roads

RECOMMENDED FOR APPROVAL

CHIEF ENGINEER Bureau of Public Roads

APPROVED

CHIEF Bureau of Public Roads