



INDEX TO DRAWINGS	
SHEET NO.	DESCRIPTION
1	TITLE SHEET
2-3	PLAN
4	PROJ. INFORMATION SIGN
5	PAV'T. MARKER DETAIL

STATE OF HAWAII
DEPARTMENT OF TRANSPORTATION
HIGHWAYS DIVISION
HONOLULU, HAWAII
"AS BUILT"
PLANS FOR
RESURFACING A PORTION OF
KUNIA ROAD
Vicinity Of Wheeler Field Kunia Gate To Wilikina Drive

PROJECT NO. 750A-01-71

DISTRICT OF WAHIWA
ISLAND OF OAHU

FED. ROAD DIST. NO.	STATE	PROJ. NO.	FISCAL YEAR	SHEET NO.	TOTAL SHEETS
HAWAII	HAW.	750A-01-71	1971	1	5

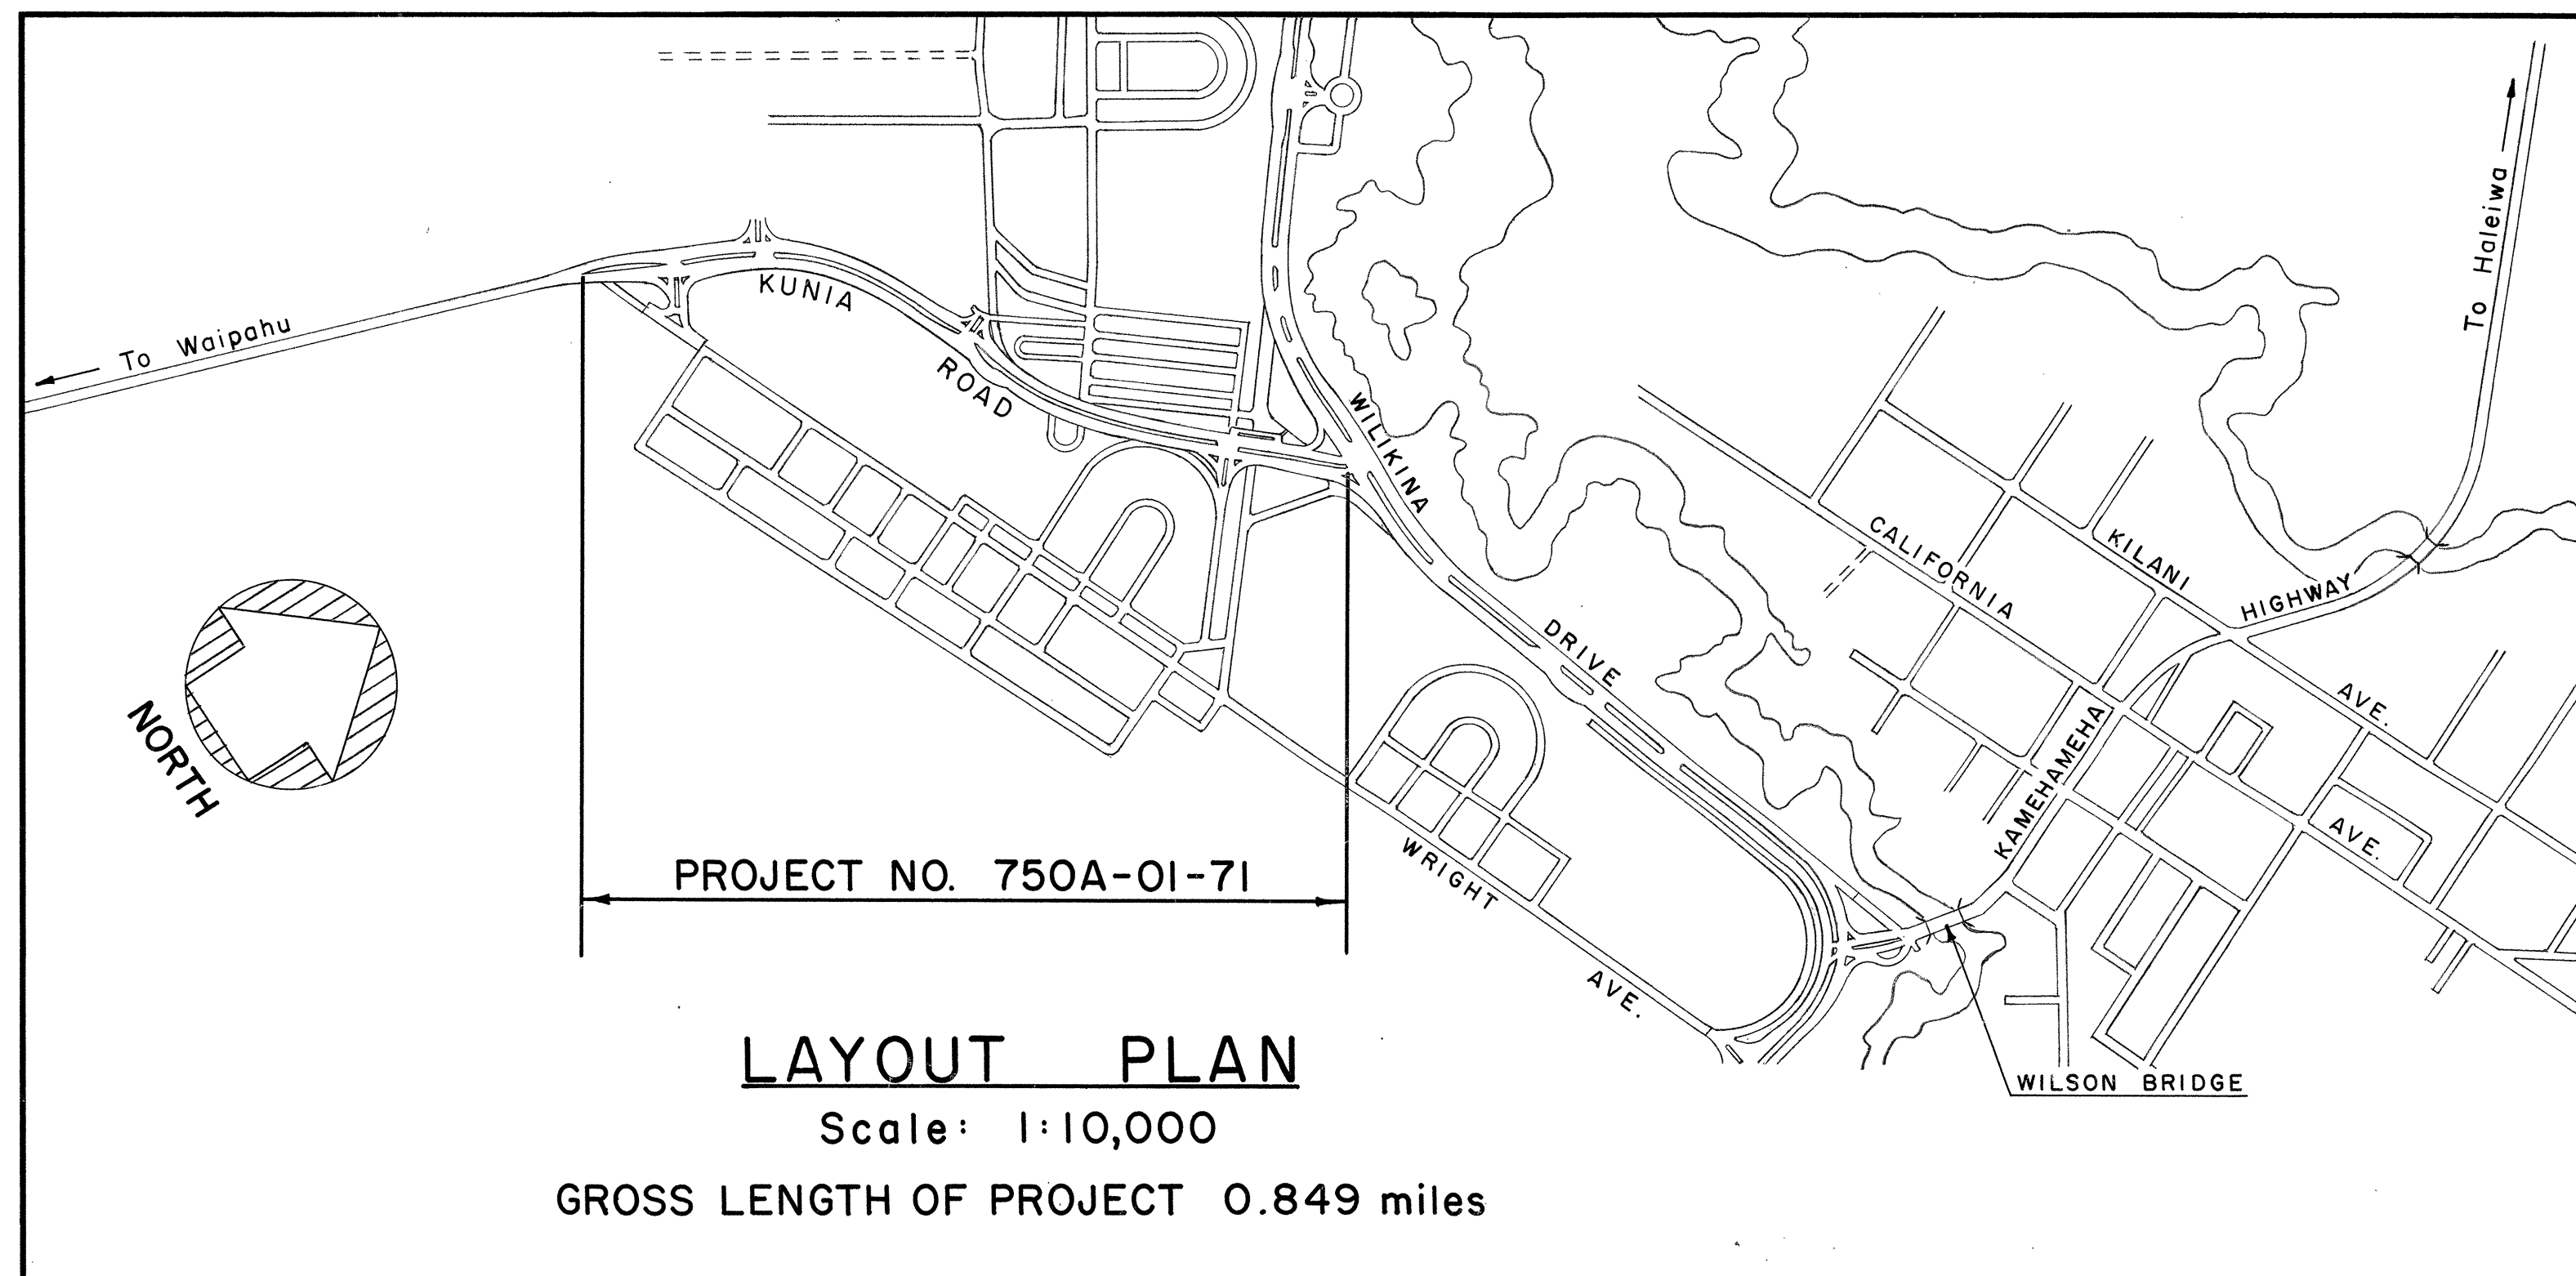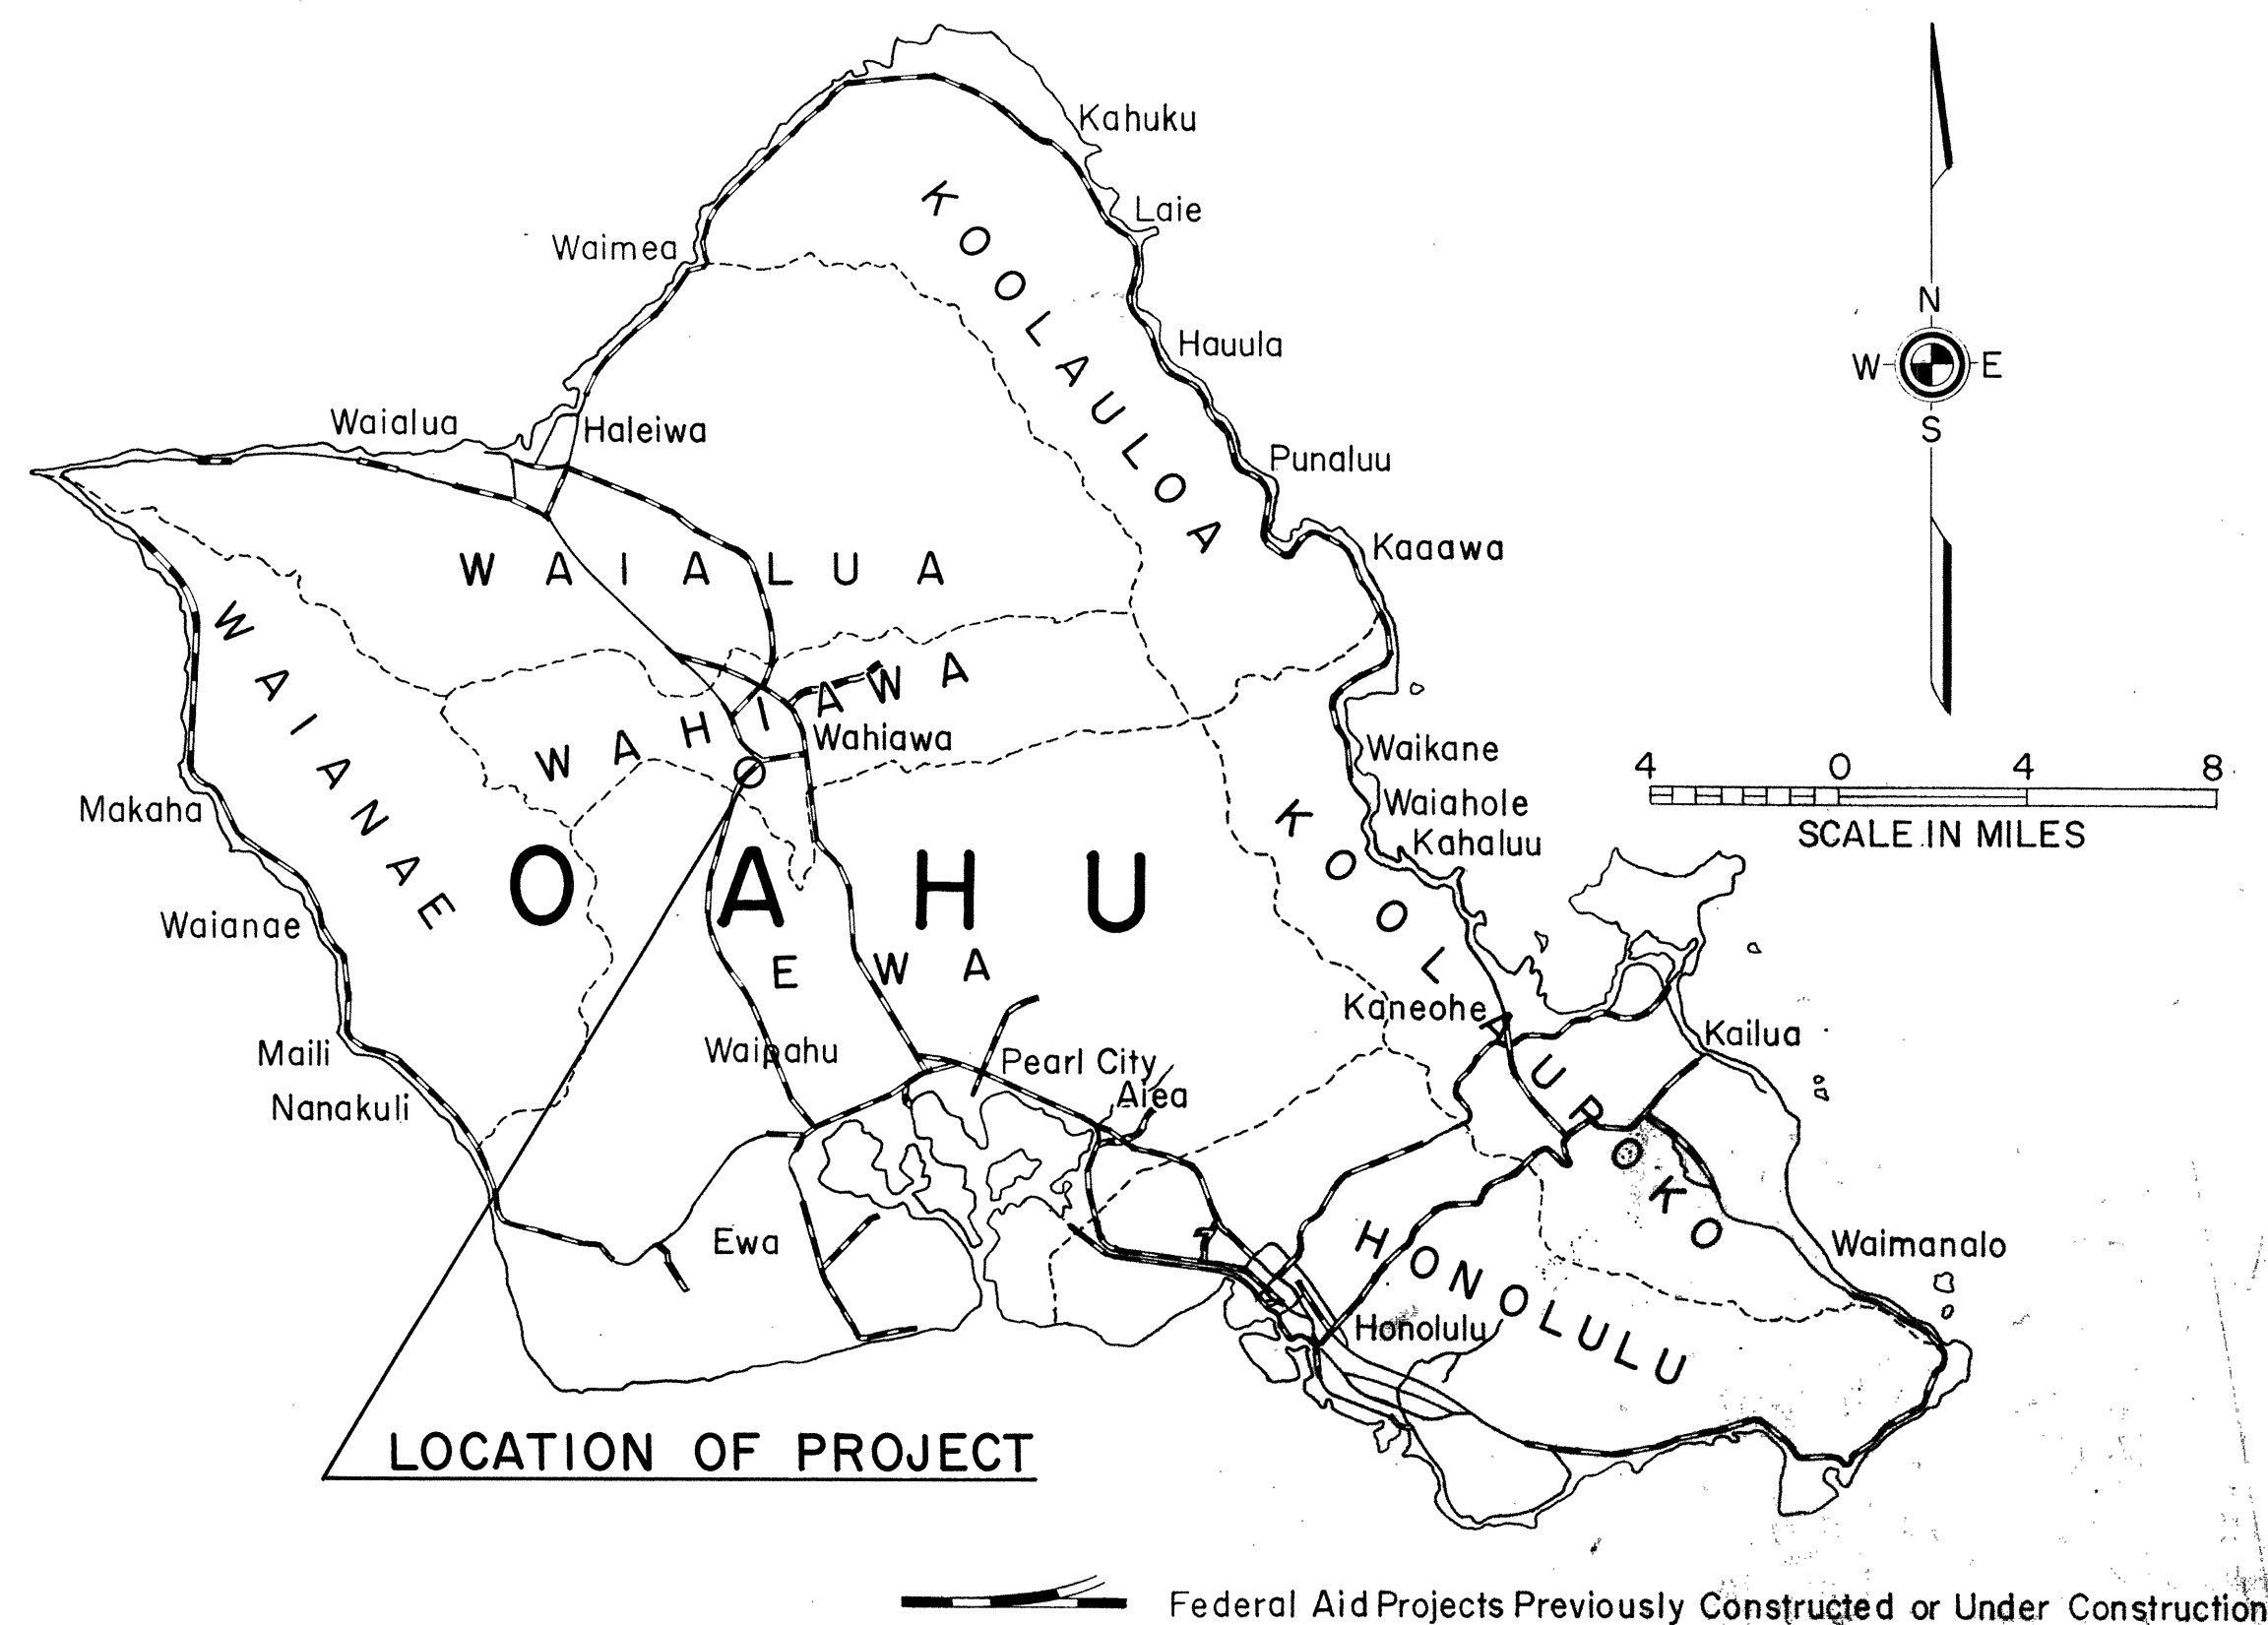

NOTE:
NO "AS BUILT" CHANGES.
David S. Wiegman 2/20/73
Project Engineer Date

DEPARTMENT OF TRANSPORTATION
STATE OF HAWAII
APPROVED:
E. Olney Wright 2/23/71
for DIR. OF TRANSPORTATION DATE

R. TSUZUKI
DESIGN ENGINEER
548-7490
PHONE
Jan., 1971
DATE