.e	
INDEX TO DRAWINGS	
SHEET NO.	DESCRIPTION
	TITLE SHEET
2	PLAN
3	STRIPING PLAN, NOTES AND DETAIL
.4	MISCELLANEOUS CROSSWALK AND STRIPING DETAILS
5	HECO OVERHEAD LINE EXTENSION
6-12	MISCELLANEOUS STANDARD DETAILS
	• .
,	





STATE OF NAME OF NAME

DEPARTMENT OF TRANSPORTATION LAND TRANSPORTATION FACILITIES DIVISION

HONOLULU, HAWAII


AS-BUILT


PLANS FOR

KUNIA ROAD
TRAFFIC SIGNALS AT FOOTE GATE

FEDERAL AID PROJ. NO. RS-0750 (4)

DISTRICT OF WAHIAWA
ISLAND OF OAHU

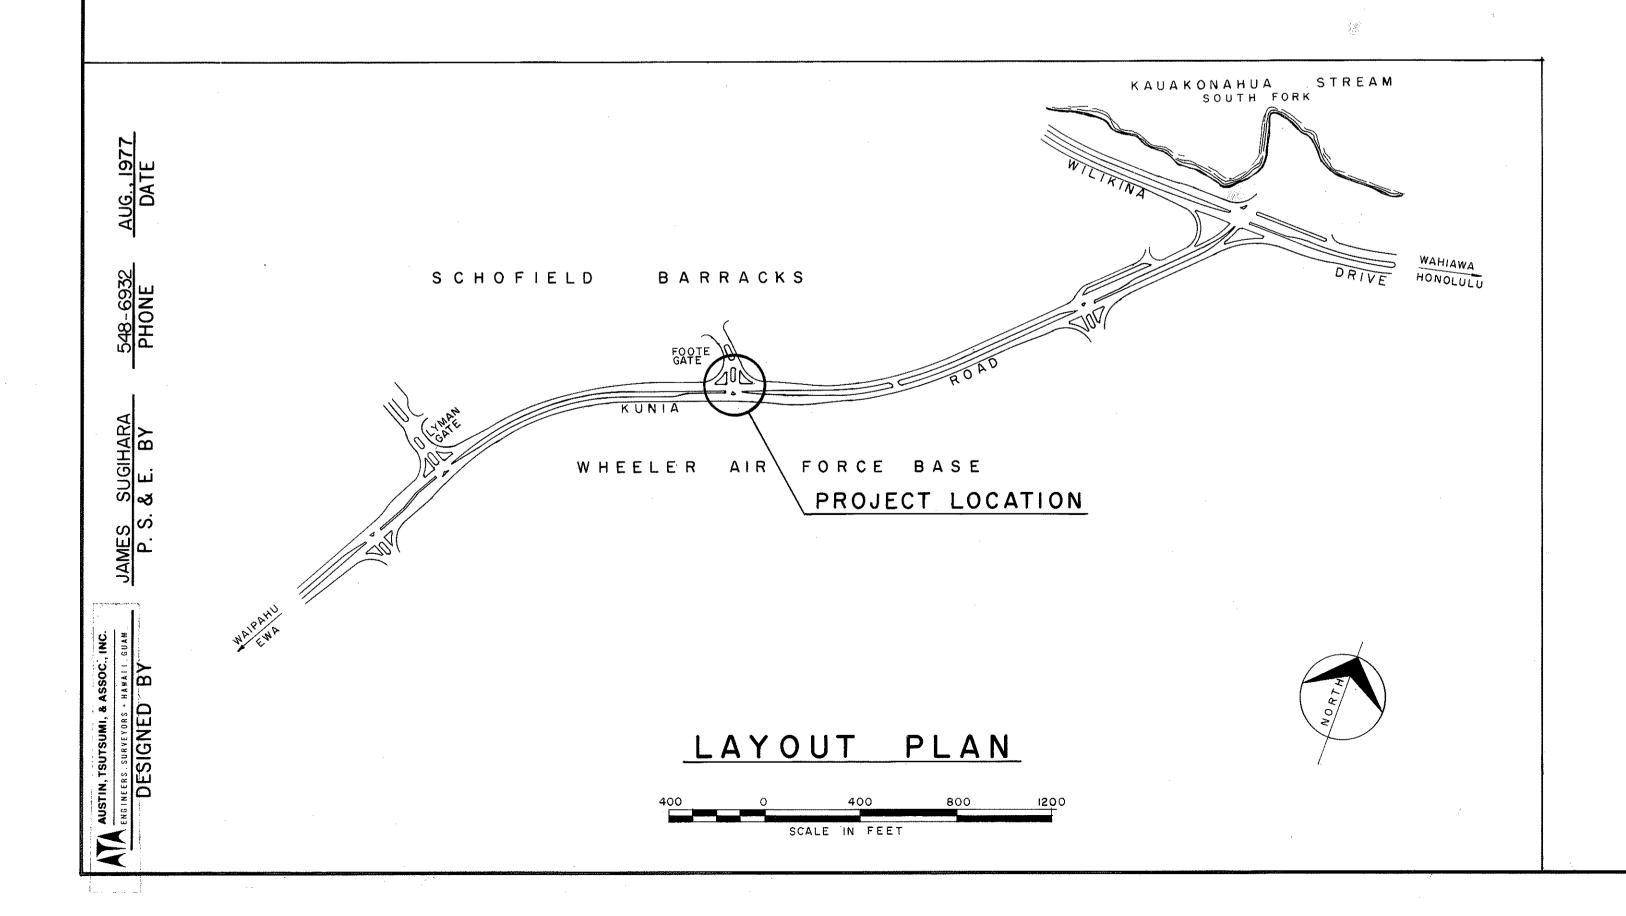

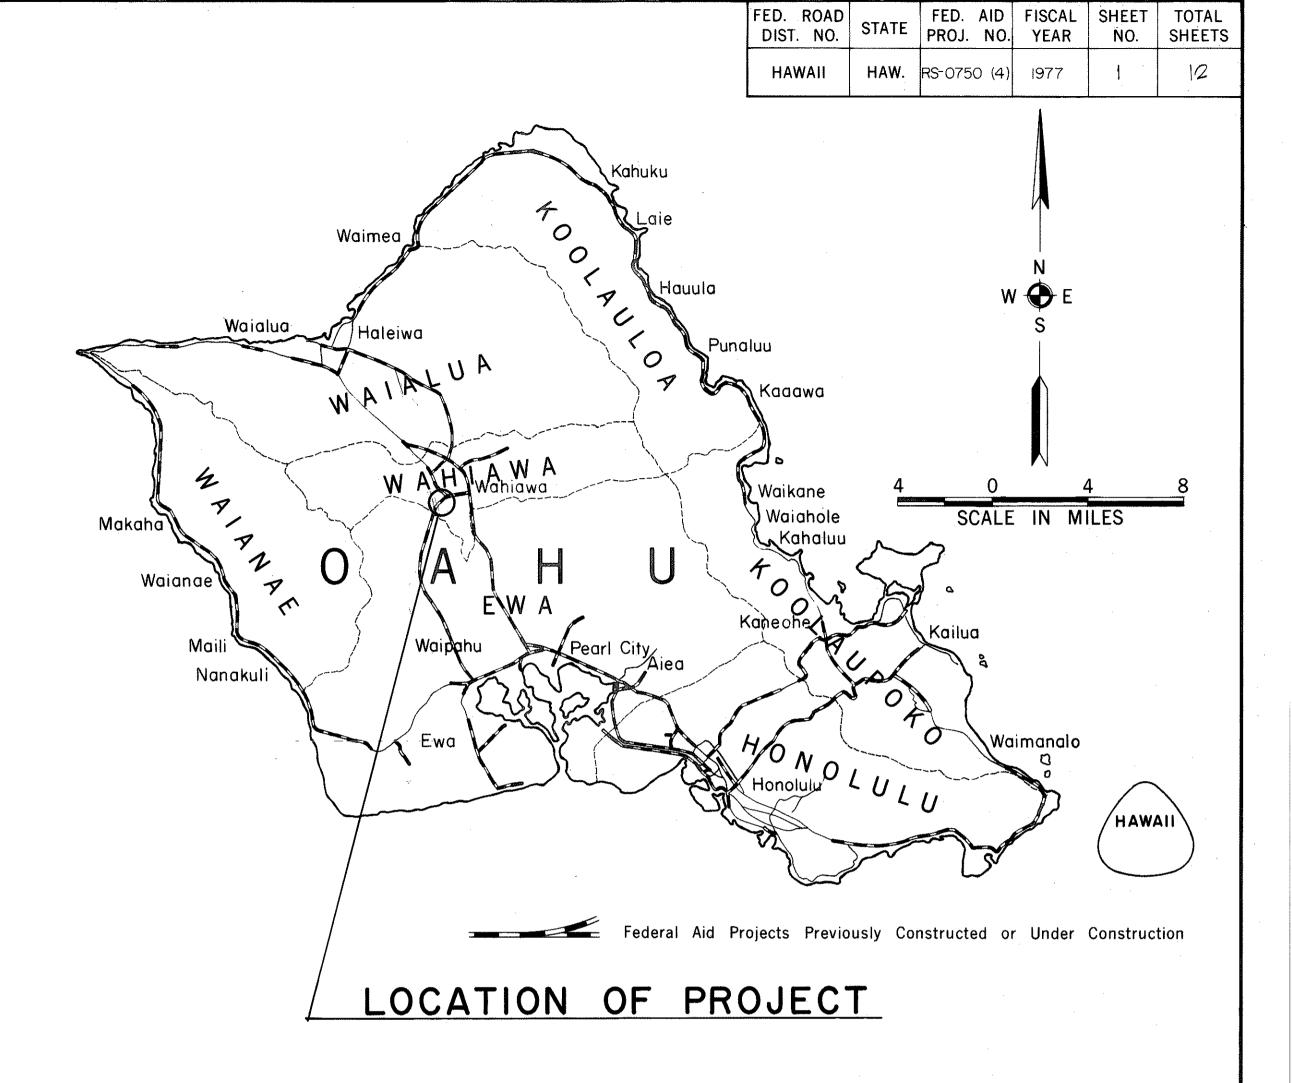

ALL CHANGES MADE DURING CONSTRUCTION HAVE BEEN INCORPORATED ON THESE PLANS EXCEPT CHANGES IN THE ORIGINAL THEORETICAL QUANTITIES.

PROJECT ENGINEER

DATE

DESIGN	CLASSIFICATION
ADT (1976)	16,570
ADT (1996)	16,240
DHV	1,870
D	65/35
Ť	2.0%
T ₂₄	5.0%
V	35 MPH

DEPARTMENT OF TRANSPORTATION
STATE OF HAWAII

APPROVED:

Regashionna 9/16/17

DIR. OF TRANSPORTATION DATE