



FED. ROAD DIST. NO.	STATE	PROJ. NO.	FISCAL YEAR	SHEET NO.	TOTAL SHEETS
HAWAII	HAW.	750A-01-79	1981	2	2

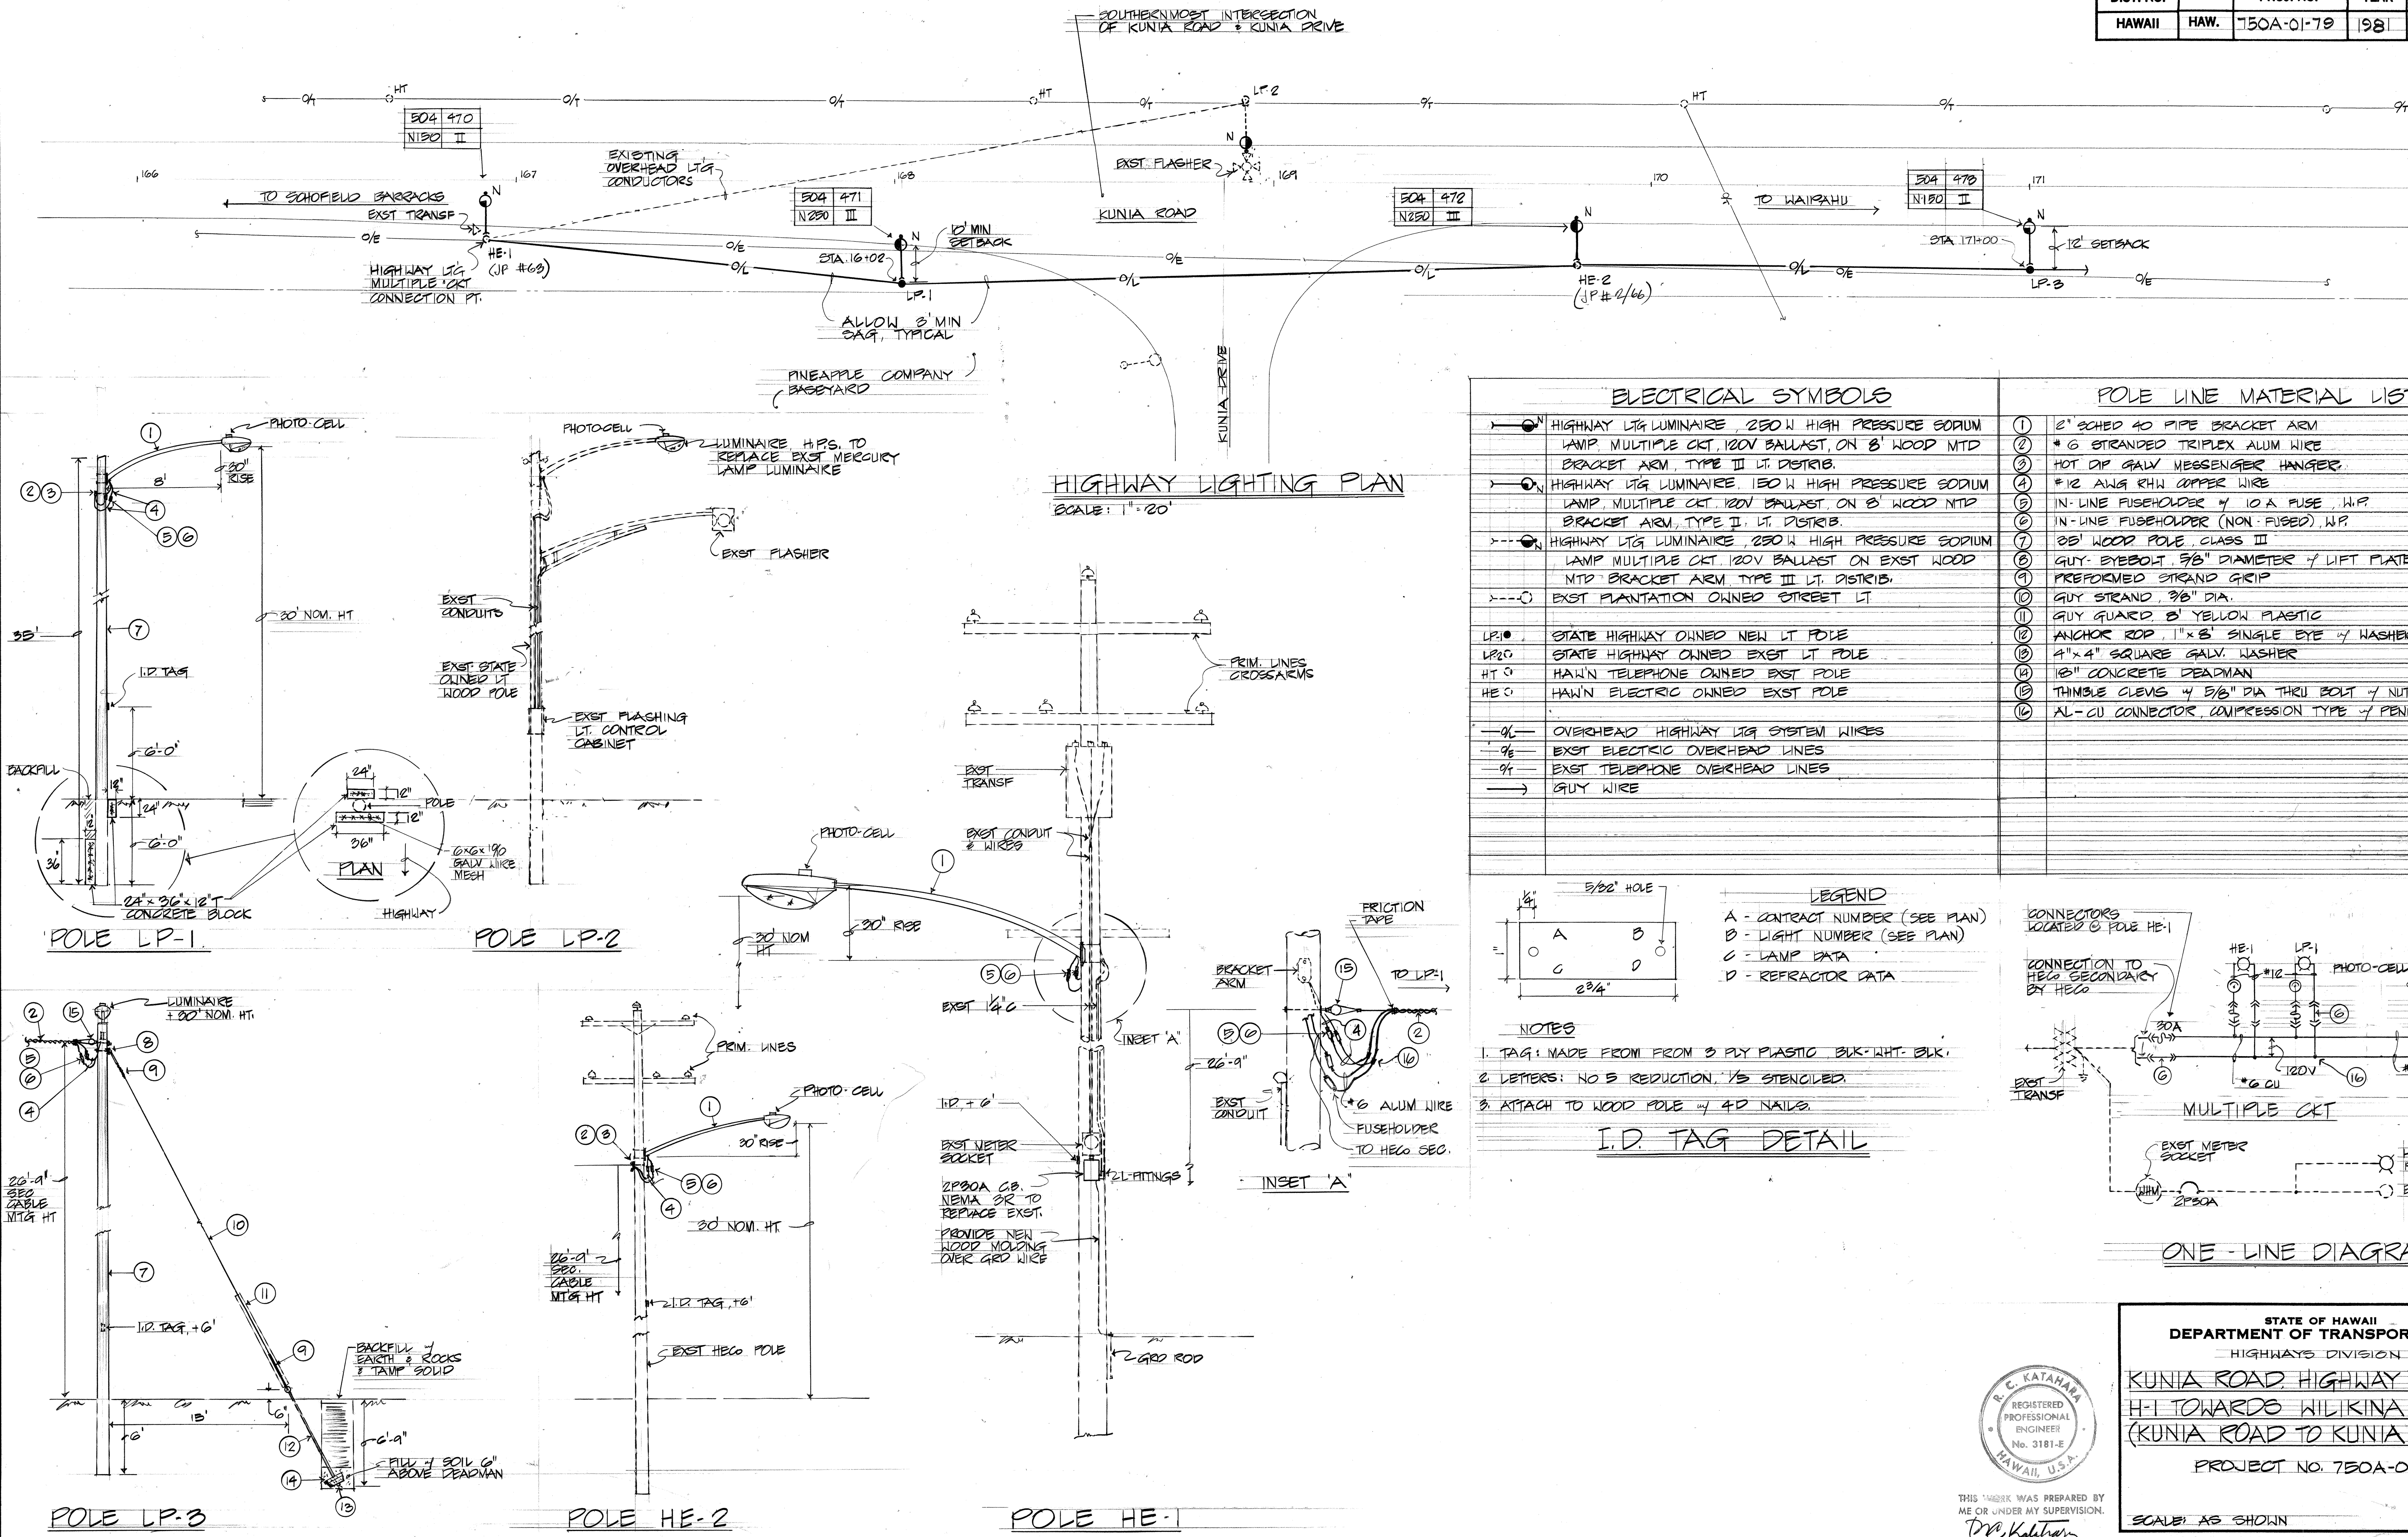

SURVEY PLOTTED BY	DATE
PLAN	
DRAWN BY	
DESIGNED BY	
NOTED BY	
CHECKED BY	

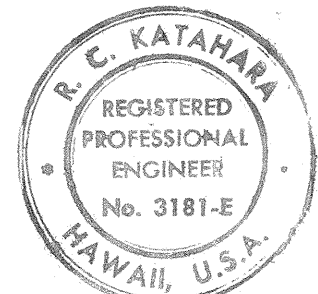

STATE OF HAWAII
DEPARTMENT OF TRANSPORTATION
HIGHWAYS DIVISION
KUNIA ROAD, HIGHWAY LIGHTING
HT TOWARDS WILKINA DRIVE
(KUNIA ROAD TO KUNIA VILLAGE)
PROJECT NO. 750A-01-79

SCALE: AS SHOWN
SHEET NO. E-1 OF 1 SHEETS

THIS WORK WAS PREPARED BY ME OR UNDER MY SUPERVISION.
D.R. KATHARA
7/23/80