,	INDEX TO DRAWINGS
SHEET NO.	DESCRIPTION
l l	TITLE SHEET
2	NOTES & SCHEDULES
3	TYPICAL SECTIONS & DETAILS
4-6	PLANS
7-13	GUARDRAIL STANDARD DETAILS
14-16	SIGNING & PAVEMENT MARKINGS PLANS
Te fyrat	
17 - 27	TYPICAL AND STANDARD SIGNING
	& MARKING DETAILS
:	
***************************************	
	•



## STATE OF HAWAII



DEPARTMENT OF TRANSPORTATION

HIGHWAYS DIVISION
"AS-BUILT"


PLANS FOR

KUNIA ROAD RESURFACING


H-I TOWARDS WILIKINA DRIVE (VICINITY OF WAIAHOLE DITCH TO VICINITY OF KUNIA DRIVE)

F.A. PROJECT NO. SR-0750(6)

DISTRICT OF EWA ISLAND OF OAHU

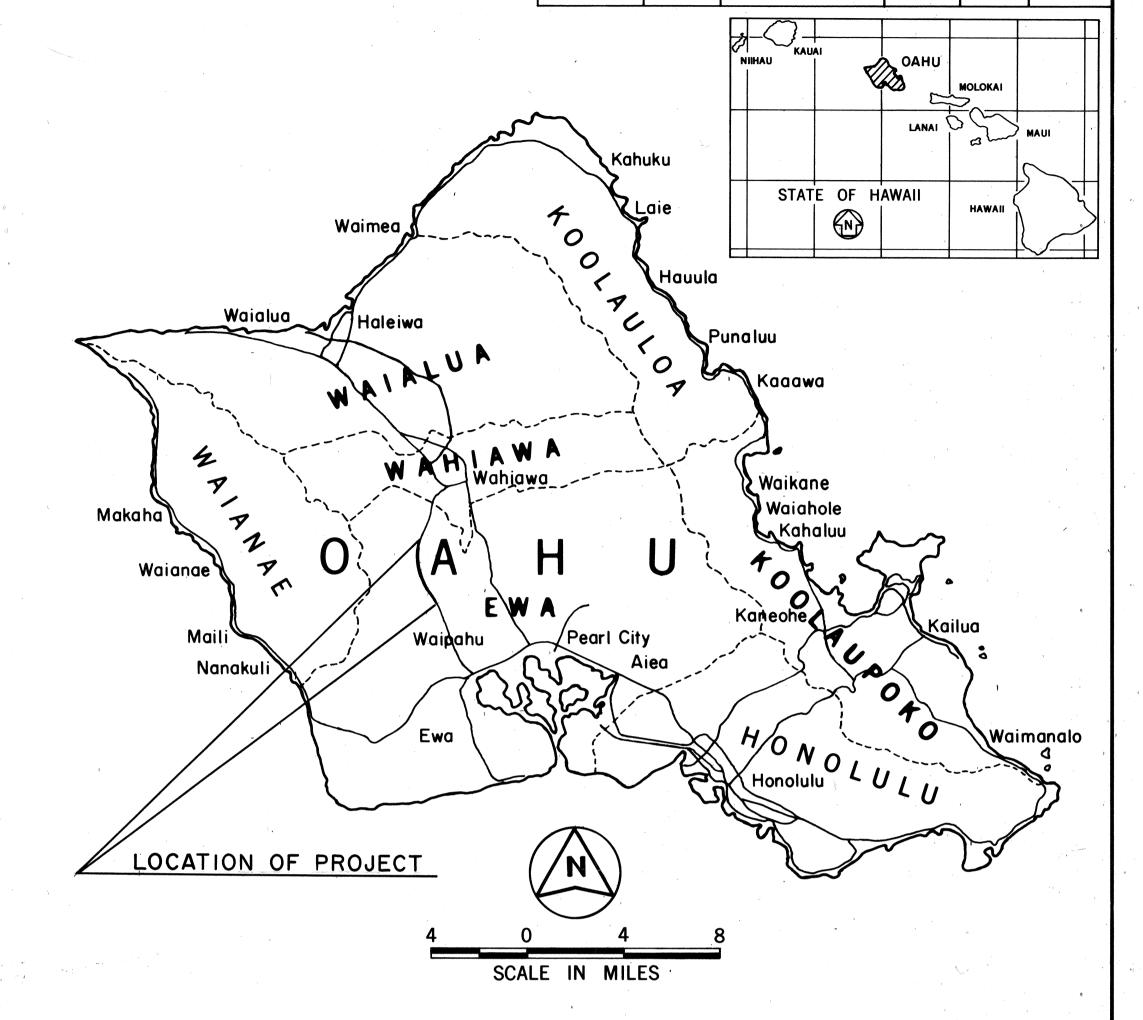

FED. AID PROJ. NO.

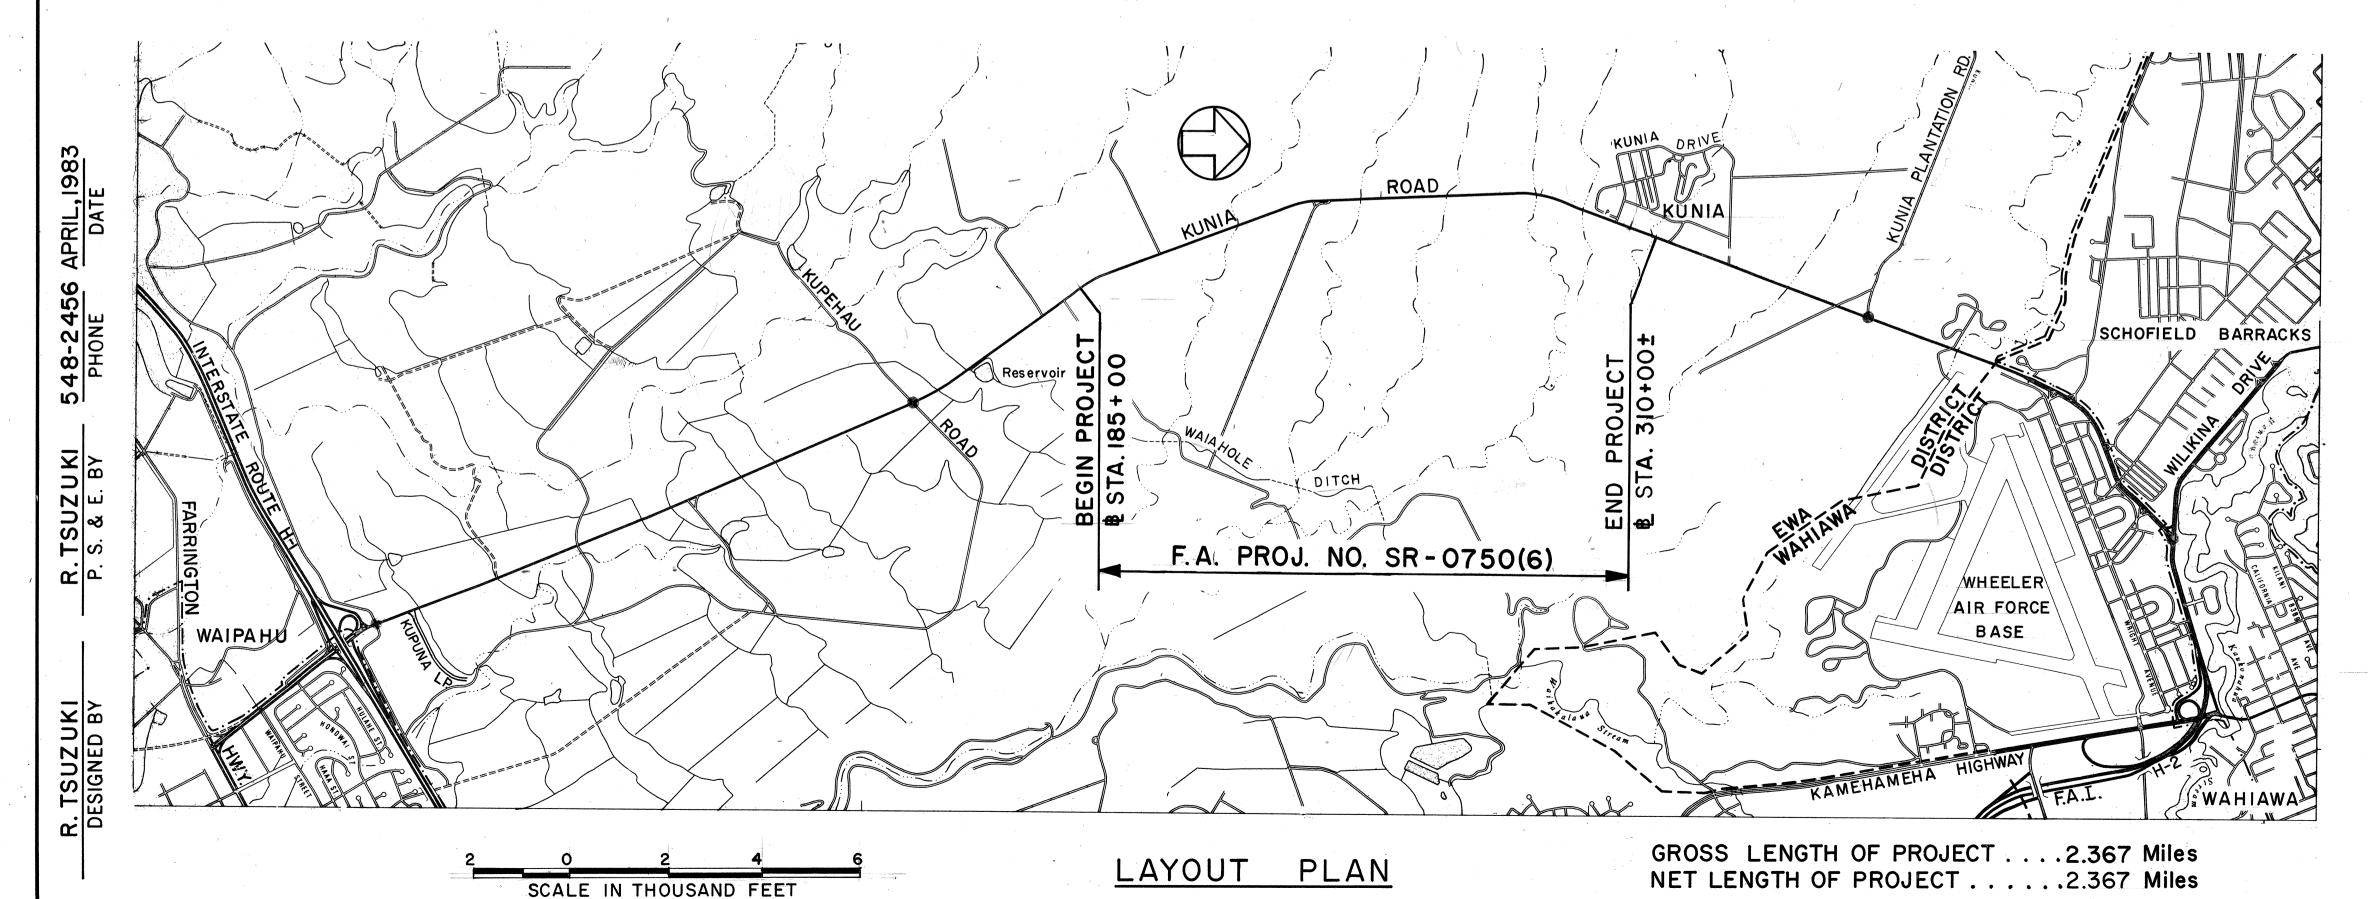

## DESIGN DESIGNATION

CHANGES MADE DURING CONSTRUCTION HAVE BEEN INCORPORATED ON THESE PLANS EXCEPT CHANGES IN THE ORIGINAL THEORETICAL QUANTITIES. FOR ACTUAL QUANTITIES, REFER TO PROJECT LEDGER AND/OR COMPUTATION BOOK

RESIDENT ENGINEER

6-15-84 DATE

DEPARTMENT OF TRANSPORTATION
STATE OF HAWAII

APPROVED:

May 19,8

DIR. OF TRANSPORTATION

DATE

TRANSPORTATION