




FED. ROAD DIST. NO.	STATE	FED. AID PROJ. NO.	FISCAL YEAR	SHEET NO.	TOTAL SHEETS
HAWAII	HAW.	RS-0750 (7)	1984	3	32

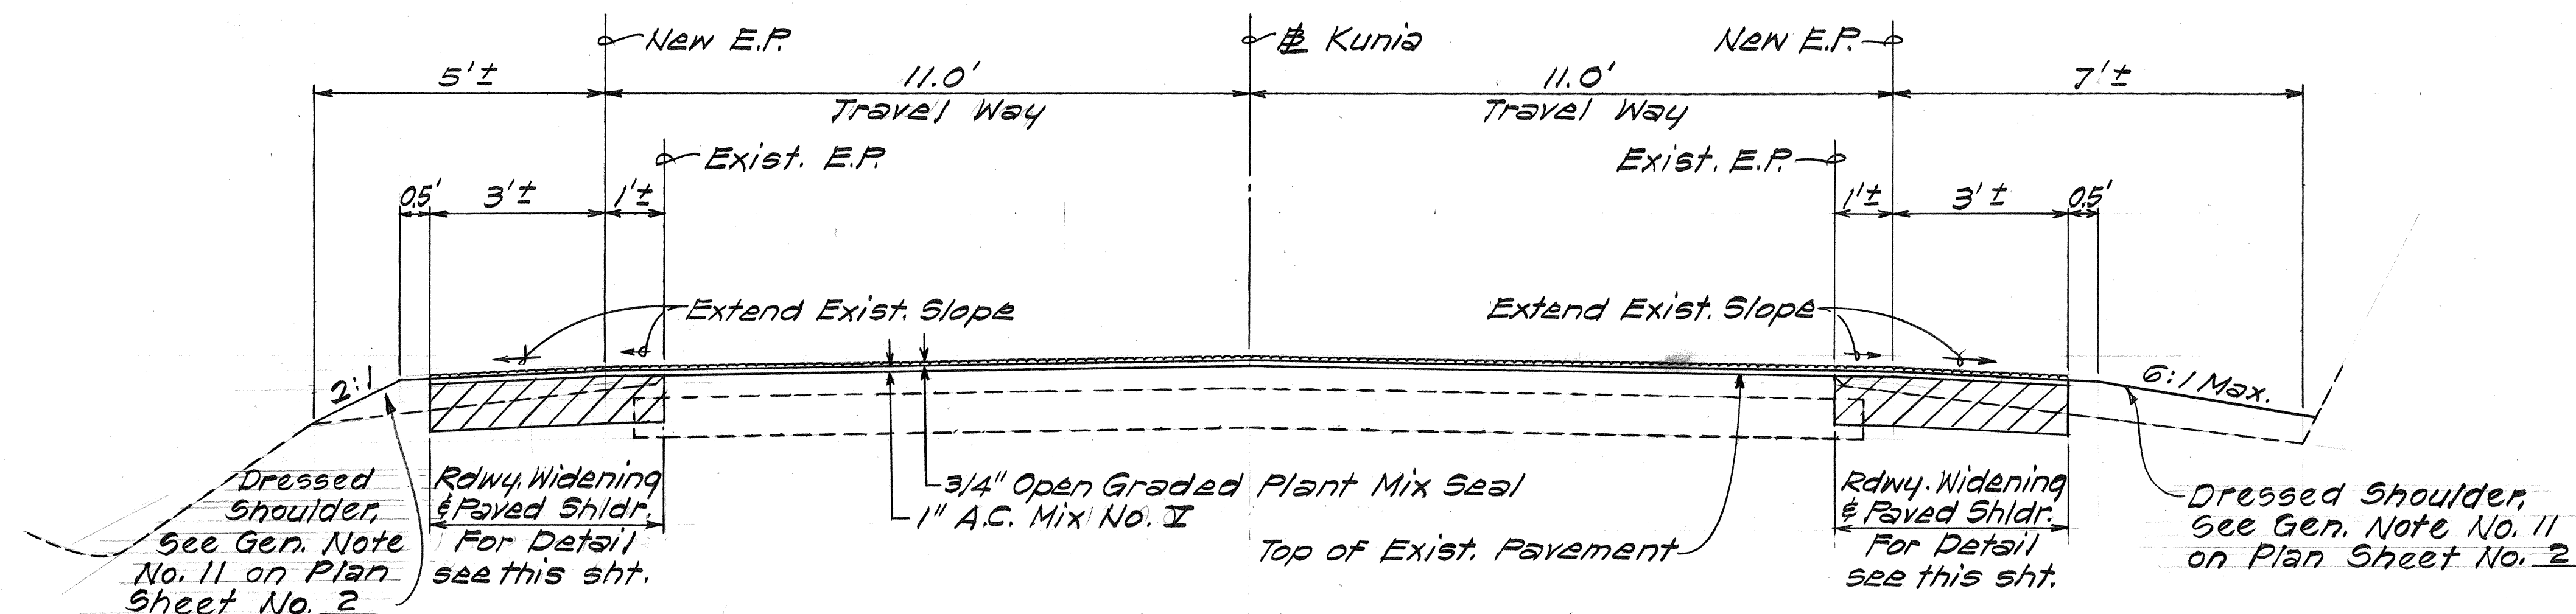


TYPICAL SECTION ~ STA. 302+90± TO STA. 380+70±
Scale: 1/2"=1'-0"

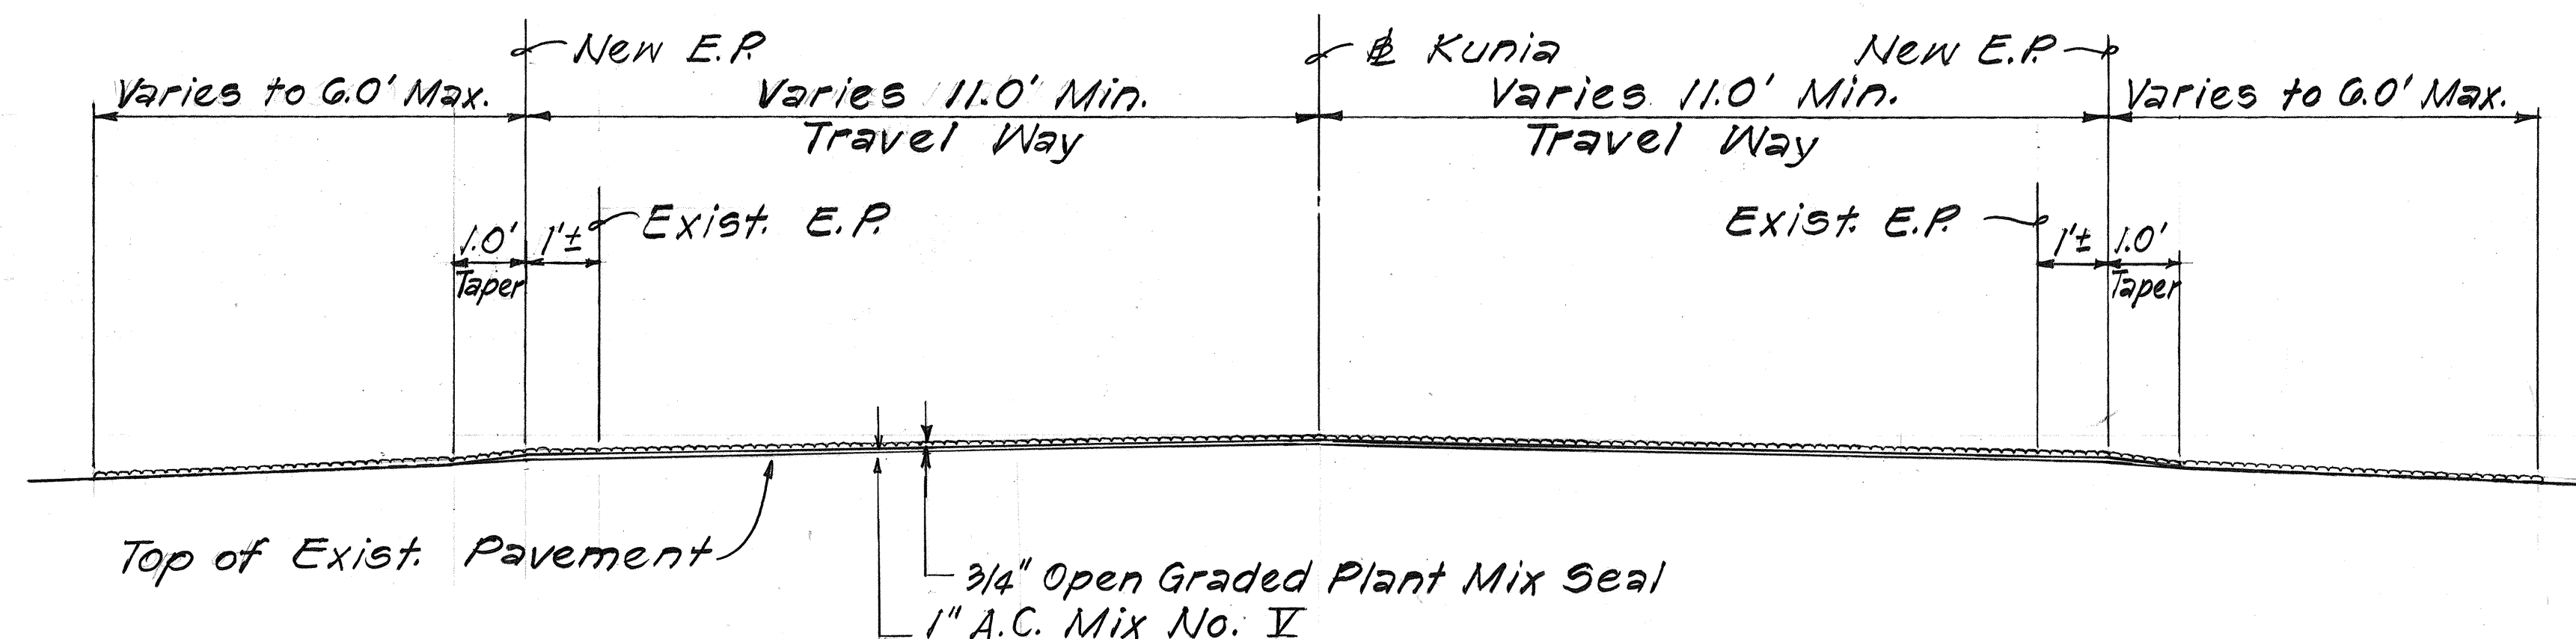


TYPICAL SECTION ~ STA. 380+70± TO STA. 392+75±
Scale: 1/2"=1'-0"

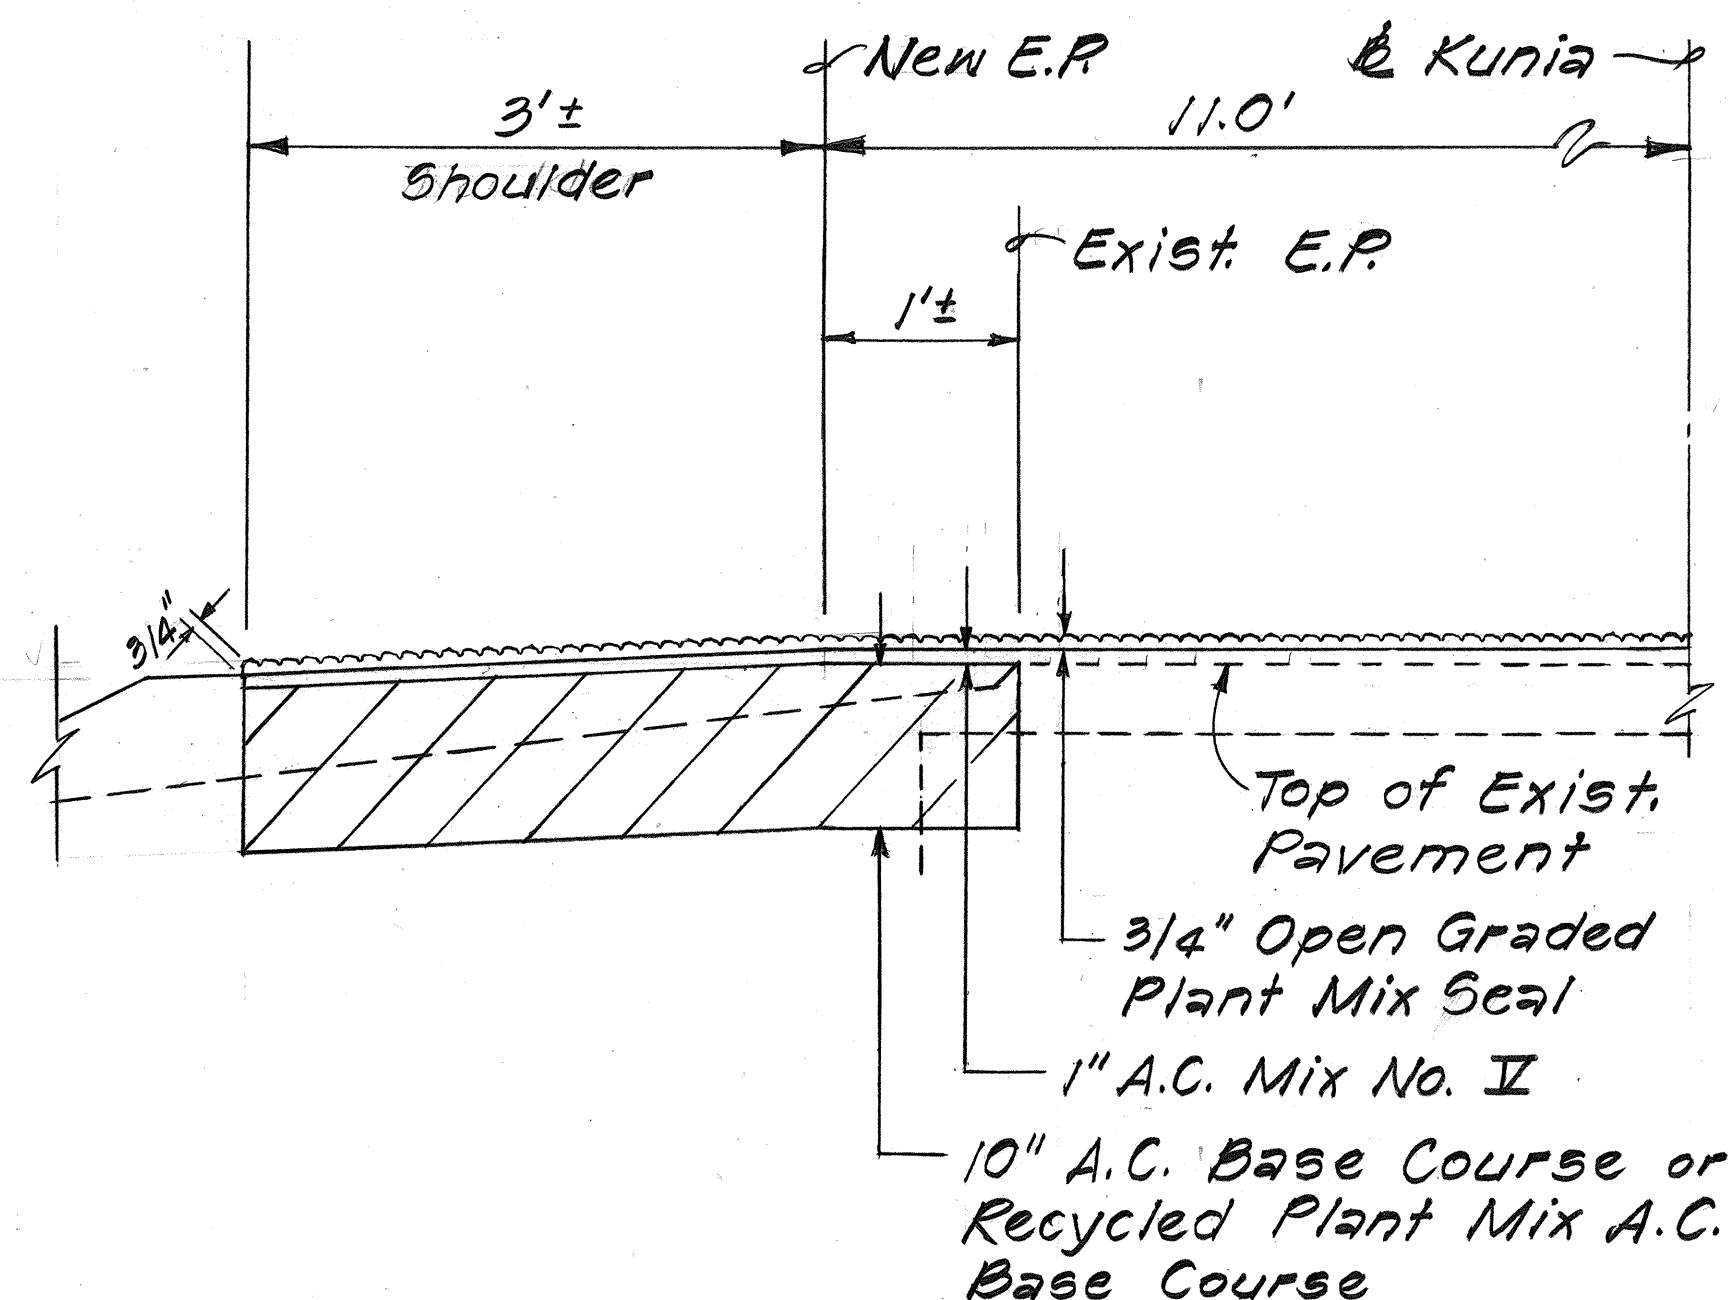


DETAIL ROADWAY WIDENING AND PAVED SHOULDER
Scale: 1"=1'-0"

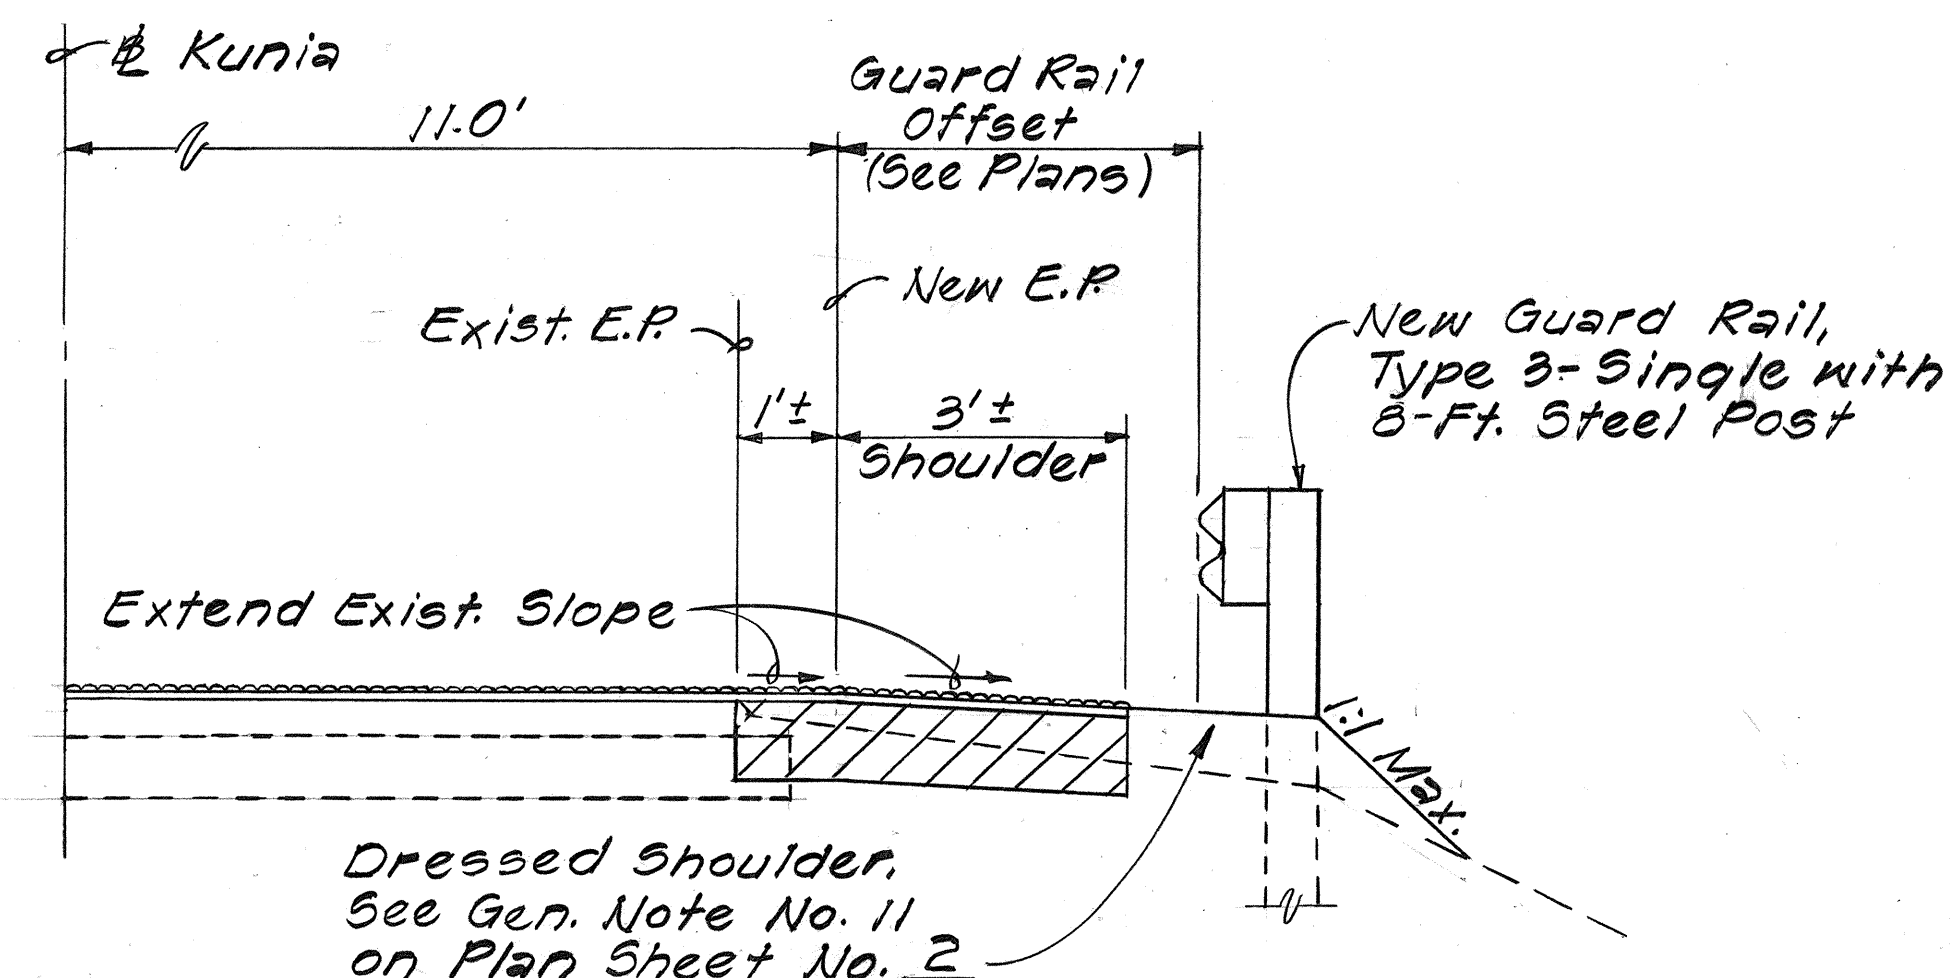

TYPICAL GUARD RAIL DETAIL
Scale: 1/2"=1'-0"

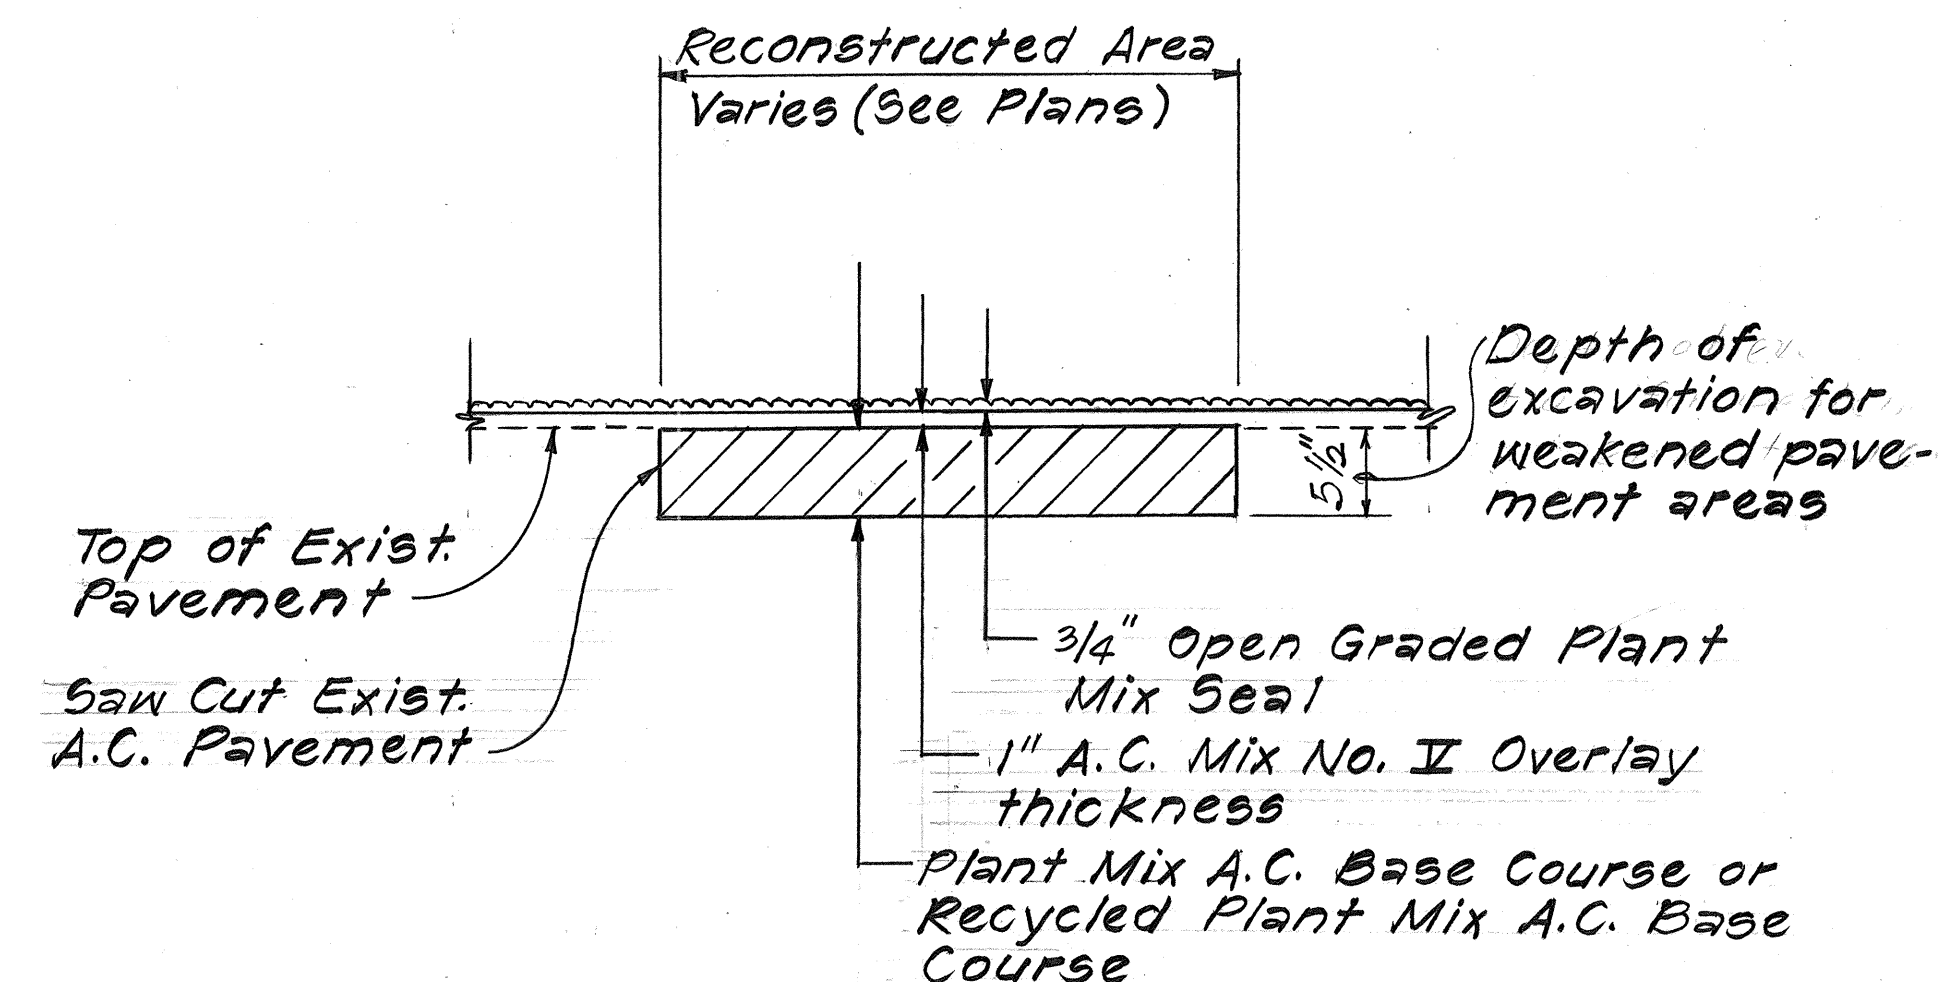

TYPICAL SECTION RECONSTRUCTED AREA
Scale: 1"=1'-0"

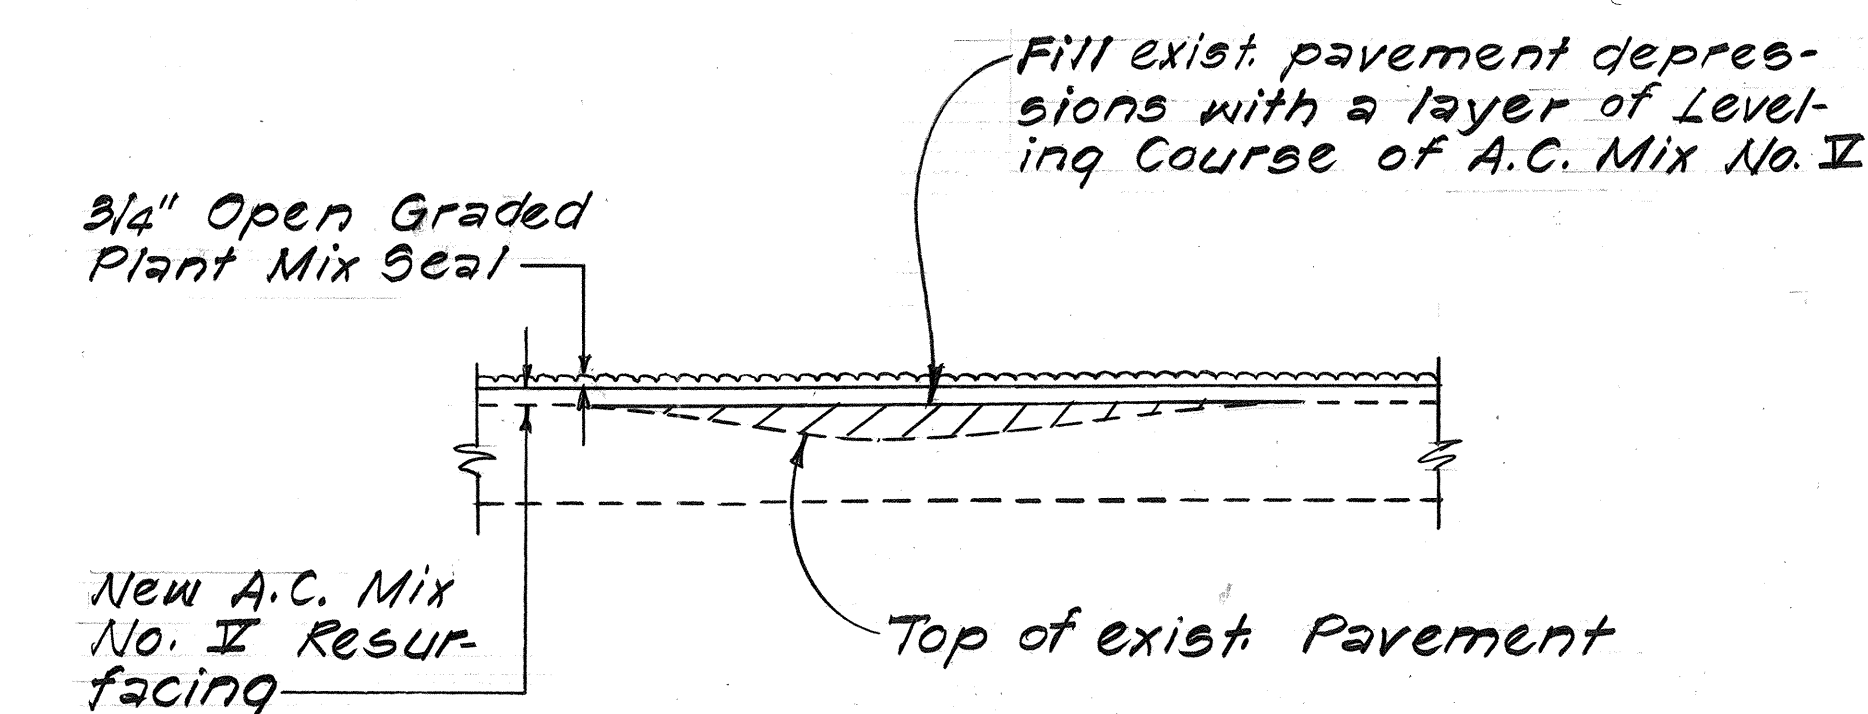


LEVELING COURSE DETAIL
Scale: 1"=1'-0"


STATE OF HAWAII DEPARTMENT OF TRANSPORTATION HIGHWAYS DIVISION
TYPICAL SECTIONS & DETAILS
KUNIA ROAD RESURFACING F.A. PROJECT No. RS-0750 (7)
Scale: As shown Date: April, 1984
SHEET No. 1 OF 2 SHEETS

DATE	DESIGNED BY	CHECKED BY
NO.	NO.	NO.


FED. ROAD DIST. NO.	STATE	FED. AID PROJ. NO.	FISCAL YEAR	SHEET NO.	TOTAL SHEETS
HAWAII	HAW.	RS-0750(7)	1984	C.0.4	32

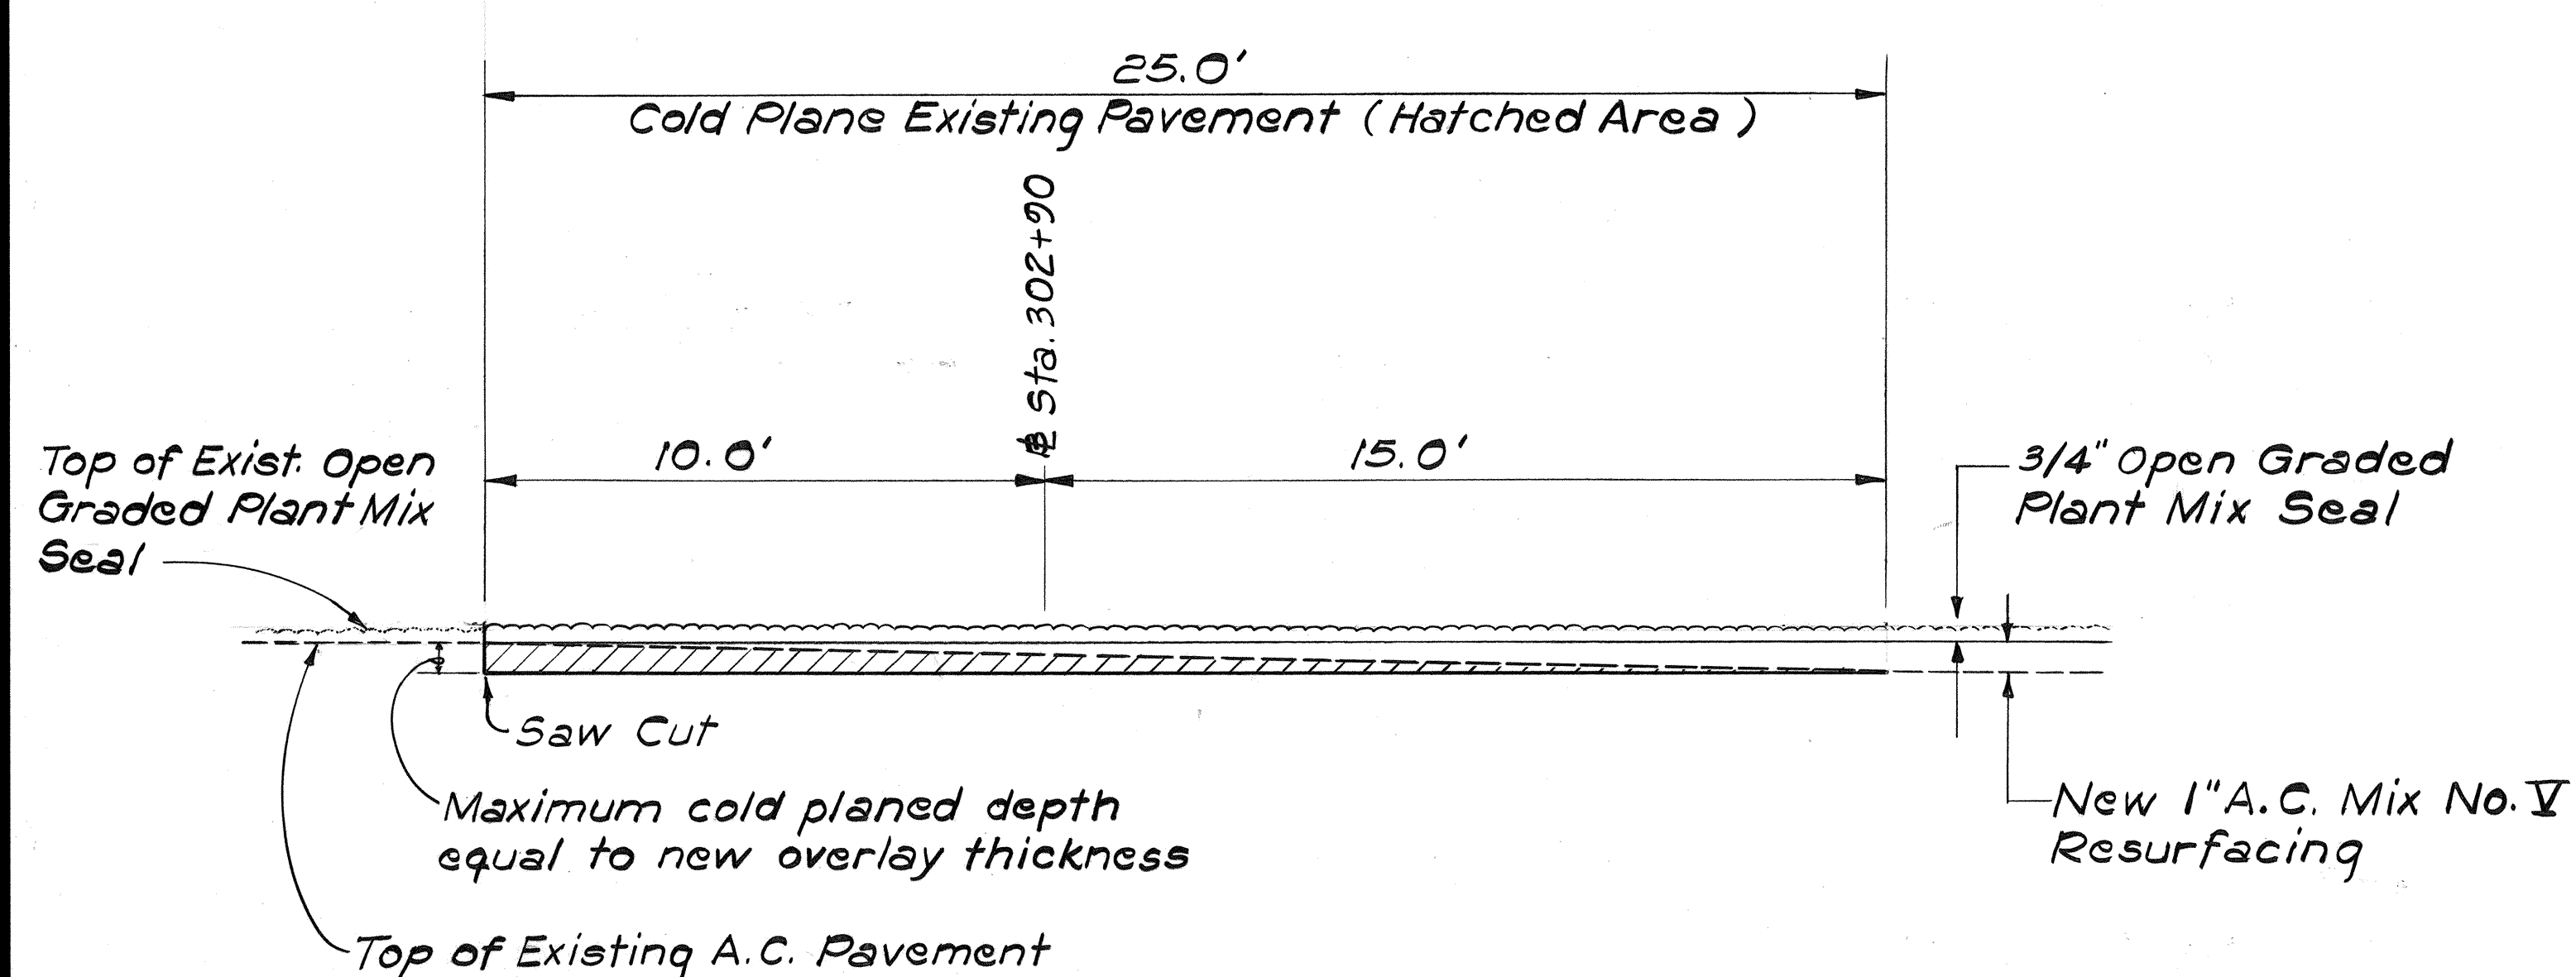


**COLD PLANE TRANSITION DETAIL
TO EXISTING PAVEMENT AT BEGINNING OF PROJECT**
Not to Scale

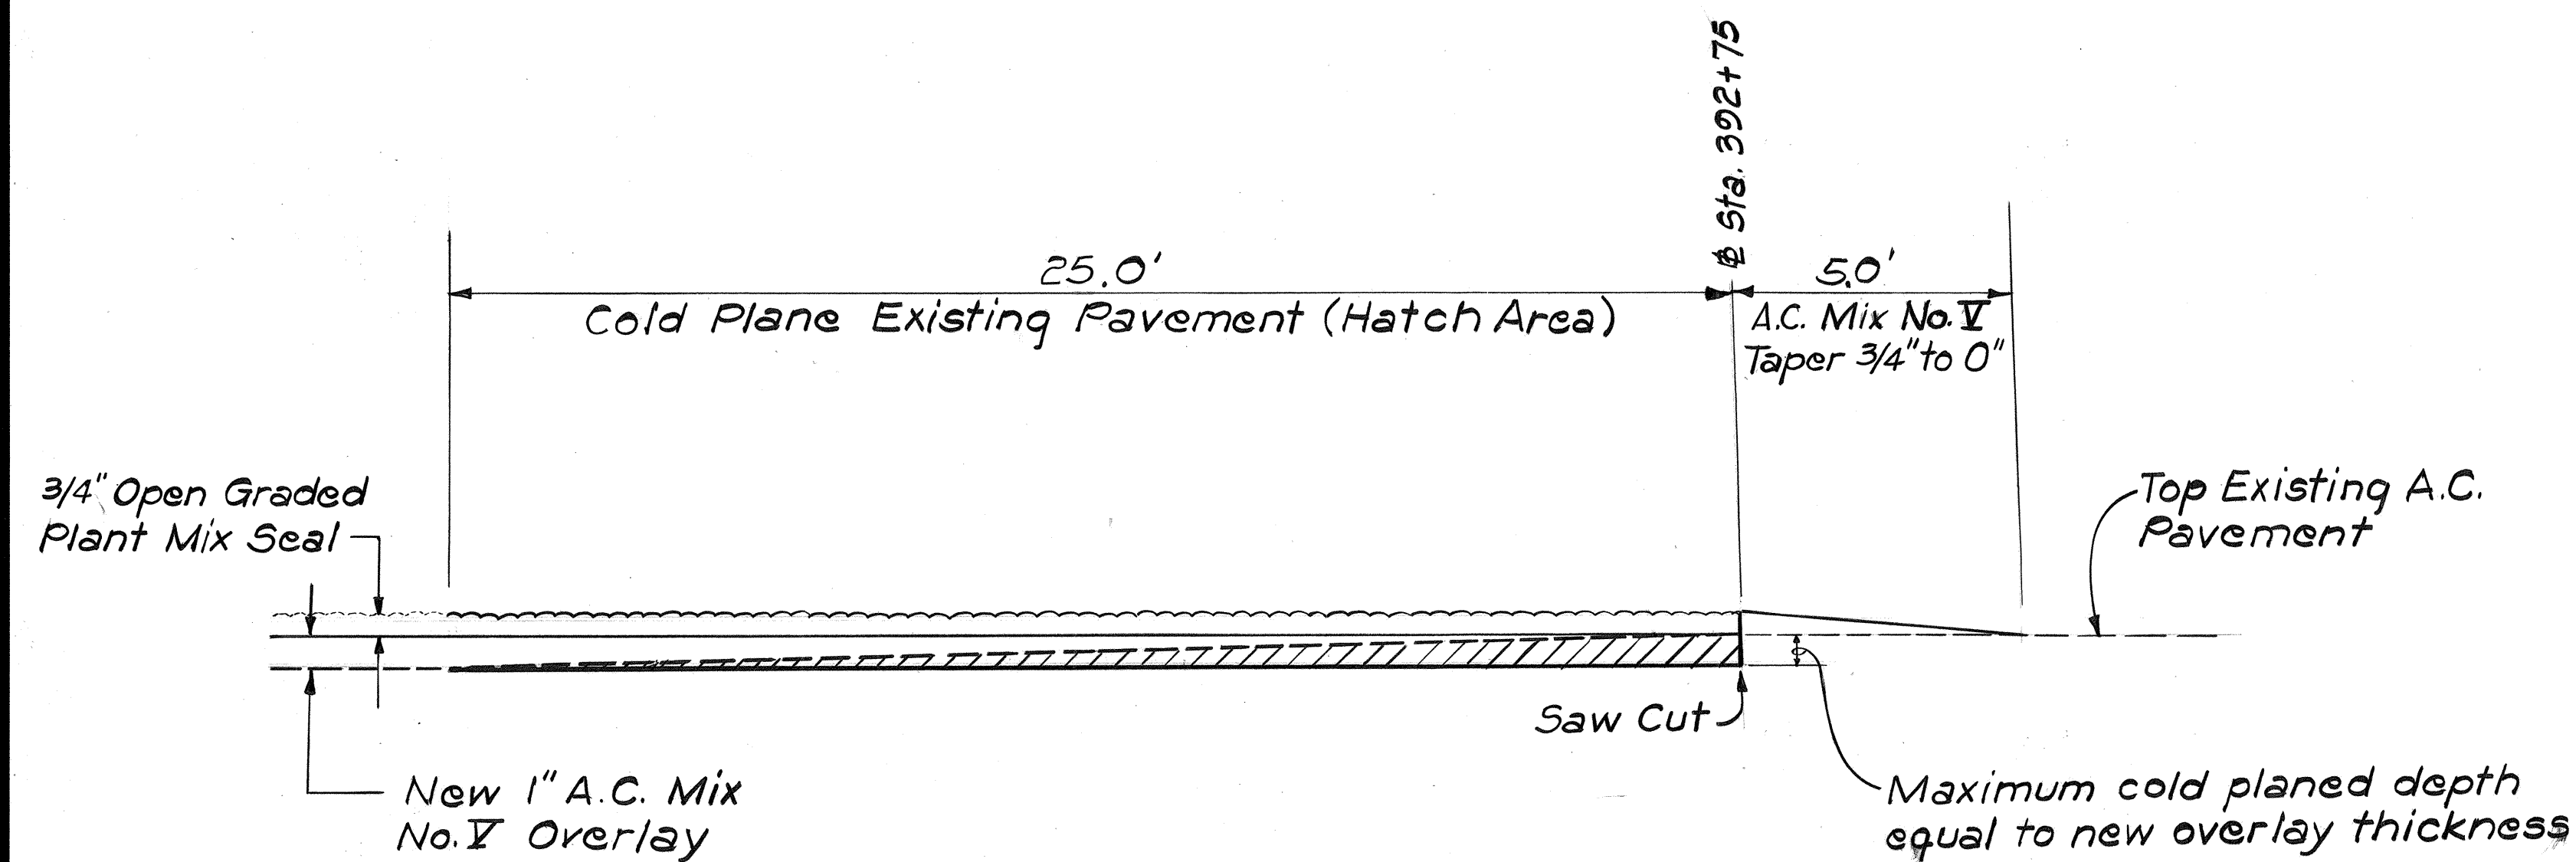

**COLD PLANE TRANSITION DETAIL
TO EXISTING PAVEMENT AT END OF PROJECT**
Not to Scale

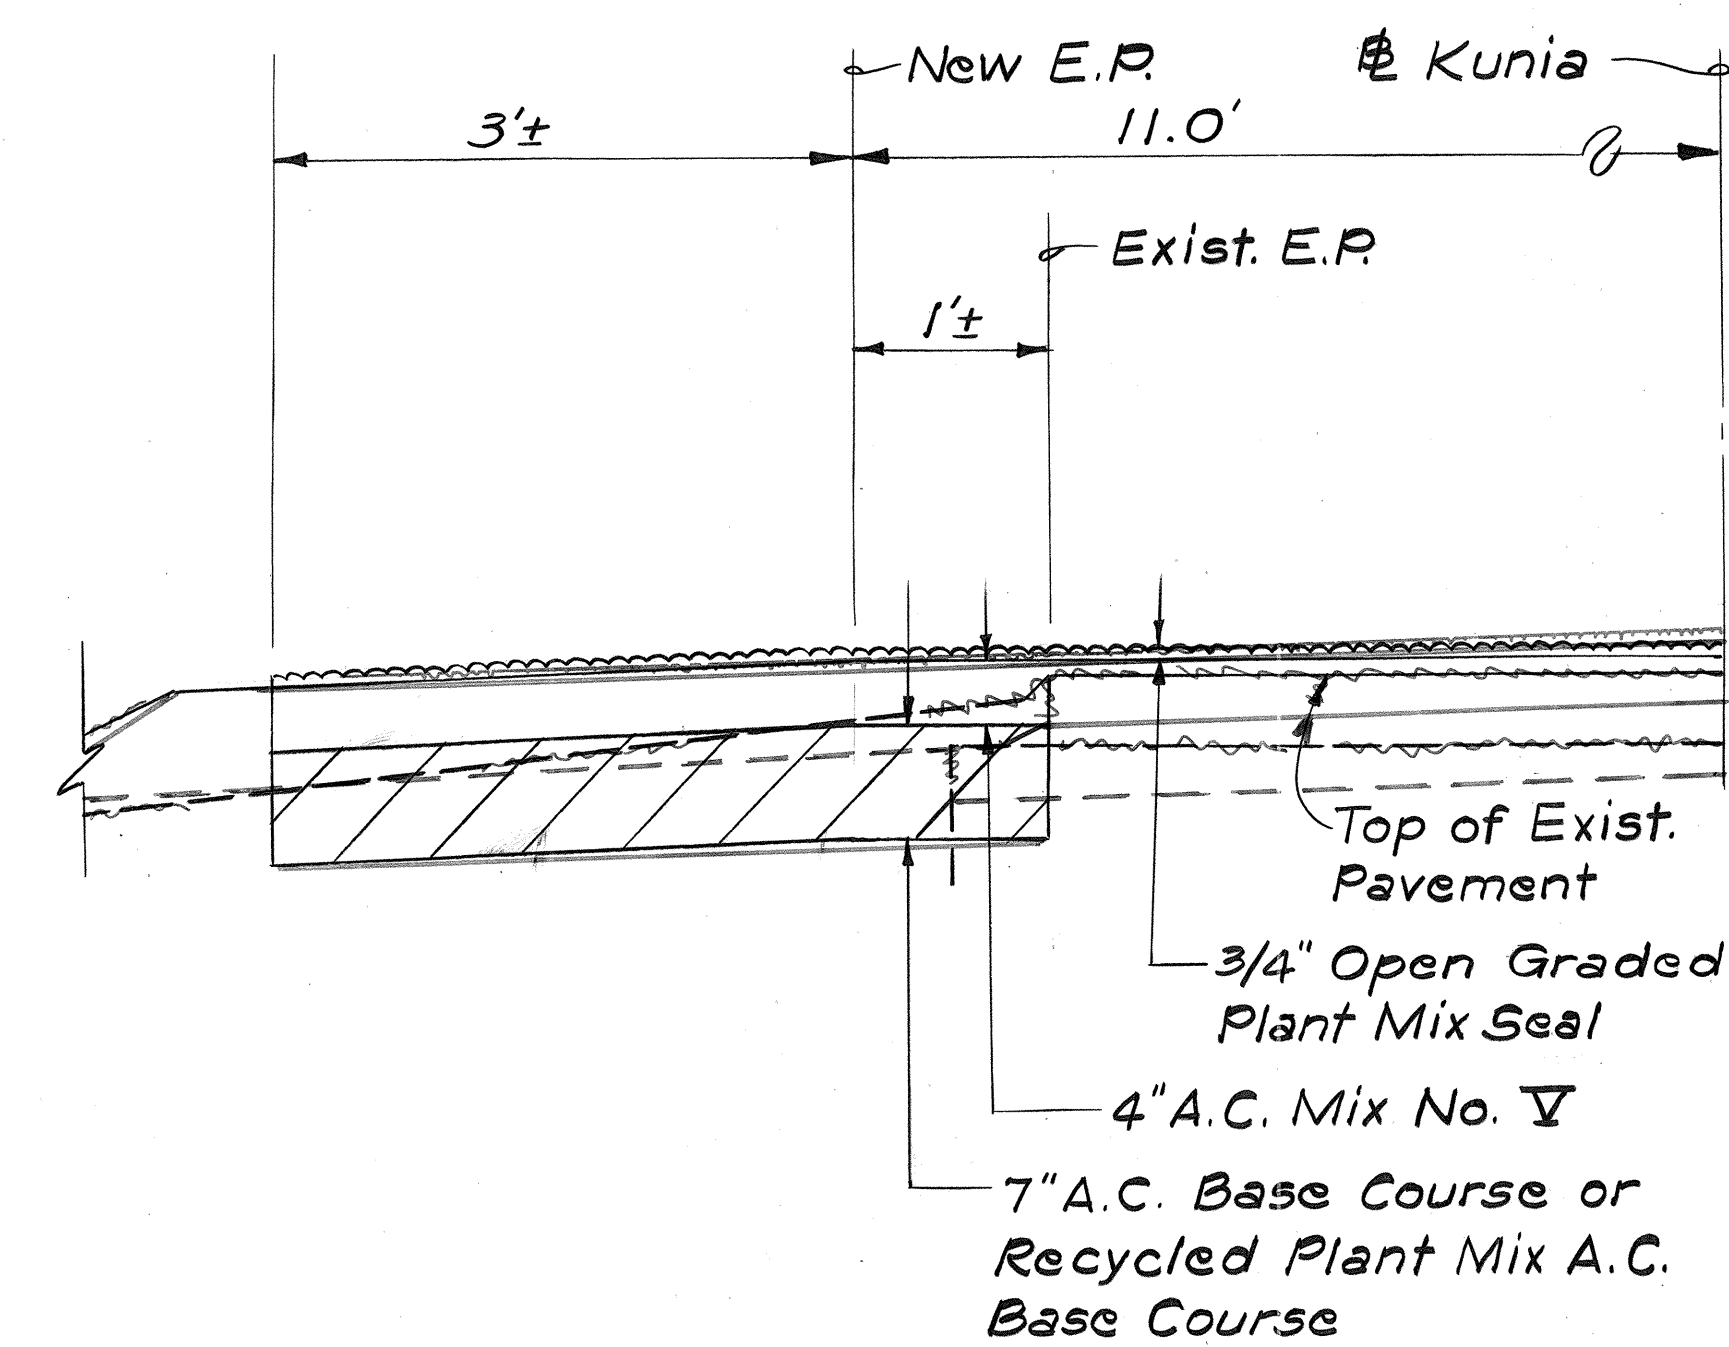

**Sta 374+50 to Sta 380+00
DETAIL ROADWAY WIDENING
AND PAVED SHOULDER**
Scale: 1"=1'-0"

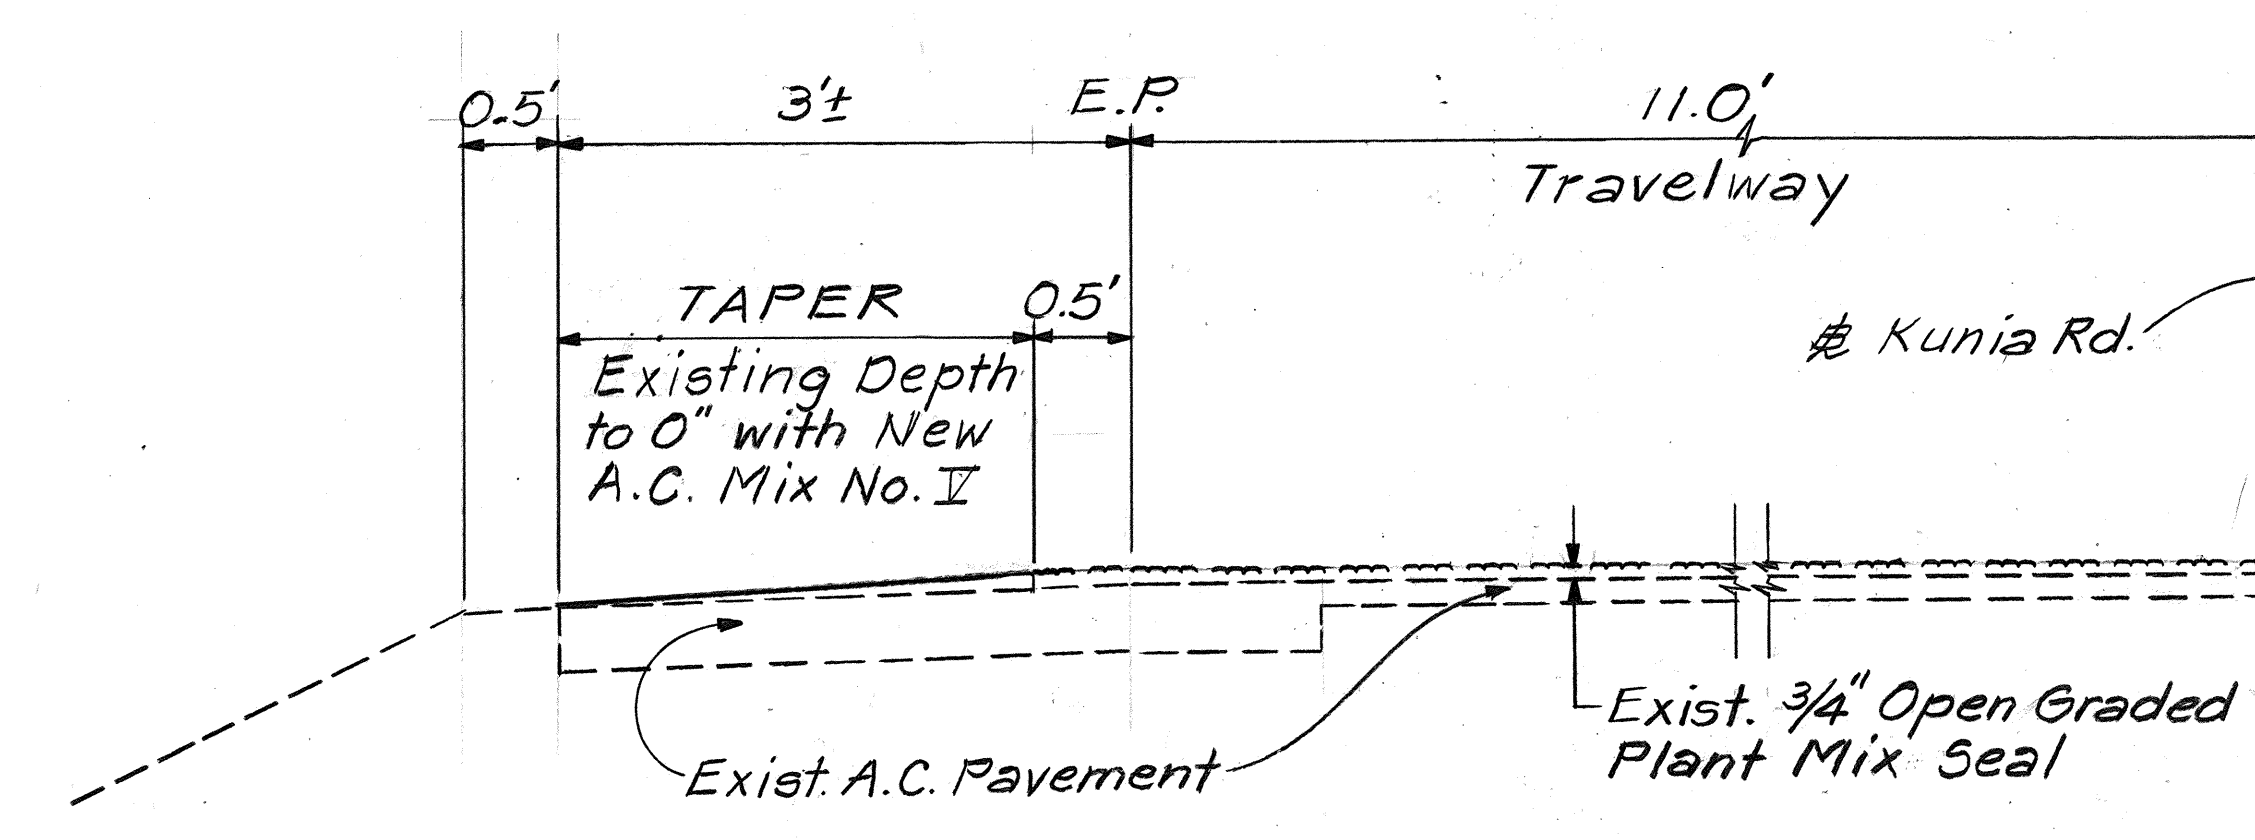

TYPICAL DETAIL - SHOULDER TAPER
Sta. 32+90 to Sta. 185+00 Lt. & Sta. 37+85 to Sta. 185+00 Rt.
Scale: 1"=1'-0"

DATE	_____
DESIGNED BY	_____
CHECKED BY	_____
NO.	_____

8/16/84	Added "TYPICAL DETAIL - SHOULDER TAPER" Sta. 32+90 to Sta. 185+00 Lt. & Sta. 37+85 to Sta. 185+00 Rt.
DATE	REVISION

STATE OF HAWAII
DEPARTMENT OF TRANSPORTATION
HIGHWAYS DIVISION

**TYPICAL SECTIONS
& DETAILS**

KUNIA ROAD RESURFACING
F.A. PROJECT No. RS-0750(7)

Scale: As shown Date: April, 1984

SHEET No. 2 OF 2 SHEETS