	INDEX TO DRAWINGS
SHEET NO.	DESCRIPTION
	TITLE SHEET
2	STANDARD PLANS SUMMARY
3	GENERAL NOTES
4	TYPICAL SECTION & DETAILS
5-7	ROADWAY PLANS
8-12	SIGNING & PAVEMENT MARKING
	PLANS & DETAILS
3	
·	
	,
). 2	


STATE OF HAWAII


DEPARTMENT OF TRANSPORTATION
HIGHWAYS DIVISION
HONOLULU, HAWAII
"AS-BUILT"
PLANS FOR

KUNIA ROAD RESURFACING URBAN BOUNDRY TO WILIKINA DRIVE PROJECT NO. 7500A - 01-88M

DISTRICT OF WAHIAWA

ISLAND OF OAHU

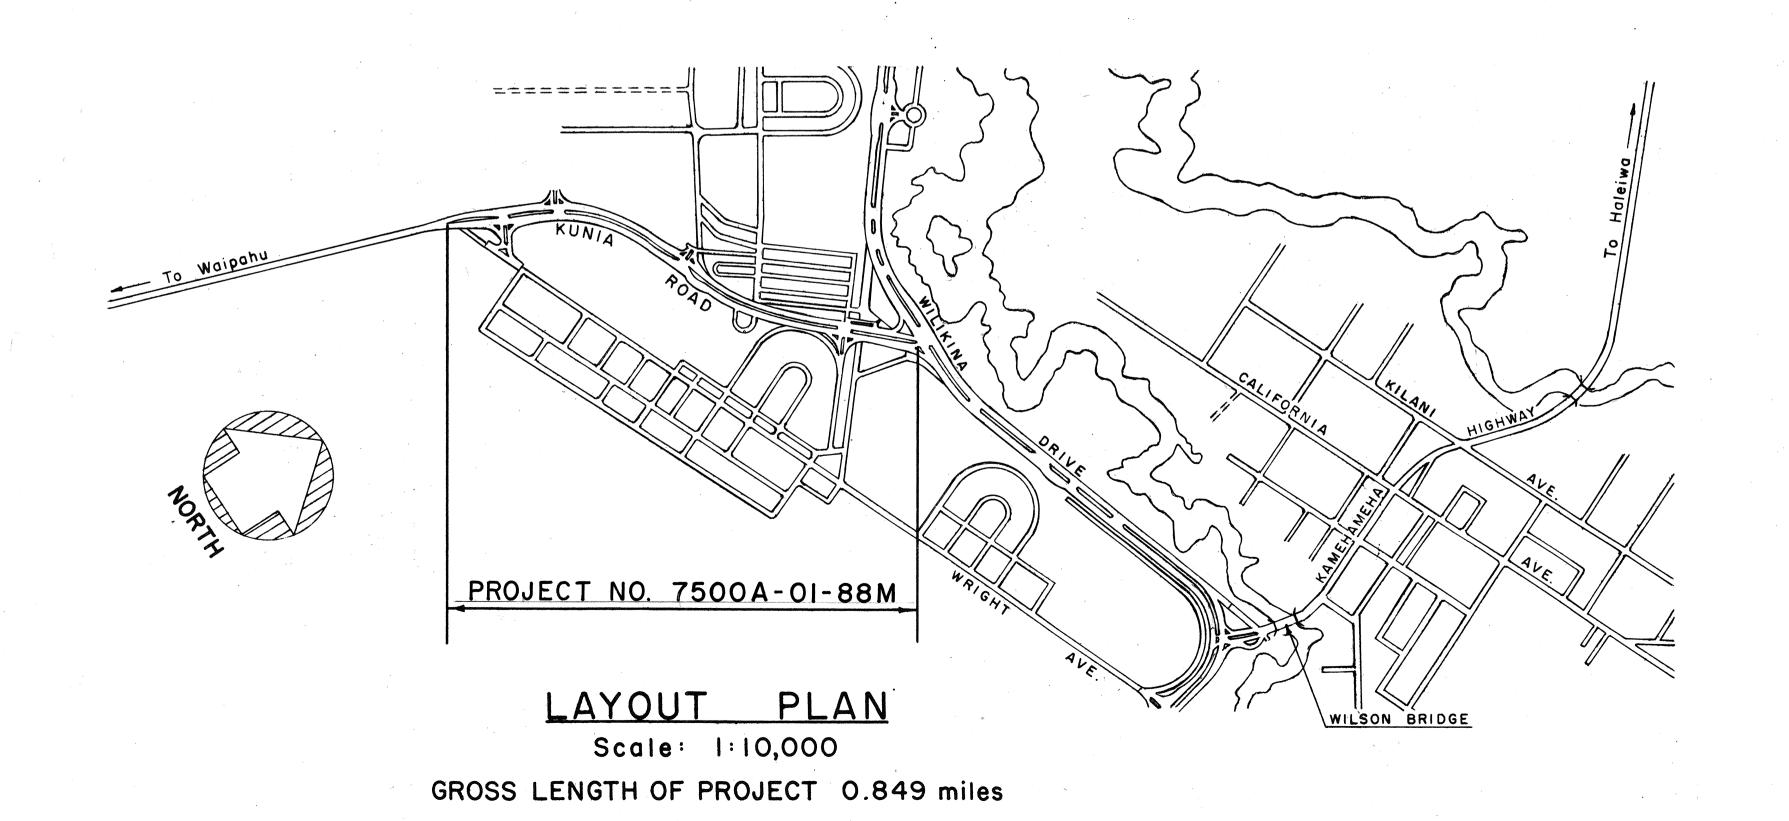

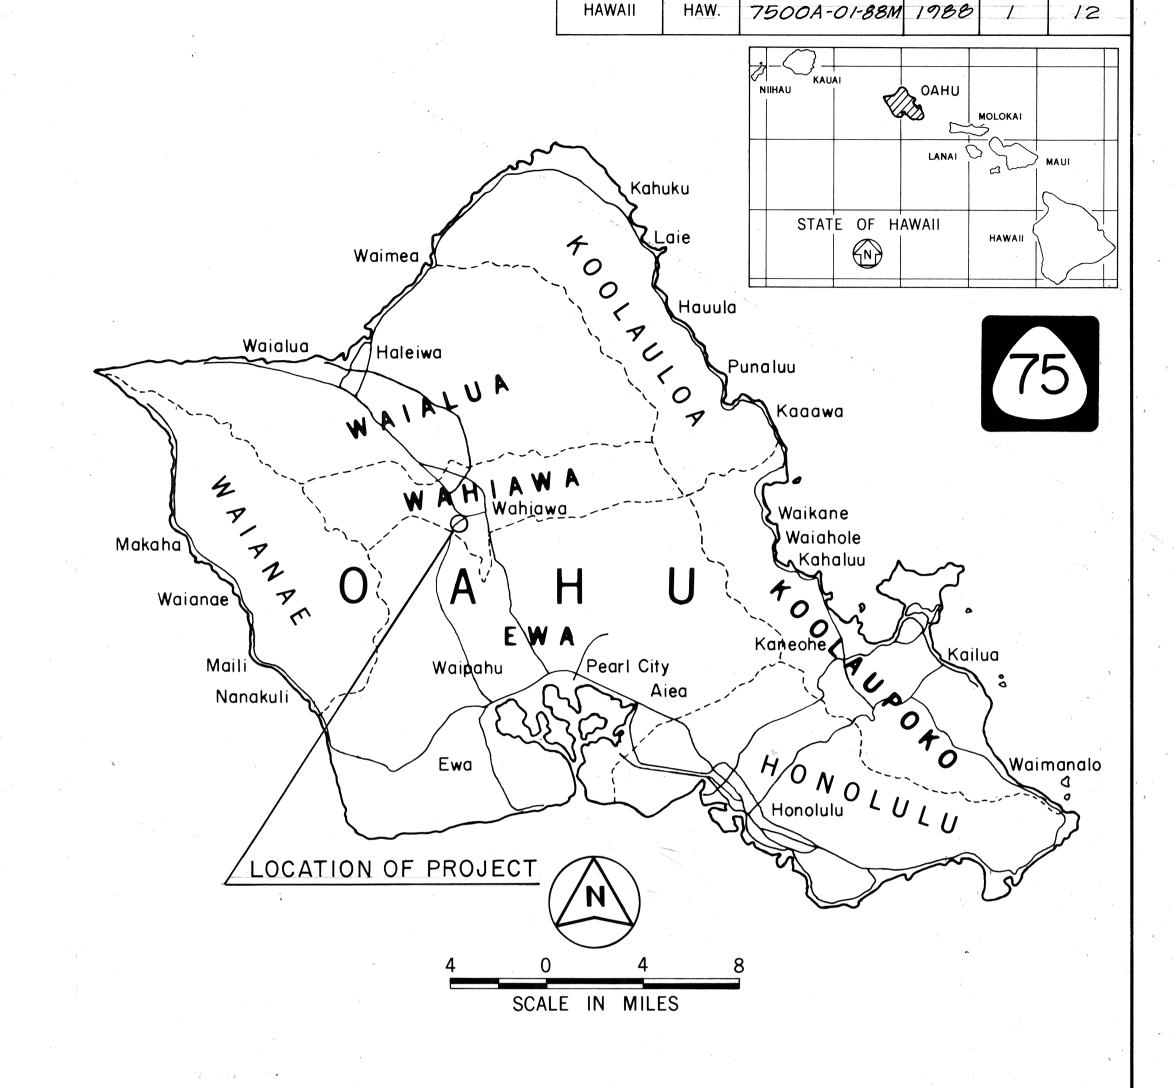

FED. ROAD DIST. NO.

NO SIGNIFICANT CHANGES WERE MADE DURING CONSTRUCTION ON THESE PLANS EXCEPT CHANGES IN THE ORIGINAL THEORETICAL QUANTITIES. FOR ACTUAL QUANTITIES, REFER TO PROJECT LEDGER AND/OR COMPUTATION BOOK.

Muchael Diniega RESIDENT ENGINEER

3/3//89 DATE

DEPARTMENT OF TRANSPORTATION
STATE OF HAWAII

APPROVED:

Line 3/30/8

DIR. OF TRANSPORTATION

DATE

8-4-0-00