
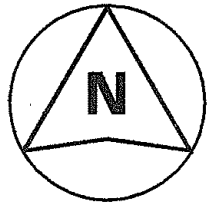
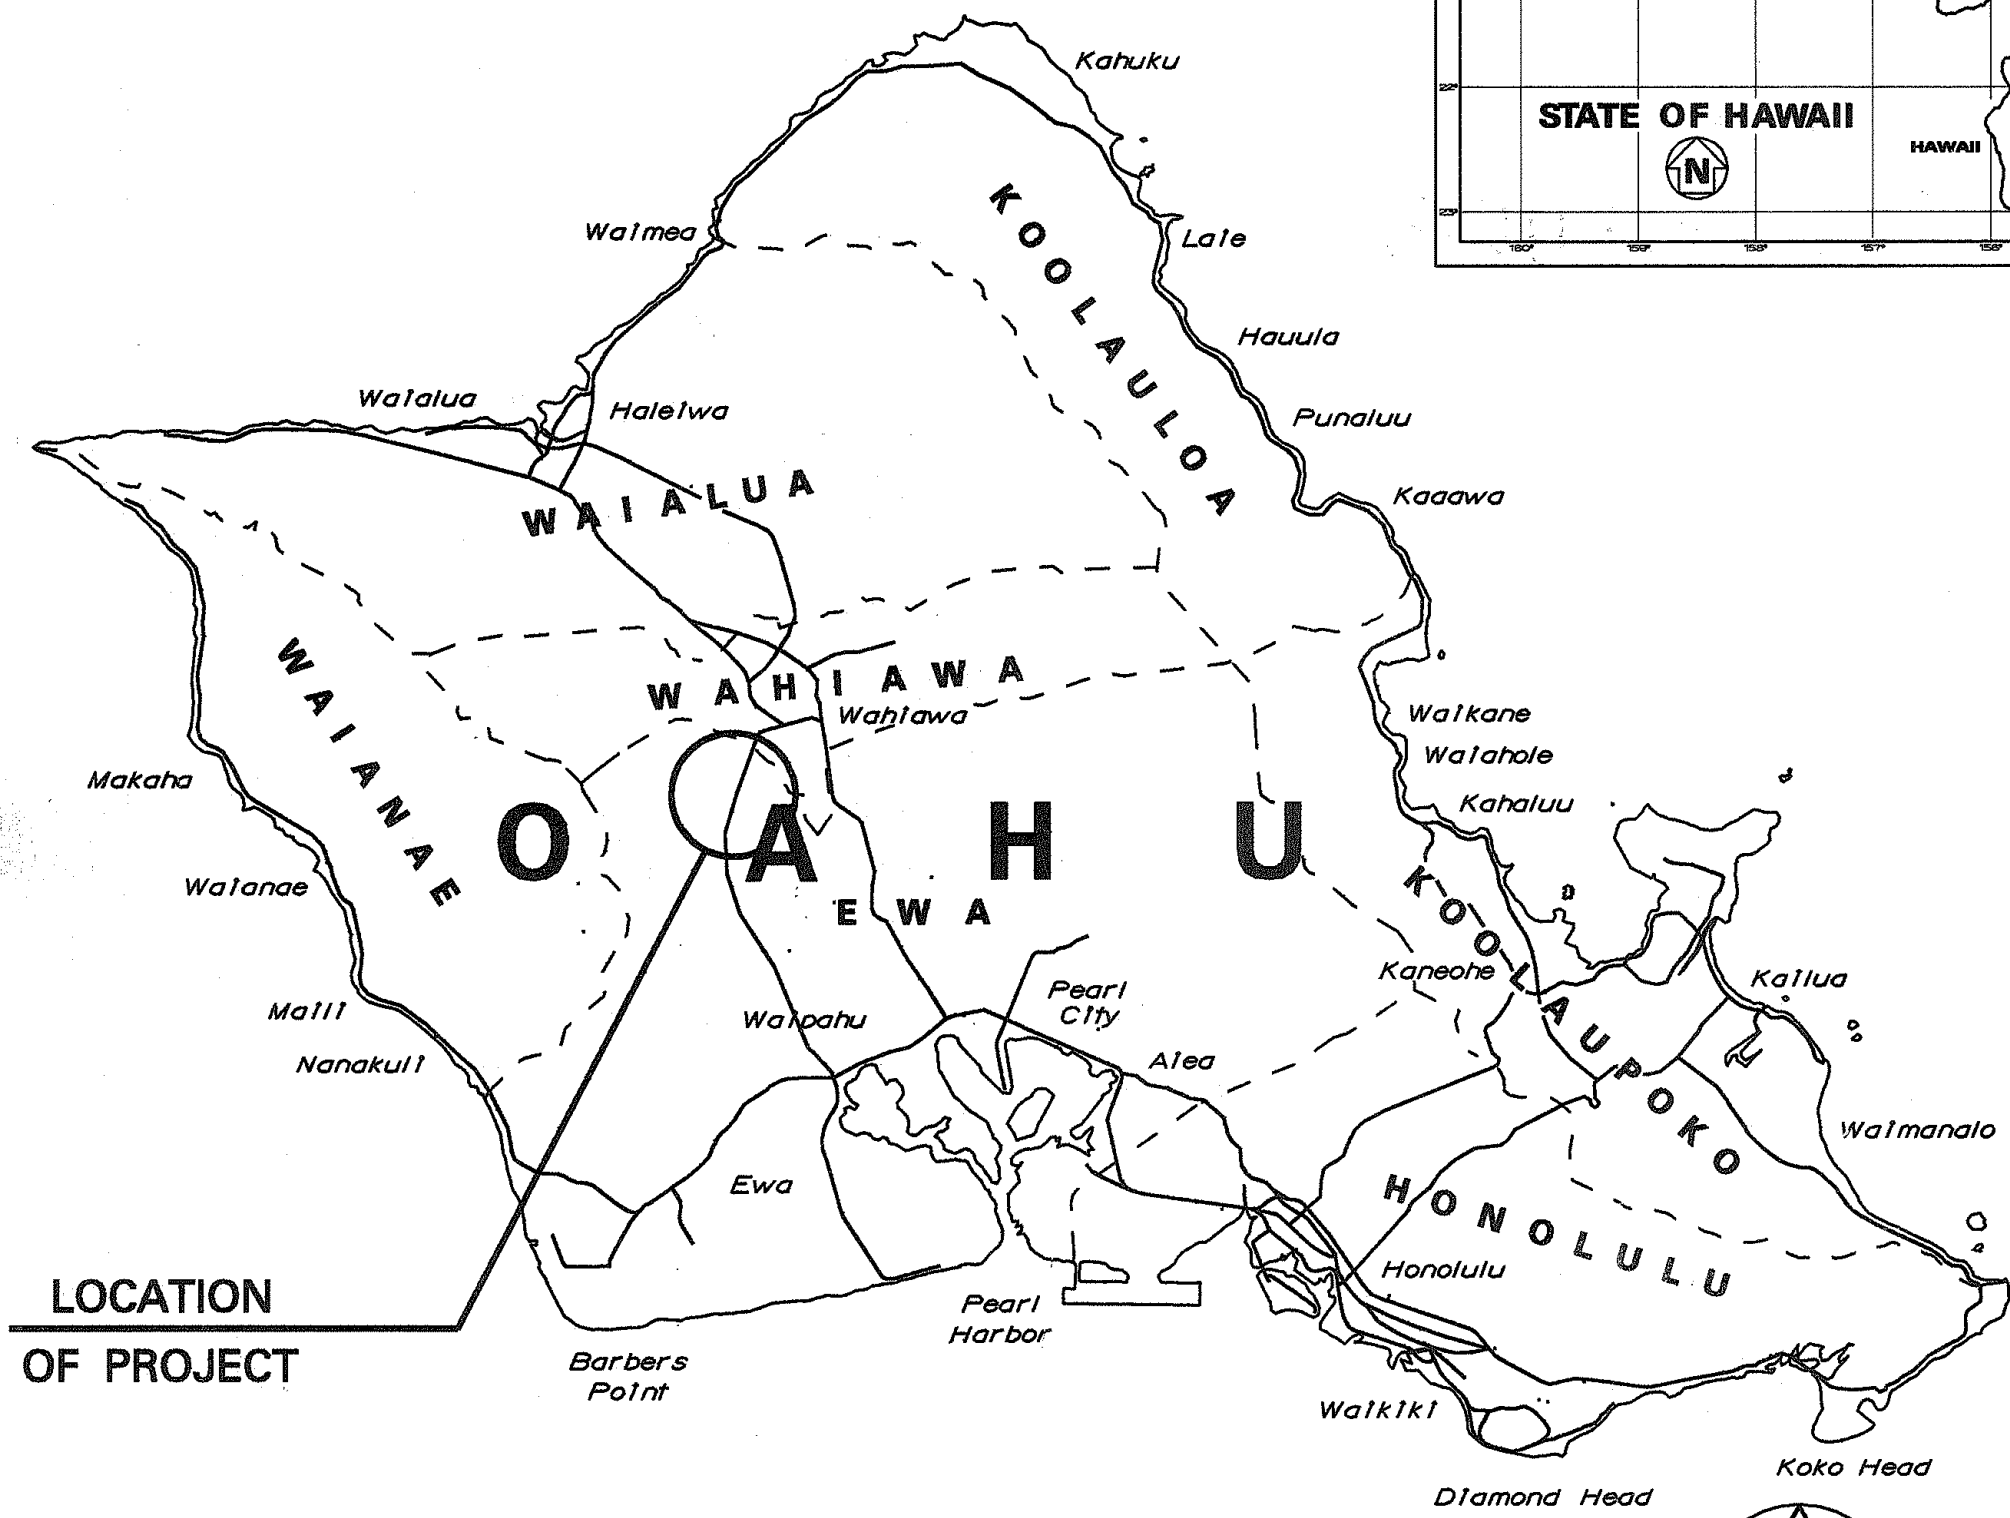


| INDEX TO DRAWINGS |                                                          |
|-------------------|----------------------------------------------------------|
| SHEET NO.         | DESCRIPTION                                              |
| 1                 | TITLE SHEET                                              |
| 2                 | STANDARD PLANS SUMMARY                                   |
| 3                 | GENERAL NOTES & LEGEND                                   |
| 4                 | NPDES GENERAL NOTES                                      |
| 5                 | TYPICAL SECTIONS                                         |
| 6                 | MISCELLANEOUS DETAILS                                    |
| 7 - 15            | PLAN                                                     |
| 16 - 17           | DRAINAGE DETAILS                                         |
| 18 - 20           | MELT DETAILS                                             |
| 21 - 31           | PAVEMENT MARKING & SIGNING<br>PLANS, DETAILS & SCHEDULES |
|                   |                                                          |
|                   |                                                          |
|                   |                                                          |

STATE OF HAWAII  
DEPARTMENT OF TRANSPORTATION  
HIGHWAYS DIVISION  
HONOLULU, HAWAII  
**"AS-BUILT"**  
PLANS FOR  
**KUNIA ROAD RESURFACING**  
HAWAII COUNTRY CLUB TO KUNIA GATE  
**FEDERAL AID PROJECT NO. STP-0750(9)**  
DISTRICT OF EWA  
ISLAND OF OAHU

| FED. ROAD DIST. NO. | STATE | PROJ. NO.   | FISCAL YEAR | SHEET NO. | TOTAL SHEETS |
|---------------------|-------|-------------|-------------|-----------|--------------|
| HAWAII              | HAW.  | STP-0750(9) | 1995        | 1         | 31           |

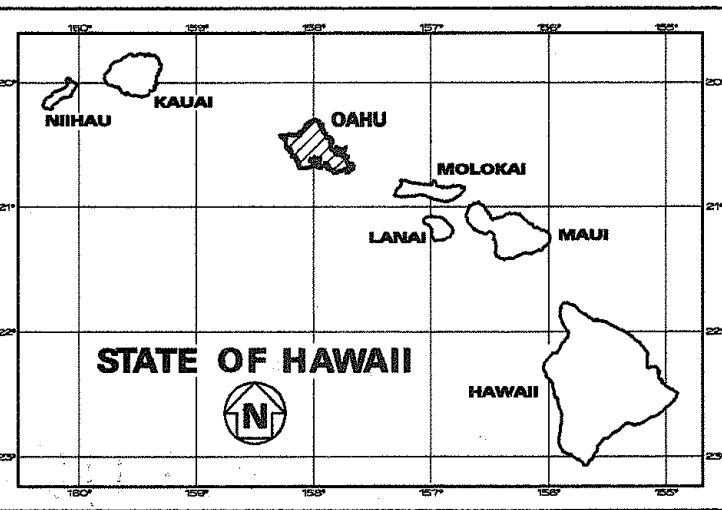


SCALE IN MILES

MILE POST 4.00 TO MILE POST 7.03


**DESIGN DESIGNATION**

ADT (1995).....10,700  
ADT (2005).....16,400  
V ..... 50 M.P.H.

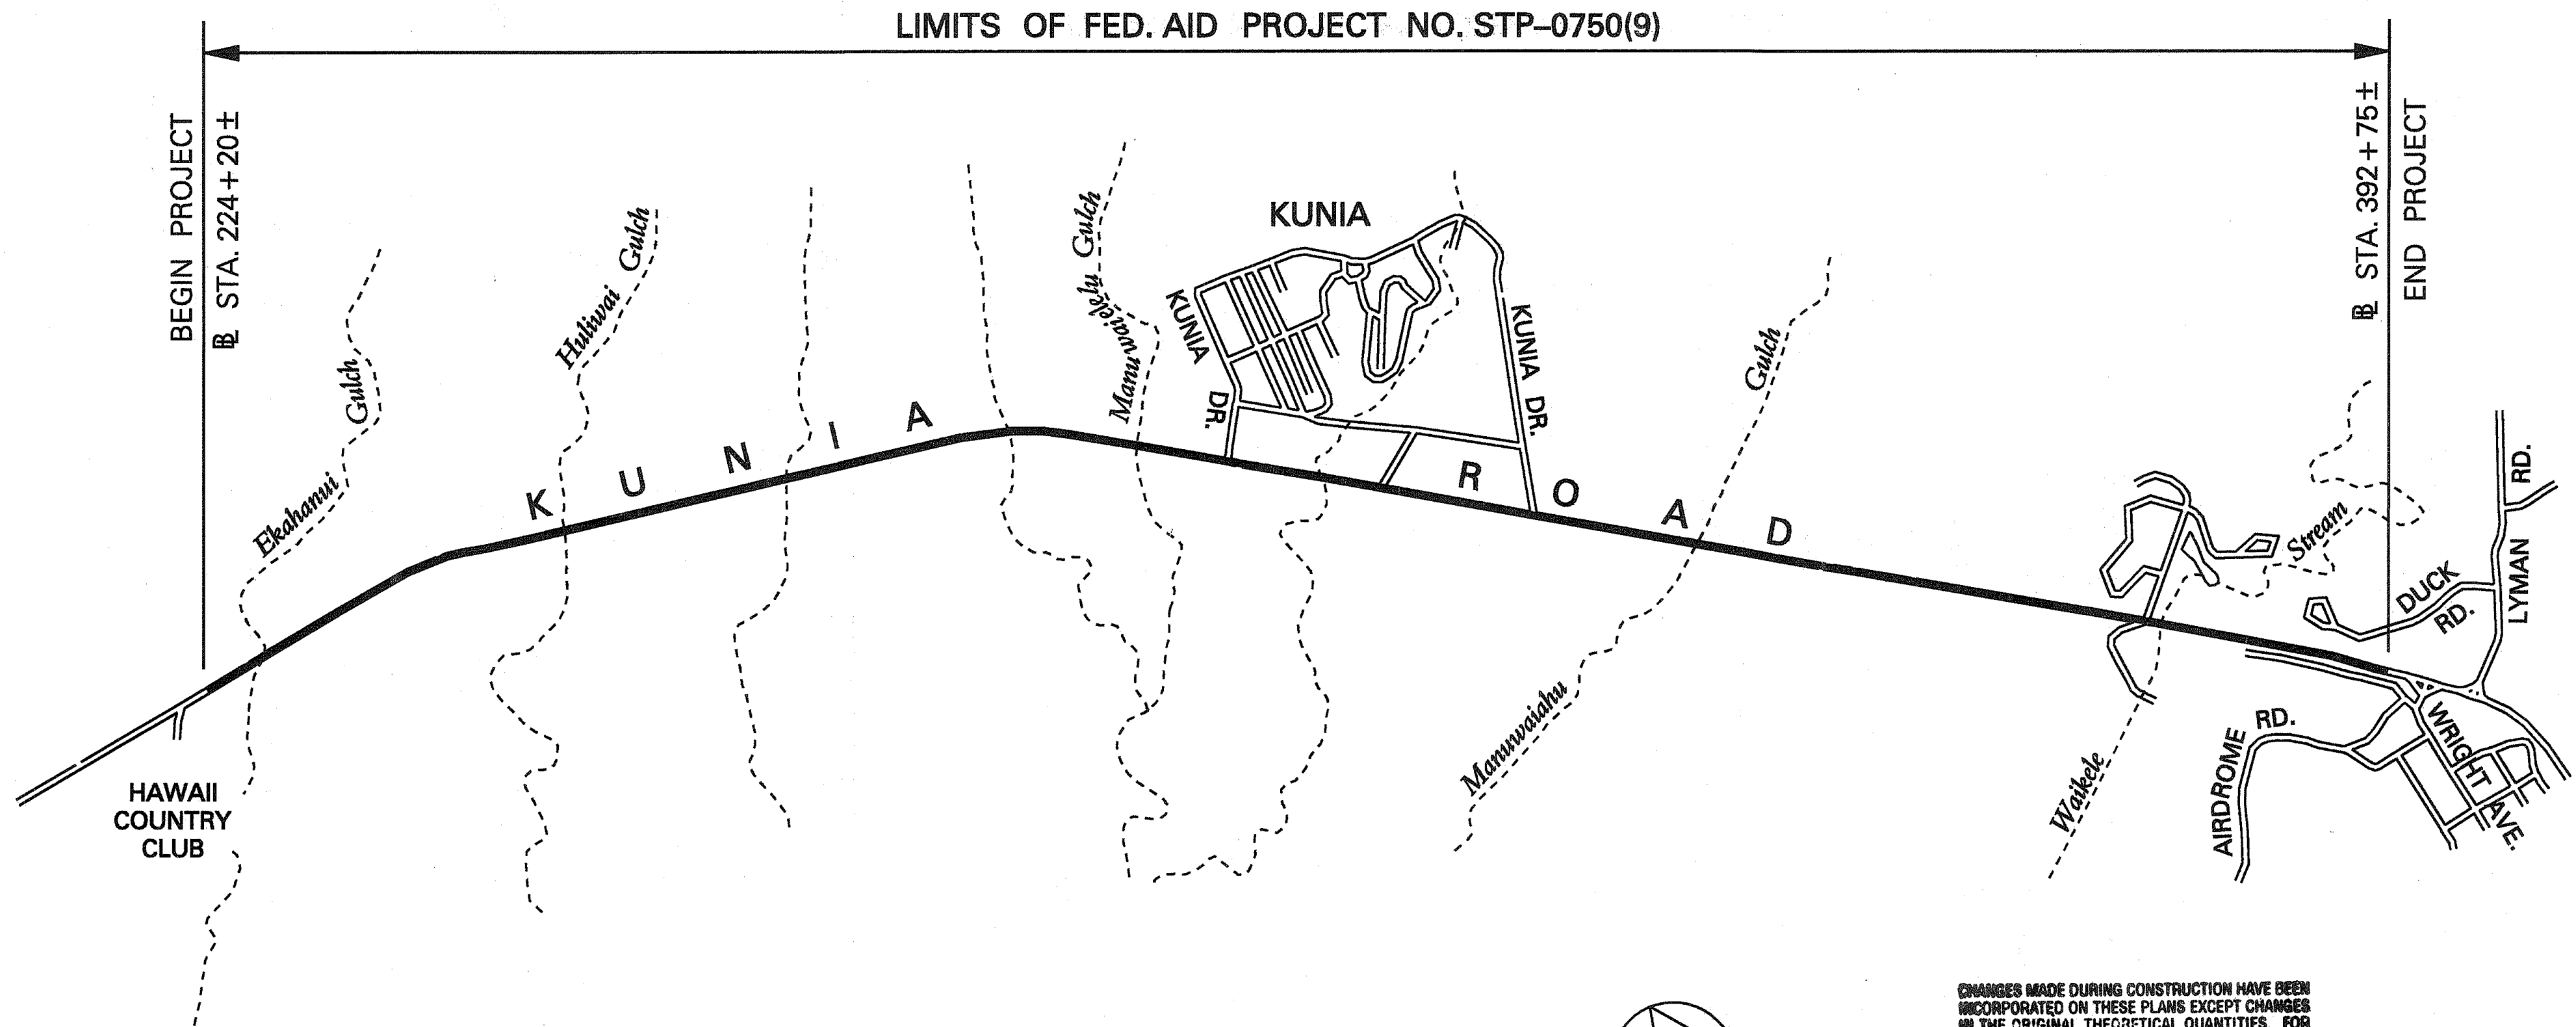

SCALE IN THOUSANDS OF FEET

**LAYOUT PLAN**  
SCALE: 1"=1000'  
LENGTH OF PROJECT.....3.03 MILES

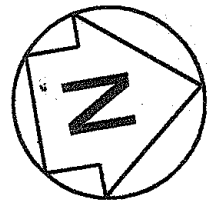

CHANGES MADE DURING CONSTRUCTION HAVE BEEN INCORPORATED ON THESE PLANS EXCEPT CHANGES IN THE ORIGINAL THEORETICAL QUANTITIES. FOR ACTUAL QUANTITIES, REFER TO PROJECT LEDGER AND/OR COMPUTATION BOOK.  
Killy Lu Sit 8/26/09  
RESIDENT ENGINEER DATE

DEPARTMENT OF TRANSPORTATION  
STATE OF HAWAII  
APPROVED: *Kayn Hayashida* 5/23/95  
DIR. OF TRANSPORTATION DATE

UNIT "D"  
DESIGNED BY  
ALLAN NISHIMURA  
P.S. & E.BY  
587-2244  
PHONE  
APRIL, 1995  
DATE