

STATE OF HAWAII


DEPARTMENT OF TRANSPORTATION

HIGHWAYS DIVISION HONOLULU, HAWAII

\*AS-BUILT PLANS FOR

KUNIA ROAD RESURFACING
KUNIA GATE TO WILIKINA DRIVE
FEDERAL AID PROJECT NO. STP-7500(1)

DISTRICT OF WAHIAWA
ISLAND OF OAHU

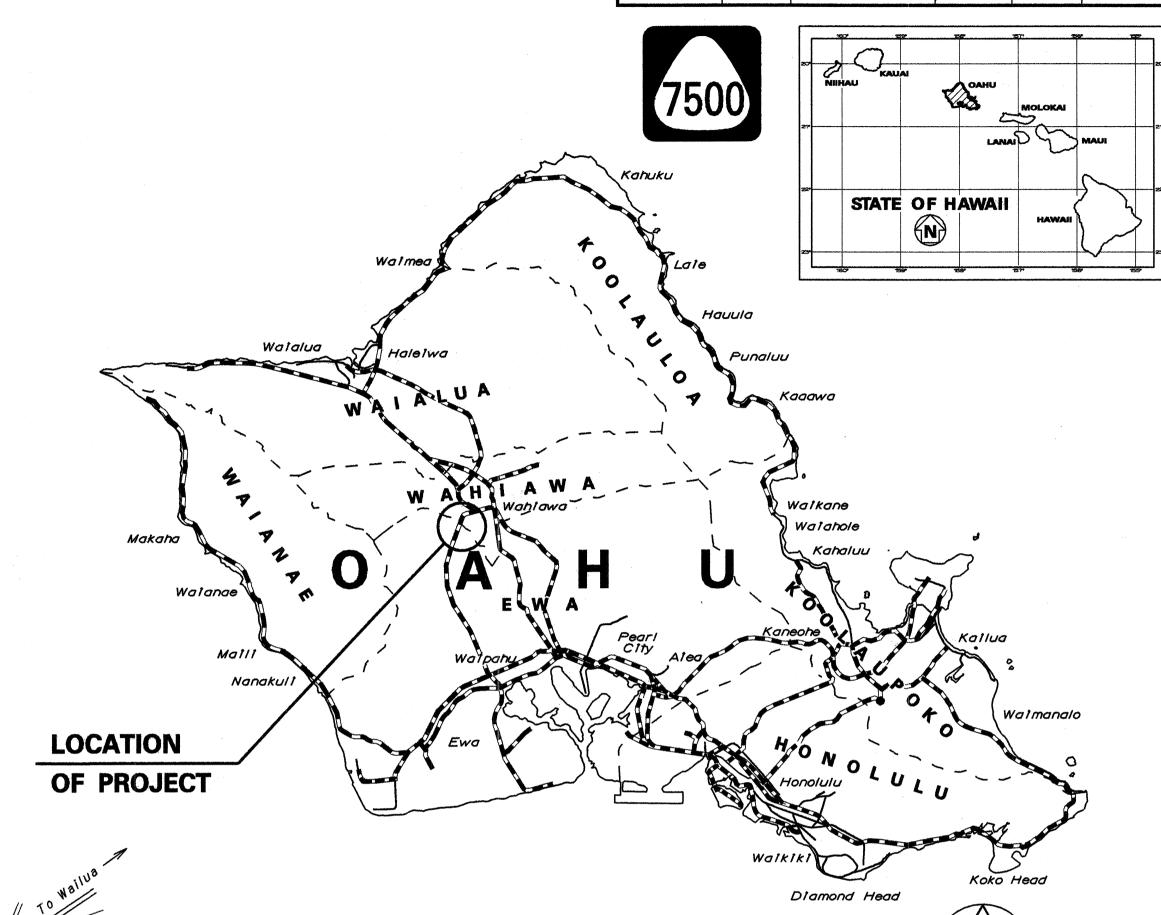


FED. ROAD DIST. NO. FISCAL SHEET YEAR NO.

23

1996

FED. AID PROJ. NO.

STP-7500(1)

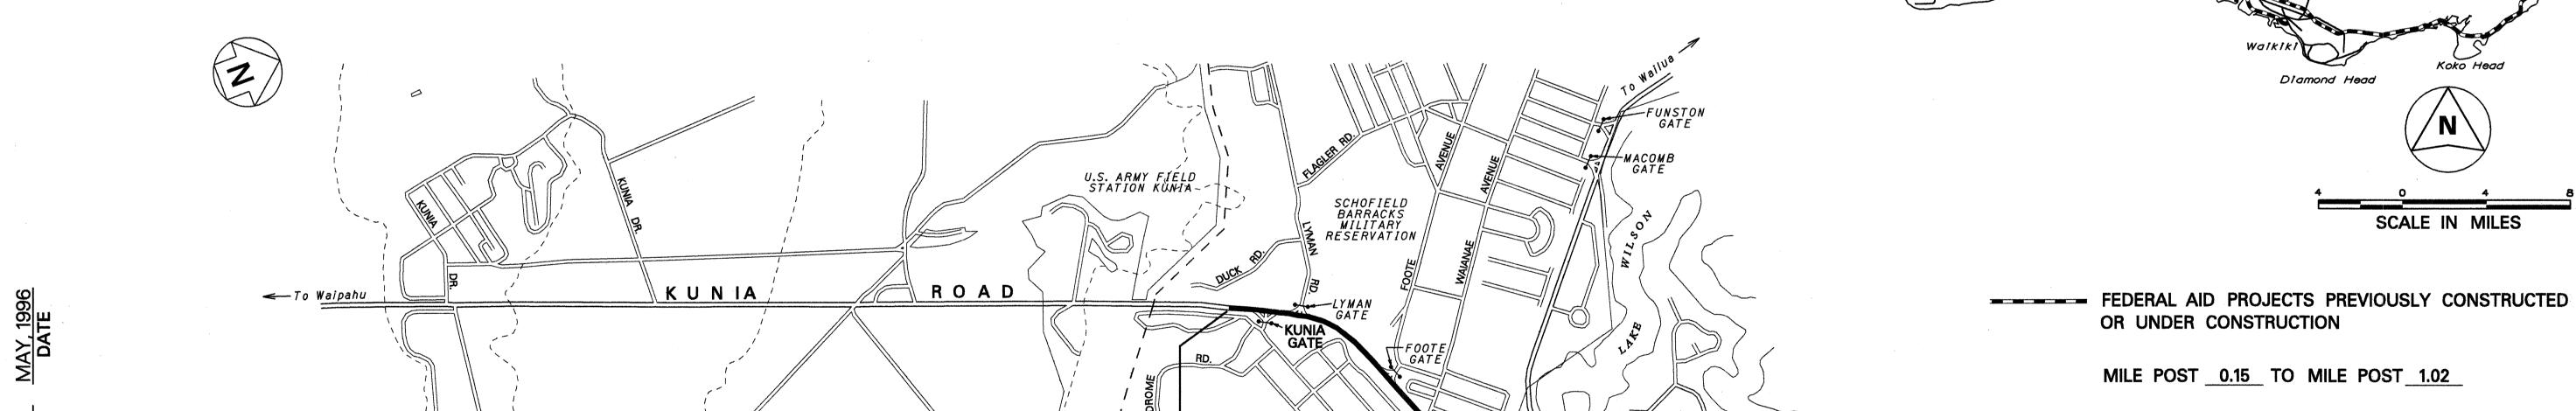

WHEELER AIR FORCE BASE

LIMITS OF PROJECT

CHANGES MADE DURING CONSTRUCTION HAVE BEEN INCORPORATED ON THESE PLANS EXCEPT CHANGES IN THE ORIGINAL THEORETICAL QUANTITES. FOR ACTUAL QUANTITIES, REFER TO PROJECT LEDGER AND/OR COMPUTATION BOOK.

Robert Shin
RESIDENT ENGINEER

3-3-99 DATE

GROSS LENGTH OF PROJECT..... 0.87 MILES

NET LENGTH OF PROJECT......0.87 MILES

1 0 1 2 3

SCALE IN THOUSAND FEET

DESIGN DESIGNATION

AD	T (1996)	20,600
AD	T (2006)	28,300
DH	V	2400
D		70/30
T		3.0%
V		55 M.P.

DEPARTMENT OF TRANSPORTATION STATE OF HAWAII

APPROVED:

Tazn Gayarhida 5/23/96

DIR. OF TRANSPORTATION

DATE