
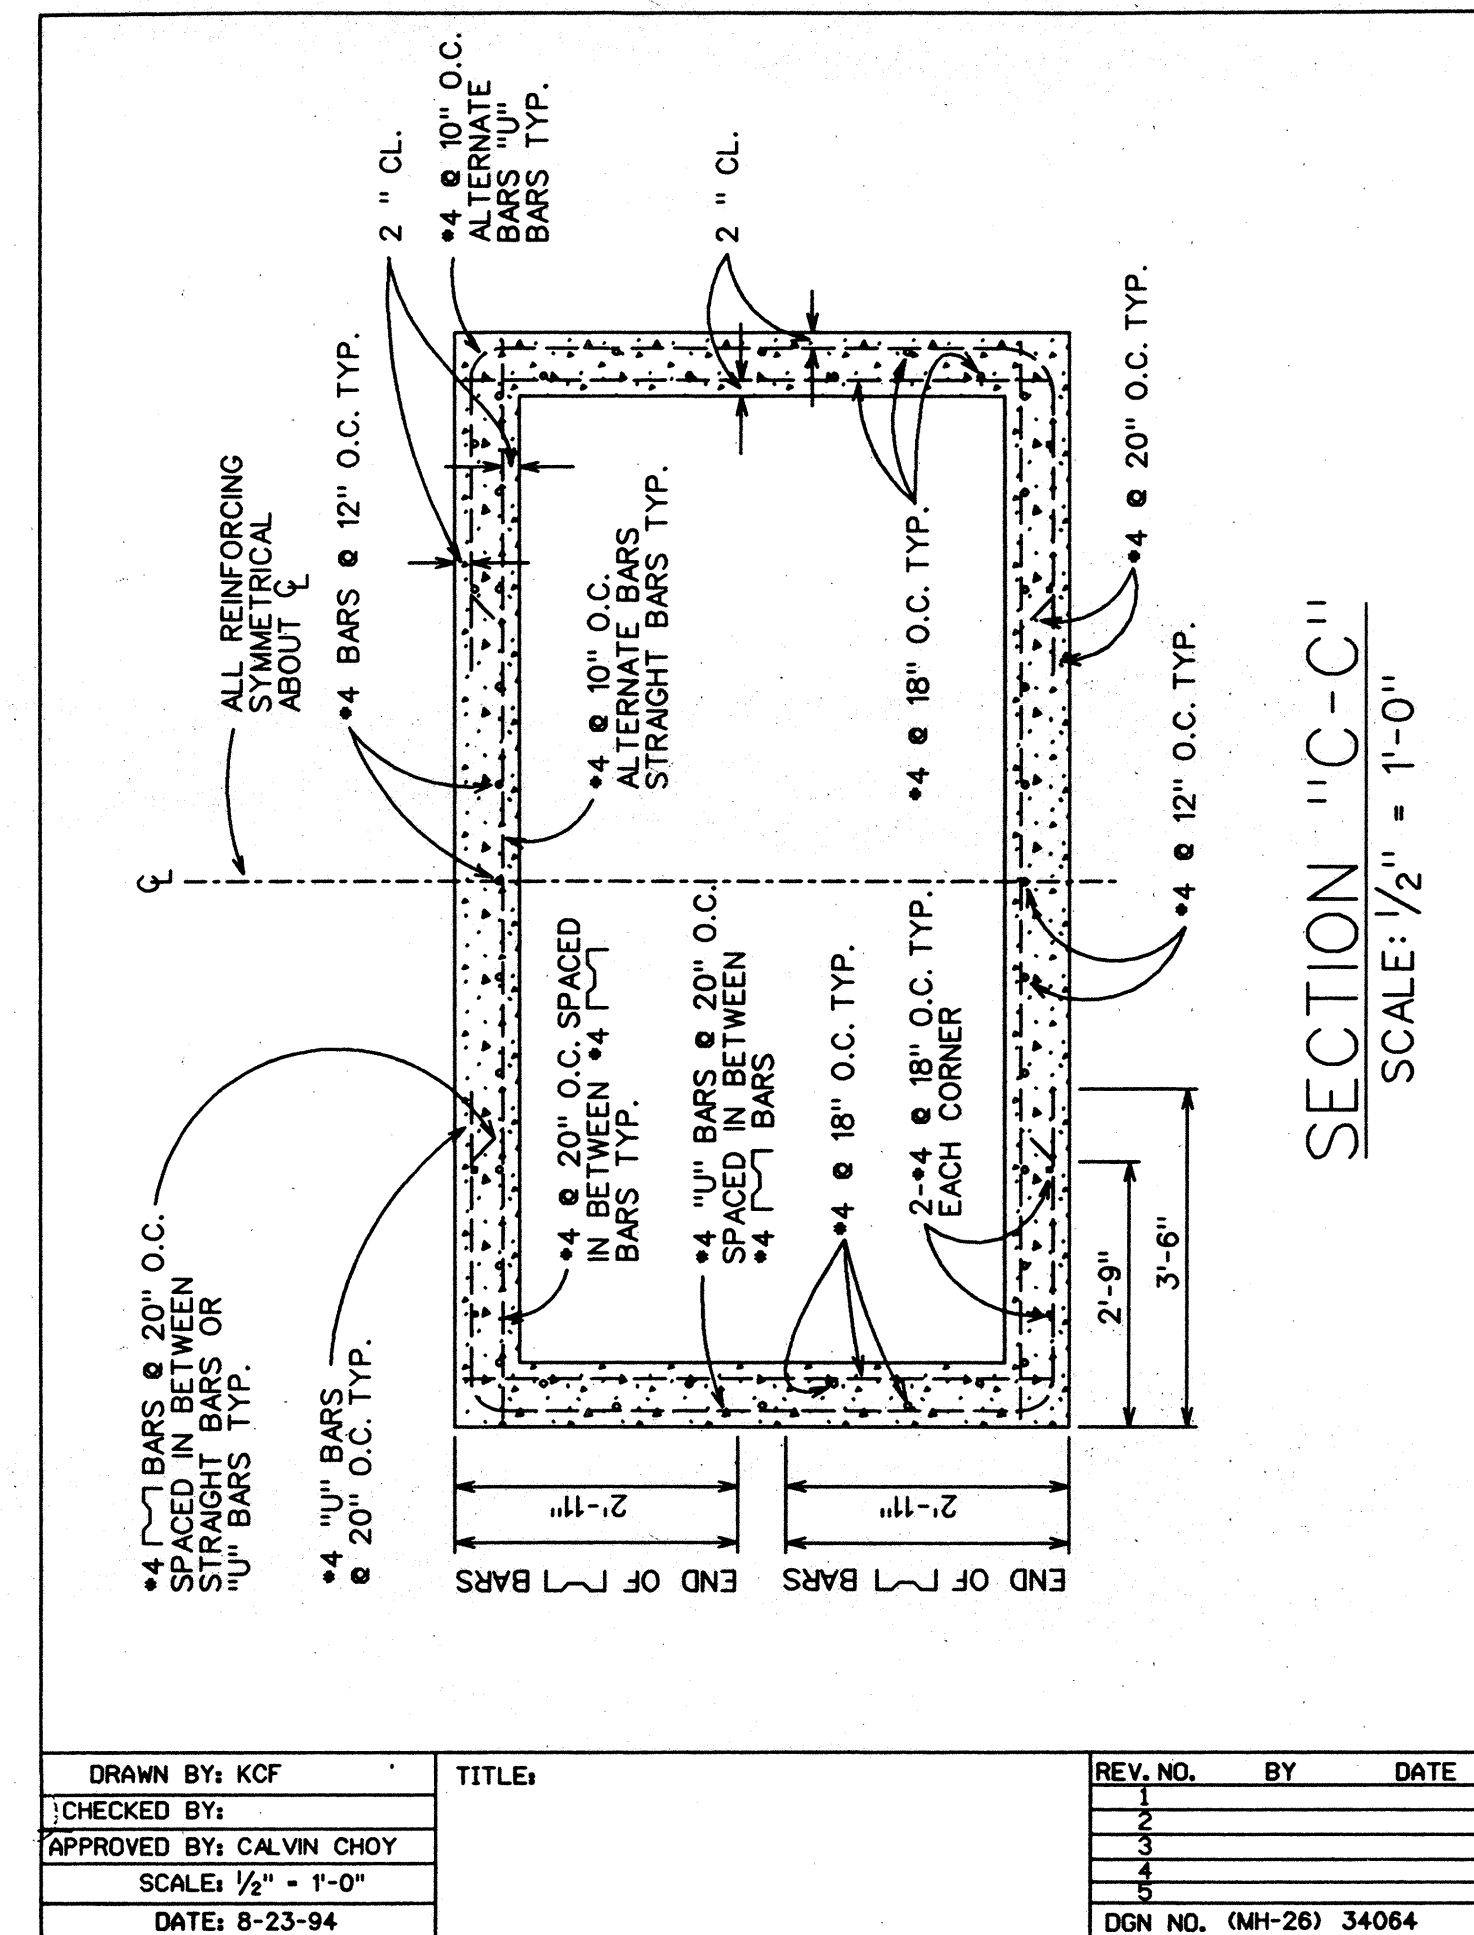
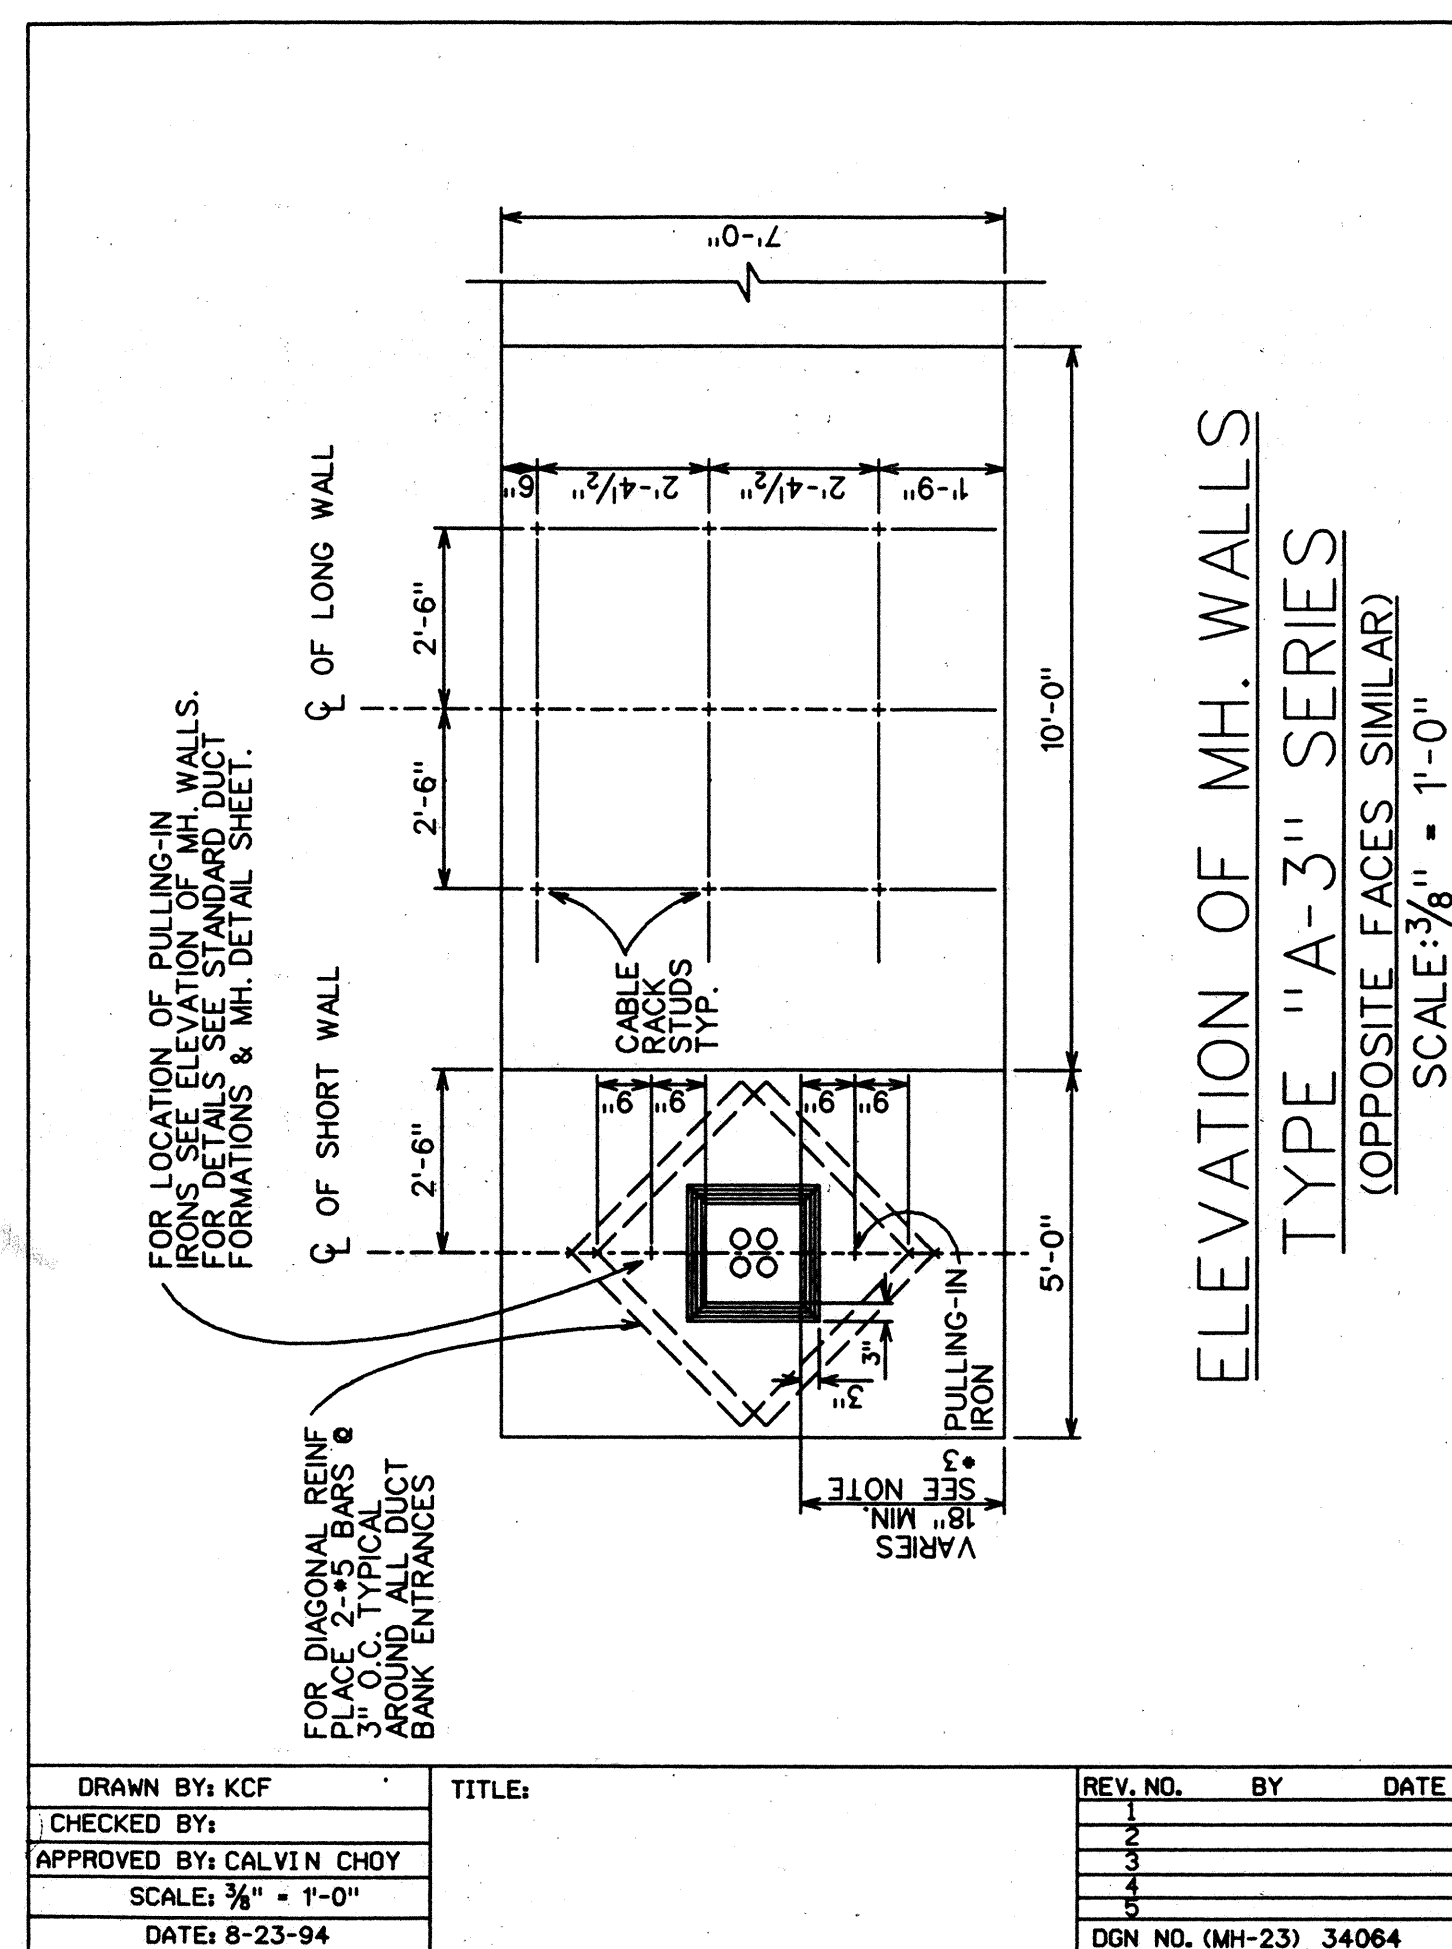
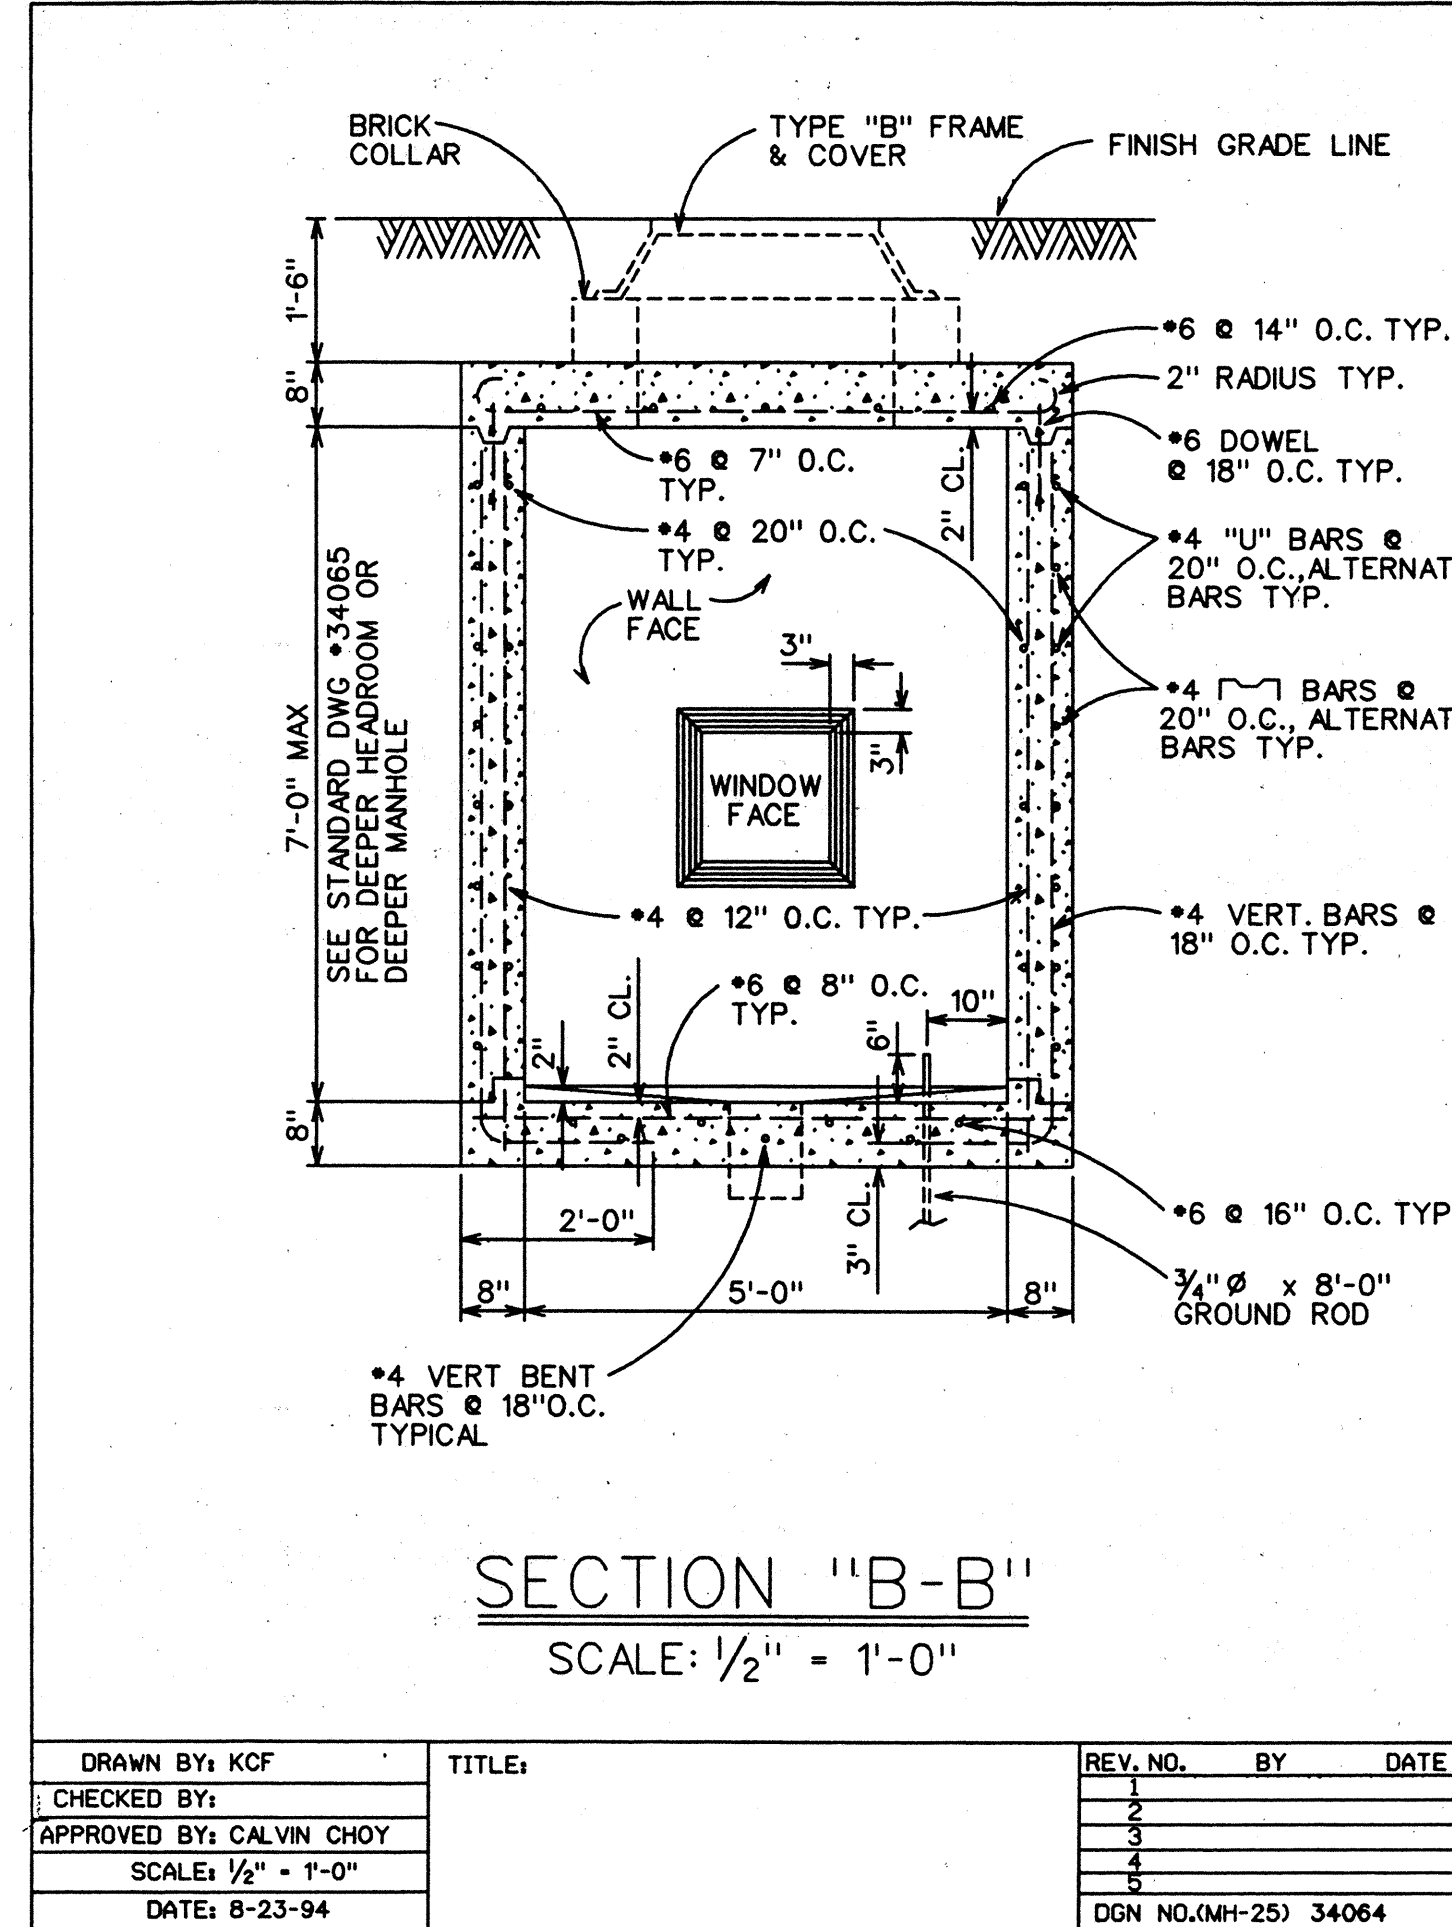
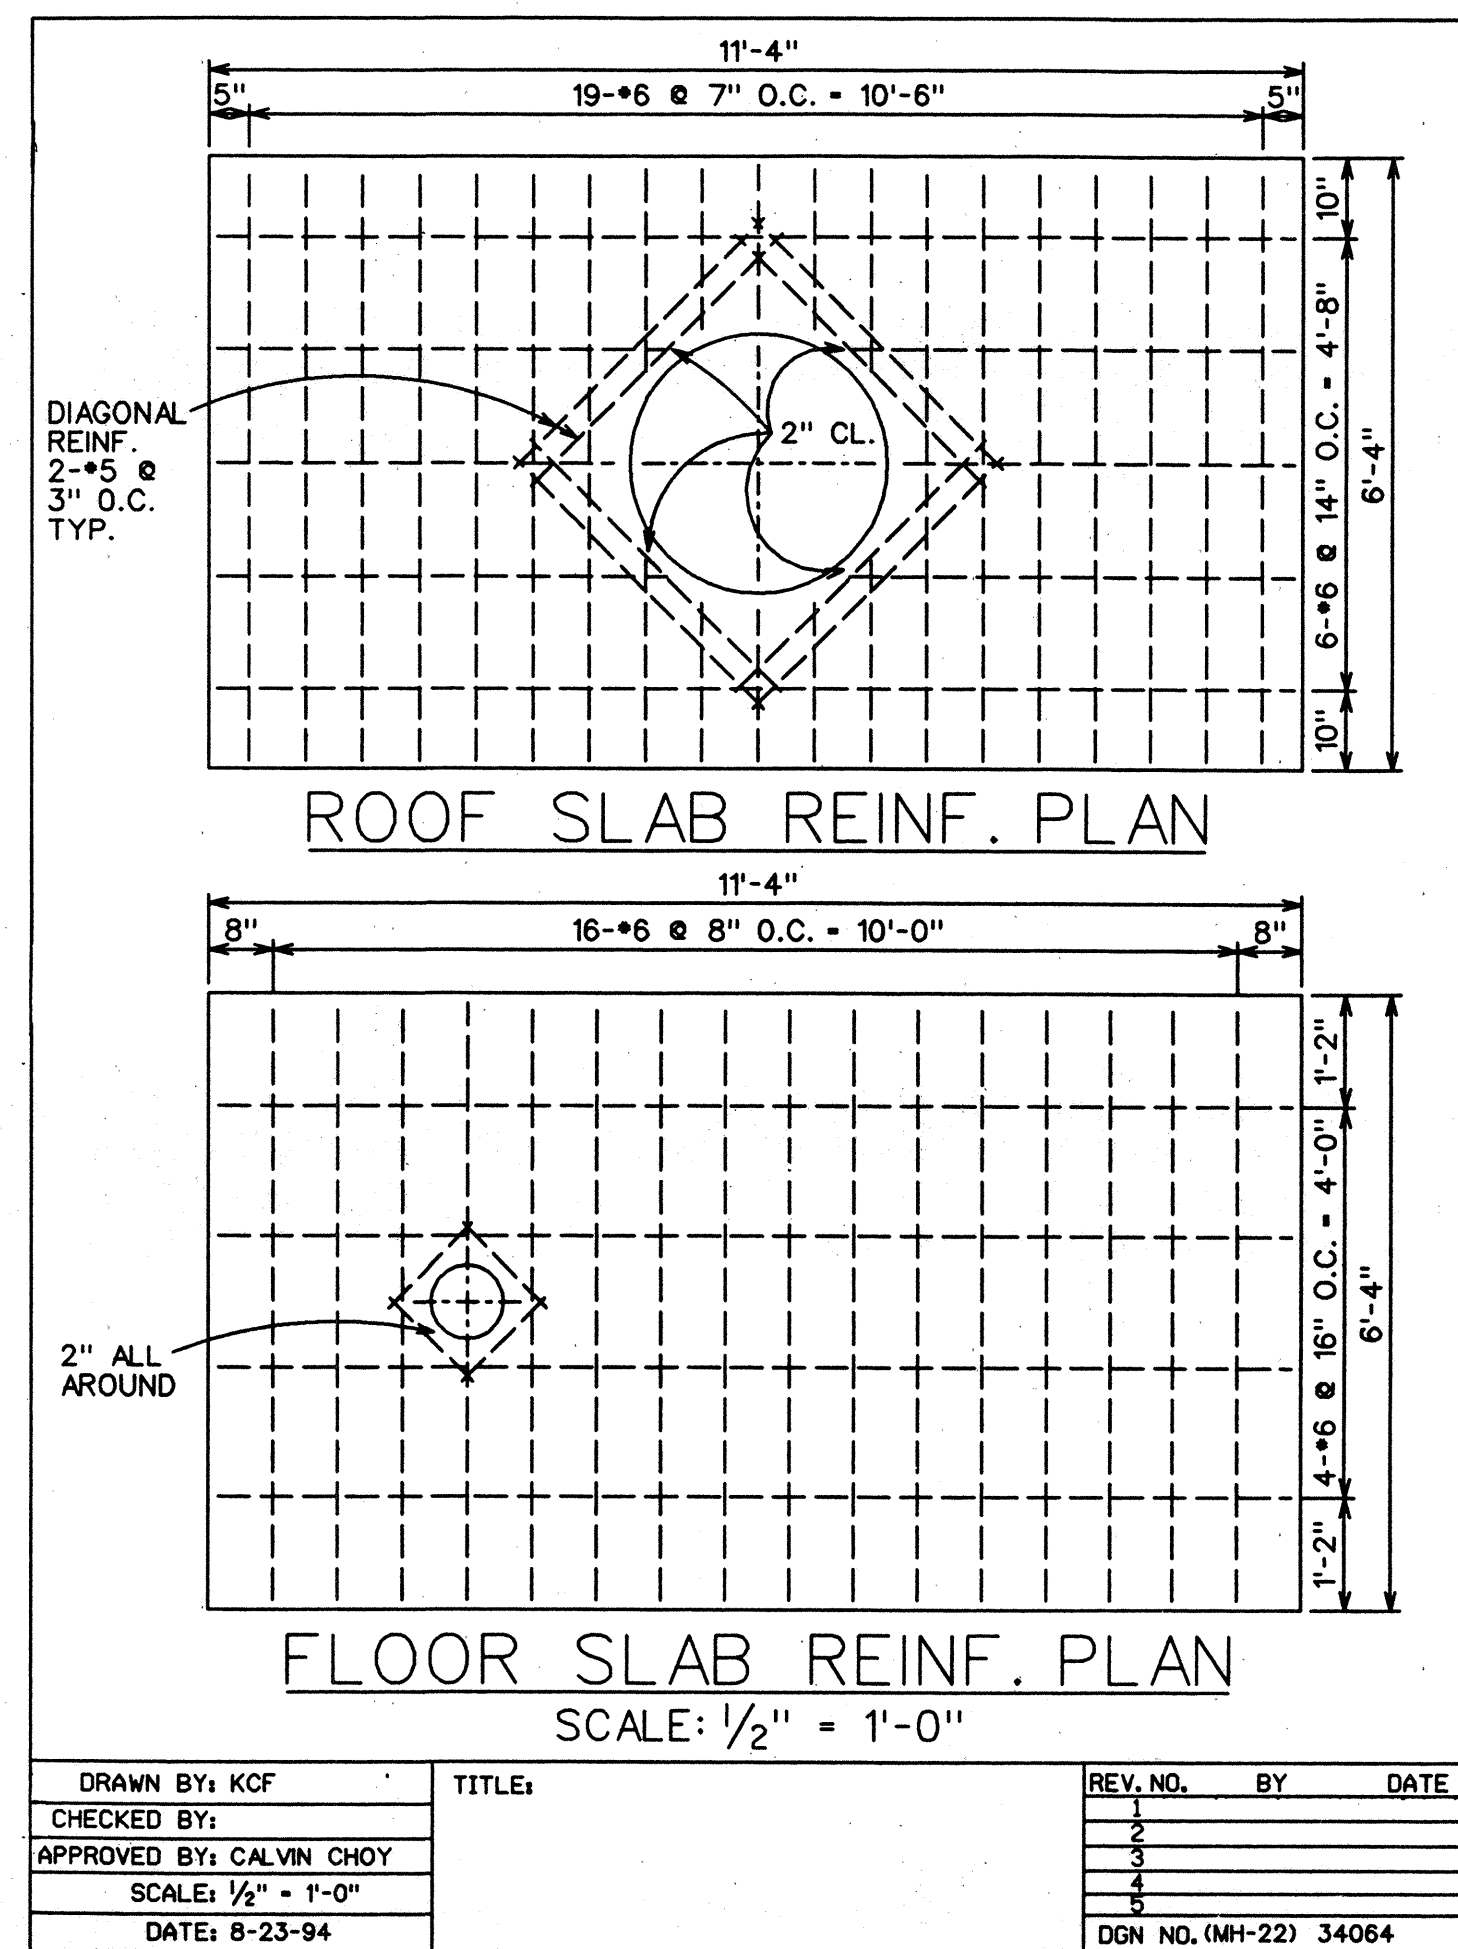
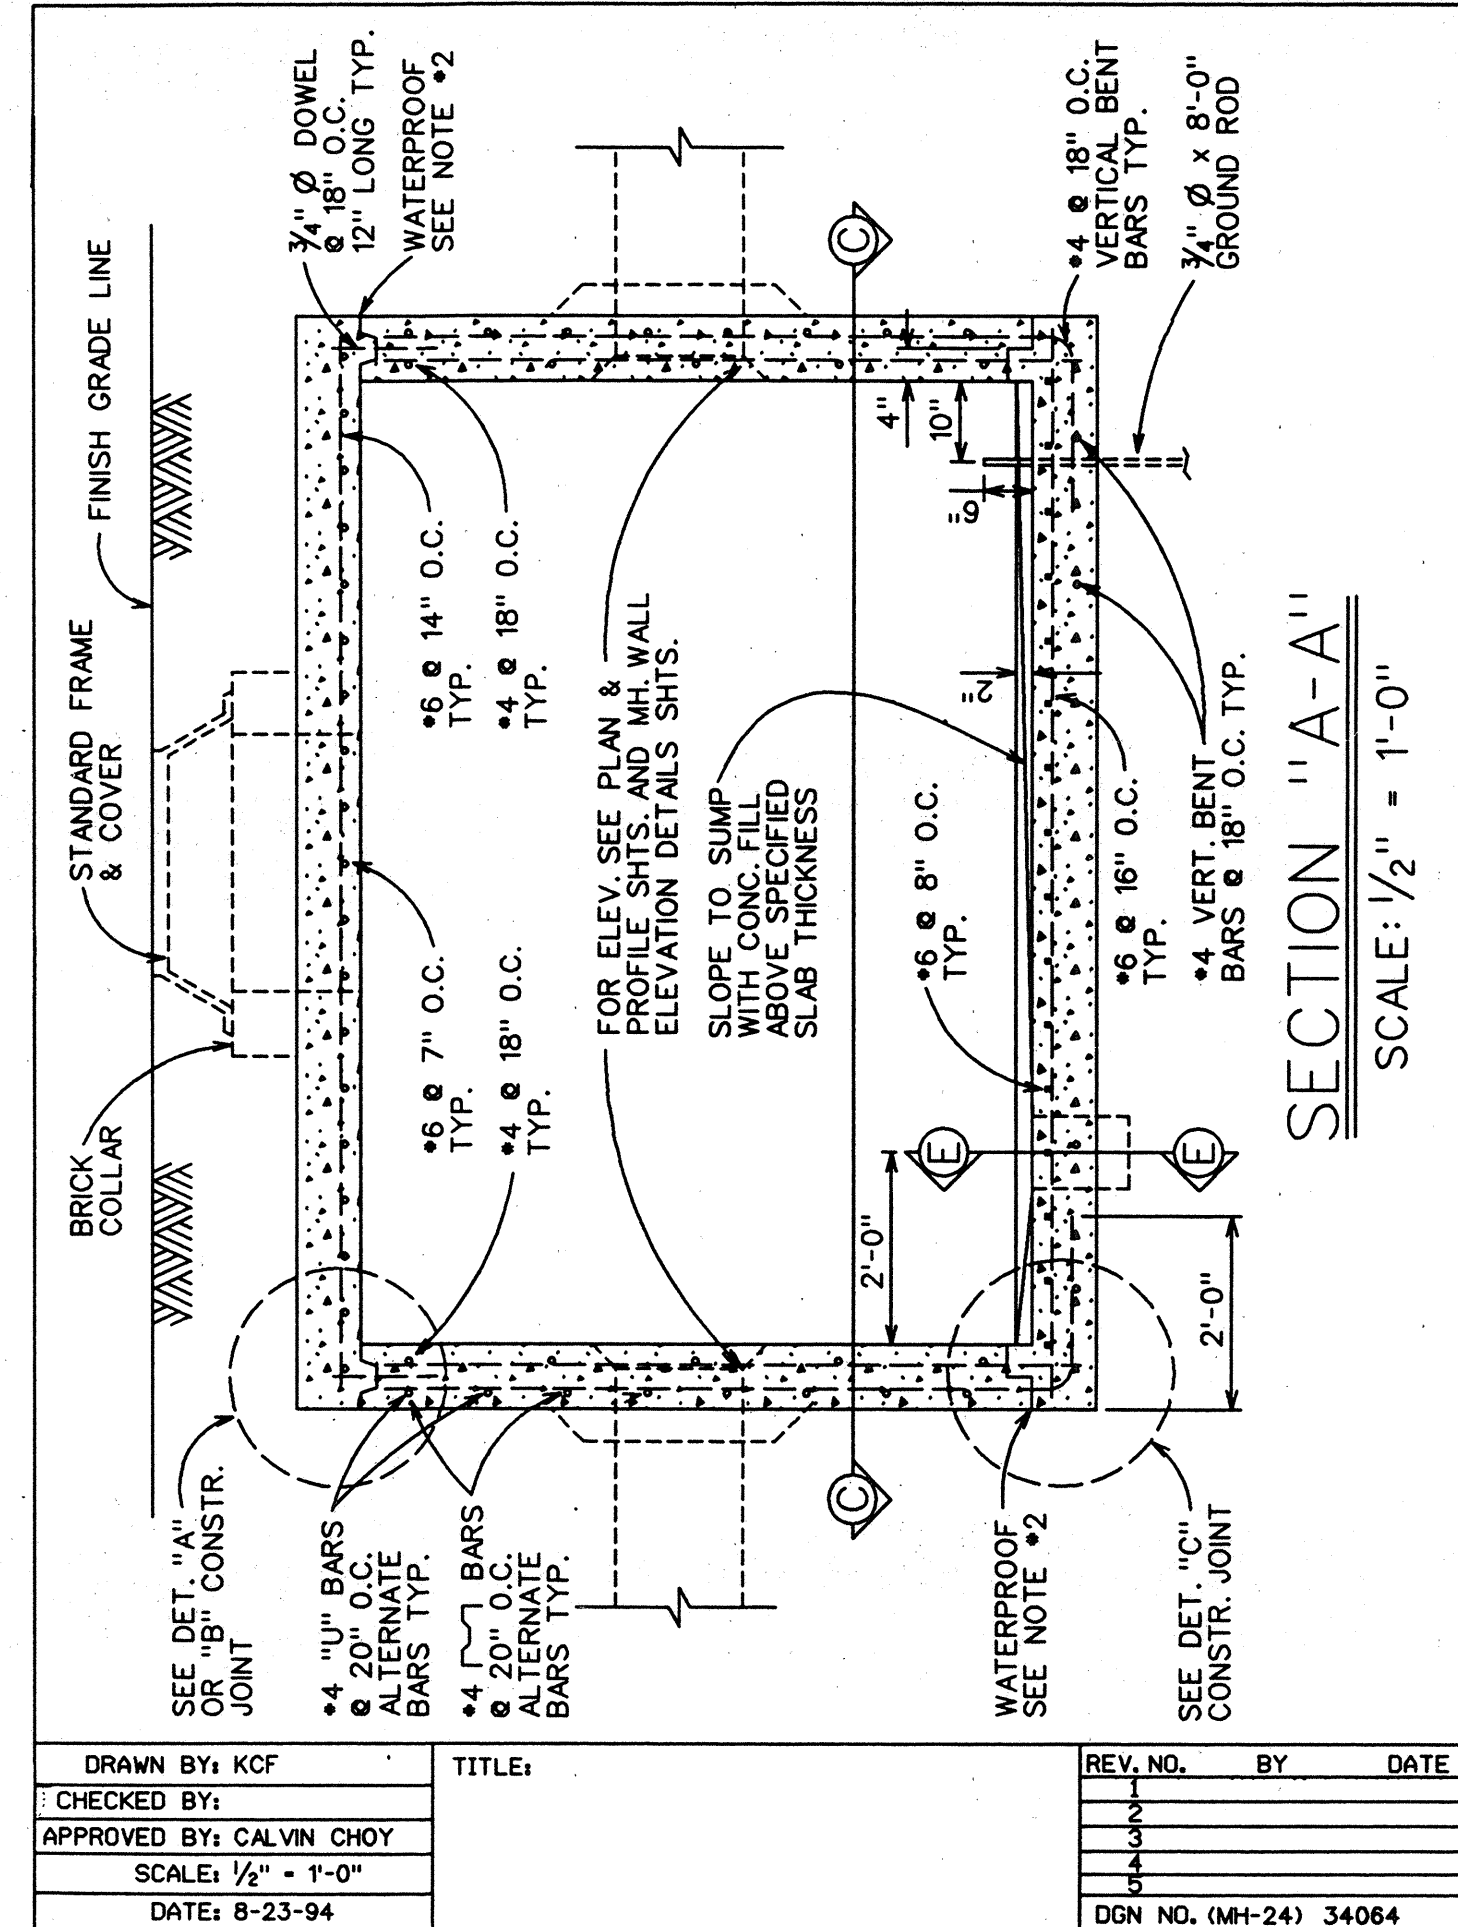


REFERENCE ONLY

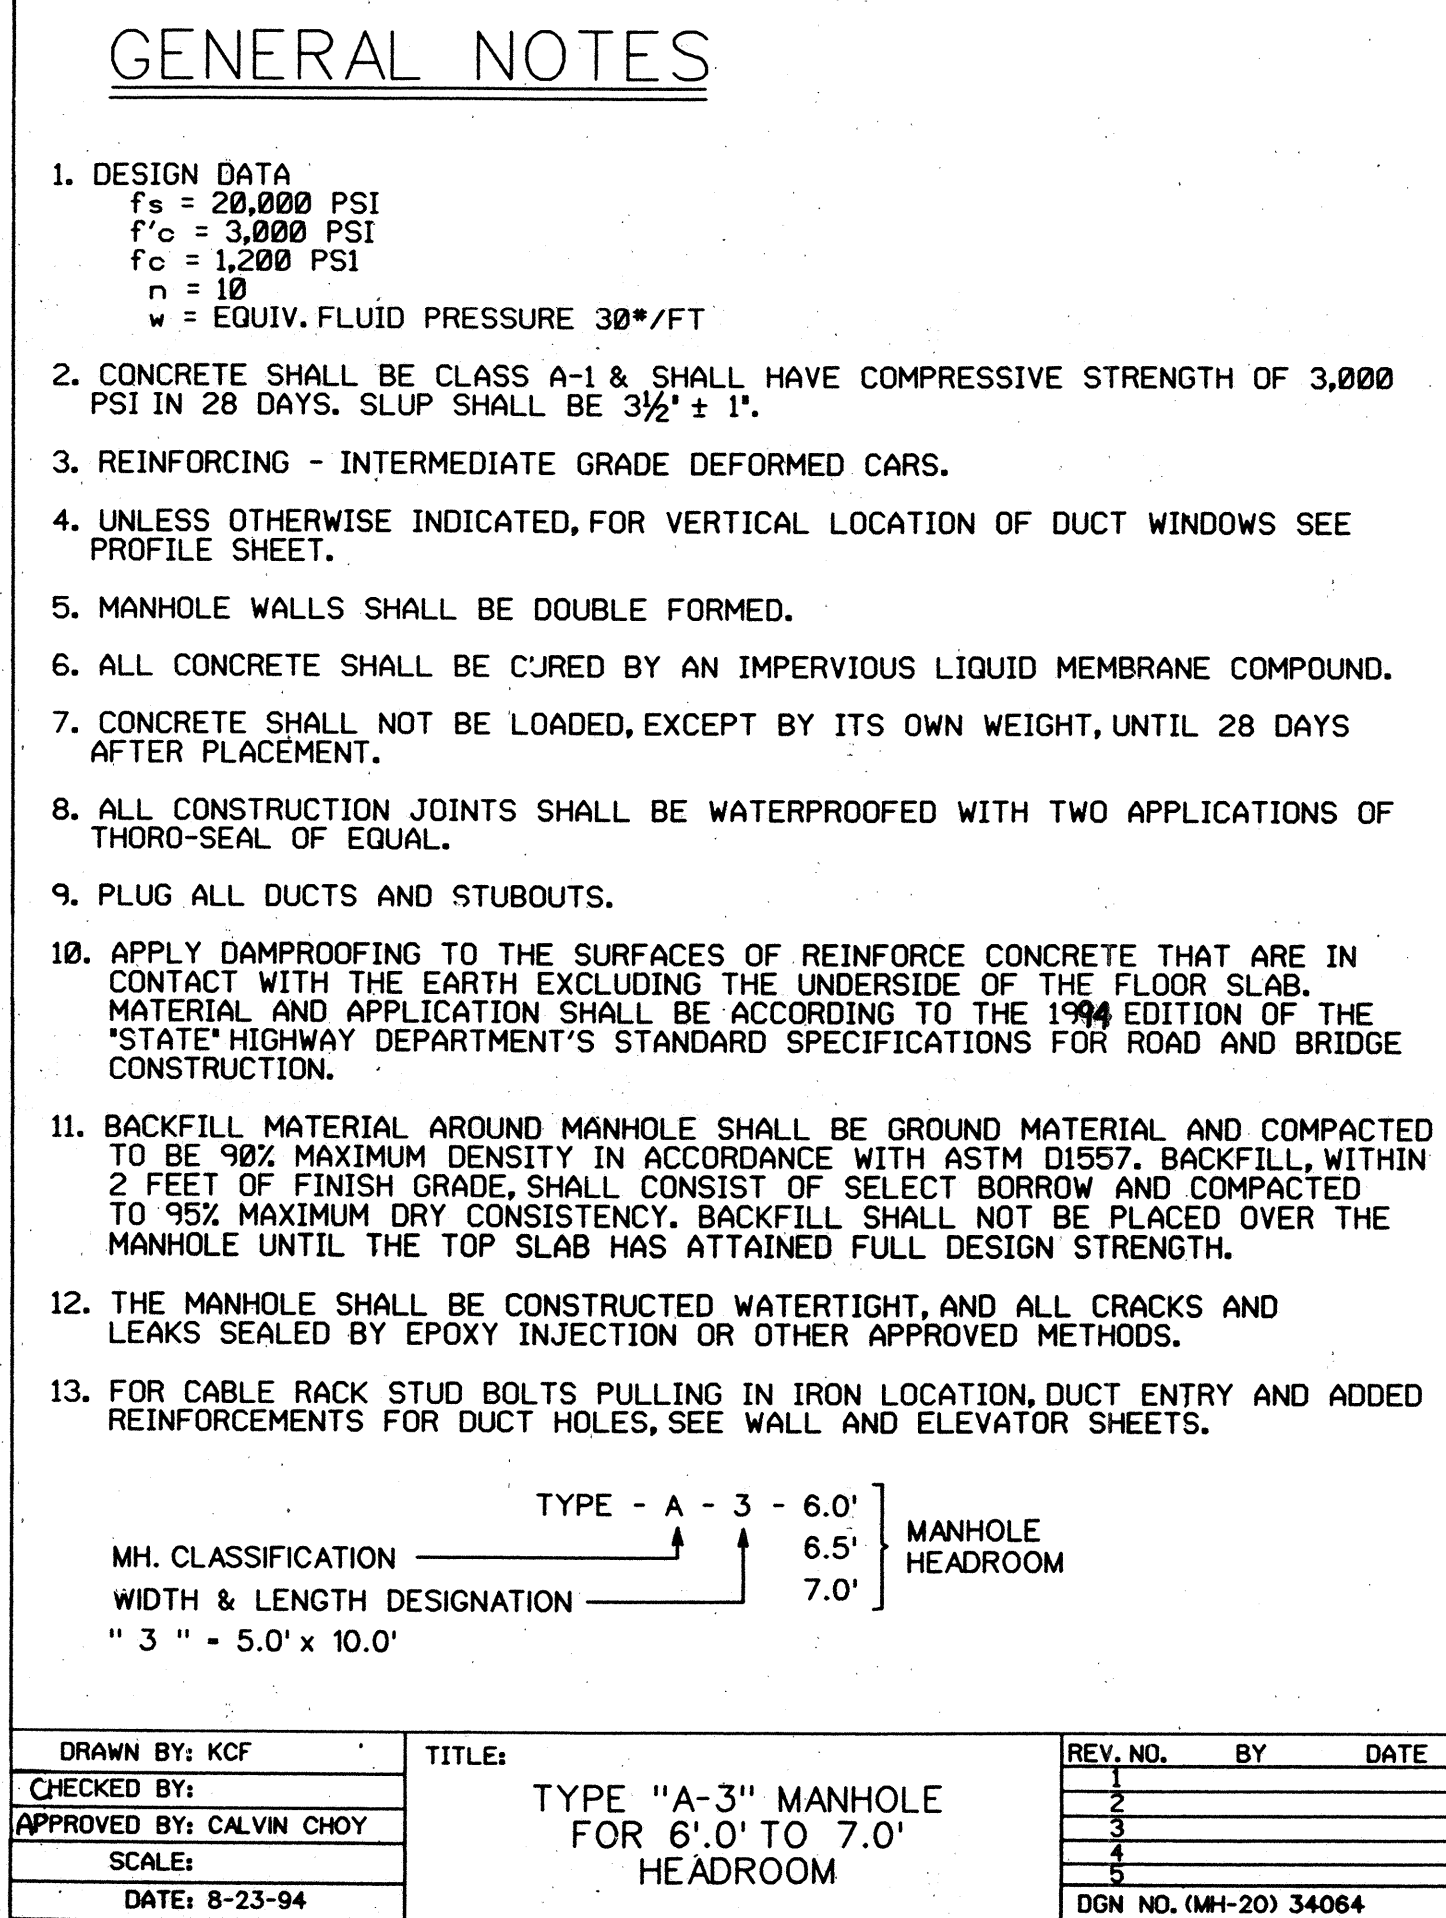

STATE OF HAWAII
DEPARTMENT OF TRANSPORTATION
HIGHWAYS DIVISION


REFERENCE DETAILS

KUNIA ROAD WIDENING; AND
H-1, KUNIA I.C., RAMP KO WIDENING
F.A.I. PROJECT NO. IM-STP-0750(10)


SCALE: AS NOTED DATE: APRIL 1999

SHEET No. 1 OF 3 SHEETS


FED. ROAD DIST. NO.	STATE	FED. AID PROJ. NO.	FISCAL YEAR	SHEET NO.	TOTAL SHEETS
HAWAII	HAW.	IM-STP-0750(10)	1999	70	97

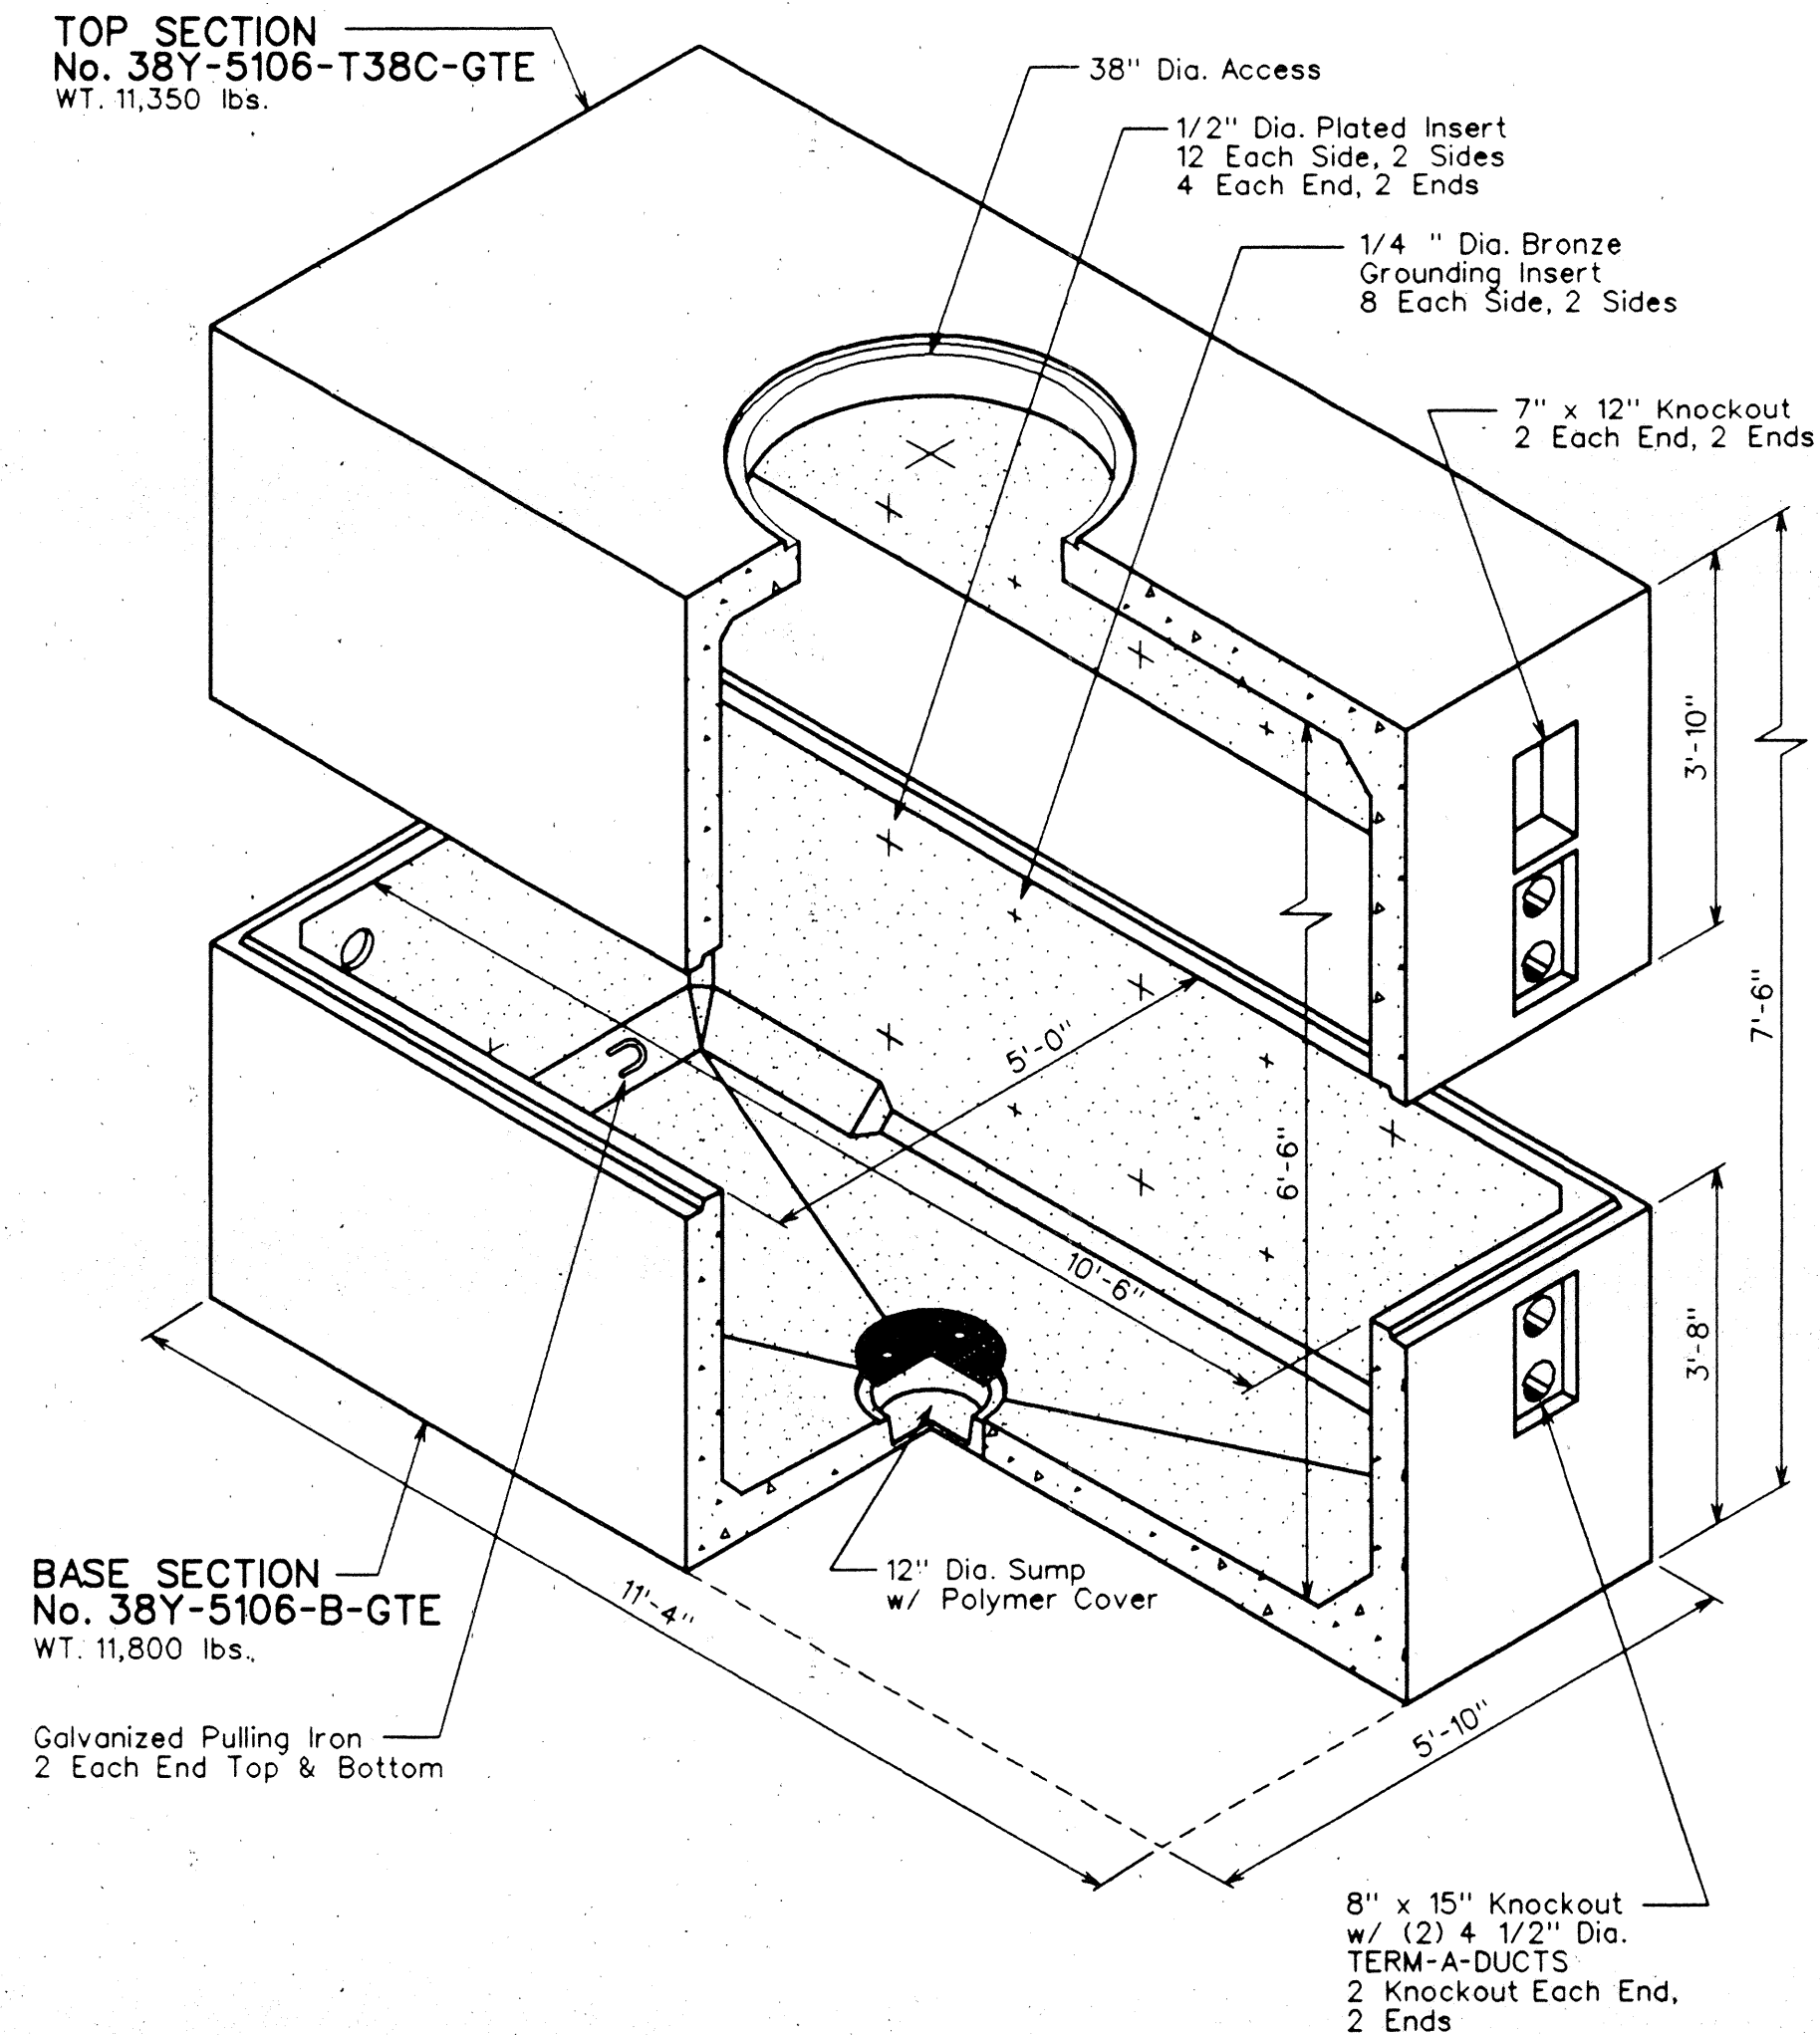

DRAWN BY: KCF/JAF	TITLE: 38Y-5106-GTE GTE ITEM CODE: 180016	REV. NO.	BY	DATE
CHECKED BY:		1		
APPROVED BY:		2		
SCALE: 3/8" = 1'-0"		3		
DATE: 07/01/94		4		
		5		
		DGN NO.		

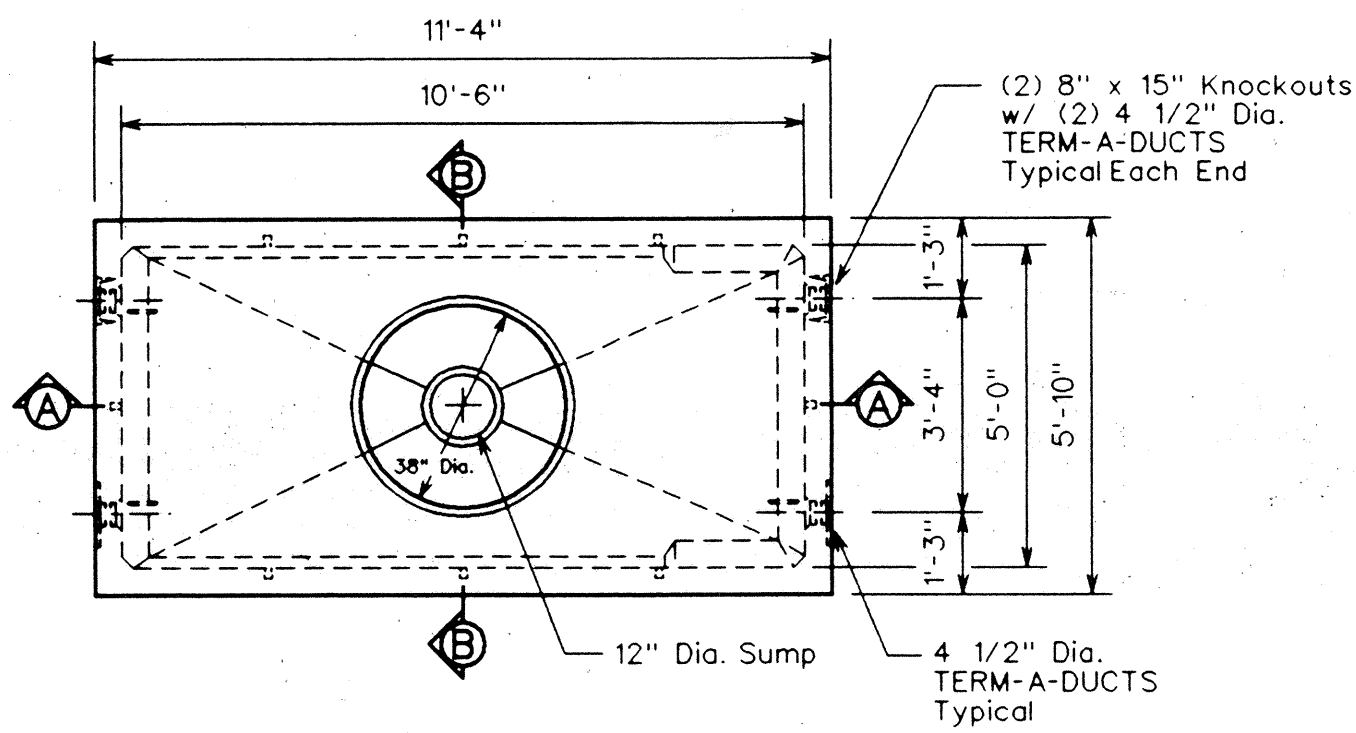

PLAN VIEW

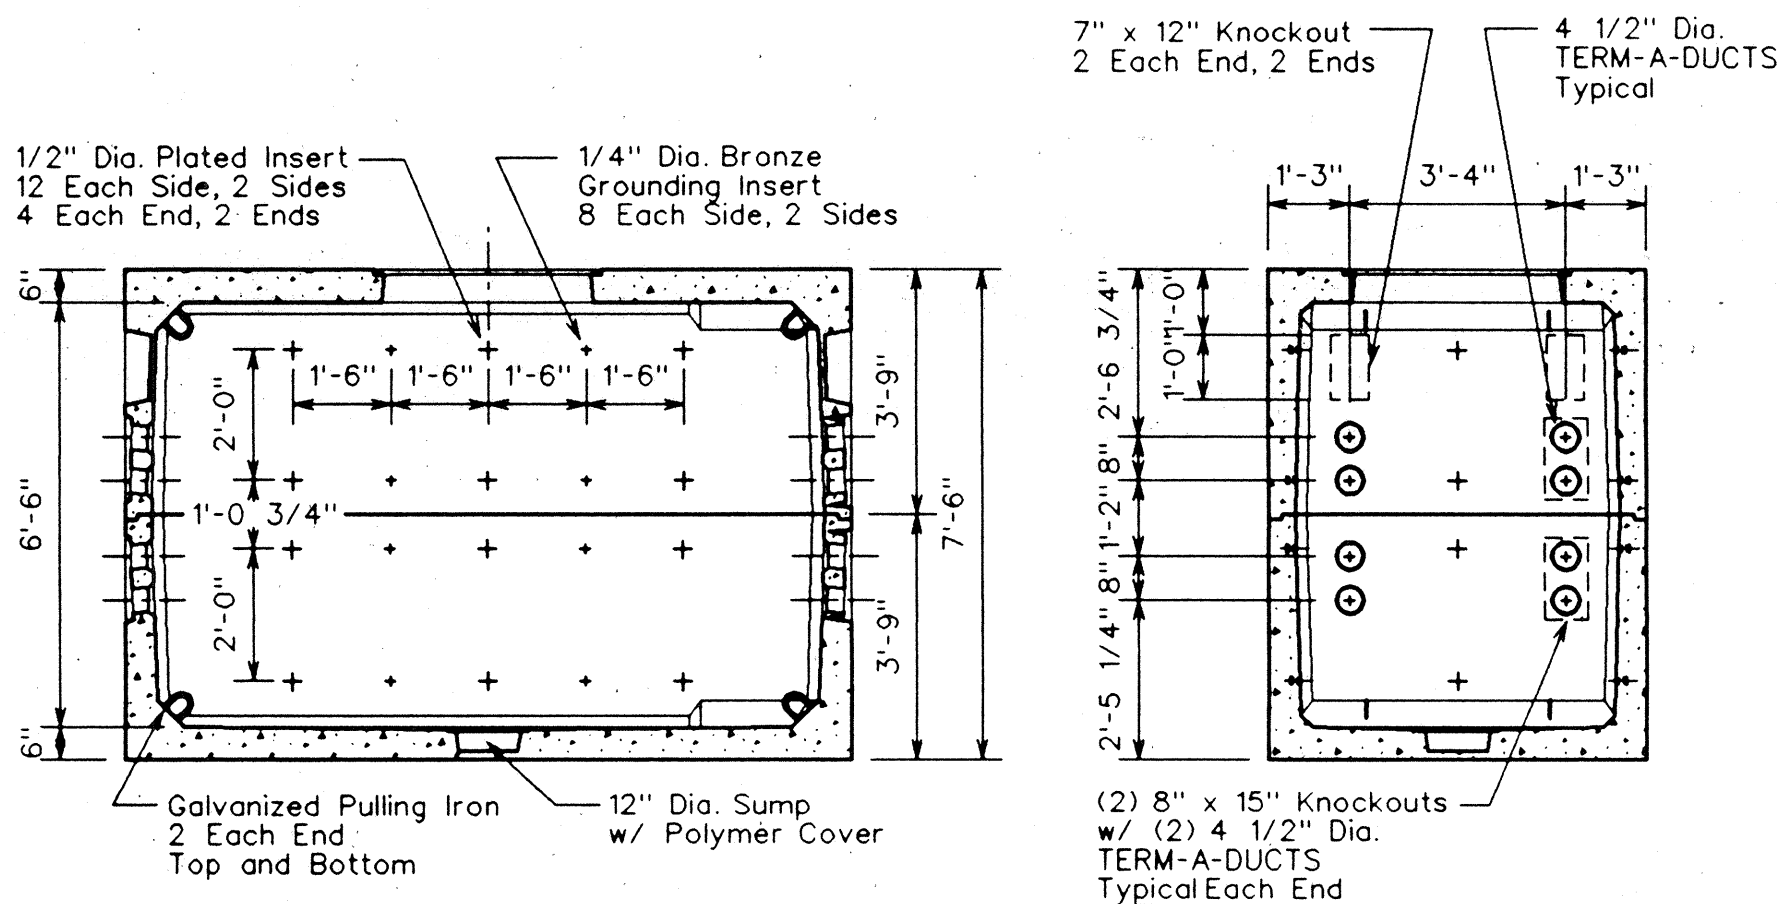

SECTION AA

SECTION BB

DRAWN BY: KCF/JAF	TITLE: 38Y-5106-GTE GTE ITEM CODE: 180016	REV. NO.	BY	DATE
CHECKED BY:		1		
APPROVED BY:		2		
SCALE: 1/4" = 1'-0"		3		
DATE: 07/01/94		4		
		5		
		DGN NO.		



REFERENCE ONLY

STATE OF HAWAII DEPARTMENT OF TRANSPORTATION HIGHWAYS DIVISION	
REFERENCE DETAILS	
KUNIA ROAD WIDENING; AND H-1, KUNIA I.C., RAMP KO WIDENING F.A.I. PROJECT NO. IM-STP-0750(10)	
SCALE: AS NOTED	DATE: APRIL 1999
SHEET No. 2 OF 3 SHEETS	

ORIGINAL PLAN	SURVEY PLOTTED BY	DATE
NOTE BOOK	DRAWN BY	
	TRACED BY	
	QUANTITIES BY	
	CHECKED BY	

Let size 12/06/94 05:33:14 by
C:\AD\PROJECTS\01450\REF-021

FED. ROAD DIST. NO.	STATE	FED. AID PROJ. NO.	FISCAL YEAR	SHEET NO.	TOTAL SHEETS
HAWAII	HAW	IM-STP-0750(10)	1999	71	97

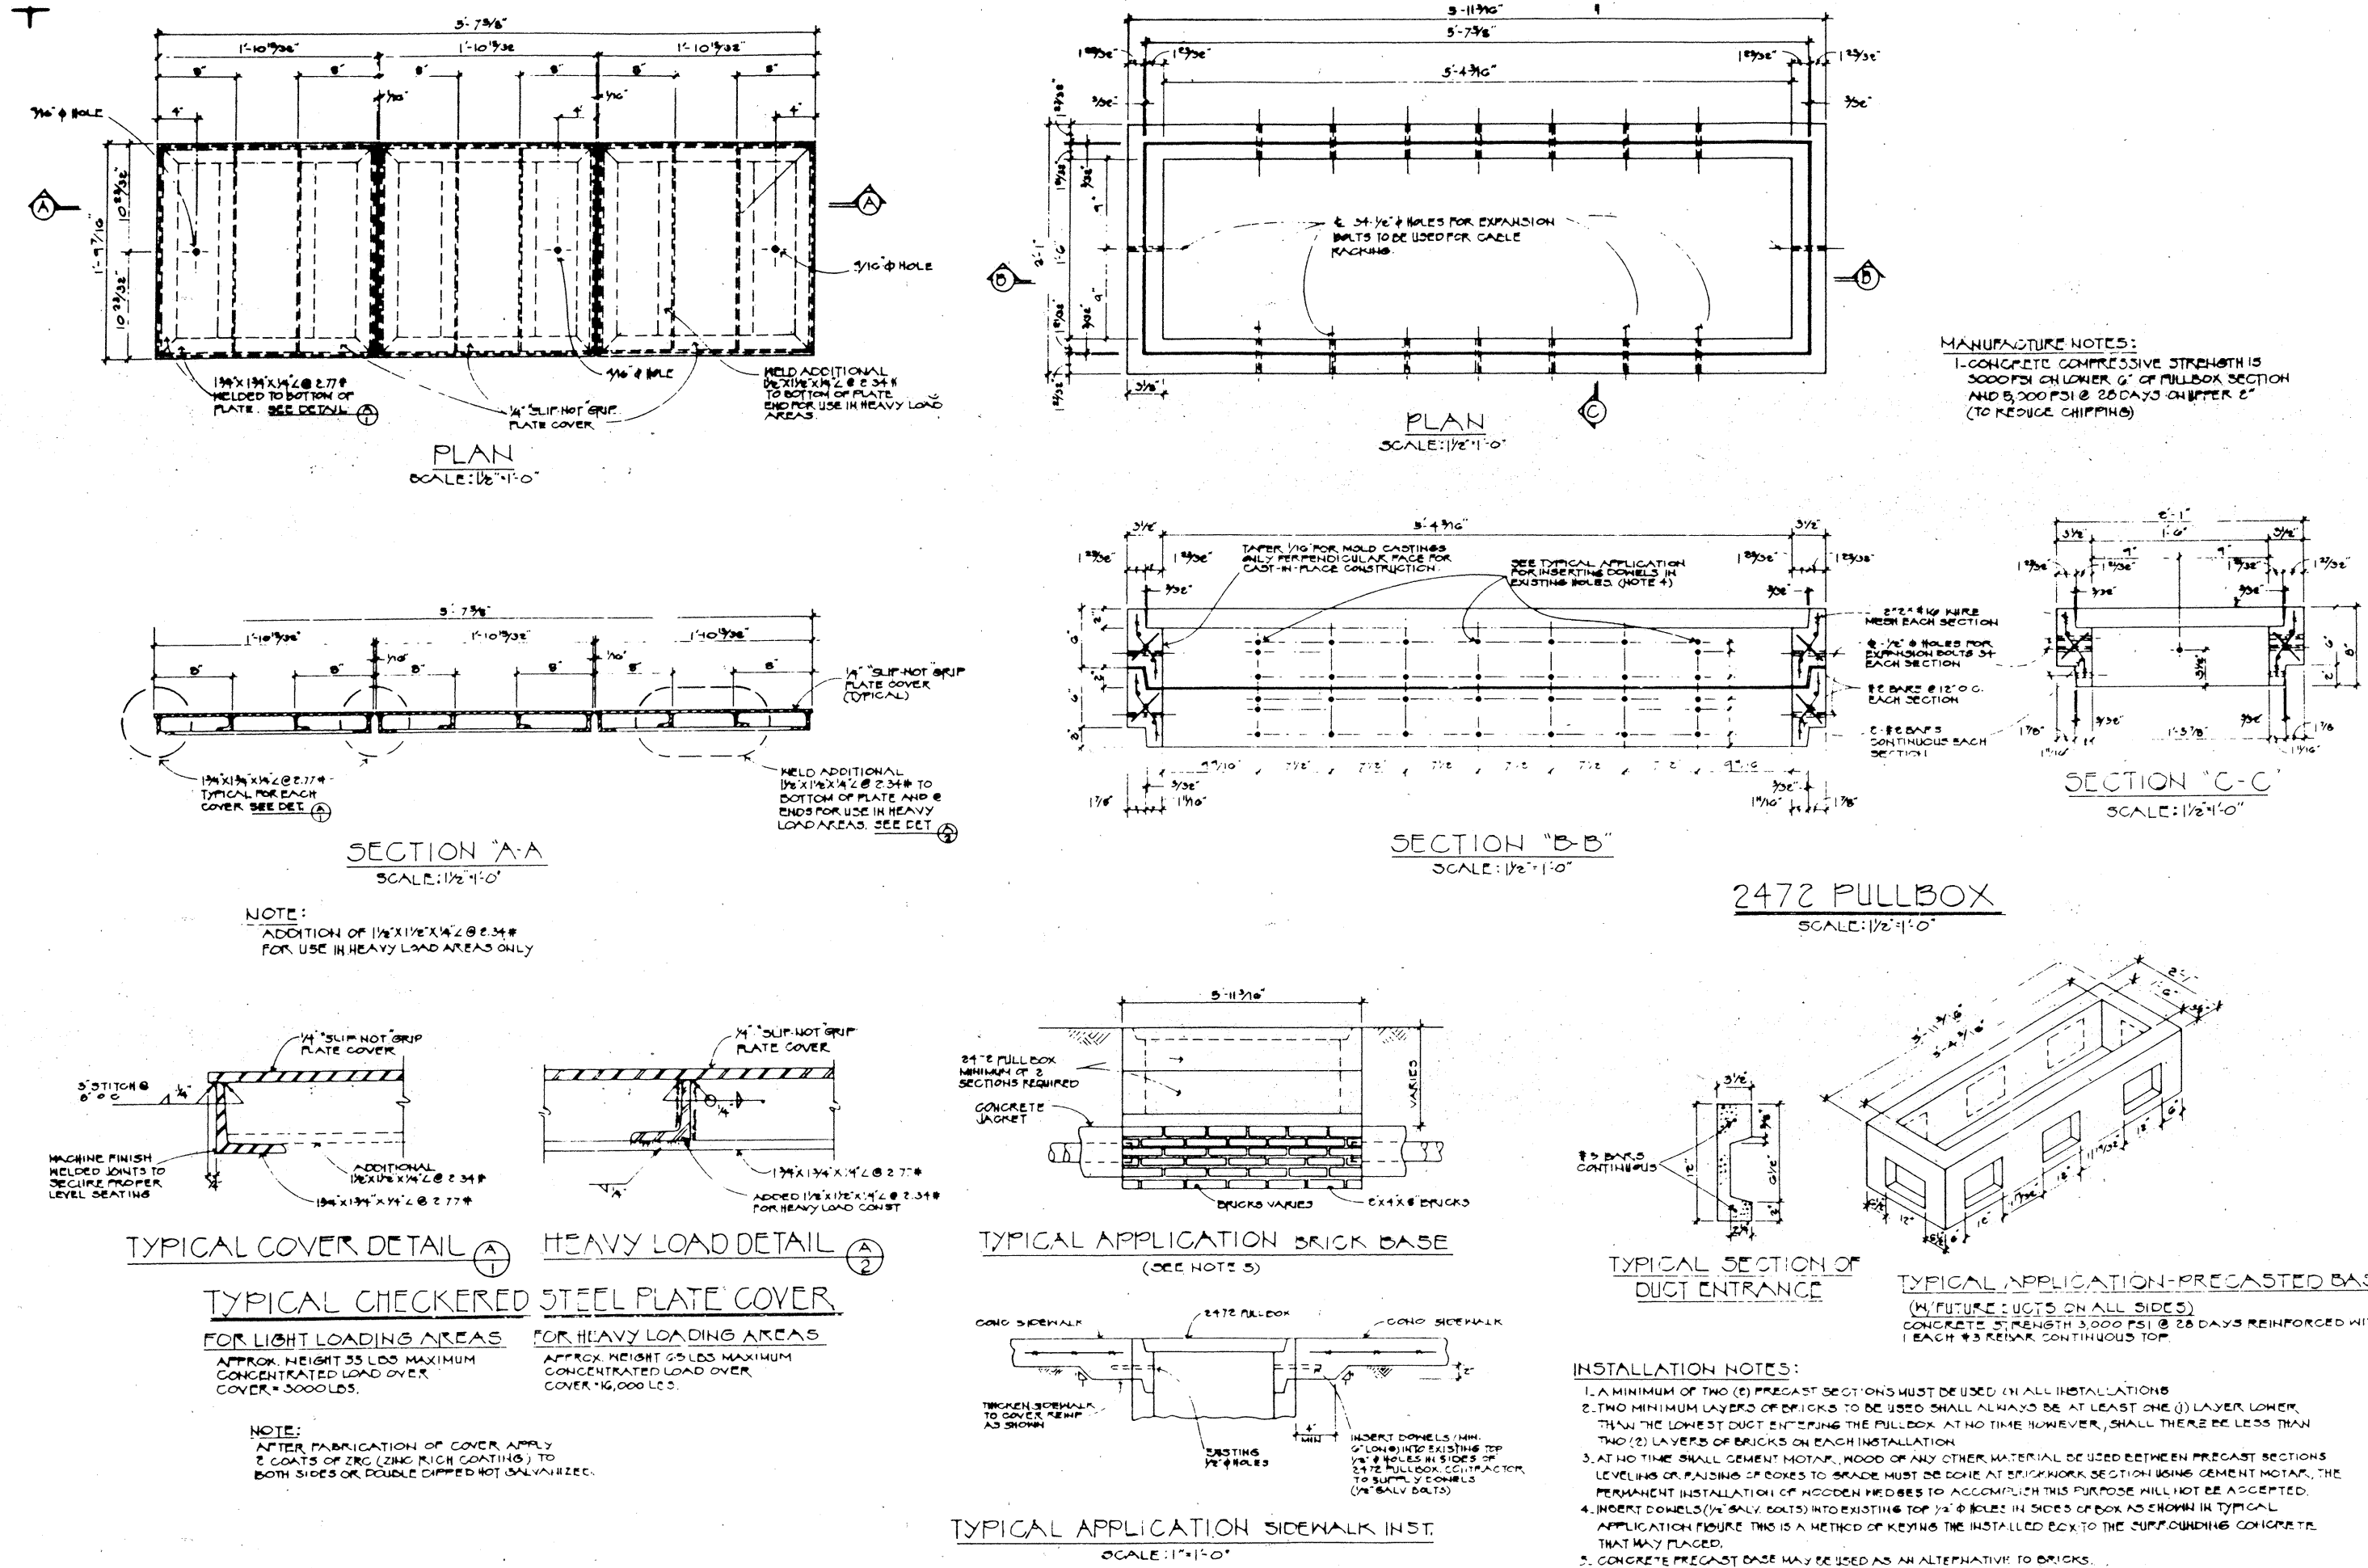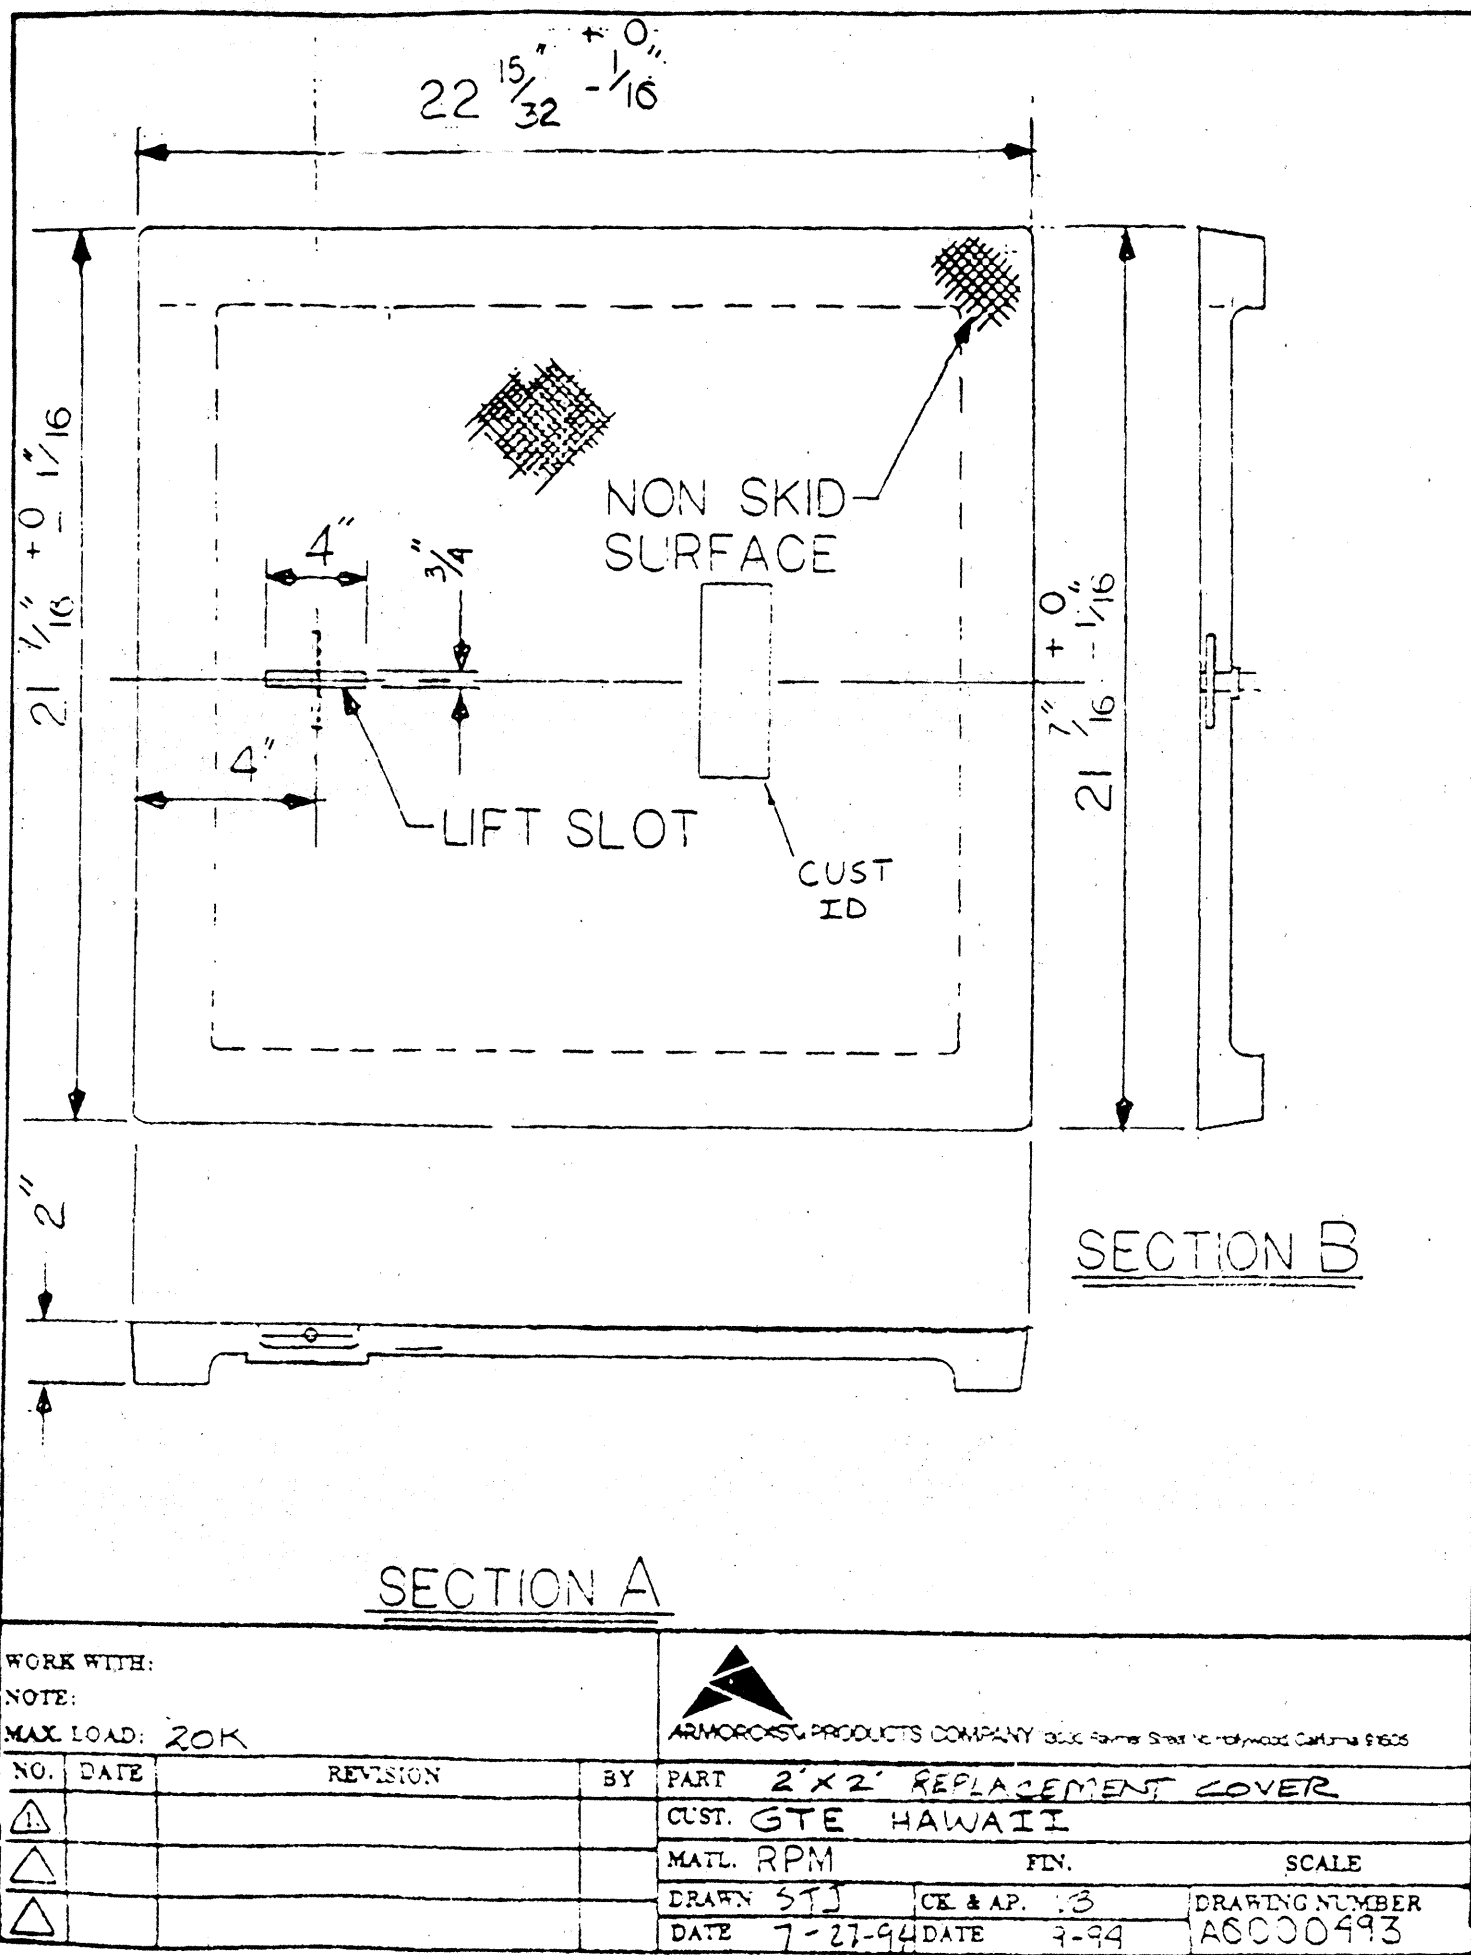

REFERENCE ONLY

STATE OF HAWAII
DEPARTMENT OF TRANSPORTATION
HIGHWAYS DIVISION

REFERENCE DETAILS


KUNIA ROAD WIDENING; AND
H-1, KUNIA I.C., RAMP KO WIDENING
F.A.I. PROJECT NO. IM-STP-0750(10)

SCALE: AS NOTED DATE APRIL 1999

SHEET No. 3 OF 3 SHEETS

RECORD DRAWINGS

71

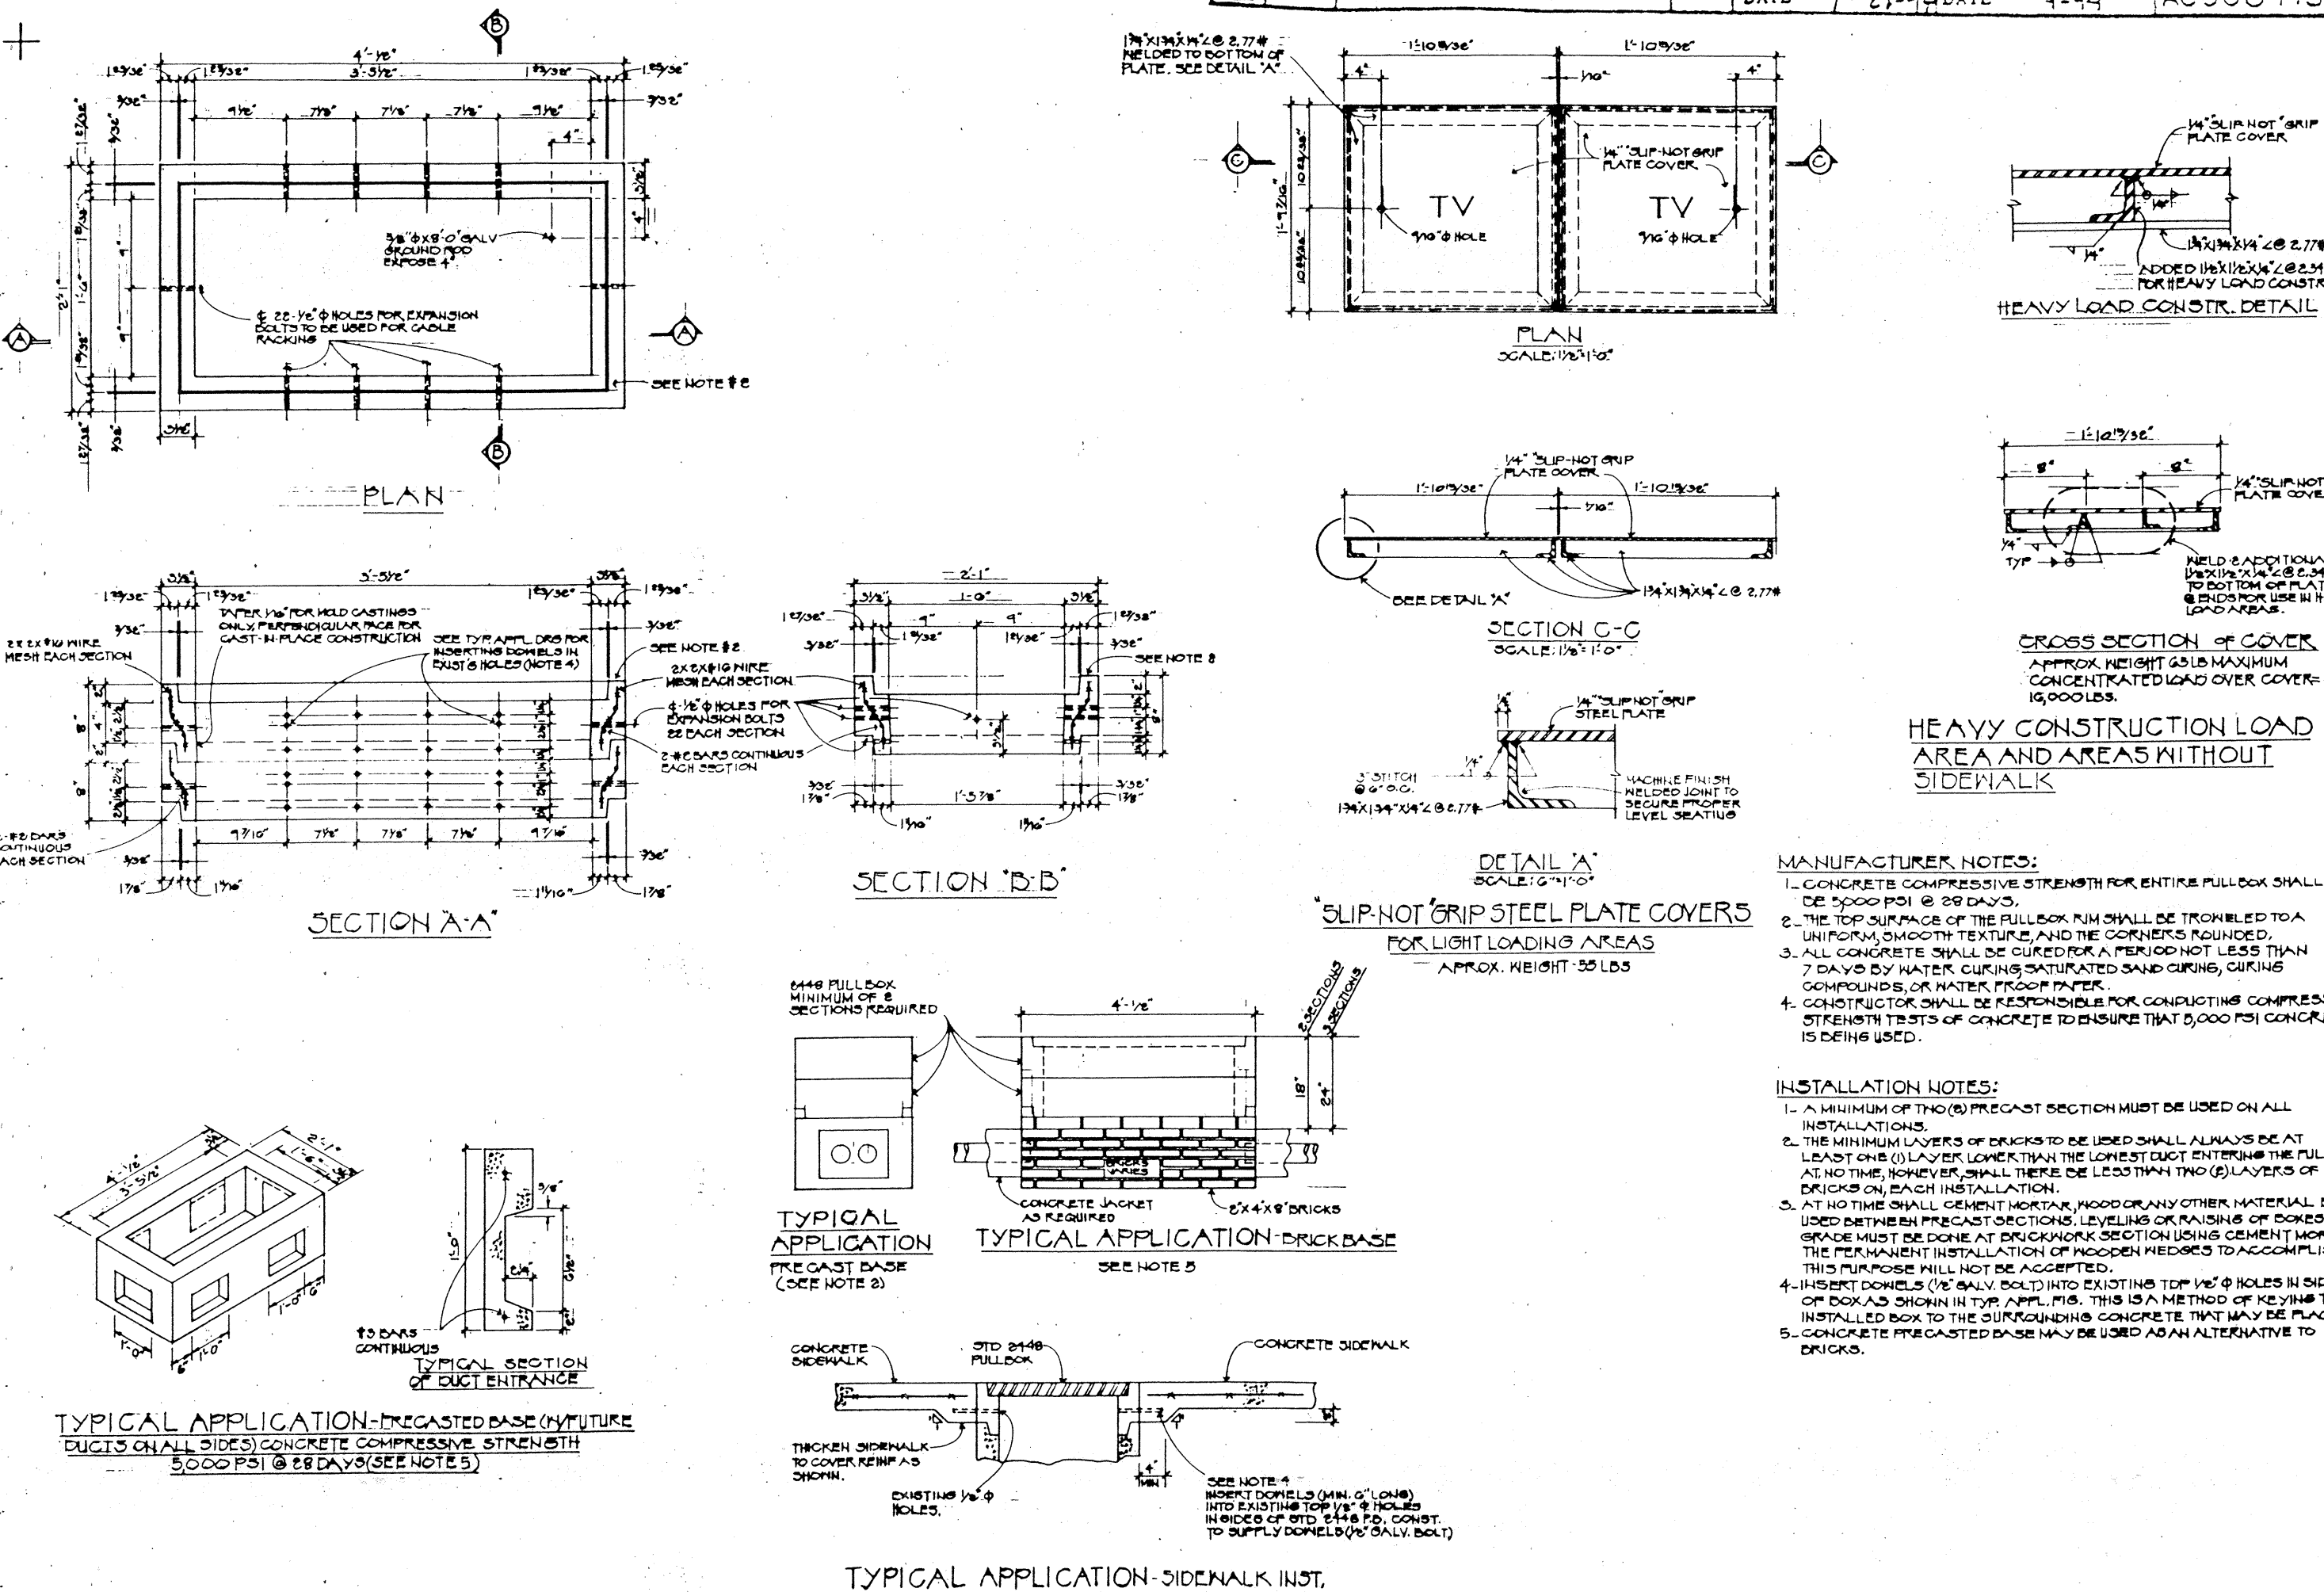

DATE	BY	REVISION
12/06/99	STJ	1.0
12/06/99	STJ	1.1
12/06/99	STJ	1.2
12/06/99	STJ	1.3
12/06/99	STJ	1.4
12/06/99	STJ	1.5
12/06/99	STJ	1.6
12/06/99	STJ	1.7
12/06/99	STJ	1.8
12/06/99	STJ	1.9
12/06/99	STJ	2.0