


FED. ROAD DIST. NO.	STATE	FED. AID PROJ. NO.	FISCAL YEAR	SHEET NO.	TOTAL SHEETS
HAWAII	HAW.	IM-STP-0750(10)	1989	57	97

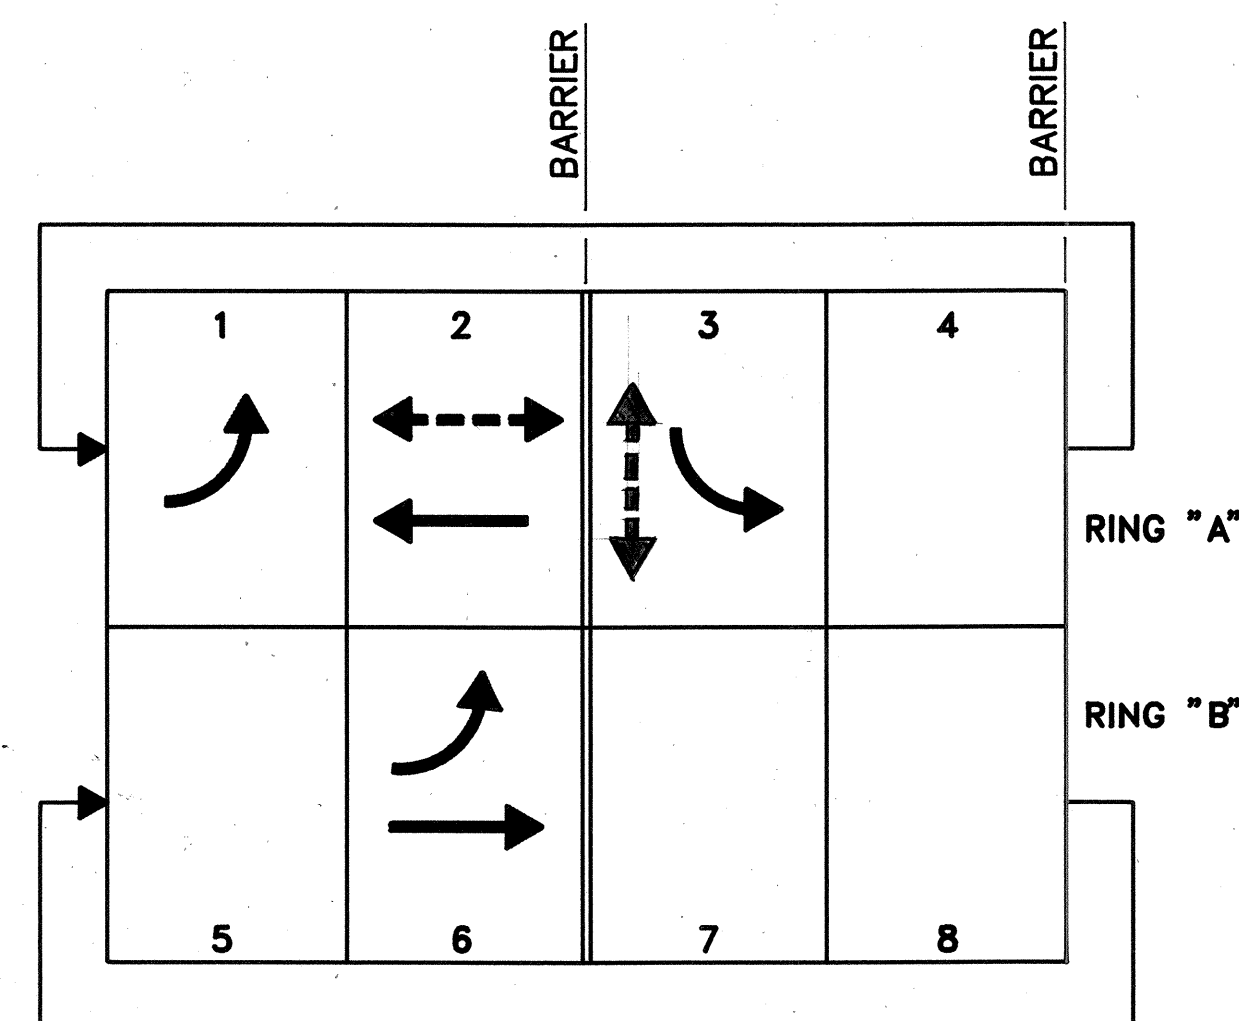

PHASE DIAGRAM


- NOTES:**

1 INSTALL R10-4b (R) WITH PED. PUSH BUTTON 2 INSTALL R10-4b (L) WITH PED. PUSH BUTTON 3 TRAFFIC SIGNALS MOUNTED ON STREET LIGHT POLE, SEE DETAIL 	5 INTERCEPT EXST. 2" CONDUIT CONN. TO EXST. HTCO M.H. NEW 2' X 4' HTCO H.H. 6 EXST. 2"C FOR T.S. CONN.
---	--

4 STREET NAME SIGN MOUNTED ON MAST ARM,
SEE DETAIL



TRAFFIC SIGNAL SYSTEM CONDUIT AND CABLE SCHEDULE																			
DELTA ITEM NO.	1	2	3	4	5	6	7	8	9	10	11	12	13	14	15	16	17	18	
QUANTITY OF NEW 2"C, TRAFFIC SIGNAL	1				1	1		2			2								
QUANTITY OF NEW 3"C, TRAFFIC SIGNAL																1			
QUANTITY OF EXISTING 2"C, TRAFFIC SIGNAL		1	1	4			4		1	4		4	1	4	6	2	1	1	
QUANTITY OF 26/C #14 CONTROL CABLE				1			1			1		1	1	1	2				
QUANTITY OF 4/C #14 CONTROL CABLE					1	1		4			3								
QUANTITY OF 2/C #14 SHIELDED LOOP DETECTOR AND PEDESTRIAN PB CABLE	1	1	3	3			3			3		1	1	3	8	2	1		
QUANTITY OF 3/C #20 SHIELDED OPTICOM HEAD CABLE					1		1	1		2	1	1			1	3			
QUANTITY OF 12PAIR #14 INTERCONNECT CABLE																1	1	1	
QUANTITY OF 3/C #2, SECONDARY POWER CABLE									1	1						1			
QUANTITY OF 2"C TELEPHONE, WITH PULLWIRE																1			
QUANTITY OF SPARE CONDUIT WITH PULLWIRE					2			1			2		1		1				
NOTES: 1. ALL CONDUITS SHALL BE PVC SCHEDULE 80, UNLESS OTHERWISE NOTED																			
2. ALL DUCT SECTIONS SEE SHEETS 53 & 54																			

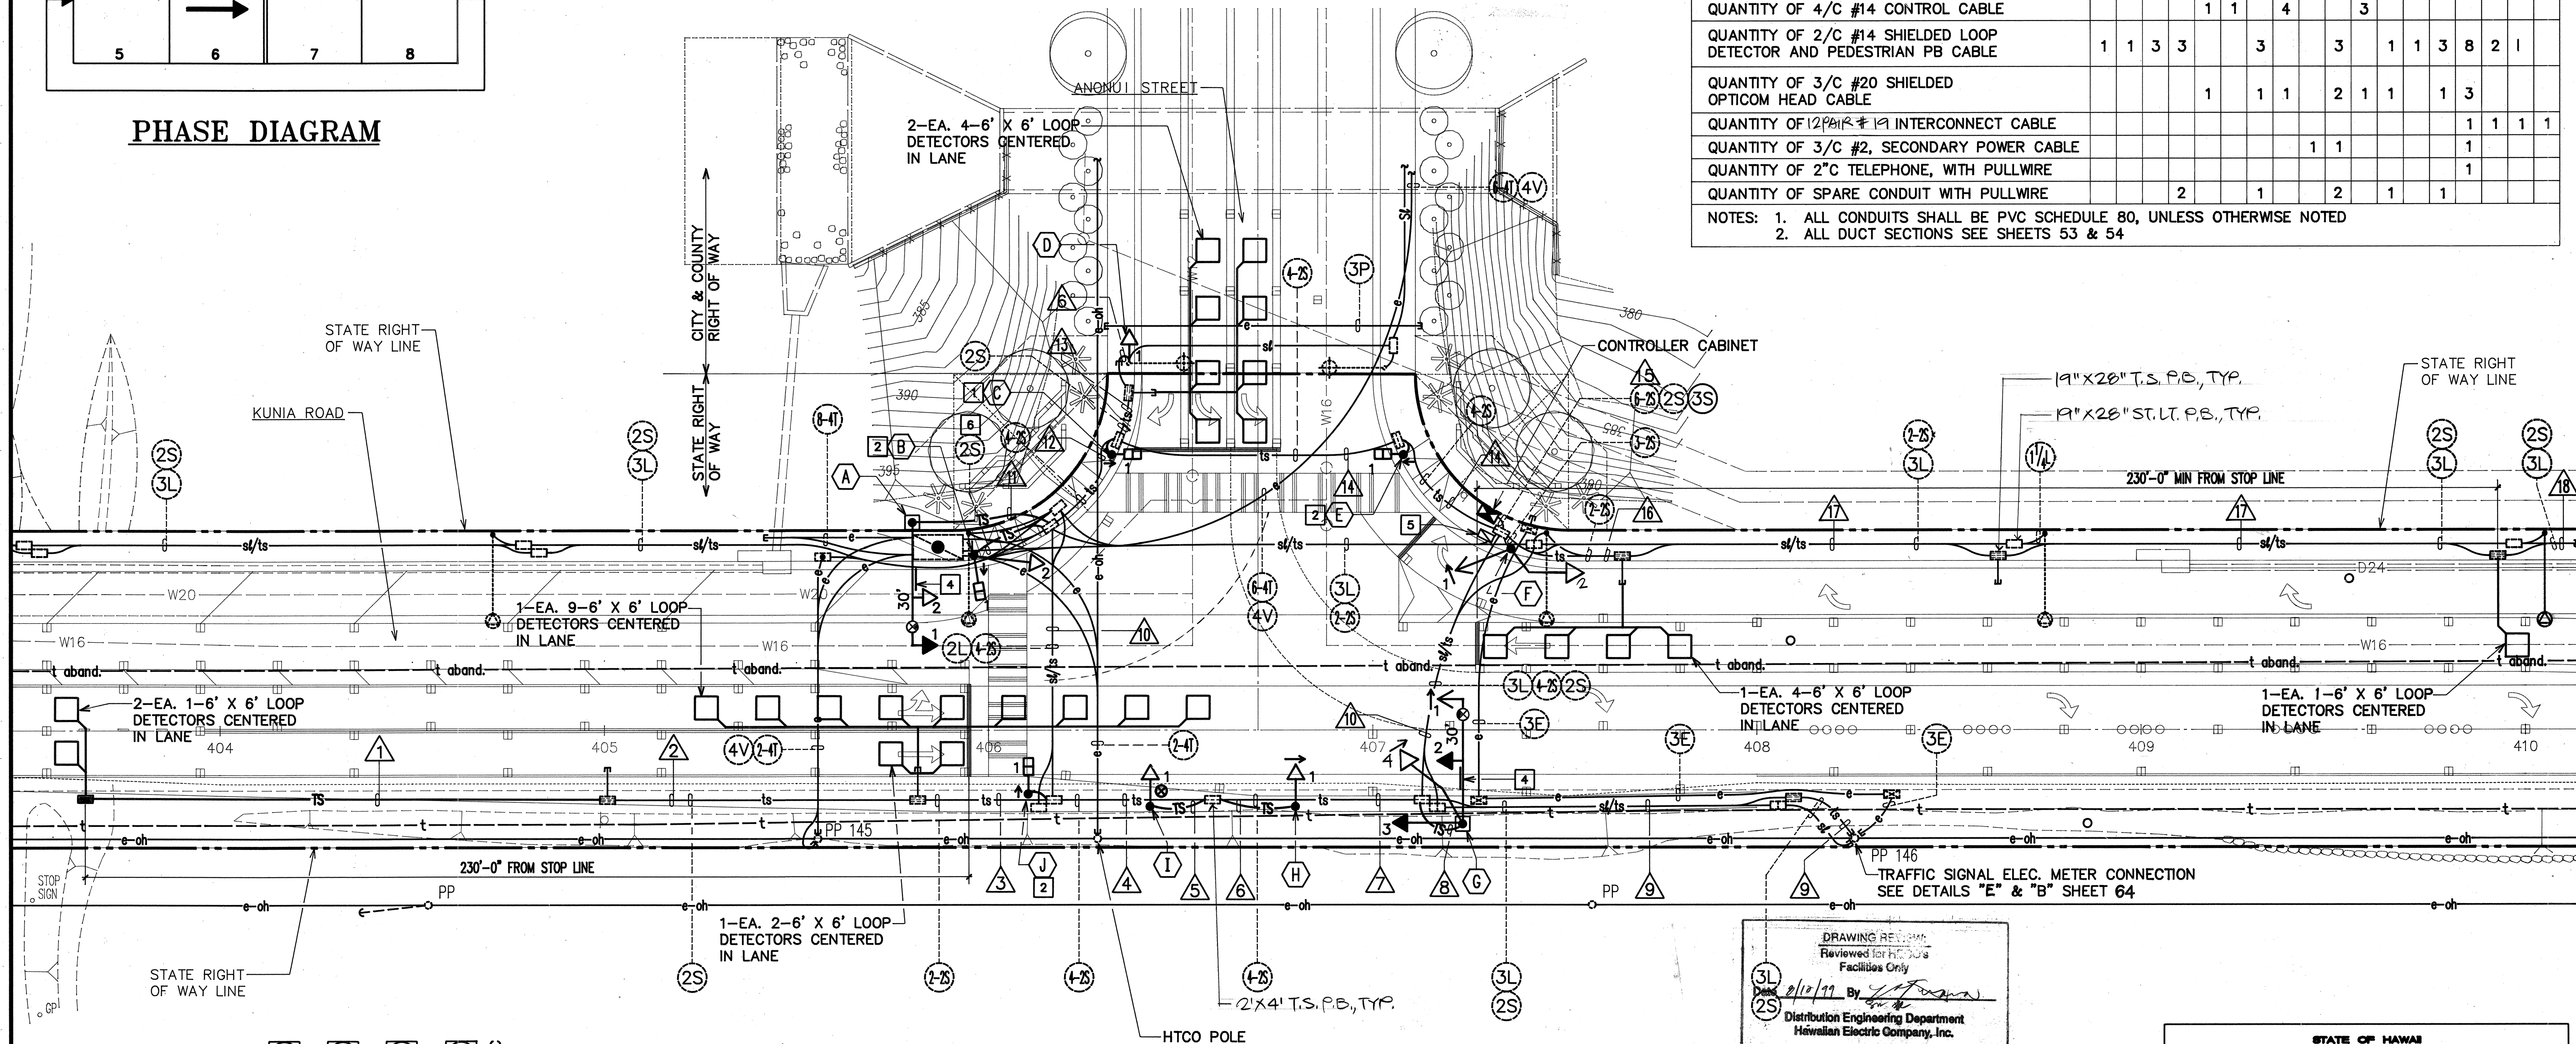

APPROVED BY:

HAWAIIAN ELECTRIC COMPANY, INC.

HAWAIIAN TELEPHONE COMPANY

OCEANIC CABLEVISION

DATE _____

DATE _____

DATE _____

DRAWING REVIEW
Reviewed for HECO's
Facilities Only

3L
Date 8/12/99 By *[Signature]*
2S

Distribution Engineering Department
Hawaiian Electric Company, Inc.

HECO's review of these drawings shall in no way relieve the Customer, its Consultant, its Contractor or anyone acting on Customer's behalf from the responsibility for engineering, design, materials and any liability associated with this project.

STATE OF HAWAII
DEPARTMENT OF TRANSPORTATION
HIGHWAYS DIVISION

TRAFFIC SIGNAL PLAN - KUNIA ROAD/ANONUI STREET INTERSECTION

KUNIA ROAD WIDENING; AND
H-1, KUNIA I.C., RAMP KO WIDENING
F.A.I. PROJECT NO. IM-STP-0750(10)

SCALE: AS NOTED DATE: APRIL 1999

SHEET No. 1 OF 4 SHEETS

RECORD DRAWINGS

57

ORIGINAL PLAN	SURVEY PLOTTED BY _____	DATE _____
NOTE BOOK	DRAWN BY _____	" _____
	TRACED BY _____	" _____
	DESIGNED BY _____	" _____
	QUANTITIES BY _____	" _____
	CHECKED BY _____	" _____
No. _____		

No. 05/15/96 11:46:09

TRAFFIC SIGNAL SYSTEM CONDUIT AND CABLE SCHEDULE


DELTA ITEM NO.	1	2	3	1488
----------------	---	---	---	---	---	---	---	---	---	----	----	-----	-----	------	------	
FED. ROAD DIST. NO.	STATE	FED. AID PROJ. NO.	FISCAL YEAR	SHEET NO.	TOTAL SHEETS
HAWAII	HAW.	IM-STP-0750(10)	1999	59	97


TRAFFIC SIGNAL SYSTEM CONDUIT AND CABLE SCHEDULE

DELTA ITEM NO.	△	△	△	△	△	△	△	△	△	△	△	△	△
QUANTITY OF 2" C TRAFFIC SIGNAL, SEE NOTE NO. 1	2	1	3	4	4	1							
QUANTITY OF 26/C #14 CONTROL CABLE, SEE NOTE NO. 1		1	1	1	1								
QUANTITY OF 2/C #14 SHIELDED LOOP DETECTOR AND PEDESTRIAN PB CABLE	1			1	2								
QUANTITY OF 3/C #20 SHIELDED OPTICOM CABLE			1	1	1								
QUANTITY OF 12 PAIR #19 INTERCONNECT CABLE, SEE NOTE NO. 1						1							
QUANTITY OF 2" C FOR STREET LIGHT CABLE, SEE CONNECTION DIAGRAM FOR NO. & SIZE						1							
QUANTITY OF SPARE CONDUIT WITH PULLWIRE	1		1	1	1								

NOTES: 1. ALL CONDUITS SHALL BE PVC SCHEDULE 80, UNLESS OTHERWISE NOTED
2. ALL DUCT SECTIONS SEE SHEETS 53 & 54

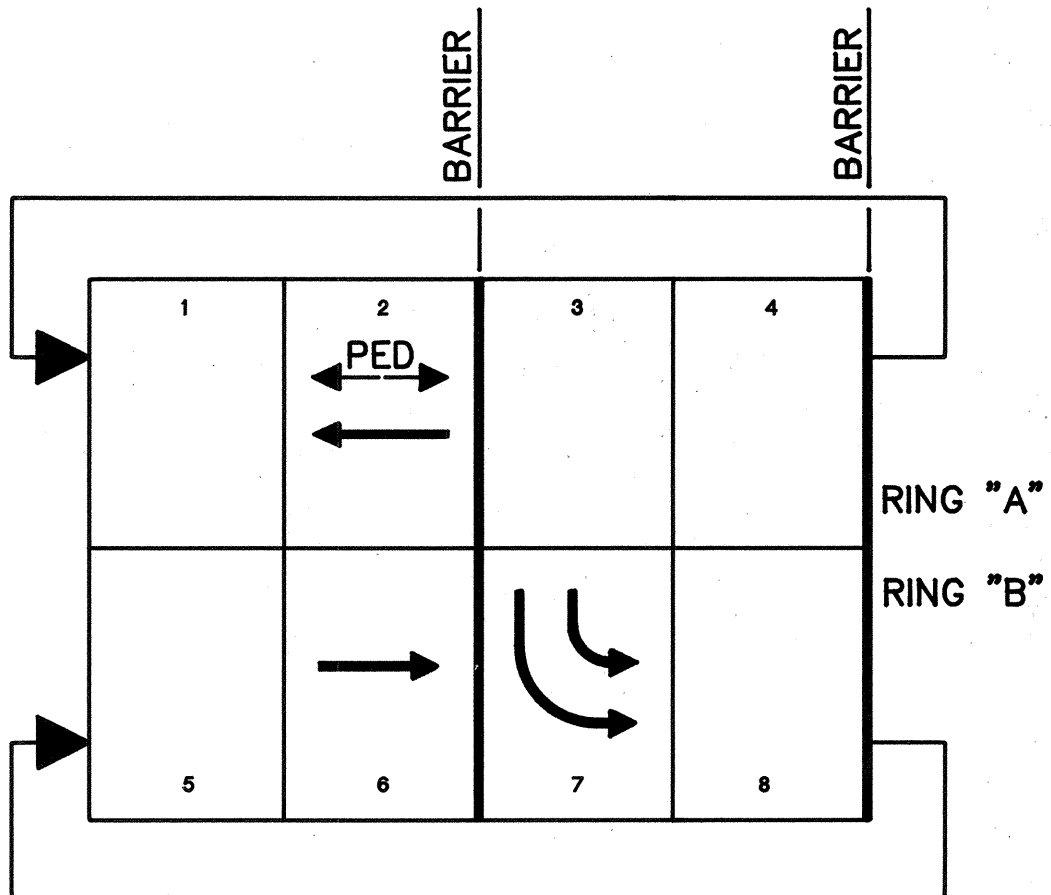


PHASE DIAGRAM
N.T.S.

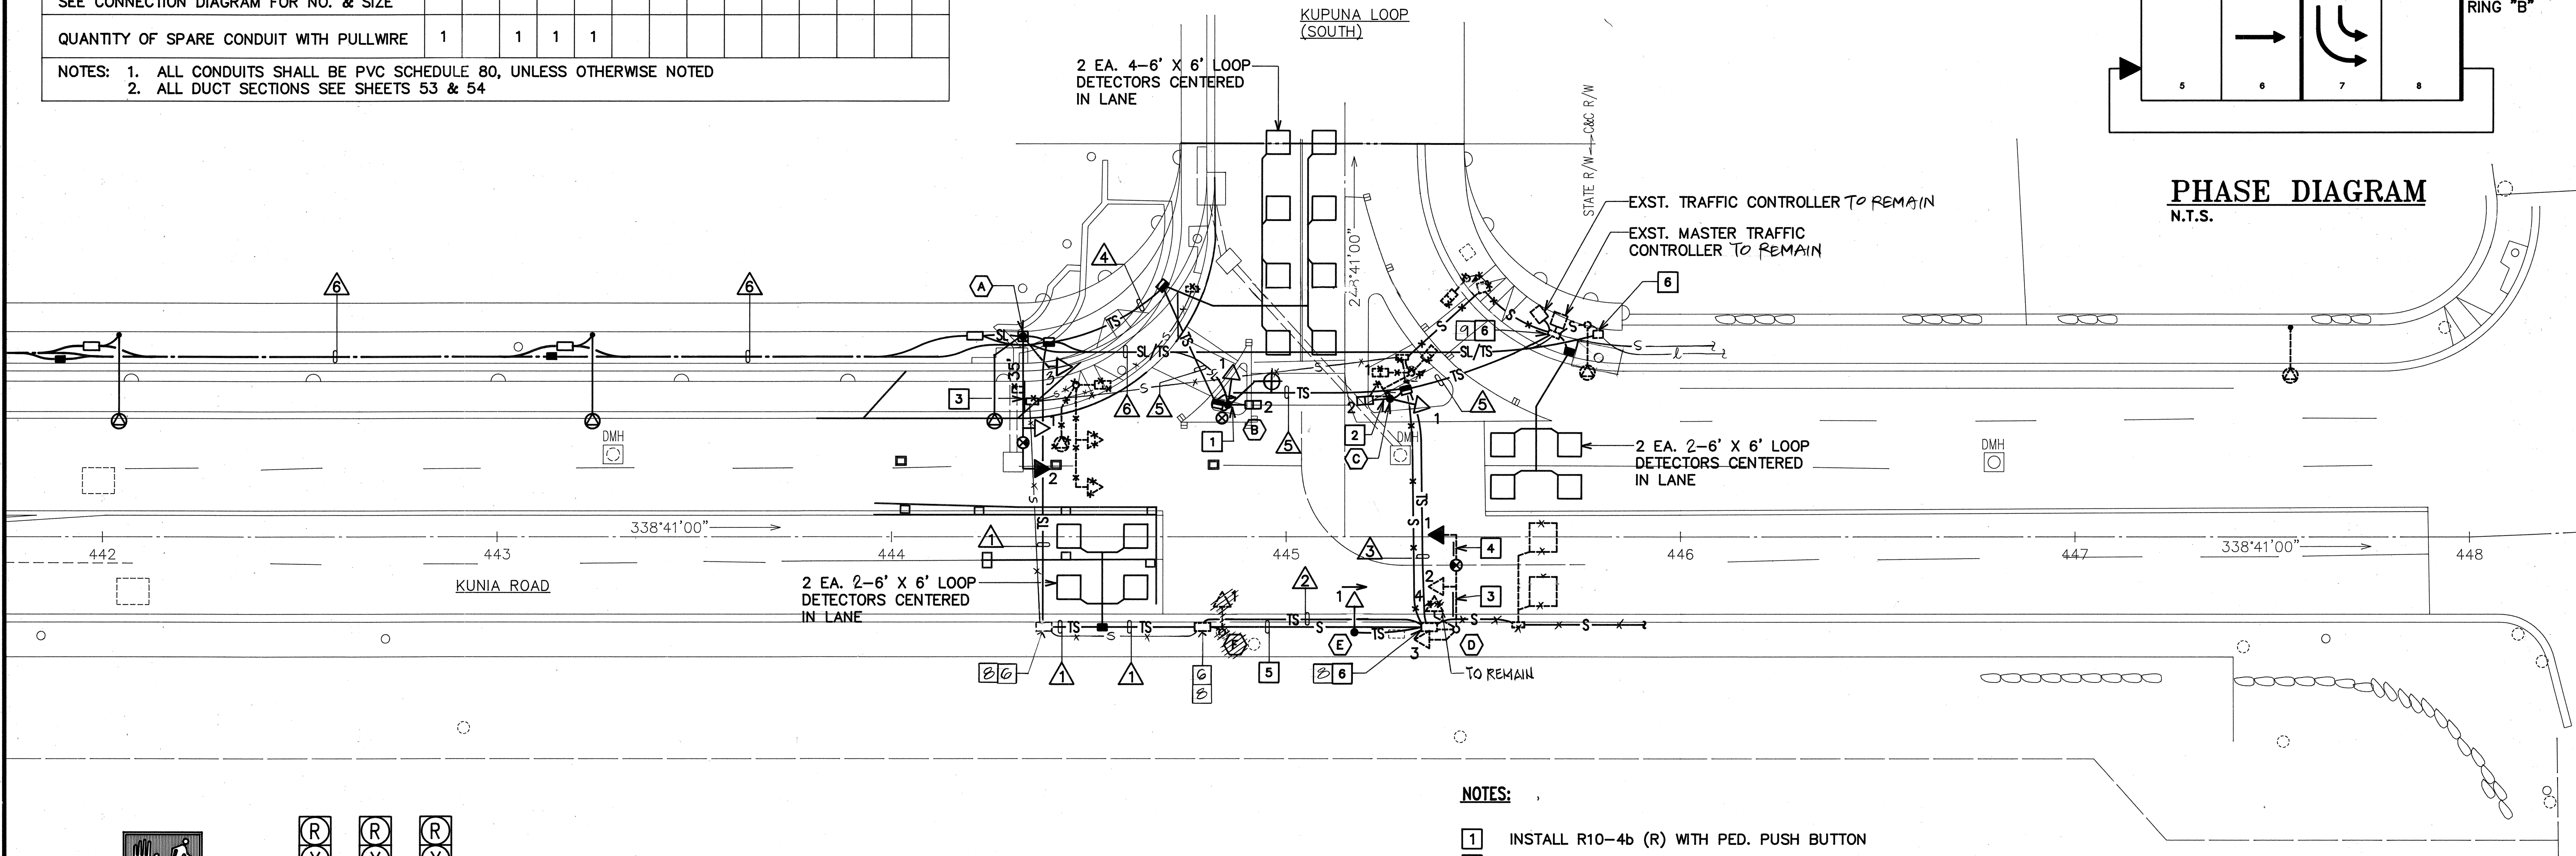


NOTES:

1. INSTALL R10-4b (R) WITH PED. PUSH BUTTON
2. INSTALL R10-4b (L) WITH PED. PUSH BUTTON
3. STREET NAME SIGN MTD. ON MAST ARM, SEE DETAIL
4. NO LEFT TURN SIGN MTD. ON MAST ARM, SEE DETAIL
5. EXST. 1-2" C WITH 1-19C #14
6. REPAIR EXST. PULLBOX TO MATCH EXST. CONDITION
7. EXST. 2" C WITH 1-2C #2, #8 GND, 2" C WITH 1-24C #20 & 2" C WITH 2-2C #14
8. EXST. 19" X 28" TRAFFIC SIGNAL PULLBOX.
9. EXST. 24" X 32" TRAFFIC SIGNAL PULLBOX.

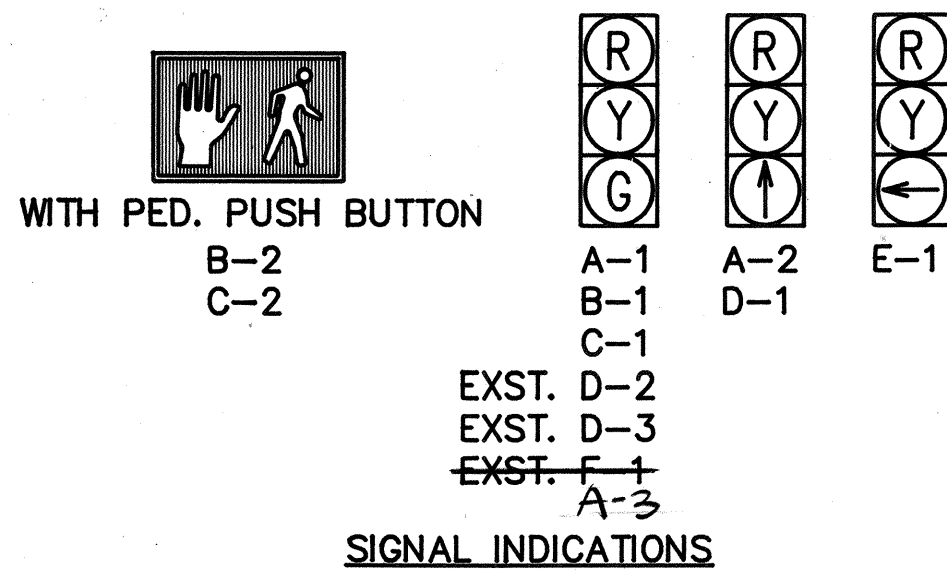

SIGN DETAIL
NOT TO SCALE

TRAFFIC SIGNAL PLAN - KUNIA ROAD/KUPUNA LOOP (SOUTH) INTERSECTION
SCALE: 1"=20'

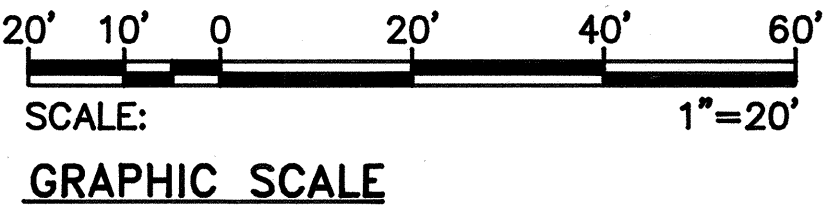

APPROVED:

HAWAIIAN ELECTRIC CO., DATE

HAWAIIAN TELEPHONE CO., DATE


STATE OF HAWAII
DEPARTMENT OF TRANSPORTATION
HIGHWAYS DIVISION

TRAFFIC SIGNAL PLAN -
KUNIA ROAD/KUPUNA LOOP
(SOUTH) INTERSECTION

KUNIA ROAD WIDENING; AND
H-1, KUNIA I.C., RAMP KO WIDENING
F.A.I. PROJECT NO. IM-STP-0750(10)

SCALE: AS NOTED DATE: APRIL 1999

SHEET No. 3 OF 4 SHEETS

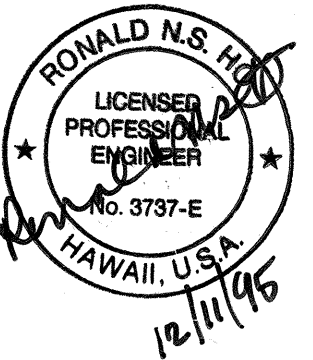

DATE

SURVEY PLOTTED BY

DRAWN BY

DESIGNED BY

QUANTITIES BY

CHECKED BY

ORIGINAL PLAN

NOTE BOOK


No.

Let 12/08/95 10:03:32 by R
G:\VADO\PROJECTS\IM-STP-0750\TRAFFIC

TRAFFIC SIGNAL SYSTEM CONDUIT AND CABLE SCHEDULE — KUNIA ROAD/KUNIA RAMP INTERSECTION														
DELTA ITEM NO.	①	②	③	④	⑤	⑥	⑦	⑧	⑨	⑩	⑪	⑫	⑬	⑭
QUANTITY OF 2" C TRAFFIC SIGNAL, SEE NOTE NO. 2	4	3	6	6	1	1	2							
QUANTITY OF 26/C #14 CONTROL CABLE, SEE NOTE NO. 1														
QUANTITY OF 2/C #14 SHIELDED LOOP DETECTOR AND PEDESTRIAN PB CABLE		1	1											
QUANTITY OF 3/C #20 SHIELDED OPTICOM CABLE														
QUANTITY OF 12PAIR #19 INTERCONNECT CABLE, SEE NOTE NO. 1		1	1											
QUANTITY OF 3/C #2, SECONDARY, #8 GND, POWER CABLE		1	1											
QUANTITY OF 2" C TELEPHONE, WITH PULLWIRE						1								
QUANTITY OF SPARE CONDUIT WITH PULLWIRE	4		3	6	1		2							
QUANTITY OF 2/C #8, #8 GND PULLWIRE														

NOTES:
 1. ALL CONDUITS SHALL BE PVC SCHEDULE 80, UNLESS OTHERWISE NOTED
 2. ALL DUCT SECTIONS SEE SHEET 52 & 53

NOTES: 1. ALL CONDUITS SHALL BE PVC SCHEDULE 80, UNLESS OTHERWISE NOTED
2. ALL DUCT SECTIONS SEE SHEET 52 & 53

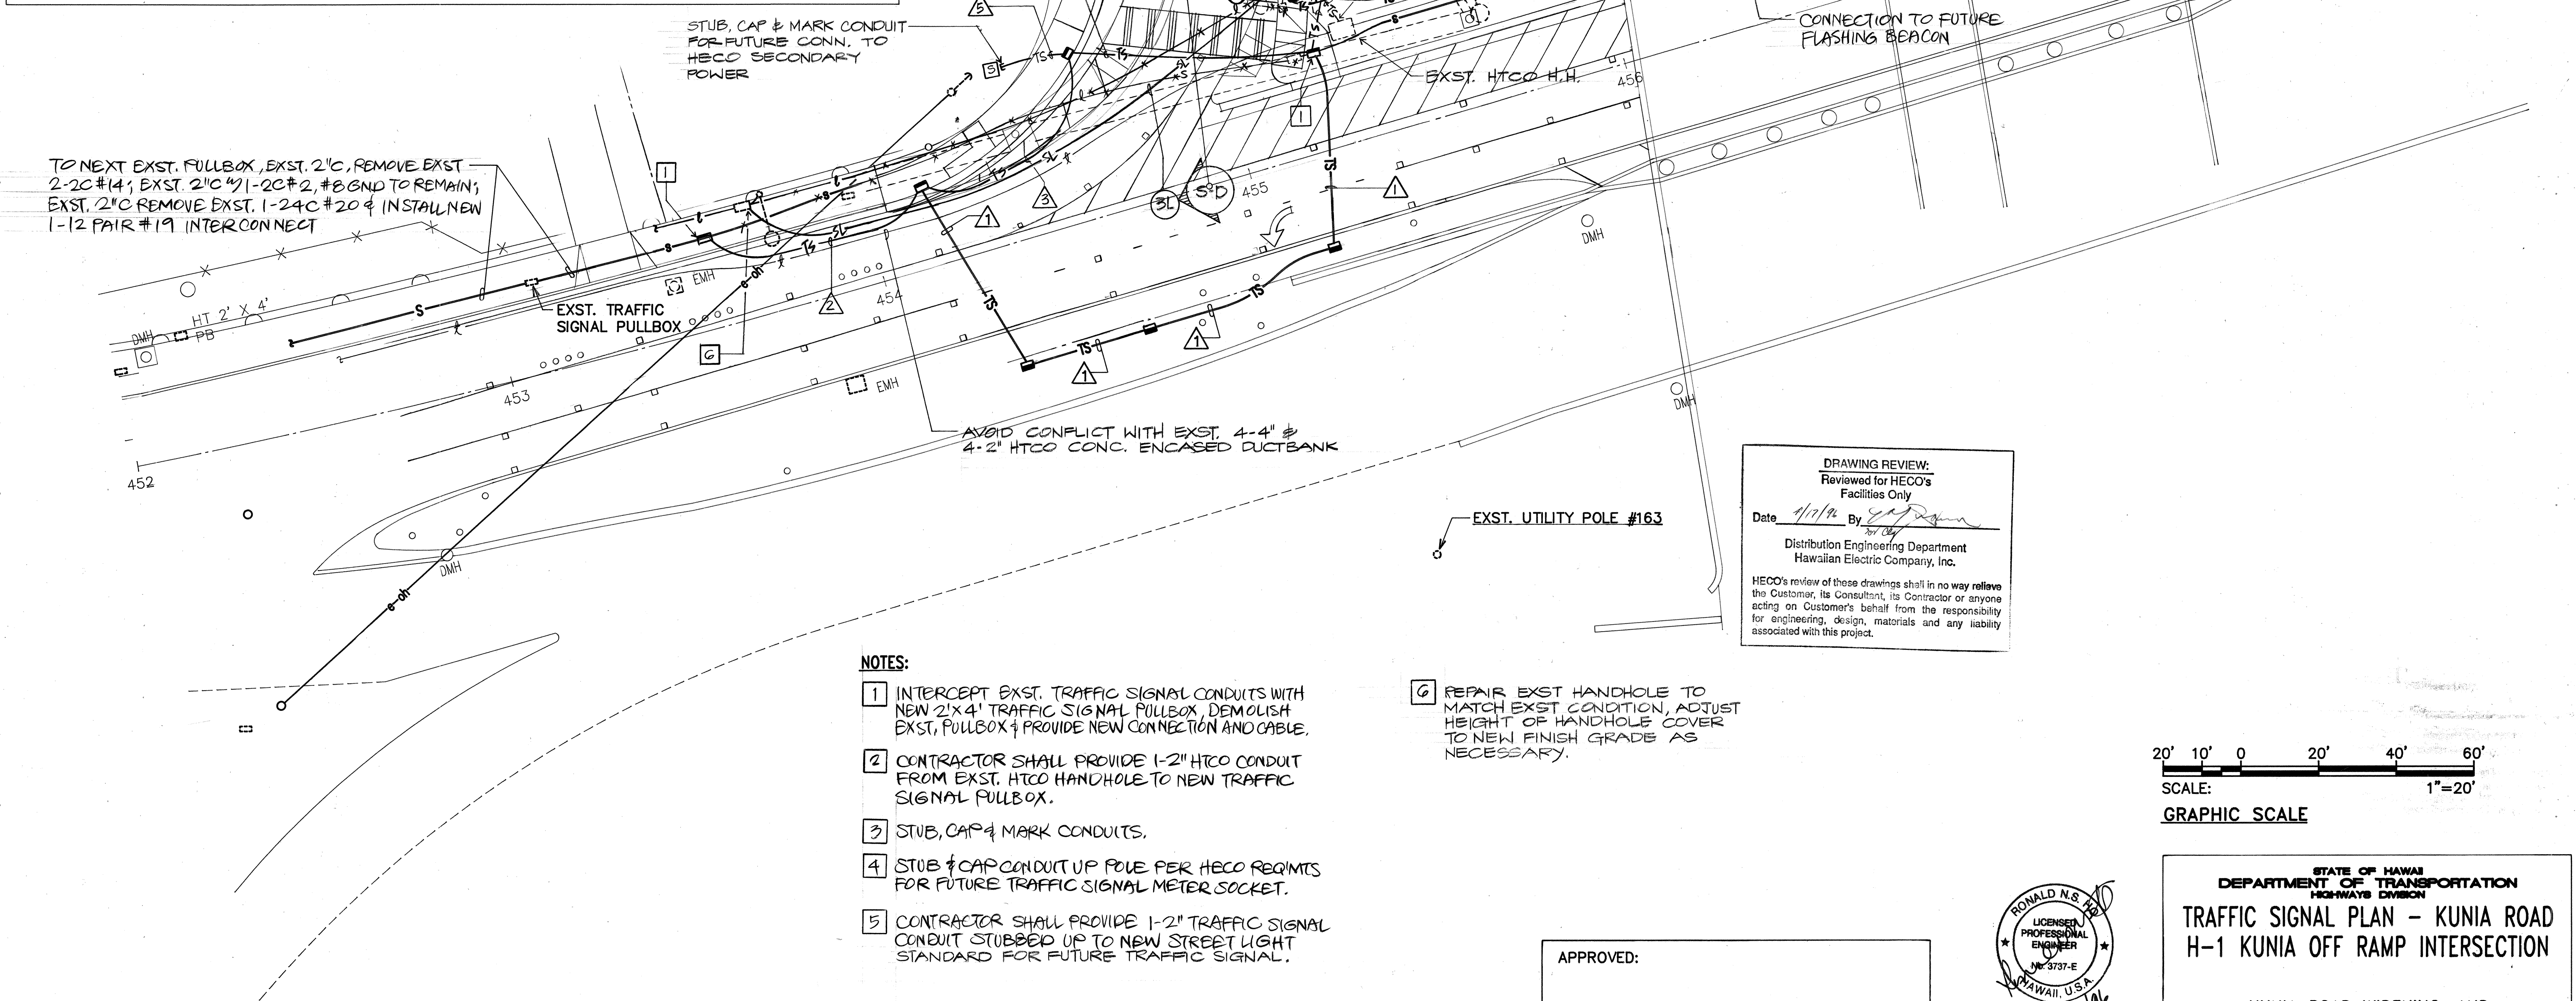

DRAWING REVIEW:
Reviewed for HECO's
Facilities Only

Date 4/2/92 By [Signature]
Not OK

Distribution Engineering Department
Hawaiian Electric Company, Inc.

HECO's review of these drawings shall in no way relieve the Customer, its Consultants, its Contractor or anyone acting on Customer's behalf from the responsibility for engineering, design, materials and any liability associated with this project.

- NOTES:**

 - 1 INTERCEPT EXST. TRAFFIC SIGNAL CONDUITS WITH NEW 2'x4' TRAFFIC SIGNAL PULLBOX, DEMOLISH EXST. PULLBOX & PROVIDE NEW CONNECTION AND CABLE.
 - 2 CONTRACTOR SHALL PROVIDE 1-2" HECO CONDUIT FROM EXST. HECO HANDHOLE TO NEW TRAFFIC SIGNAL PULLBOX.
 - 3 STUB, CAP & MARK CONDUITS.
 - 4 STUB & CAP CONDUIT UP POLE PER HECO REQ'MENTS FOR FUTURE TRAFFIC SIGNAL METER SOCKET.
 - 5 CONTRACTOR SHALL PROVIDE 1-2" TRAFFIC SIGNAL CONDUIT STUBBED UP TO NEW STREET LIGHT STANDARD FOR FUTURE TRAFFIC SIGNAL.

6 REPAIR EXST HANDHOLE TO MATCH EXST CONDITION, ADJUST HEIGHT OF HANDHOLE COVER TO NEW FINISH GRADE AS NECESSARY.


APPROVED:

APPROVED:

HAWAIIAN ELECTRIC CO. DATE

W. Donnet T. Hayashi 4/10/90

HAWAIIAN TELEPHONE CO. DATE

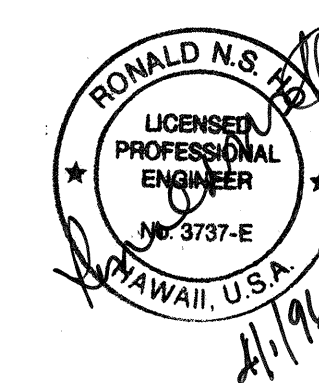

20' 10' 0 20' 40' 60'
SCALE: 1"=20'
GRAPHIC SCALE

STATE OF HAWAII
DEPARTMENT OF TRANSPORTATION
HIGHWAYS DIVISION

TRAFFIC SIGNAL PLAN - KUNIA ROAD
H-1 KUNIA OFF RAMP INTERSECTION

KUNIA ROAD WIDENING; AND
H-1, KUNIA I.C., RAMP KO WIDENING
F.A.I. PROJECT NO. IM-STP-0750(10)

SCALE: AS NOTED DATE: APRIL 1991

SHEET No. 4 OF 4 SHEETS