


FED. ROAD DIST. NO.	STATE	FED. AID PROJ. NO.	FISCAL YEAR	SHEET NO.	TOTAL SHEETS
HAWAII	HAW.	D-AD-1(2)	1958	3	29

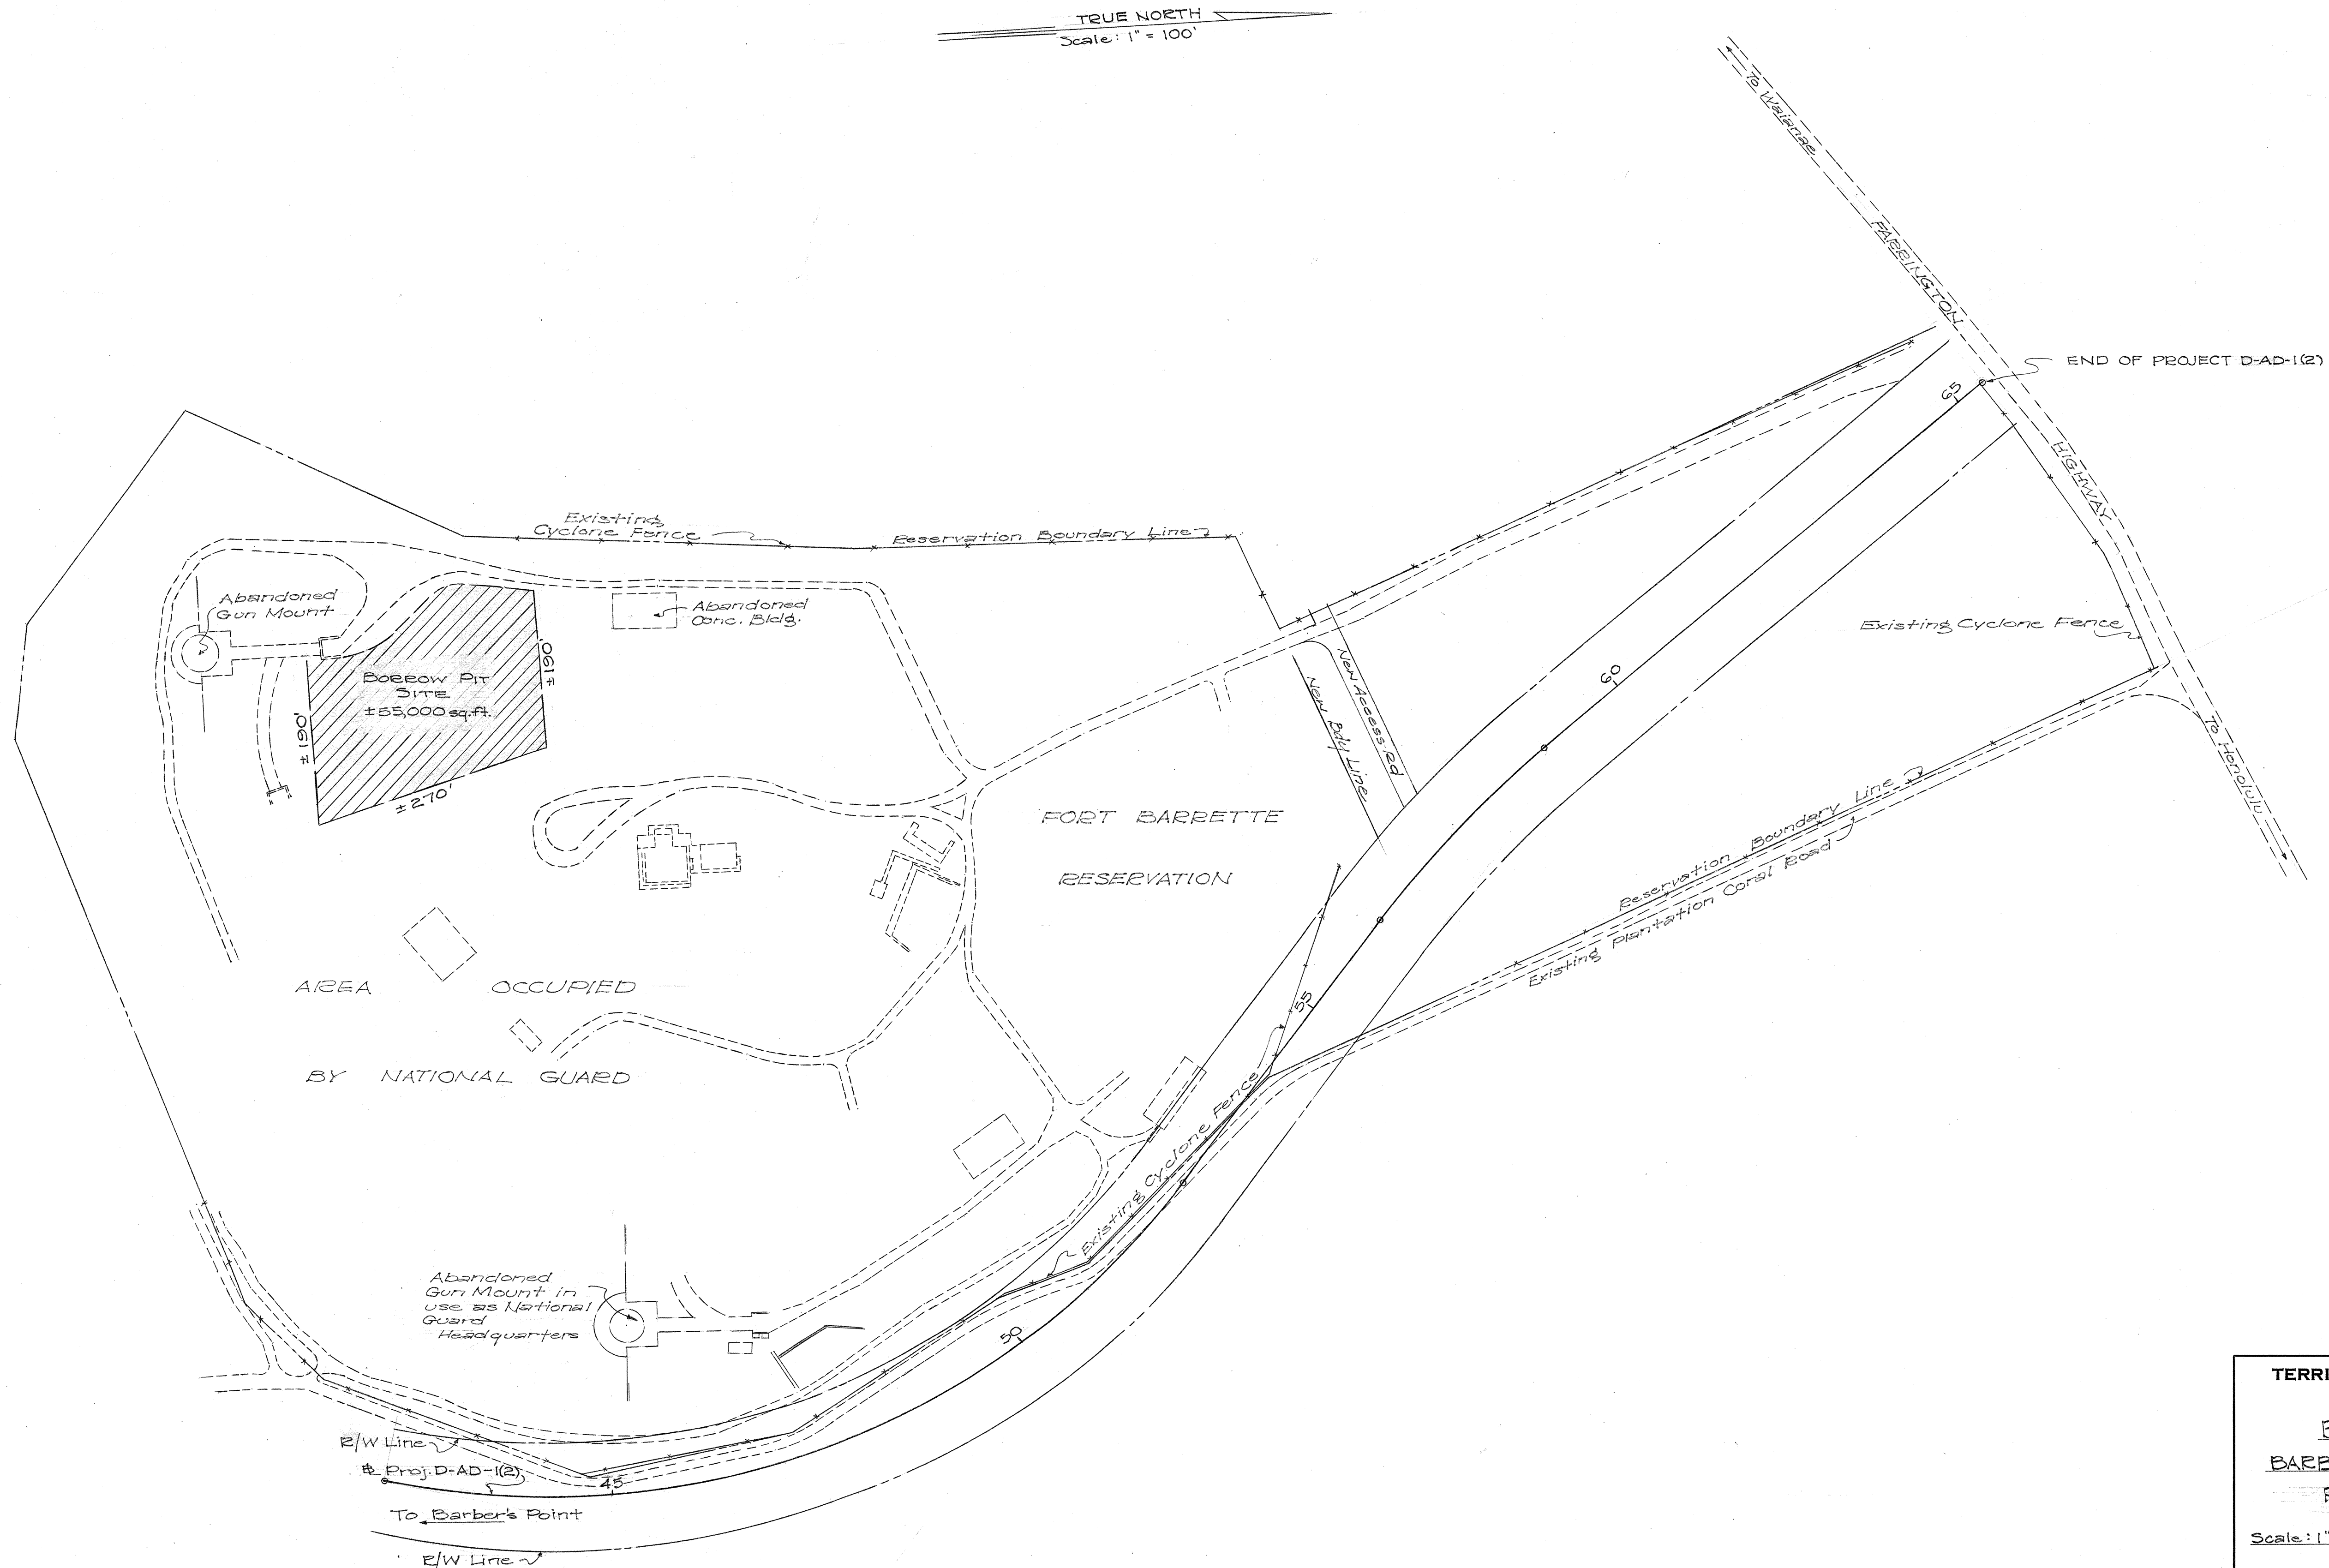

SURVEY PLOTTED BY	DATE
DESIGNED BY	
TRACED BY	
QUANTITIES CHECKED BY	
CHECKED BY	
ORIGINAL PLAN	
NOTE BOOK	
No.	

TERRITORIAL HIGHWAY DEPARTMENT
TERRITORY OF HAWAII

BORROW PIT SITE

BARBER'S POINT ACCESS RD.

PROJ. NO D-AD-1(2)

EWA, OAHU

Scale: 1" = 100' April, 1958

SHEET NO. OF SHEETS

5998.3