
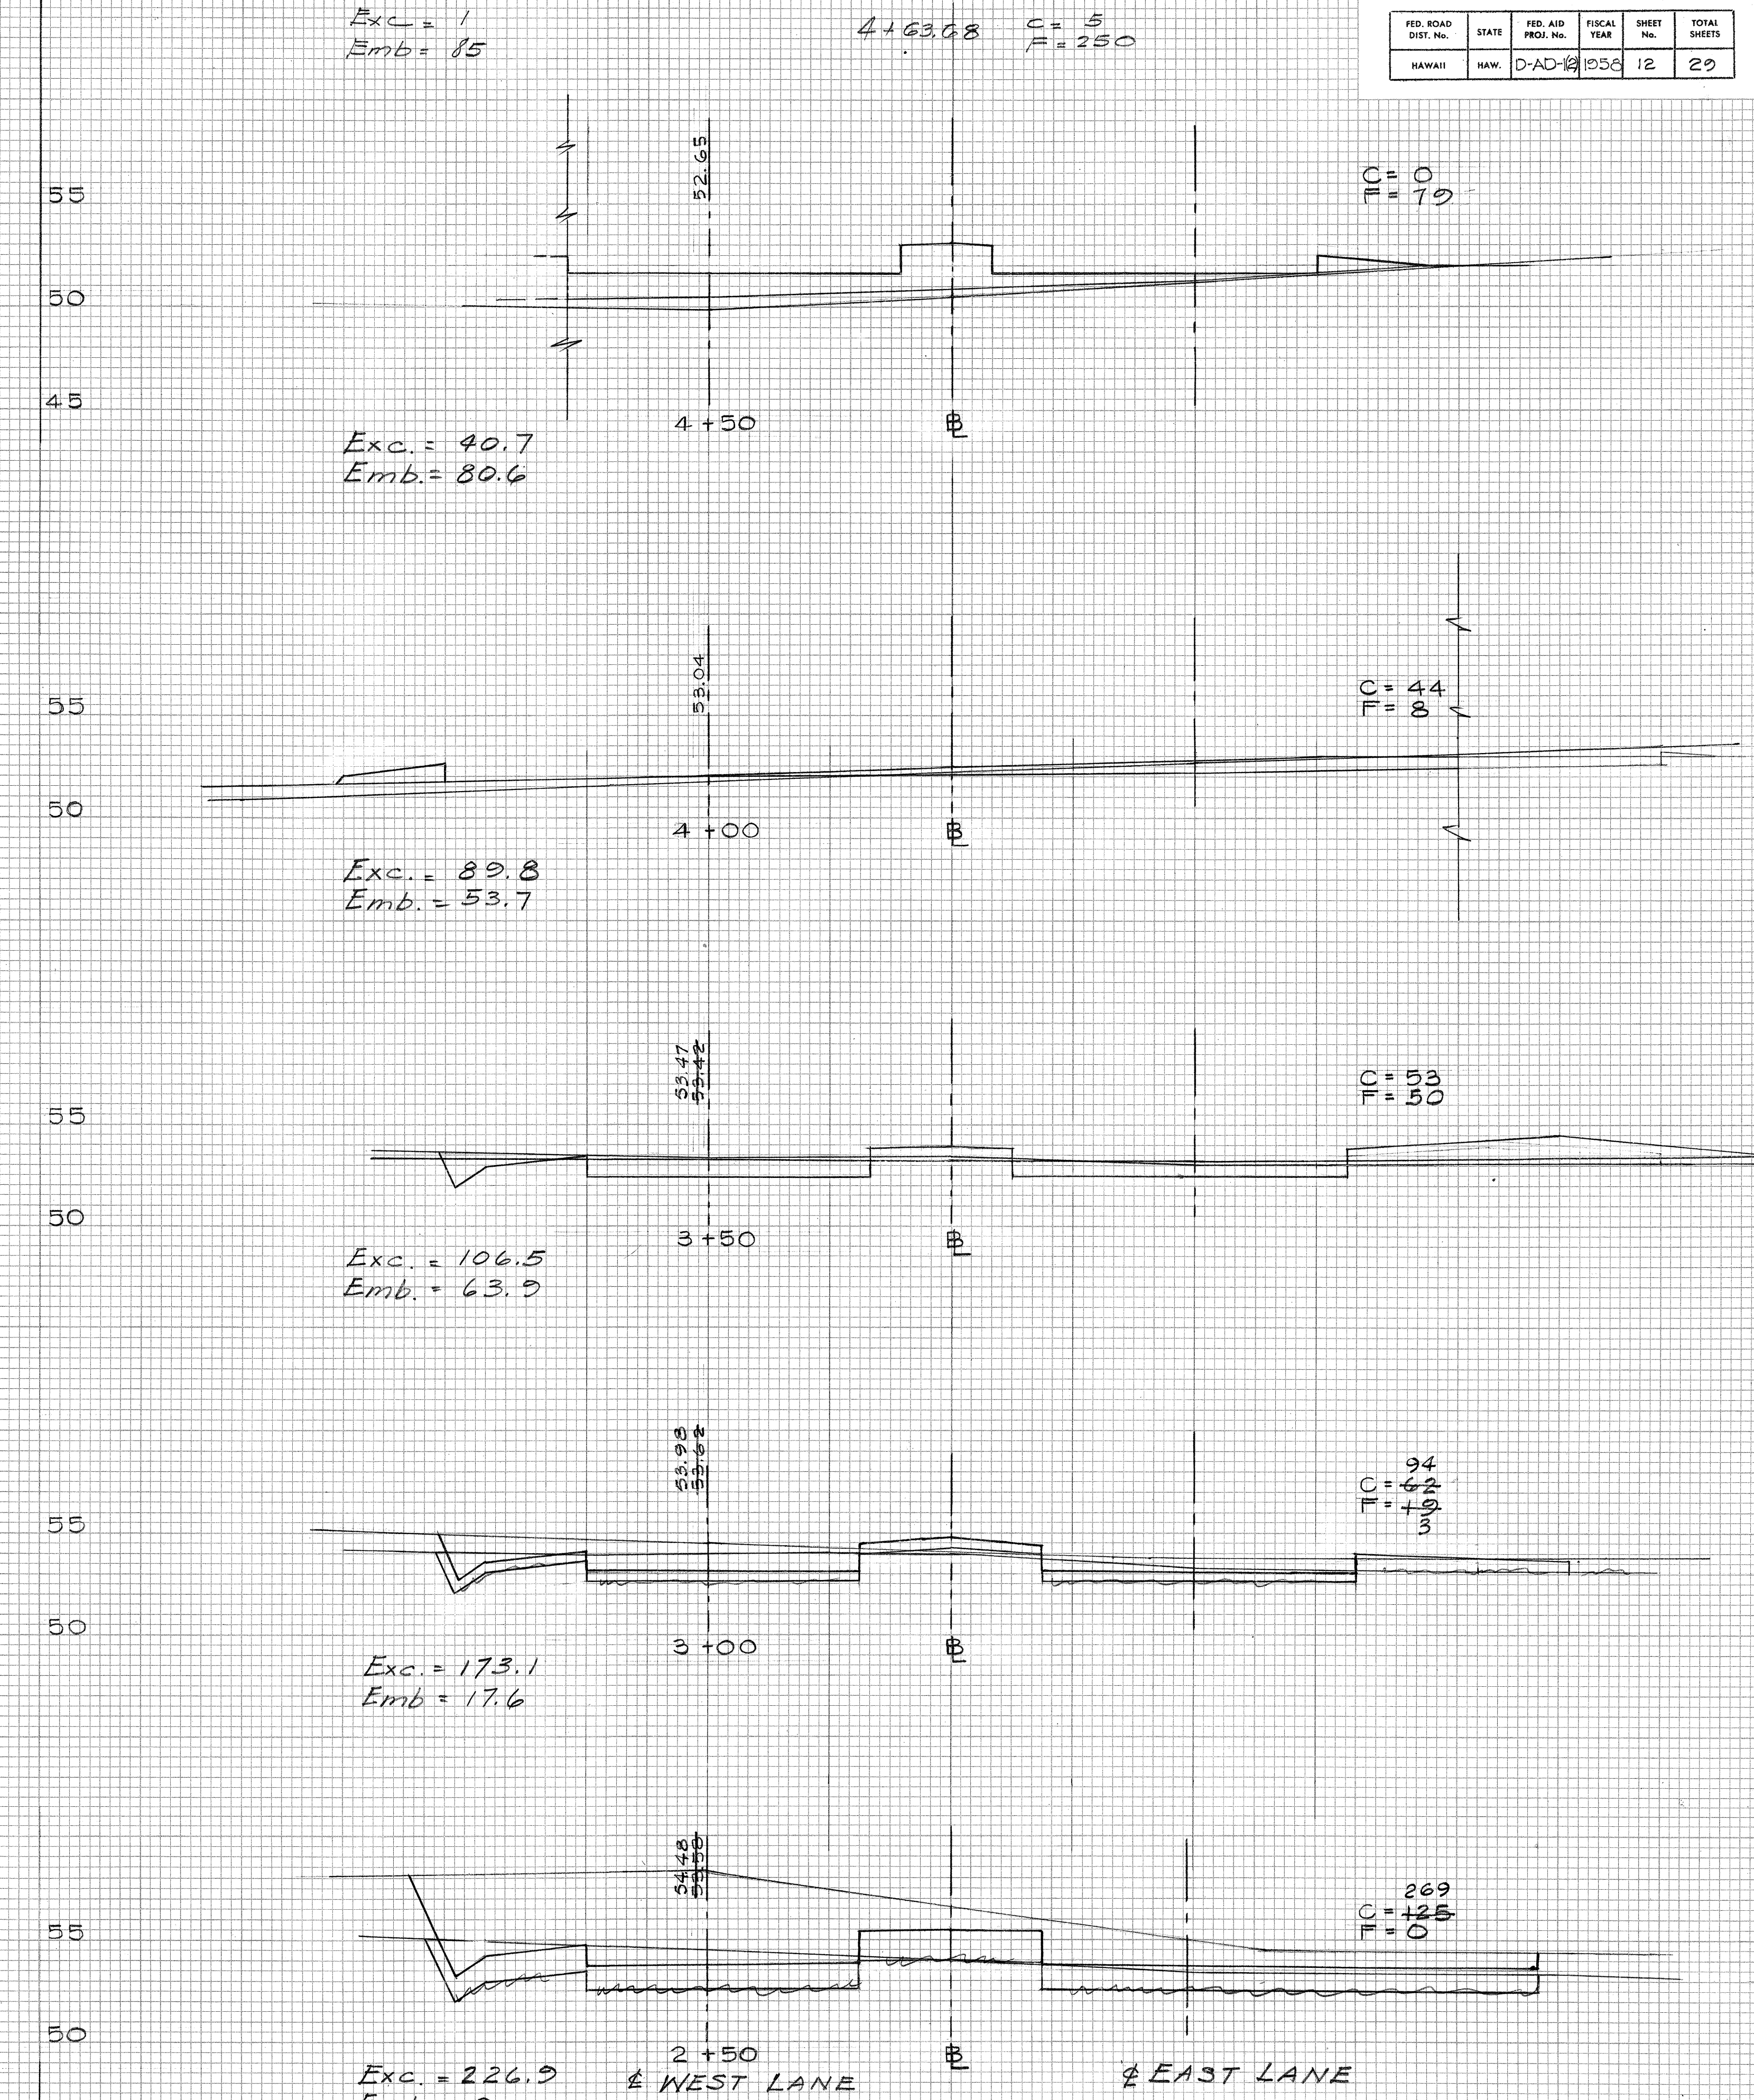


DATE	BY	NO.
		410-58
FINAL SURVEY	SURVEY	NO.
NOTE BOOK	NOTE BOOK	NO.
PLATTED	PLATTED	NO.
AREAS CHECKED	AREAS CHECKED	NO.

DATE	BY	NO.
ORIGINAL SURVEY	SURVEY	NO.
NOTE BOOK	NOTE BOOK	NO.
PLATTED	PLATTED	NO.
AREAS CHECKED	AREAS CHECKED	NO.

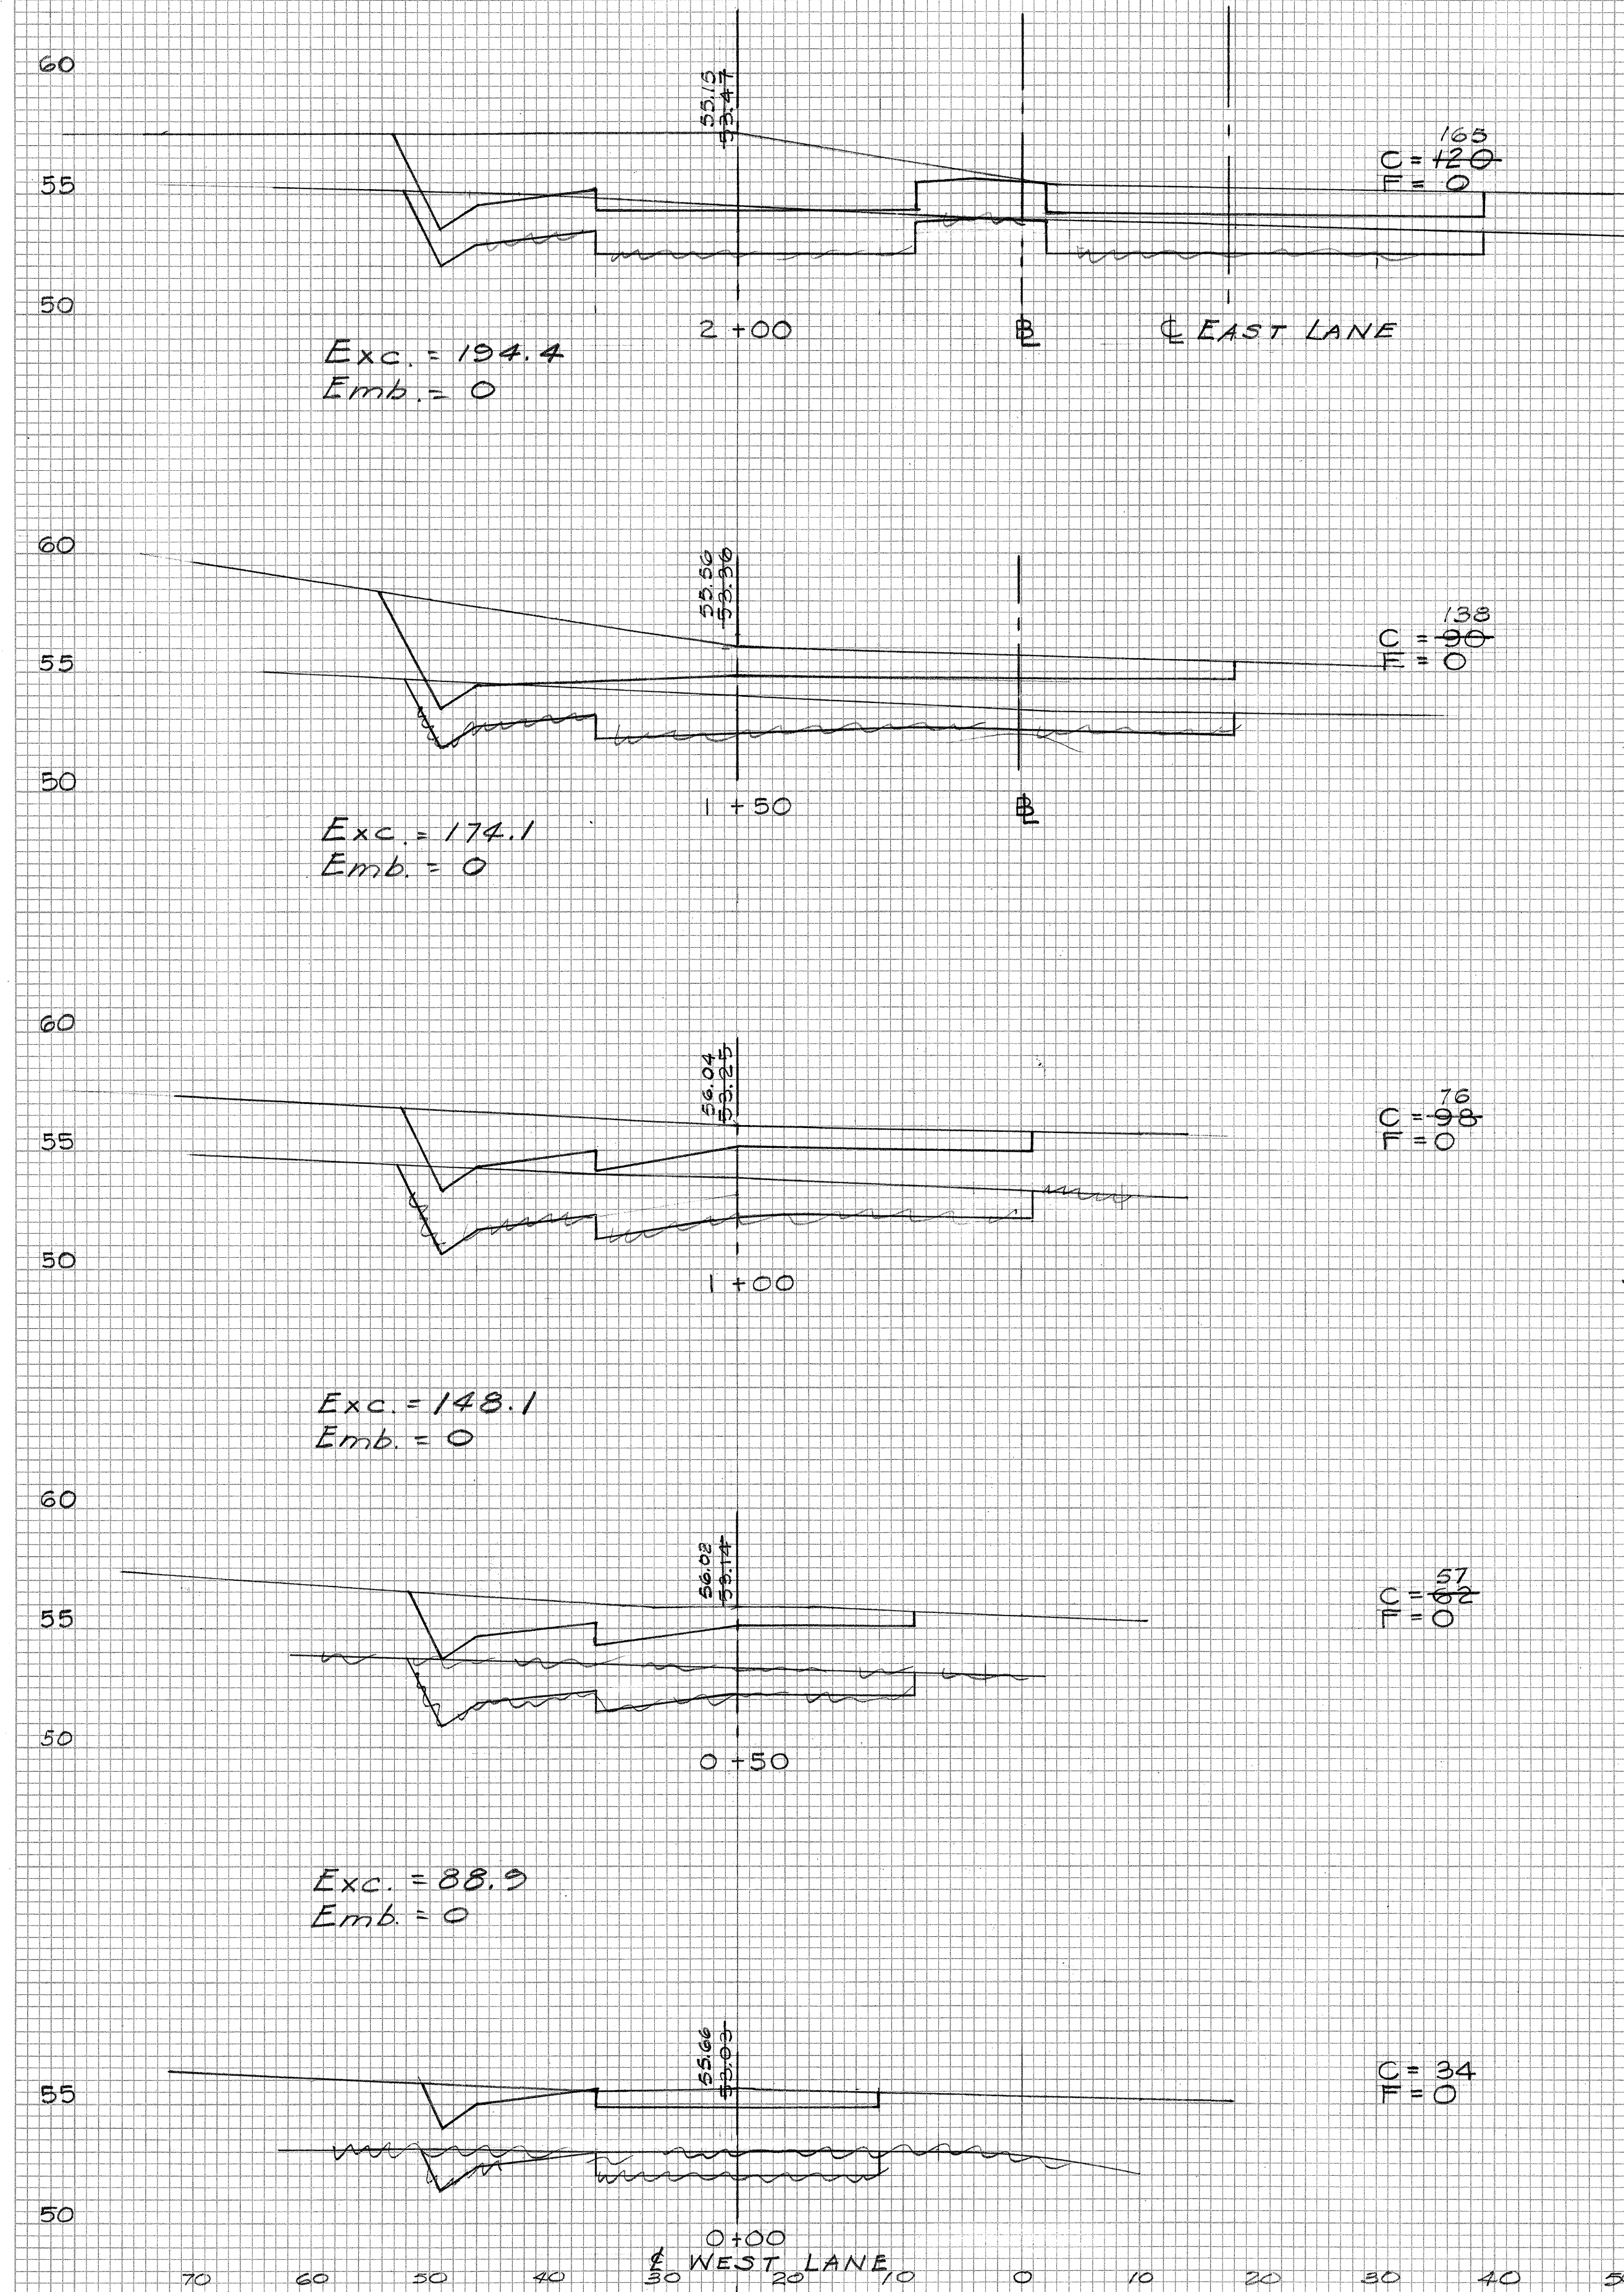

BARBER'S PT CONNECTION

PLATE 3 CROSS SECTION O. P. R. & R. E. STANDARD
100% RAG PAPER-MADE AND PRINTED IN U. S. A.
EUGENE DISTENFELD CO.



5998.12

FED. ROAD DIST. NO.	STATE	FED. AID PROJ. NO.	FISCAL YEAR	SHEET NO.	TOTAL SHEETS
HAWAII	HAW.	D-AD-103	1958	12	22

FINAL SURVEY	DATE	BY	
	SURVEYED	PLOTTED	
	NOTE BOOK	TEMPLATE	
	NO.	AREAS CHECKED	

ORIGINAL SURVEY	DATE	BY	
	SURVEYED	PLOTTED	
	NOTE BOOK	TEMPLATE	
	NO.	AREAS CHECKED	

FED. ROAD DIST. No.	STATE	FED. AID PROJ. No.	FISCAL YEAR	SHEET No.	TOTAL SHEETS
HAWAII	HAW.	D-AD-12	1958	13	22

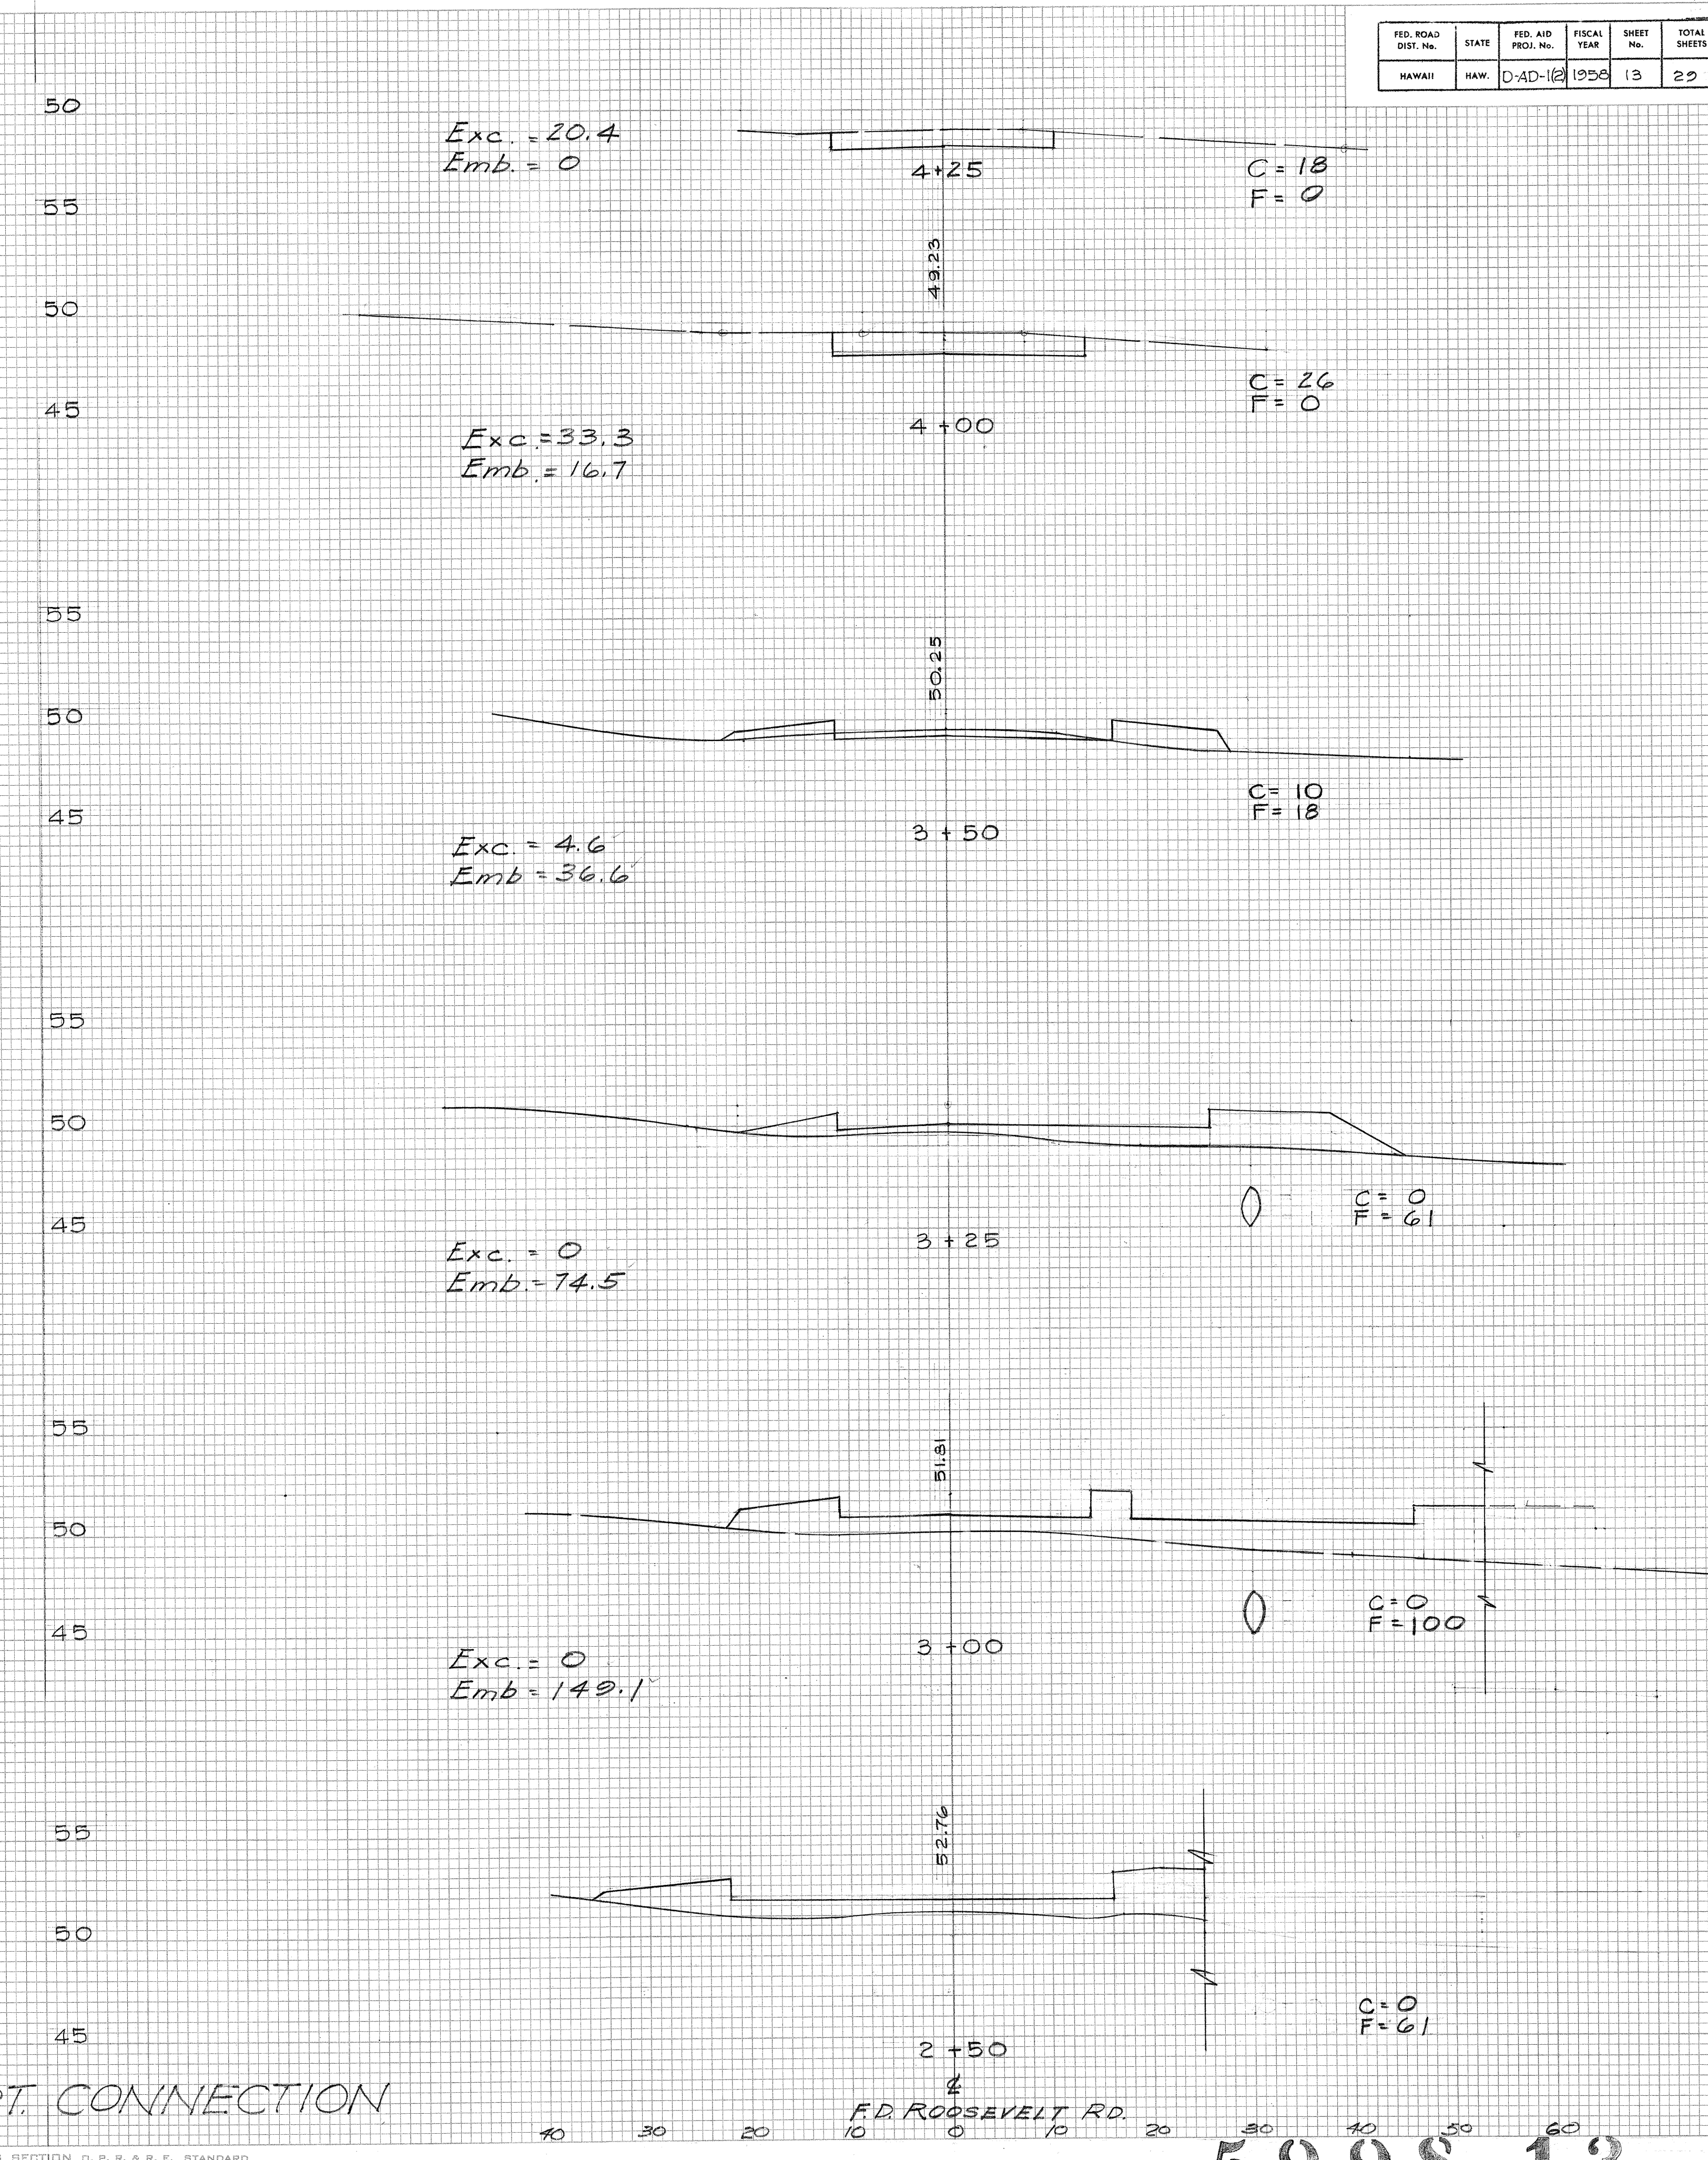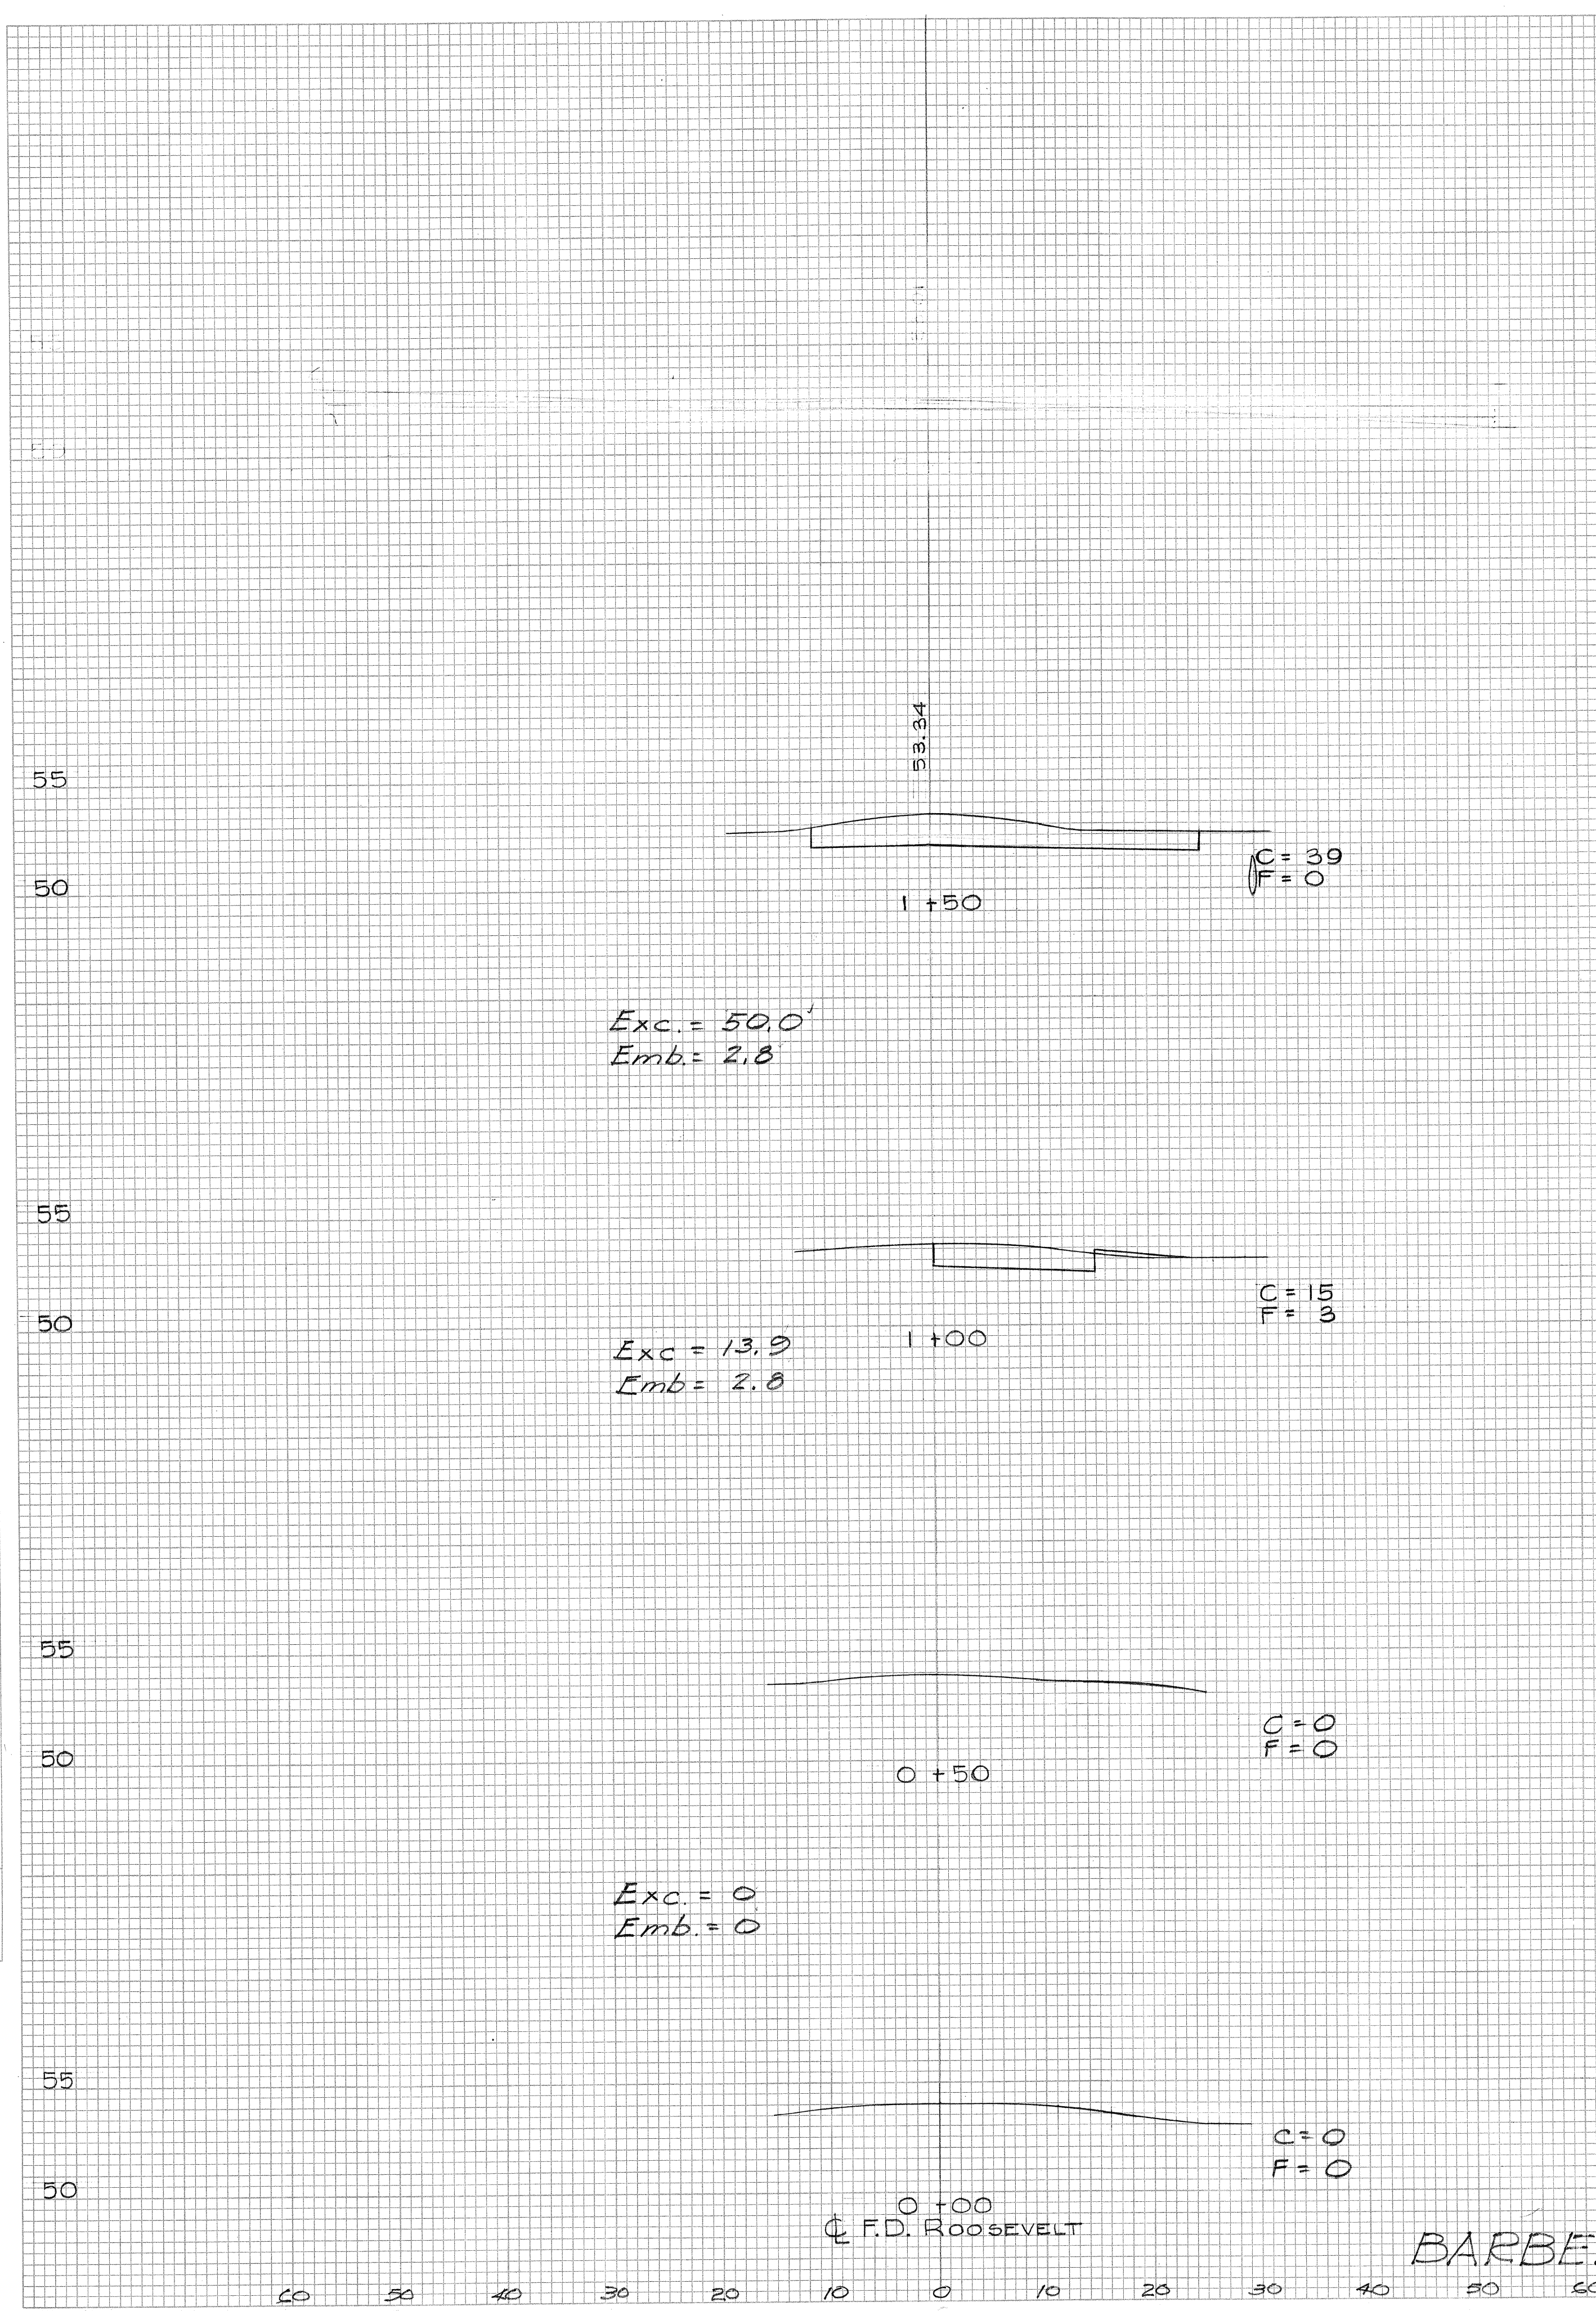



BARBER'S PT. CONNECTION

PLATE 3 CROSS SECTION D.P.R. & R.E. STANDARD
100% RAS PAPER-MADE AND PRINTED IN U. S. A.
EUGENE DIETZEN CO.

Sheet 12

FINAL SURVEY	DATE	
	BY	
	SURVEY PLOTTER	
	NOTE BOOK NO.	



ORIGINAL SURVEY	DATE	
	BY	
	SURVEY PLOTTER	
	NOTE BOOK NO.	

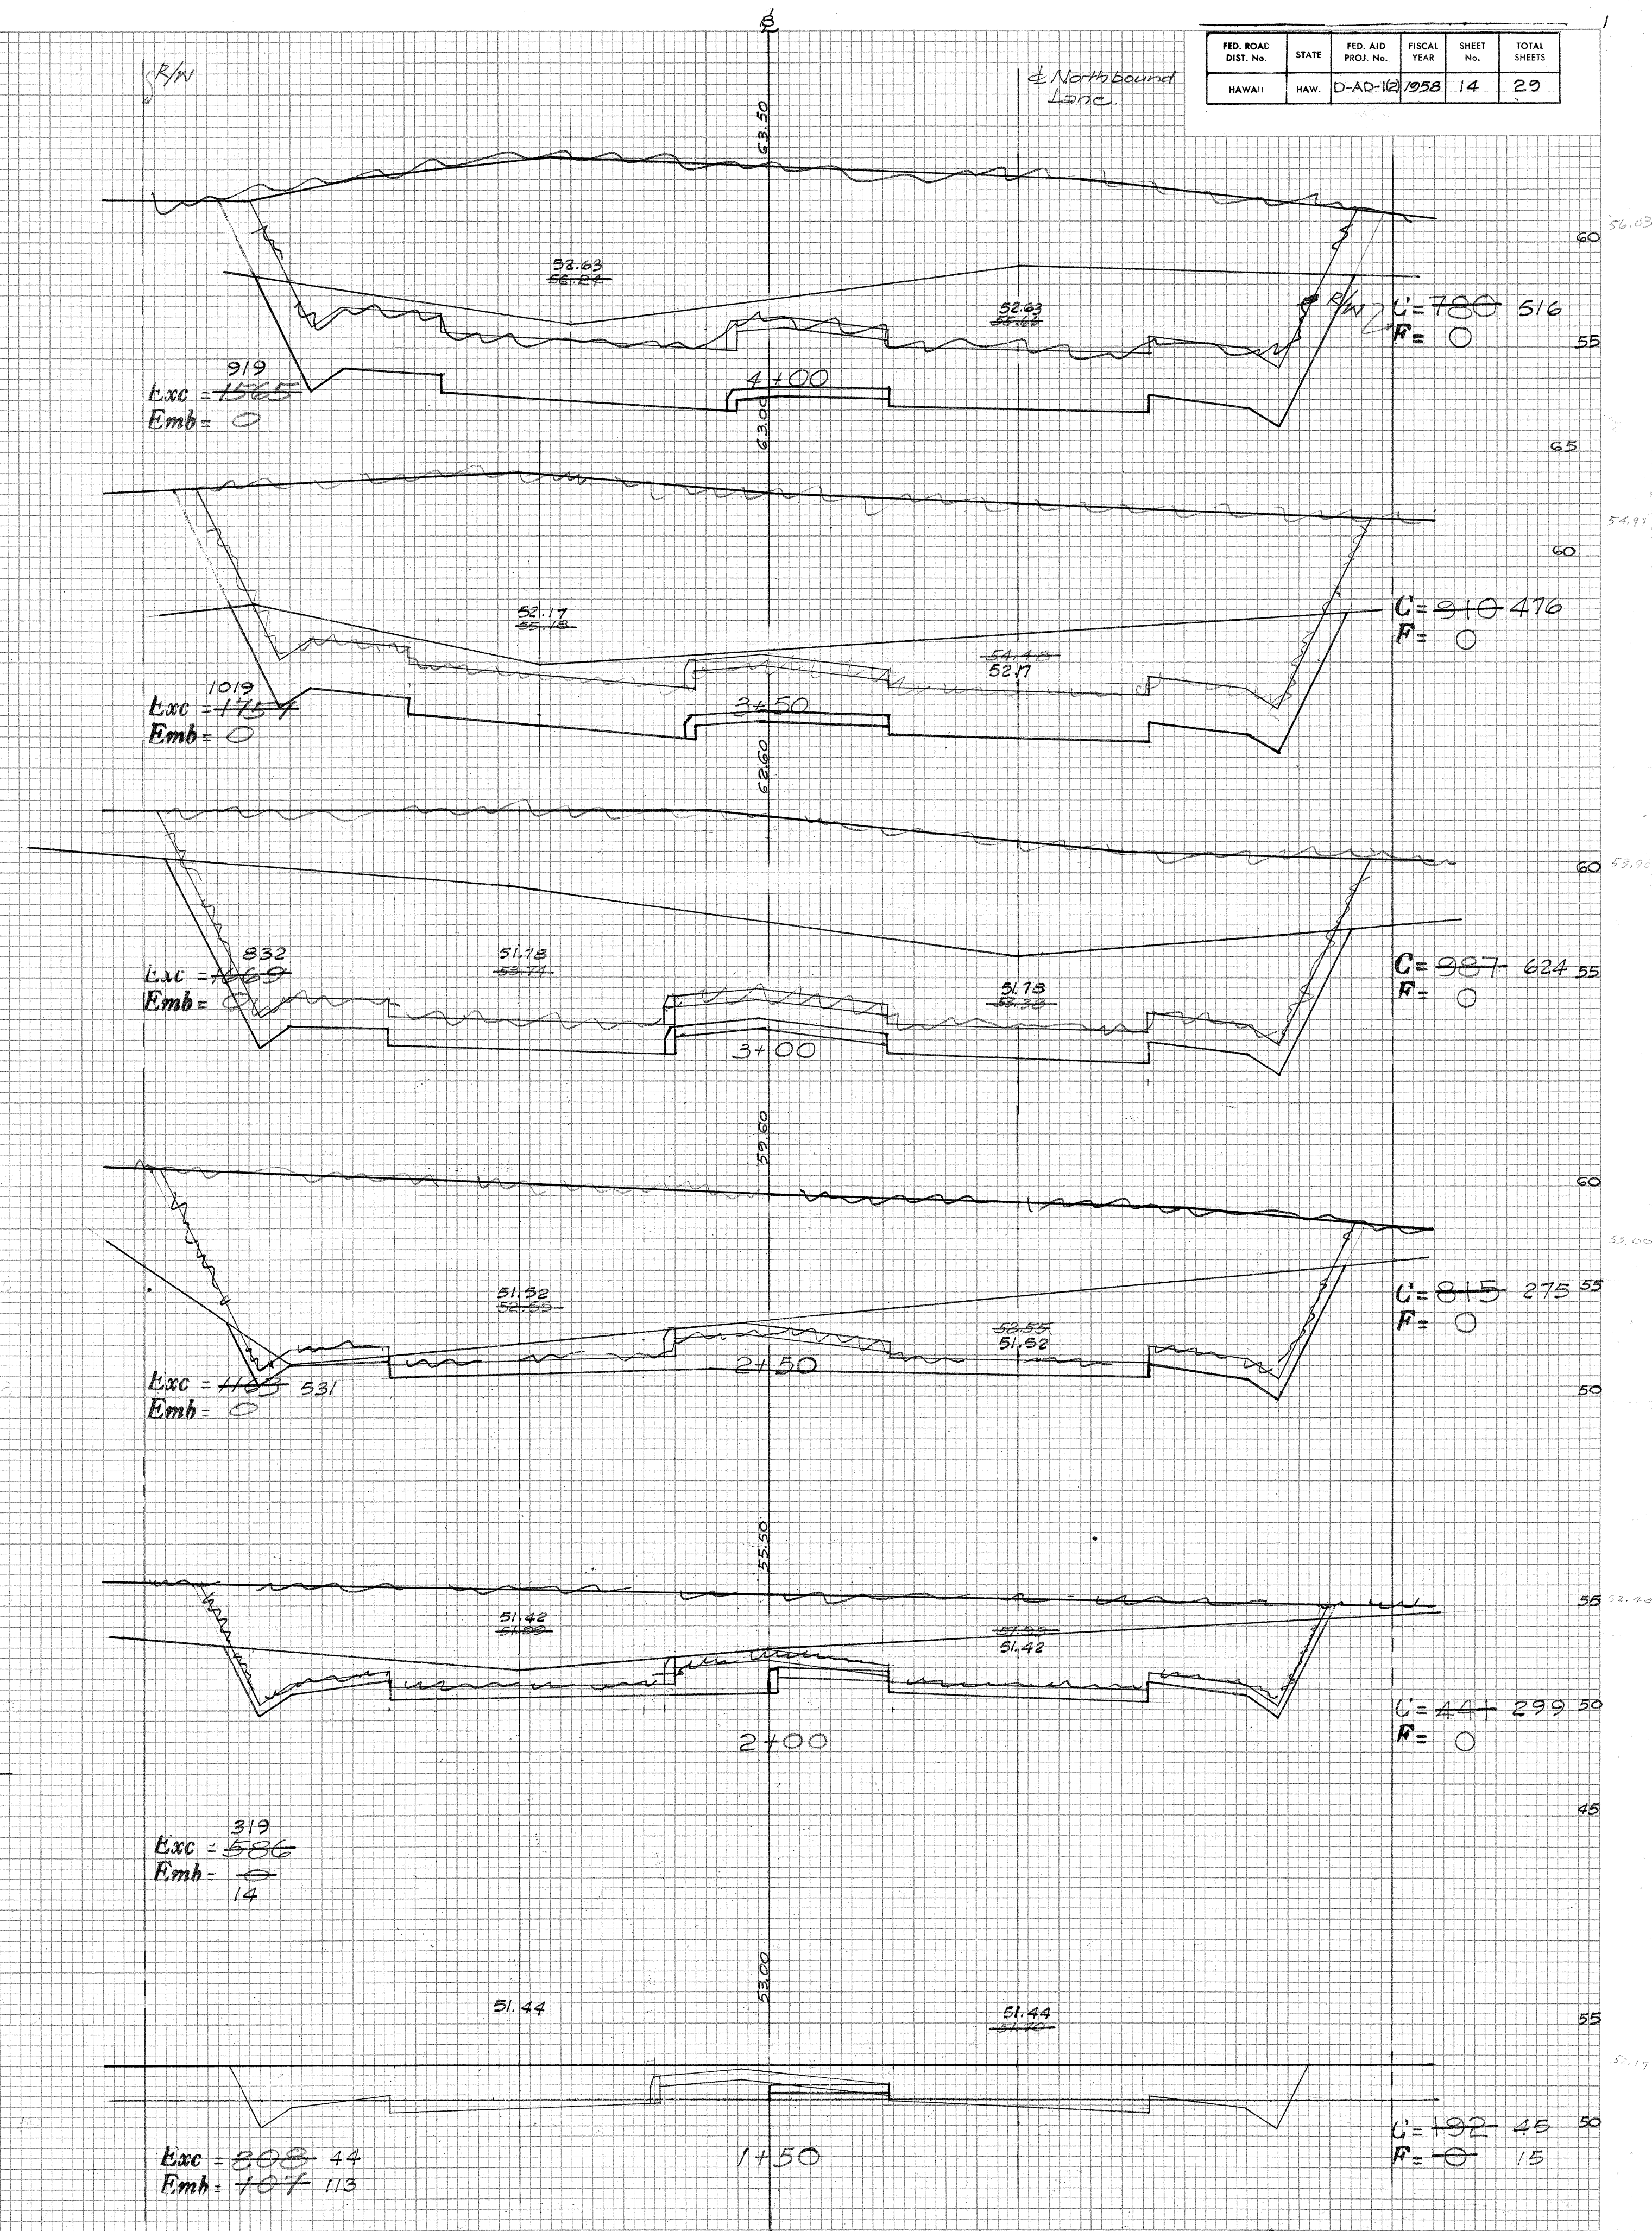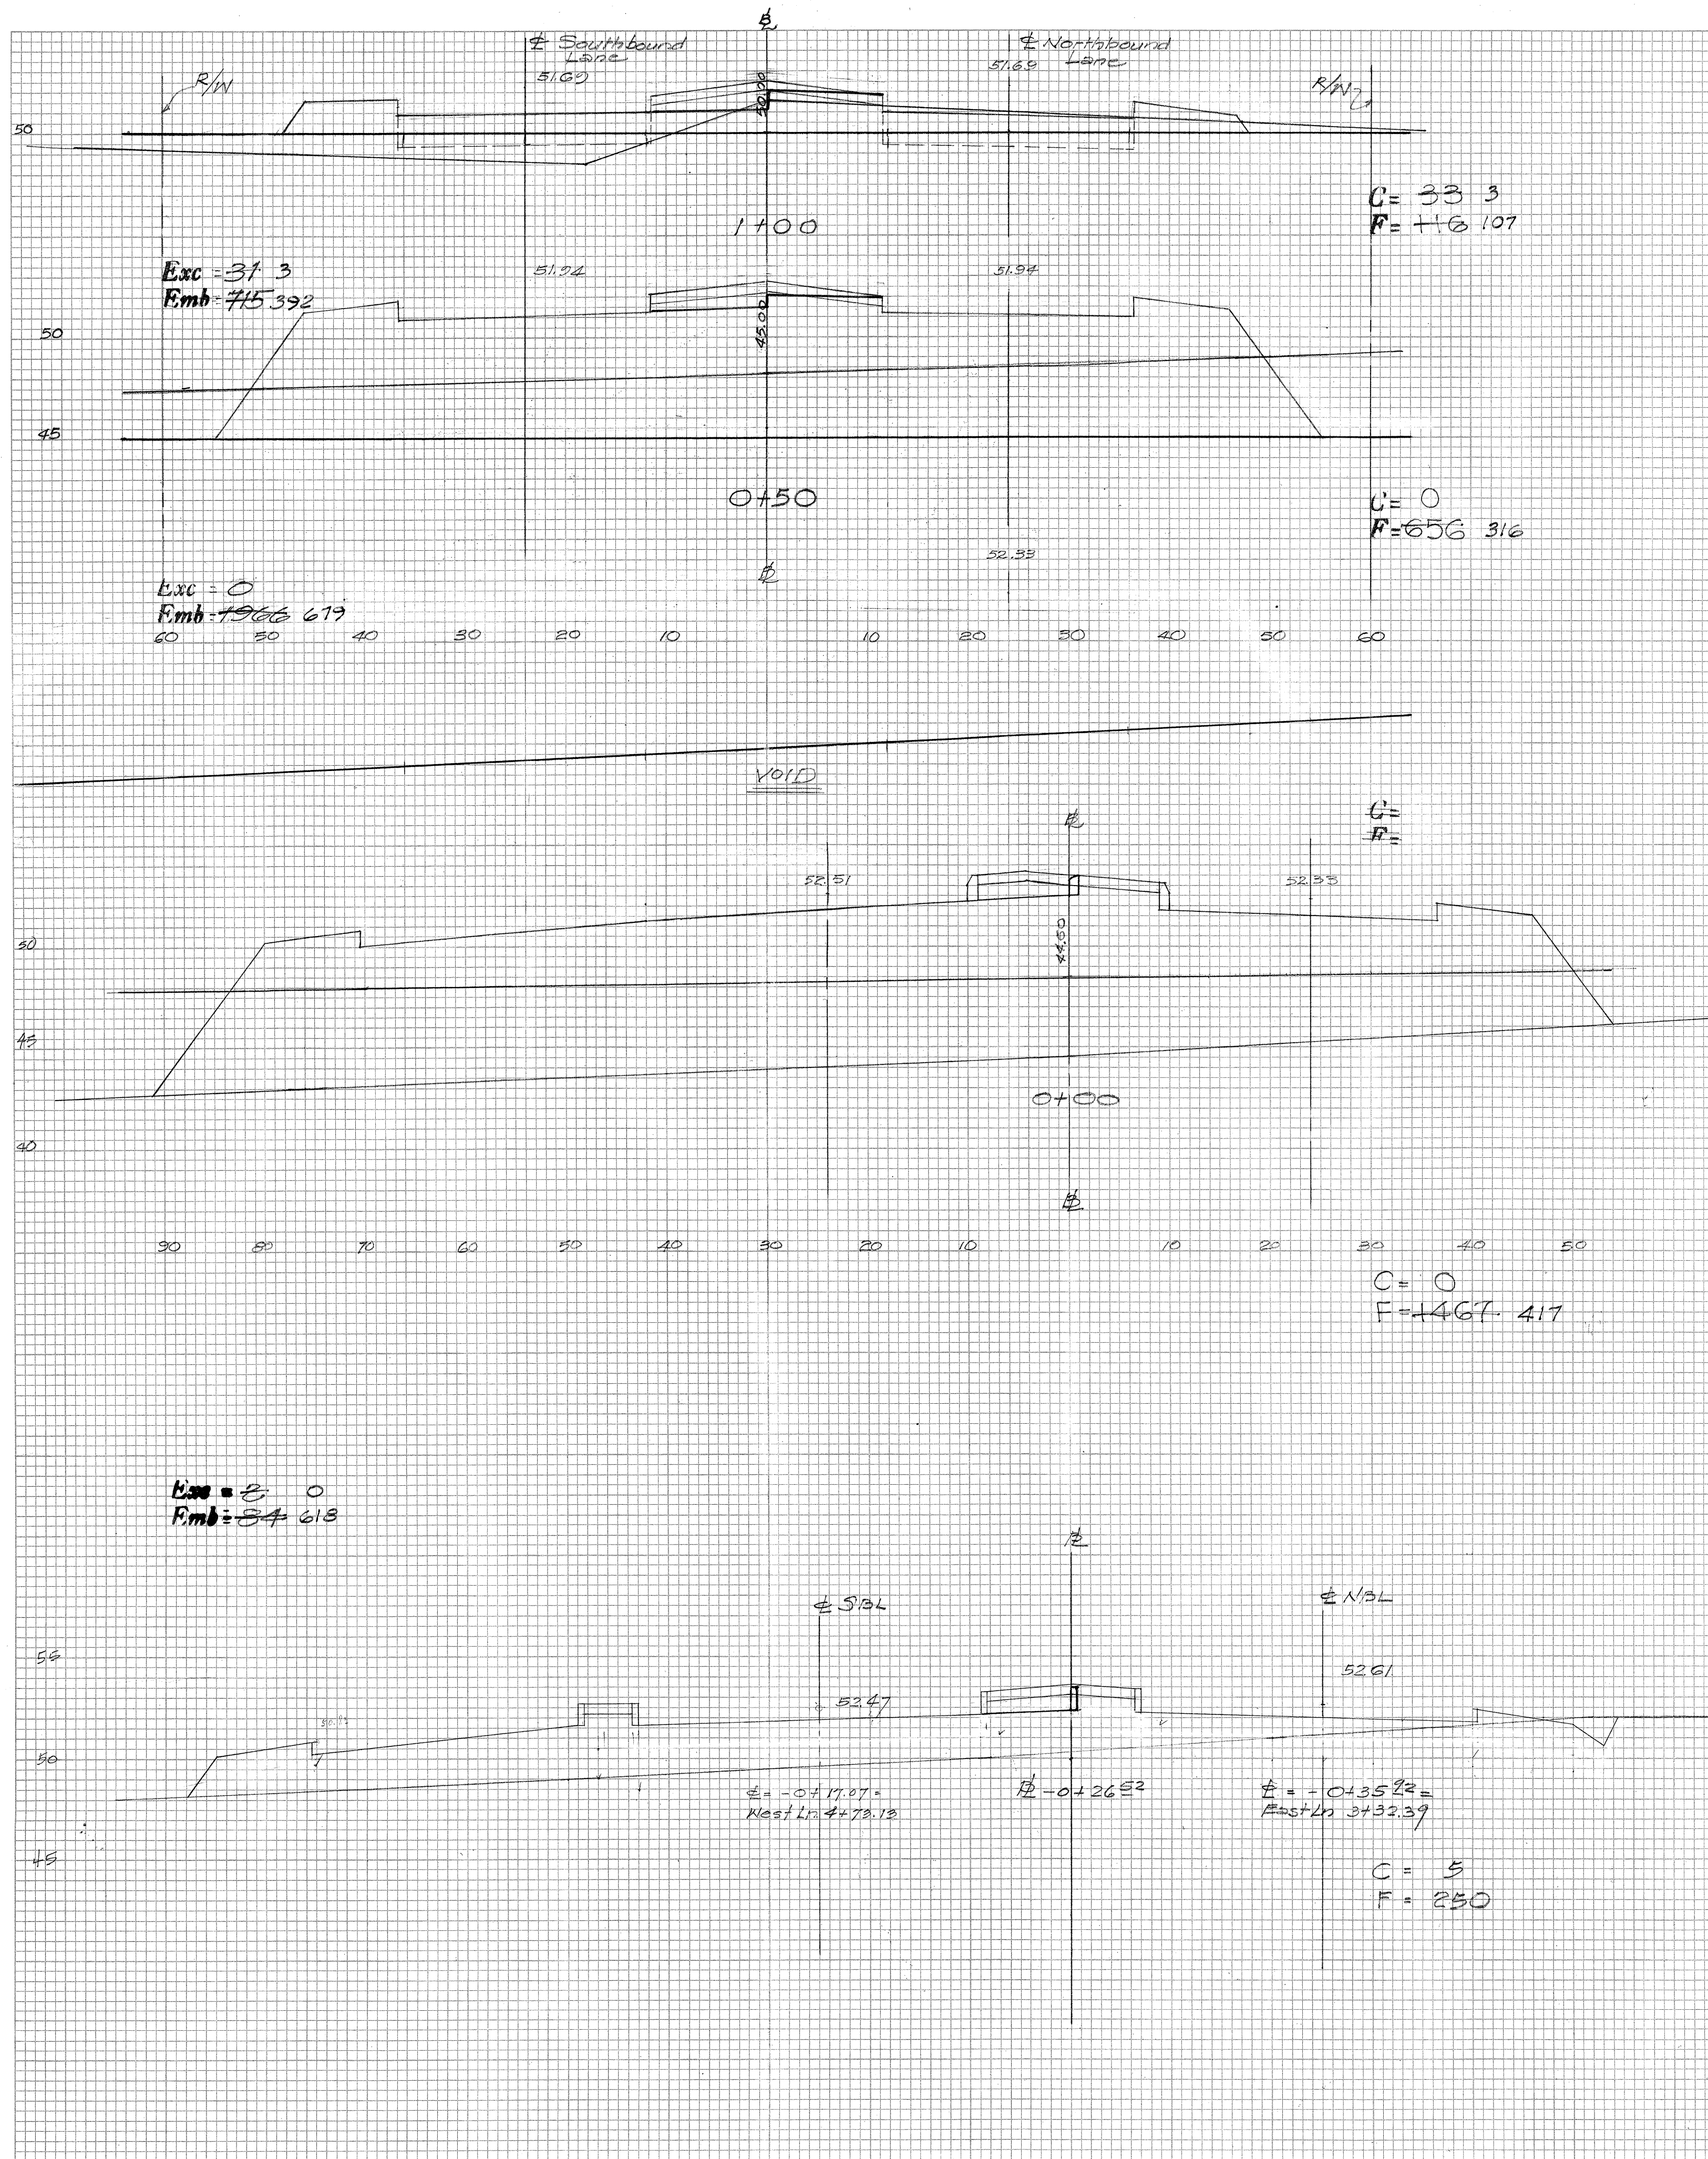

FED. ROAD DIST. No.	STATE	FED. AID PROJ. No.	FISCAL YEAR	SHEET No.	TOTAL SHEETS
HAWAII	HAW.	D-AD-12	1958	14	20

FINAL SURVEY
 BY
 DATE
 SURVEYED
 PLOTTED
 NOTE BOOK
 TEMPLATE
 AREAS
 CHECKED
 NO.



ORIGINAL SURVEY
 BY
 DATE
 SURVEYED
 PLOTTED
 NOTE BOOK
 TEMPLATE
 AREAS
 CHECKED
 NO.

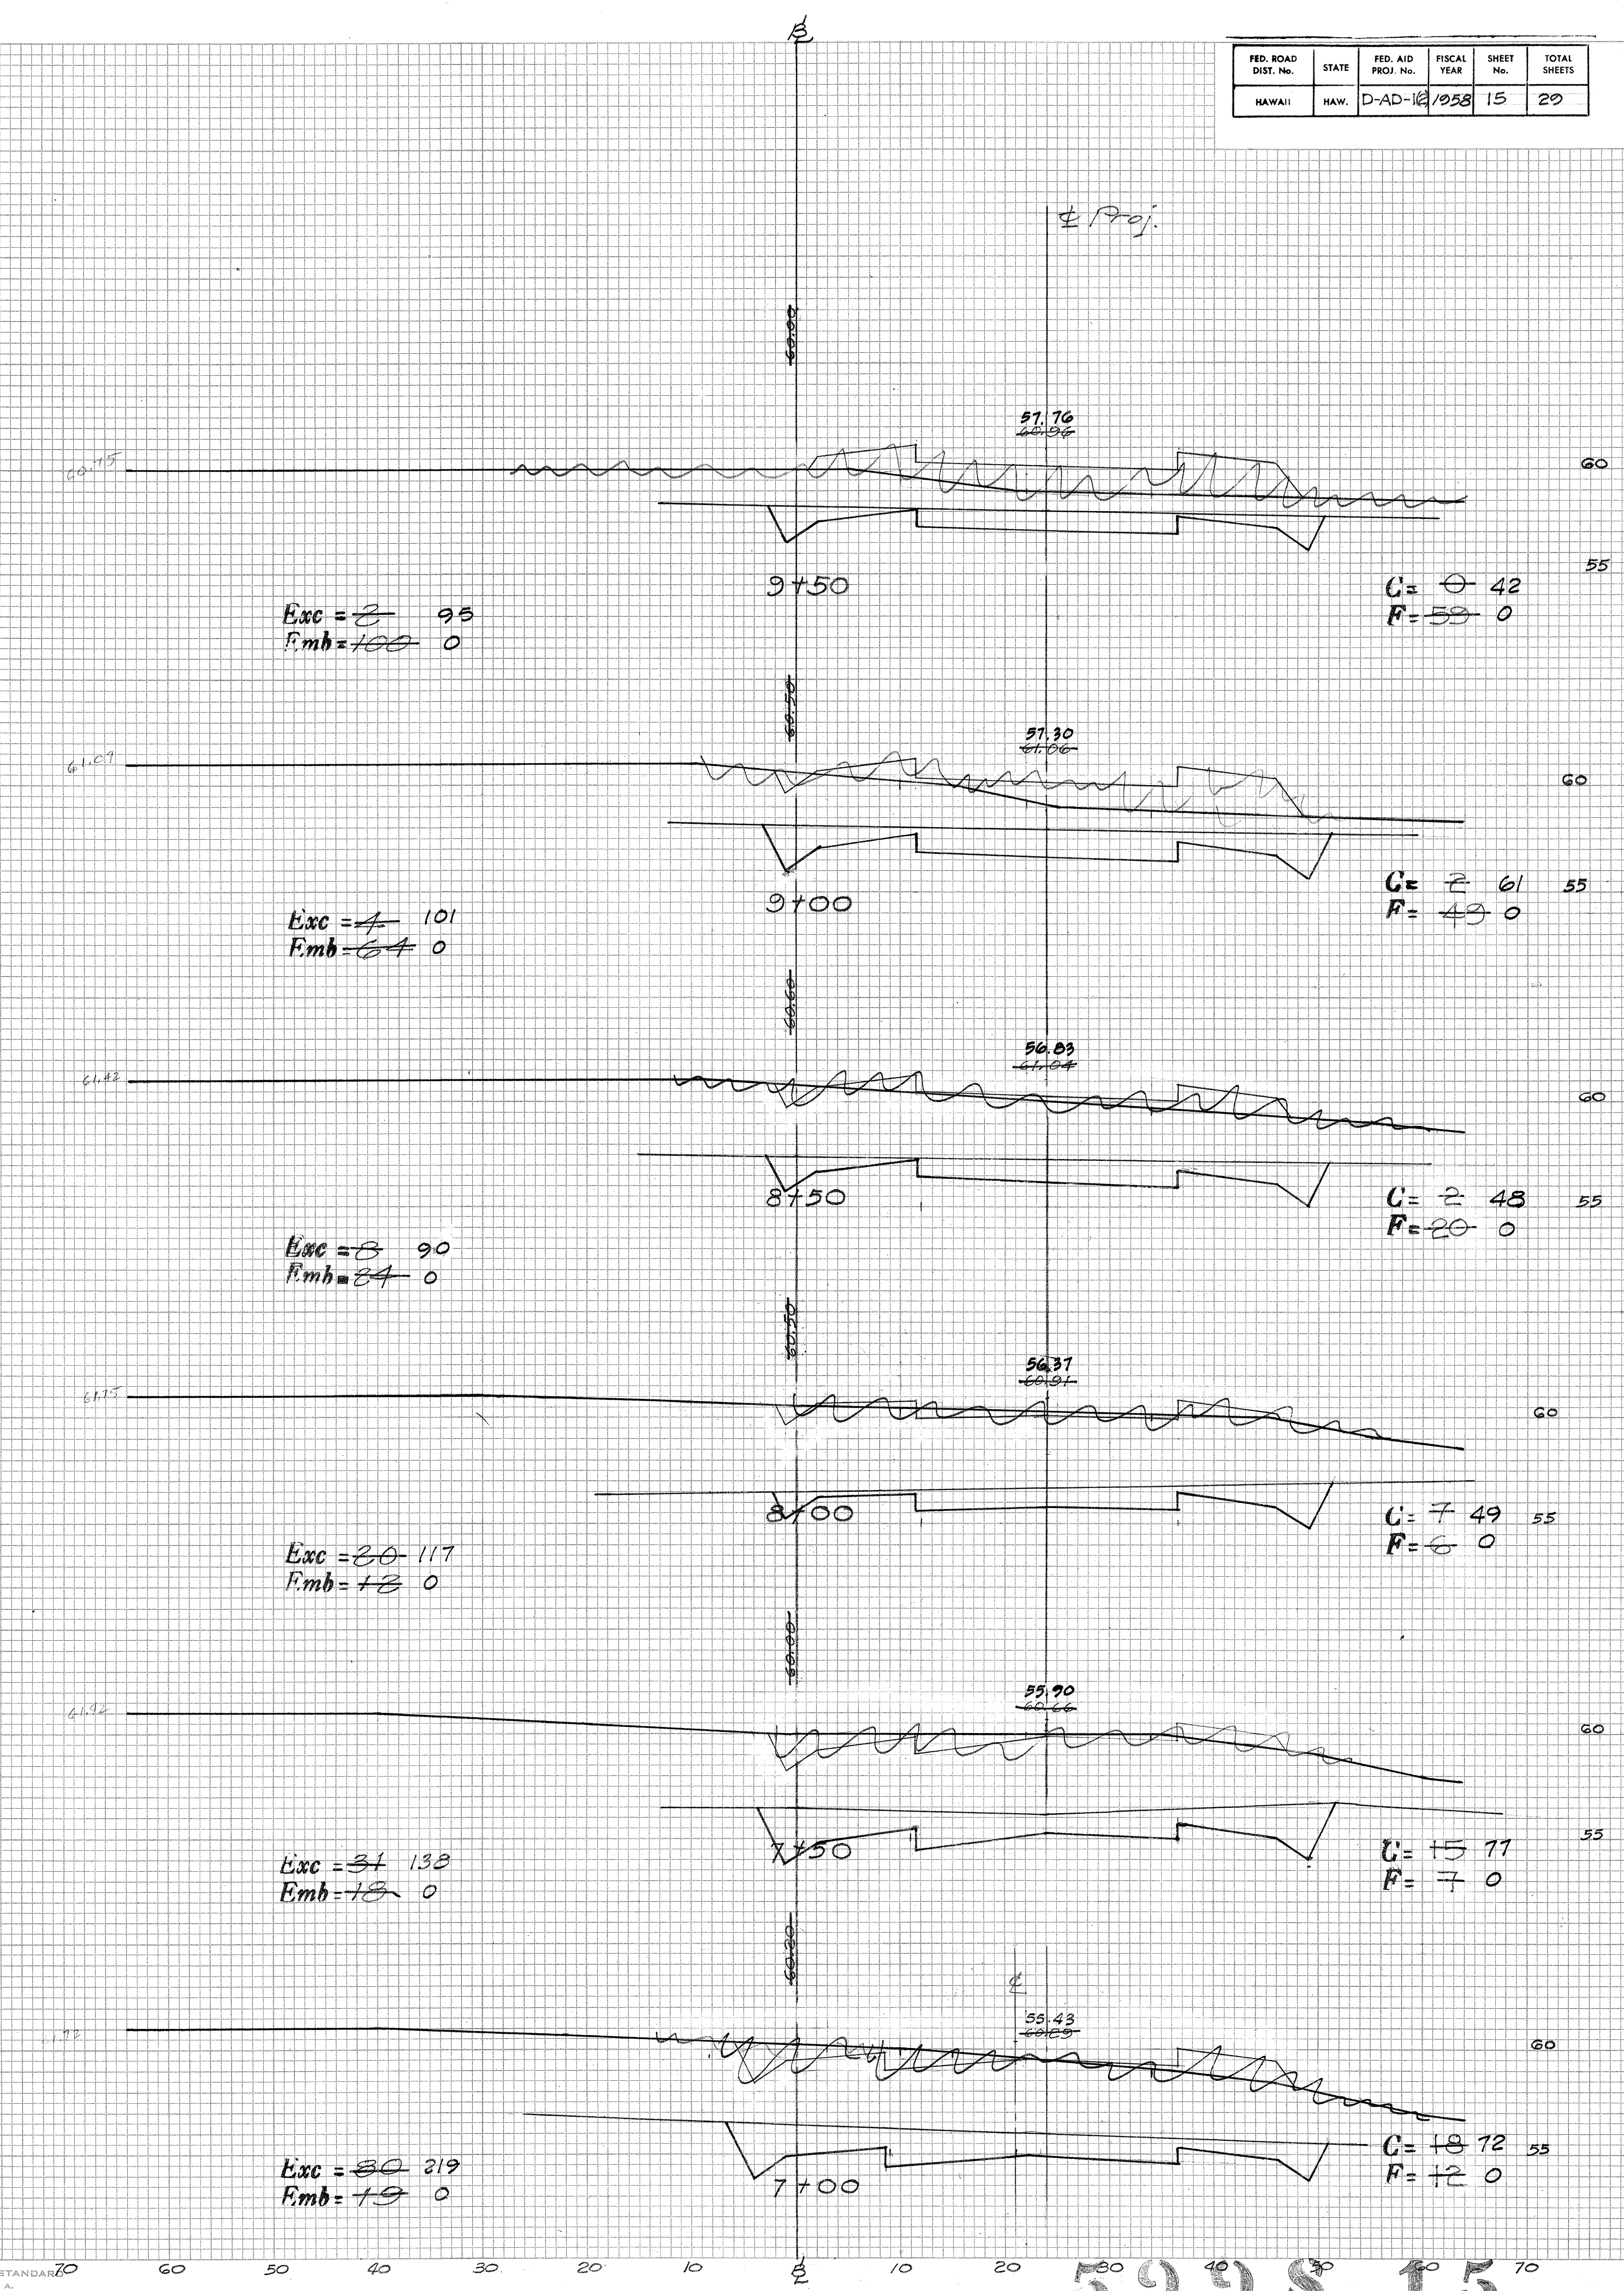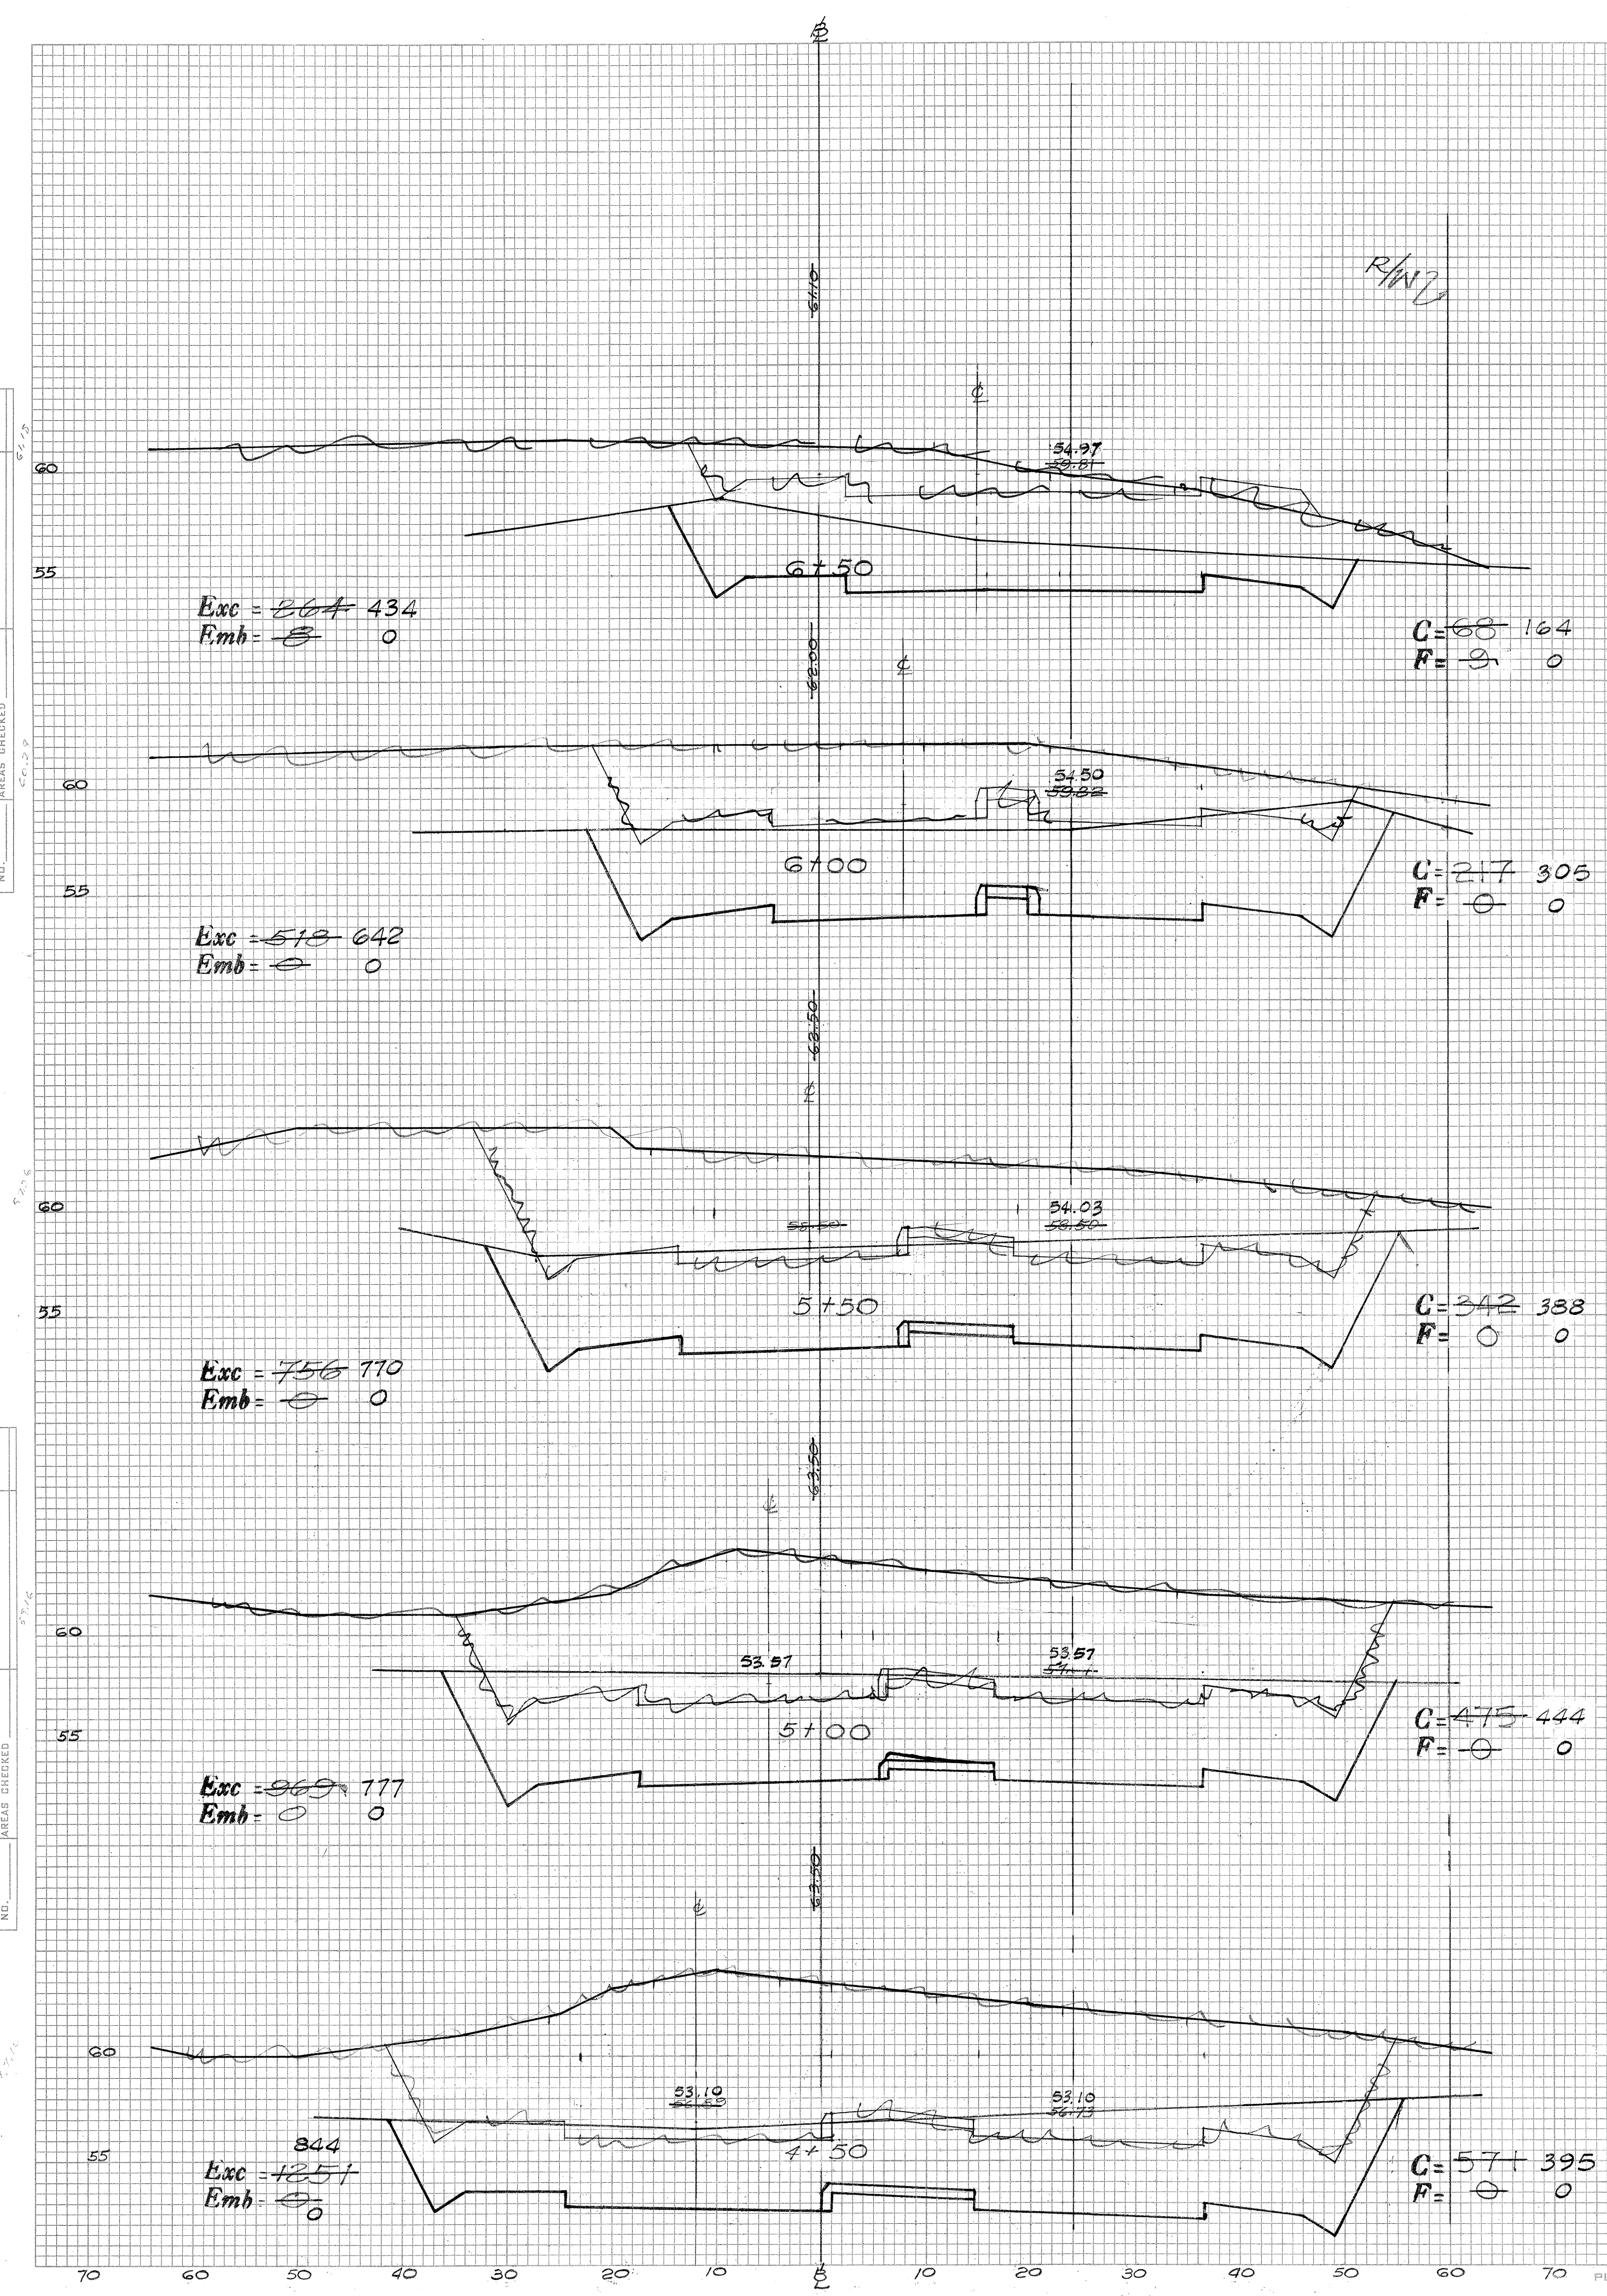

FED. ROAD DIST. No.	STATE	FED. AID PROJ. No.	FISCAL YEAR	SHEET No.	TOTAL SHEETS
HAWAII	HAW.	D-AD-12	1958	16	29

FINAL SURVEY	SURVEYED _____	BY _____	DATE _____
NOTE BOOK	PLOTTED _____		
	TEMPLATE _____		
	AREAS _____		
NO. _____	AREAS CHECKED _____		



ORIGINAL SURVEY	SURVEYED _____	BY _____	DATE _____
	PLOTTED _____		
	TEMPLATE _____		
	AREAS _____		
	AREAS CHECKED _____		
NO. _____			

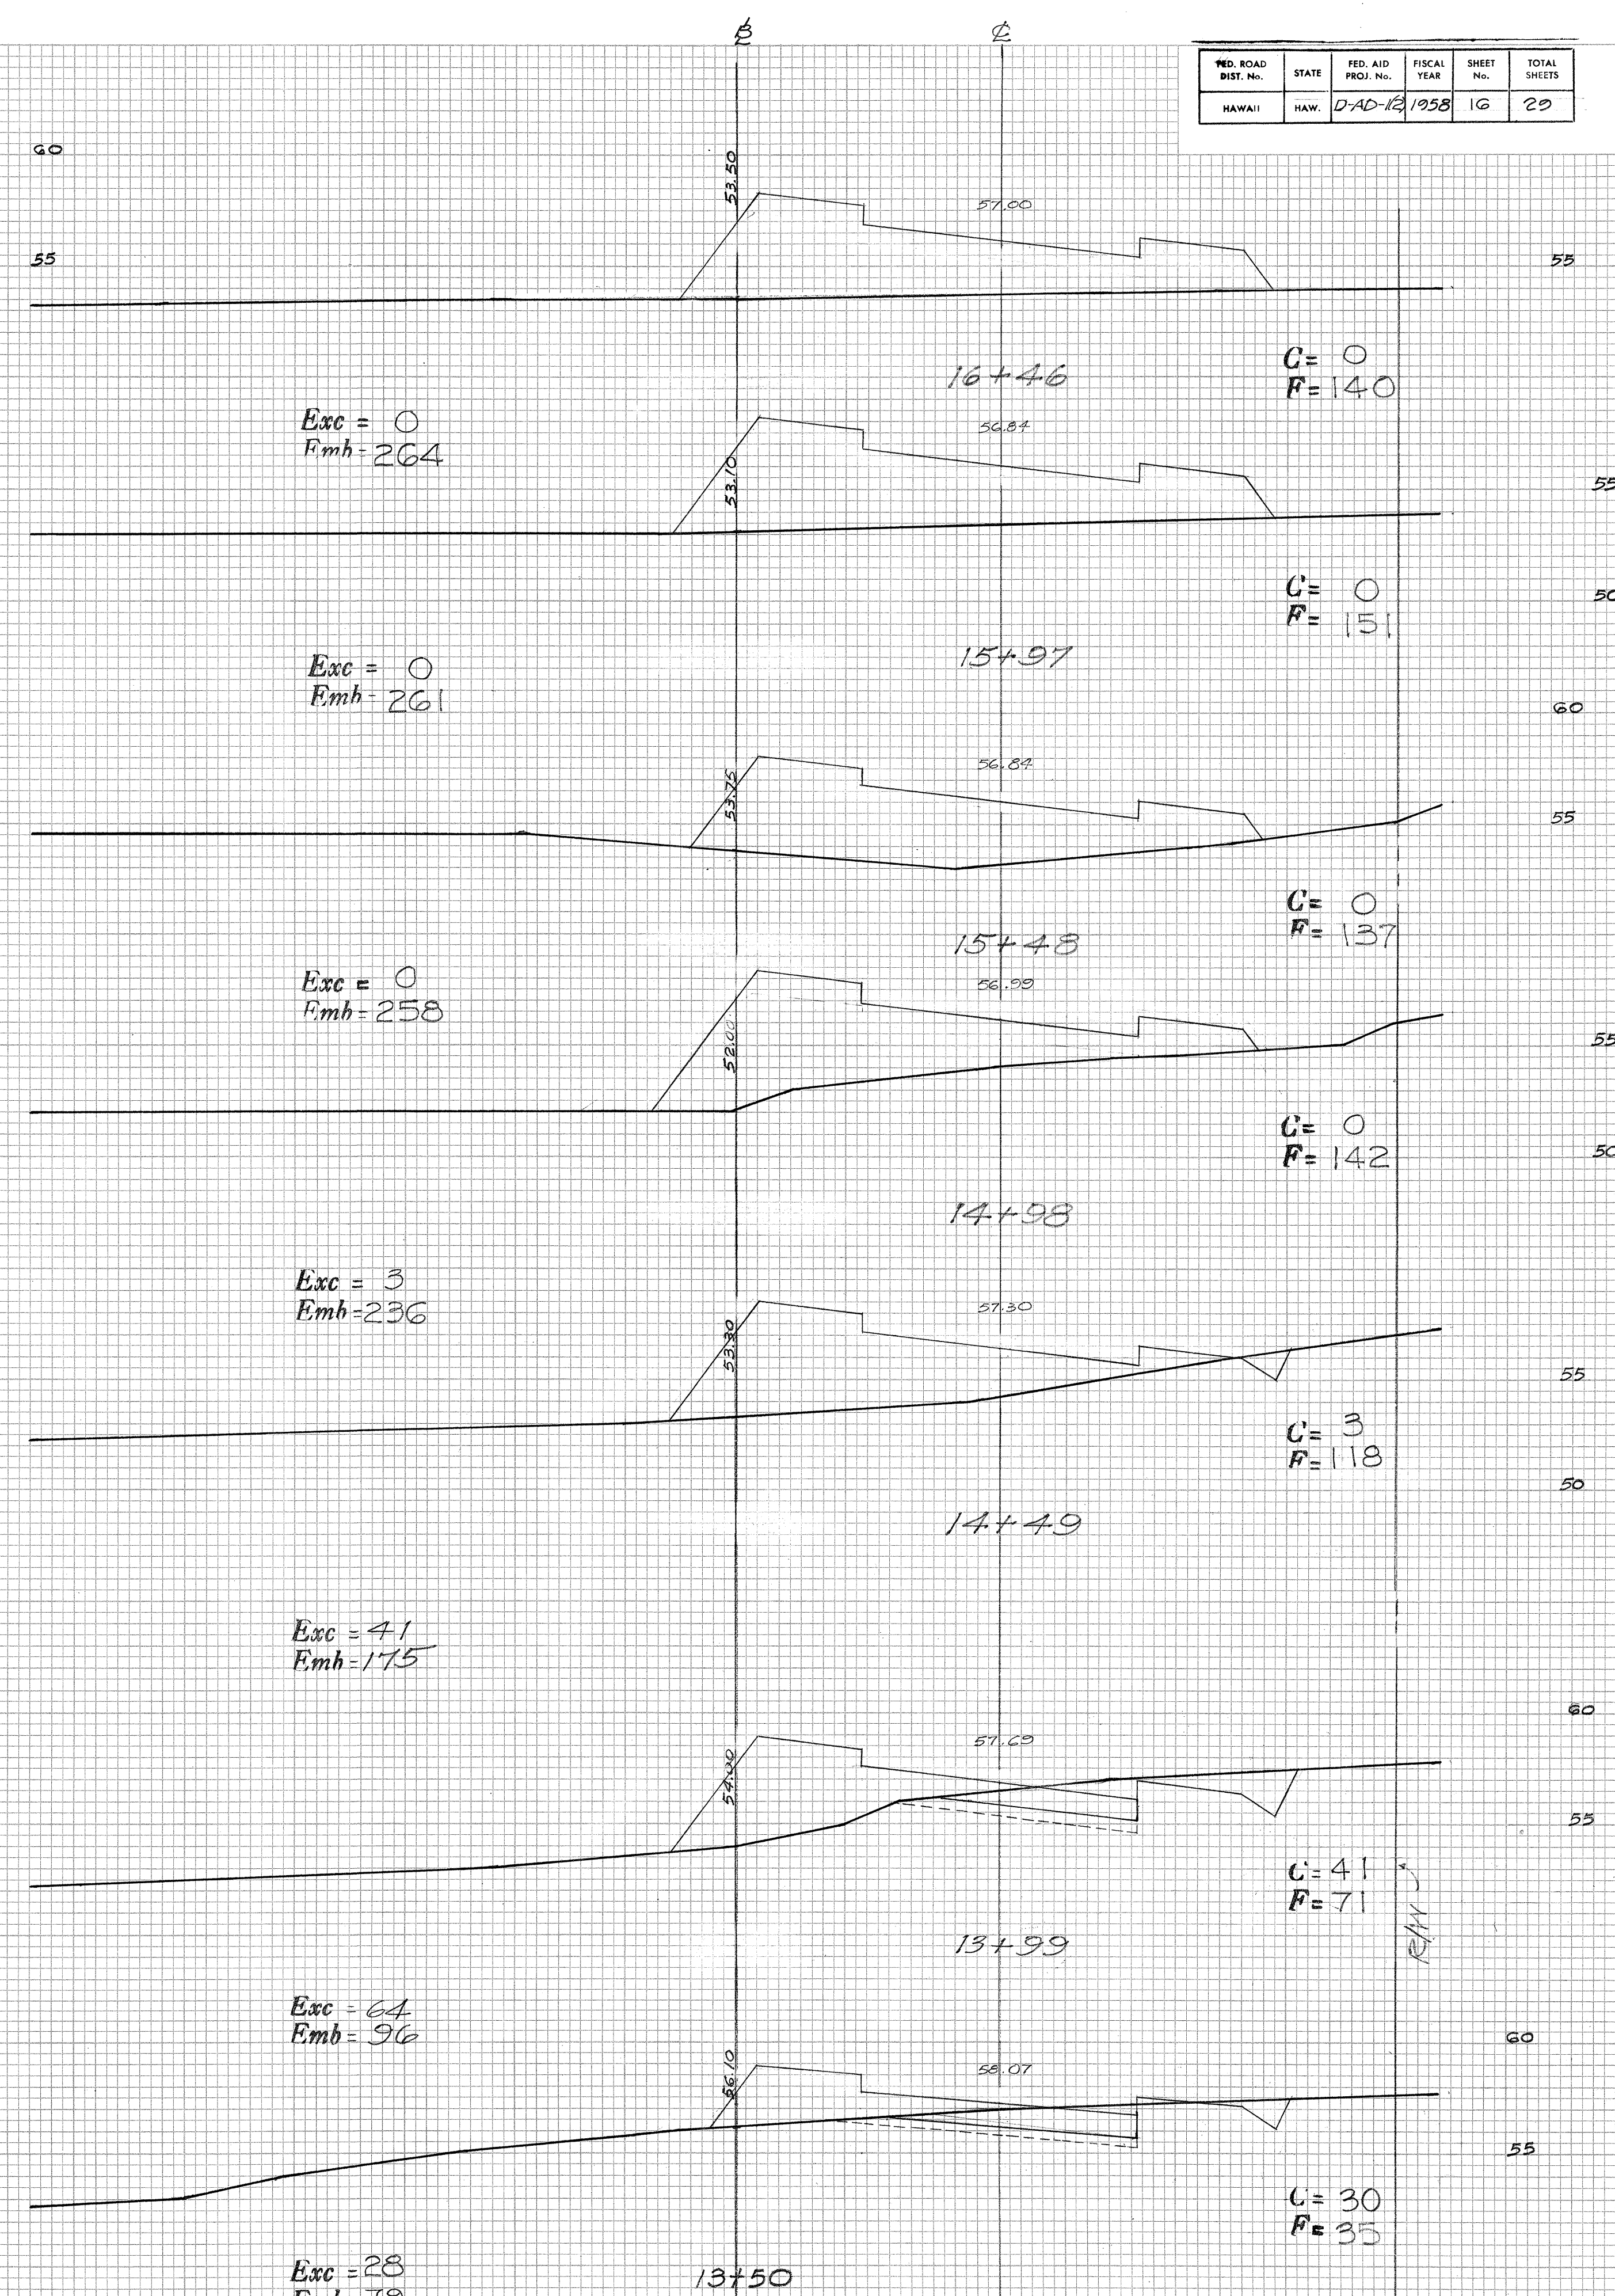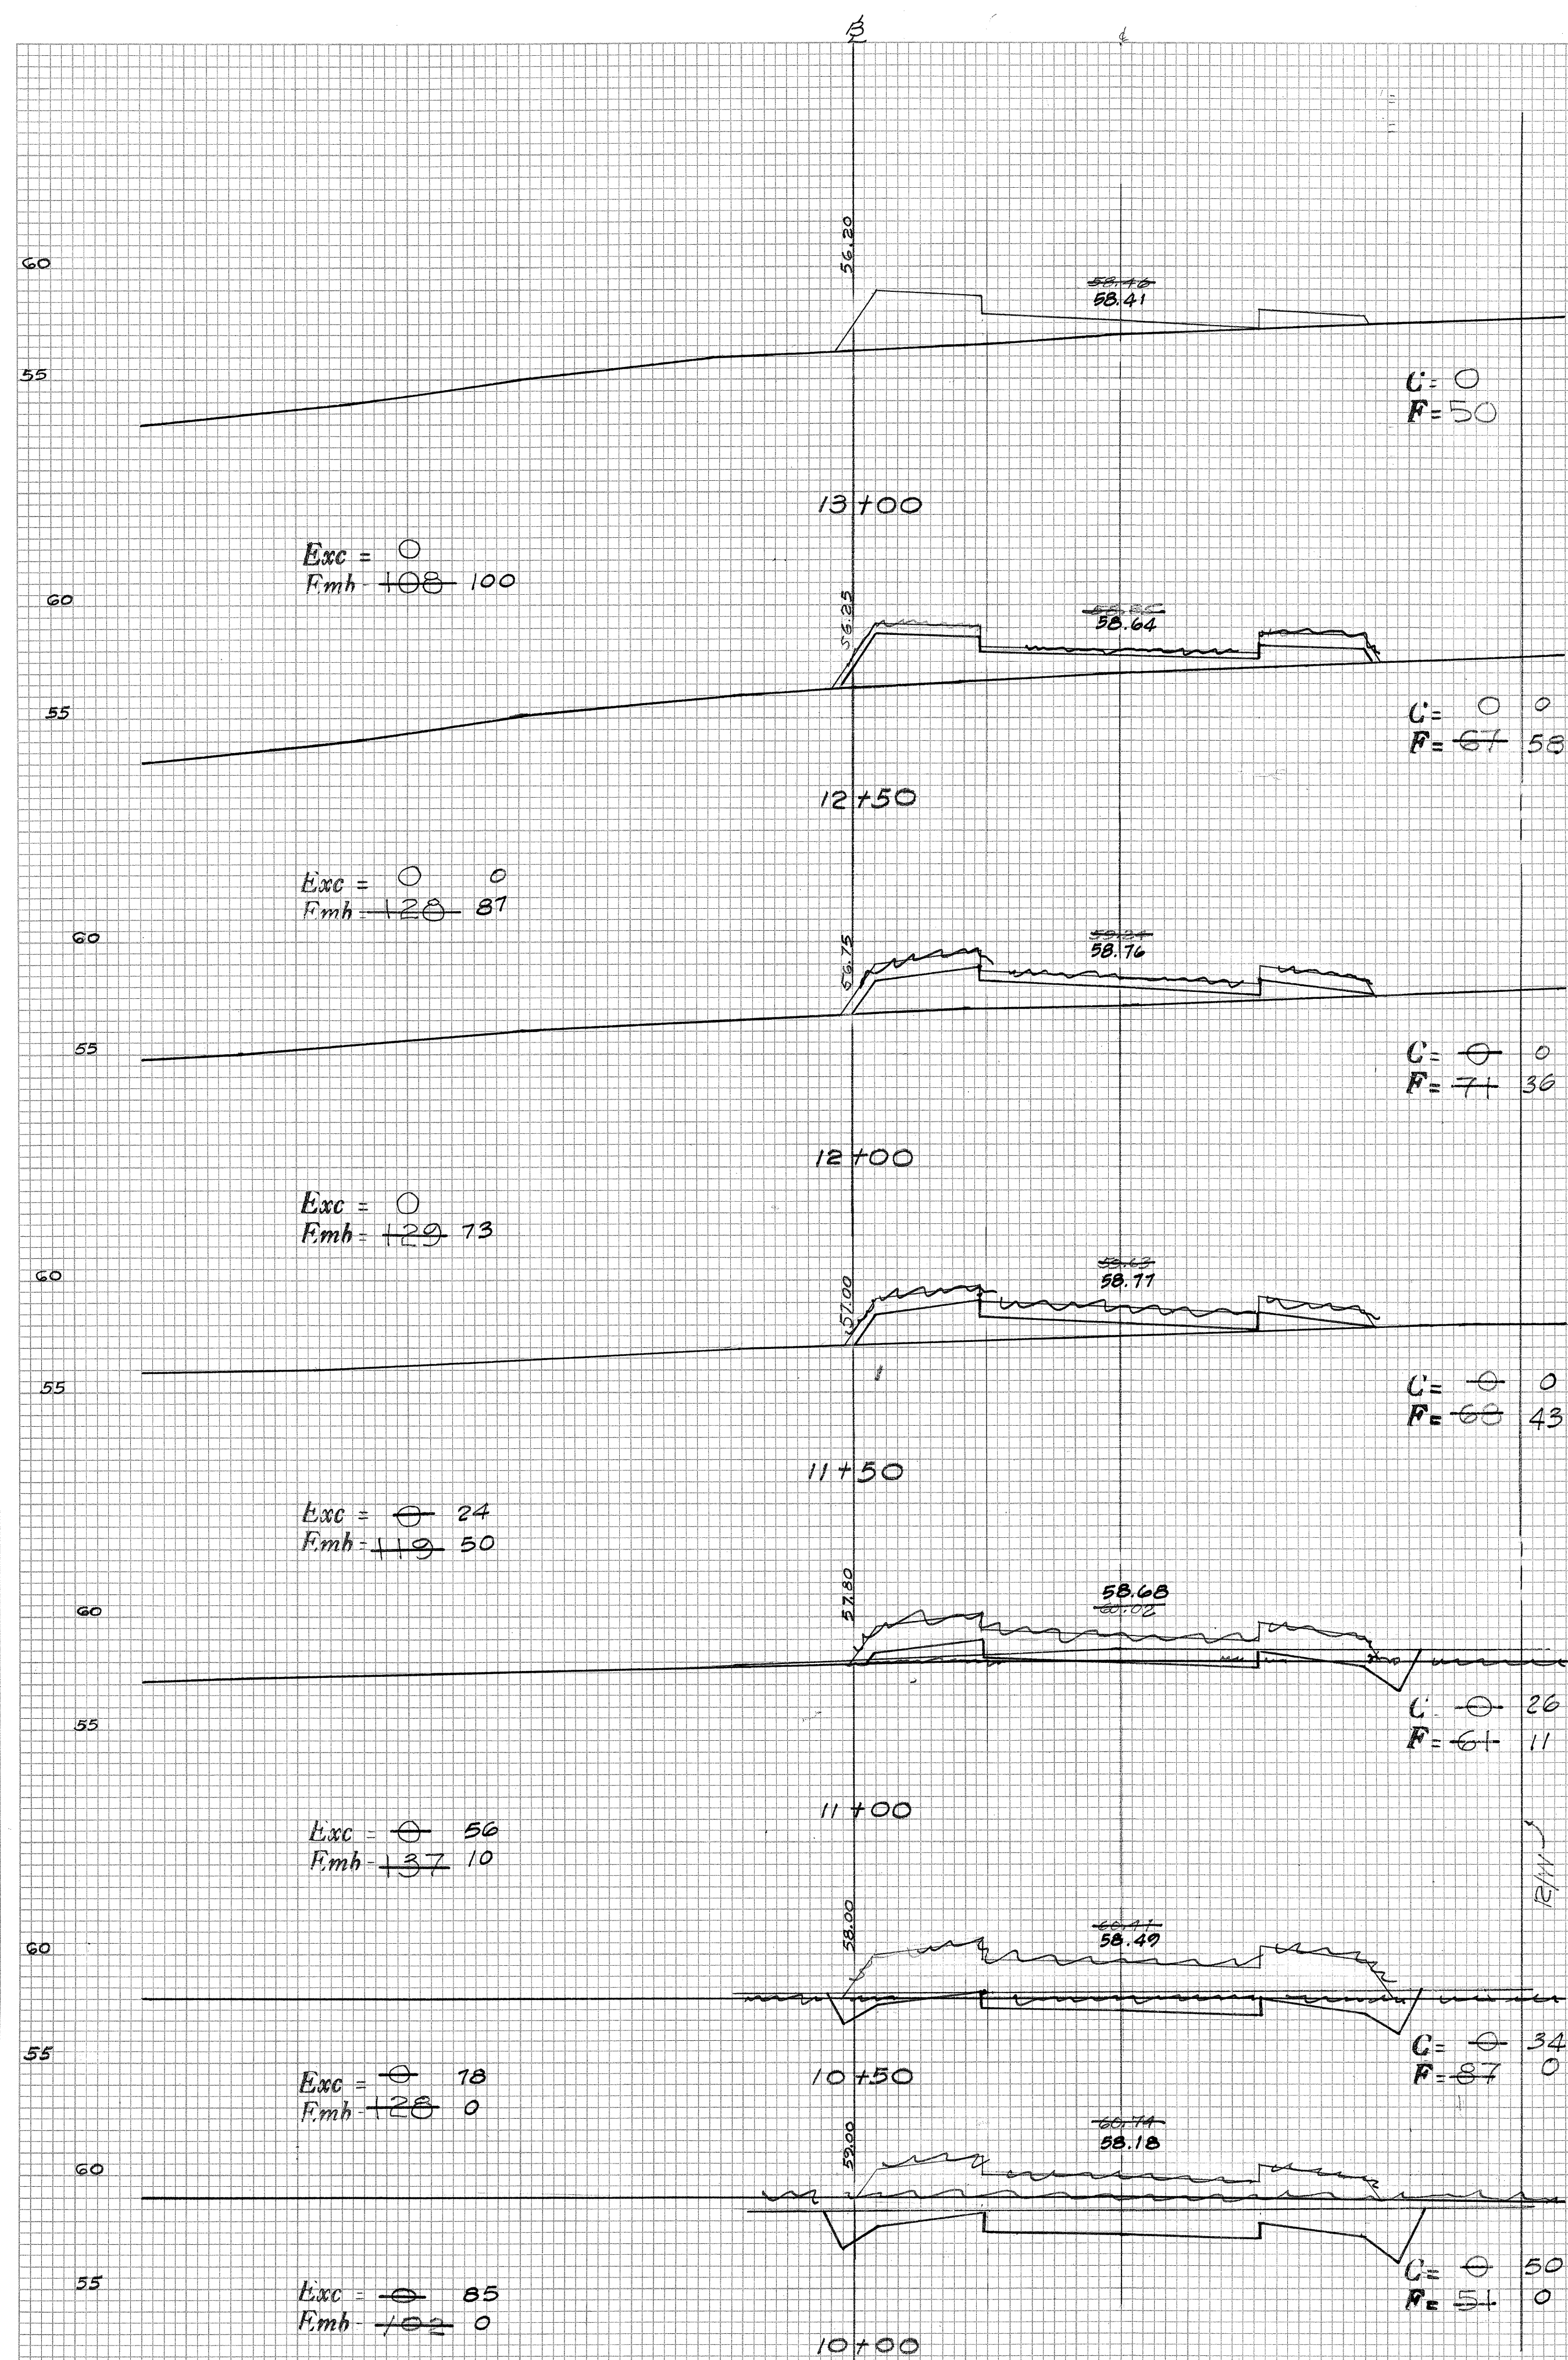

5³⁰ 9⁴⁰ 9⁵⁰ S. 1⁶⁰ 6

FINAL SURVEY	DATE	
	BY	
	SURVEYED	
	NOTE BOOK	
	NO.	

ORIGINAL SURVEY	DATE	
	BY	
	SURVEYED	
	NOTE BOOK	
	NO.	

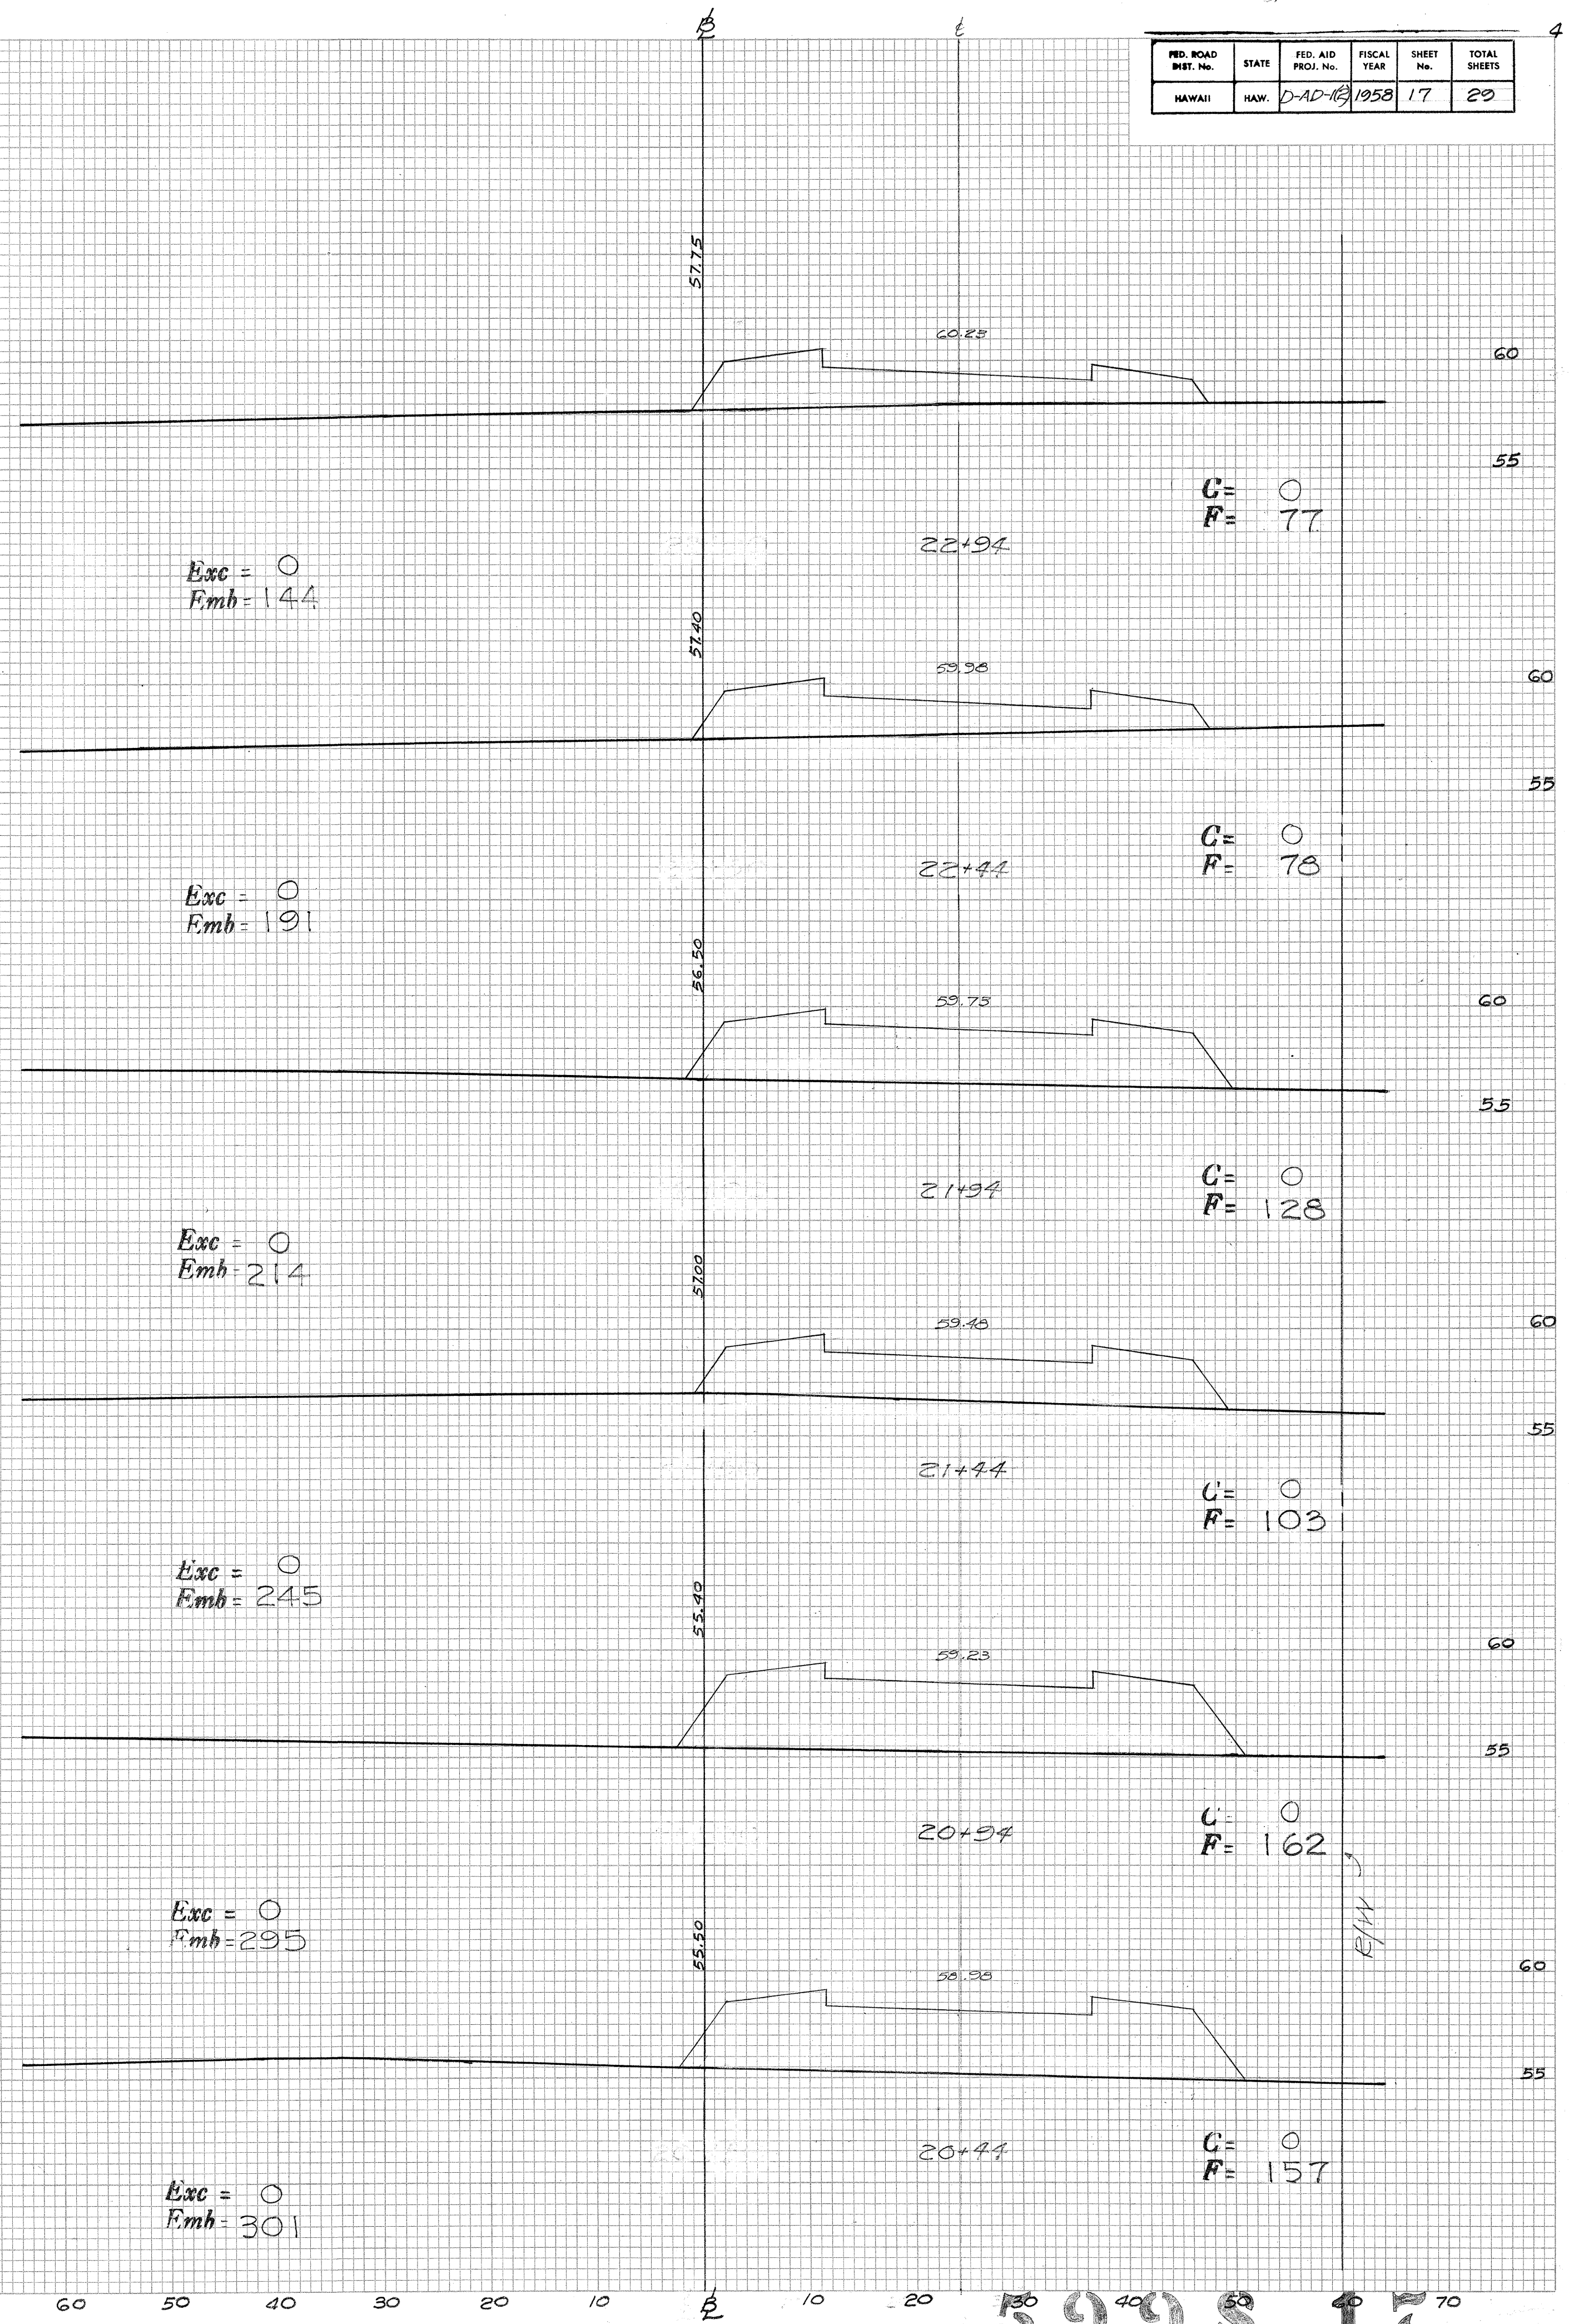
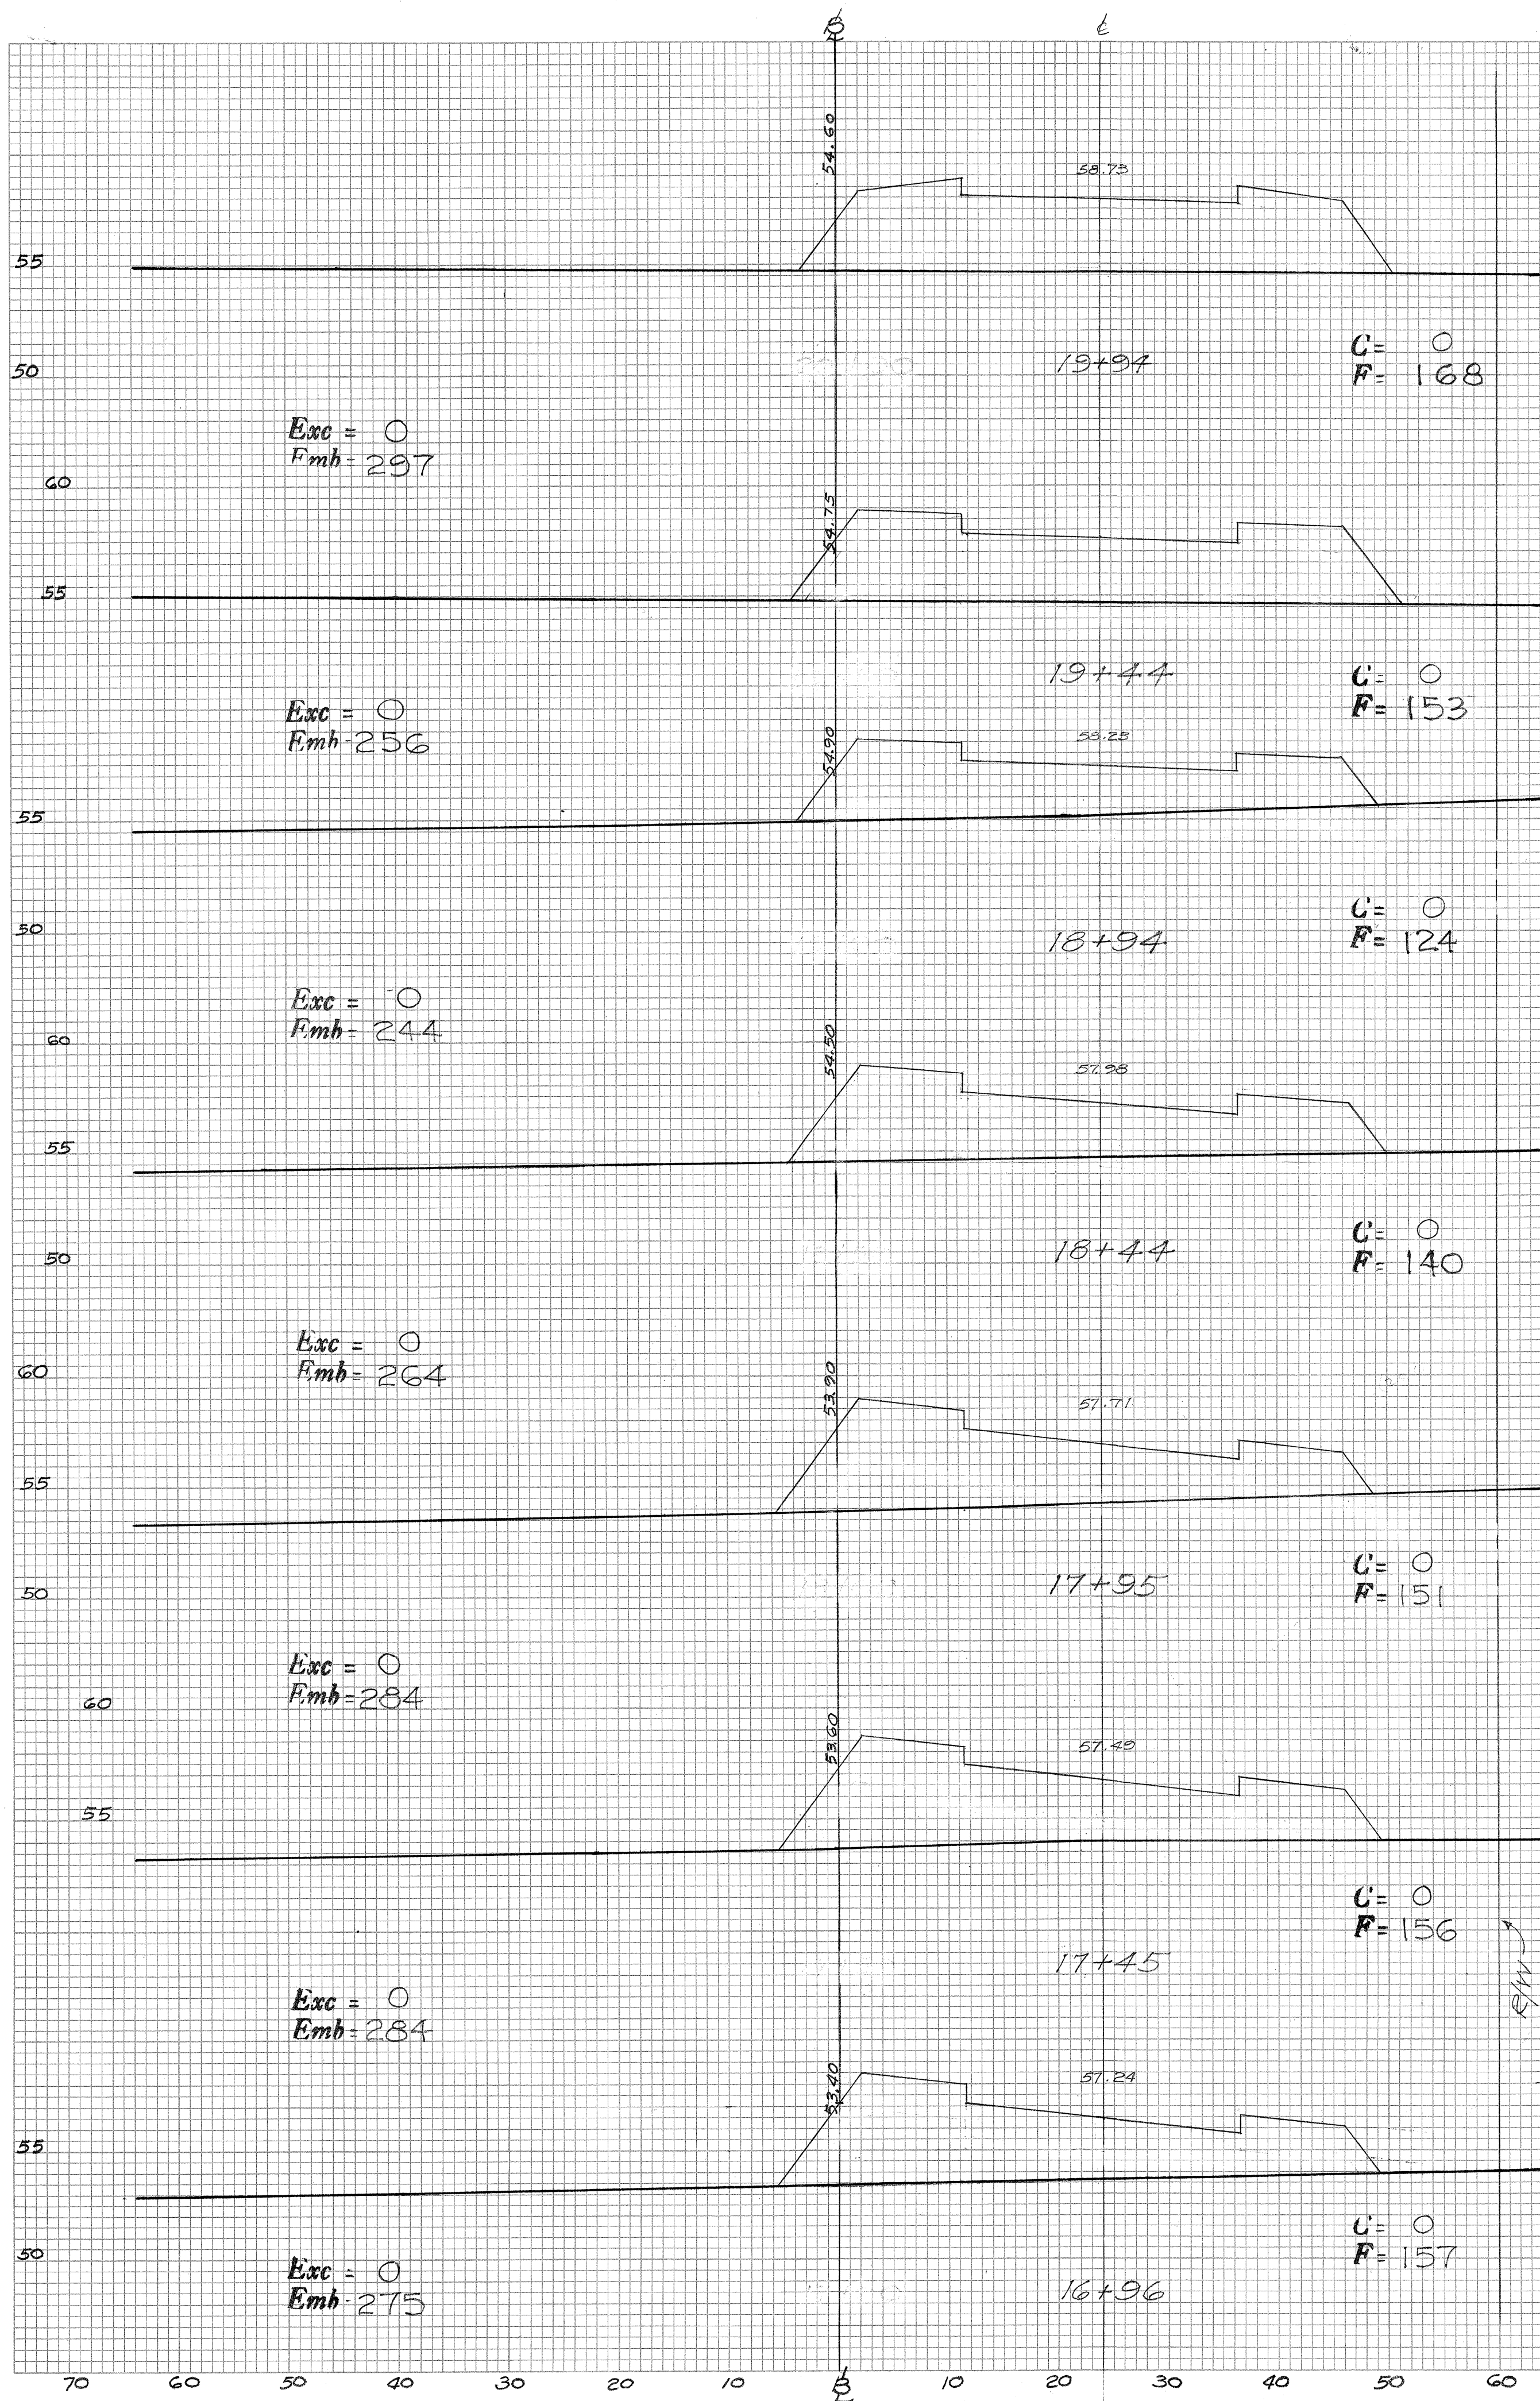


FED. ROAD DIST. No.	STATE	FED. AID PROJ. No.	FISCAL YEAR	SHEET No.	TOTAL SHEETS
HAWAII	HAW.	D-AD-163	1958	17	29

FINAL SURVEY	DATE	
	BY	
	SURVEYED	
	NOTE BOOK	
	NO.	

ORIGINAL SURVEY	DATE	
	BY	
	SURVEYED	
	NOTE BOOK	
	NO.	

FED. ROAD DIST. No.	STATE	FED. AID PROJ. No.	FISCAL YEAR	SHEET No.	TOTAL SHEETS
HAWAII	HAW.	D-AD-18	1958	10	29

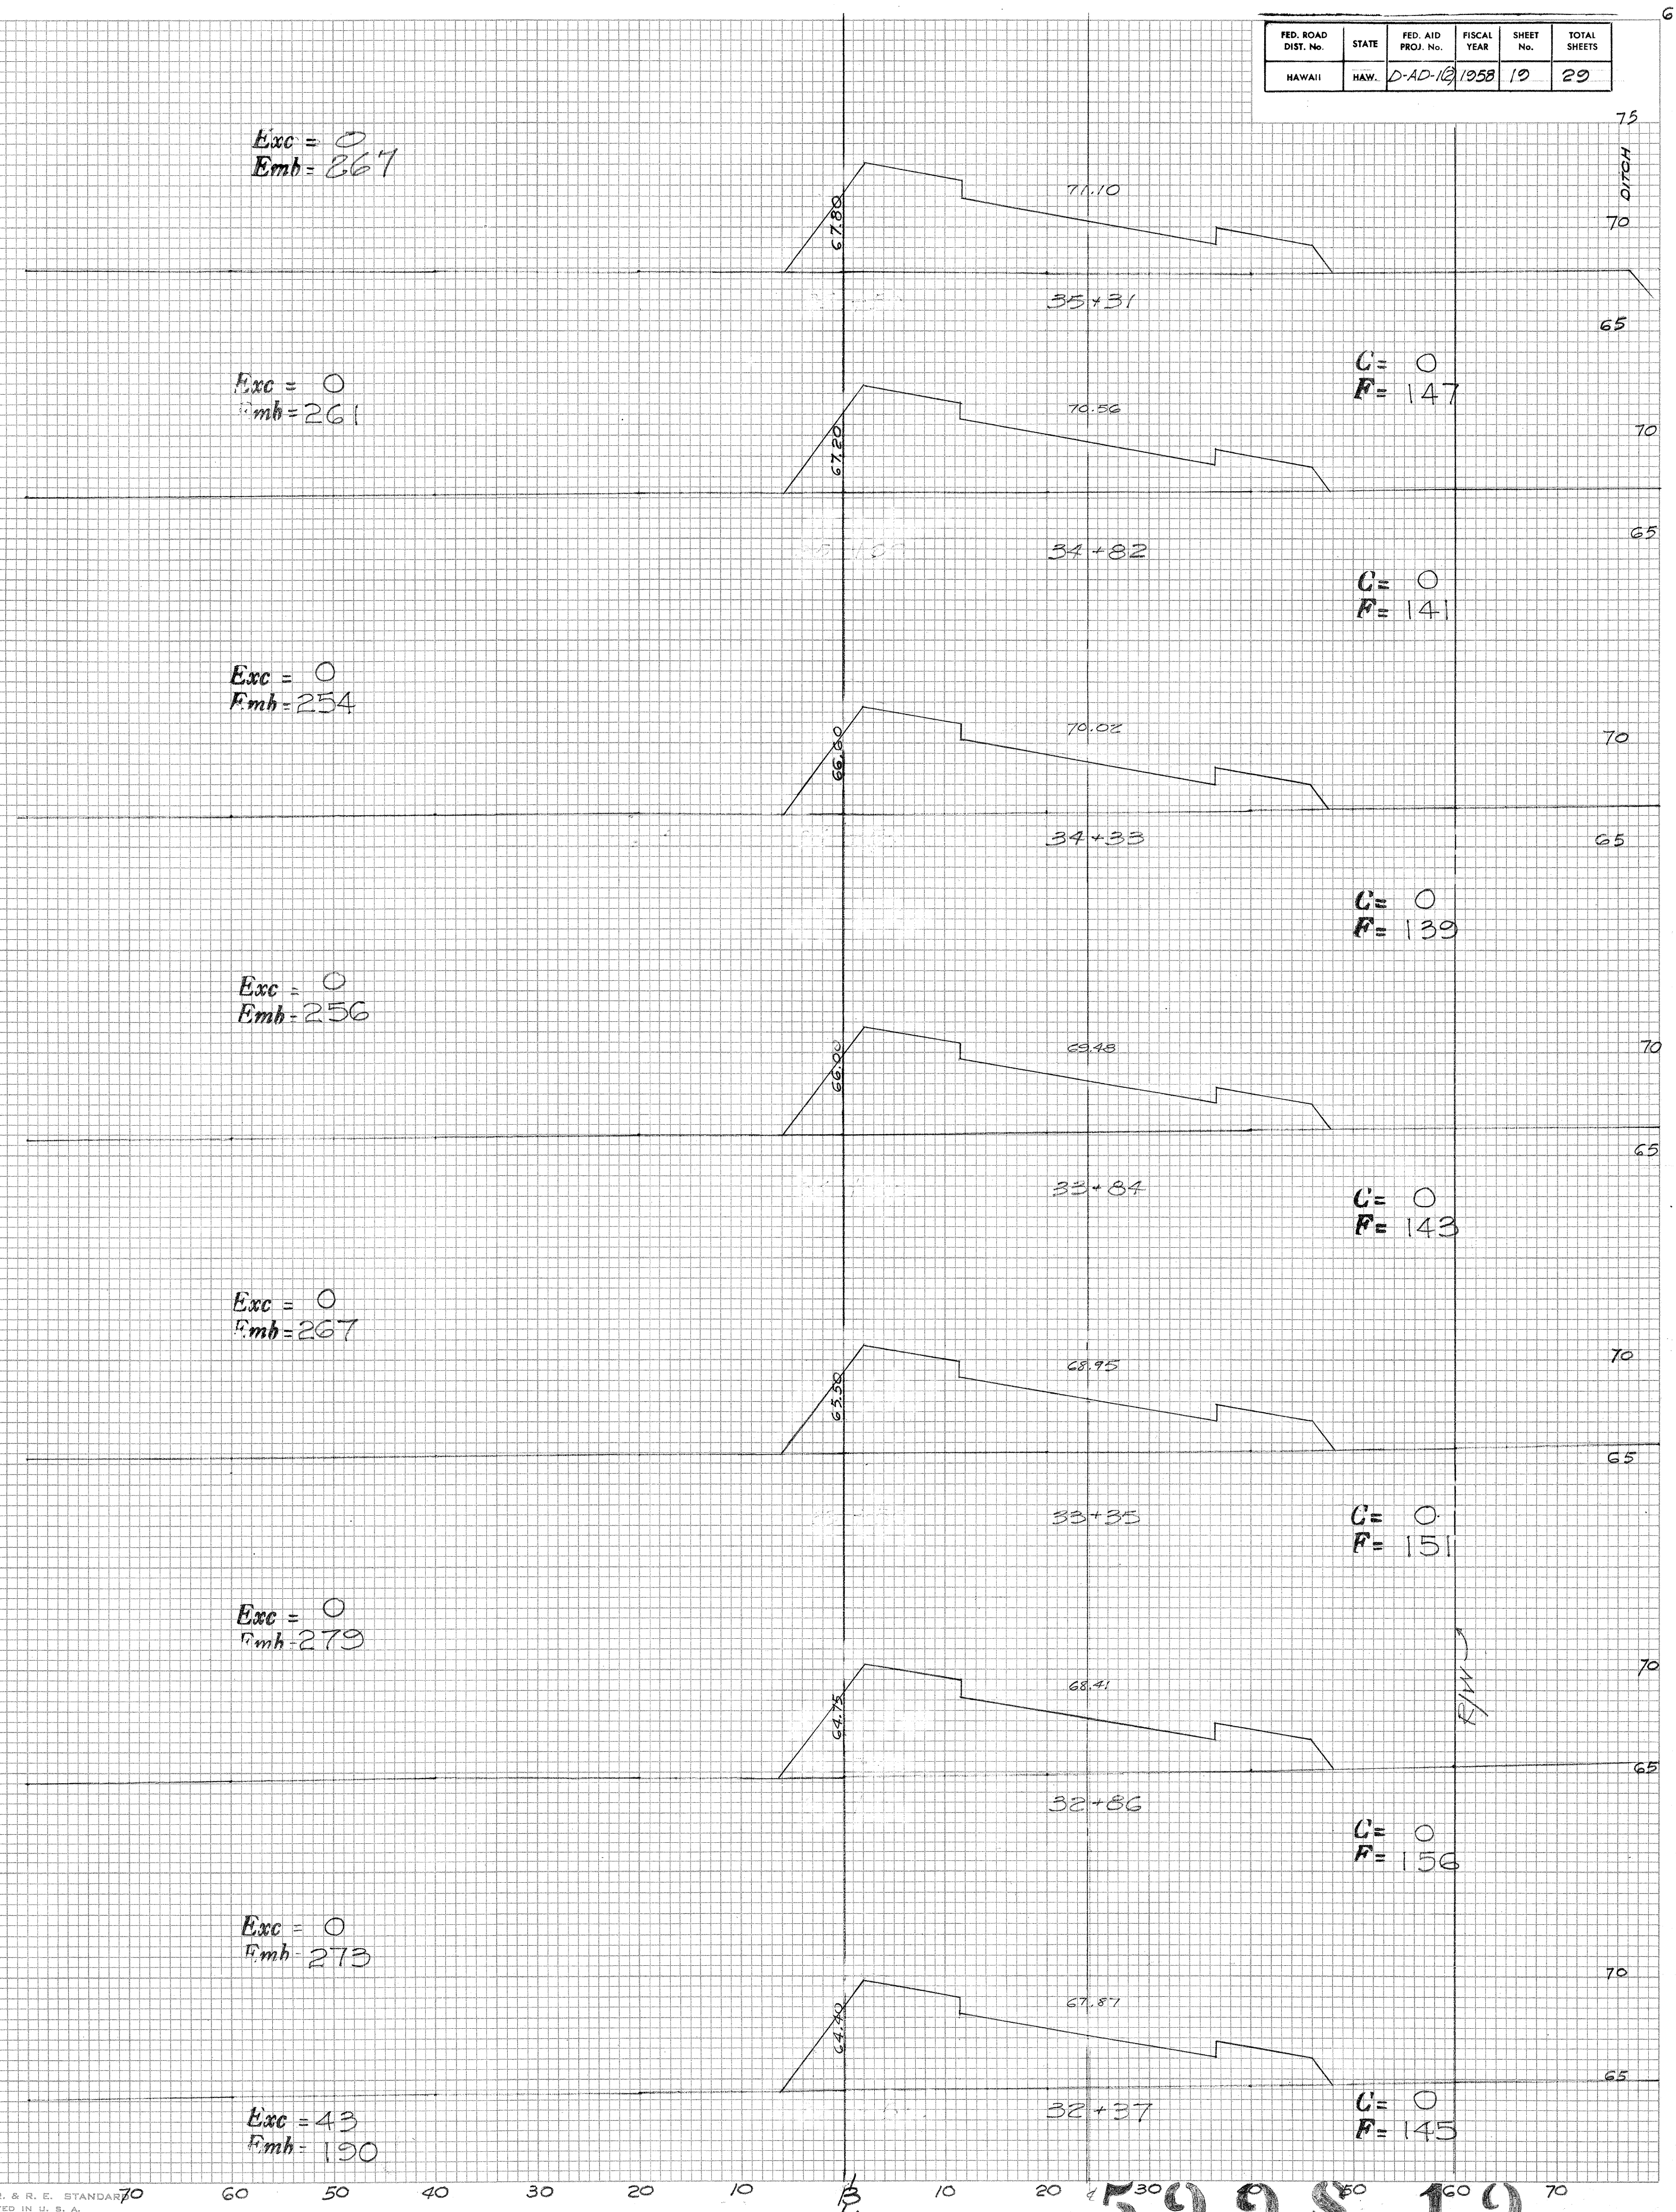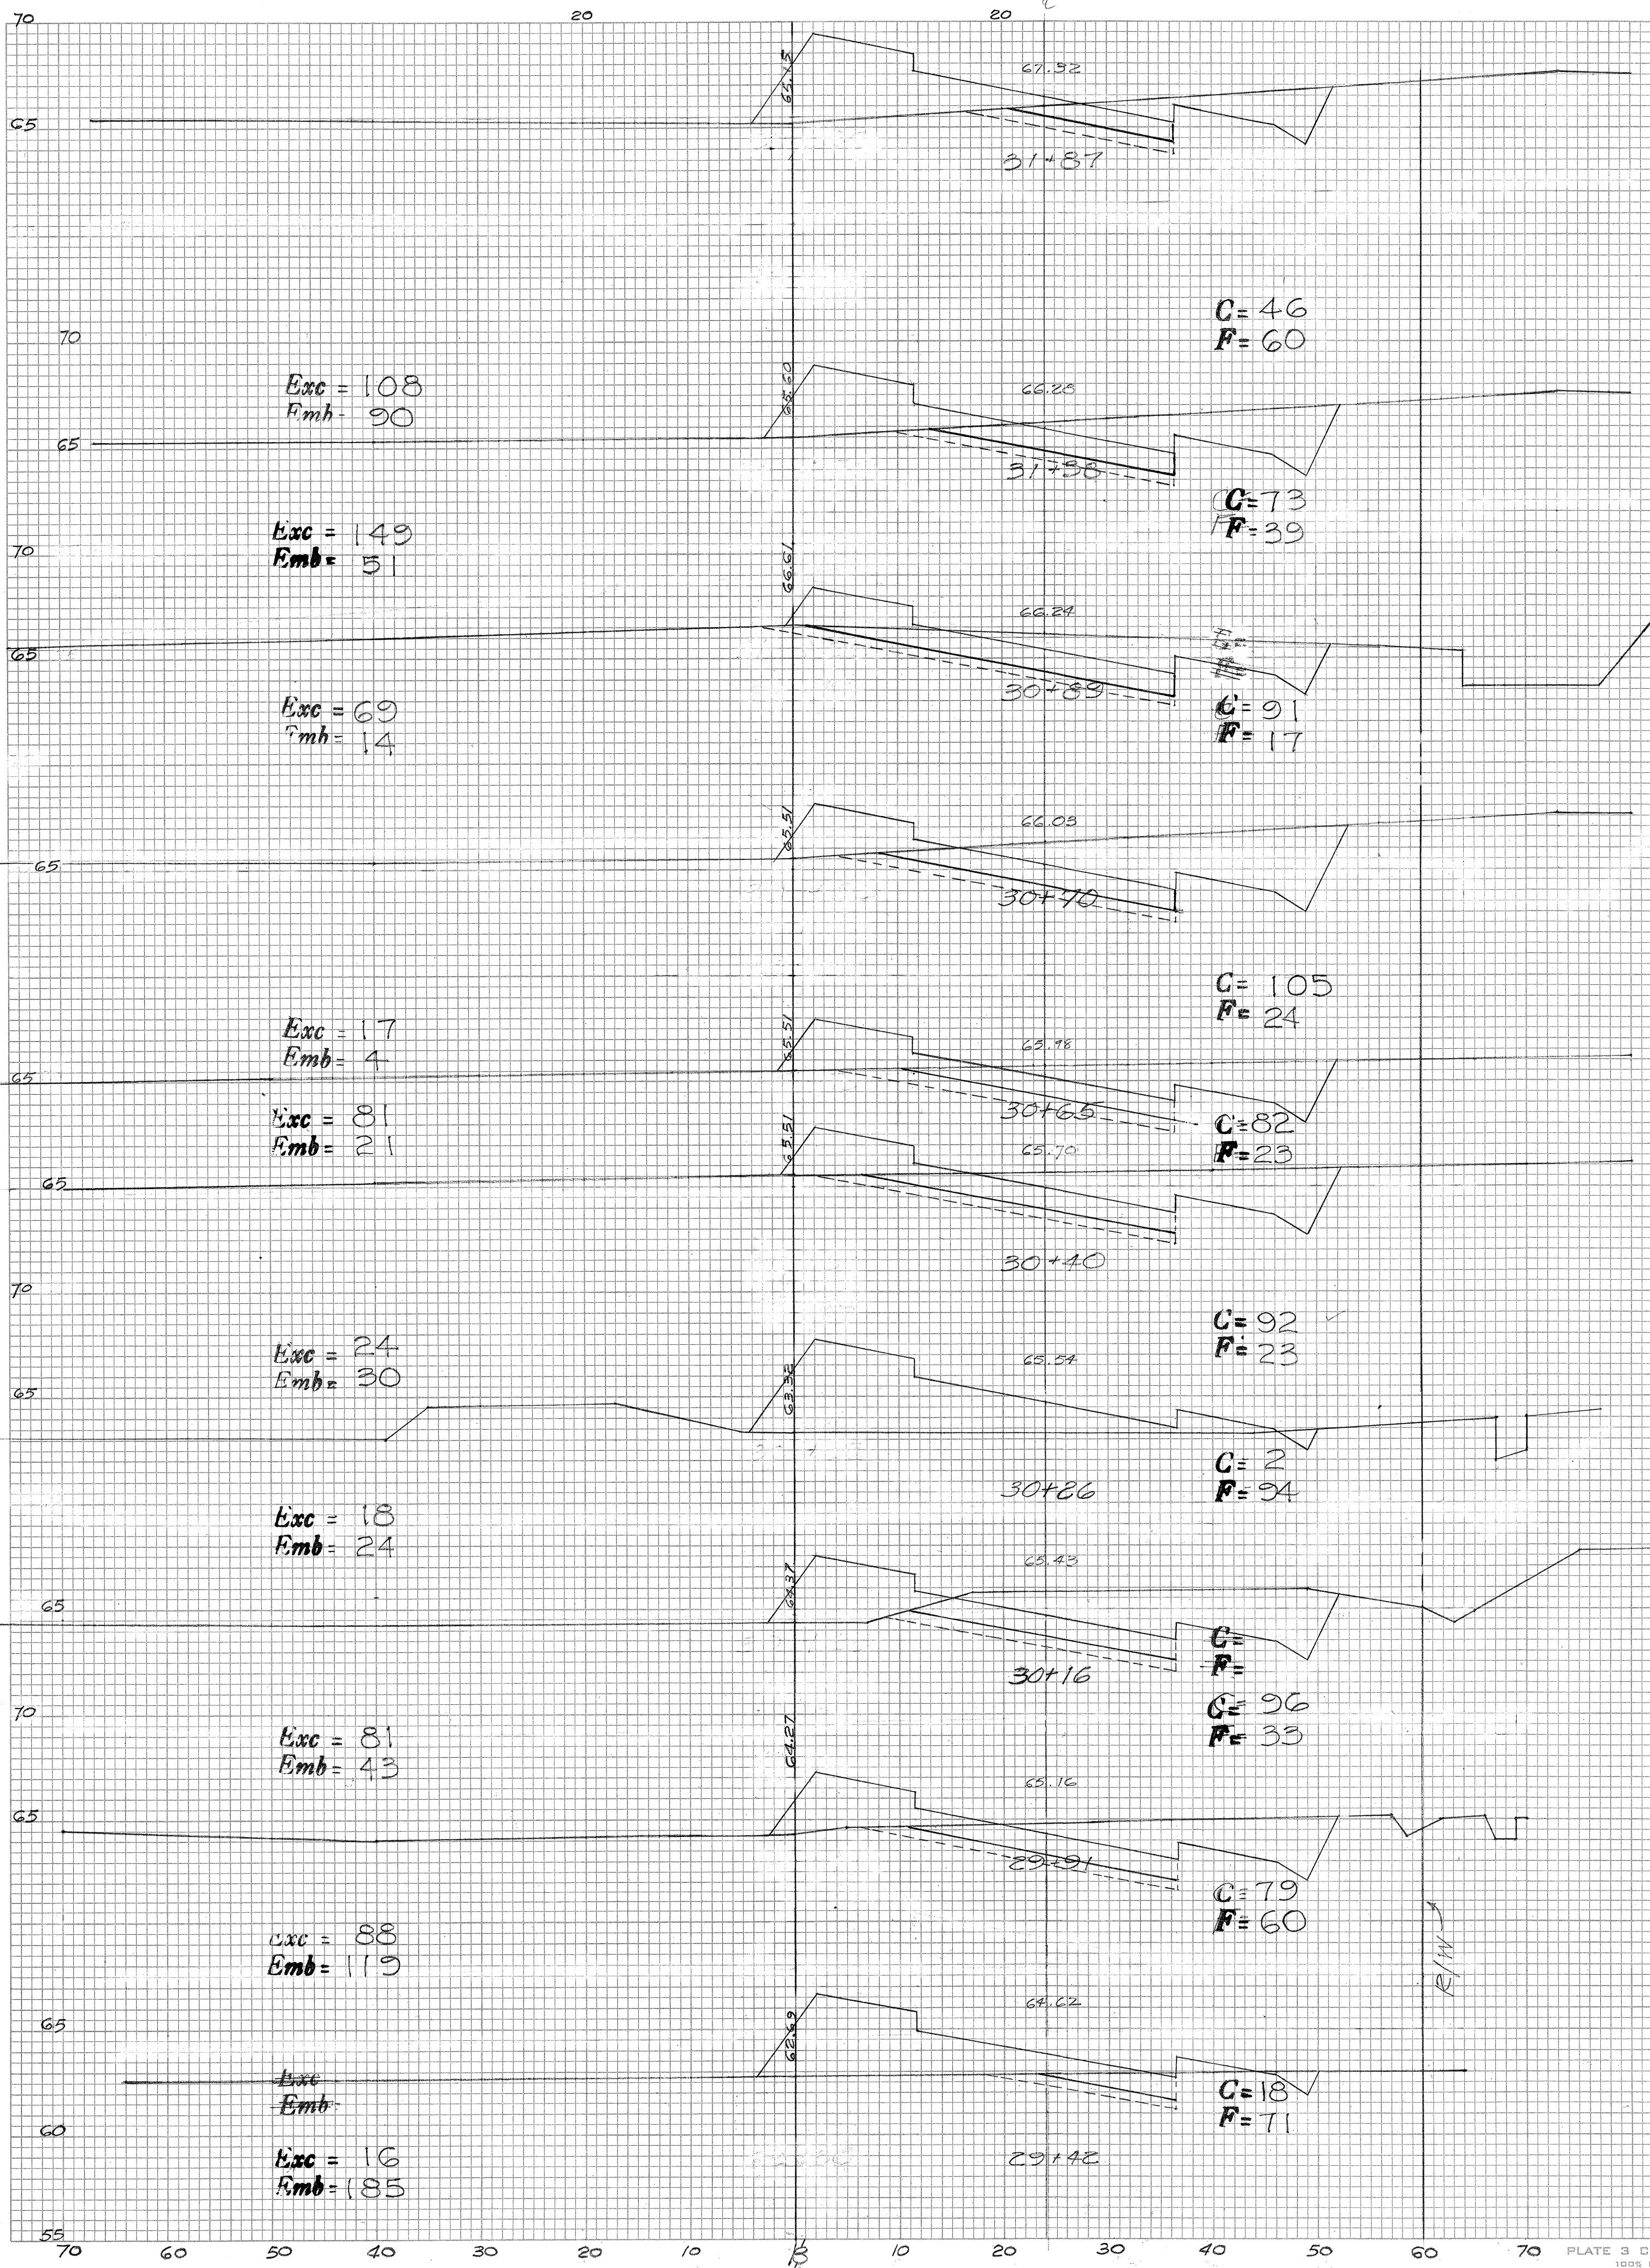

FINAL SURVEY	DATE	
	BY	
	SURVEYED PLOTTER	
	NOTE BOOK NO.	

ORIGINAL SURVEY	DATE	
	BY	
	SURVEYED PLOTTER	
	NOTE BOOK NO.	

FED. ROAD DIST. No.	STATE	FED. AID PROJ. No.	FISCAL YEAR	SHEET No.	TOTAL SHEETS
HAWAII	HAW.	DAO-16	1958	20	23

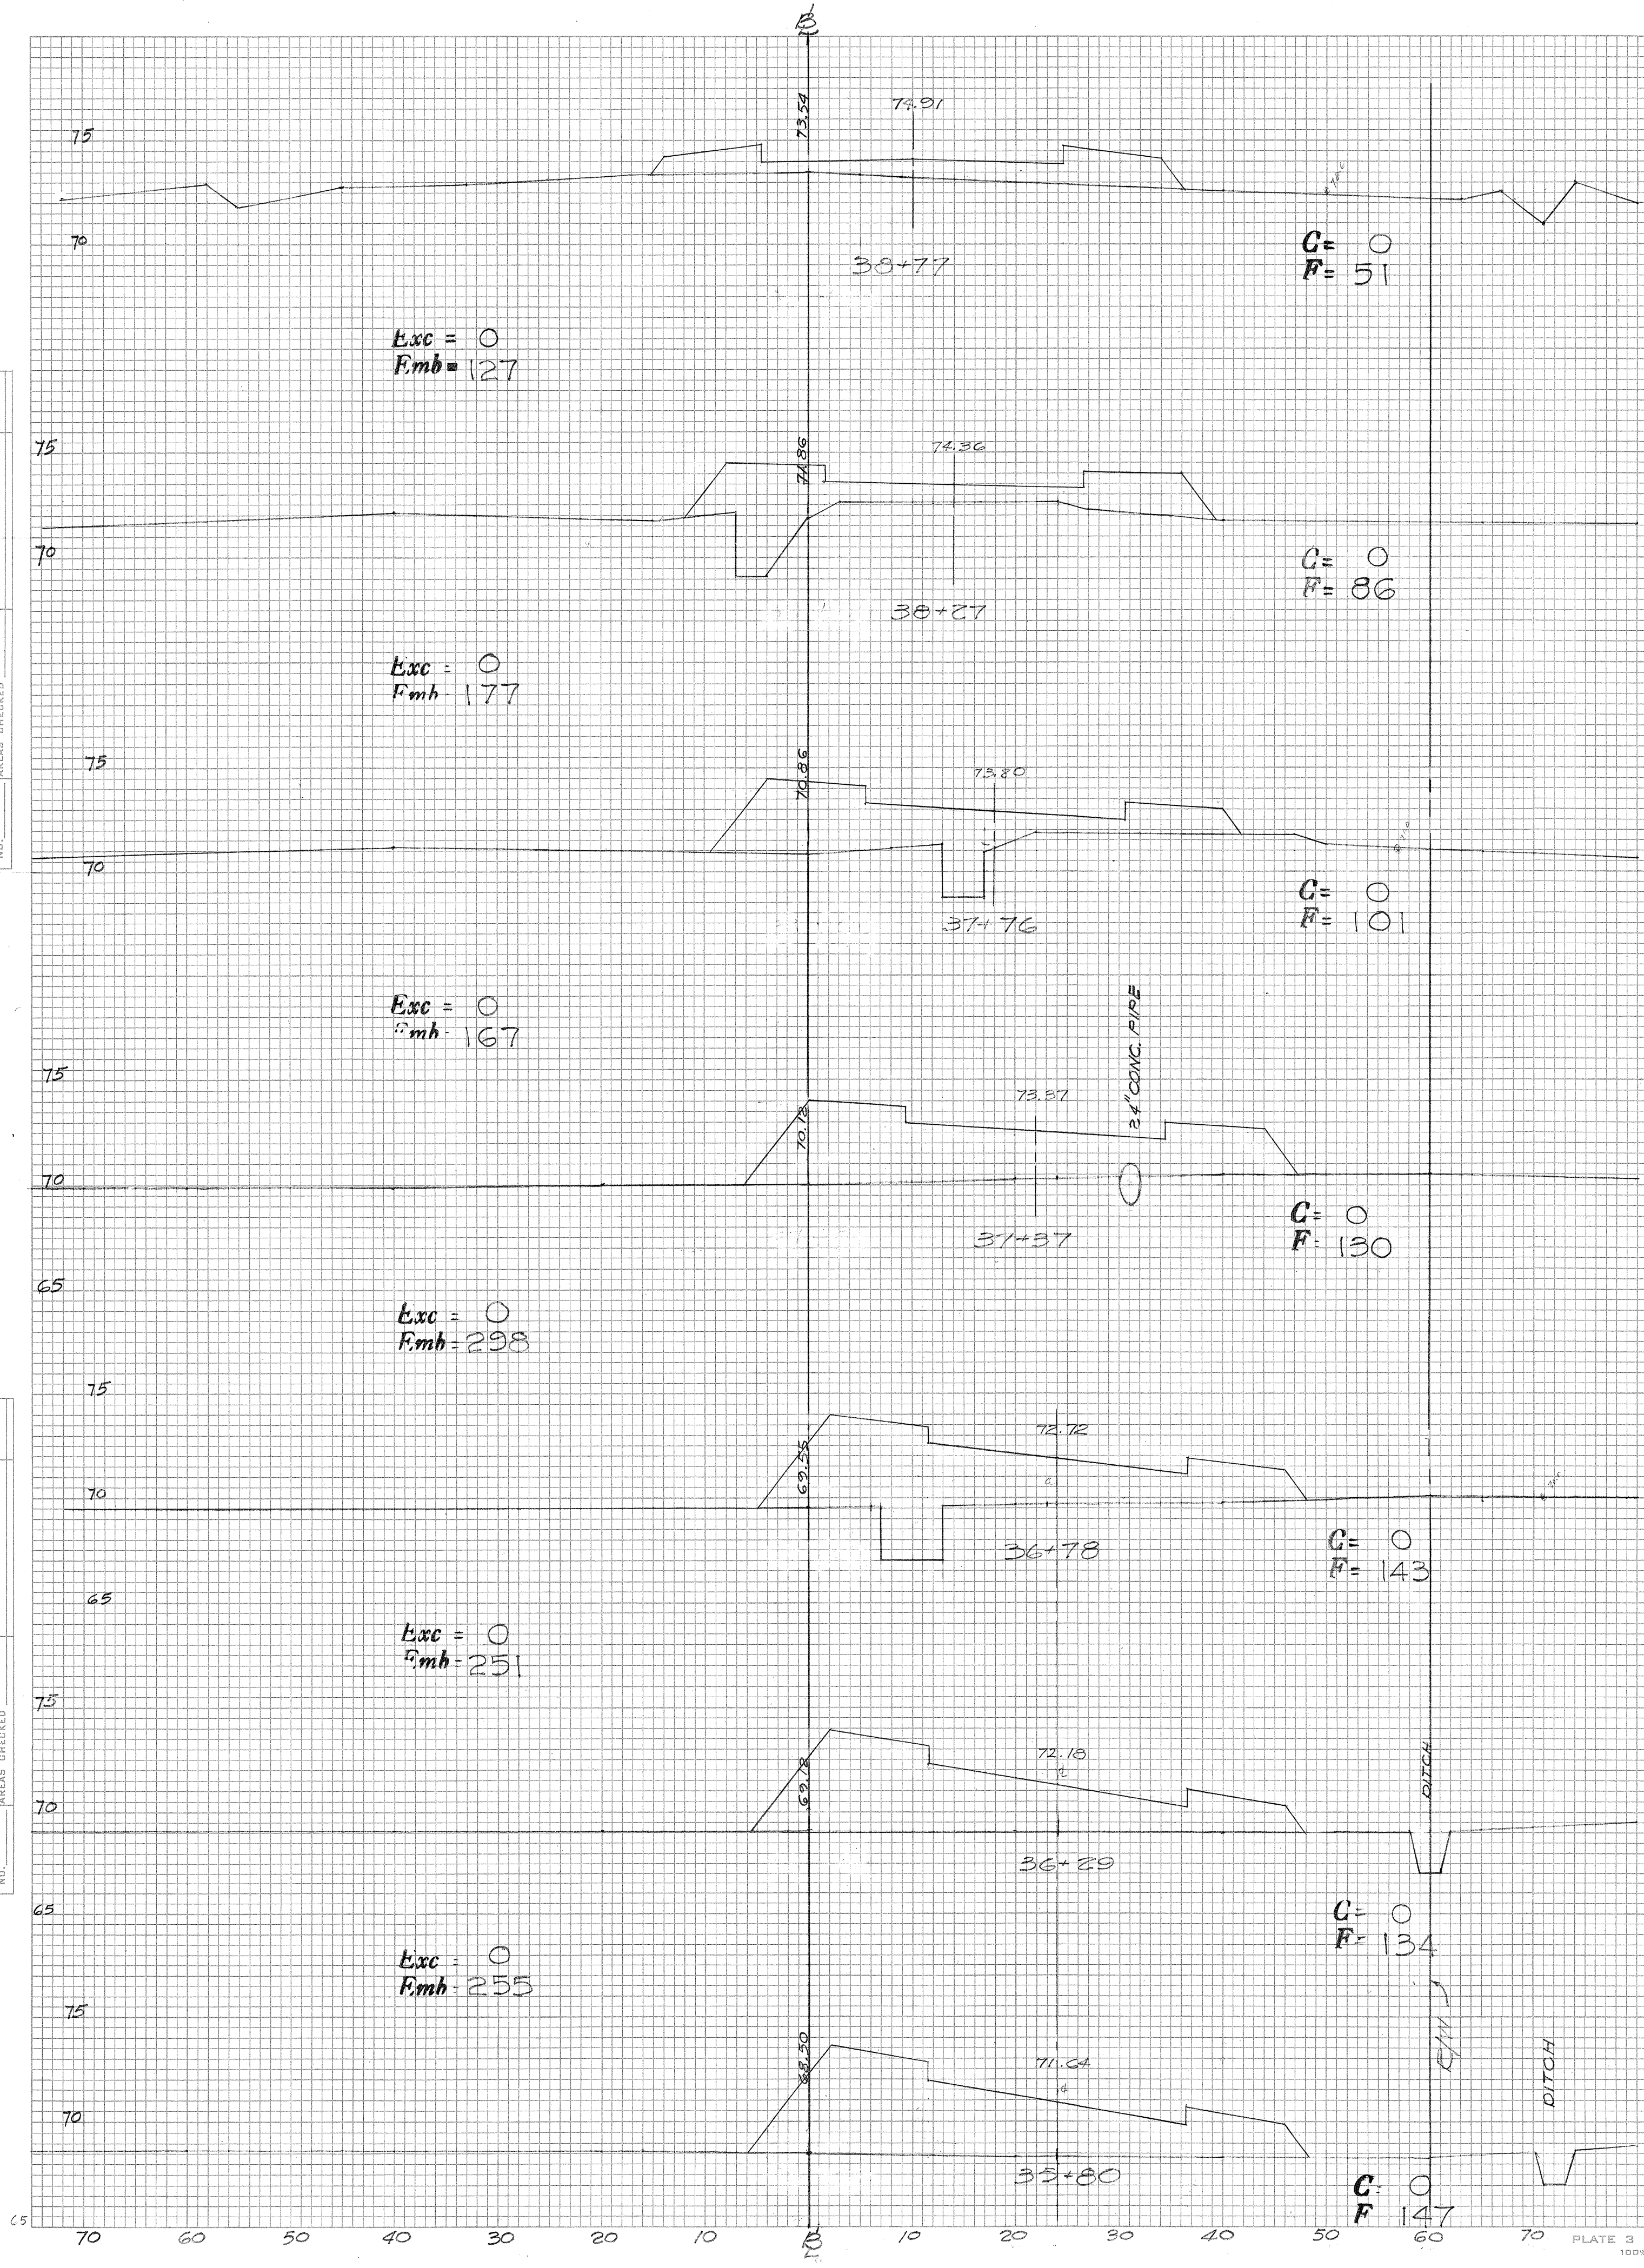



PLATE 3 CROSS SECTION D. P. R. & R. E. STANDARD
100% RAS PAPER-MADE AND PRINTED IN U. S. A.
EUGENE DIETZEN CO.

5998.20

FED. ROAD DIST. No.	STATE	FED. AID PROJ. No.	FISCAL YEAR	SHEET No.	TOTAL SHEETS
HAWAII	HAW.	DAD-12	1958	21	29



DATE	BY	FINAL SURVEY
		NO. _____
		NO. _____
DATE	BY	ORIGINAL SURVEY
		NO. _____
		NO. _____
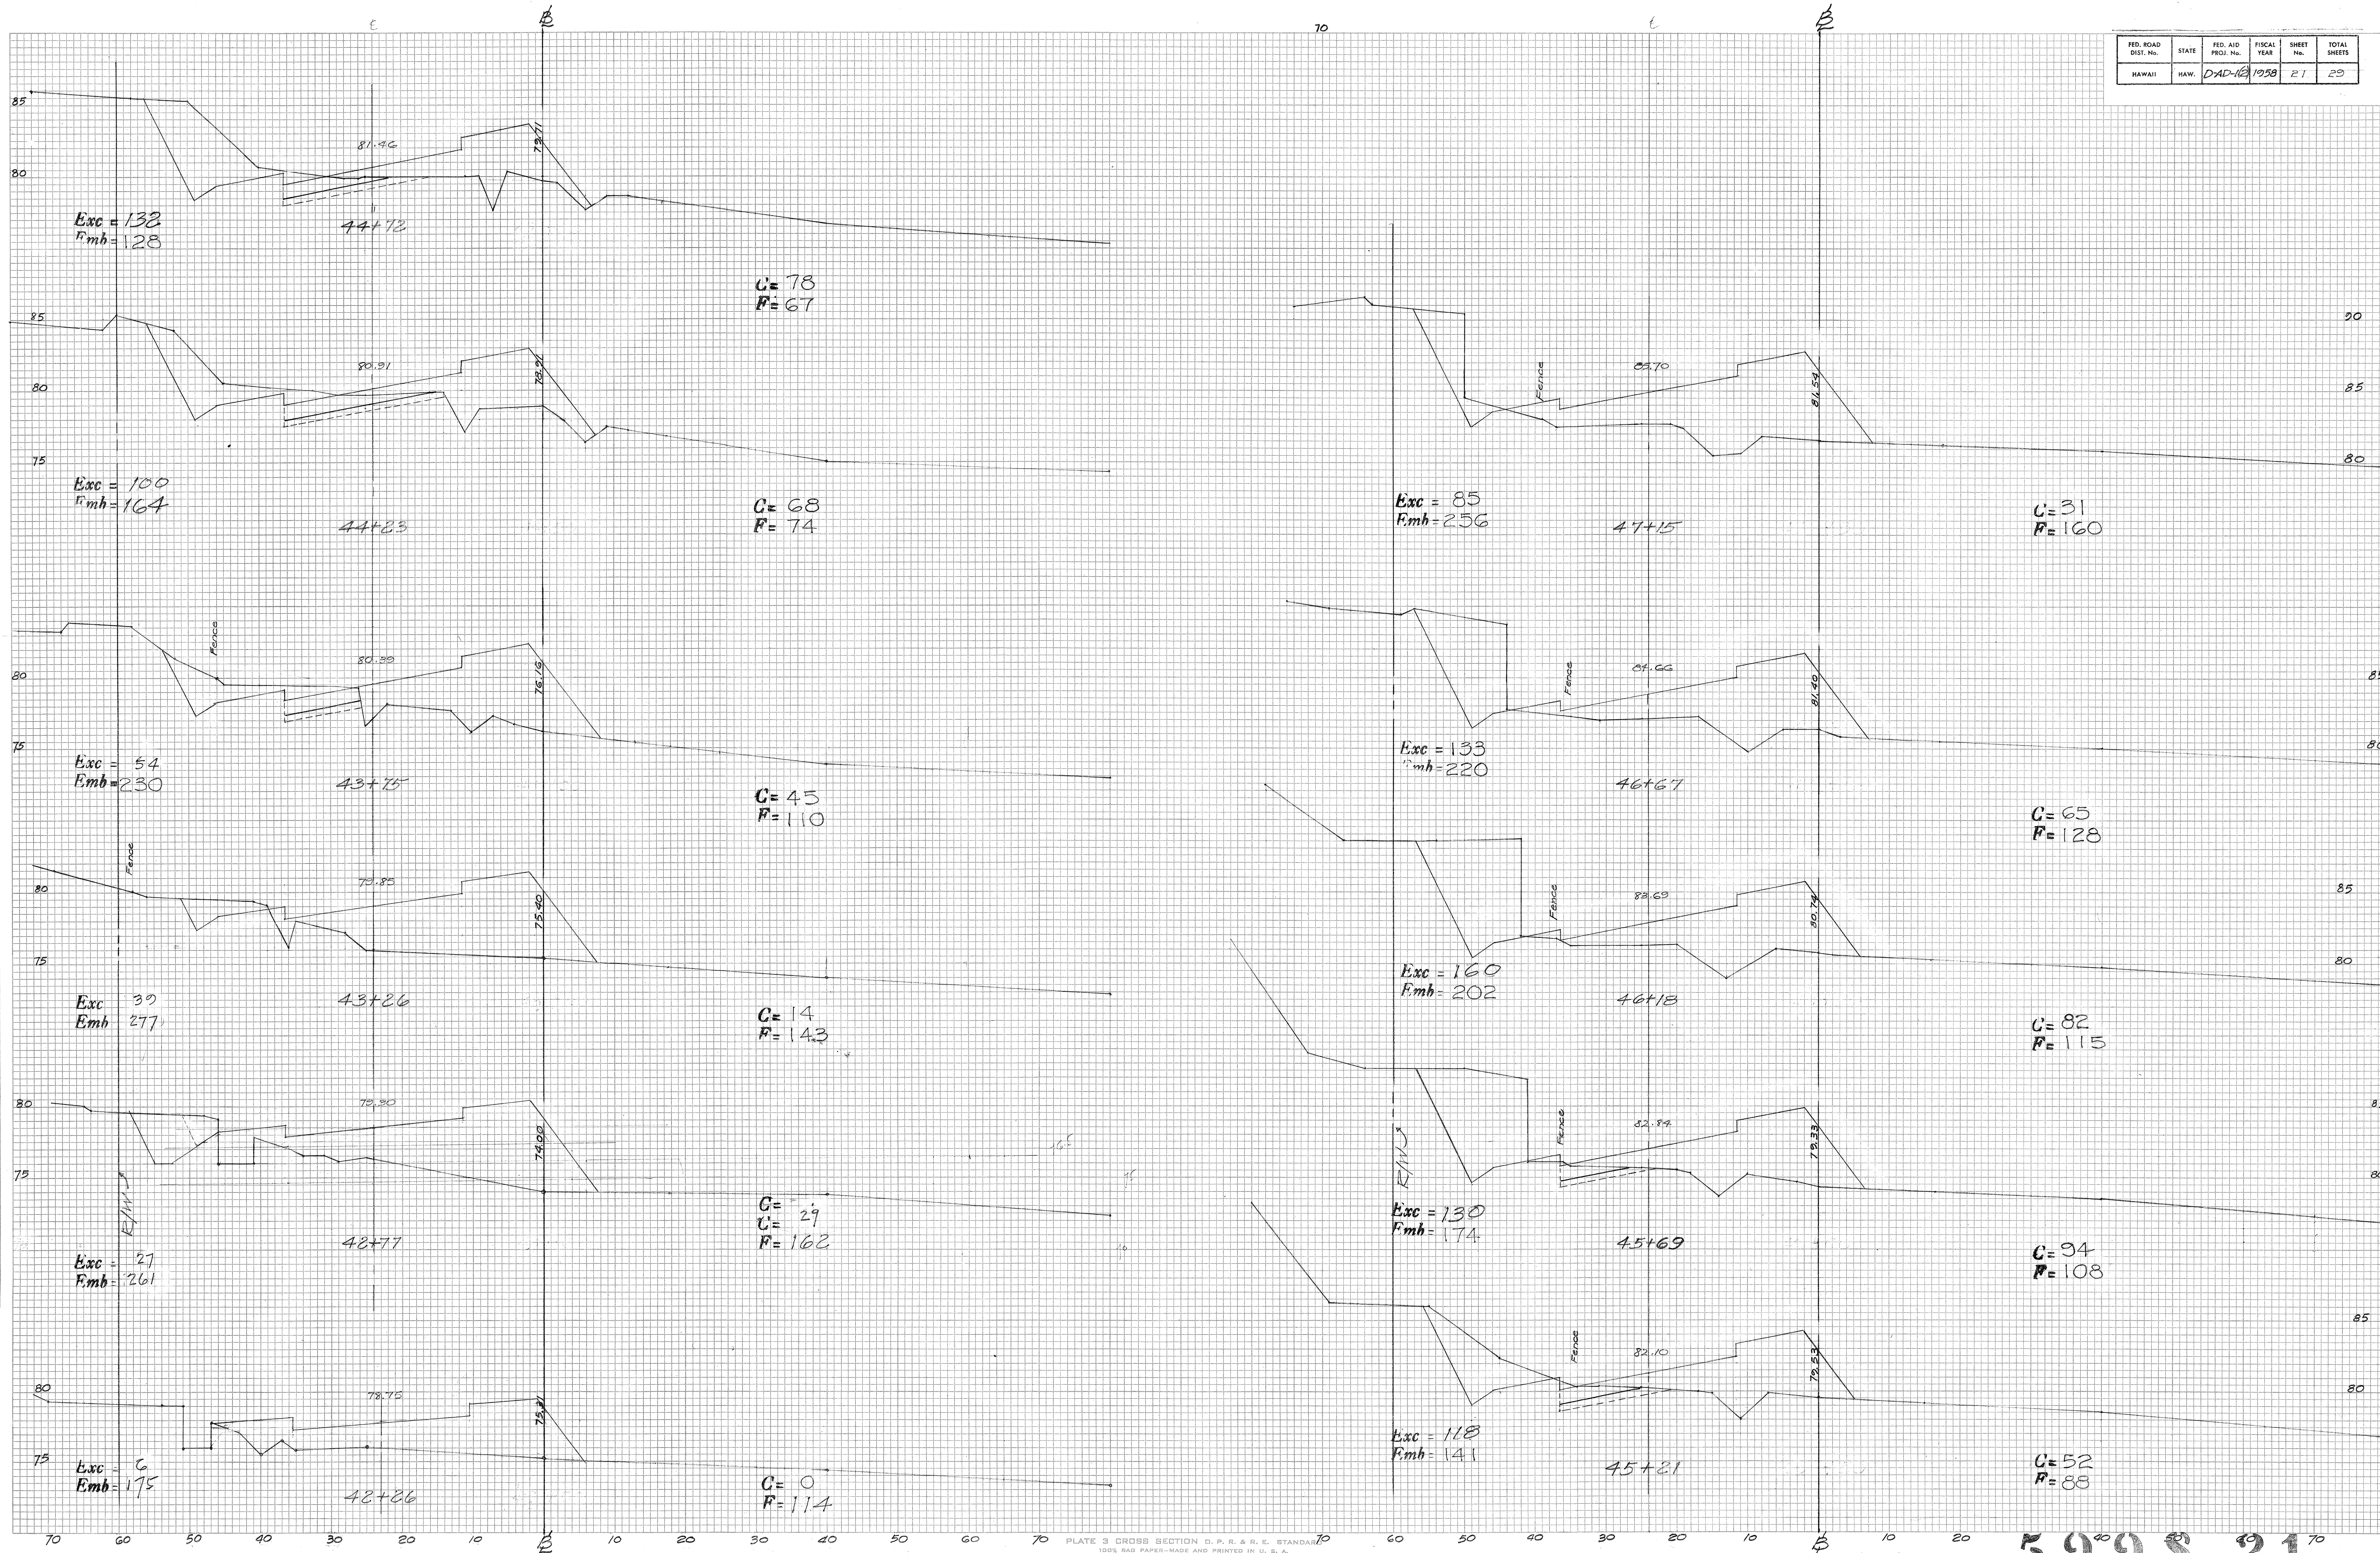

FINAL SURVEY	DATE	BY
SURVEYED		
NOTED		
AREAS		
NO.		

ORIGINAL SURVEY	DATE	BY
SURVEYED		
NOTED		
AREAS		
NO.		

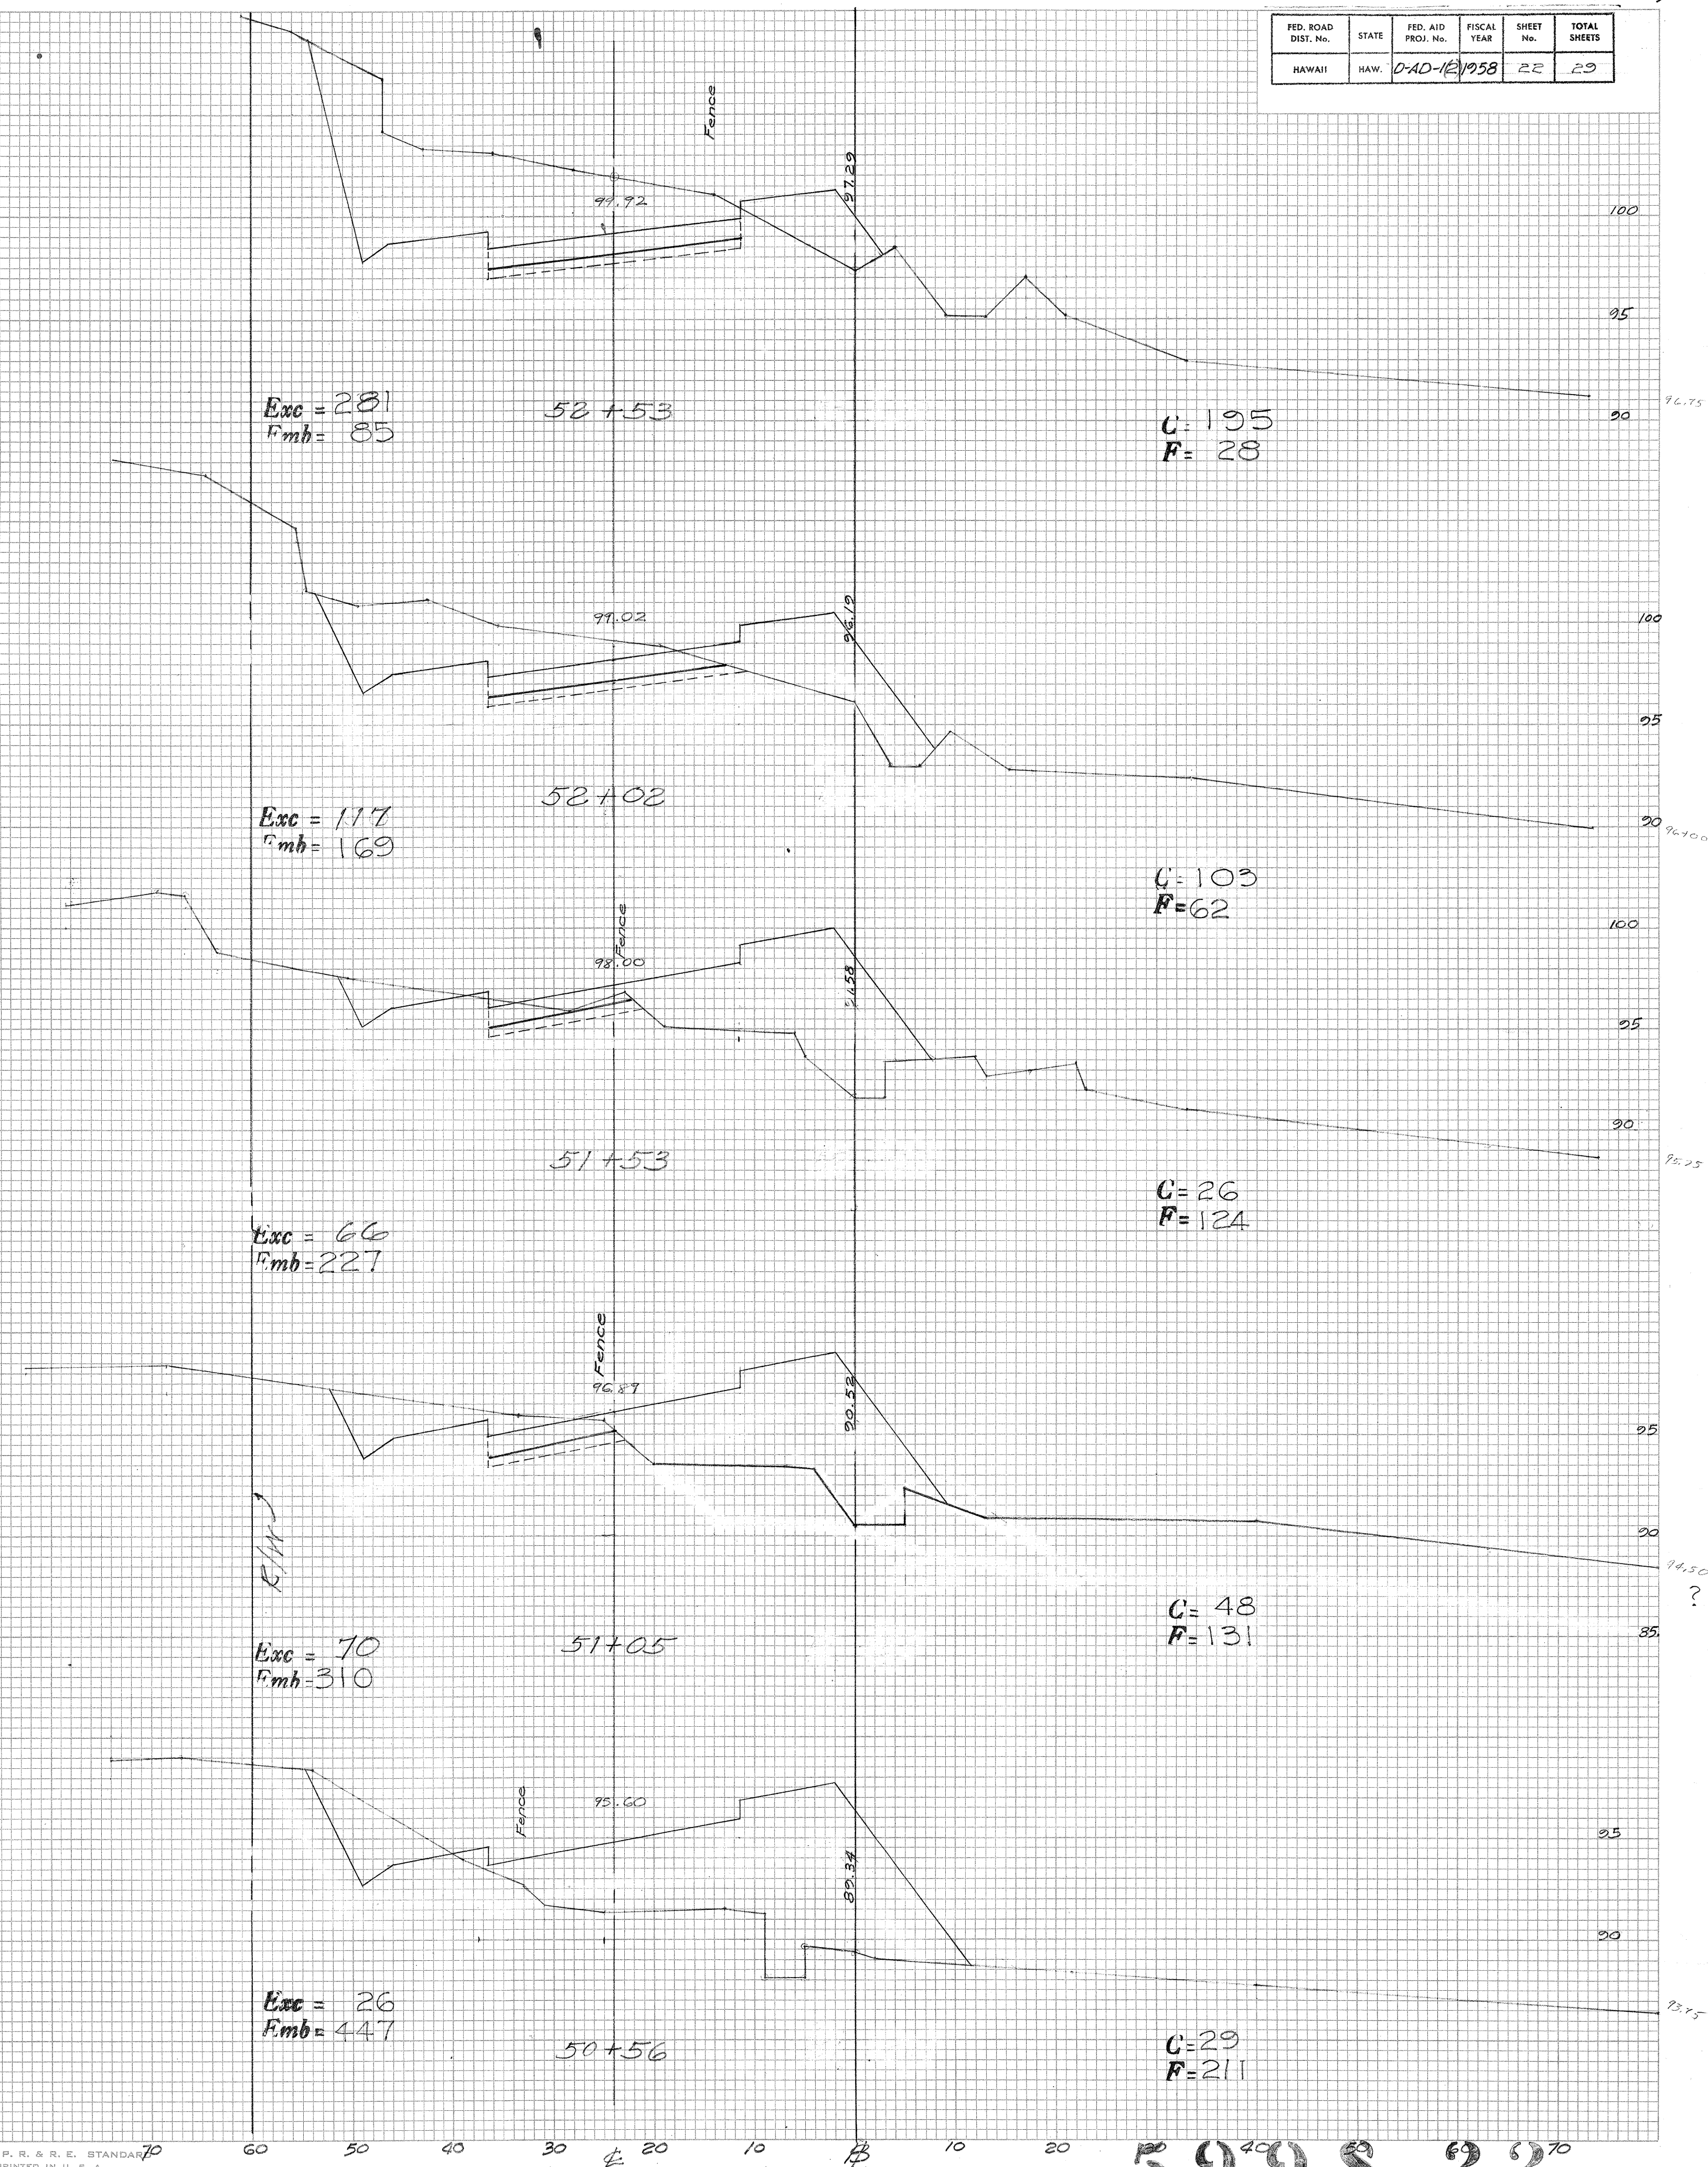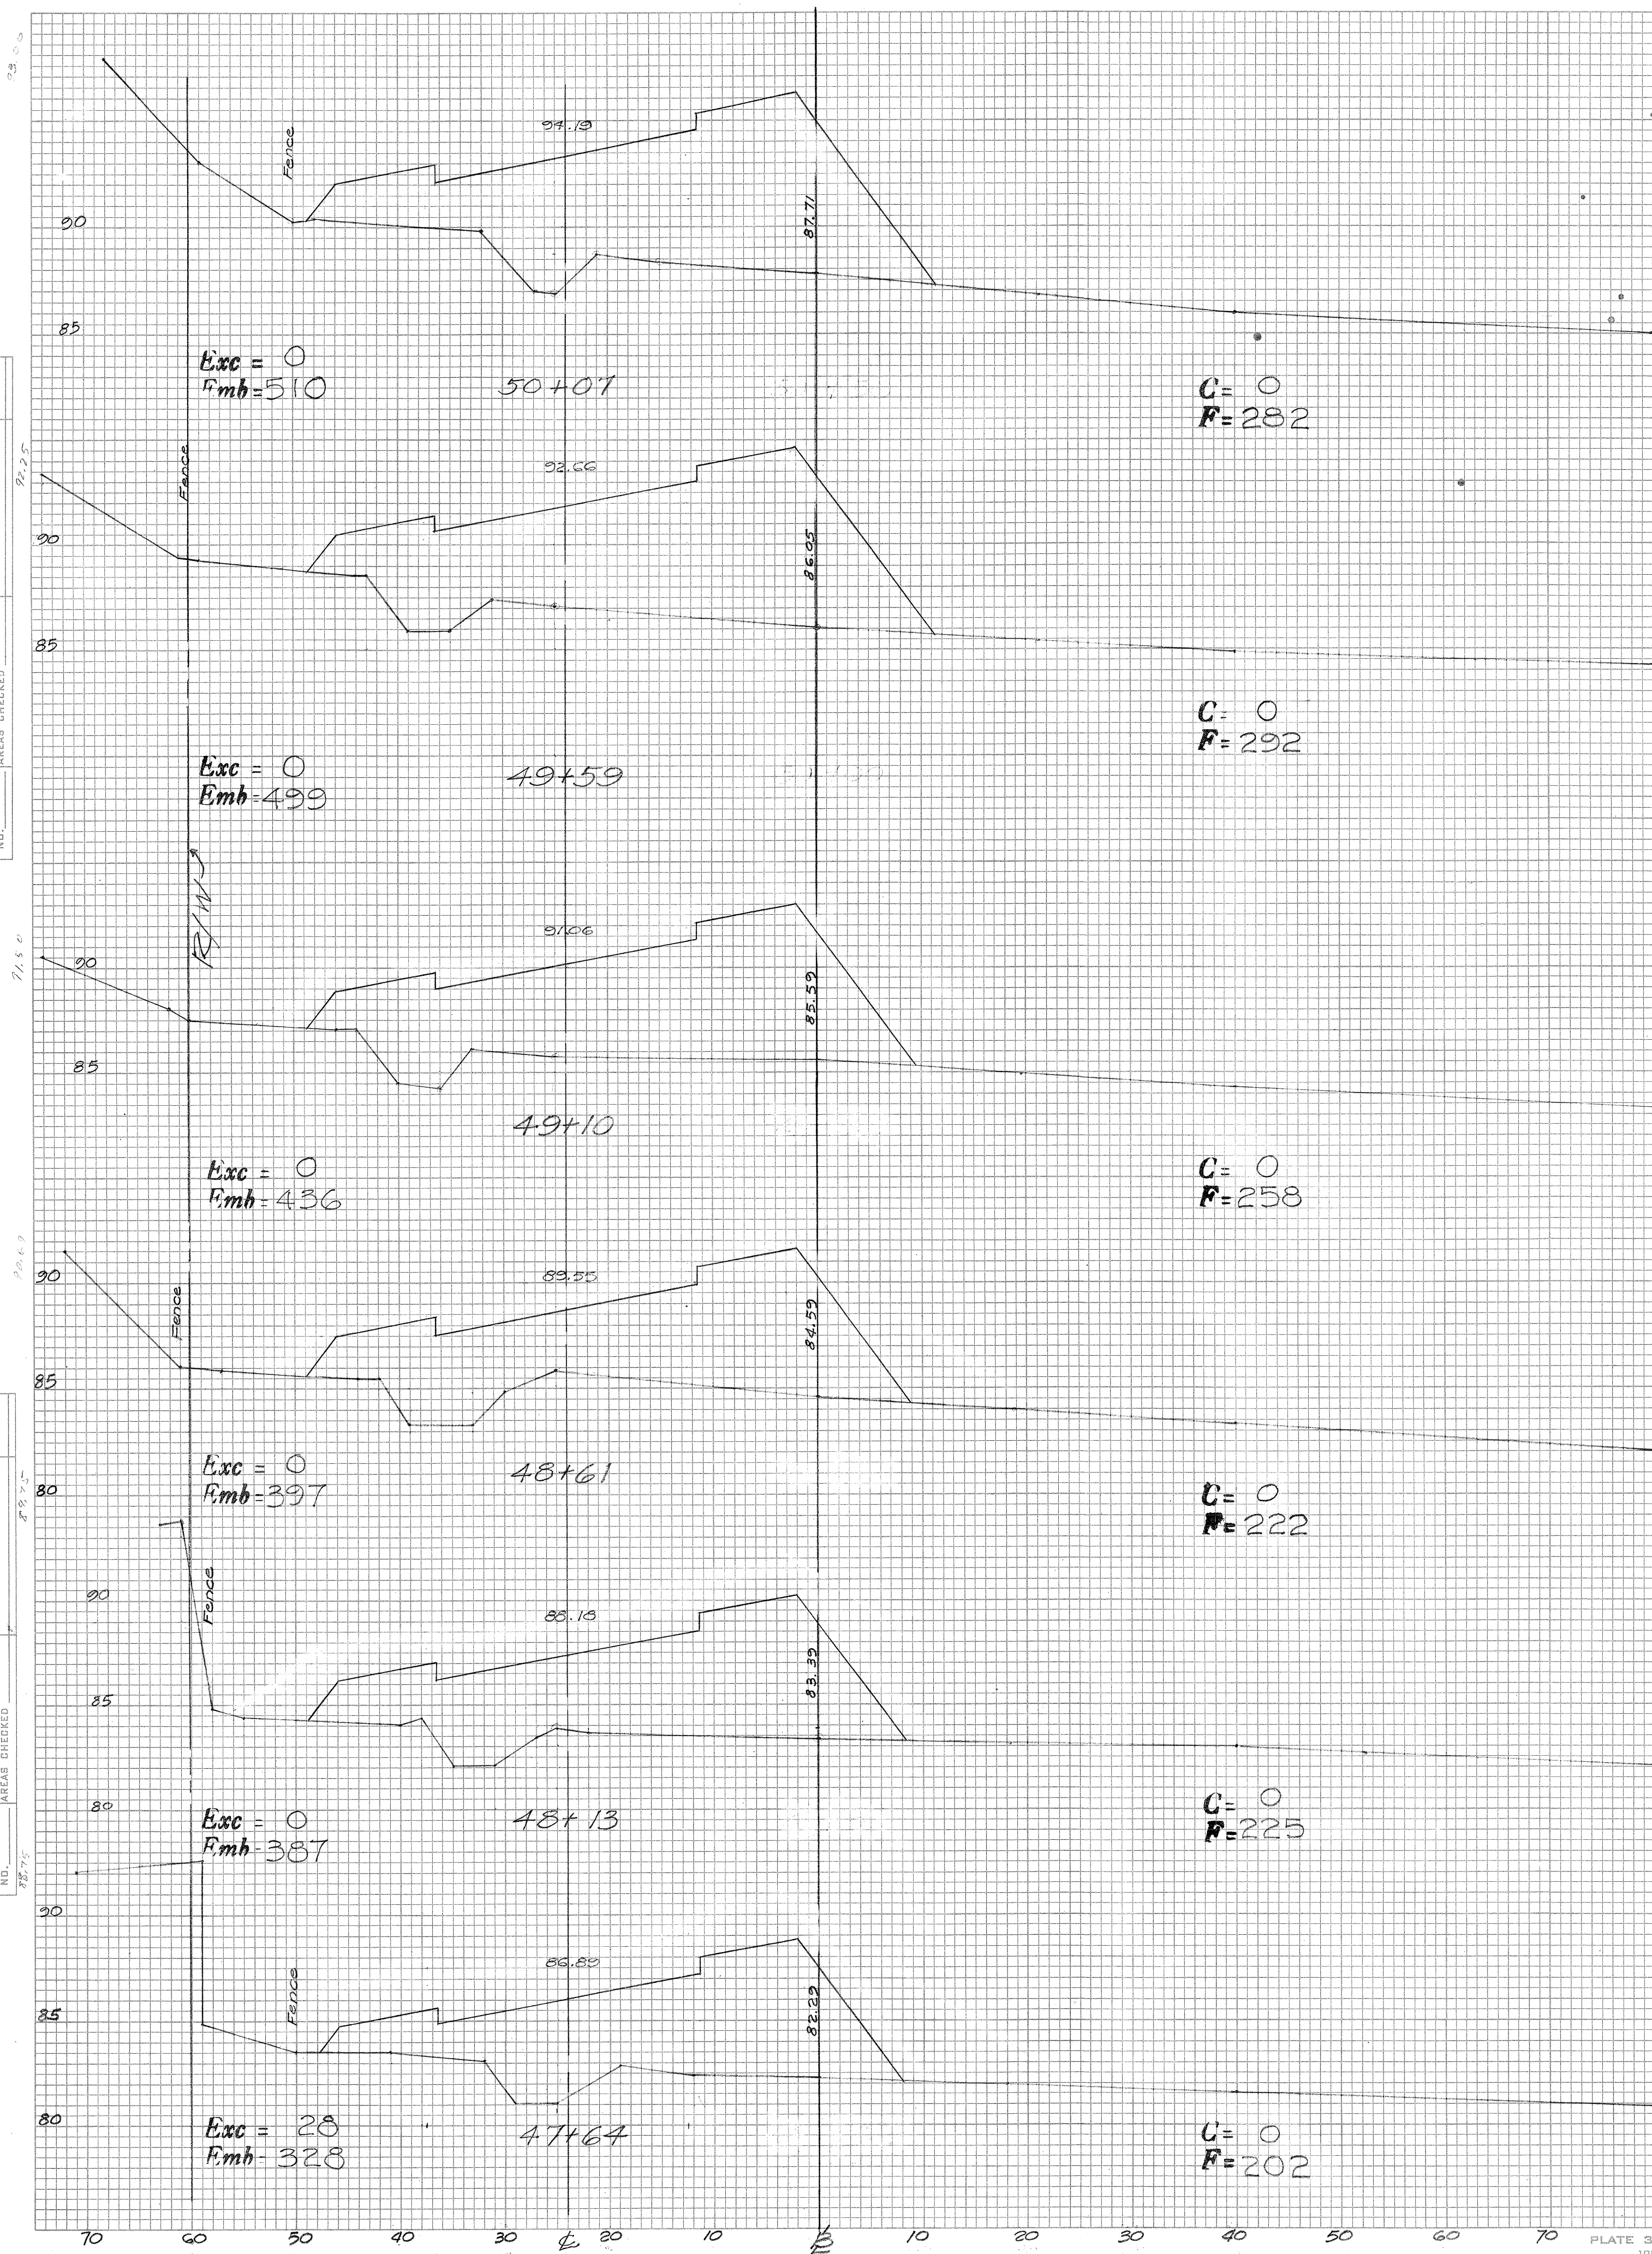


FED. ROAD DIST. No.	STATE	FED. AID PROJ. No.	FISCAL YEAR	SHEET No.	TOTAL SHEETS
HAWAII	HAW.	0-AD-12	1958	22	23

FED. ROAD DIST. No.	STATE	FED. AID PROJ. No.	FISCAL YEAR	SHEET No.	TOTAL SHEETS
HAWAII	HAW.	D-10-12	1958	23	25

FINAL SURVEY	DATE
NO.	
SURVEYED	BY
PLOTTED	
NOTE BOOK	
AREAS CHECKED	

ORIGINAL SURVEY	DATE
NO.	
SURVEYED	BY
PLOTTED	
NOTE BOOK	
AREAS CHECKED	


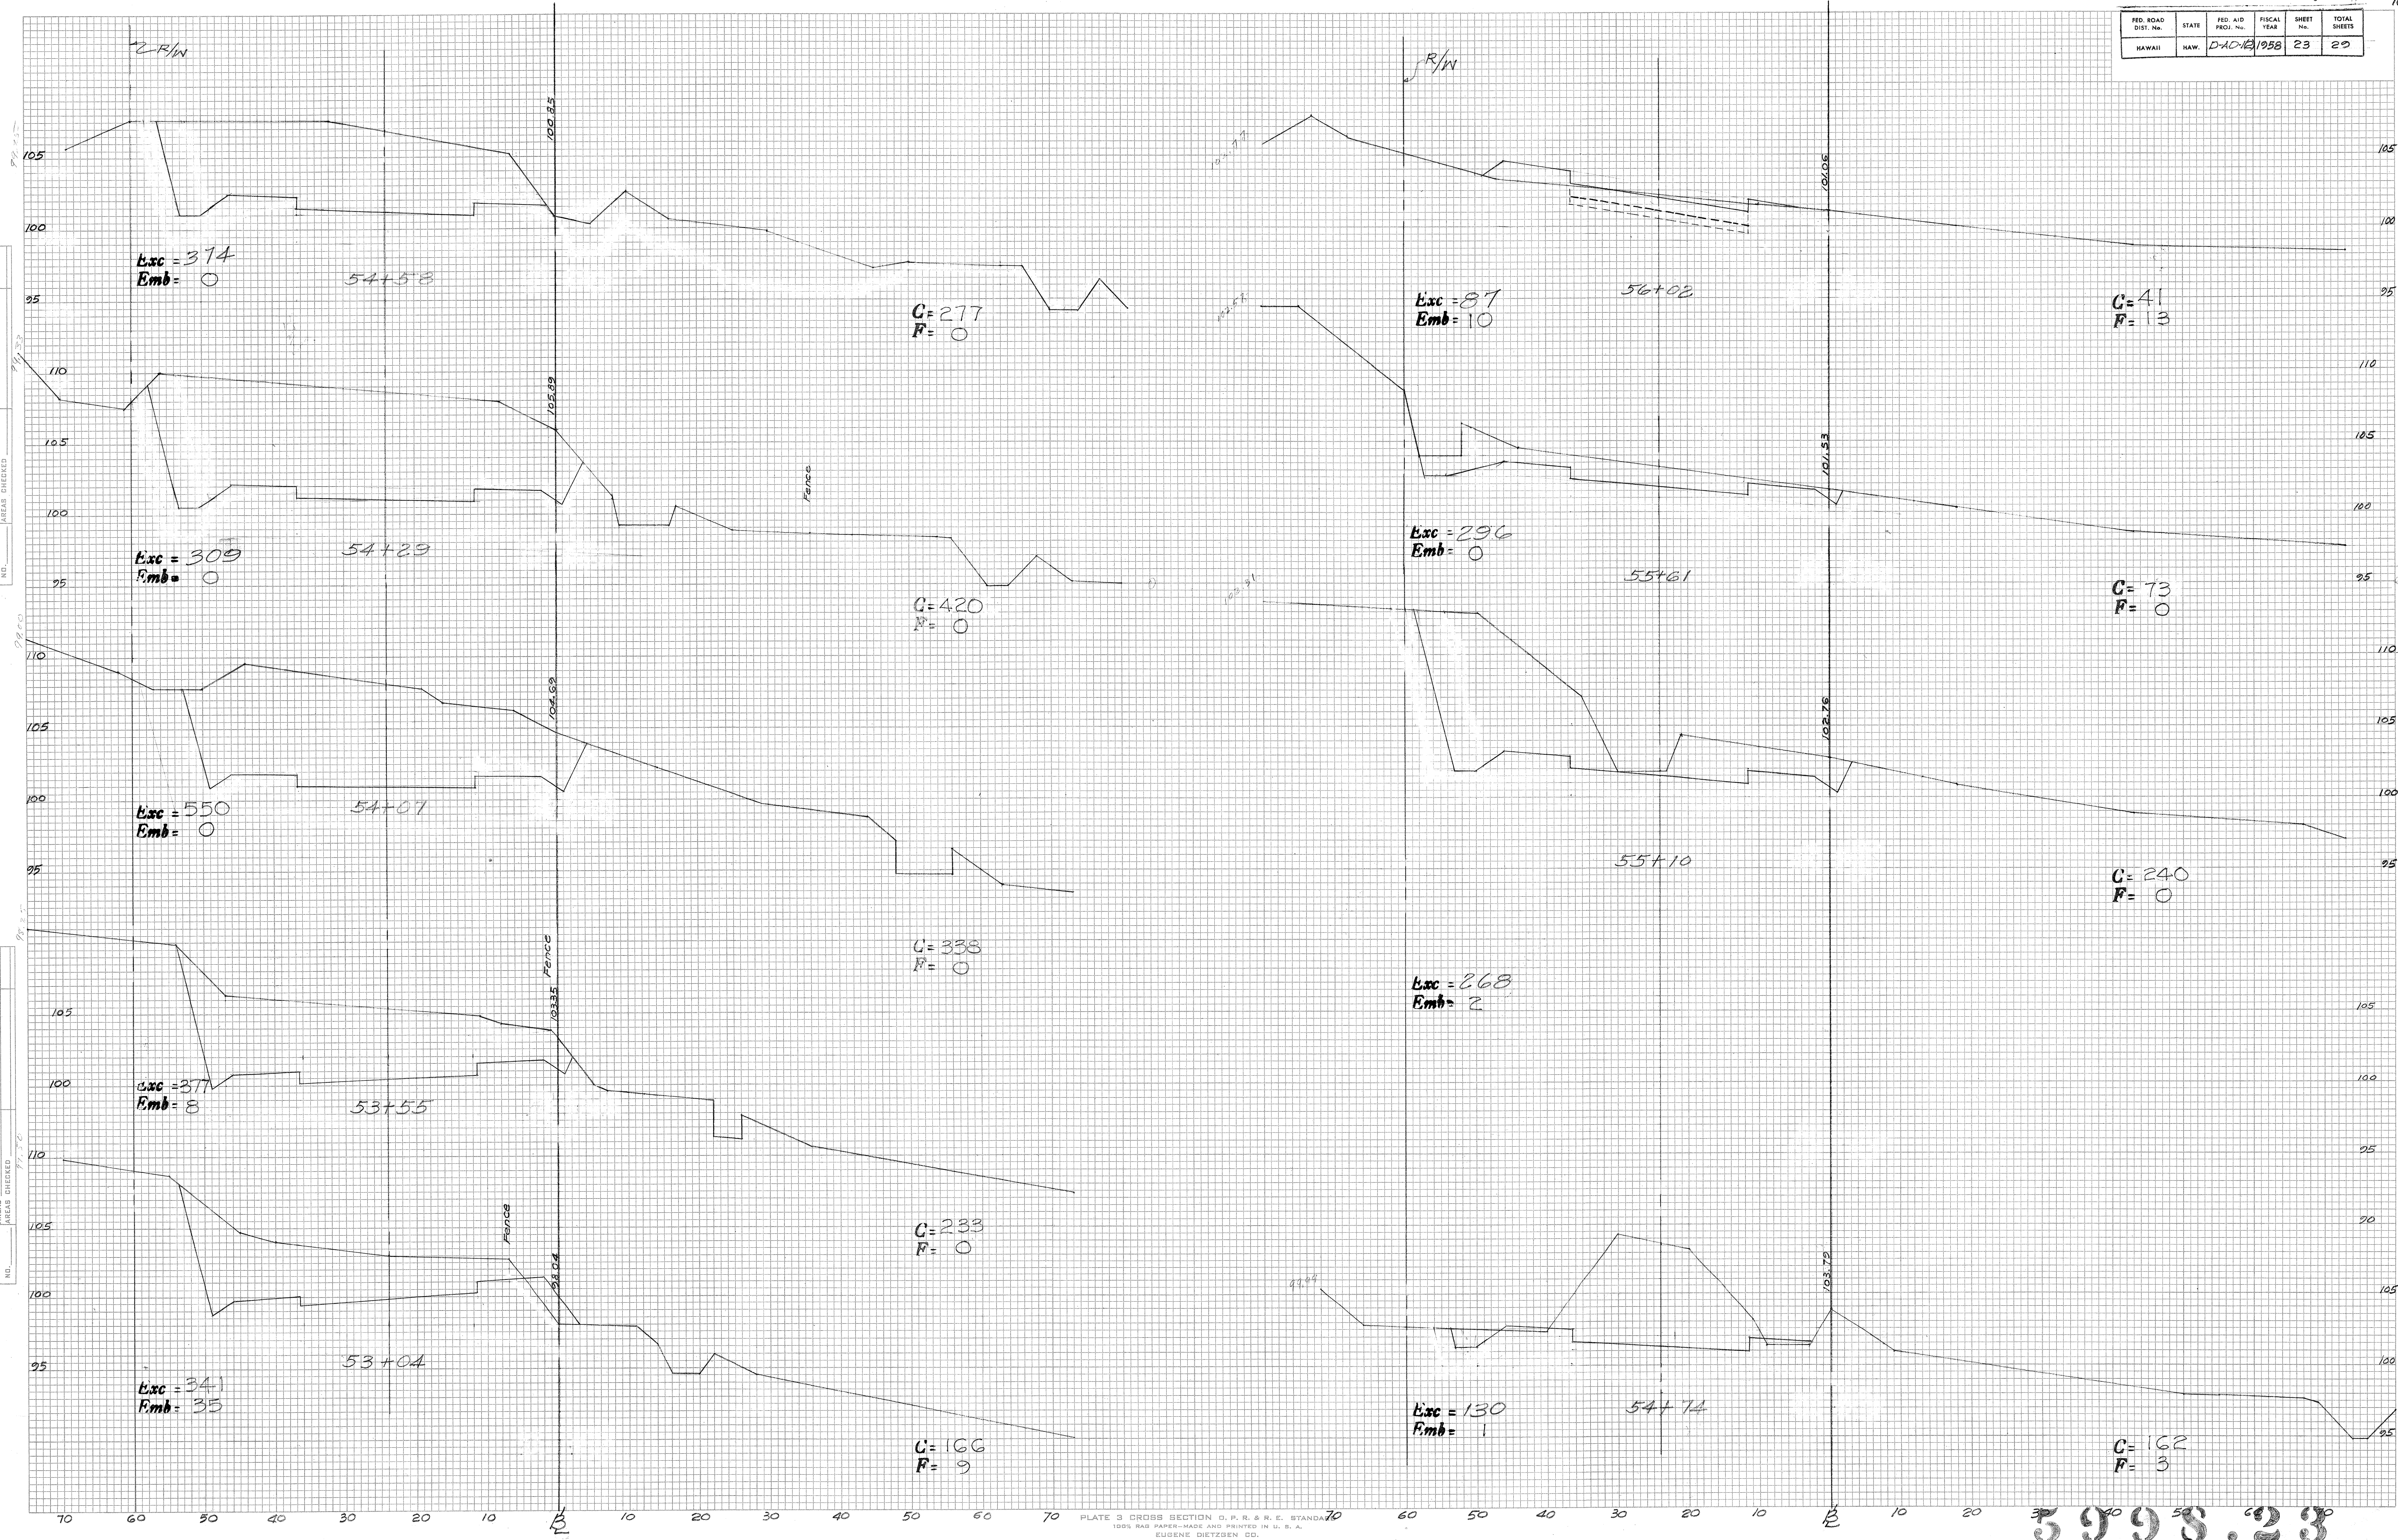


5998.23

DATE	BY	FINAL SURVEY	SURVEYED	PLOTTED	NOTED	CHECKED

DATE	BY	ORIGINAL SURVEY	SURVEYED	PLOTTED	NOTED	CHECKED

FED. ROAD DIST. NO.	STATE	FED. AID PROJ. NO.	FISCAL YEAR	SHEET NO.	TOTAL SHEETS
HAWAII	HAW.	D-AD-12	1958	24	29

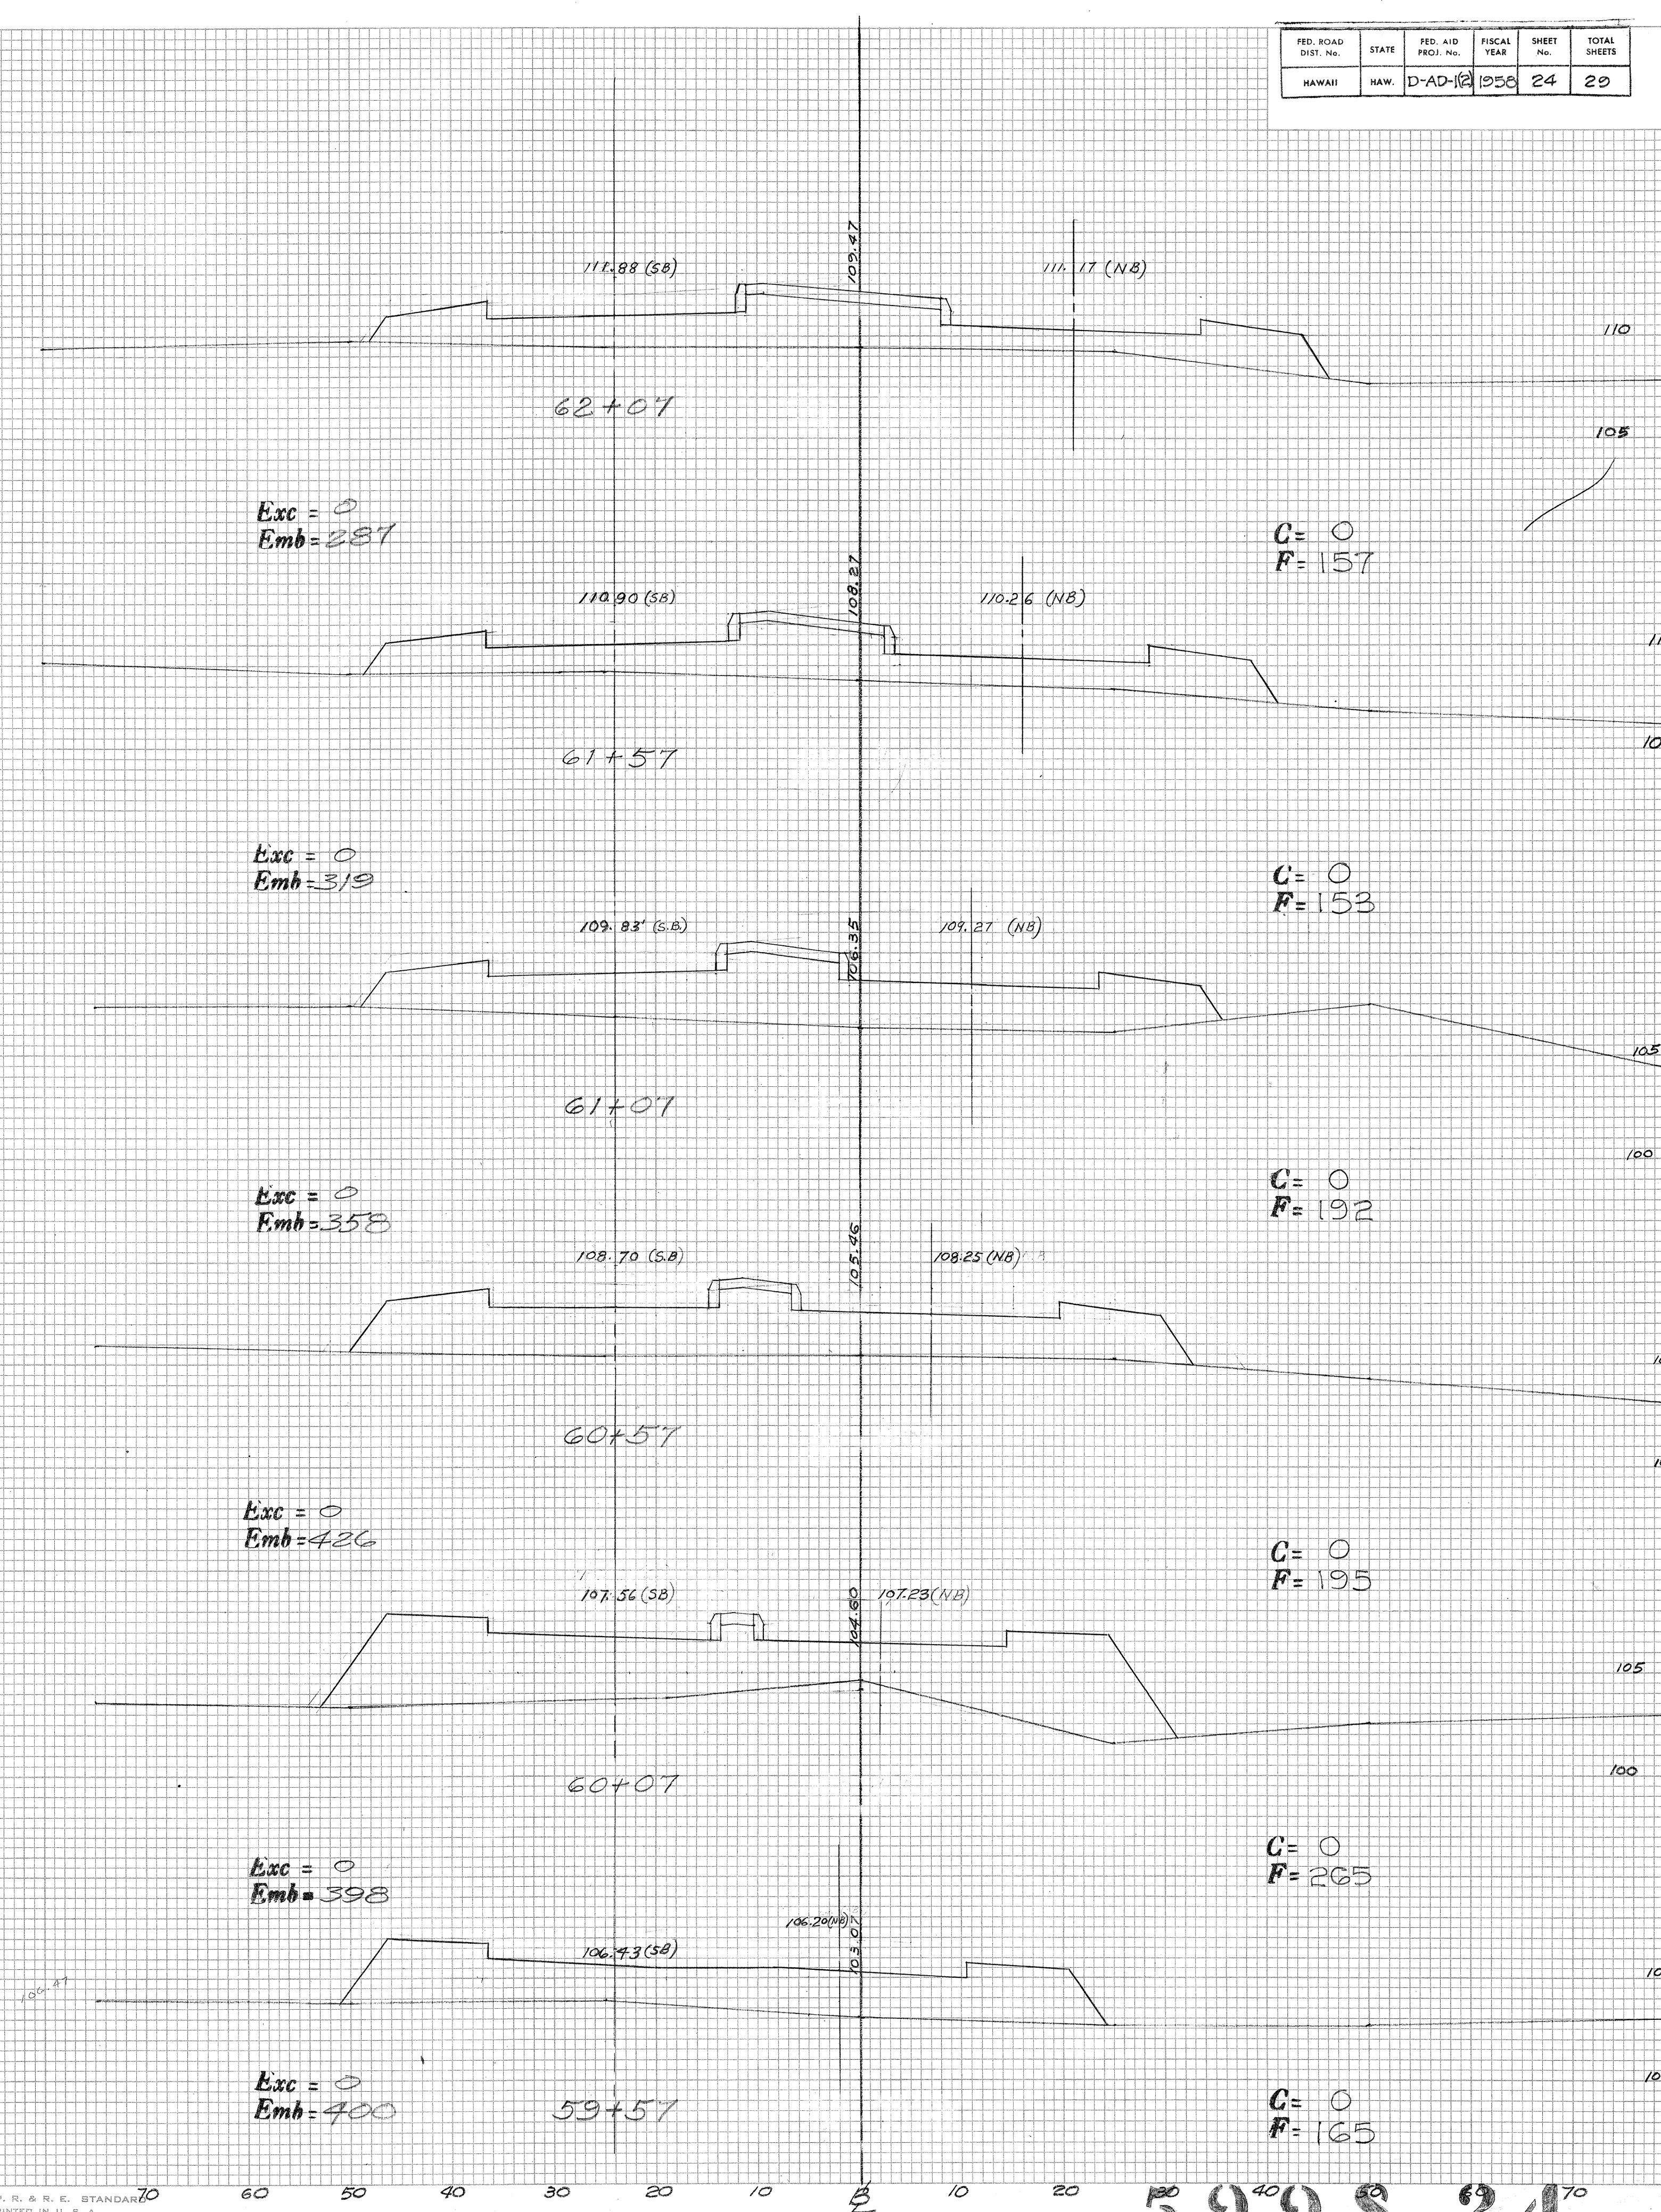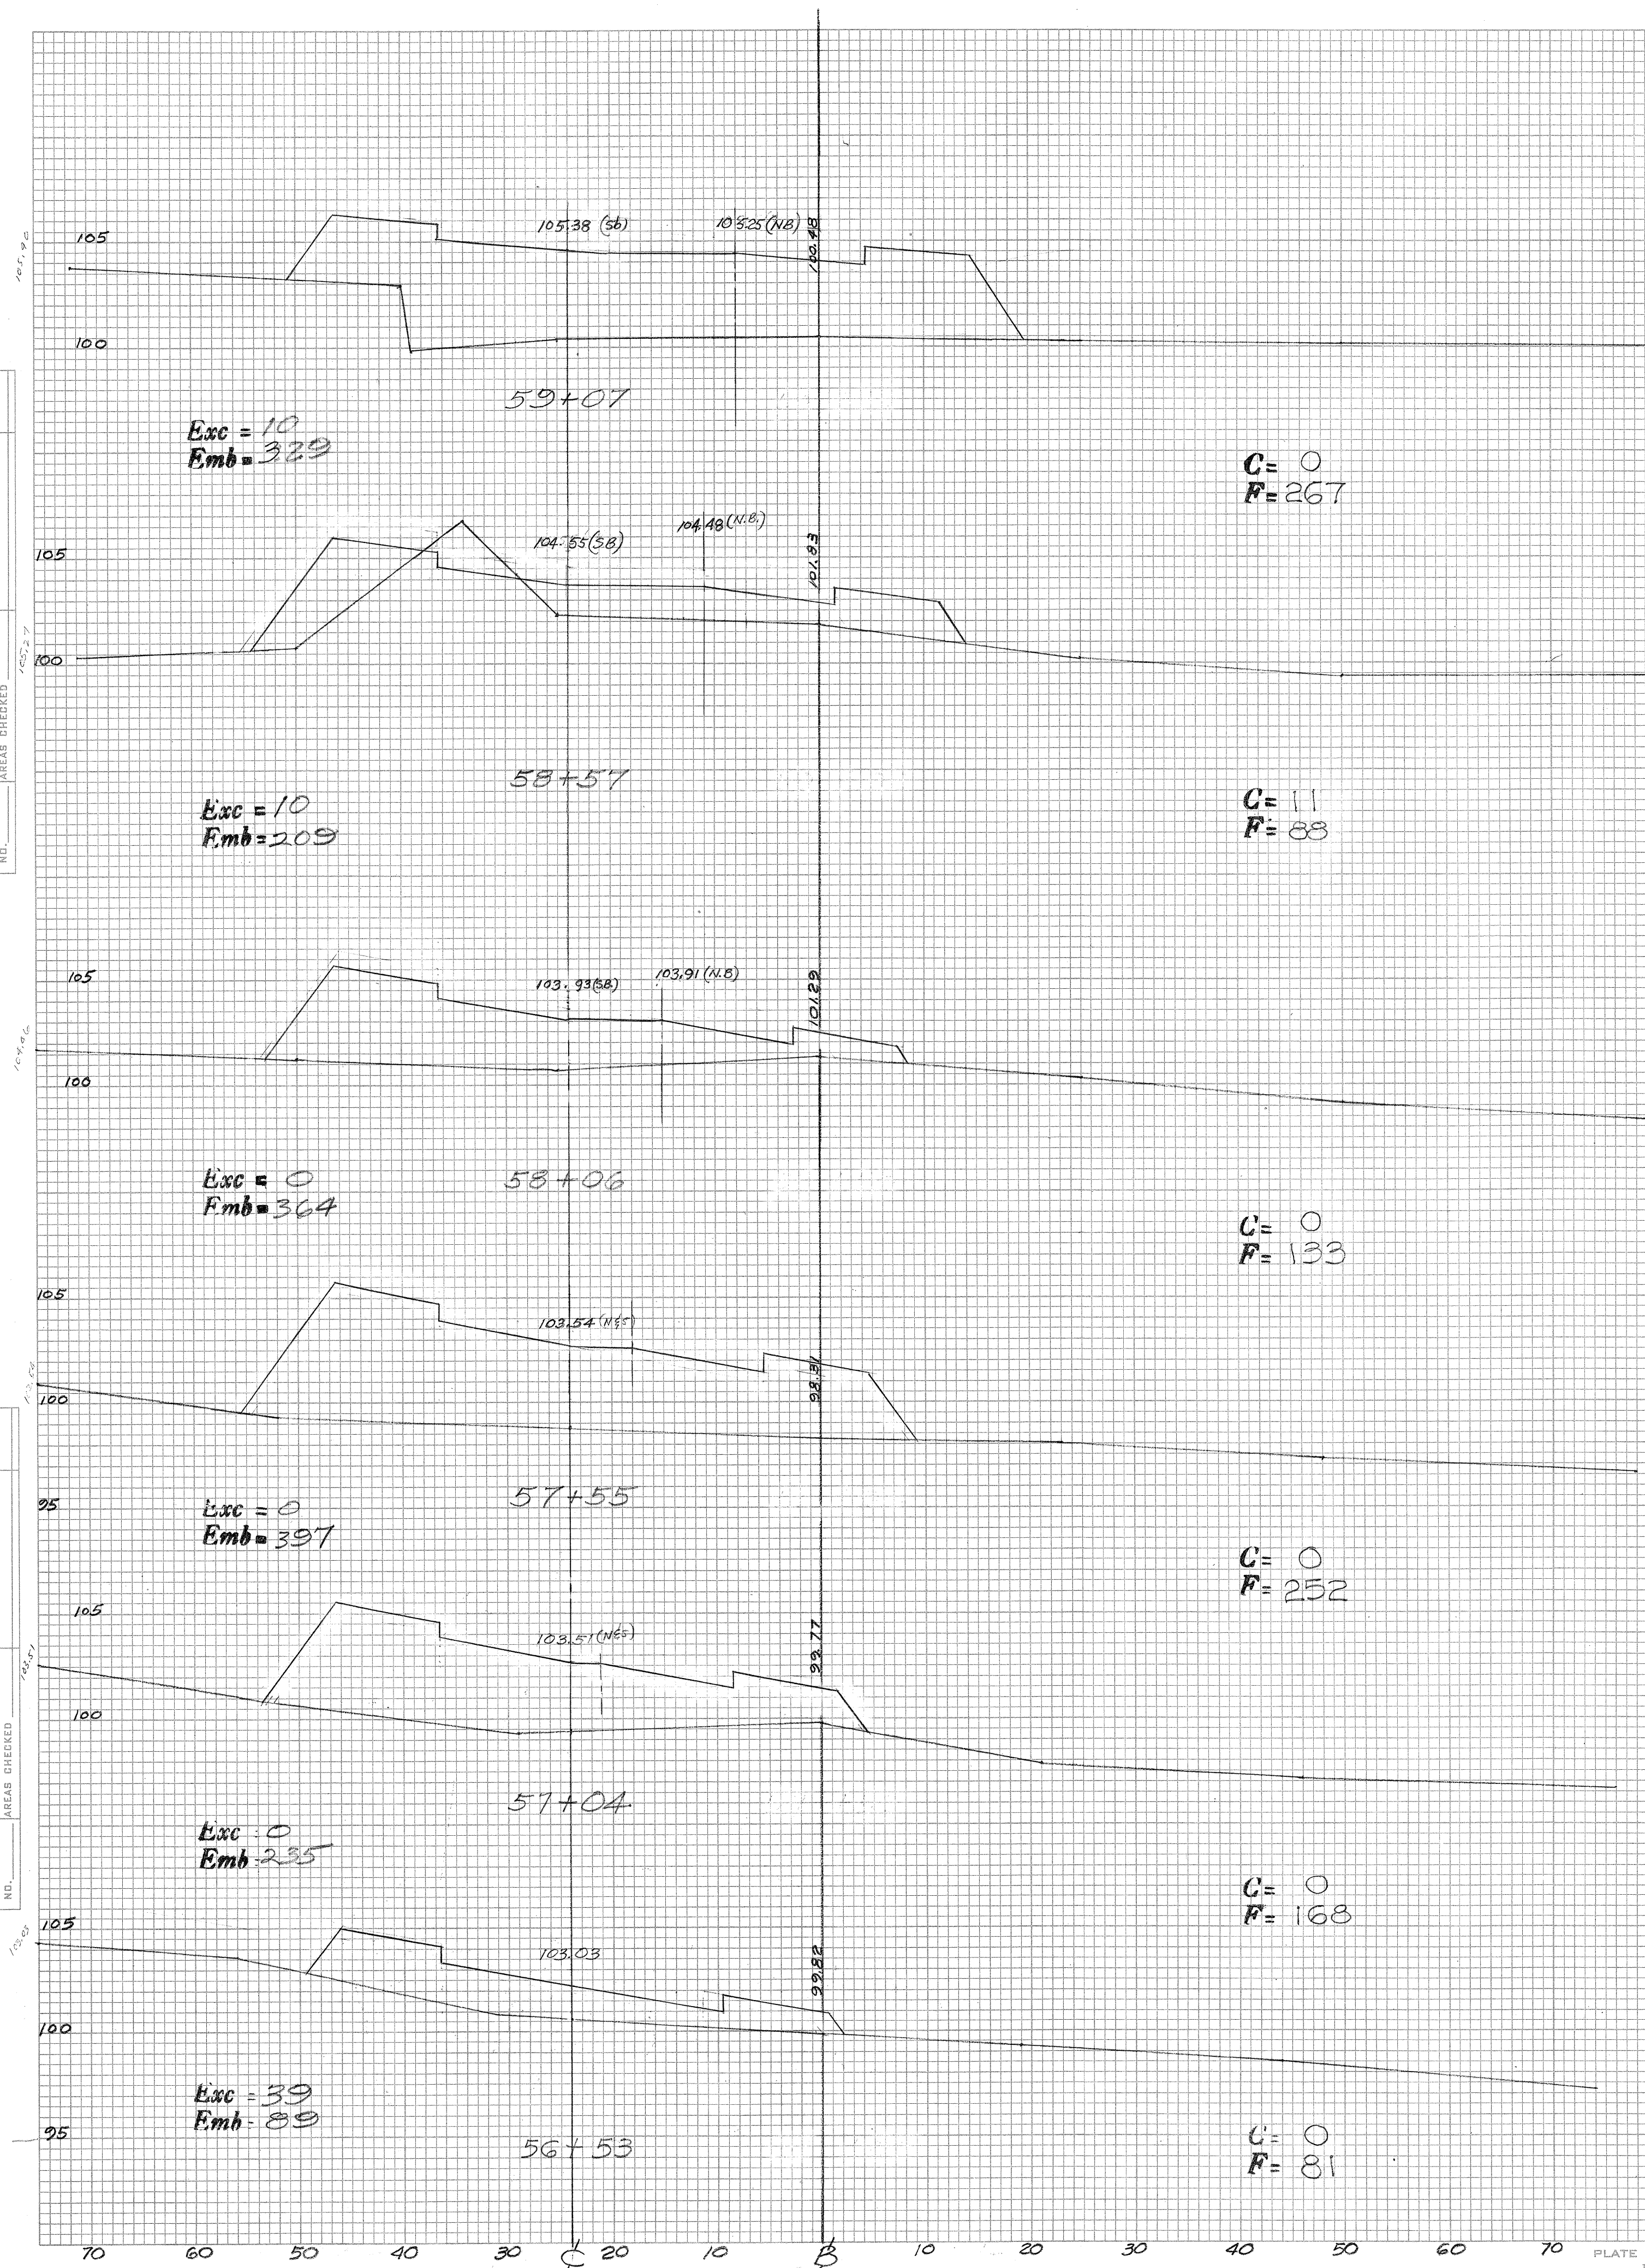


5998.24

FED. ROAD DIST. No.	STATE	FED. AID PROJ. No.	FISCAL YEAR	SHEET No.	TOTAL SHEETS
HAWAII	HAW.	D-AD-12	1958	25	29

DATE	BY	SURVEYED	NOTED	AREA	CHECKED
		BOOK	BOOK		
		NO.	NO.		

DATE	BY	ORIGINAL SURVEY	PLOTTED	NOTED	AREA	CHECKED
		BOOK	BOOK			
		NO.	NO.			

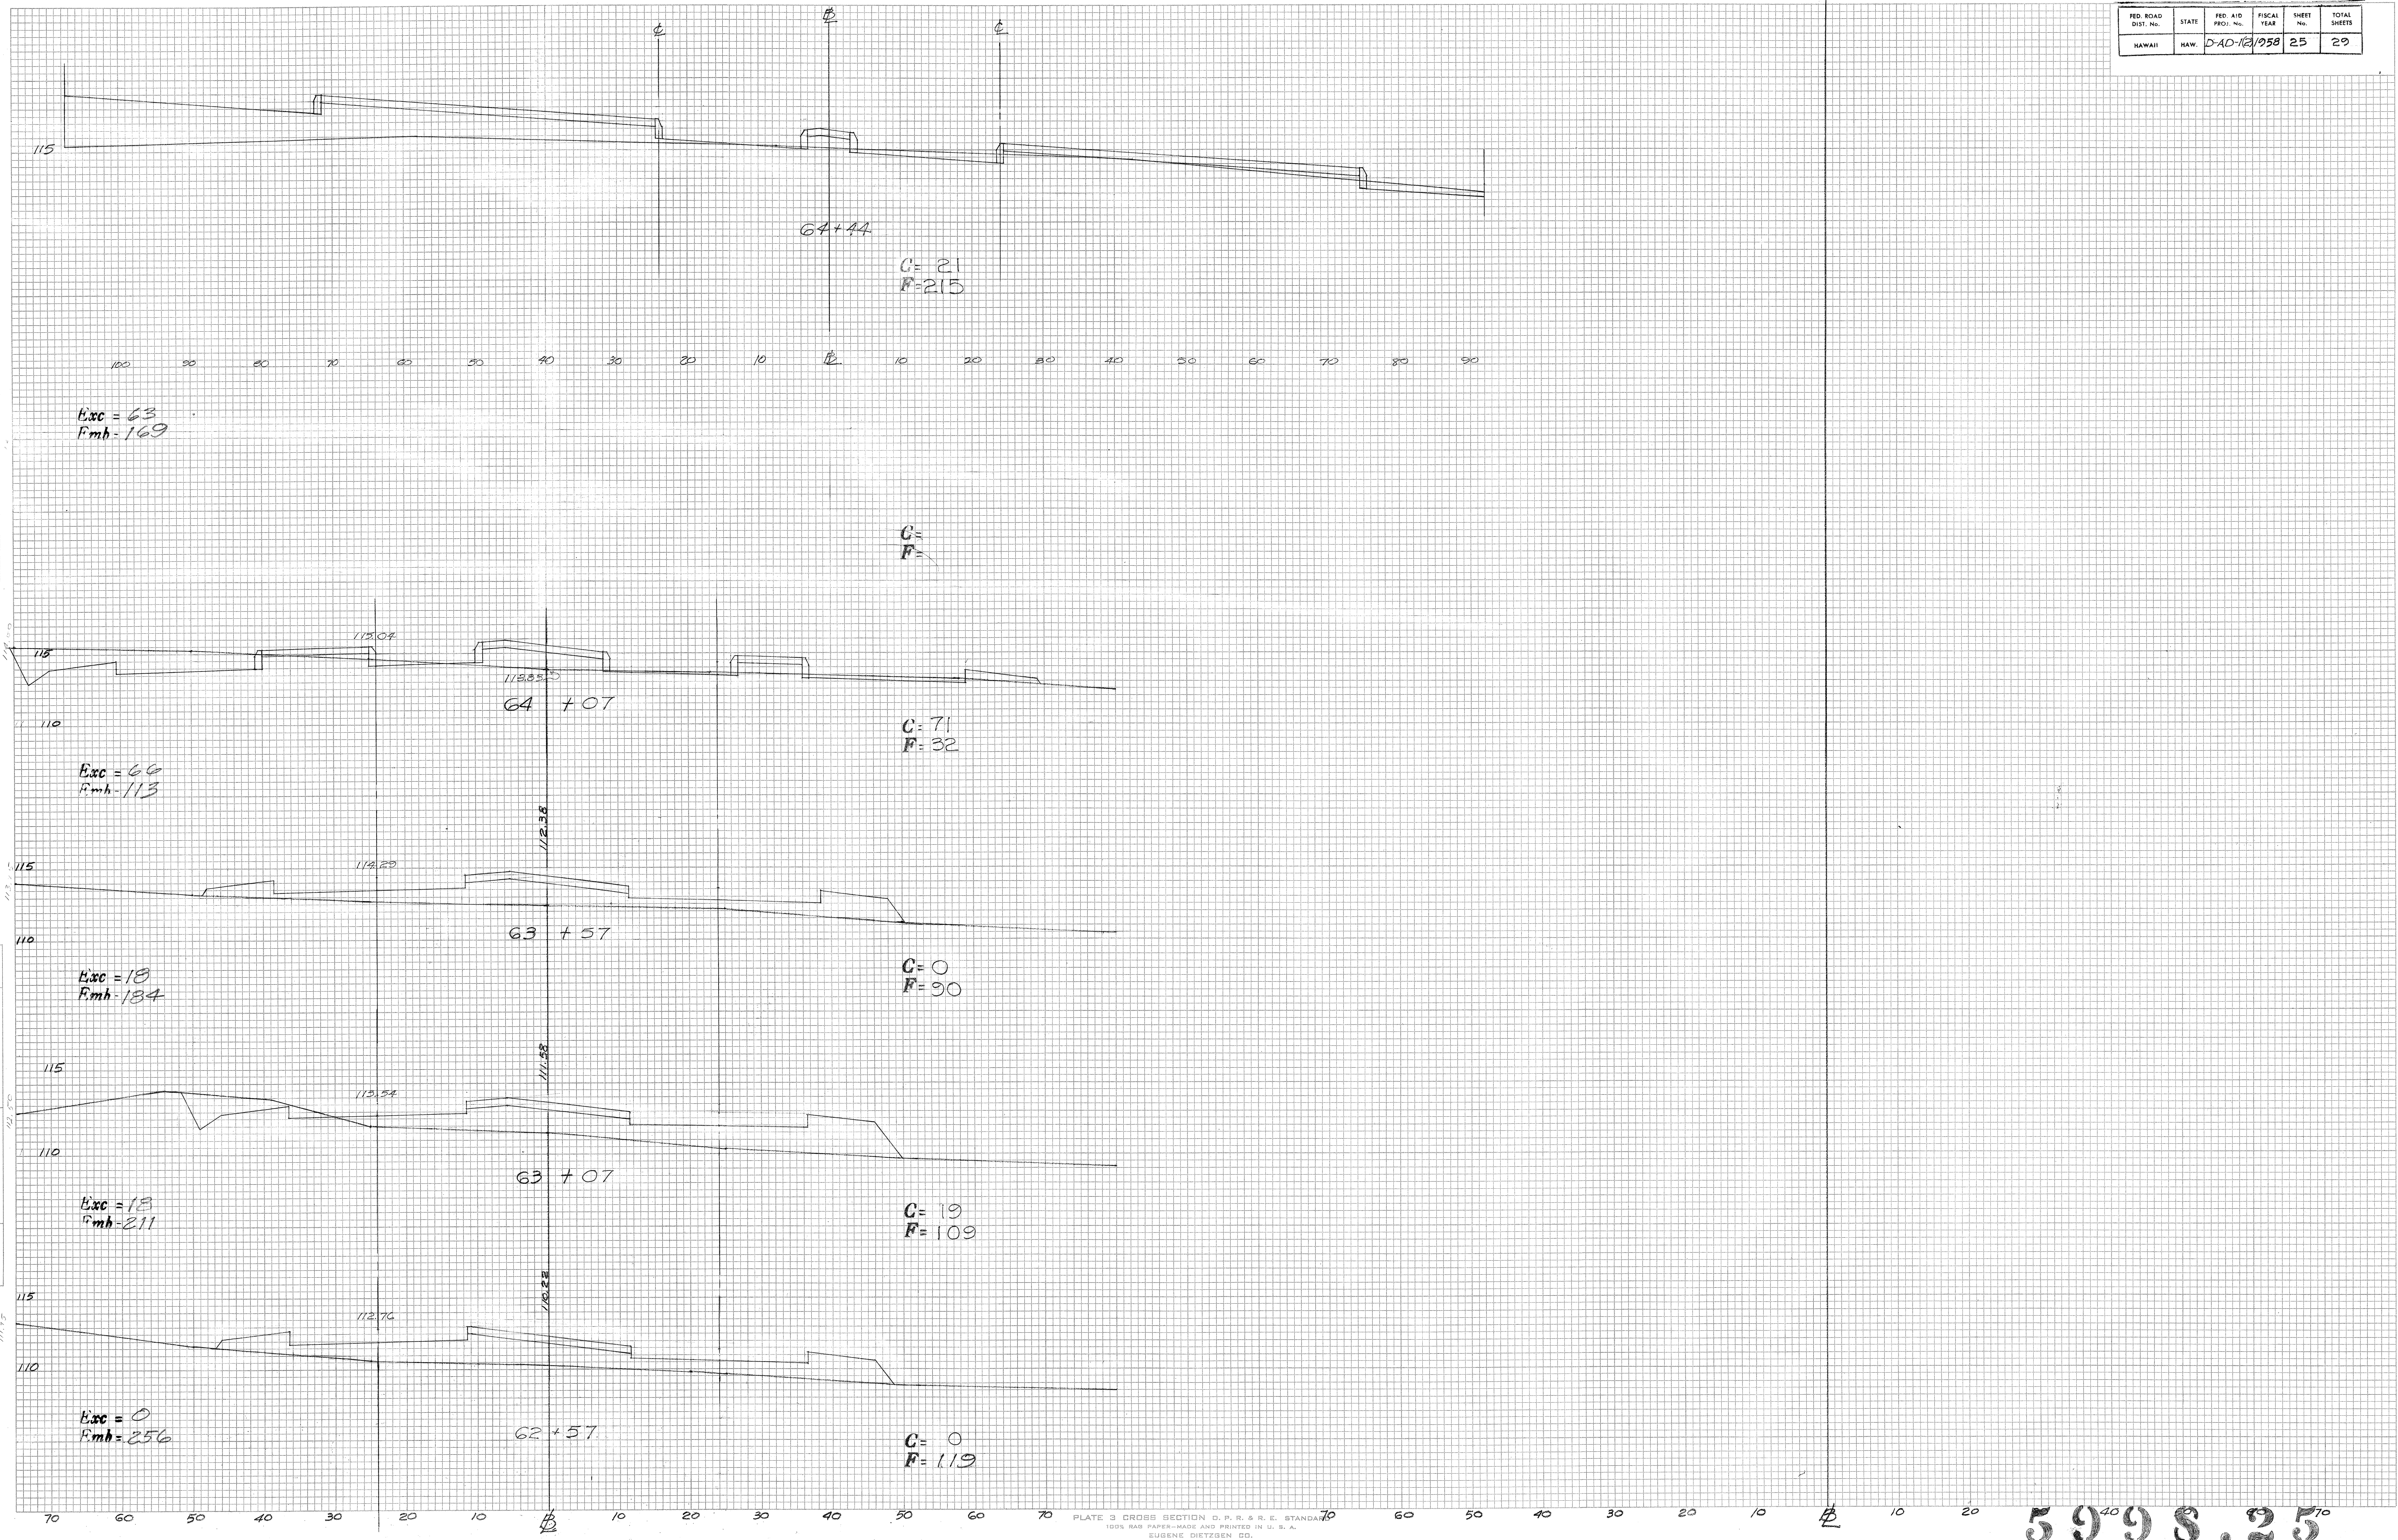

5998.25


Form 14

EXIST 3

FED. ROAD DIST. NO.	STATE	FED. AID PROJ. NO.	FISCAL YEAR	SHEET NO.	TOTAL SHEETS
HAWAII	HAW.	D-AD-12	1958	26	29

FINAL SURVEY	DATE	
	BY	
	SURVEYED	
	NOTE BOOK	
	AREAS CHECKED	

ORIGINAL SURVEY	DATE	
	BY	F.L.
	SURVEYED	
	NOTE BOOK	
	AREAS CHECKED	

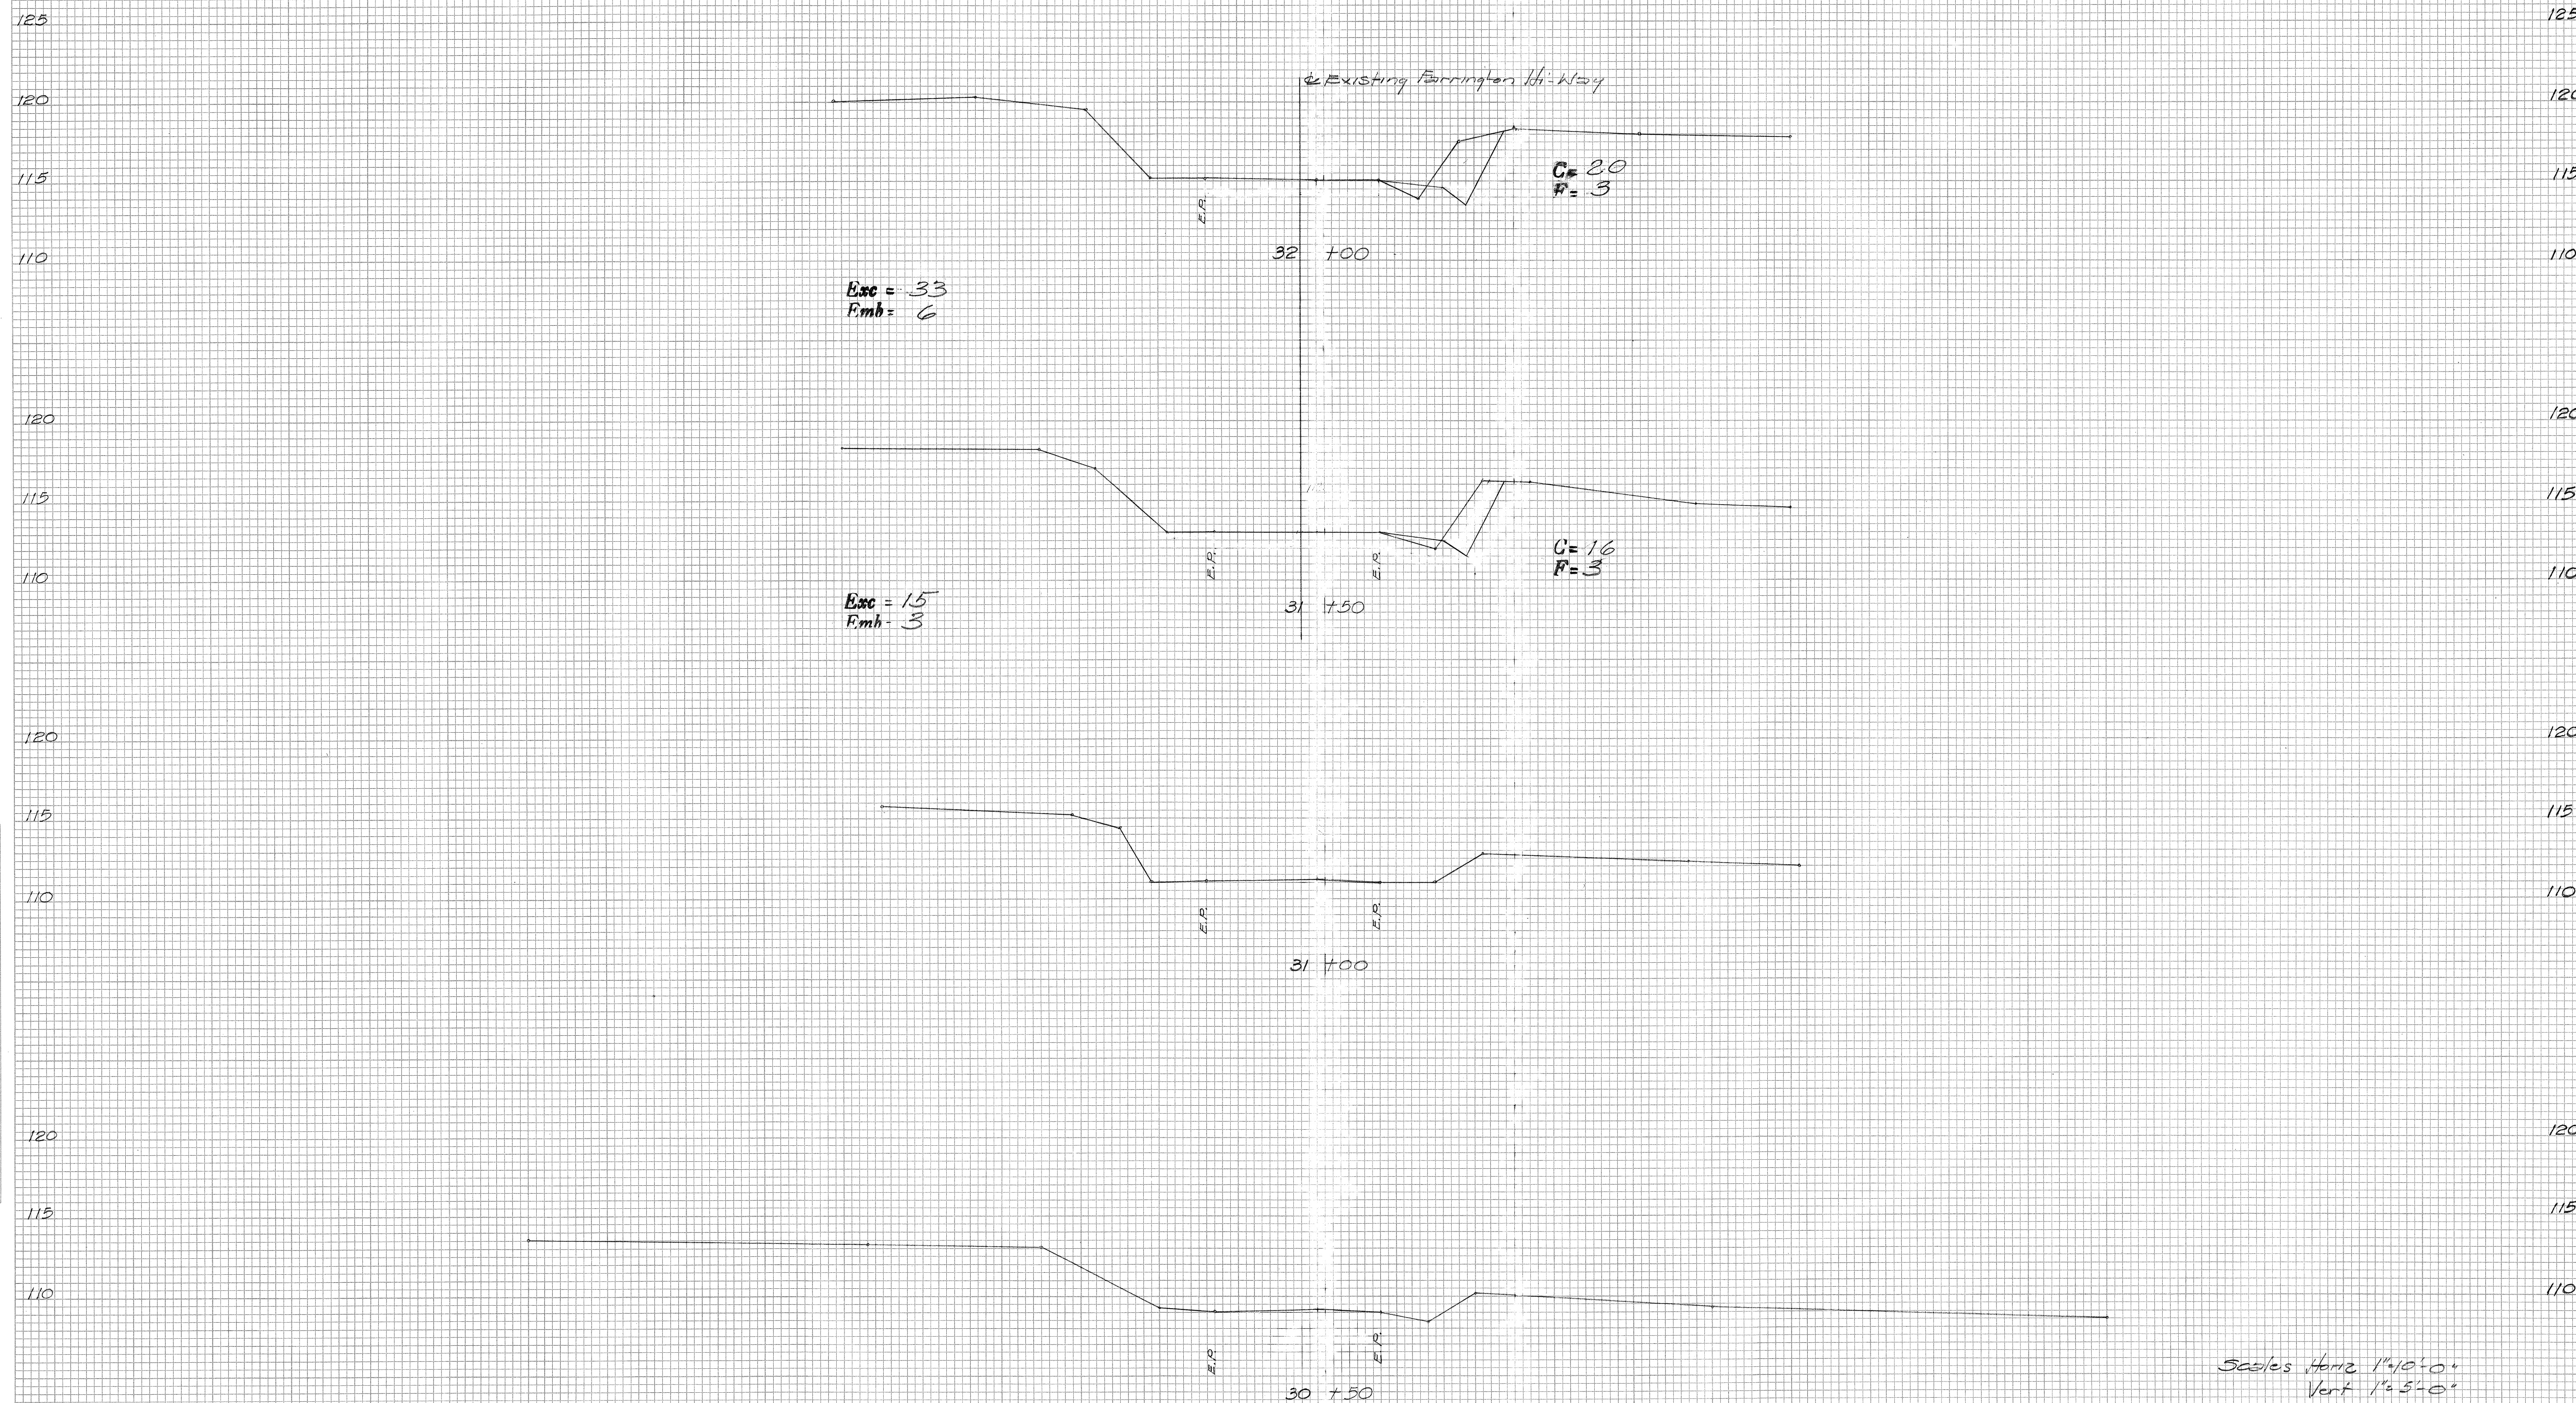



Scales Horiz 1"=10'-0"
Vert 1"=5'-0"

Farrington Highway

5998.26

FINAL SURVEY
NO. _____
DATE _____
BY _____
SURVEYED _____
NOTE BOOK _____
TEMPLATE _____
AREAS _____
CHECKED _____

ORIGINAL SURVEY
NO. _____
DATE _____
BY _____
SURVEYED _____
NOTE BOOK _____
TEMPLATE _____
AREAS _____
CHECKED _____

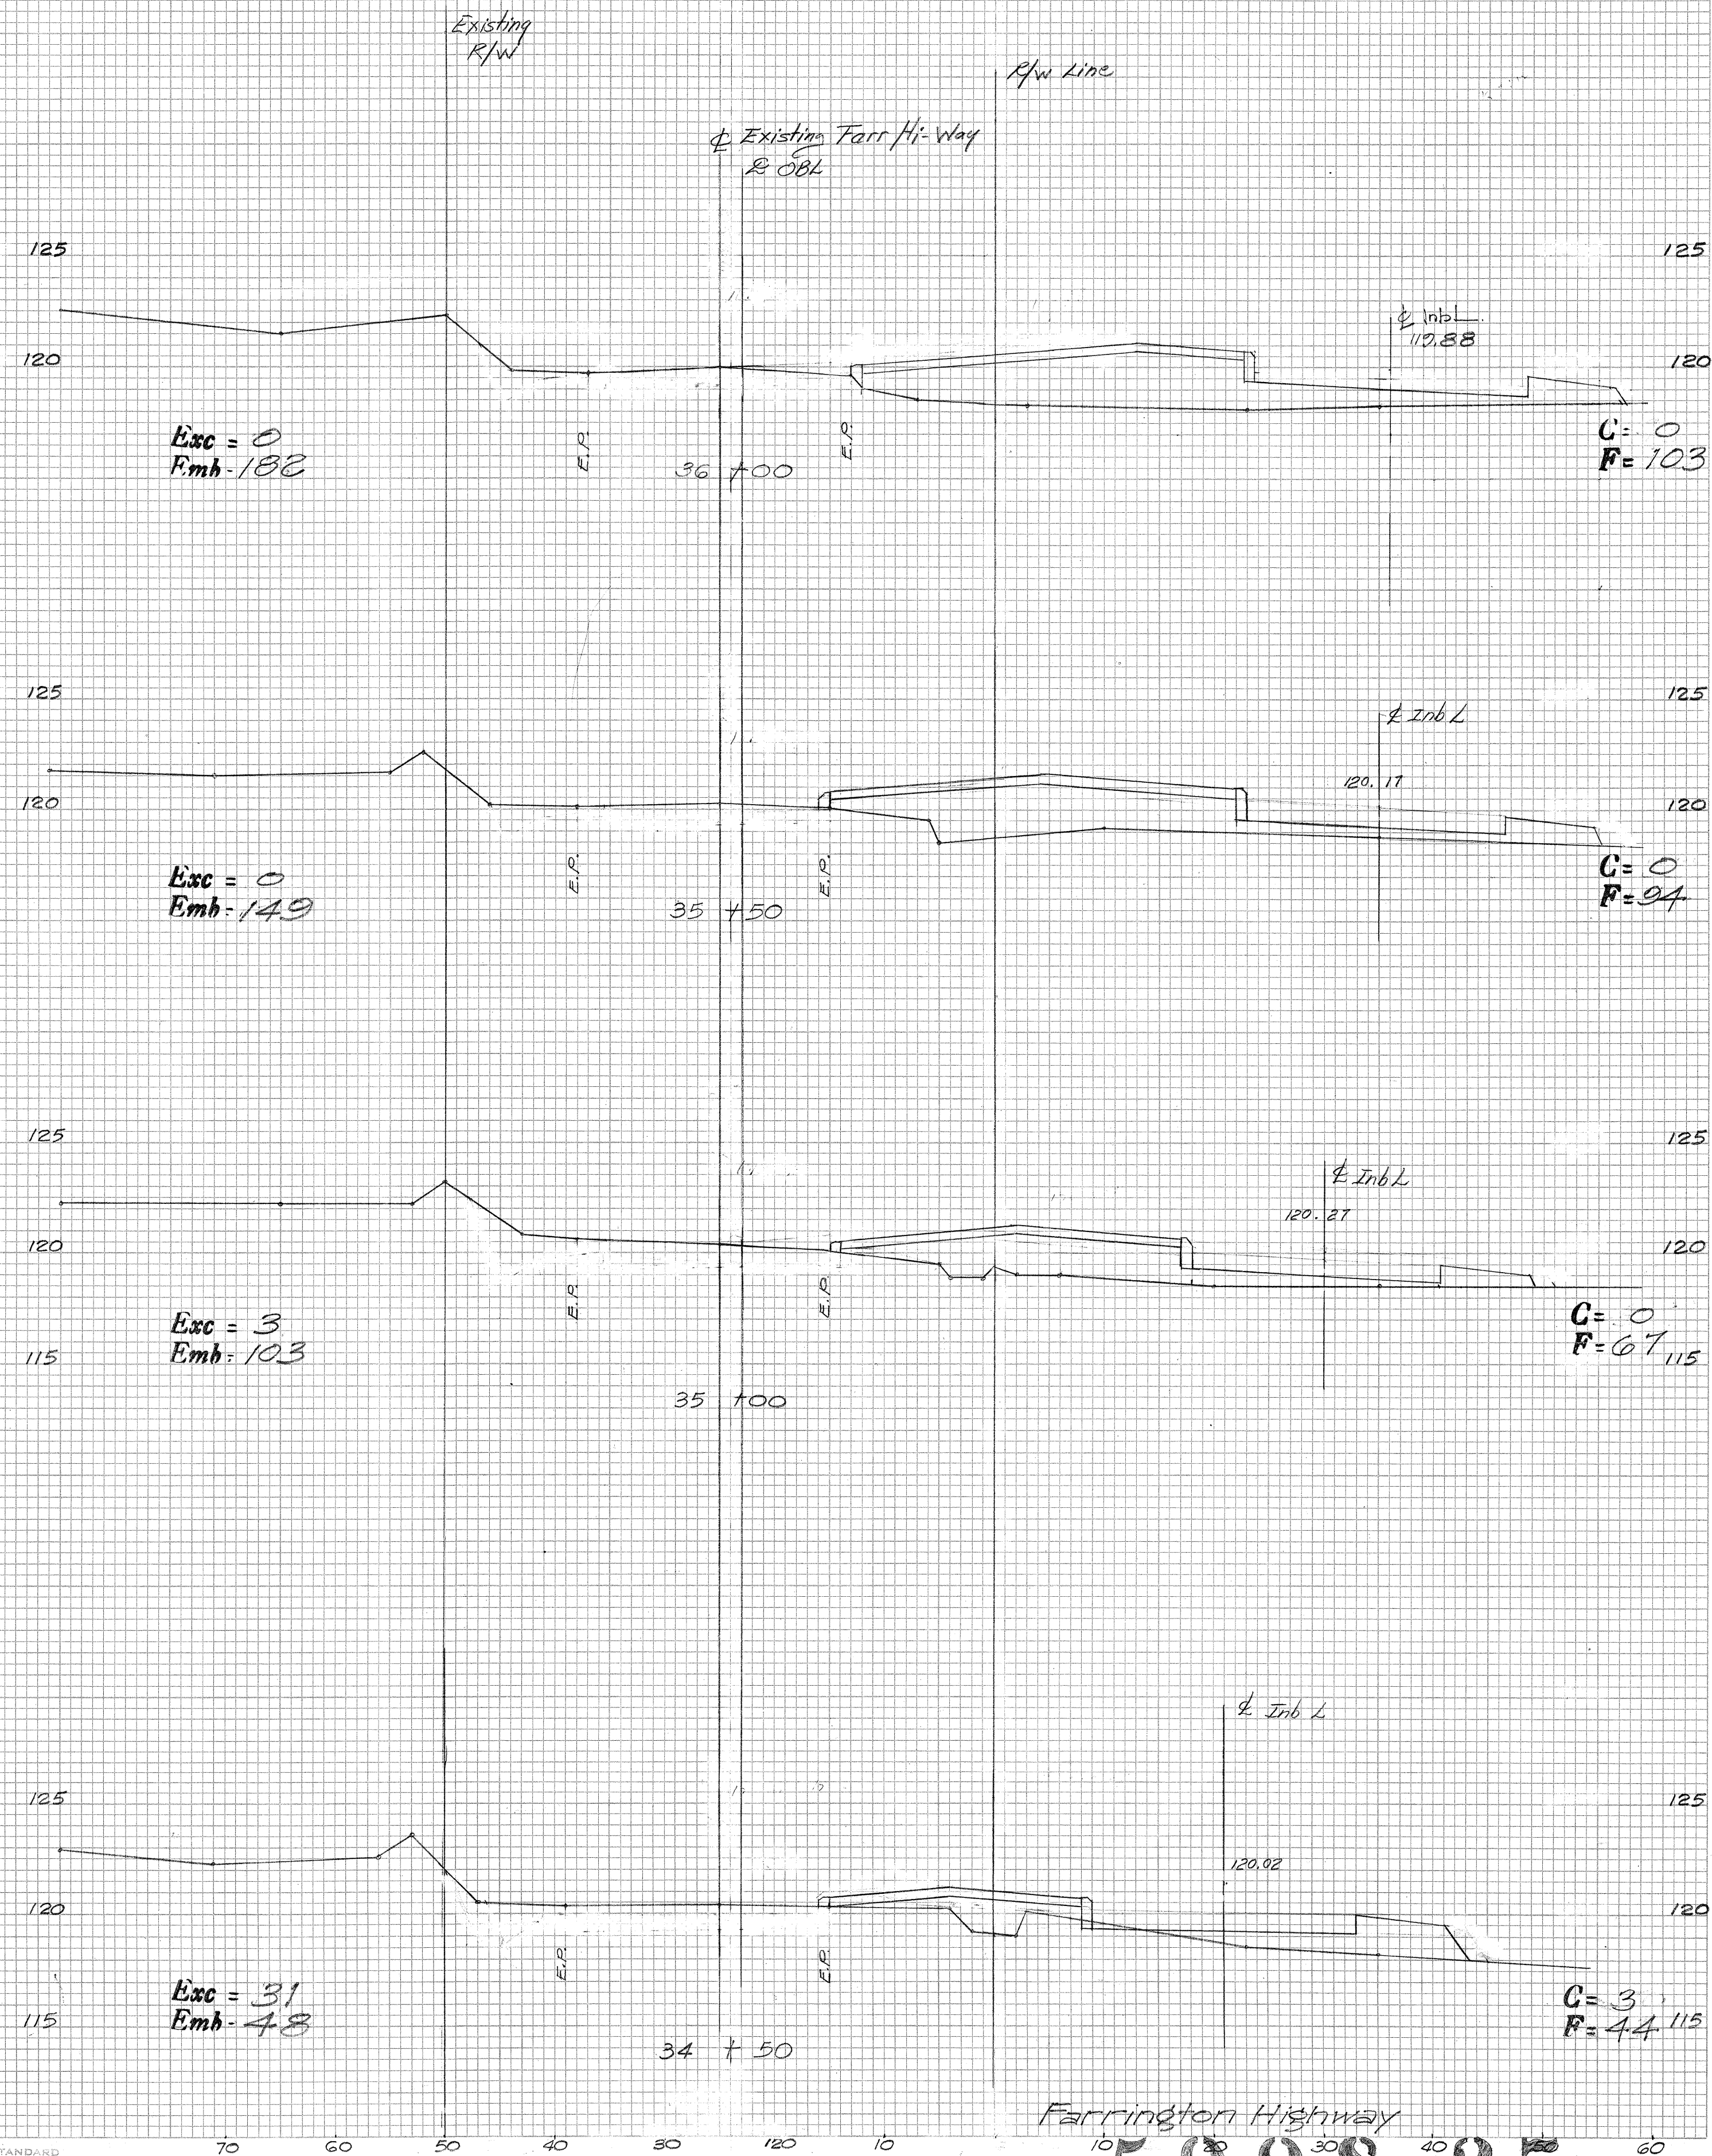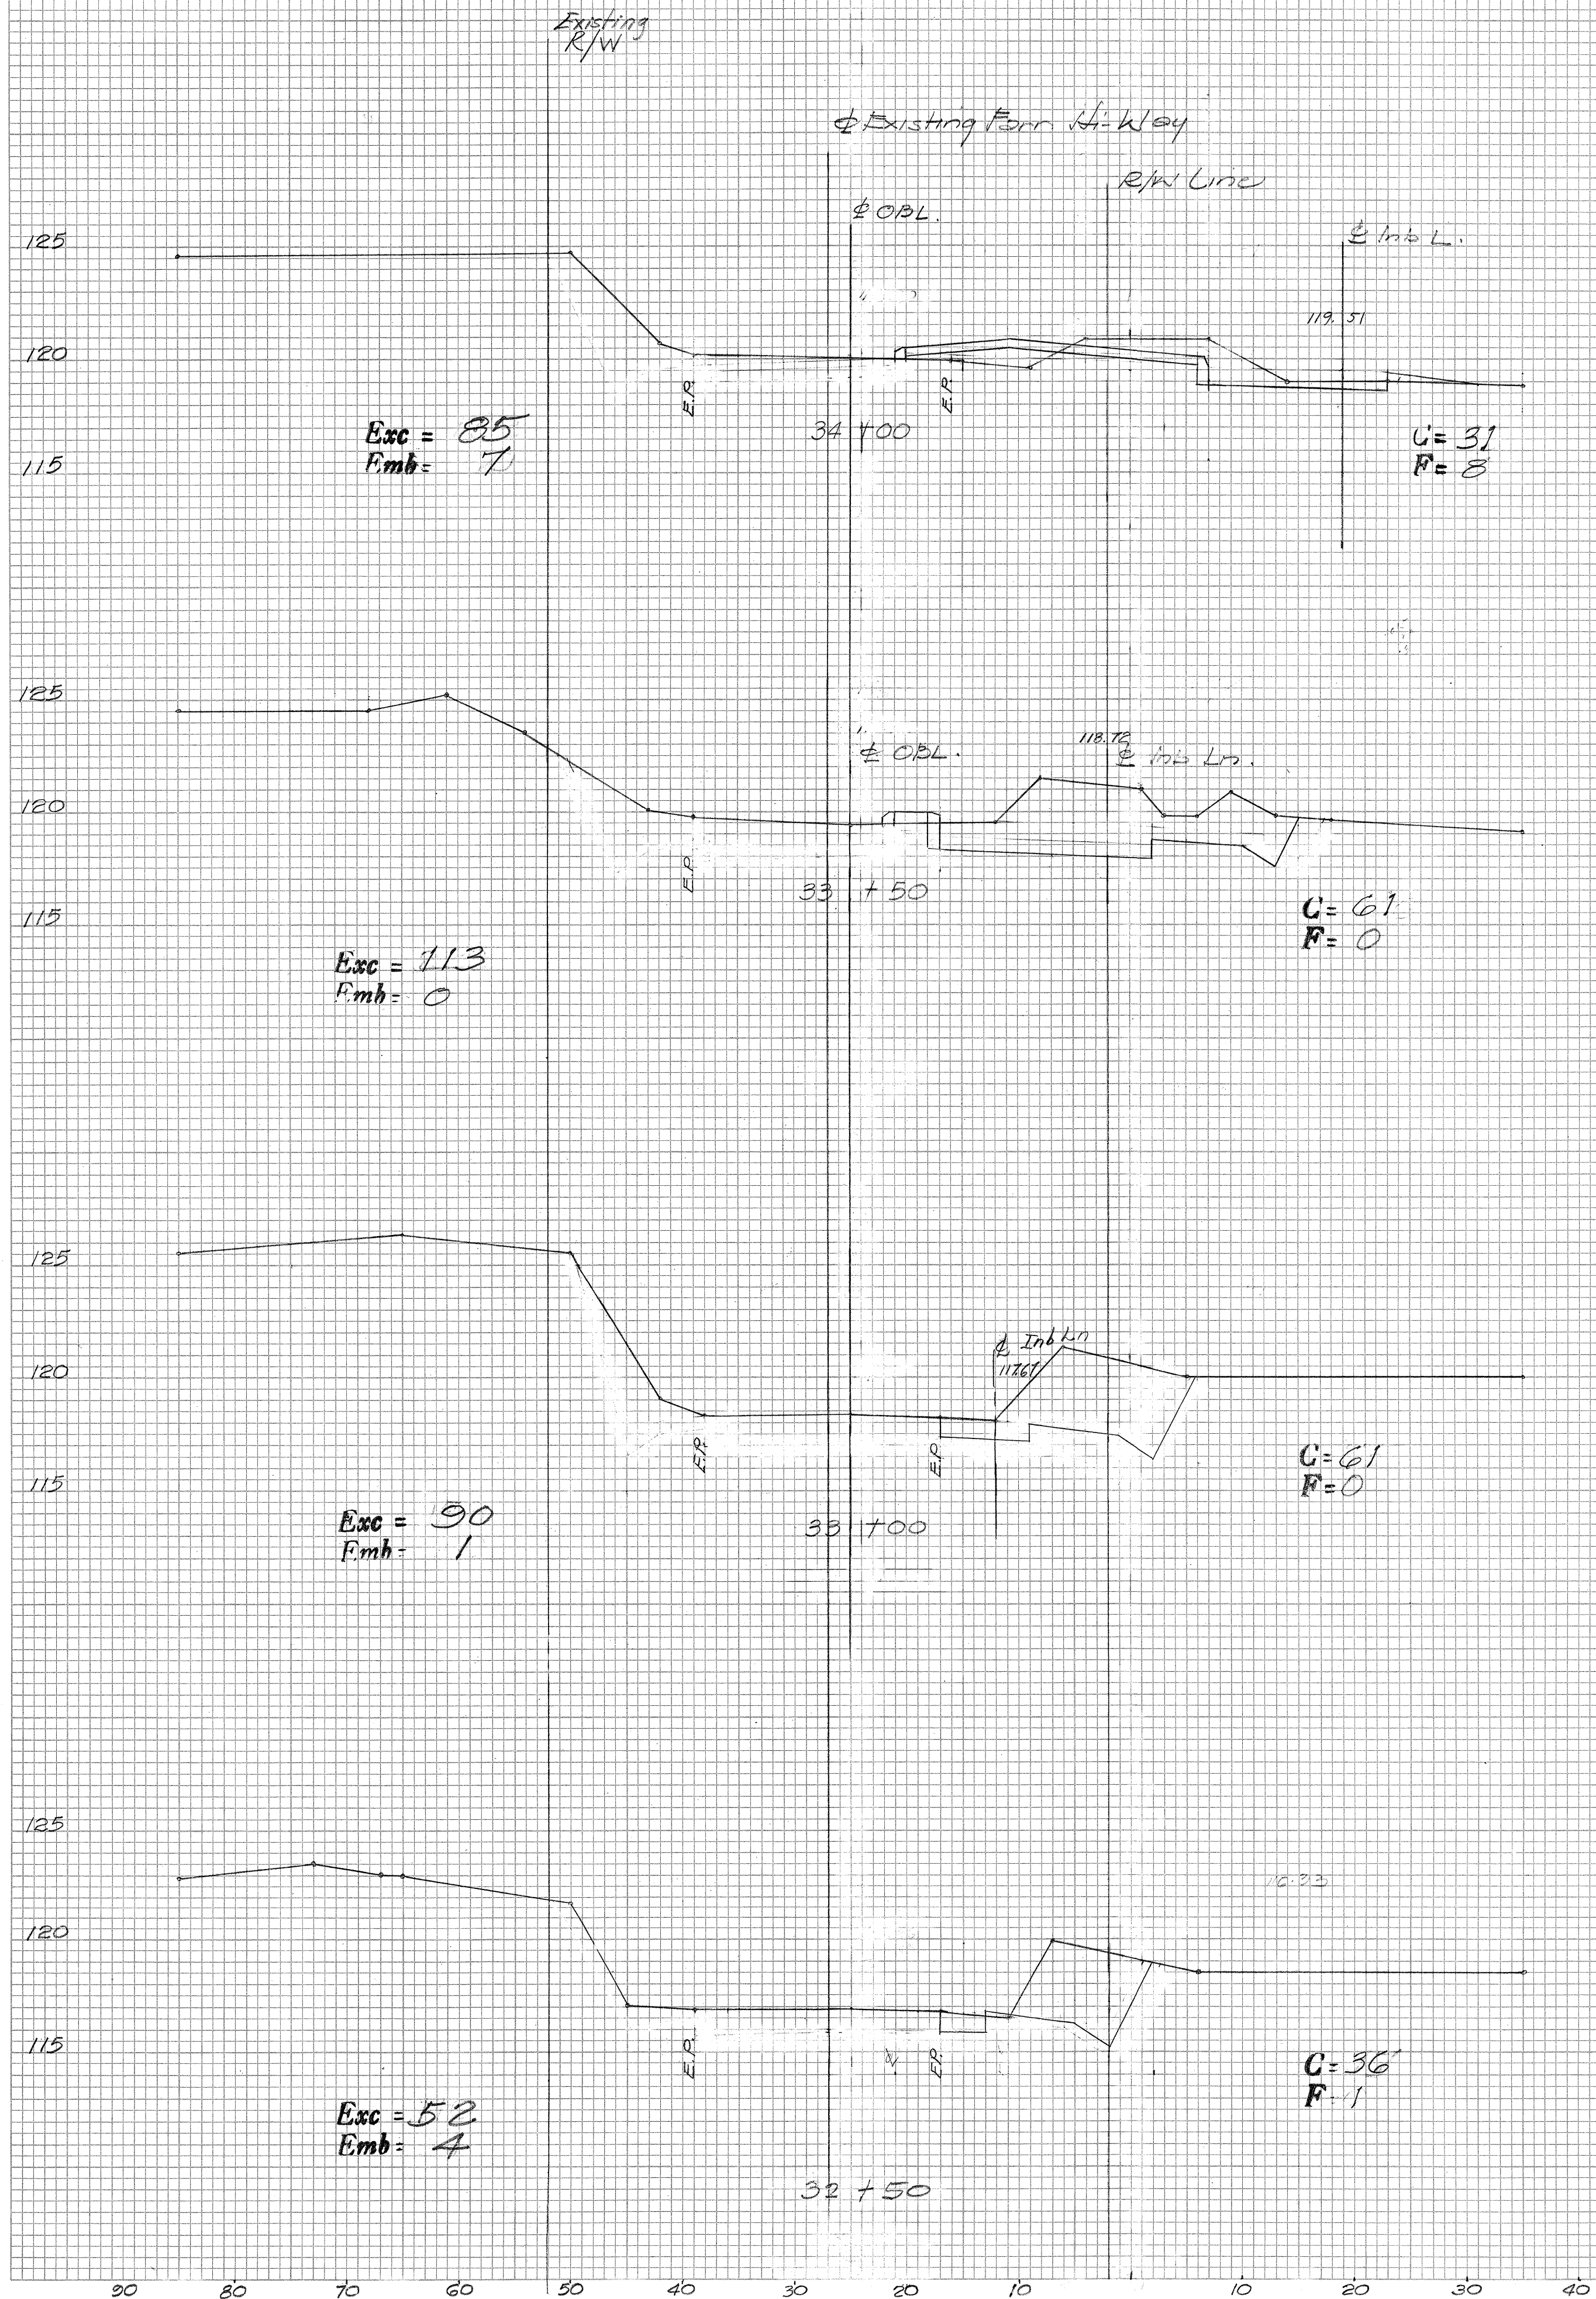


FINAL SURVEY
BY _____
DATE _____
NOTE BOOK _____
NO. _____

ORIGINAL SURVEY
BY _____
DATE _____
NOTE BOOK _____
NO. _____

FED. ROAD DIST. NO.	STATE	FED. AID PROJ. NO.	FISCAL YEAR	SHEET NO.	TOTAL SHEETS
HAWAII	HAW.	AD-1	1958	28	29

EX/ST. FARR.

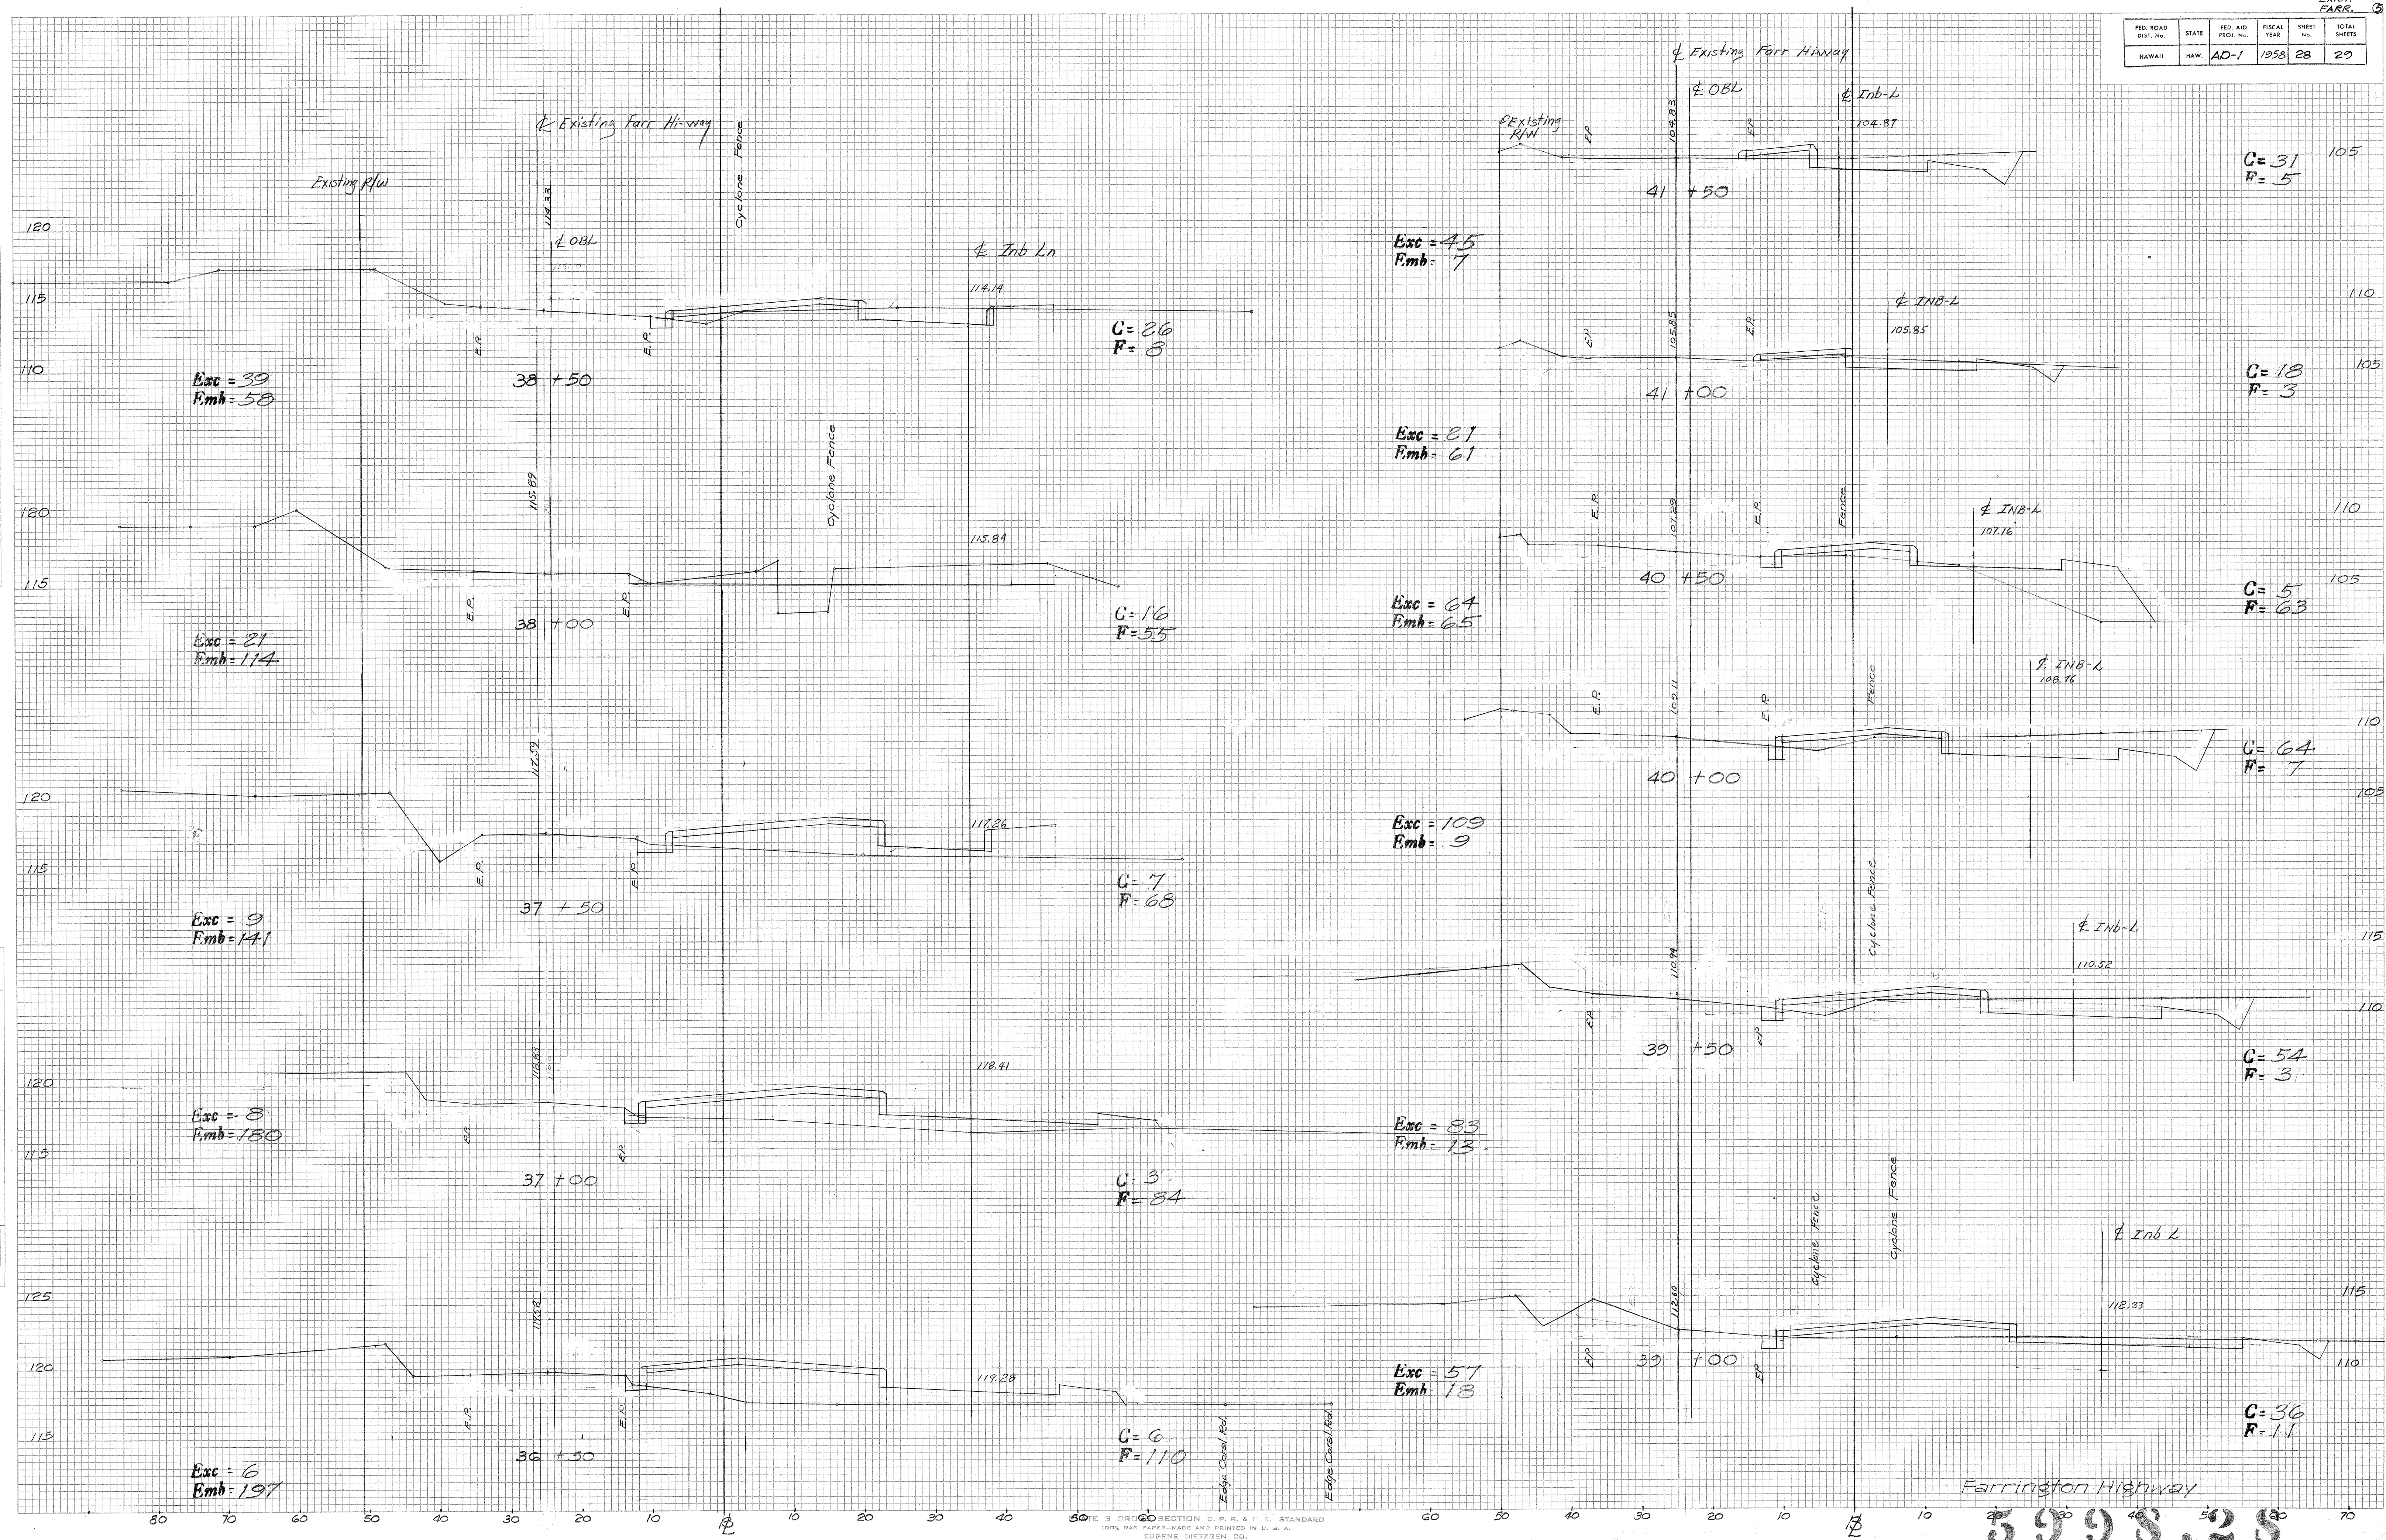

5998.28

FED. ROAD DIST. No.	STATE	FED. AID PROJ. No.	FISCAL YEAR	SHEET No.	TOTAL SHEETS
HAWAII	HAW.	AD-1	1958	29	29

FINAL SURVEY	DATE	BY
SURVEYED		
PLOTTED		
NOTED		
AREAS CHECKED		

ORIGINAL SURVEY	DATE	BY
SURVEYED		
PLOTTED		
NOTED		
AREAS CHECKED		

