

1. B.M. Elevations are referred to Mean Sea Level.
2. Azimuths are referred to Kapehu New A Station
3. Install E Monuments and St Monuments as sketched
4. All utilities shall be relocated by others unless otherwise noted in the plans.
5. Regulatory, Warning, and Destination Signs within the Barbers Pt Reservation shall be installed by others.
6. Irrigation ditches within the R/W shall be relocated outside the R/W as shown on the plans or as directed by the Engineer. For hand-laid riprap existing rocks from ditches to be relocated may be used.
7. Relocation of gates and keys shall be incidental to applicable items.
8. Construction of connections to existing ditches shall conform to existing connections wherever practicable in width and depth of ditches. All excavation for construction of ditches and connections shall be paid for as ditch and channel excavation unless otherwise noted.



Boundary Fence in way of construction shall be removed and stockpiled as directed by the Engr.

± EAST & WEST LANES. CURVE DATA


$\Delta = 21^{\circ}30'$
 $D = 14^{\circ}$
 $R = 409.25'$
 $T = 77.70'$
 $L_c = 153.57'$
 ~~$S.E. = 0.1$ per ft.~~

Right-of-Way Symbols

No vehicular access permitted
Vehicular access permitted

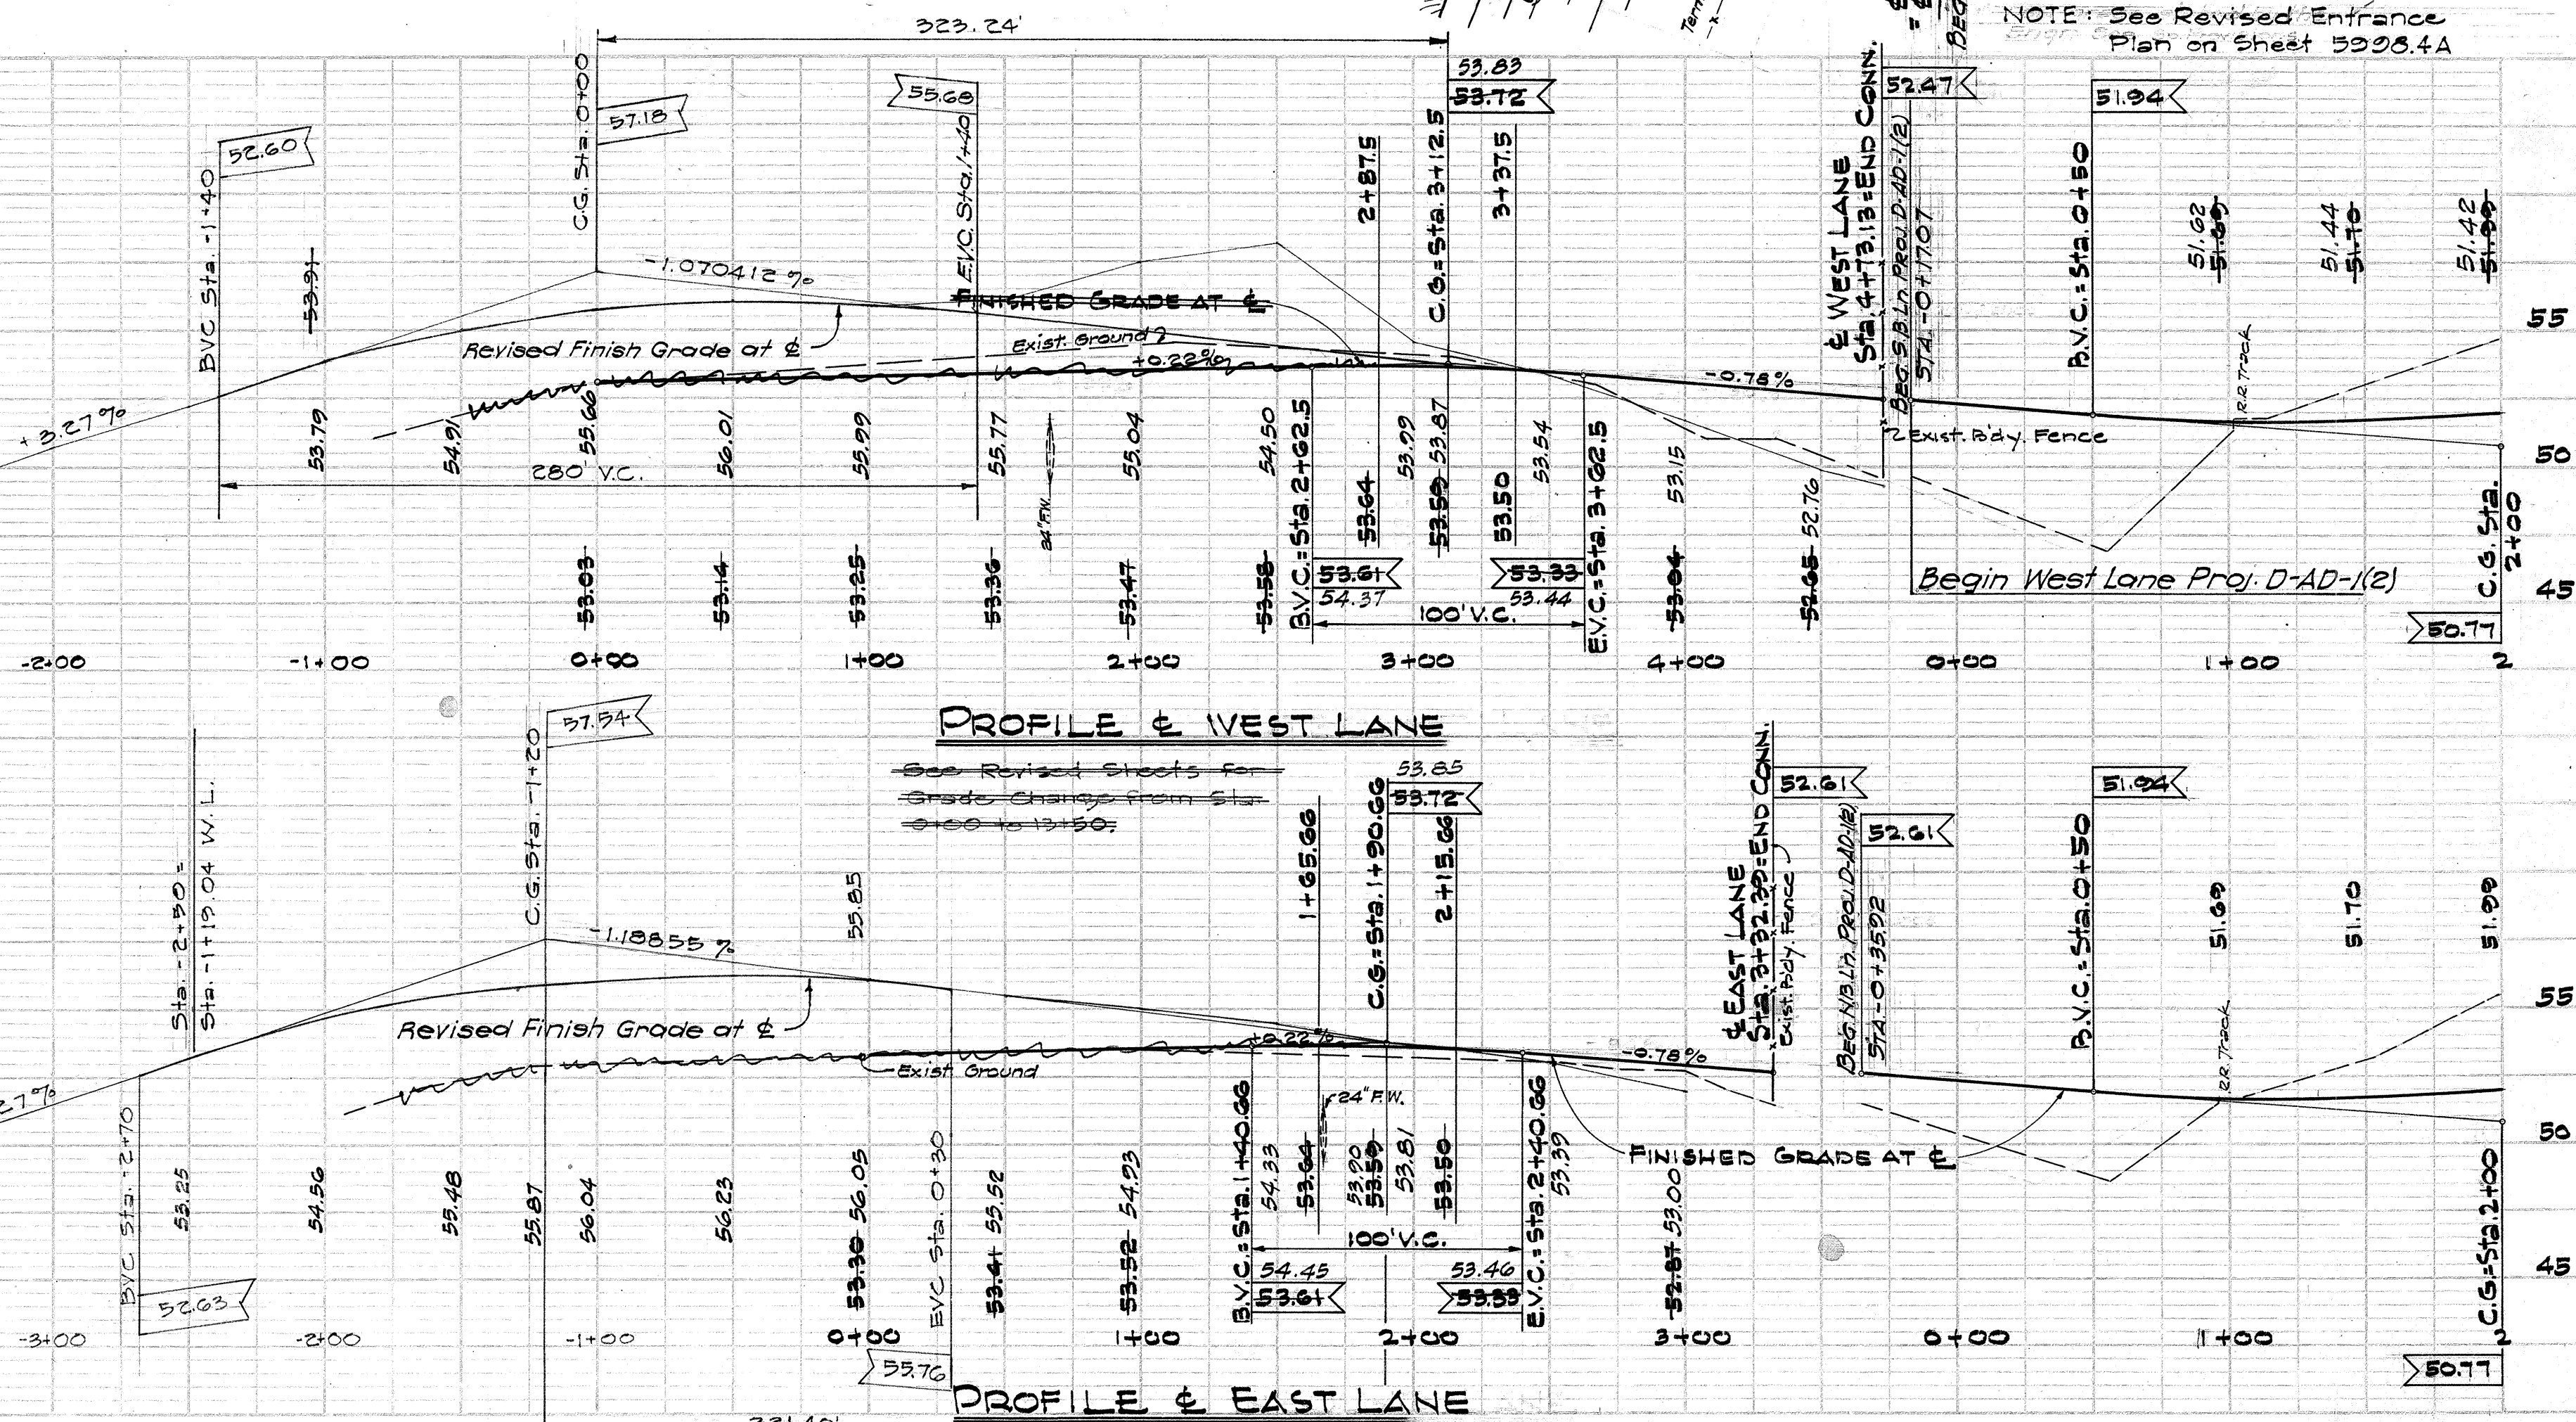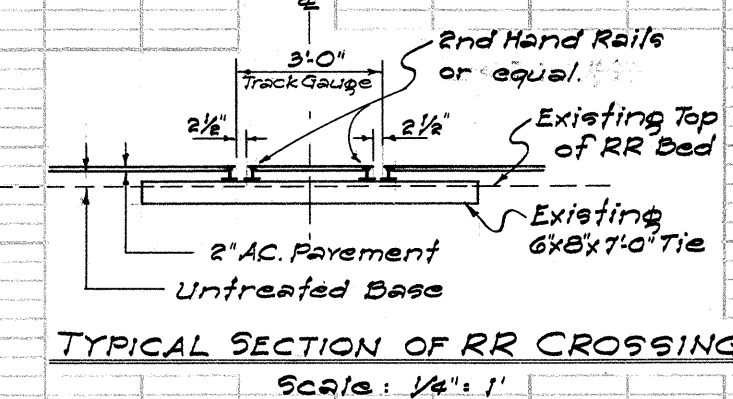

ORIGINAL PLAN	SURVEY PLOTTED BY _____	DATE _____
	DESIGNED BY _____	"
	TRACED BY _____	"
NOTE BOOK	QUANTITIES BY _____	"
No.	QUANTITIES CHECKED BY _____	"
	CHECKED BY _____	"

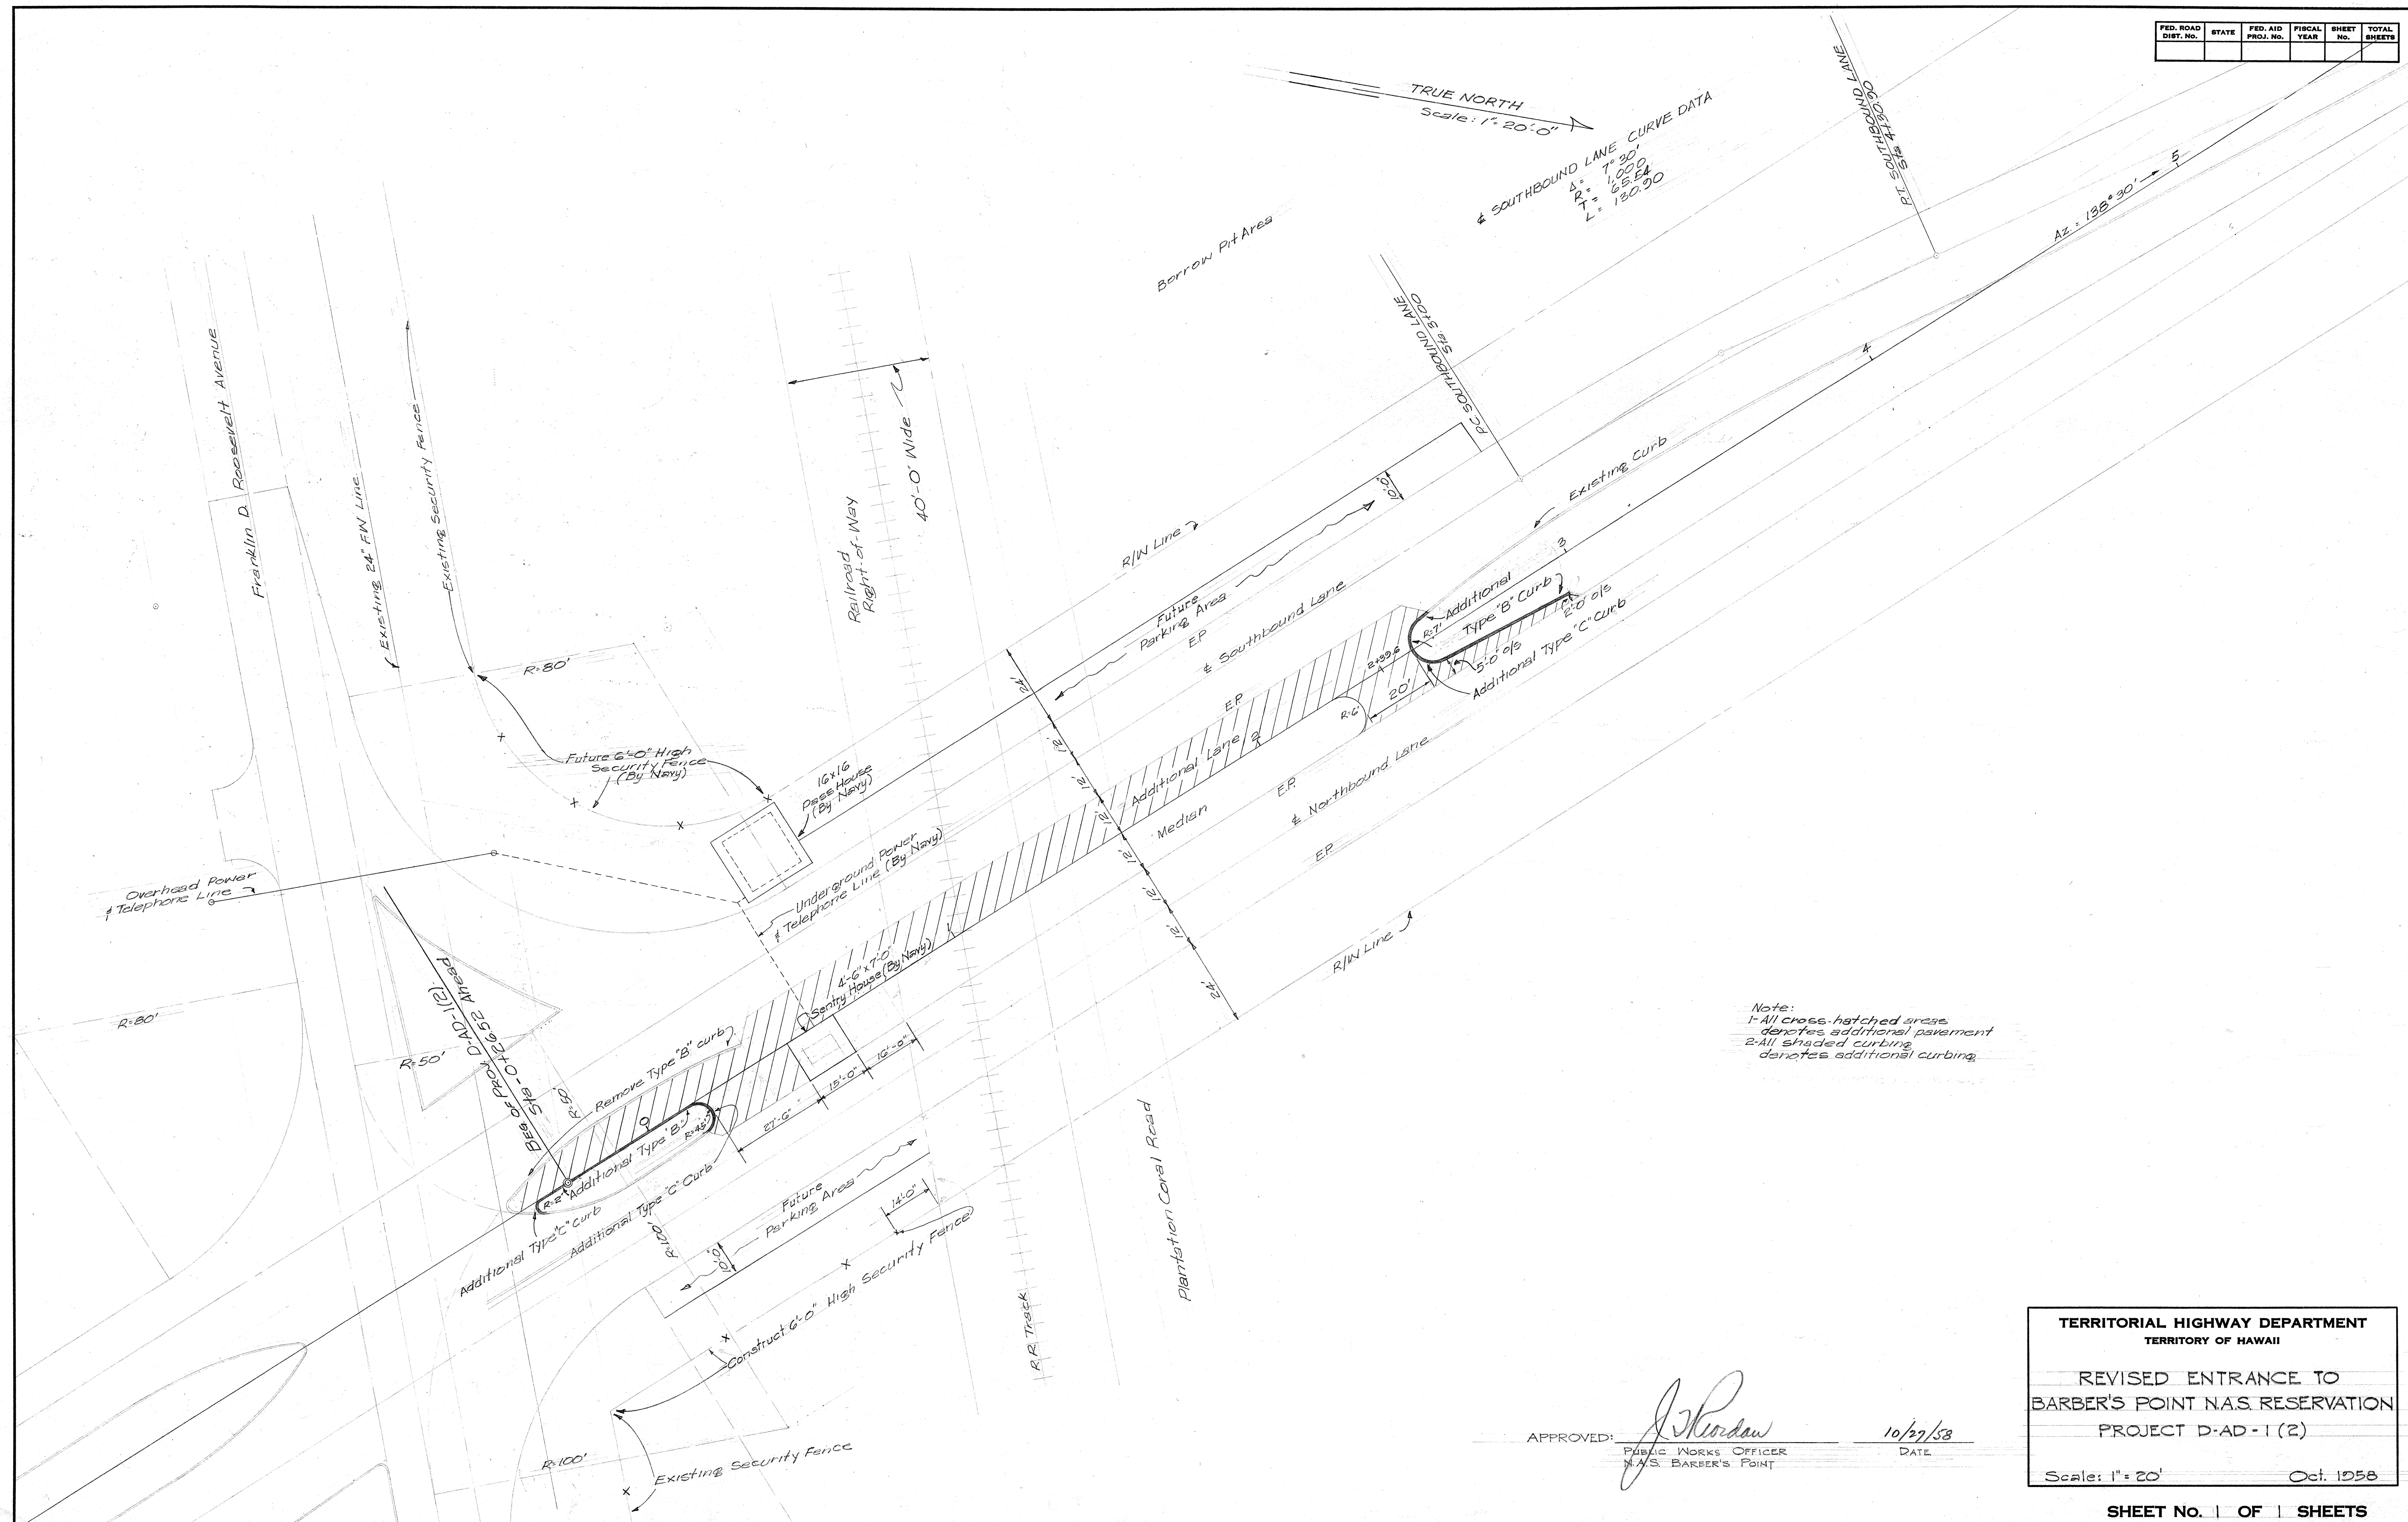

APPROVED: J. J. Rordan 10/27/58
PUBLIC WORKS OFFICER
N.A.S. BARBER'S POINT DATE

10/27/58
DATE

TERRITORIAL HIGHWAY DEPARTMENT
TERRITORY OF HAWAII



REVISED ENTRANCE TO
BARBER'S POINT N.A.S. RESERVATION
PROJECT D-AD-1 (2)

Scale: 1" = 20' Oct. 1958

SHEET No. 1 OF 1 SHEETS

5998.4A





PLAN	SURVEYED	BY	DATE
NOTE BOOK	PLOTTED	DRAWN S.N.	
NO. _____	ALIGNMENT CHECKED	TRACED G.N.	
	RT. OF WAY CHECKED		

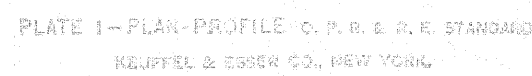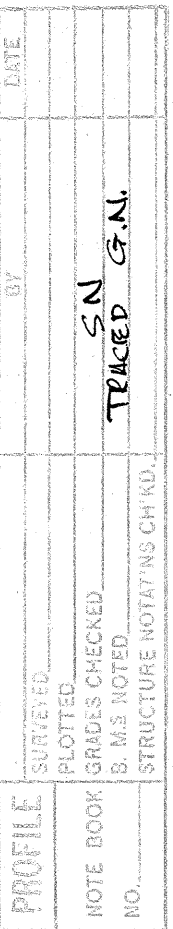

PLAN	DATE	BY	CHKD	DATE	BY
SUBMITTED					
PLOTTED					
NOTE BOOK					
RT. OF WAY CHECKED					
NO.					

PROFILE	DATE	BY	CHKD	DATE	BY
SUBMITTED					
PLOTTED					
NOTE BOOK					
STRUCTURE NOTATIONS (P.F.D.)					
NO.					

FED. ROAD DIST. NO.	STATE	FED. AID PROJ. NO.	FISCAL YEAR	SHEET NO.	TOTAL SHEETS
HAWAII	HAW.	D-AD-102	1958	G	20

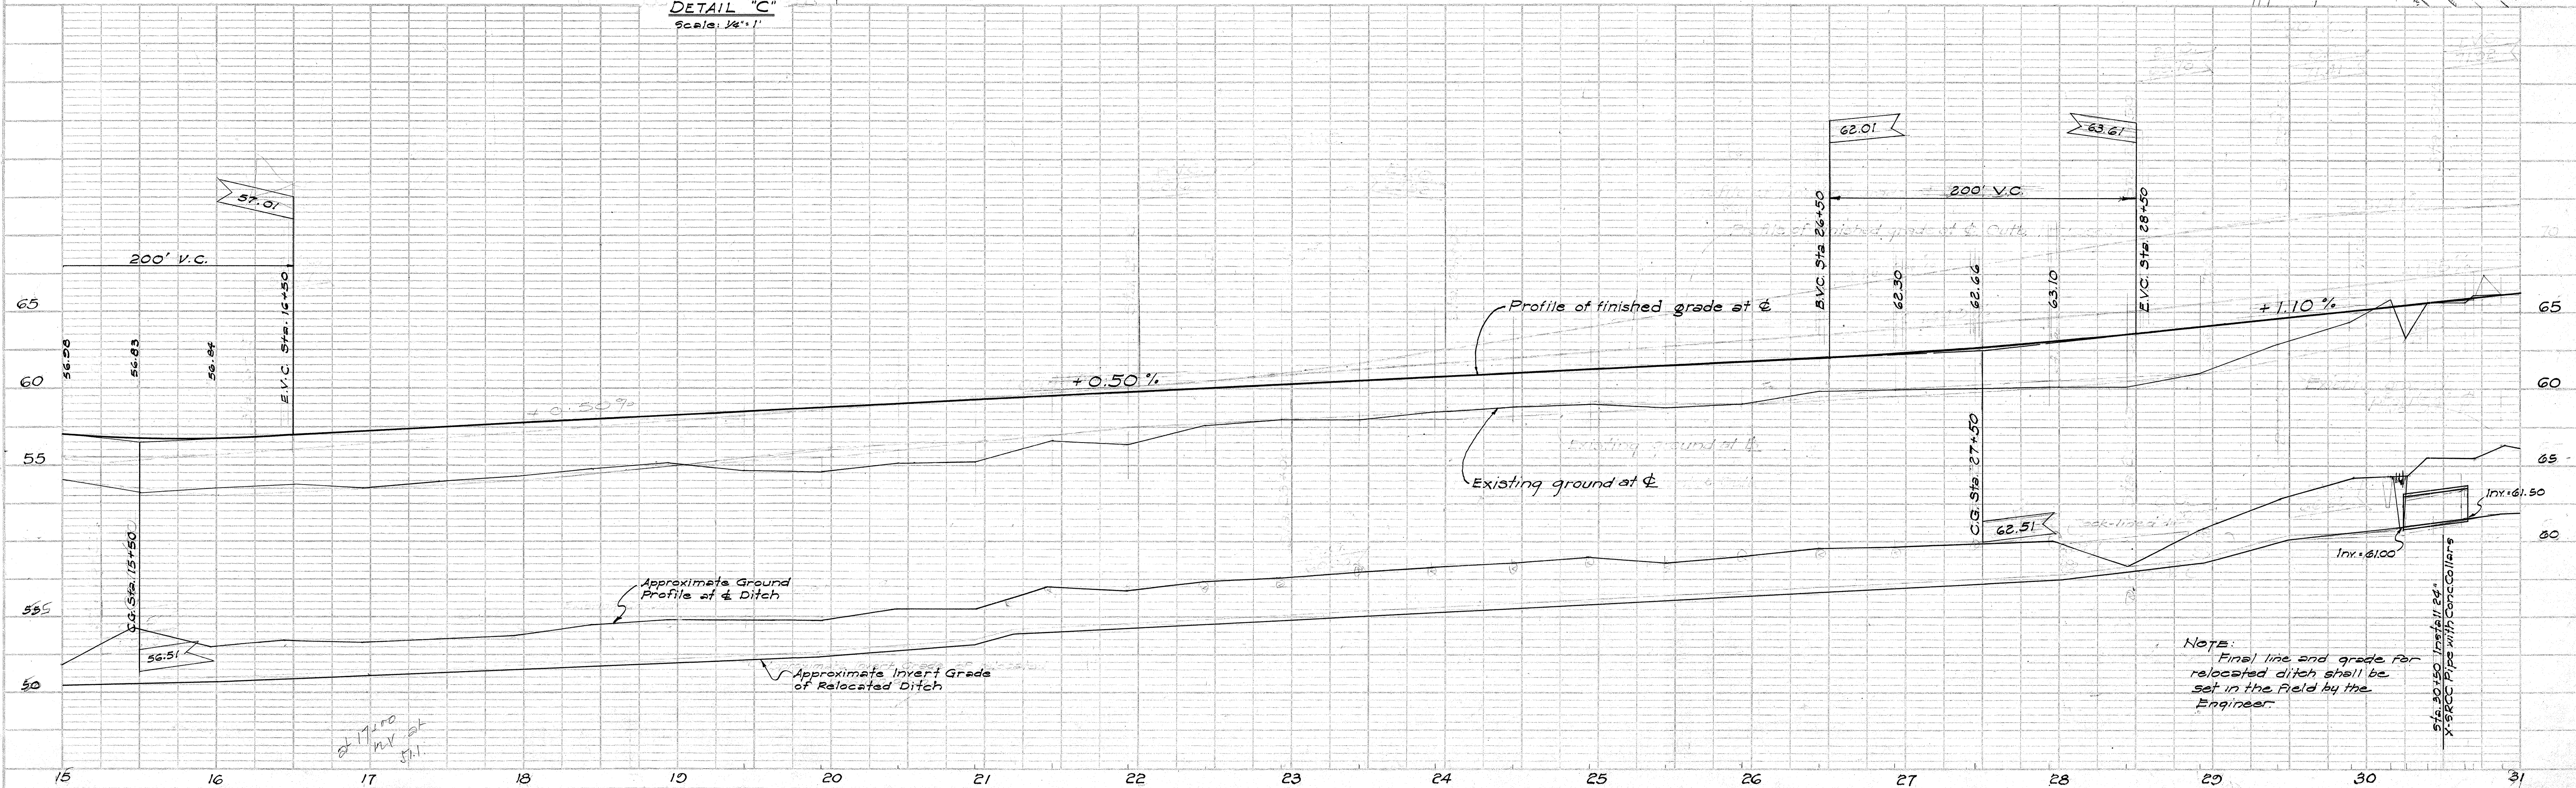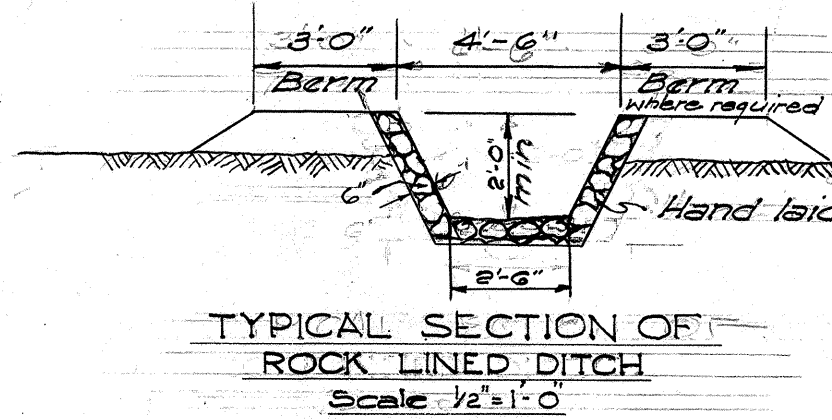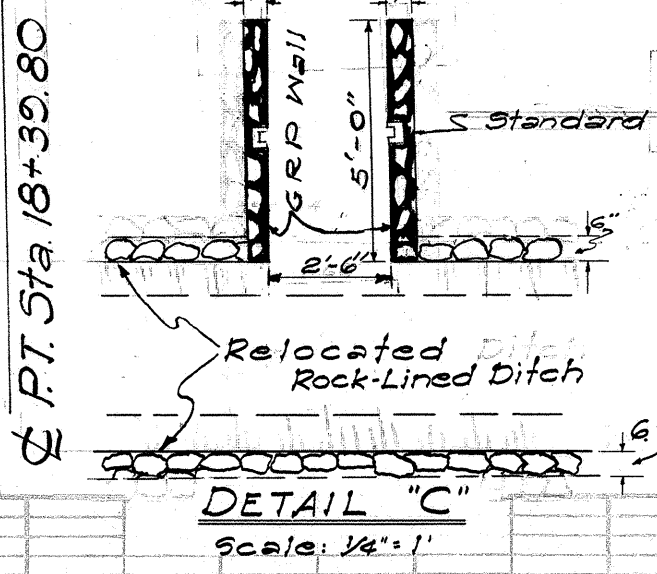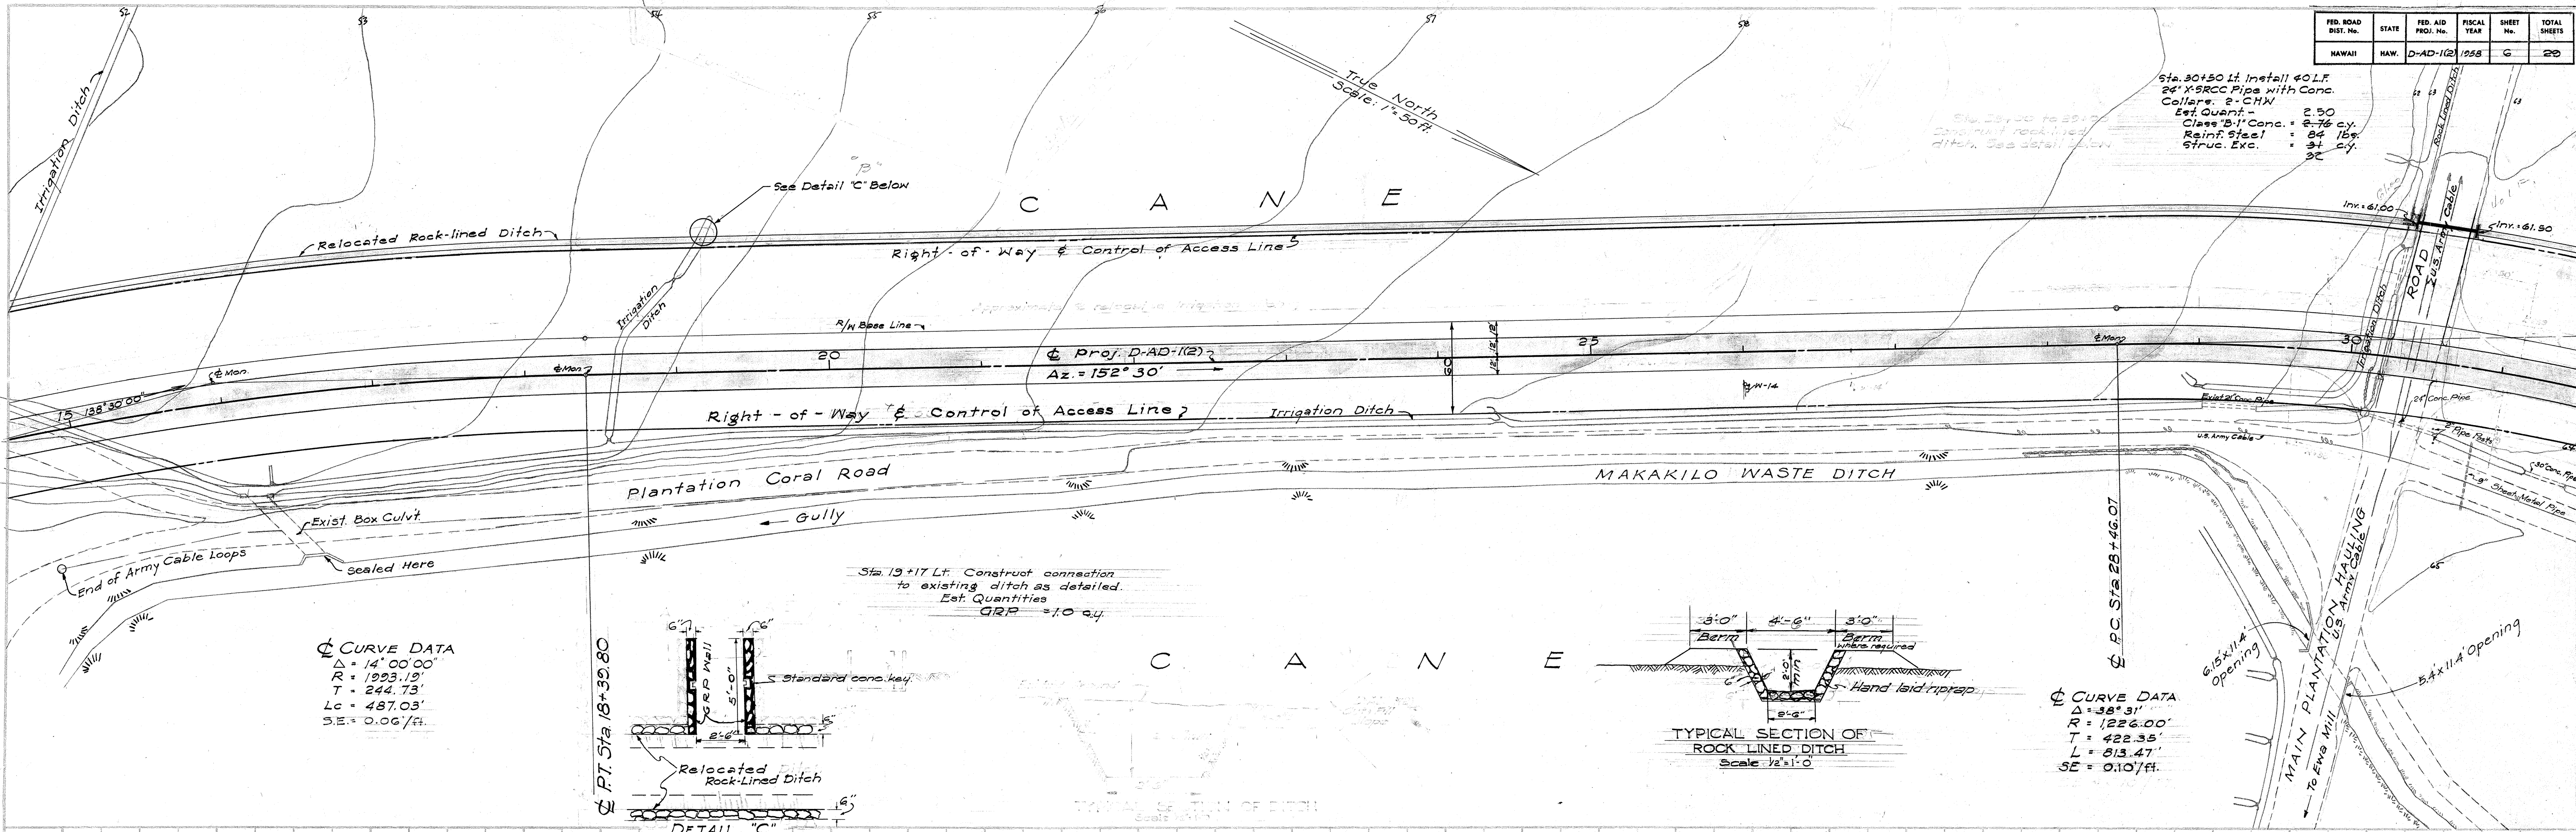

NOTE:
Final line and grade for relocated ditch shall be set in the field by the Engineer.

FED. ROAD DIST. No.	STATE	FED. AID PROJ. No.	FISCAL YEAR	SHEET No.	TOTAL SHEETS
HAWAII	HAW.	D-AD-1(2)	1958	7	29


CURVE DATA
 $\Delta = 59^{\circ} 50'$
 $R = 876.00'$
 $T = 504.06'$
 $L = 914.80'$
 $SE = 0.10'/ft.$

Sta. 30+30 Lt. & Rt. Construct connections to existing Haul Rd. (See details below.) Install traffic signal system. (See sheet no. 5998.11)
Est. Quant.
Pav. Area = 733 sq. y.
BC Area = 631 sq. y.
Exc. = 171 cu. y.
Emb. = 89 cu. y.


Sta. 30+25 Lt. Construct conn. to existing ditches. Est. Quant. 0.2 cu. y. = 20 cu. y.

CURVE DATA
 $\Delta = 38^{\circ} 01'$
 $R = 1226.00'$
 $T = 422.35'$
 $L = 813.47'$
 $SE = 0.10'/ft.$

True North
Scale 1" = 50 ft.

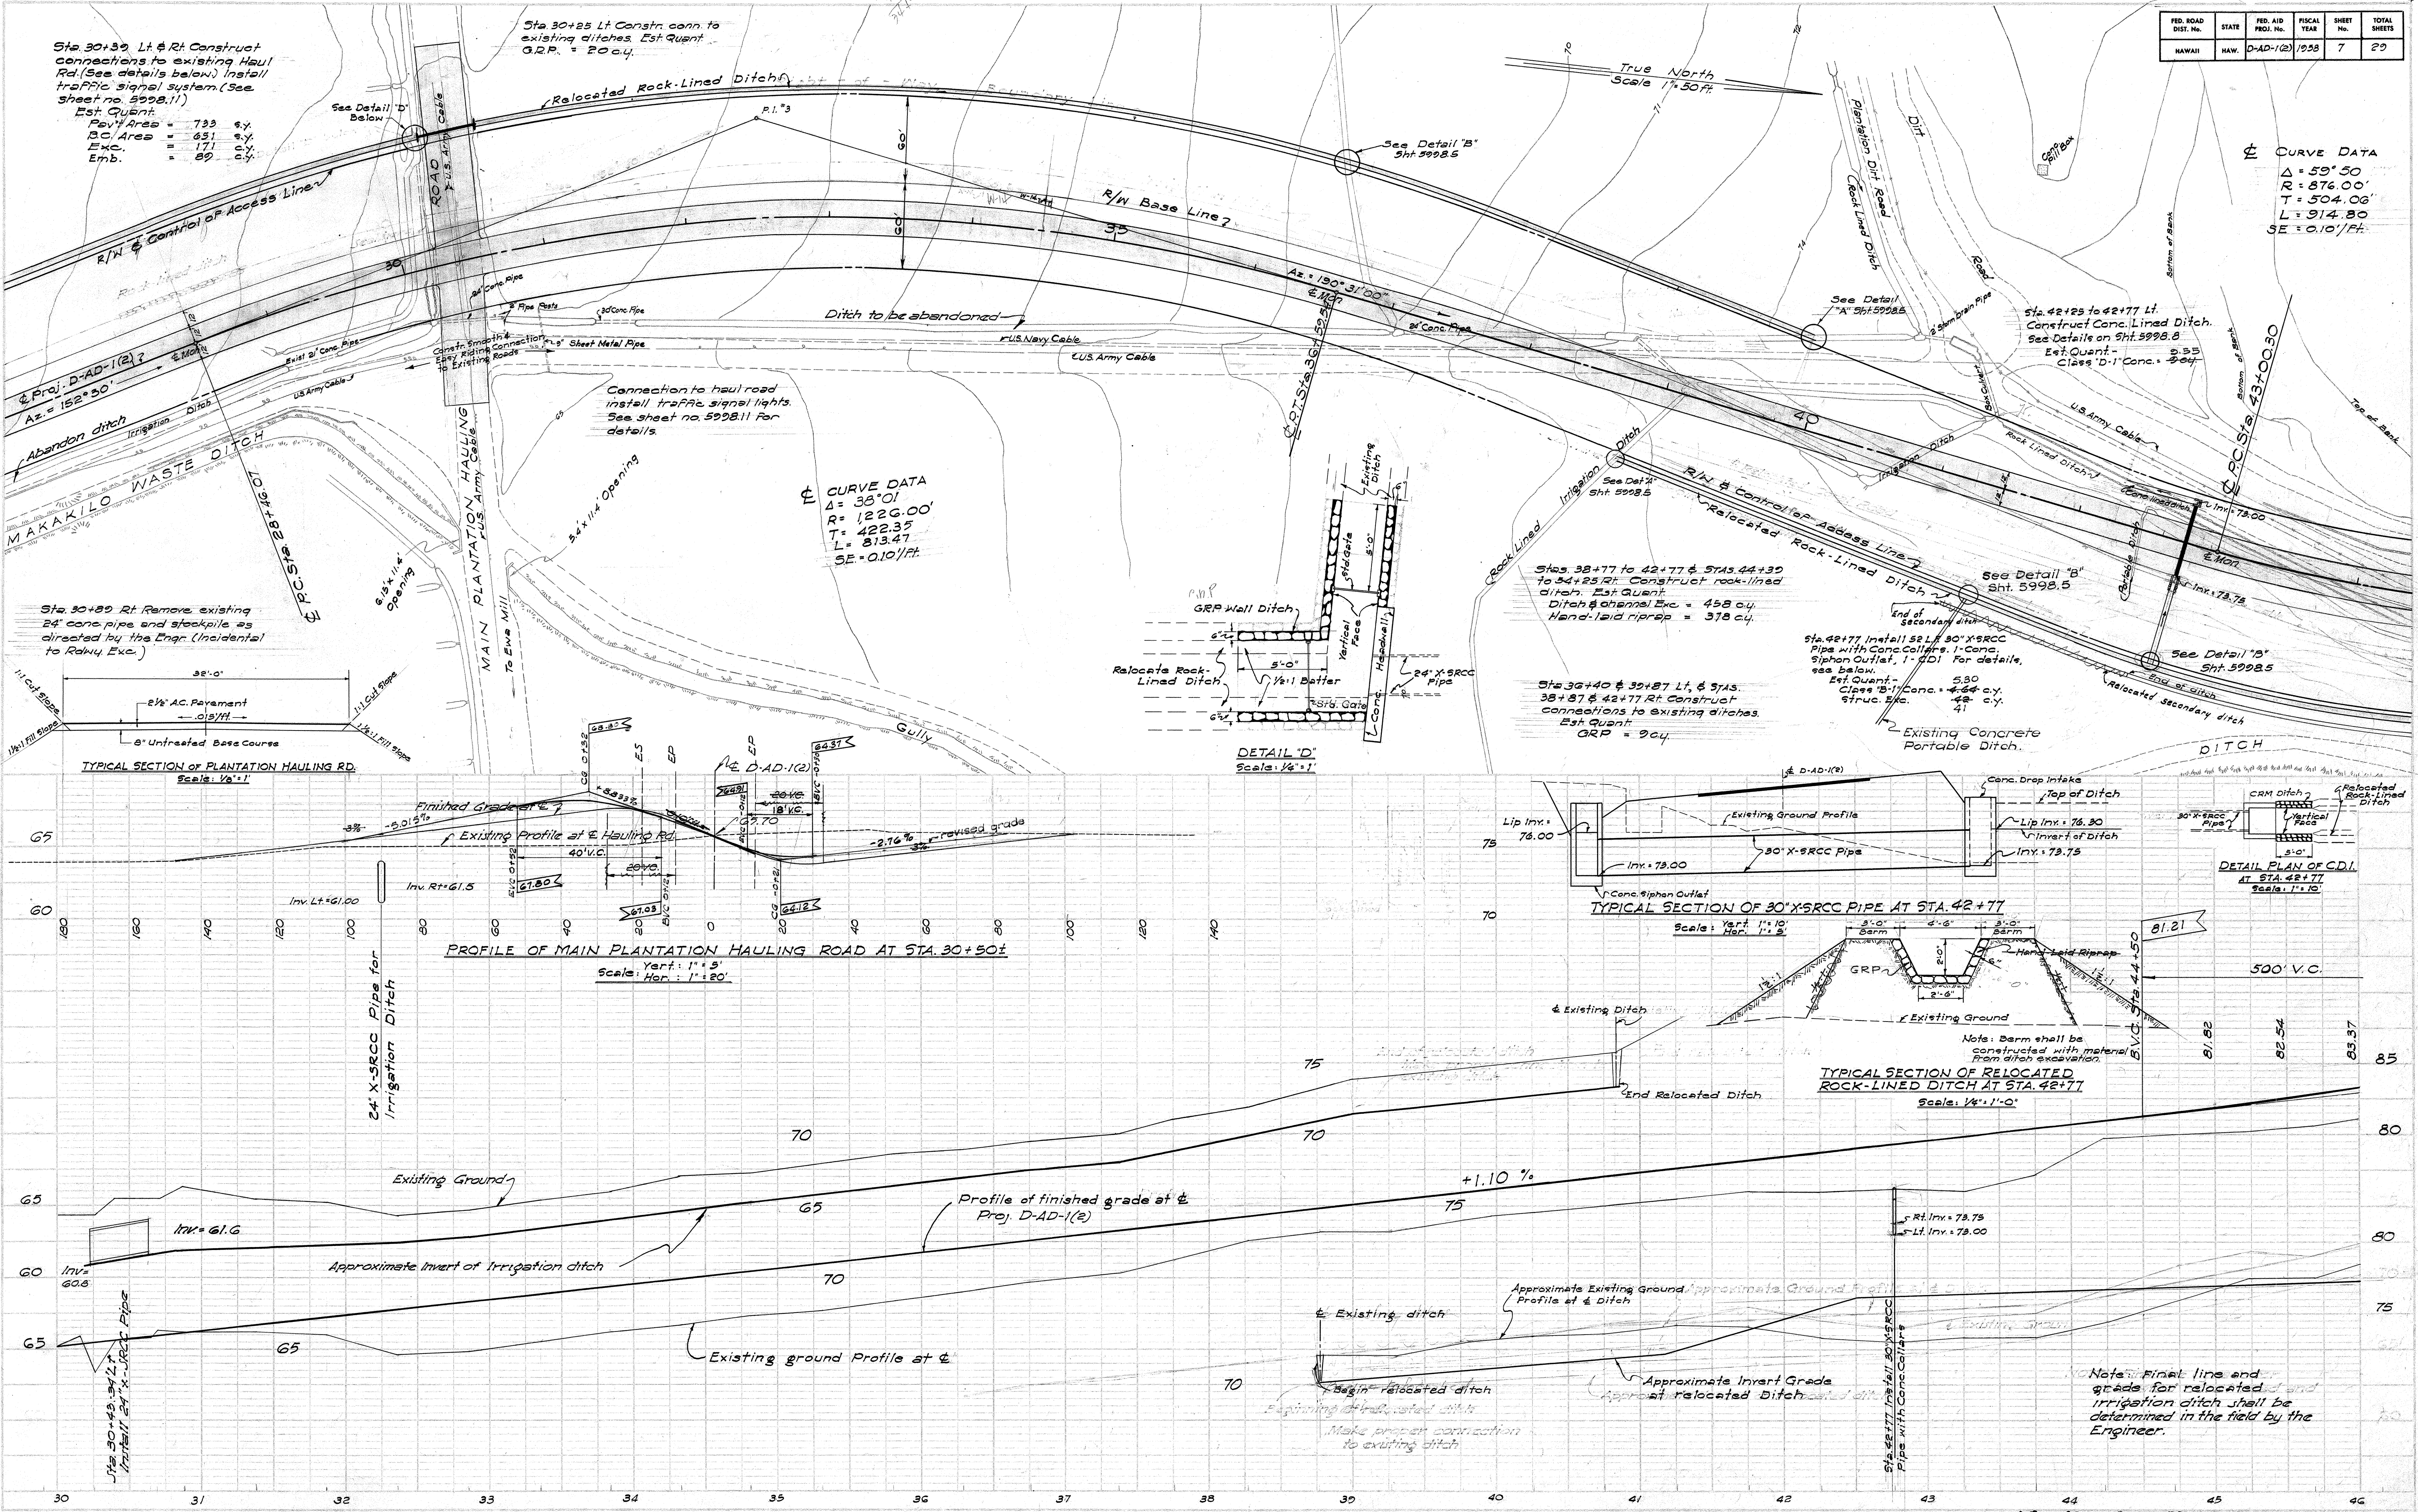

FED. ROAD DIST. No.	STATE	FED. AID PROJ. No.	FISCAL YEAR	SHEET No.	TOTAL SHEETS
HAWAII	HAW.	D-AD-1(2)	1958	8	29

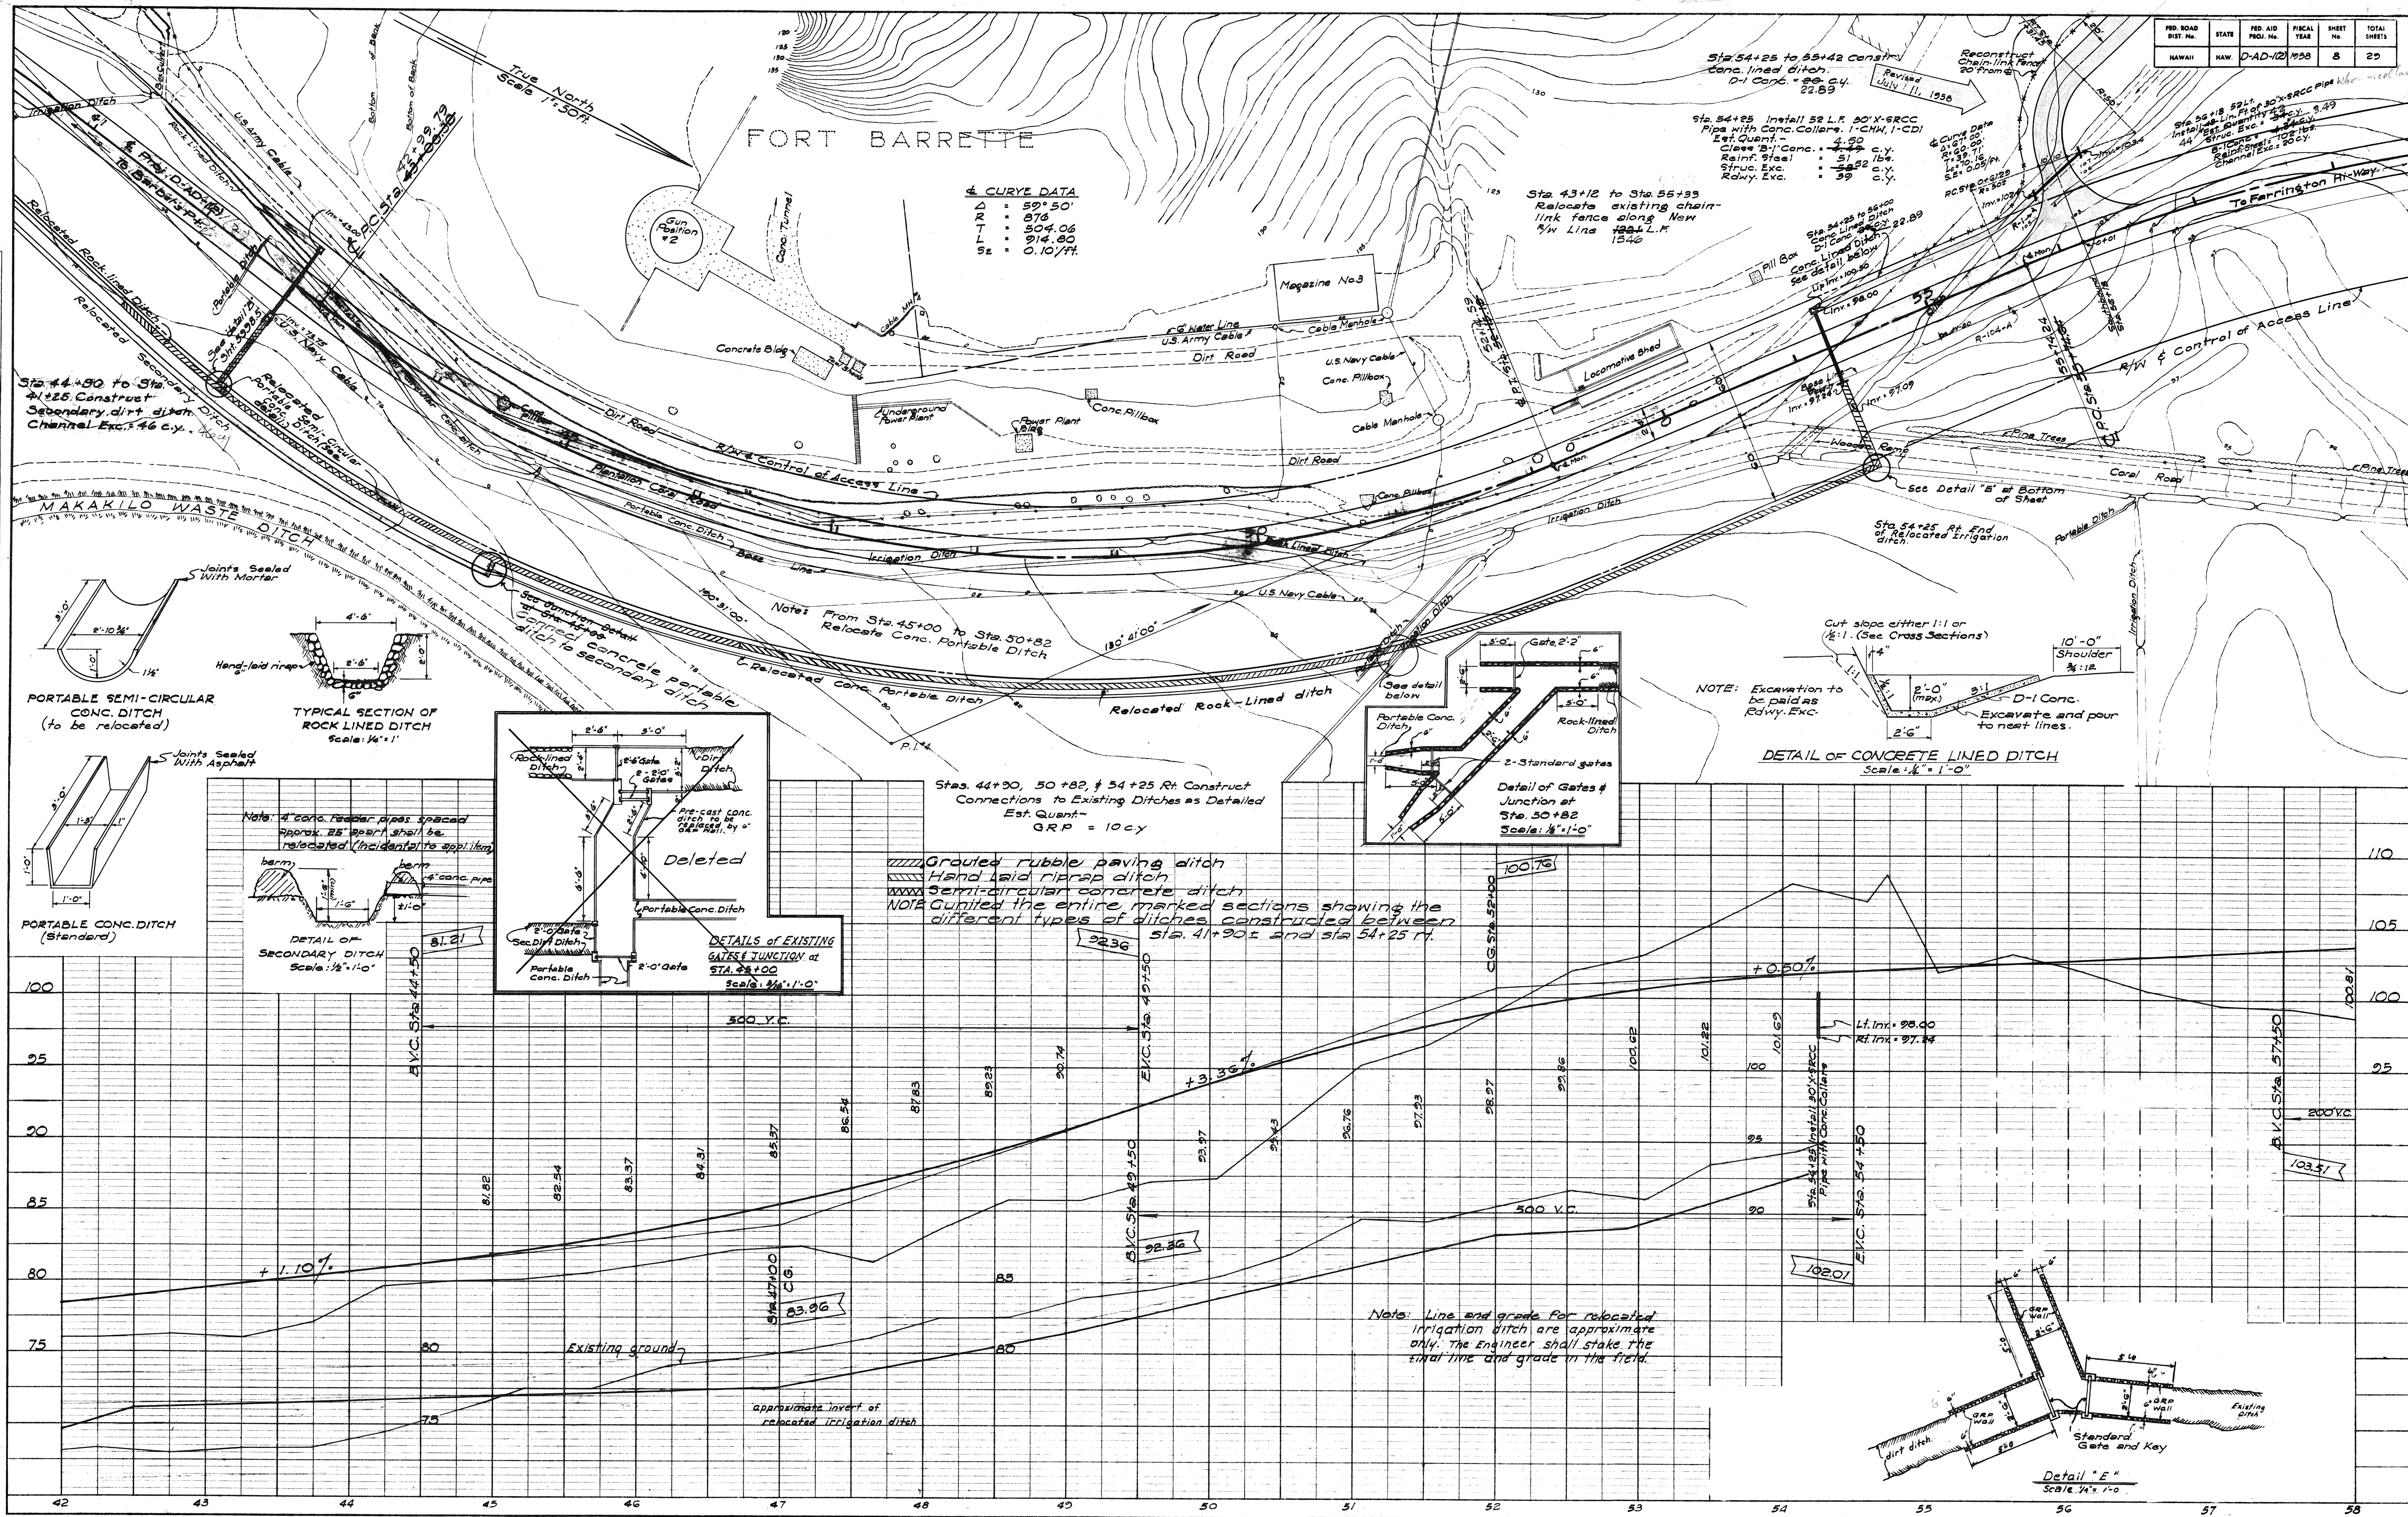

PROJ. NO.	STATE	PROJ. NAME	FISCAL YEAR	SHEET NO.	TOTAL SHEETS
HAWAII	HA	D-AD-1(2)	1958	10	29

END OF PROJ. D-AD-1(2)
STA. 64+91.97 ST
FARRINGTON HIGHWAY
STA. 38+08.06

WAIANAE
BARBER'S POINT

Message For Destination Sign

NOTE: Letters shall be 4" Series "D"
See Standard Detail.

