

INDEX TO DRAWINGS	
SHEET NO.	DESCRIPTION
1	TITLE SHEET
2	TYPICAL SECTIONS
3	BORROW PIT SITE
4-10	PLAN AND PROFILE
11	TRAFFIC SIGNAL DETAIL
12-29	CROSS SECTIONS

TERRITORY OF HAWAII
TERRITORIAL HIGHWAY DEPARTMENT
HONOLULU, OAHU, T. H.
AS BUILT
PLANS OF


BARBER'S POINT N.A.S. ACCESS ROAD

HAWAII PROJECT NO. D-AD-1(2)


DISTRICT OF EWA

ISLAND OF OAHU

SCALES		
PLAN	1 IN. =	50 FT.
PROFILE	HOR. 1 IN. =	50 FT.
	VERT. 1 IN. =	5 FT.
CROSS SECTION	HOR. 1 IN. =	10 FT.
	VERT. 1 IN. =	5 FT.

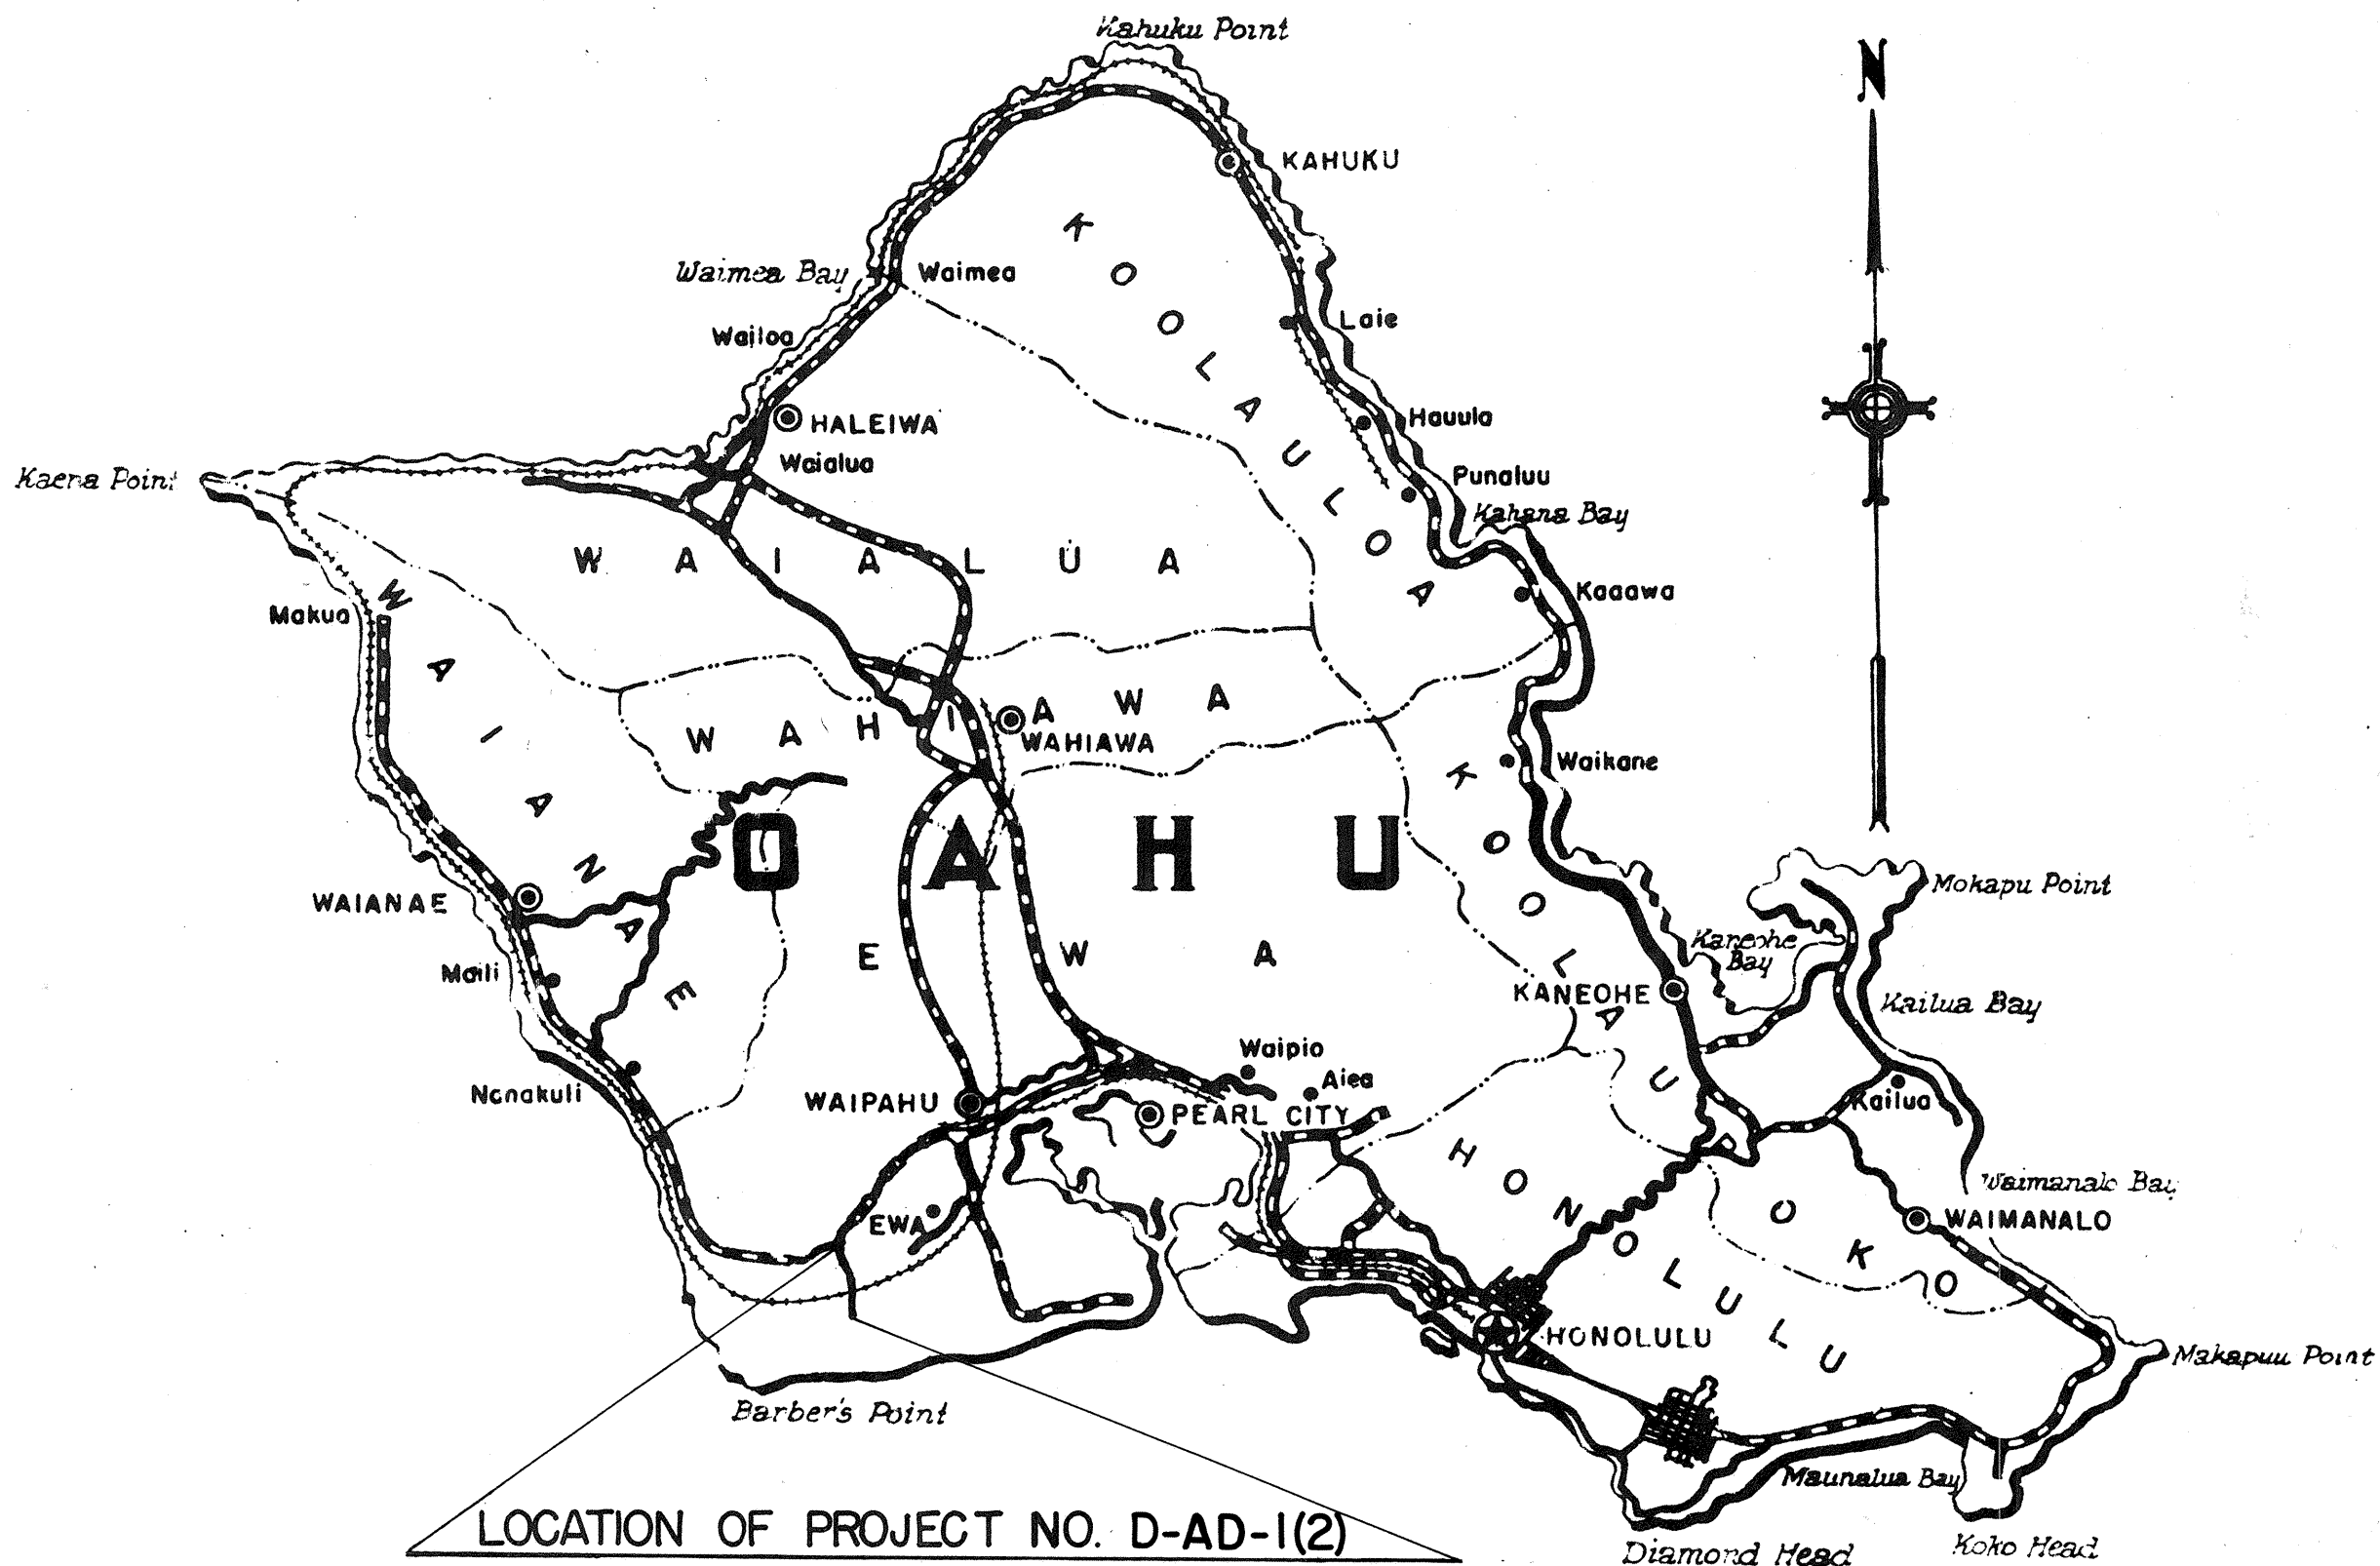

CONVENTIONAL SIGNS	
Centerline	125
Boundary Lines	or
Fences (Named)	
Existing Roadways	
Circular Culvert	
Box Culvert	
Bridge	
Telephone Pole	T.P.
Electric Power Pole	E.P.
Water Main	W ₂ (W ₄ , 6, 12, Etc.)
Storm Drain	SD ₂ (SD ₄ , 8, 24, Etc.)
Concrete Drop Intake	C.D.I.
Standard Catch Basin	S.C.B.
Standard Manhole	M.H. 5'
Sewer Manhole	S.S. 5' 2"
Telephone Manhole	T.M.H.
Fire Hydrant	F.H.
Tree (Large, named)	Wango, Coco
Railroad	
Mutual Telephone Underground Cable	MTC
Water Meter	WM

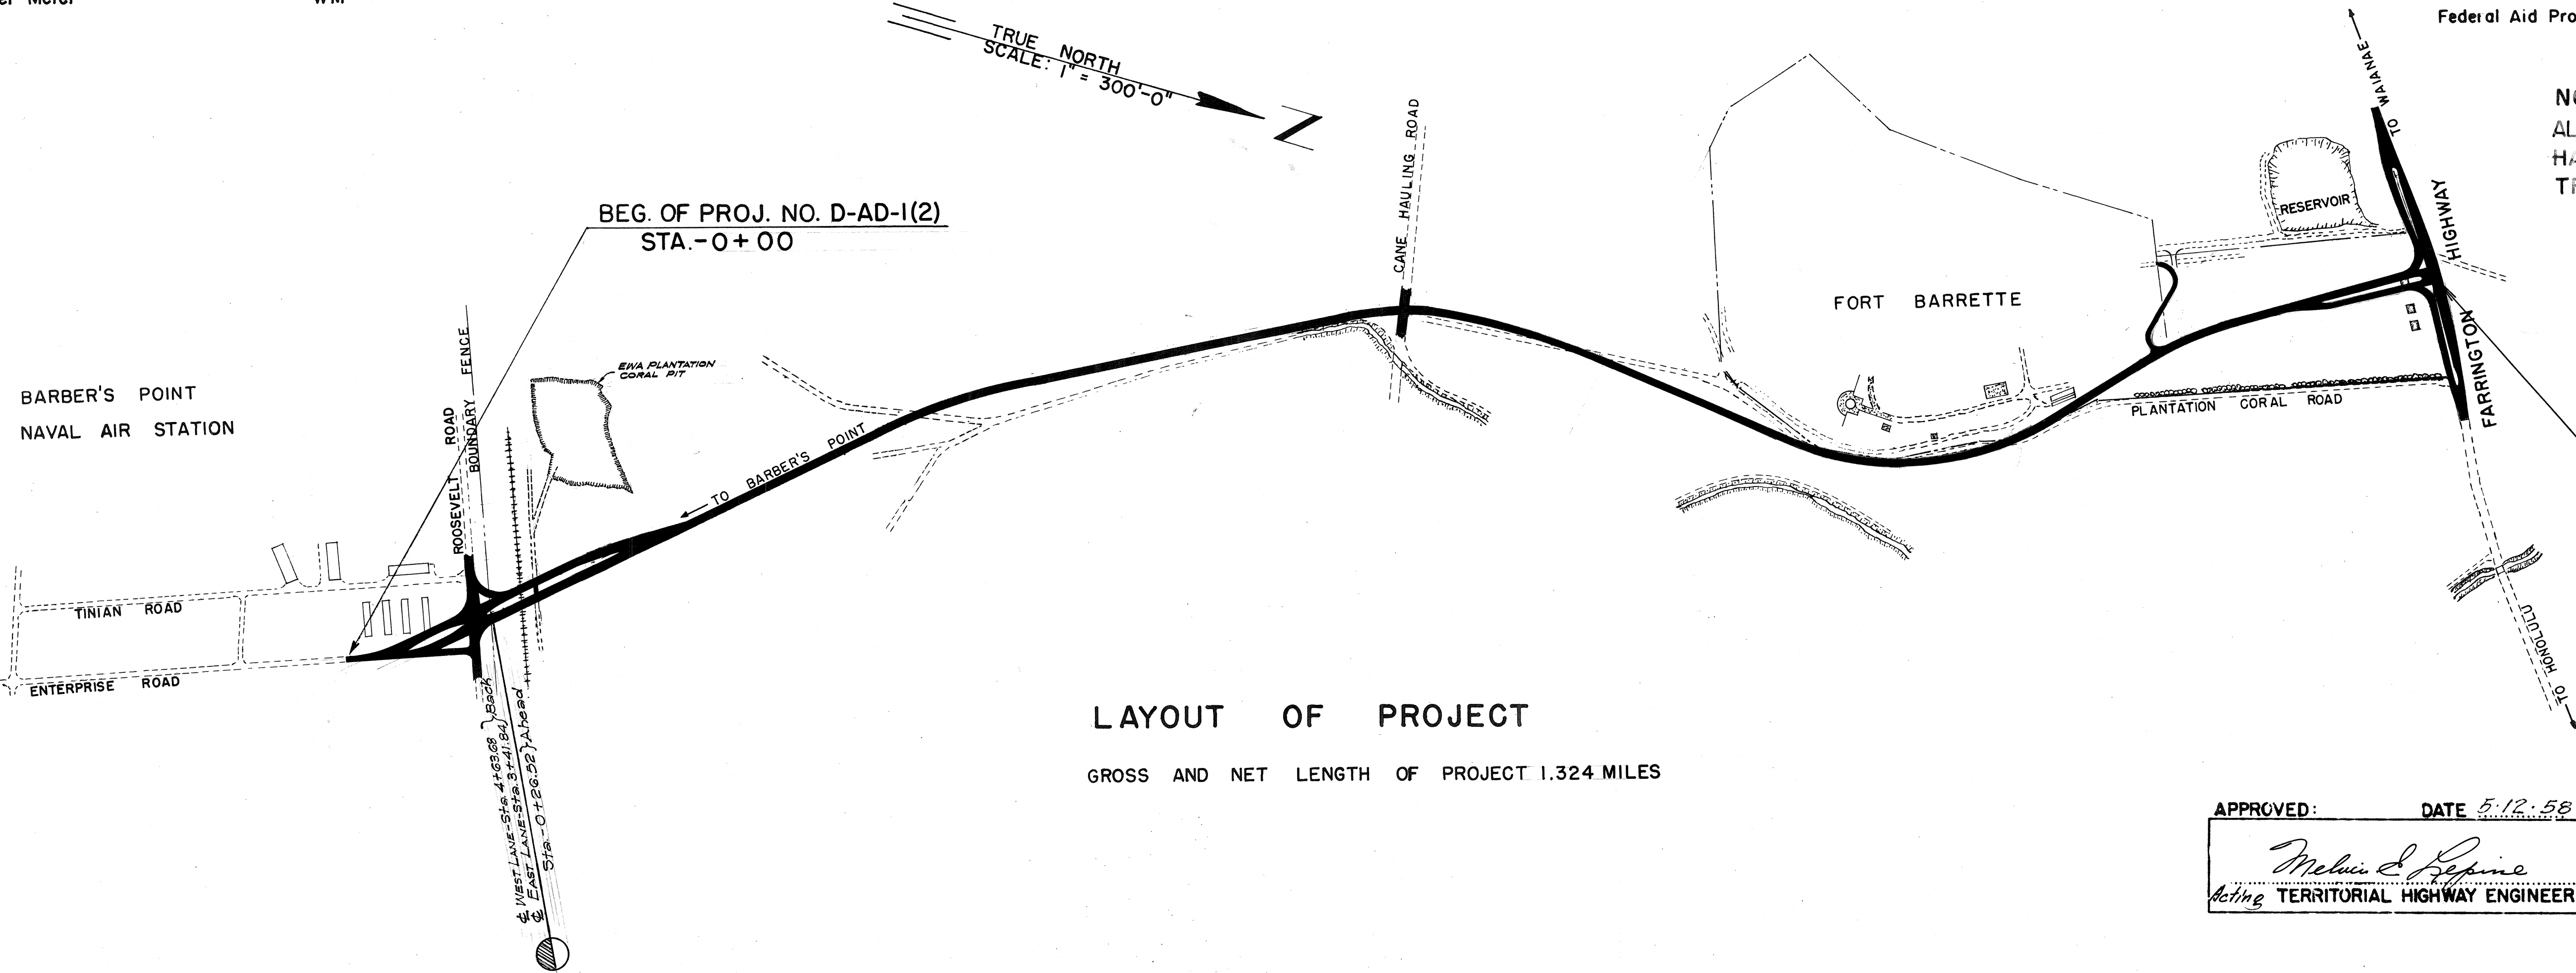

Federal Aid Projects Previously Constructed Or Under Construction

NOTE:
ALL CHANGES MADE DURING CONSTRUCTION
HAVE BEEN NOTED IN RED ON THESE
TRACINGS AND CHECKED.

R. W. Hendry
DISTRICT ENGINEER

DATE

END OF PROJ. NO. D-AD-1(2)
STA. 64+91.97

DATE	
SURVEY PLOTTED BY	
DESIGNED BY	
TRACED BY	
QUANTITIES BY	
CHECKED BY	

APPROVED: DATE 5-12-58
Melvin D. Repine
Acting TERRITORIAL HIGHWAY ENGINEER

DEPARTMENT OF COMMERCE
BUREAU OF PUBLIC ROADS
APPROVED:
DIVISION ENGINEER DATE