


GENERAL NOTES

STATE PROJECT NO. PMT-901A-01-98

1. THE CONTRACTOR SHALL VERIFY ALL DIMENSIONS AND LOCATIONS OF DUCTS AND PIPES BEFORE POURING CONCRETE AND COORDINATE INFORMATION SHOWN ON STRUCTURAL DRAWINGS WITH CIVIL DRAWINGS BEFORE COMMENCEMENT OF WORK.
2. ALL CONCRETE SHALL HAVE A MINIMUM 28-DAY COMPRESSIVE STRENGTH OF 3,000 p.s.i.
3. REINFORCING STEEL SHALL BE DEFORMED BARS CONFORMING TO A.S.T.M. A-615, GRADE 60.
4. UNLESS OTHERWISE NOTED, ALL CONTINUOUS BARS IN WALLS AND SLABS SHALL BE LAPPED 40 BAR DIAMETERS AT ALL SPLICES, CORNERS AND INTERSECTIONS. SPLICES BETWEEN ADJACENT BARS SHALL BE STAGGERED 4'-0" APART.
5. EXCEPT AS OTHERWISE NOTED, ALL MANHOLE COVERS, PRECAST CONCRETE MANHOLE RINGS, RINGS, AND OTHER TYPICAL ENGINEERING DETAILS SHALL REFER TO THE CITY AND COUNTY OF HONOLULU STANDARDS (DENOTED AS "STANDARD DETAILS").
6. MINIMUM CONCRETE COVER OVER REINFORCING STEEL SHALL BE AS FOLLOWS :
 BOTTOM SLAB OR FOOTING IN CONTACT WITH GROUND 3"
 TOP BARS IN BOTTOM SLAB 2"
 TOP AND BOTTOM BARS IN TOP SLAB 2"
 WALLS 2"
7. REFER TO CIVIL DRAWINGS FOR THE LOCATION OF BOX CULVERTS, DRAIN MANHOLES, CATCH BASINS AND OTHER ITEMS.
8. DESIGN LIVE LOADS :
 ROADWAY HS20-44
 SURCHARGE 240 p.s.f.
9. OPTION OF PRECAST CONCRETE :
 AT HIS OPTION, THE CONTRACTOR MAY USE PRECAST CONCRETE IN THE CONSTRUCTION OF MANHOLE. SUBMIT CALCULATIONS AND SHOP DRAWINGS FOR APPROVAL BEFORE FABRICATION. CALCULATIONS AND SHOP DRAWINGS SHALL BE STAMPED AND SIGNED BY A PROFESSIONAL STRUCTURAL ENGINEER LICENSED IN THE STATE OF HAWAII.


10. FOUNDATION NOTES :
 A. FOR GEOTECHNICAL INFORMATION AND RECOMMENDATIONS FOR THE DESIGN AND CONSTRUCTION OF ALL FOUNDATIONS, REFER TO THE GEOTECHNICAL REPORT ENTITLED "GEOTECHNICAL ENGINEERING EXPLORATION, VILLAGES OF KAPOLEI, FARRINGTON HIGHWAY IMPROVEMENTS, EWA, OAHU, HAWAII" DATED JUNE 28, 1996 AND FAX ADDENDUM LETTER DATED FEBRUARY 4, 1997, PREPARED BY GEOLABS HAWAII.
 B. EXCEPT AS OTHERWISE NOTED, THE FOLLOWING CRITERIA WAS USED IN THE DESIGN OF THE FOUNDATION.
 ALLOWABLE SOIL BEARING CAPACITY 3,000 p.s.f.
 ACTIVE EARTH PRESSURE 50 p.s.f.
 C. THE EXCAVATIONS AND BACKFILLING FOR CONSTRUCTION OF FOUNDATIONS SHALL BE MONITORED BY THE SOILS ENGINEER. ANY DEVIATION FROM HIS ORIGINAL RECOMMENDATIONS WHICH MAY CHANGE THE DESIGN OF THE FOUNDATION SHALL BE REPORTED TO THE STRUCTURAL ENGINEER IN WRITING.

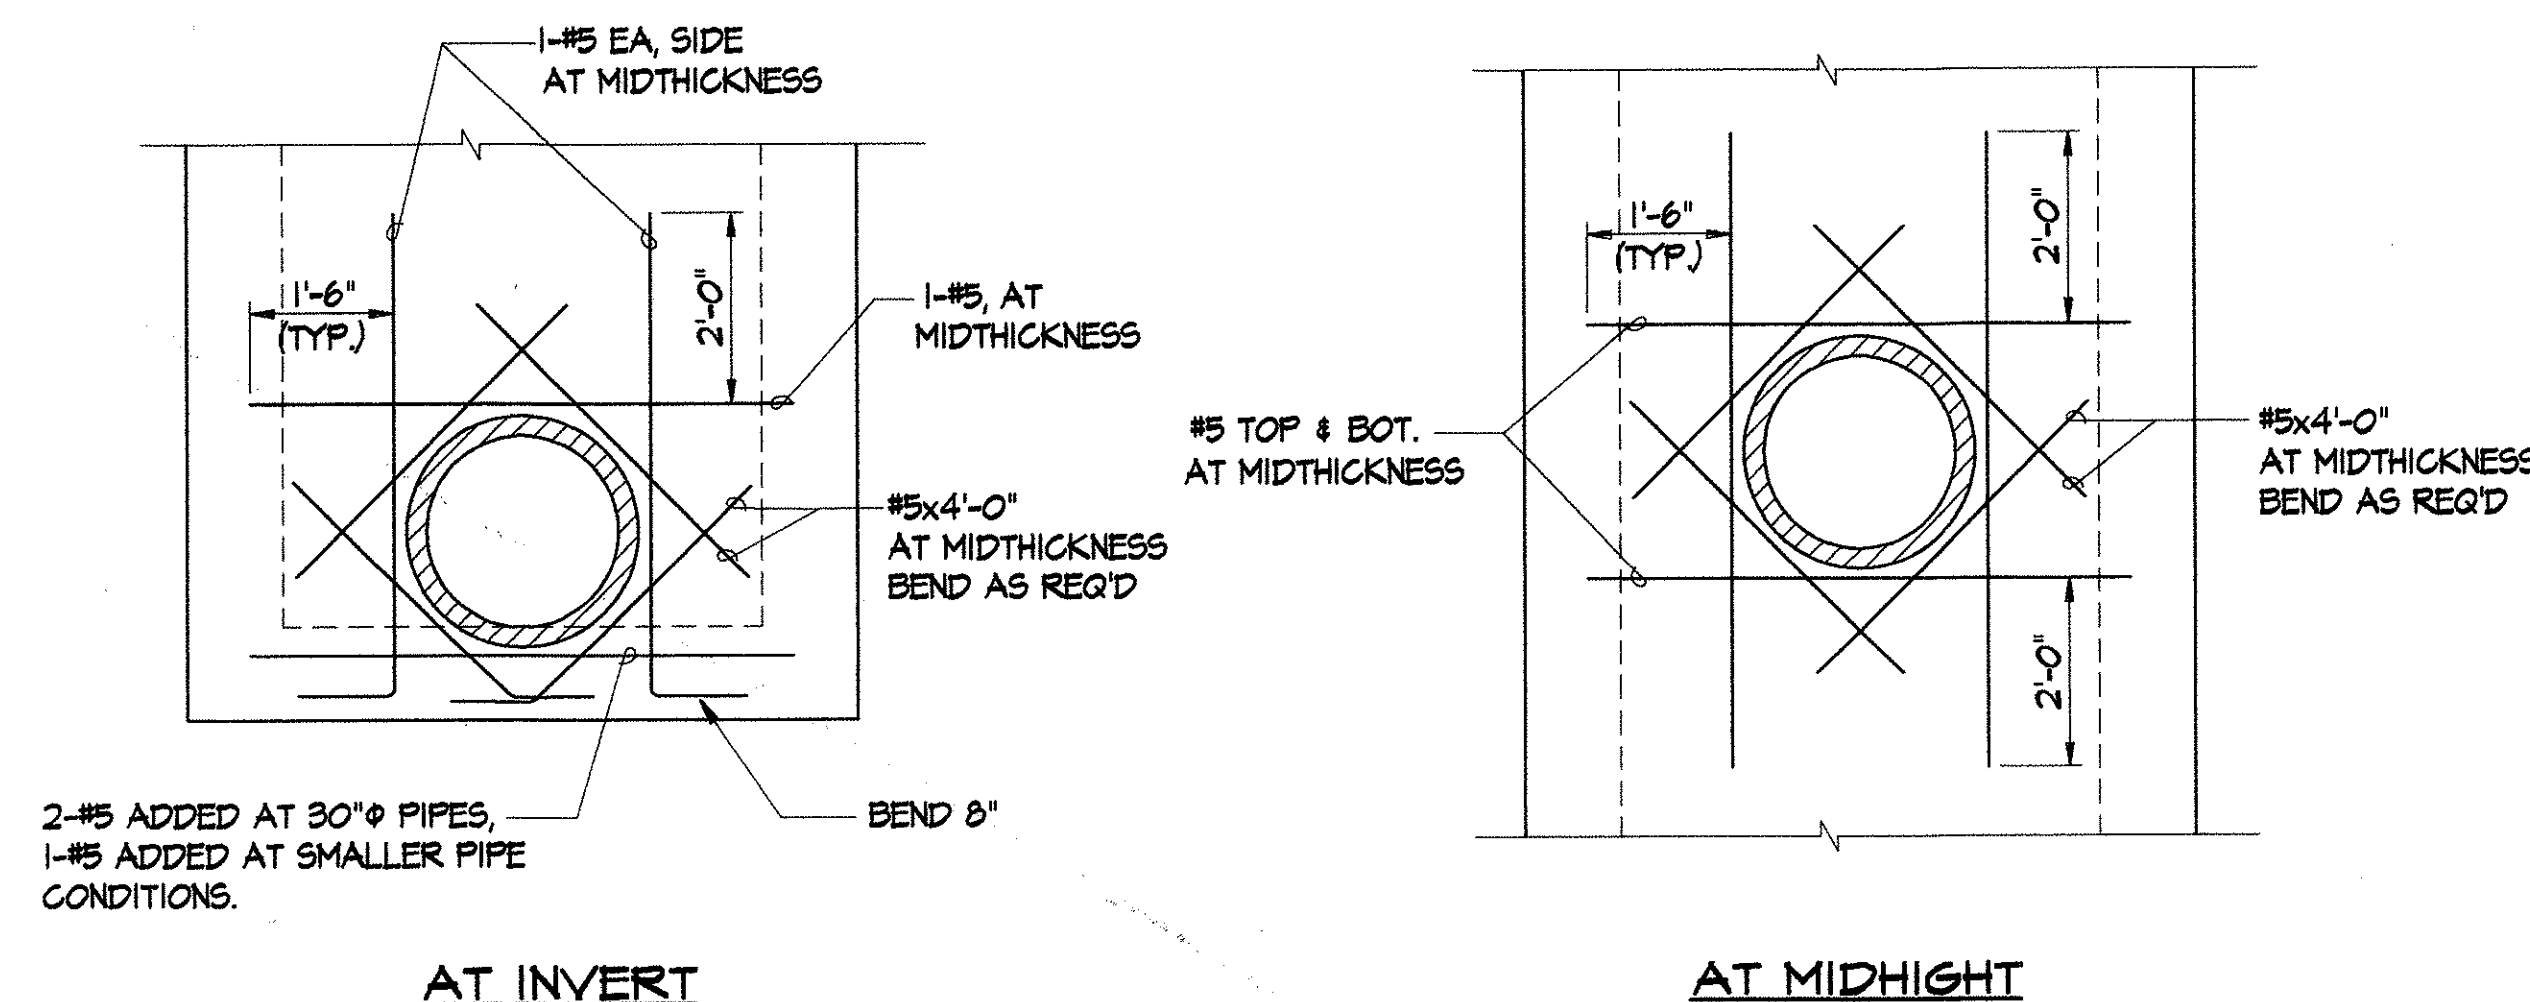


TYP. PIPE PENETRATION DETAILS AT MANHOLES AND CATCH BASINS

NOT TO SCALE

A
S-1

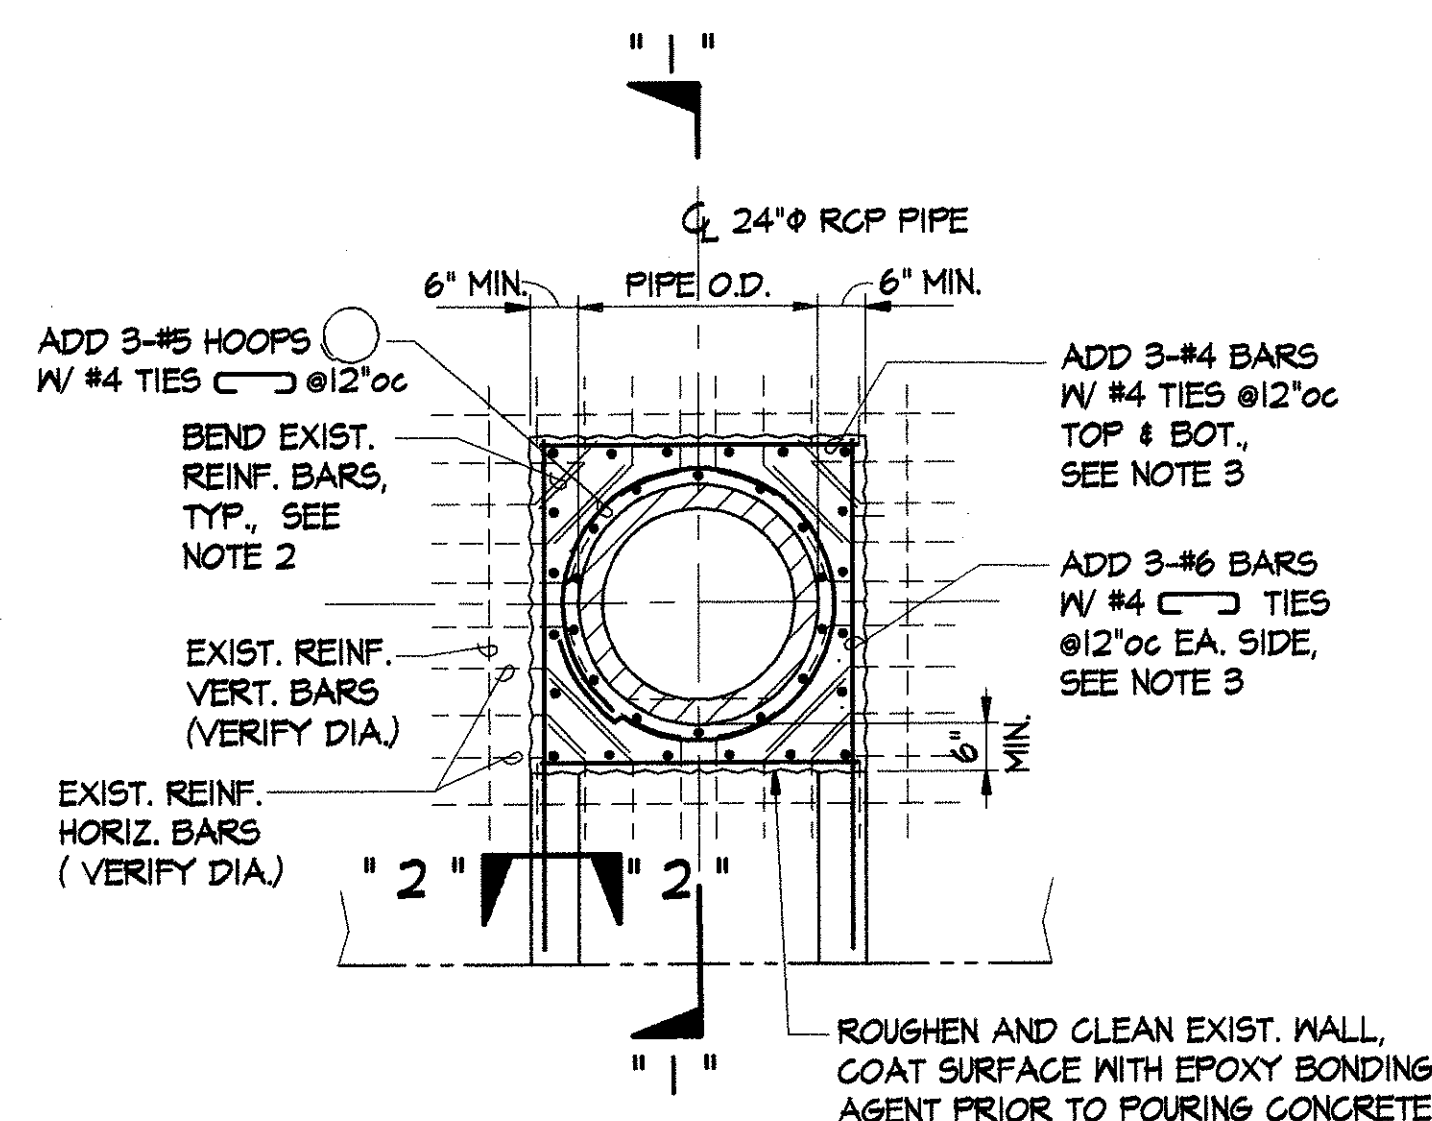


ELEVATION

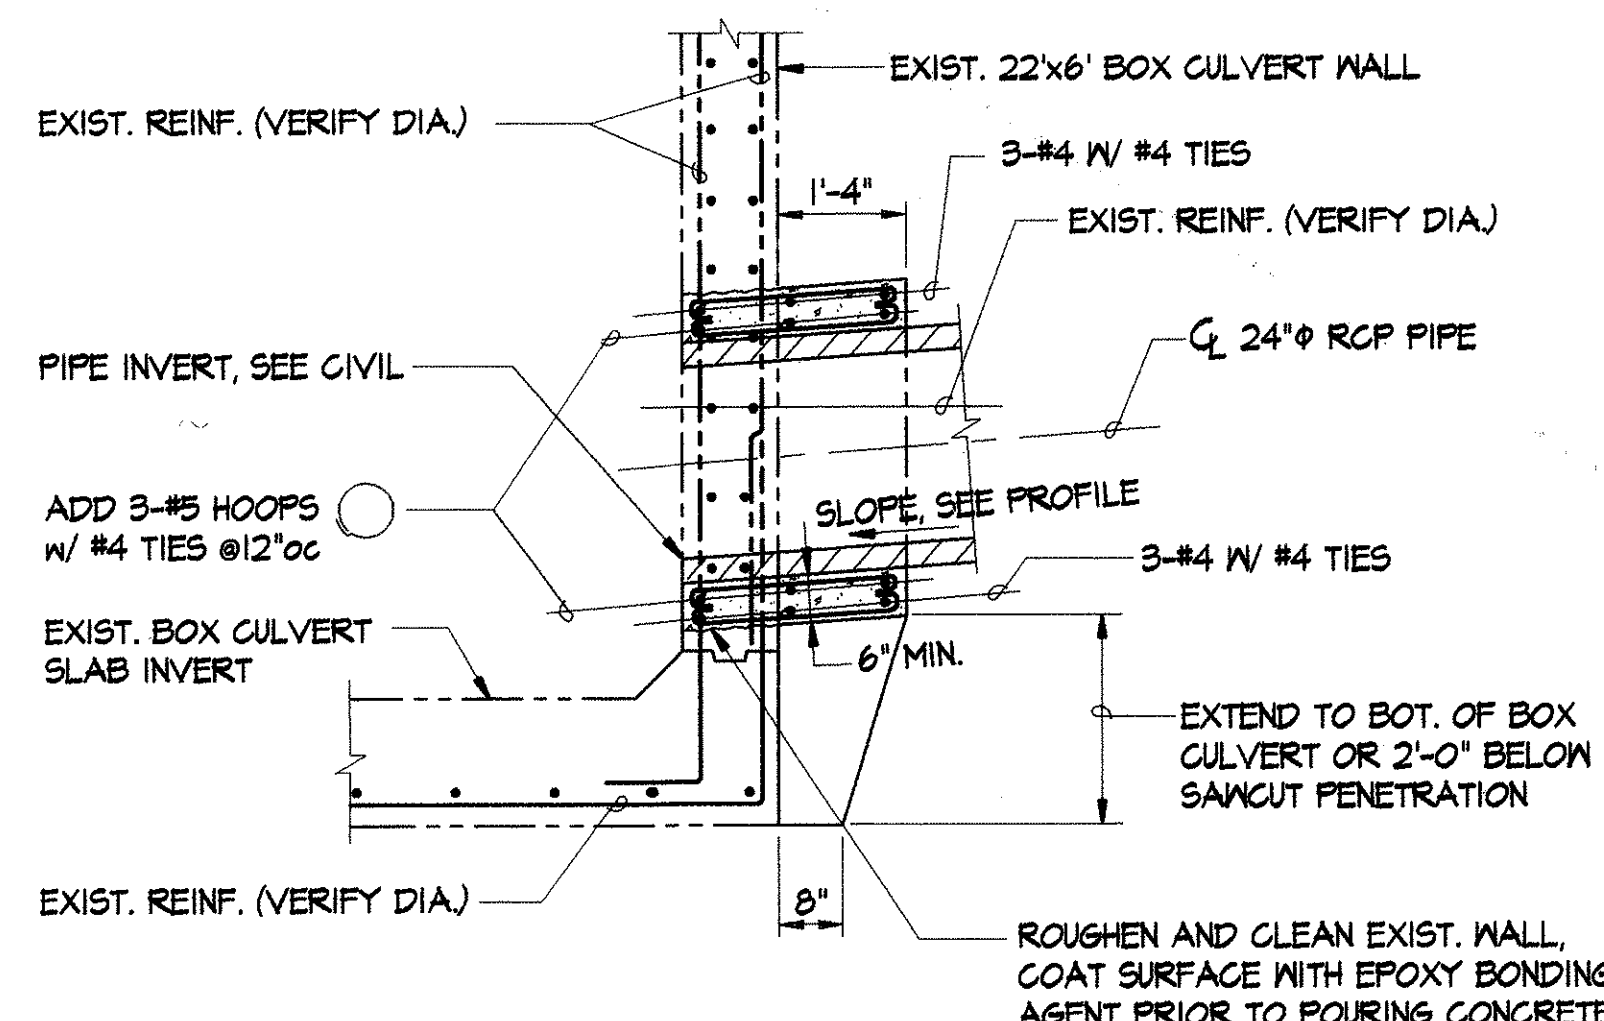

SECTION " I-I "

- NOTE:
1. SAWCUT & CHIP EXISTING BOX CULVERT, EXPOSING EXISTING REINFORCEMENT AS REQUIRED.
 2. BEND EXISTING HORIZONTAL AND VERTICAL REINFORCEMENT BARS AROUND NEW RCP PENETRATION.
 3. DIAMETER OF ADDED REINFORCEMENT BARS TO BE GREATER THAN OR EQUAL TO EXISTING REINFORCEMENT BARS REPLACED.
 4. SHORE EXISTING BOX CULVERT PRIOR TO SAWCUTTING AND FOR 10 DAYS AFTER PLACING CONCRETE.

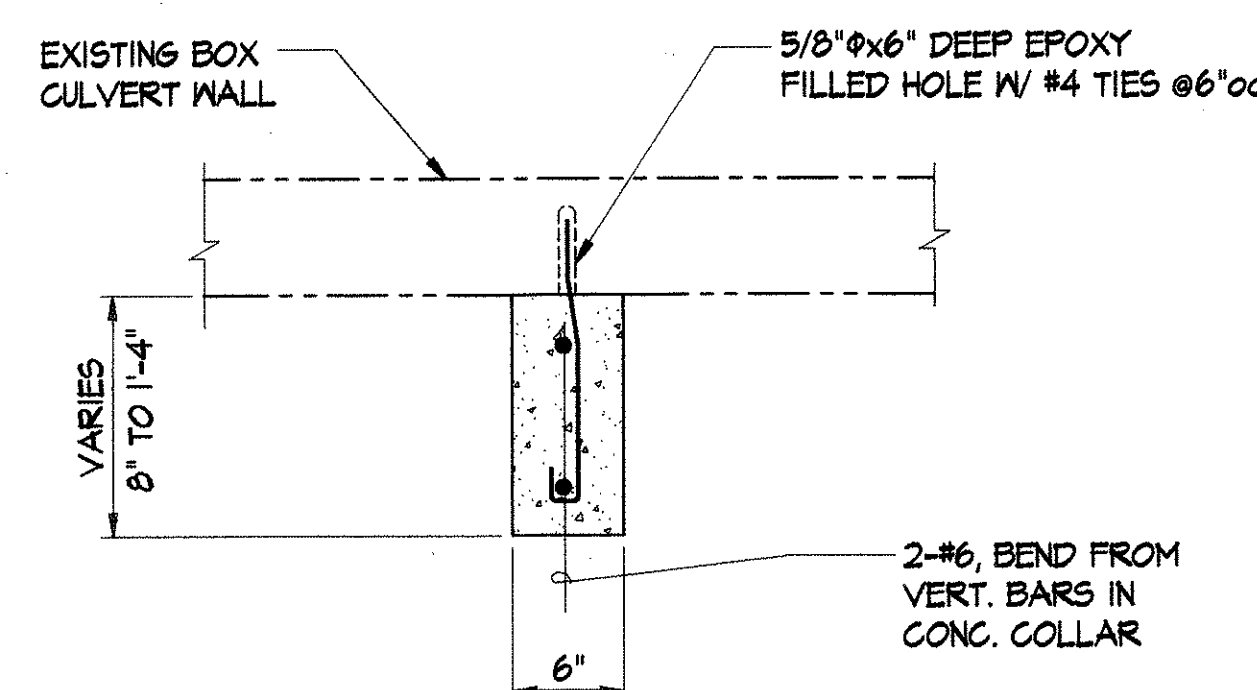

SECTION " 2-2 "

24" ϕ PIPE CONNECTION TO EXIST. 22' x 6' BOX DRAIN

NOT TO SCALE

B
S-1

Approved:

Chief, Division of Engineering, DPW

8/29/97
Date

ENGINEER	C.T.				
DRAFTSMAN	H.C.				
CHECKED BY	J.W.				
		R. M. TOWILL CORPORATION ENGINEERS • PLANNERS • SURVEYORS • PHOTOGRAMMETRISTS 420 Waiakamilo Road Honolulu, Hawaii 96817-4941 THE ESTATE OF JAMES CAMPBELL, FINANCE REALTY COMPANY, AND HOUSING FINANCE AND DEVELOPMENT CORPORATION STATE OF HAWAII FARRINGTON HIGHWAY IMPROVEMENTS EWA, OAHU, HAWAII T.M.K.: (1ST DIVISION) PORTION OF 9-1-16			
THIS WORK WAS PREPARED BY ME OR UNDER MY SUPERVISION. 		GENERAL NOTES AND TYPICAL DETAILS			
DEV 93-41		SCALE AS NOTED		DATE JULY 1997	
FILE		POCKET		FOLDER NO.	

[illegible][illegible]

FOR CONDITION @ RAMP CURB ABOVE, SEE CIVIL DWGS.

TOP SLAB FRAMING PLAN
SCALE: 1/2" = 1'-0"

PLAN VIEW OF WALL SECTION
SCALE: 1/2" = 1'-0"

SECTION A
SCALE: 1/2" = 1'-0"

SECTION B
SCALE: 1/2" = 1'-0"

SECTION C
SCALE: 1/2" = 1'-0"

SECTION D
SCALE: 1/2" = 1'-0"

SECTION E
SCALE: 1/2" = 1'-0"

SECTION F
SCALE: 1/2" = 1'-0"

PROPOSED PUBLIC ROAD

REVISION

REVISION	DATE	BRIEF	BY	APPROVED
1				

R. M. TOWILL CORPORATION
ENGINEERS • PLANNERS • SURVEYORS • PHOTOGRAMMETRISTS
CONSTRUCTION MANAGERS
420 Waiakomilo Road Honolulu, Hawaii 96817-4941

THE ESTATE OF JAMES CAMPBELL, FINANCE REALTY COMPANY, AND HOUSING FINANCE AND DEVELOPMENT CORPORATION
STATE OF HAWAII

FARRINGTON HIGHWAY IMPROVEMENTS
EWA, OAHU, HAWAII
T.M.K.: (1ST DIVISION) PORTION OF 9-1-16

MODIFIED CATCH BASIN TYPE "C"
(STATE CATCH BASIN)

JEFFREY Y.C. WONG
LICENSED PROFESSIONAL ENGINEER
HAWAII, U.S.A.
3207-S

THIS WORK WAS PREPARED BY ME OR UNDER MY SUPERVISION.

Signature

Chief, Division of Engineering, DPHW Date

"RECORD DRAWINGS" 5-6 SHEET OF SHEETS

FILE POCKET FOLDER NO.

FOR CONDITION @ RAMP CURB ABOVE, SEE CIVIL DWGS.

TOP SLAB FRAMING PLAN
SCALE: 1/2" = 1'-0"

PLAN VIEW OF WALL SECTION
SCALE: 1/2" = 1'-0"

SECTION A
SCALE: 1/2" = 1'-0"

SECTION B
SCALE: 1/2" = 1'-0"

SECTION C
SCALE: 1/2" = 1'-0"

SECTION D
SCALE: 1/2" = 1'-0"

SECTION E
SCALE: 1/2" = 1'-0"

SECTION F
SCALE: 1/2" = 1'-0"

PROPOSED PUBLIC ROAD

REVISION

REVISION	DATE	BRIEF	BY	APPROVED
1				

R. M. TOWILL CORPORATION
ENGINEERS • PLANNERS • SURVEYORS • PHOTOGRAMMETRISTS
CONSTRUCTION MANAGERS
420 Waiakomilo Road Honolulu, Hawaii 96817-4941

THE ESTATE OF JAMES CAMPBELL, FINANCE REALTY COMPANY, AND HOUSING FINANCE AND DEVELOPMENT CORPORATION
STATE OF HAWAII

FARRINGTON HIGHWAY IMPROVEMENTS
EWA, OAHU, HAWAII
T.M.K.: (1ST DIVISION) PORTION OF 9-1-16

MODIFIED CATCH BASIN TYPE "C"
(STATE CATCH BASIN)

JEFFREY Y.C. WONG
LICENSED PROFESSIONAL ENGINEER
HAWAII, U.S.A.
3207-S

THIS WORK WAS PREPARED BY ME OR UNDER MY SUPERVISION.

Signature

Chief, Division of Engineering, DPHW Date

"RECORD DRAWINGS" 5-6 SHEET OF SHEETS

FILE POCKET FOLDER NO.

[illegible][illegible][illegible][illegible][illegible][illegible][illegible][illegible]