

FARRINGTON HIGHWAY IMPROVEMENTS

EWA, OAHU, HAWAII

STATE PROJECT No. PMT-901A-01-98

PREPARED BY:

R. M. TOWILL CORPORATION

PLANNERS, ENGINEERS, SURVEYORS, PHOTOGRAMMETRISTS, CONSTRUCTION MANAGERS

FOR:

THE ESTATE OF JAMES CAMPBELL,
FINANCE REALTY COMPANY

AND
HOUSING FINANCE AND DEVELOPMENT CORPORATION,
STATE OF HAWAII


TAX MAP KEY: (1ST DIVISION) PORTION OF 9-1-16: 4, 34, 35, 108, 114;
9-1-71: Por. 10, 79, 81, 83;
9-1-72: 108, Por. 1;
9-1-81: Por. 21, 81; 9-1-106: 10

RECORD DRAWING TRACINGS

Certified By: Kenneth J. Kishida, P.E. Date: 2/1/02
(Include name and company)


Submitted By: Henry H. Hight Date: 2/5/02
Engineer

Approved By: _____ Date: _____

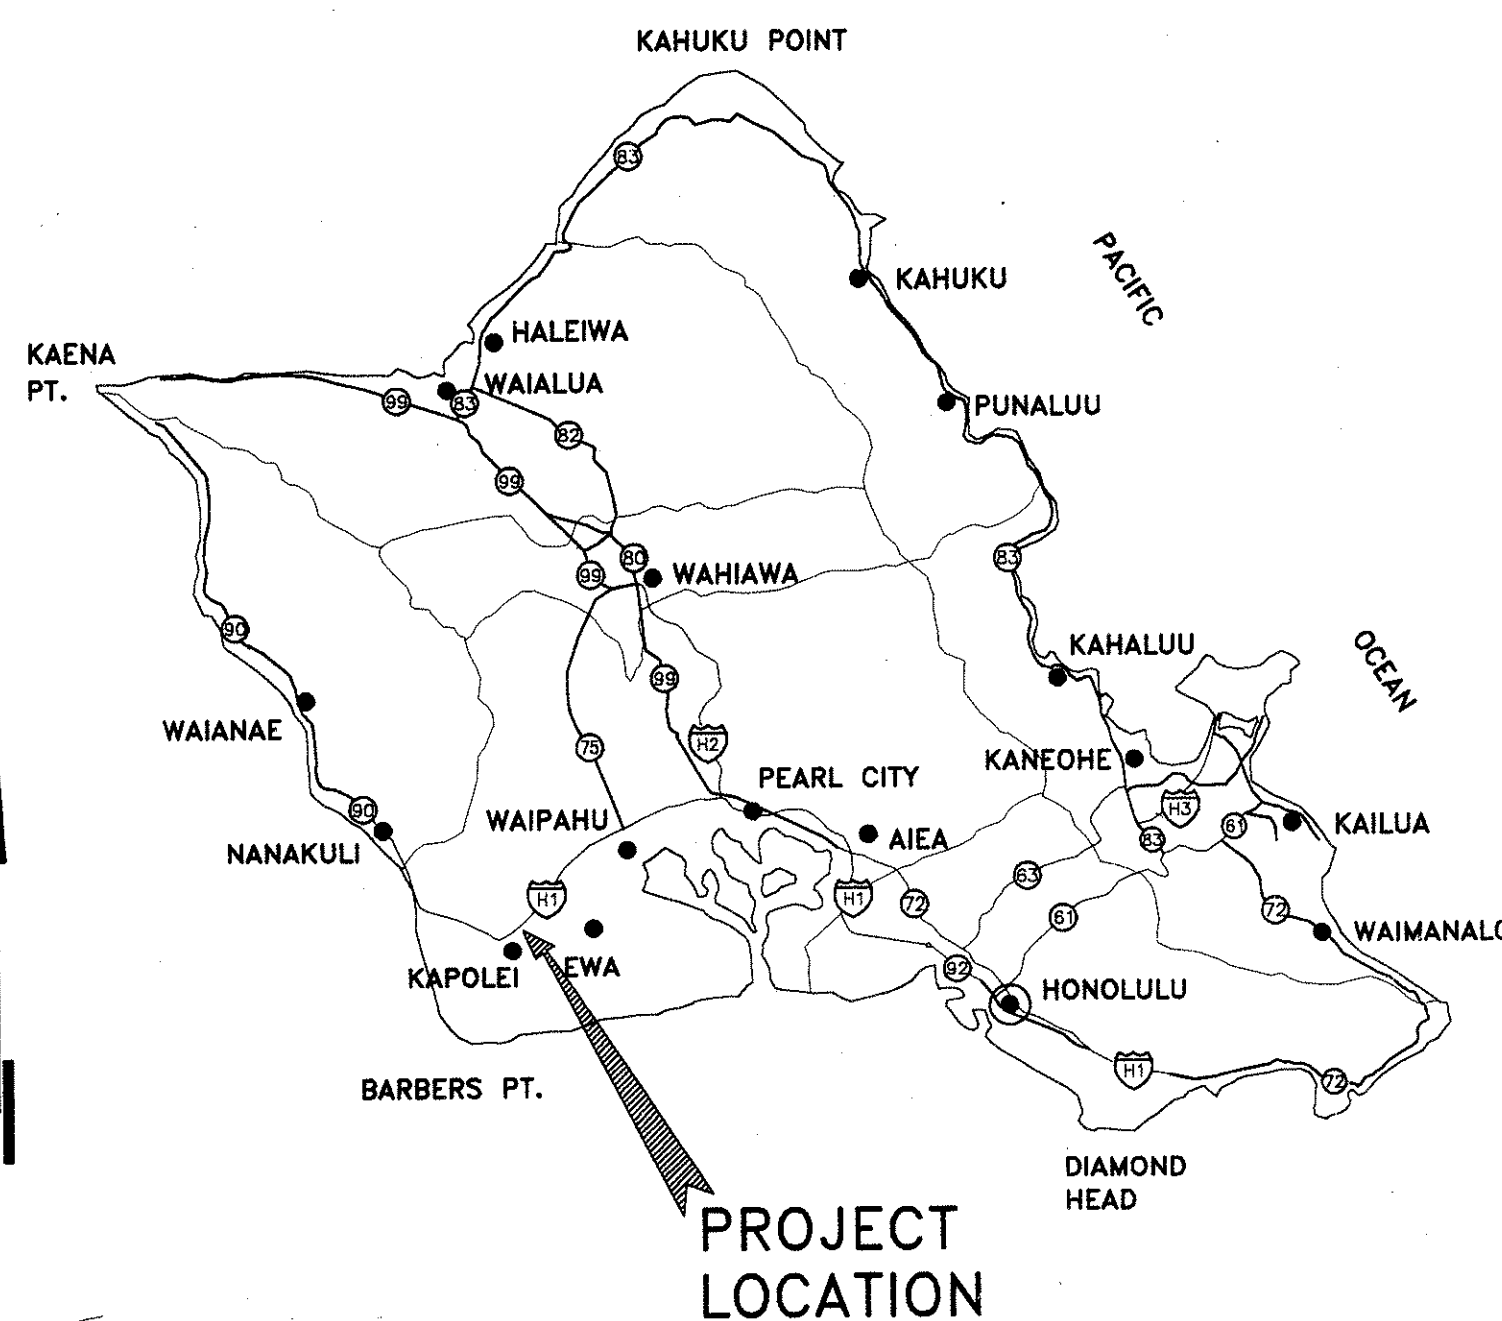

VICINITY MAP

SCALE IN MILES
0 5 10

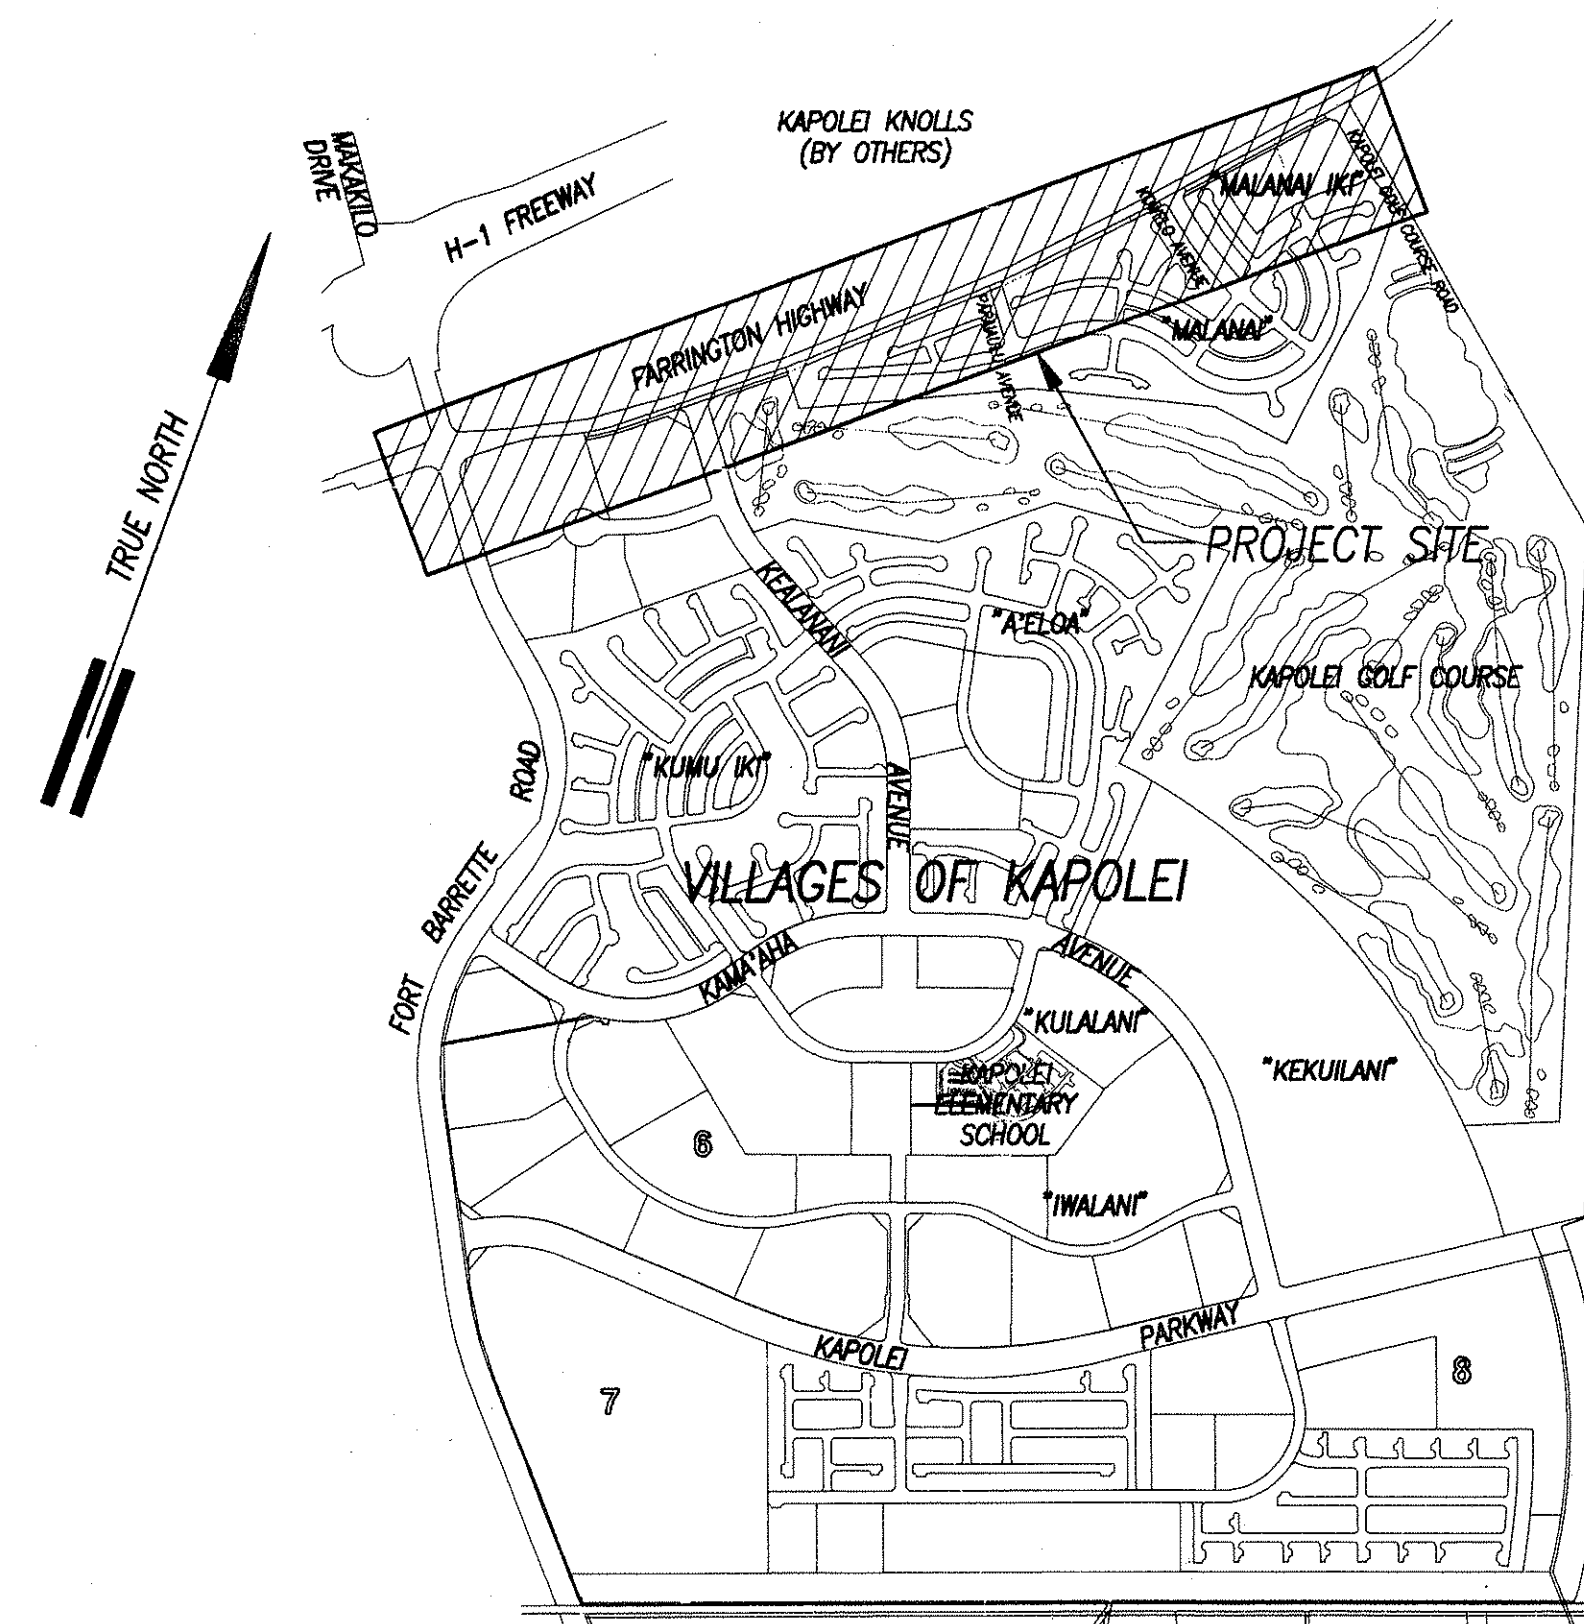

LOCATION MAP

SCALE : 1" = 1000'

APPROVED:

for Robert W. J.
DIRECTOR, DEPARTMENT OF PLANNING & PERMITTING, CITY & COUNTY OF HONOLULU

7/14/98
DATE

Robert W. J.
EXECUTIVE DIRECTOR, HOUSING FINANCE AND DEVELOPMENT CORPORATION, STATE OF HAWAII

2/6/98
DATE

Henry H. Hight
ADMINISTRATOR, HIGHWAYS DIVISION, STATE DEPARTMENT OF TRANSPORTATION, STATE OF HAWAII
(Approval granted for work within State right-of-way only. ID No. 0-97-26
letter of approval No. HWY-CM 2-2376 dated 5/18/98)

21 May 98
DATE

Robert W. J.
CHIEF, HARBORS DIVISION, STATE DEPARTMENT OF TRANSPORTATION, STATE OF HAWAII
(Approval granted for work within State right-of-way only. ID No. 0-97-26
letter of approval No. HAR-PM 2-2376 dated 5/18/98)

10/3/97
DATE

Robert W. J.
DIRECTOR & CHIEF ENGINEER, DEPARTMENT OF PUBLIC WORKS, CITY AND COUNTY OF HONOLULU

9/2/97
DATE

Robert W. J.
DIRECTOR, DEPARTMENT OF WASTEWATER MANAGEMENT, CITY AND COUNTY OF HONOLULU

9/10/97
DATE

Robert W. J.
DIRECTOR, DEPARTMENT OF TRANSPORTATION SERVICES, CITY AND COUNTY OF HONOLULU
(For construction within City right-of-way only.)

4/17/98
DATE

Robert W. J.
CHIEF, ENVIRONMENTAL MANAGEMENT DIVISION, DEPARTMENT OF HEALTH, STATE OF HAWAII

7-21-97
DATE