


FED. ROAD DIST. NO. STATE PROJ. NO. FISCAL SHEET NO. SHEETS

HAWAII HAW. 901A-01-19 2020 ADD,14S-2 167

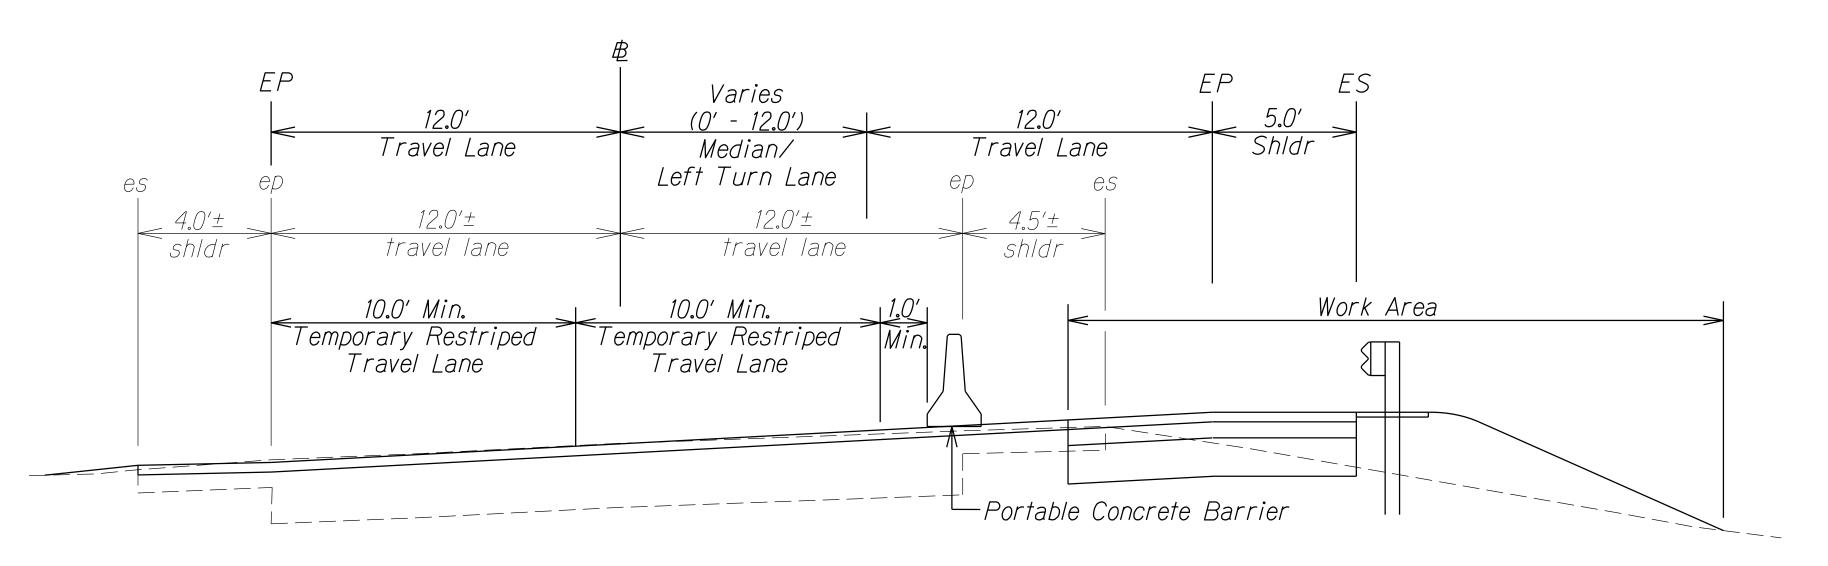



PORTABLE CONCRETE BARRIER POSITION DETAIL FOR WIDENING WORK B STA. 43+47± TO B STA. 56+03±

Scale: Not to Scale


Notes:


- 1. Inertial Barrier System shall comply with the manufacturer's recommendations/requirements and shall be paid under Contract Item No. 695.2000 Inertial Barrier System.
- 2. Place Type II Barricade w/Lamp at spacings and positions that comply with part 6 of the MUTCD, Typical Application 5, and install steady burn amber lamps on Portable Concrete Barriers @ 20.0' o.c. Installing, maintaining and removing each steady burn amber lamp including changing of batteries and bulbs shall be considered incidental to Contract Item No. 695.1000 State-Furnished Portable Concrete Barrier.
- 3. Travel Lanes shall be temporarily restriped and adjusted to a minimum of 10 feet to accommodate Portable Concrete Barrier Installation and use. Following the completion of road widening work, Travel Lanes shall be striped according to the traffic plans. This work shall be considered incidental to Contract Item No. 695.1000 State-Furnished Portable Concrete Barrier and shall not be paid for separately.
- The Contractor shall develop a Traffic Control Plan to include all necessary Traffic Control Devices. This work shall be considered incidental to Contract Item No. 645.0100 Traffic Control and shall not be paid for separately.

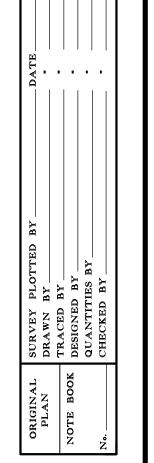


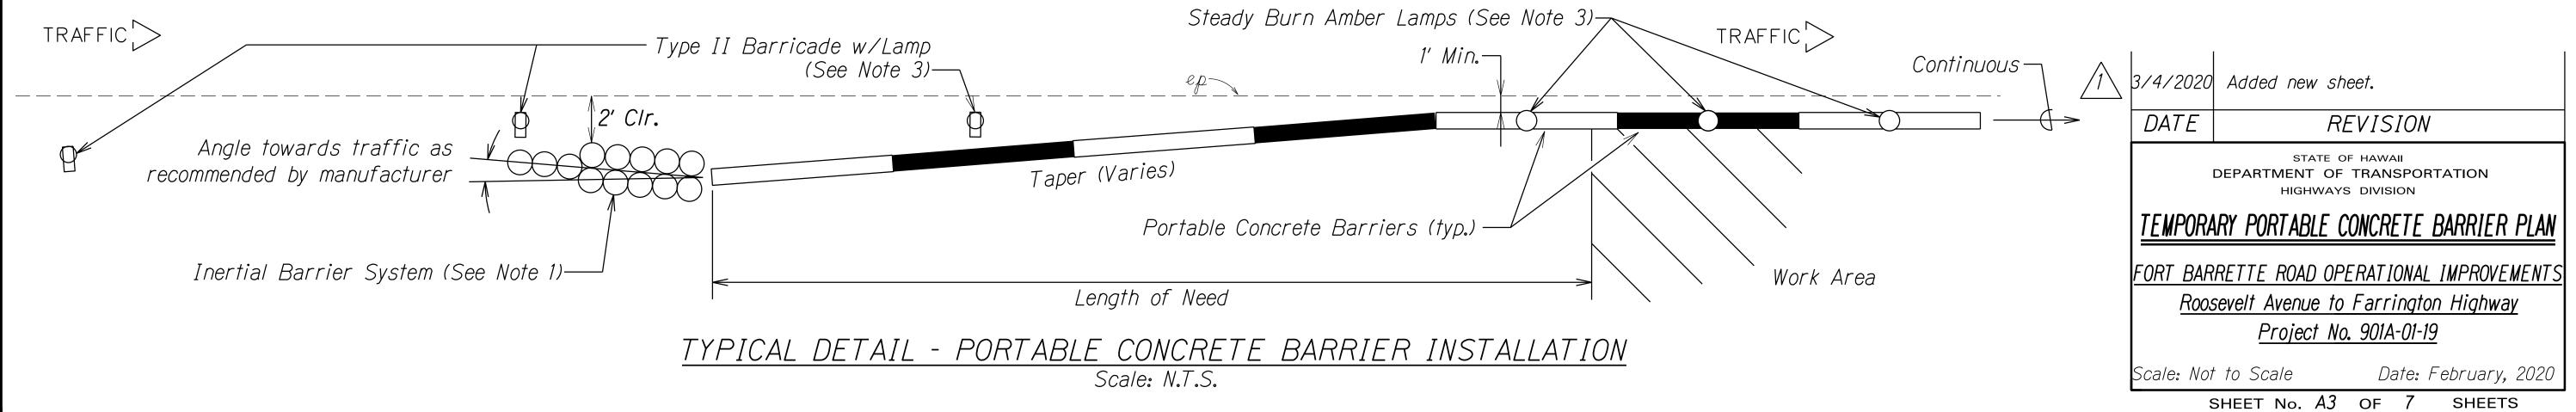

ADD. 14S-2

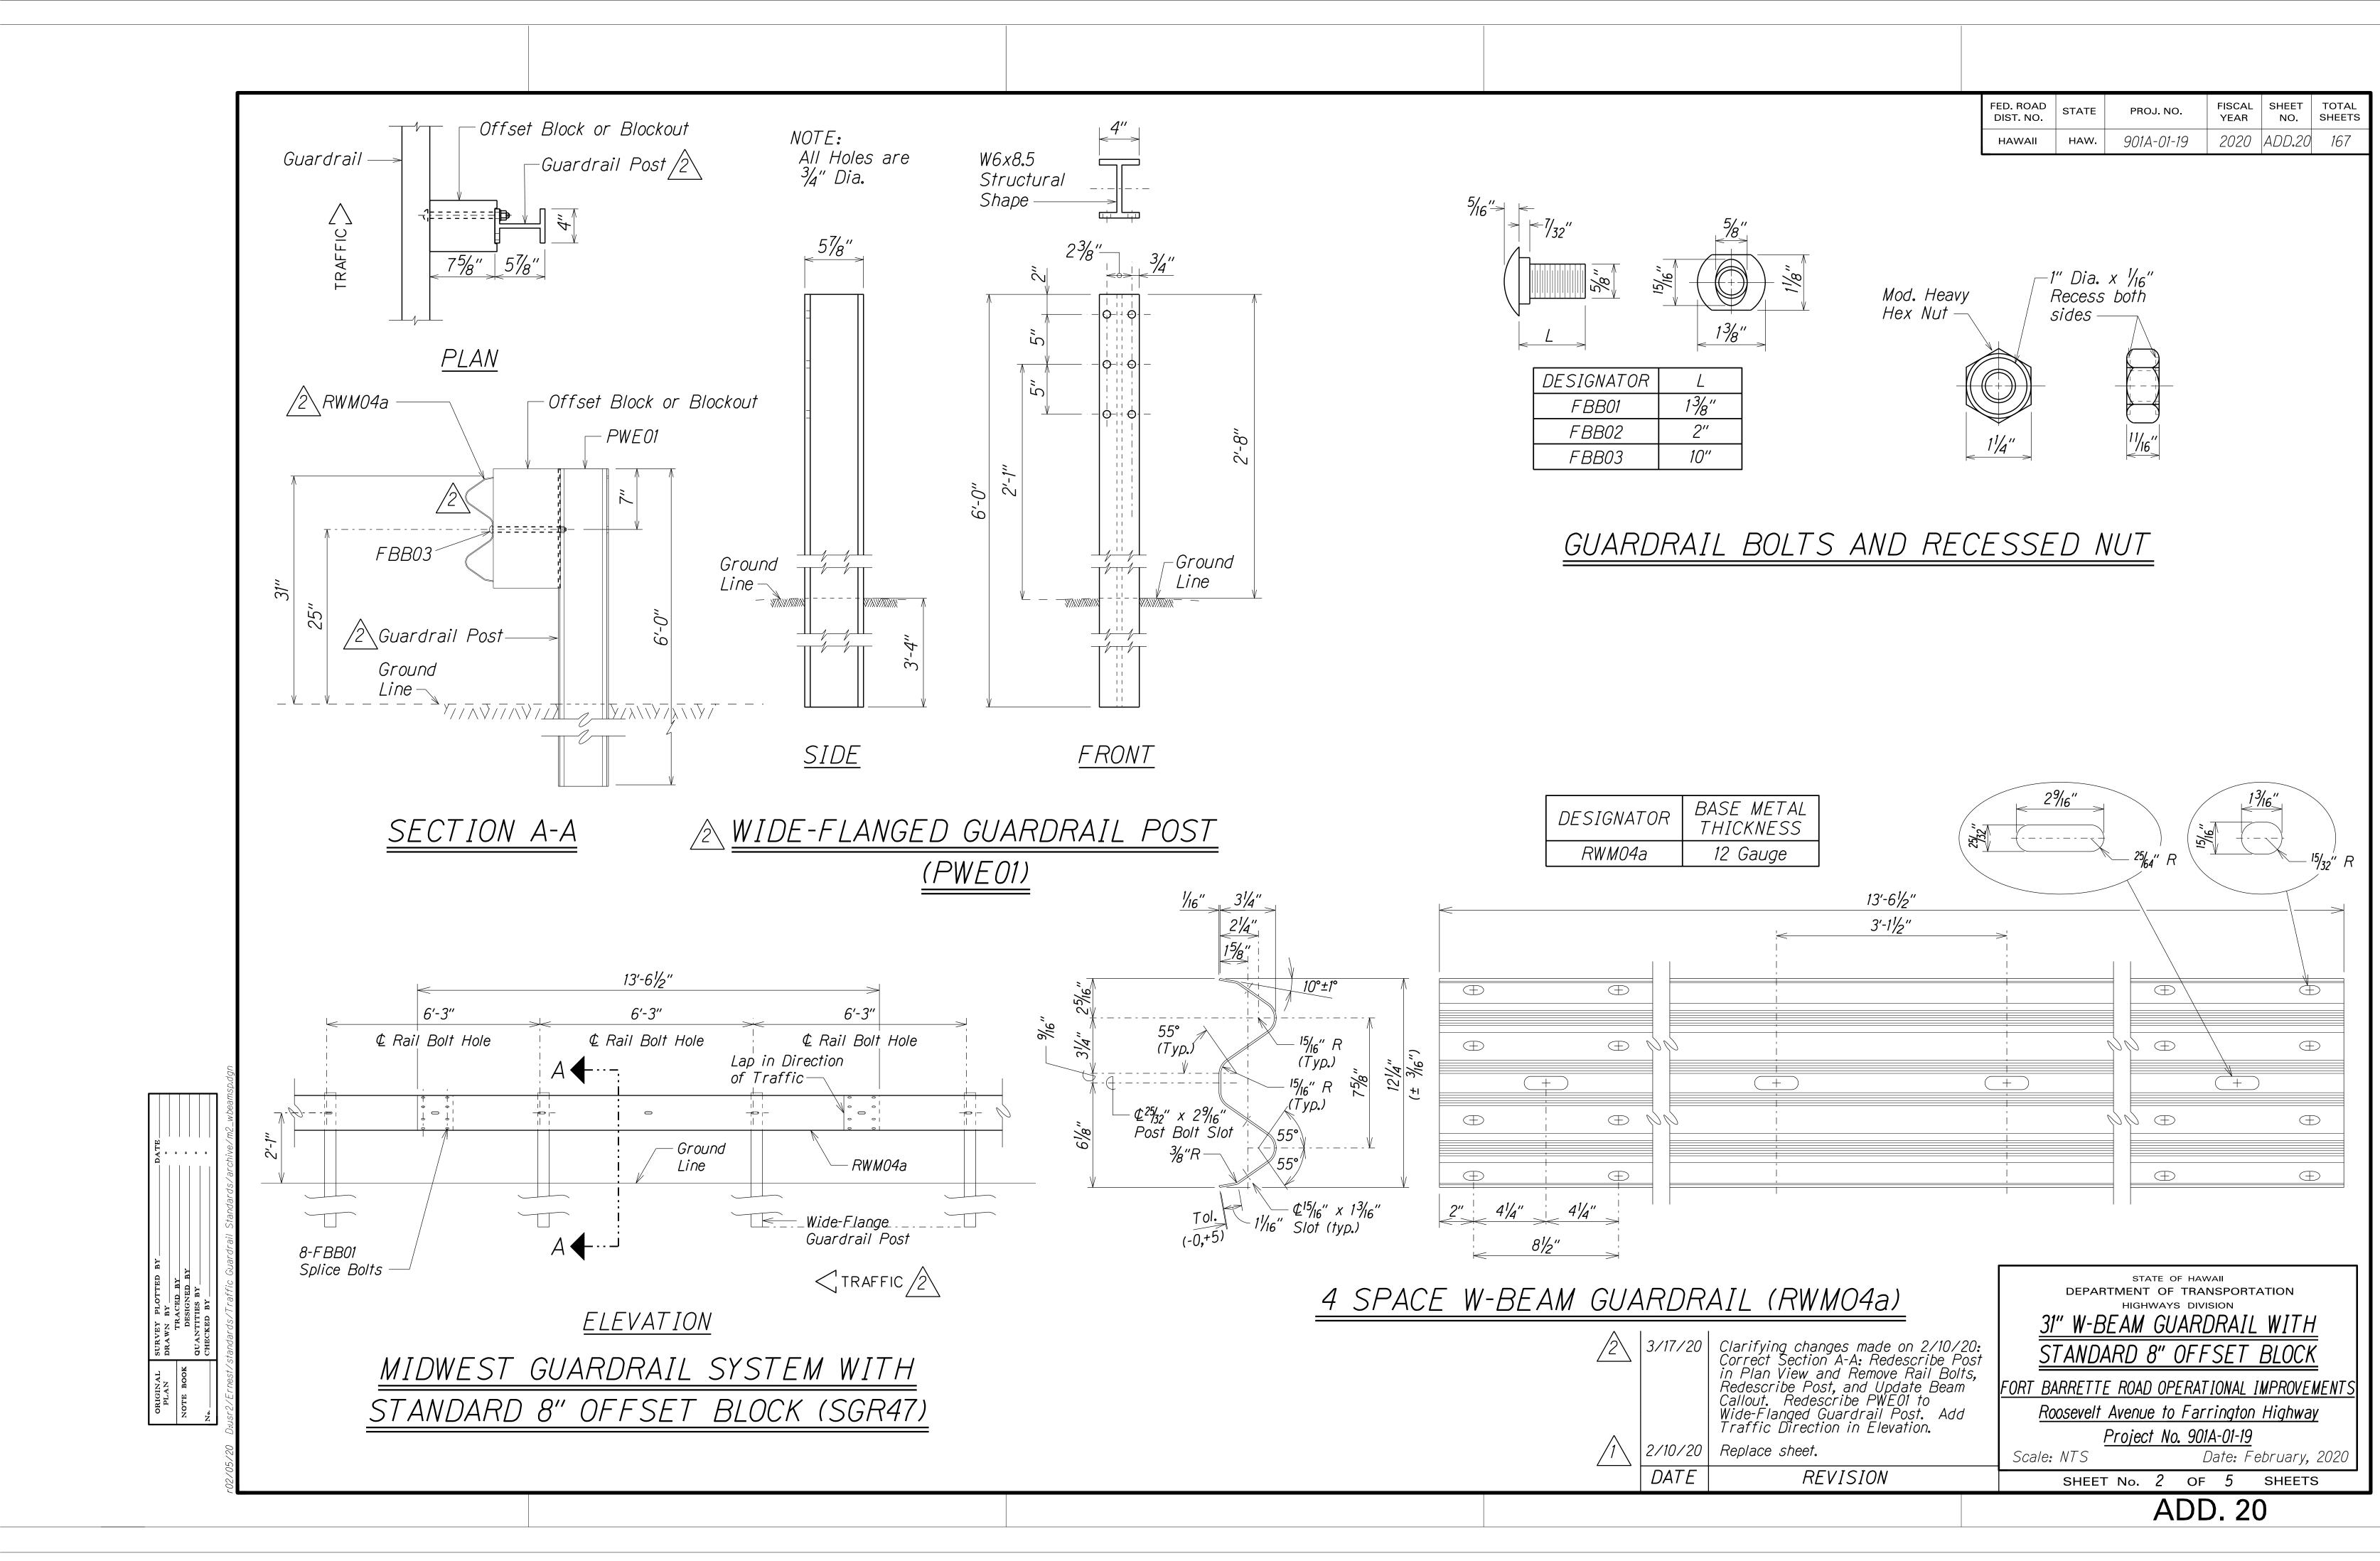

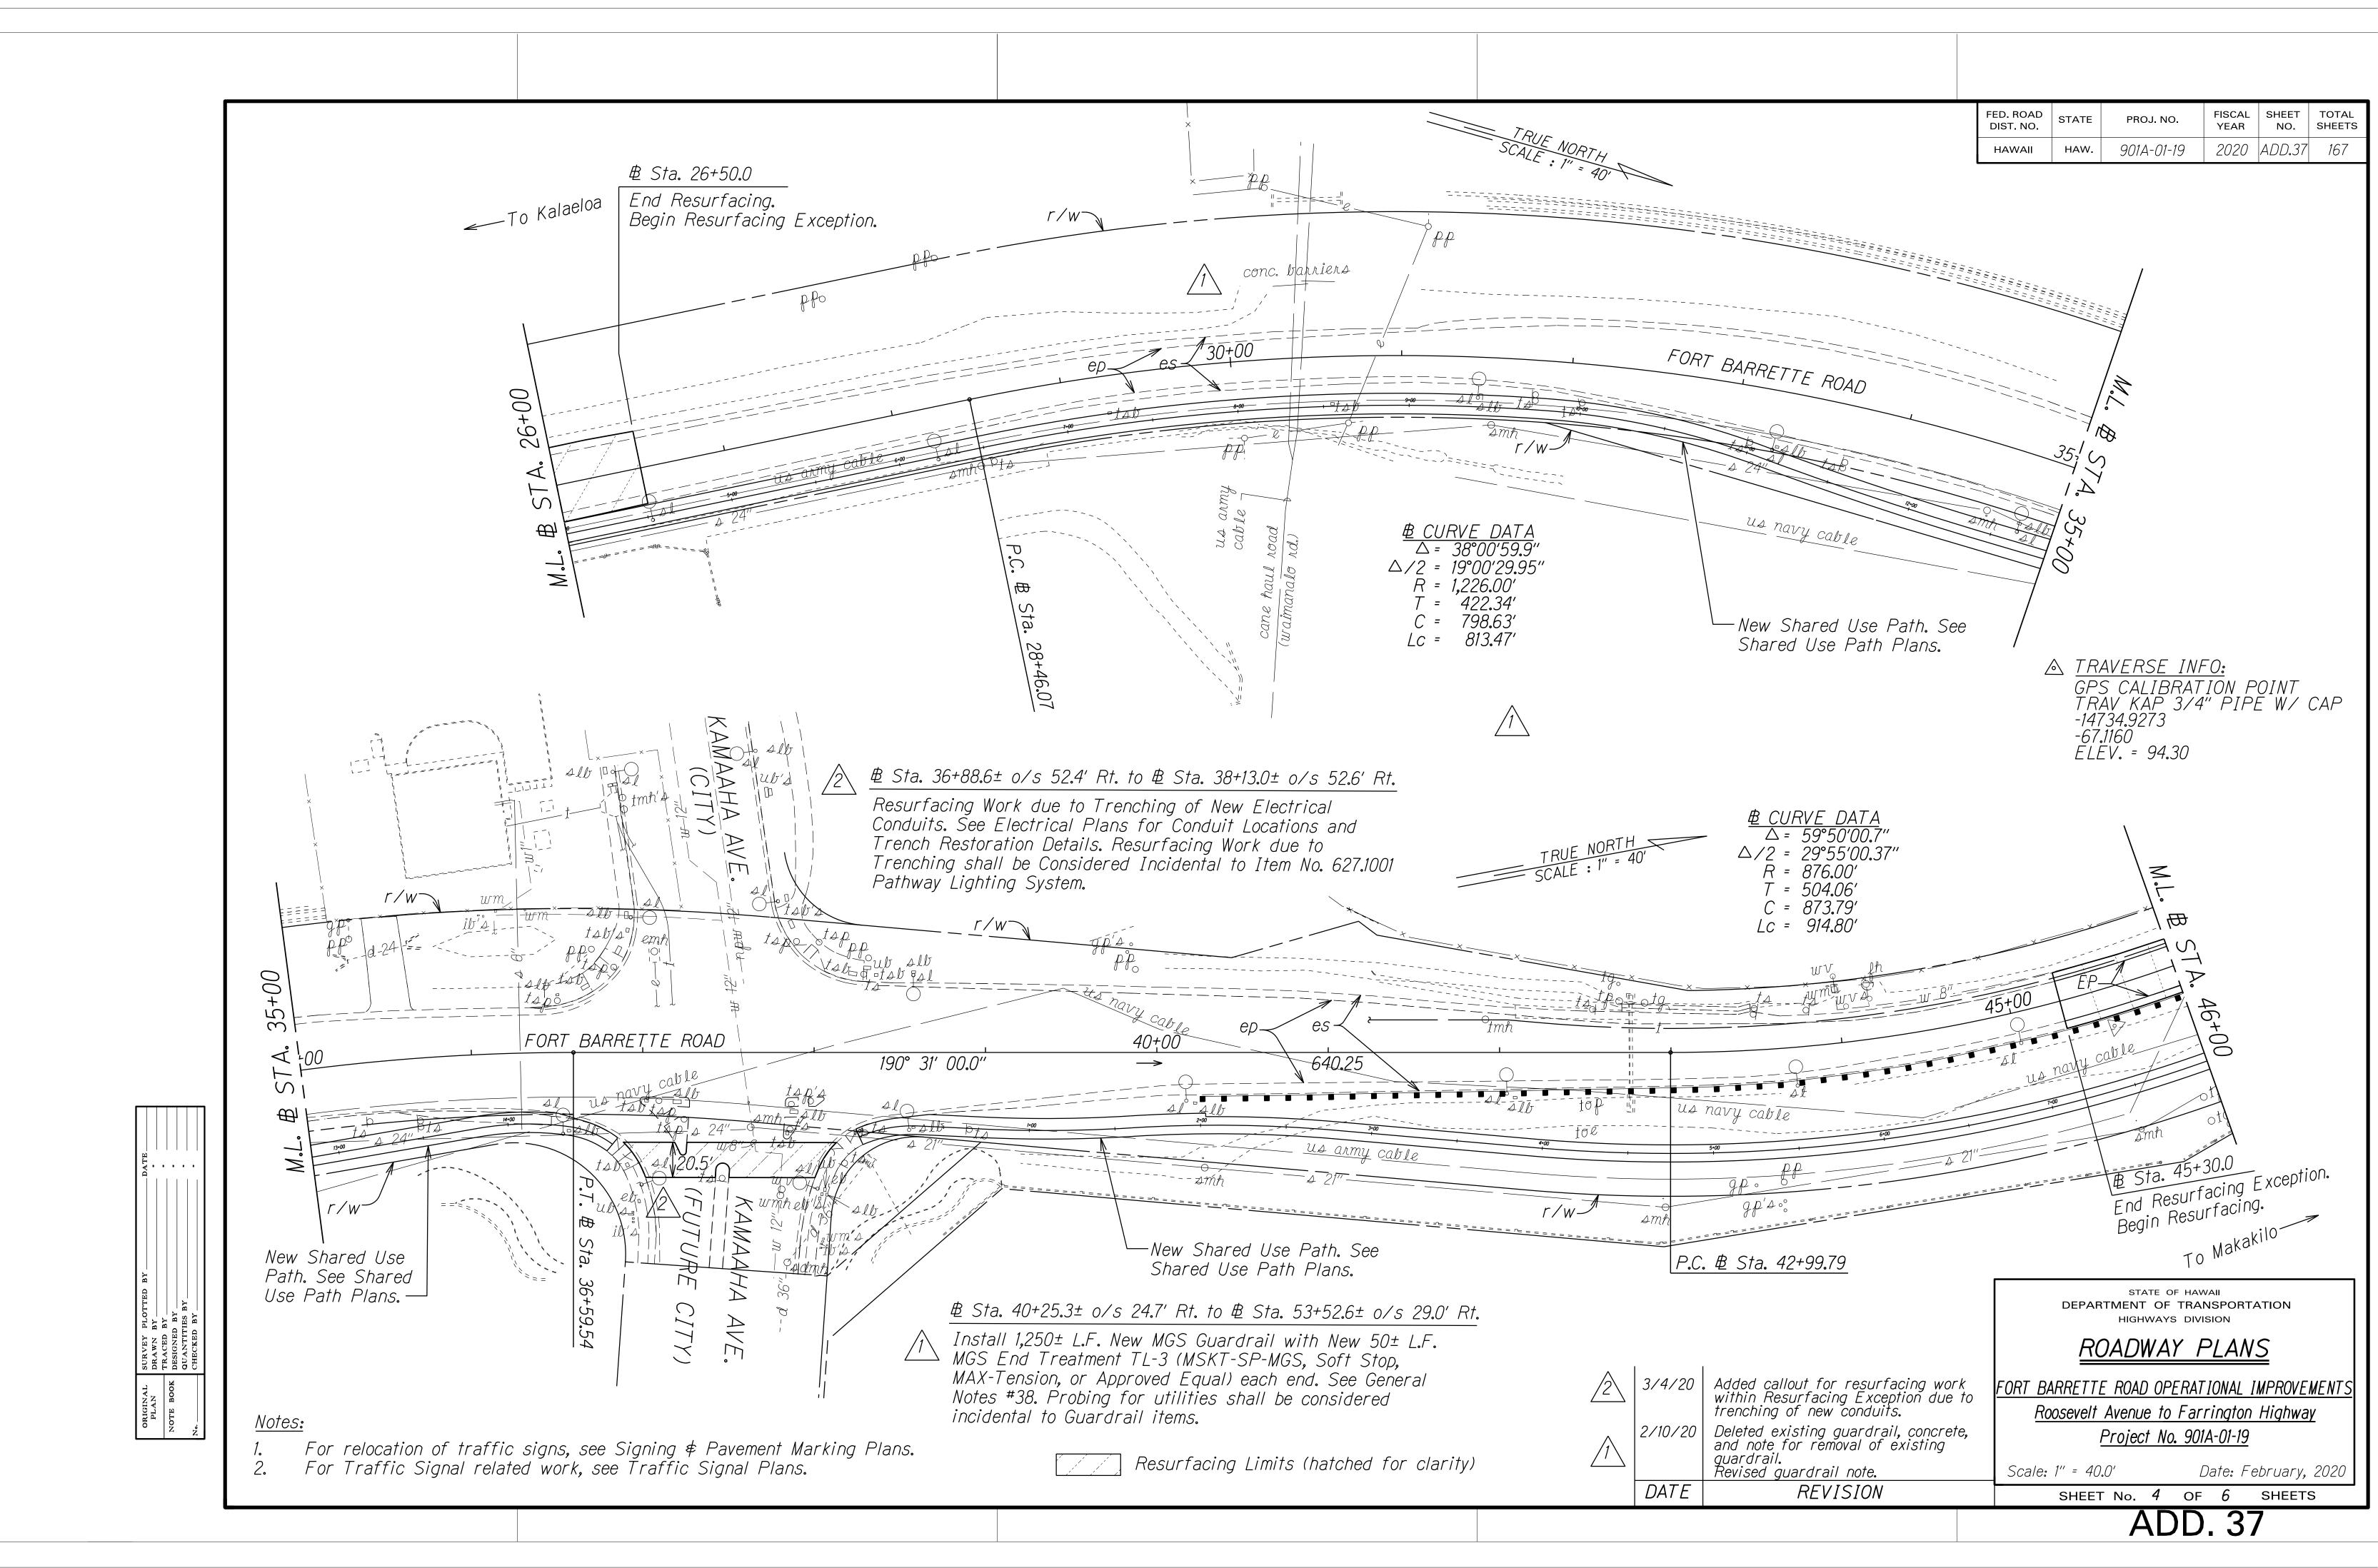

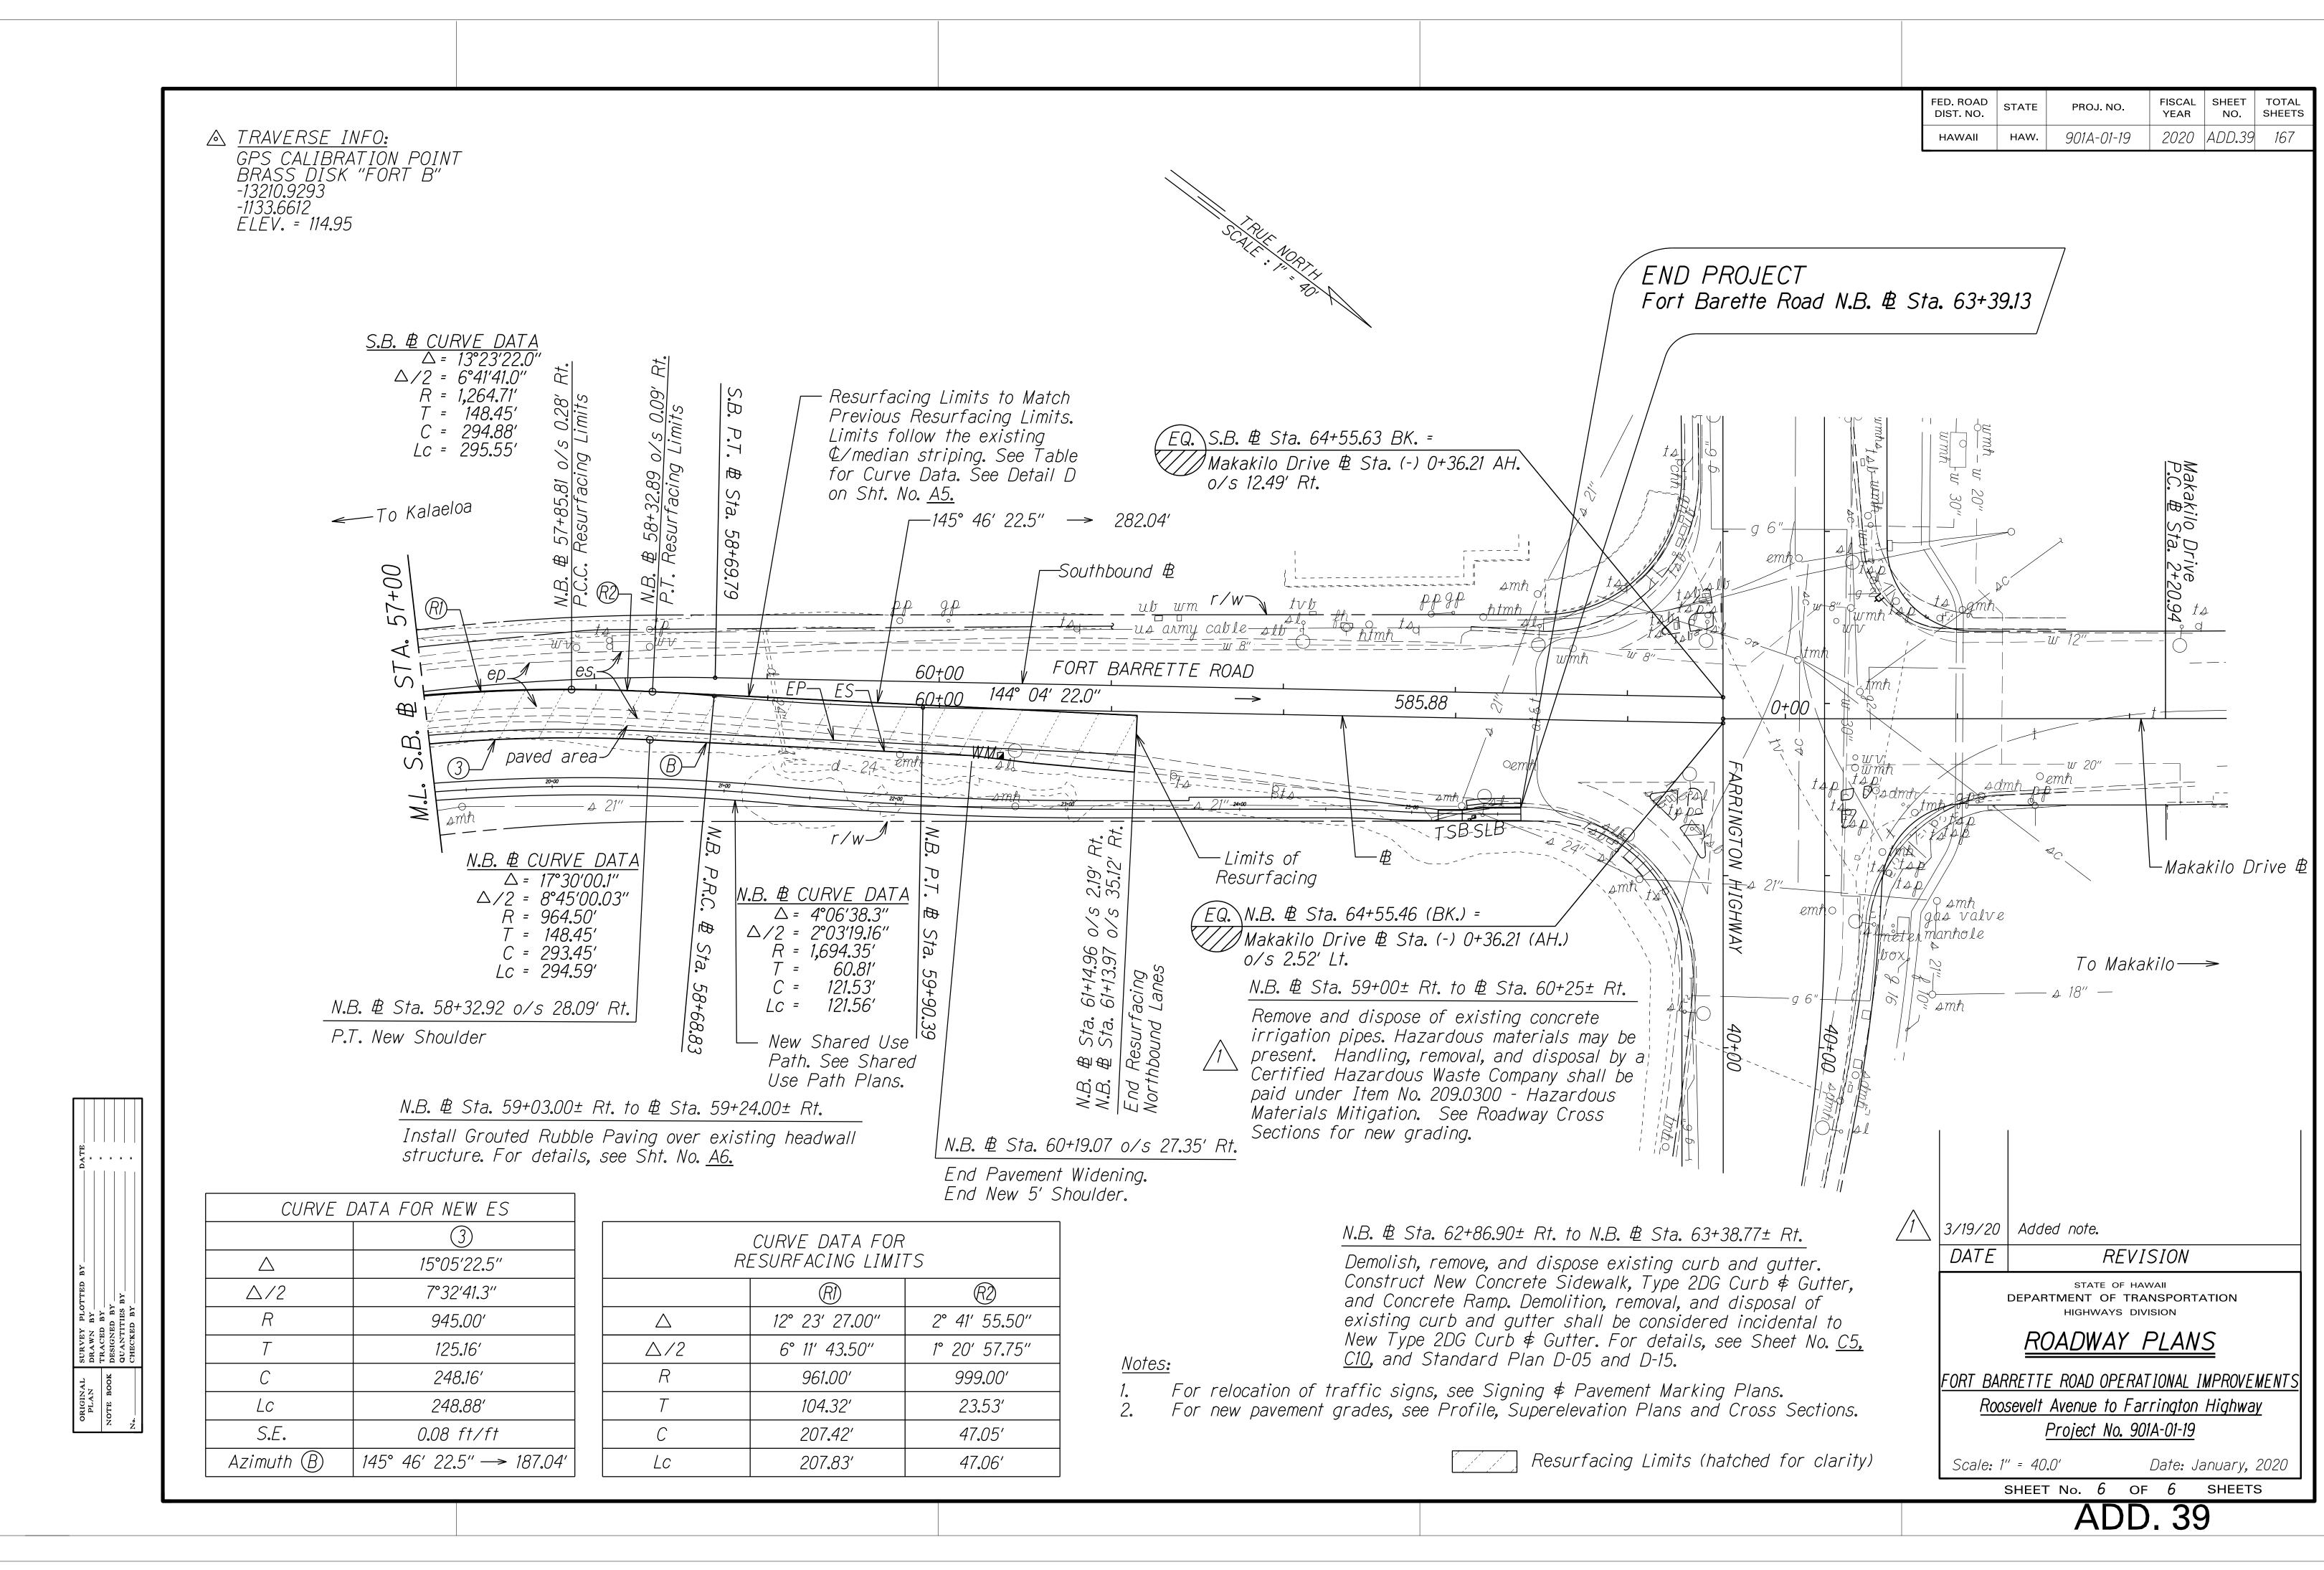

Ī	<u>LE</u>	GEND	
	Ą_	<u> </u>	
	L	<u> </u>	
		1 ш	
	==	П	
	=		
	-		
			Ш
		т п	
		П	Ш
	_		
	7		
	Ш		
		@ 	
			_

STOP

<u>LEGEND</u>	
ę – ę	- 10' White Profiled Thermoplastic Stripe - Type C Raised Pavement Markers @ 40'-0" o.c.
Q I	- 10' Yellow Profiled Thermoplastic Stripe - Type D Raised Pavement Markers @ 40'-0" o.c.
	8" White Stripe with Type C Raised Pavement Markers @ 20'-0" o.c. (Tape, Type I or Thermoplastic Extrusion)
	4" Double Solid Yellow with Type D Raised Pavement Markers @ 20'-0" o.c. (Tape, Type I or Thermoplastic Extrusion))
	4" Double Solid Yellow Stripes with Type H Raised Pavement Markers @ 20'-0" o.c. (Tape, Type II or Thermoplastic Exrusion))
	6" Yellow Edge Stripe with Type H Raised Pavement Markers @ 40'-0" o.c. (Tape, Type II or Thermoplastic Extrusion))
	4" Double Solid White Stripes with Type C Raised Pavement Markers @ 20'-0" o.c. (Tape, Type I or Thermoplastic Extrusion)
	Lane Change Restriction Marking —10' White Profiled Thermoplastic Stripe

Extrusion)

6" or 8" White Edge Stripe with Type C Raised Pavement Markers @ 40'-0" o.c. (Tape. Type II or Thermonlastic Extrusion)

4" White Guide Lines (Tape, Type III or Thermoplastic Extrusion except for bus bays)

— Type C Raised Pavement Markers @ 20'-0" o.c. 4" White Stripe (Tape, Type I or Thermoplastic

Transverse Median Marking (Tape, Type II or Thermoplastic Extrusion)

Transverse Shoulder Marking (Tape, Type II or Thermoplastic Extrusion)

Channelizing Island or Deceleration Lane Gore (Tape, Type II or Thermoplastic Extrusion)

Crosswalk and Stop Line. All Stop Lines shall be 10'-0" from Crosswalk unless otherwise noted. The circled number indicates the number of lanes for payment (Tape, Type III or Thermoplastic Extrusion)

Pavement Arrow (Tape, Type III or Thermoplastic

Pavement Word (Tape, Type III or Thermoplastic Extrusion)


10' Yellow Profiled Thermoplastic Stripe Type D Raised Pavement Markers @ 40'-0" o.c. Type H Raised Pavement Markers (Reflective Surface facing no-passing direction) 4" Single Solid Yellow Stripe (Tape, Type I or Thermoplastic Extrusion)

Extension of Edge Line, 4" Wide x 2'-0" Long White Stripe @ 10'-0" o.c. w/Type C Markers @ 40'-0" o.c. (Tape, Type III or Thermoplastic Extrusion)

NOTES

- 1. Layout of payement markings and striping shall be done by the Contractor and approved by the Engineer prior to any installation work.
- 2. Fxisting payement markings not incorporated in the final traffic pattern shall be removed as directed by the Engineer. Costs shall be incidental to the various pavement marking items.
- 3. Raised pavement markers shall not be installed within crosswalks.
- 4. Final locations of all signs shall be approved by the Engineer prior to any installation work.
- 5. Existing signs not shown on these plans shall remain as posted unless otherwise directed by the Engineer. Removal and disposal of existing signs and/or posts as designated on these plans shall be incidental to the various signing items.
- 6. Final locations of all Stop Lines shall be approved by the Engineer prior to installation.
- 7. All pavement striping shall be as noted on the legend or plans.
- 8. All preformed payement marking tapes over existing payement shall be applied with an approved primer as recommended by the tape manufacturer and as approved by the Engineer. The primer shall be allowed to dry to the tacky stage prior to tape application.
- 9. All pedestrian warning signs with supplemental sign shall be on a fluorescent vellow-green retroreflective background with a black legend and border.



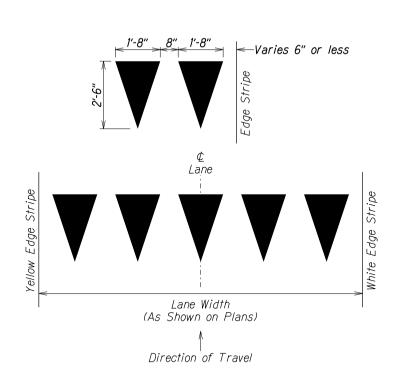


FED. ROAD

STATE


PROJ. NO. 901Δ-01-19 SHEET NO.


2020 ADD 52 167

YIELD LINE

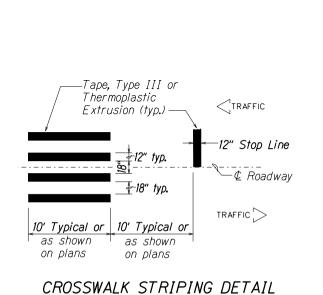

Not to Scale

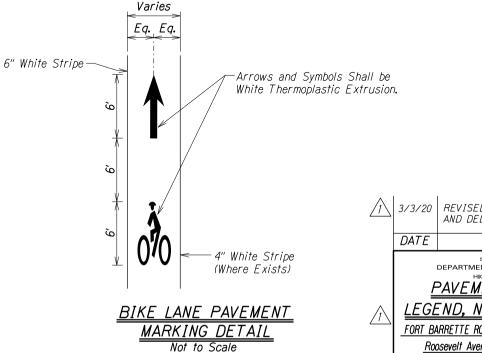

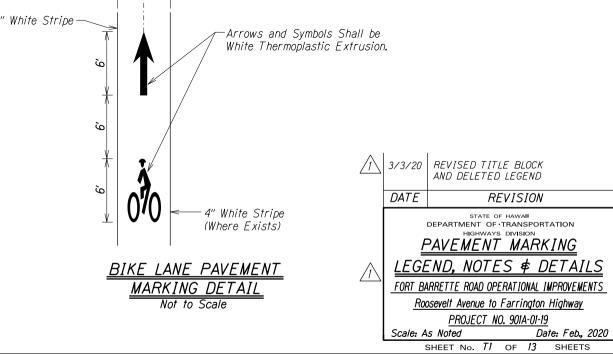





TRAFFIC CONTROL NOTES FOR CONSTRUCTION COORDINATION FORT BARRETTE ROAD OPERATIONAL IMPROVEMENTS, 901A-01-19


- 1. Lane closures will be allowed only from 7:30 a.m. to 2:00 p.m. Monday through Friday.
- 2. In additional to A.C. paying and restriping work, this project also includes:
 - a. Roadyway widening (vicinity of Kapolei Regional Park, Kapolei Parkway intersection)
 - b. Traffic signal modifications (Kapolei Parkway)
 - c. Upgrade railroad crossing (North of Roosevelt Ave.)
 - d. New traffic signal installation (Roosevelt Ave. intersection)
 - e. Shared-use path and lighting (entire project length)
- 3. The Contractor shall coordinate his work to minimize impacts to existing traffic patterns. Multiple lane-closures shall require approval by the Engineer. If approved, multiple lane-closures shall be implemented with adequate traffic queue storage for each lane-closure location. The Engineer may suspend multiple lane-closures if cumulative work zone traffic delays exceeded 30 minutes.
- 4. Per Standard Specs Sec. 645.03 Construction, the Contractor shall submit site-specific Traffic Control Plan (TCP) to the Engineer for acceptance at least 15 working days before work starts.
- 5. If excess traffic delays (equal to or above 30 minutes) are observed in the field by the Engineer, the Contractor shall take corrective measures and a modified TCP be submitted to the Engineer for acceptance at least 15 working days before such work could resume.
- 6. If lane shift or change to existing traffic patterns must be implemented beyond normal work hours, all conflicting pavement markings shall be removed, and temporary markings shall be installed before traffic patterns are changed. After completion of the work, temporary markings shall be removed, and normal traffic patterns restored.
- 7. The Contractor shall coordinate with nearby Kapolei High School (KHS) administration staff, (808) 305-8000, when working between Rooosevelt Ave. and Kapolei Parkway. This coordination shall include, but not limited to, maintaining access to school ground during special events at KHS.
- 8. The Contractor shall coordinate all work with the Hawaiian Railway Society (HRS), (808) 681-5461, when working adjacent to or within the railroad R.O.W.
- 9. The Contractor shall notify the Department of Transportation Services (DTS), Public Transit Division, (808) 768-8396, and the Oahu Transit Services, Inc. Bus Operations, (808) 848-4578, or (808) 852-6016, and Paratransit Operations, (808) 454-5041, or (808) 454-5020, of any closure of street, sidewalk or bus stop at least two (2) weeks prior to starting construction operations.
- 10. The Contractor shall notify the Traffic Signals and Technology Division, Department of Transportation Services (DTS), (808) 768-8388, three (3) days prior to commencing work on the existing and new traffic signal systems.
- 11. The Contractor shall notify the Hawaii Housing Finance and Development Corp. (HHFDC), (808) 587-0620, when working in the vicinity of Kapolei Parkway and Kamaaha Ave. intersections, which are main access roads for the Villages of Kapolei maintained by HHFDC.
- 12. The Contractor shall notify the Hawaii Community Development Authority (HCDA), (808) 594-0300, when working outside of HDOT R.O.W. in the vicinity of Enterprise Street, which is the main access road to nearby Kalaeloa Airport maintained by HCDA.
- 13. The Contractor shall notify the Hawaii FBI Headquarters, (808) 566-4300, when working in the vicinity of Roosevelt Ave. intersection for access coordination to the facility.
- 14. Maintain abutting owners' existing access until replacement access is usable. Obtain permission from abutting owners, including conditions for closing existing access. Submit copy of agreement with abutting owners before beginning work in the affected area.
- 15. Per Standard Specs Sec. 645.03(F) Lane Closures, before scheduling work, submit requests for detours and lane closures as follows:
 - (1) Detours 8 weeks before implementing detours.
 - (2) Lane closures 6 weeks before implementing lane closures.

Detours or lane closures will not be allowed before the Engineer accepts detour or lane closure requests.

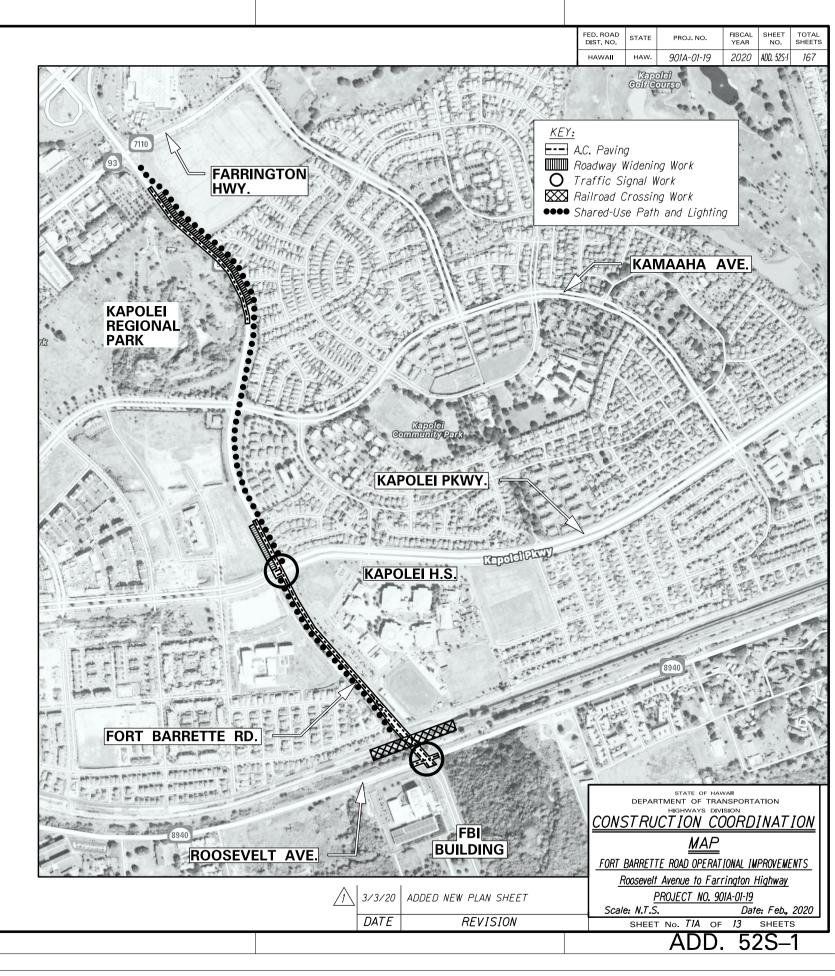



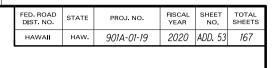

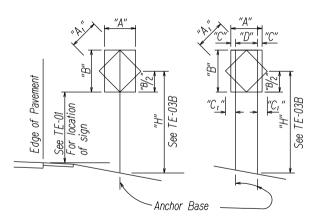


<u>1 - POST</u> "A" or "A," less than 36"

<u>2 - POST</u> "A" or "A," less than 60"


"A" or "A,"	"C"	"C,'
Less than 36"	6"	-
Greater than 36" and less than 48"	9"	19"
Greater than 48"	12"	24"

NOTE: Frame stiffeners are required when D is greater than 24" See General Notes.

TYPICAL INSTALLATION

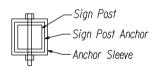

TOP VIEW

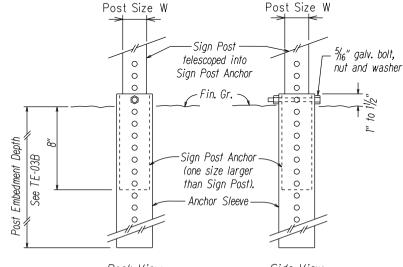

<u>Back View</u> <u>Side View</u> SIGN POST INSTALLATION

ANCHOR BASE DETAIL

Not to Scale

GENERAL NOTES

1. <u>Design Specifications</u>:

(A) "Traffic Signal Supports and Foundations design shall conform with the AASHTO LRFD Specifications for Structural Supports for Highway Signs, Luminaires and Traffic Signals, 1st Edition, with latest Interim Revisions and as modified by HDOT Memorandum with subject title, "Changes to Design Criteria for Bridges and Structures" (Letter No. HWY-DB 2.5098) dated January 8, 2018."

2. Loads:

- (A) Basic Wind Speed: 105 mph.
- (B) Recurrence Interval of 10 years.


3. Materials:


- (A) Post shall conform to the Standard Specifications.
- (B) All connection bolts shall be AASHTO M164 bolts and anchor bolts shall be AASHTO M314-105 bolt.
- (C) Lap splice nuts and bolts shall be M180, with an ultimate tensile strength of 180 ksi, min.
- (D) Aluminum members and surfaces in contact with structural steel shall be isolated with neoprene material as approved by the Engineer.

4. General:

- (A) See General Notes on B-01, TE-01, and TE-03B for additional information.
- (B) All square tube posts shall be 12 gauge unless otherwise specified or shown on the plans.
- (C) Square tube posts shall be perforated with \$\frac{1}{16}\$"\$\notin\$ holes, 1" o.c., 4 sides, along entire length of post.
- (D) All accessories, fittings and stiffener details (as required) shall be submitted to the Engineer for approval 20 days prior to installation.
- (E) Alternate designs in accordance with the plans and specifications shall use the Service Load Design Method and shall be stamped by a registered structural engineer of the State of Hawaii and submitted to the Engineer for approval.
- (F) All sign support posts without break away anchor base shall be outside of the clear zone or shielded by an appropriate traffic barrier system. The traffic barrier system shall be submitted to the Engineer for his approval.
- (G) The Contractor shall use templates while installing the anchor bolts.

 Anchor bolts shall be vertical.
- (H) Excavation and backfill shall be considered incidental to the cost of the sign foundation.

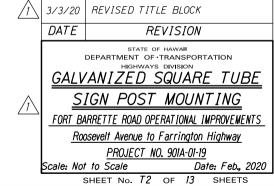

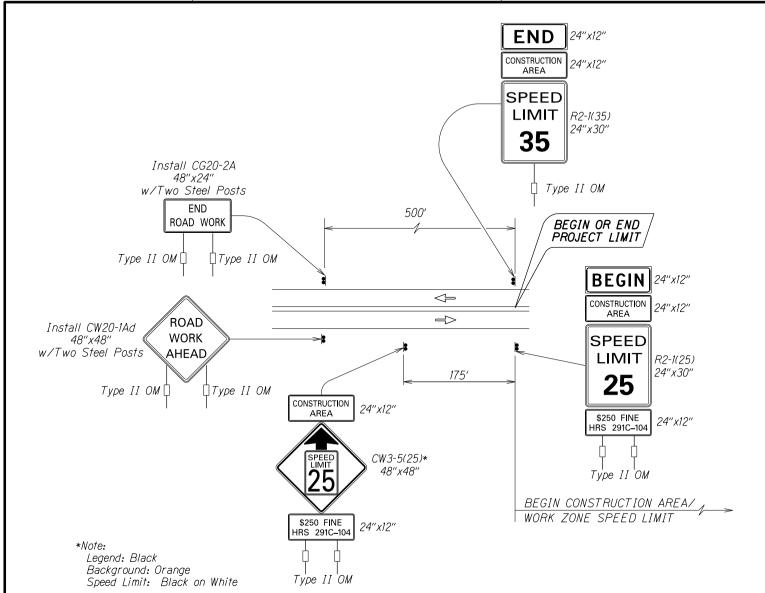

TYPICAL DETAIL FOR CONSTRUCTION SIGNS
ON TWO LANE OR MULTILANE UNDIVIDED LOW SPEED HIGHWAY

Not to Scale

HAWAII HAW. 901A-01-19 2020 ADD. 54 167

SHEET NO.


EED BOAD


STATE


Work Zone Notes:


- 1. This Work Zone Sign Plan is intended for use on long-term stationary work zones/construction phases (3 days or more). All work zones or construction phases less than 3 days duration will use Traffic Control Plans shown in Section 645 of the Standard Specifications and/or Special Provisions.
- 2. All existing regulatory speed limit signs with posts within the work zone/project limits shall be removed and replaced with work zone speed limit sign assemblies (R2-1(25) and CW3-5(25) with "CONSTRUCTION AREA" and "\$250 FINE HRS 291C-104" Supplemental Signs).
- 3. Construction sign assemblies shall be installed on both the approaching and trailing ends of each work zone as shown on this plan.
- 4. Each construction warning sign shall have a minimum of two (2) Type II OM. Each work zone speed limit assembly shall have a minimum of one (1) Type II OM. Installation of each Type II OM shall be considered incidental to Item No. 645.0100 Traffic Control.
- 5. Upon the completion of all physical work or as directed by the Engineer, all construction signs and work zone speed limit assemblies shall be removed. All speed limit signs and posts that were existing at the start of the project within the work zone/project limits shall be restored back to their original locations and configurations.
- 6. Placement of construction signs shall not obstruct the path of pedestrians and bicyclists.
- 7. The removal and restoration of existing regulatory speed limit signs with new posts along with the installation, maintenance and removal of work zone speed limit sign assemblies shall be considered incidental to Item No. 645.0100 Traffic Control.




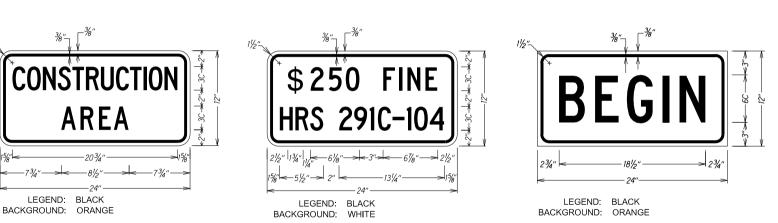


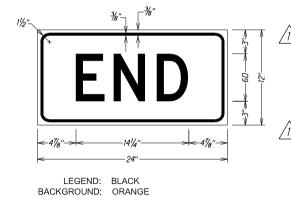


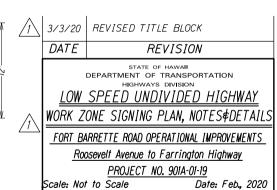


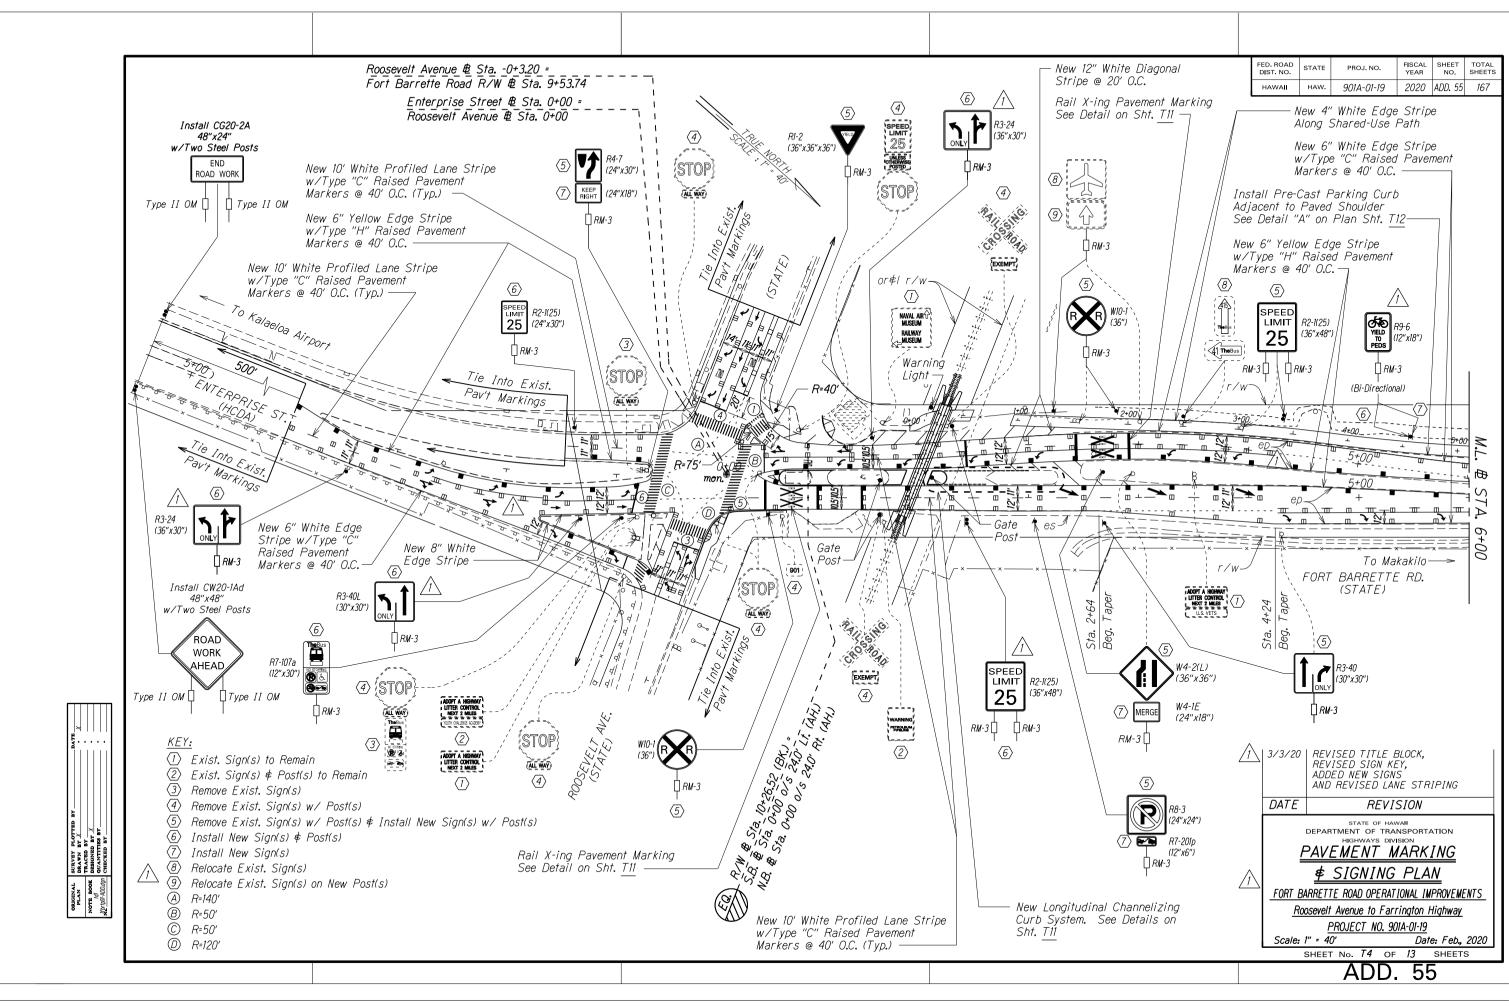


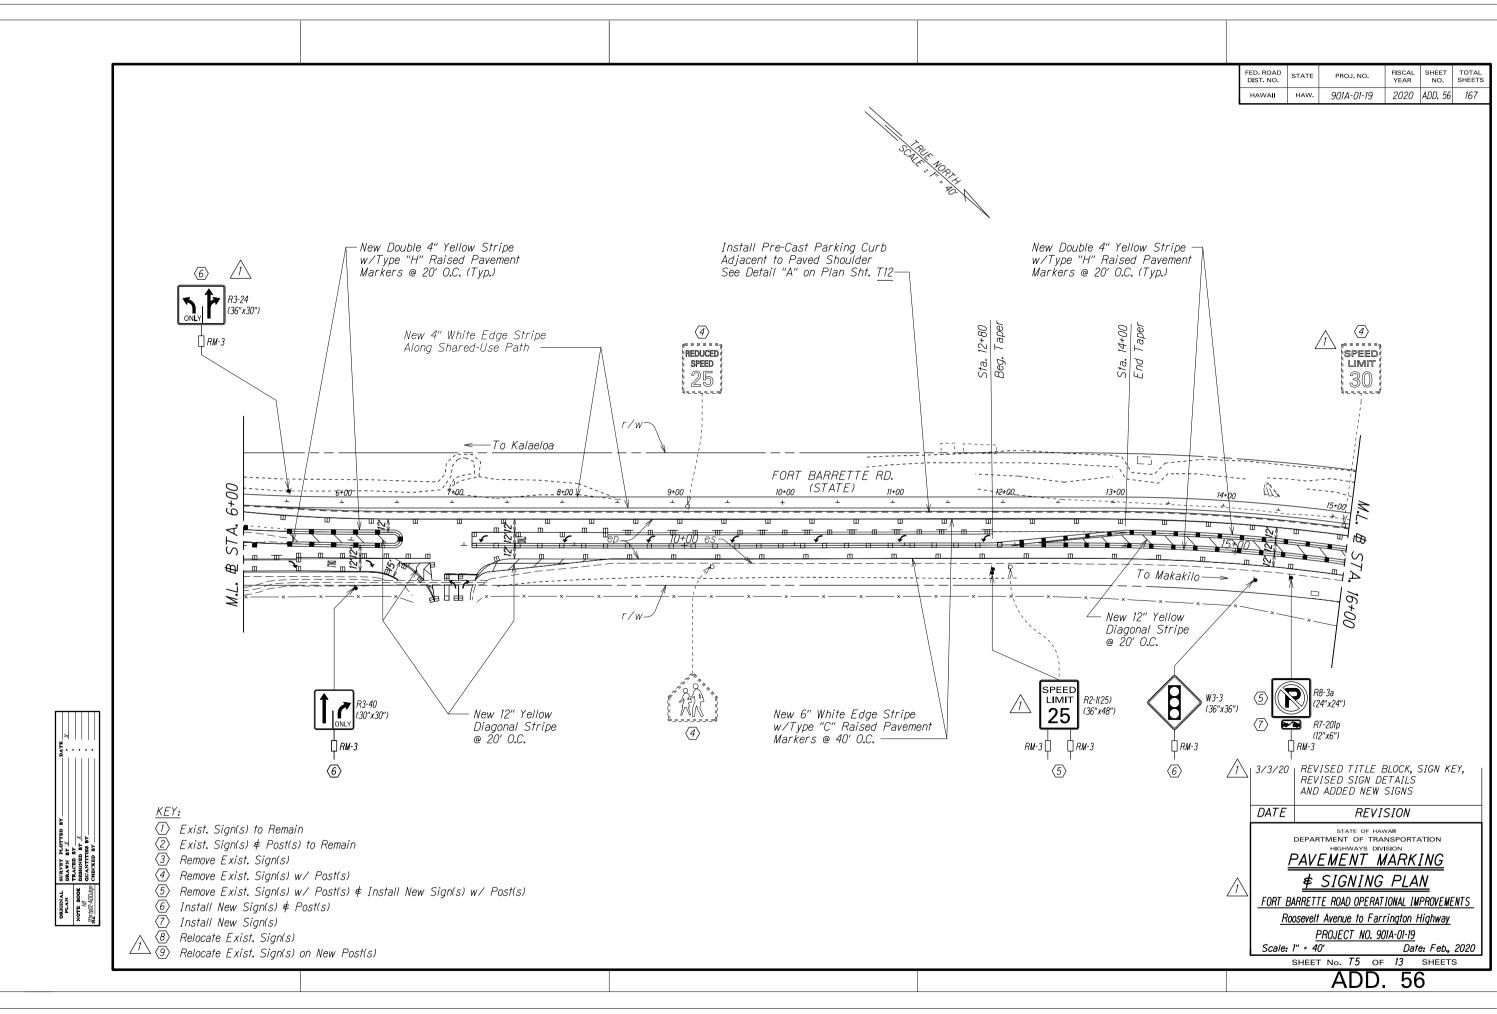

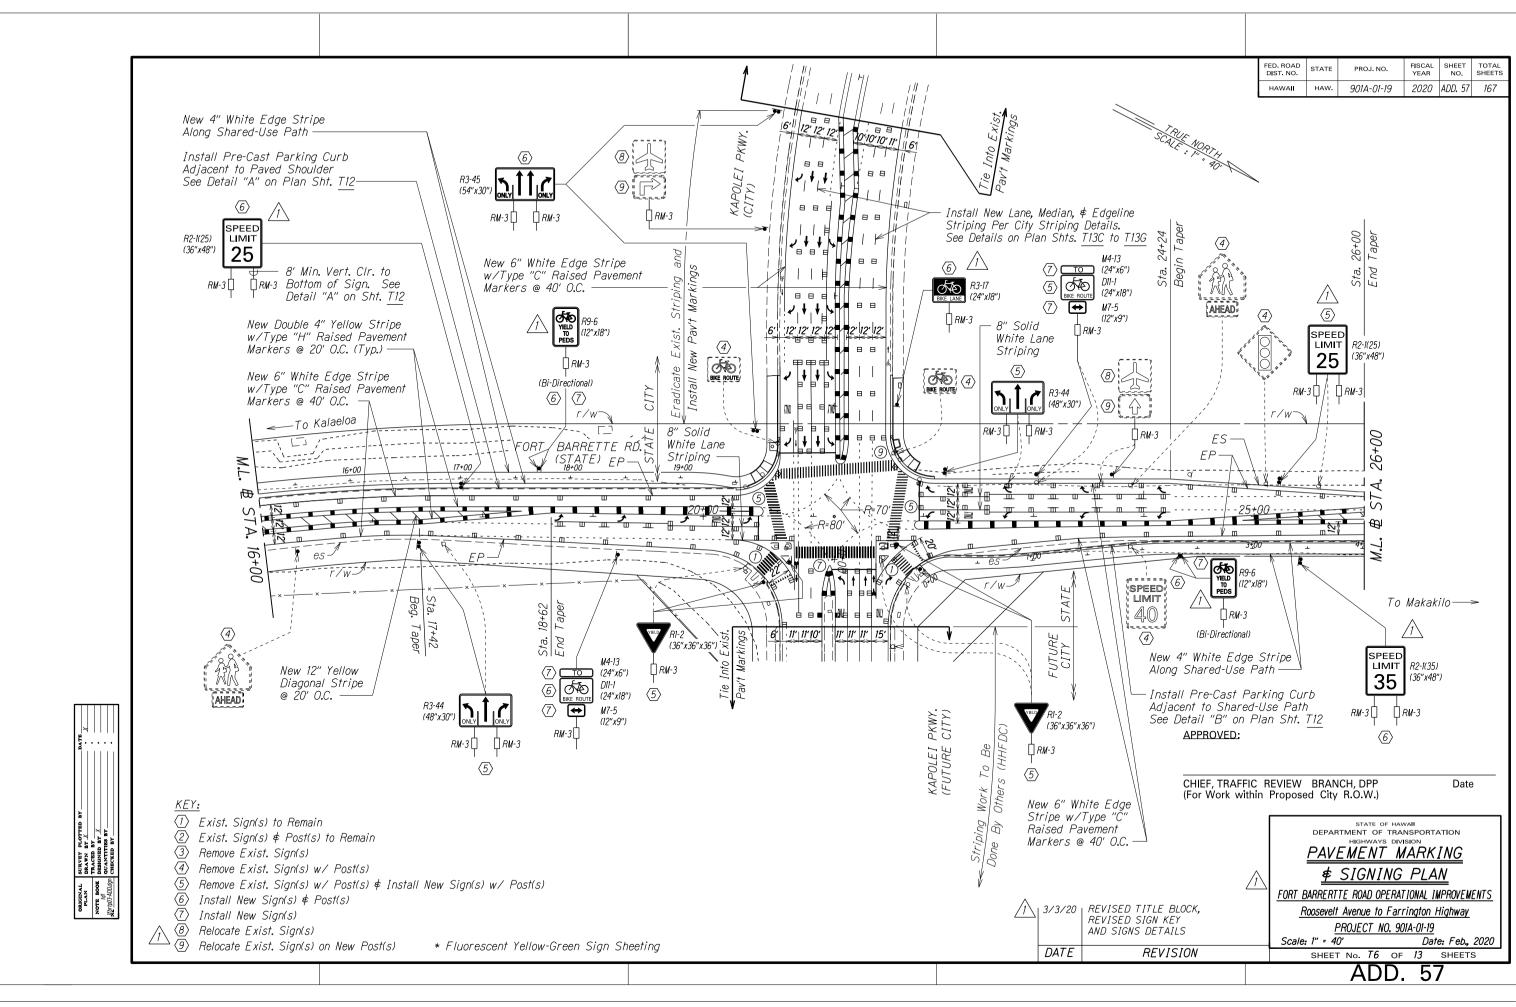

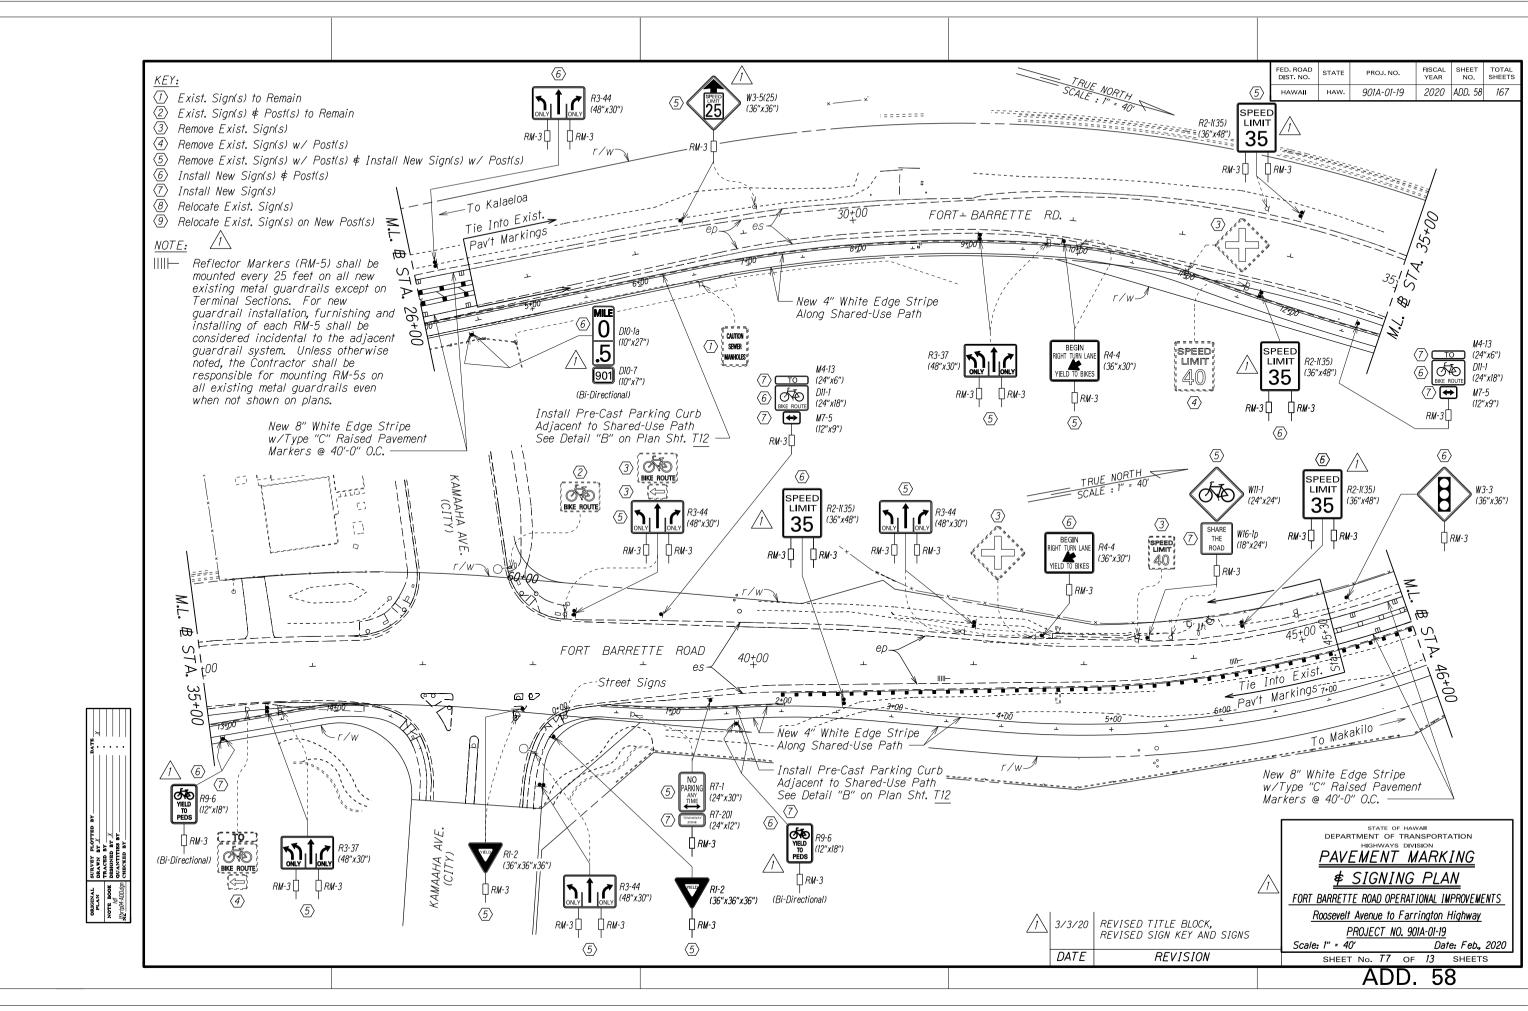

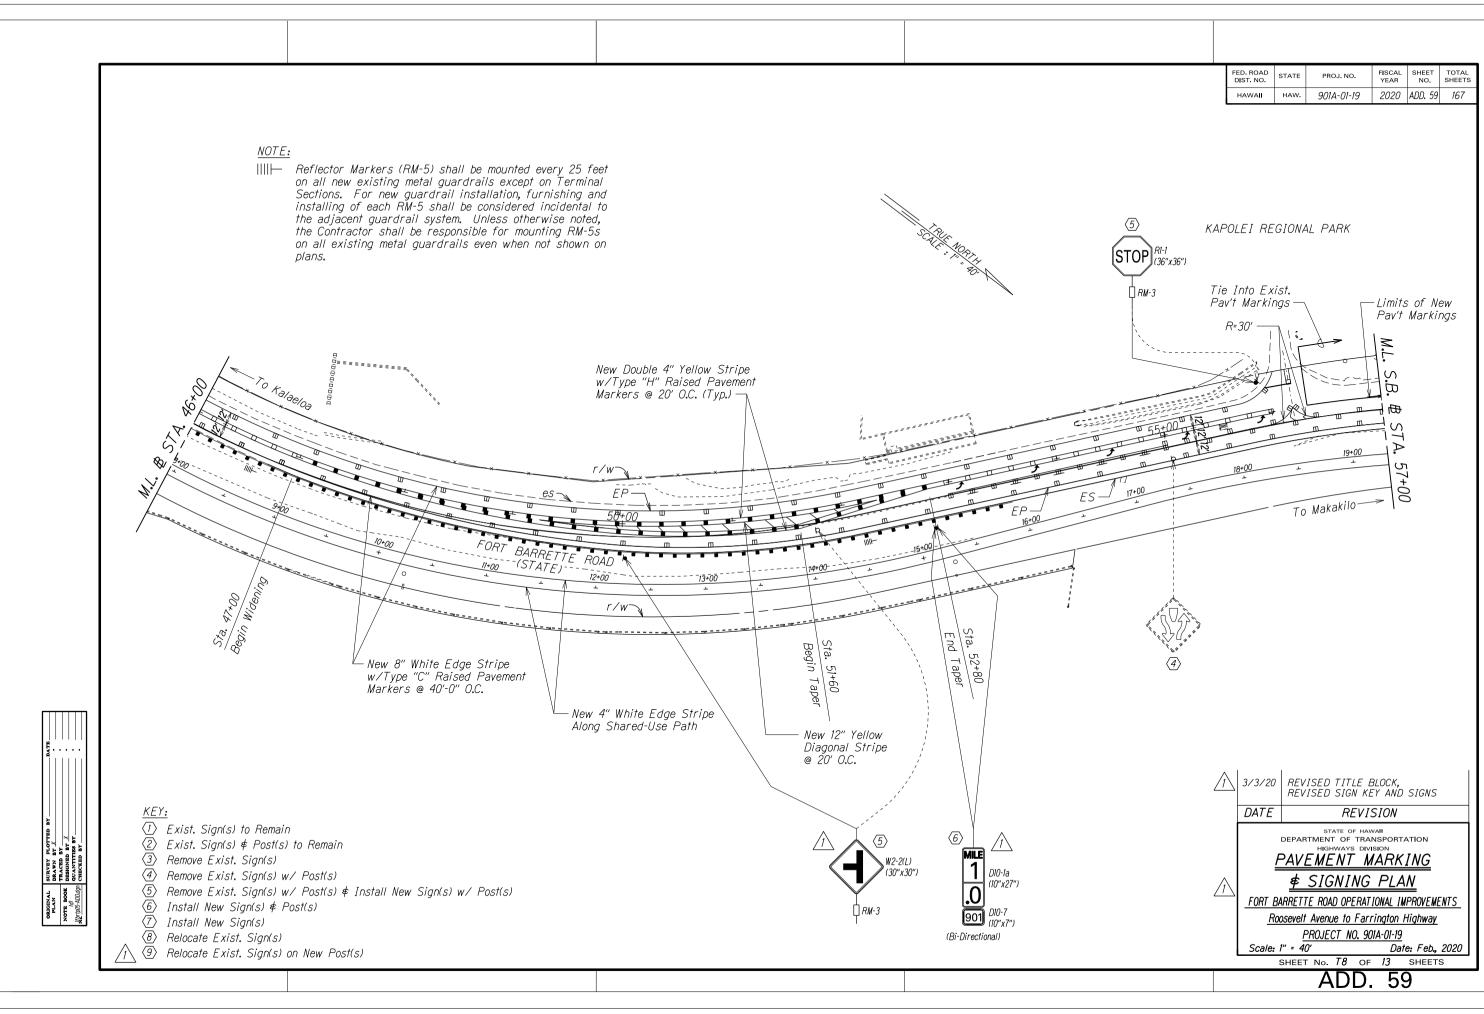


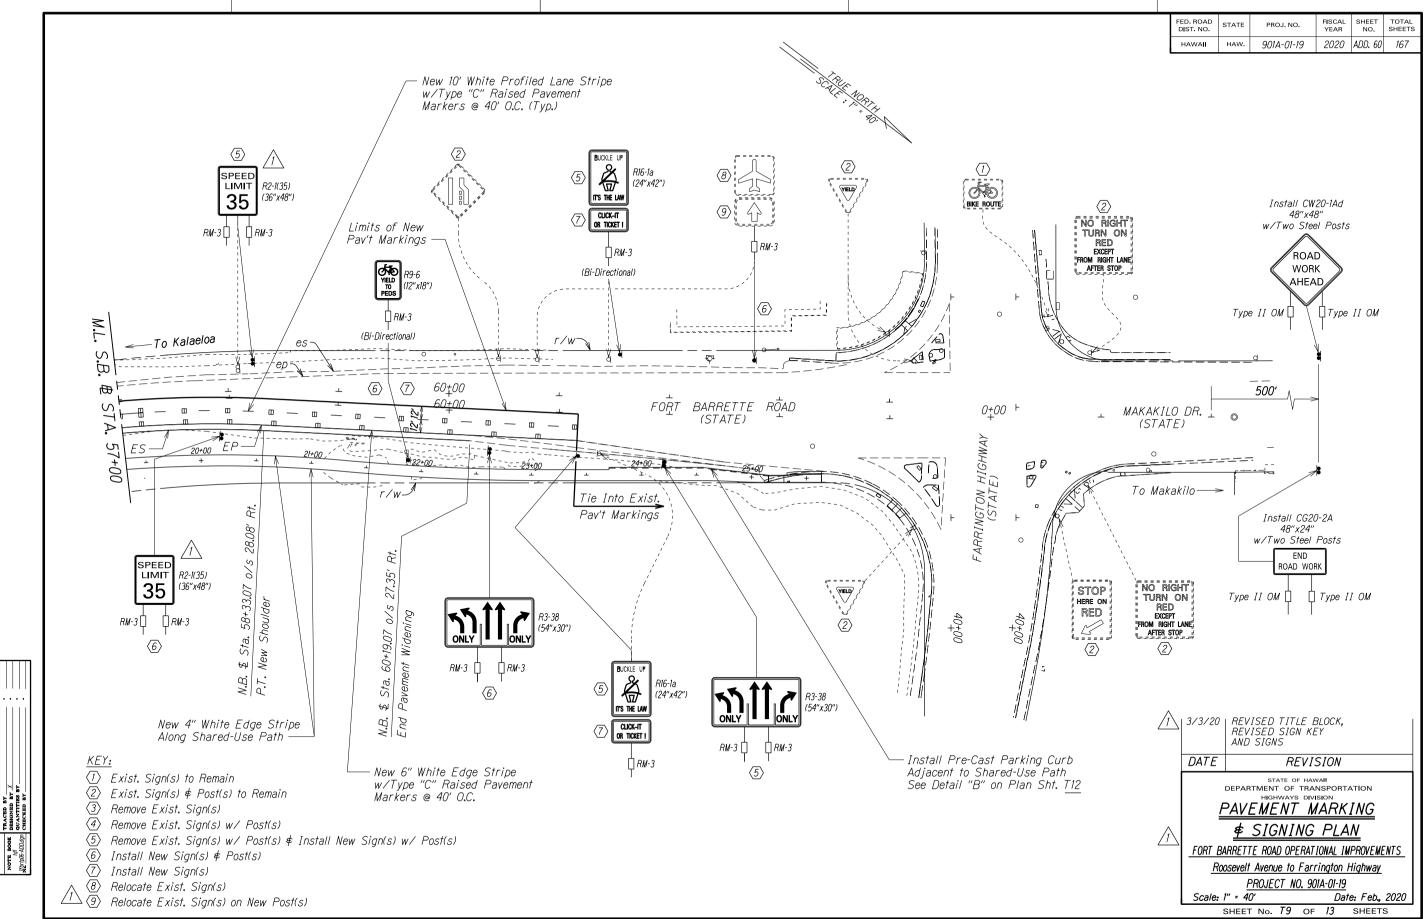


ORIGINAL BURVEY PLOTTS
PLAN TRACED BY X
NOTE BOOK DESIGNED BY X
Id OUANTITIES BY
IR 106-401490 CHECKED BY

ADD, 60


FED. ROAD DIST. NO.	STATE	PROJ. NO.	FISCAL YEAR	SHEET NO.	TOTAL SHEETS	
HAWAII	HAW.	901A-01-19	2020	ADD. 61	167	

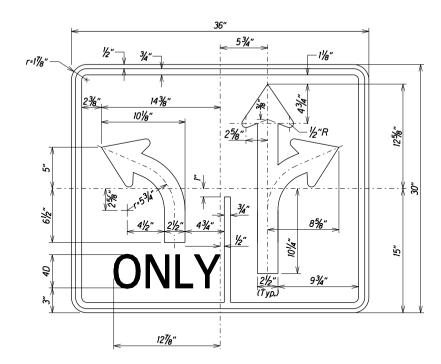


R3-24
Not to Scale

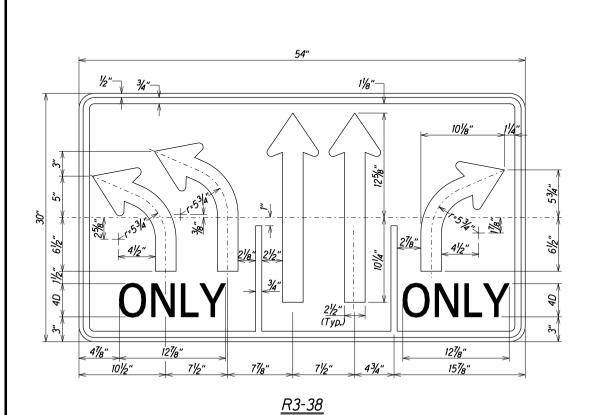


Not to Scale

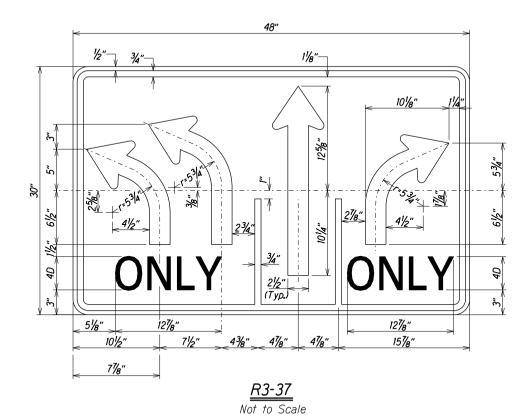


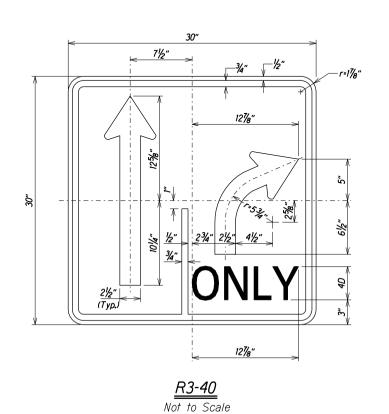


NOTE:


1. Sign R3-40L is a mirrored varaiation of sign R3-40. Plate and arrow details shall conform to sign R3-40.

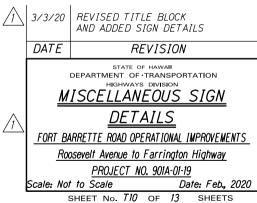

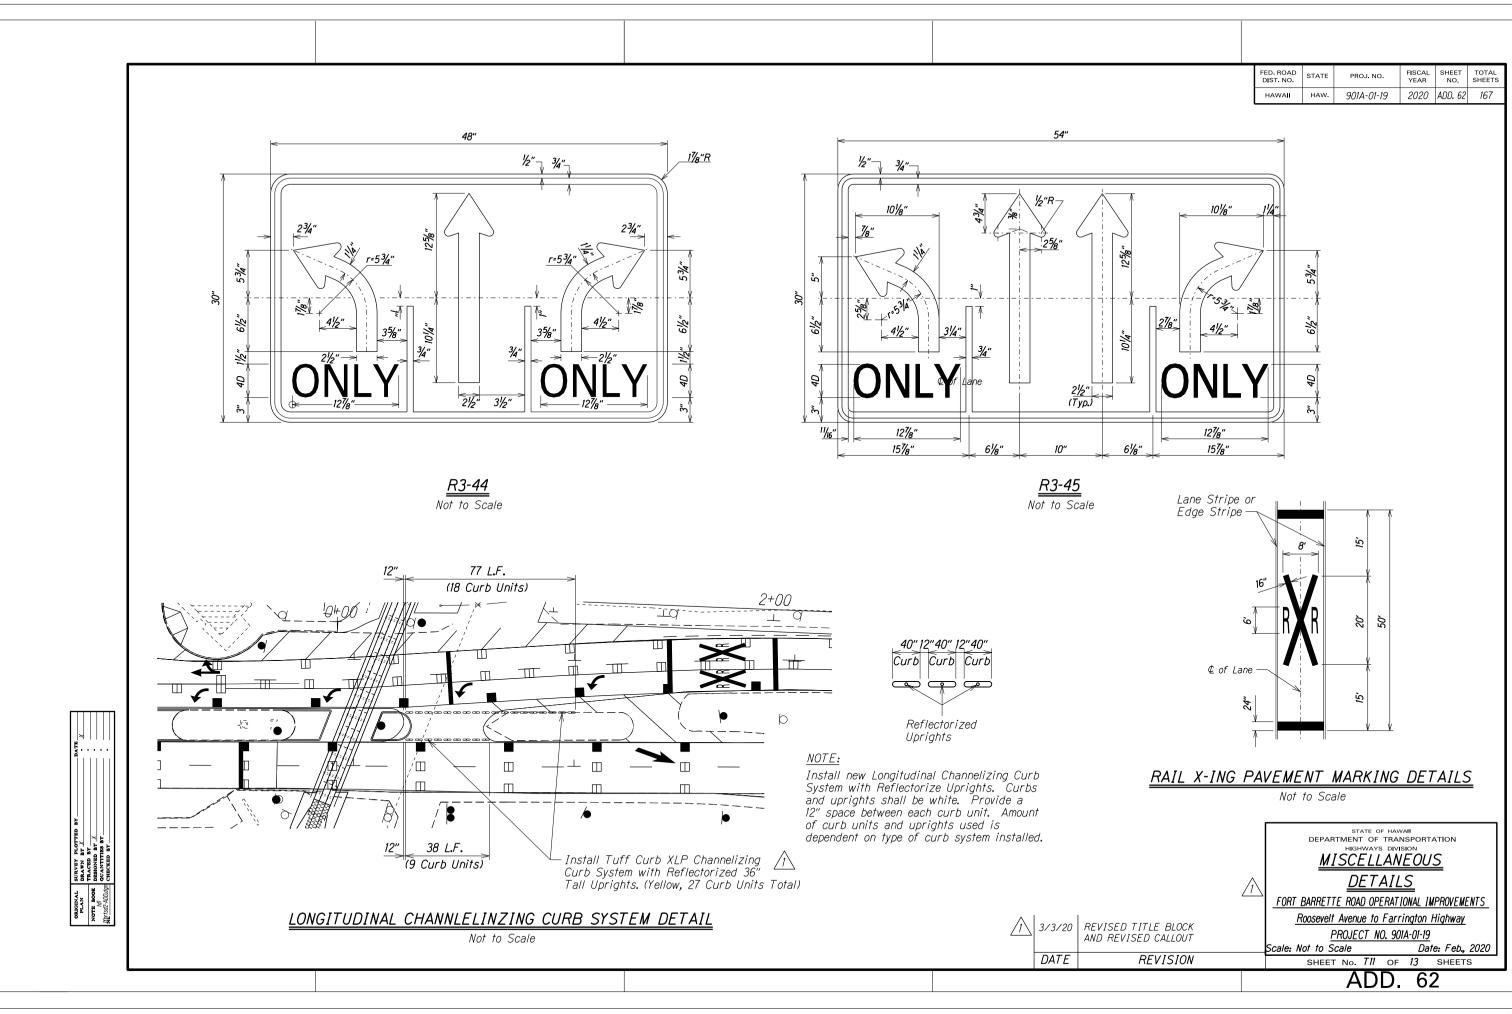

FED. ROAD DIST. NO.		STATE	PROJ. NO.	FISCAL YEAR	SHEET NO.	TOTAL SHEETS
	HAWAII	HAW.	901A-01-19	2020	ADD, 63	167

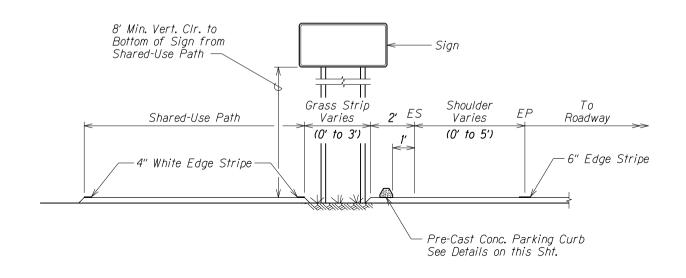

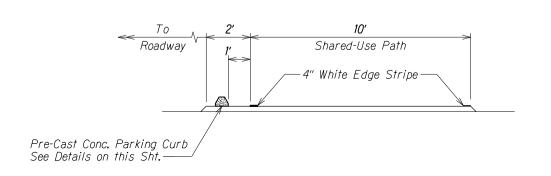


PARKING CURB ADJACENT TO PAVED SHOULDER (DETAIL "A")

Not to Scale


PARKING CURB ALONG SHARED-USE PATH (DETAIL "B")

Not to Scale

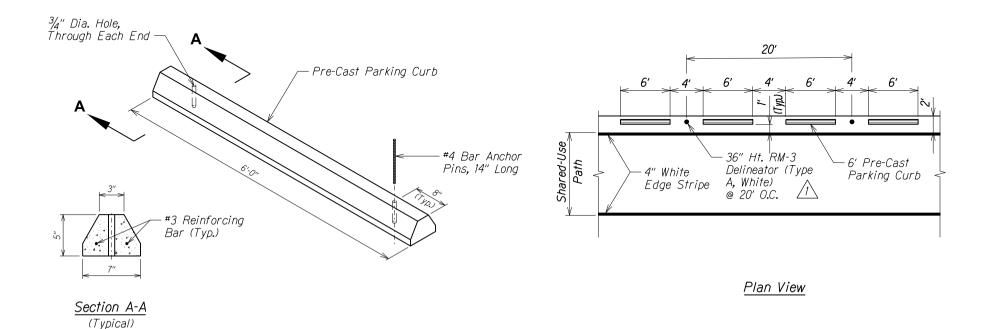

PRE-CAST CONCRETE PARKING CURB DETAIL


Not to Scale

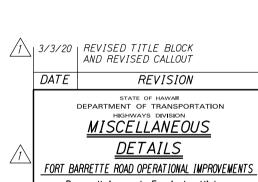

Roosevelt Avenue to Farrington Highway PROJECT NO. 901A-01-19 Scale: Not to Scale Date: Feb., 2020


SHEET No. 712 OF 13 SHEETS

ADD, 63

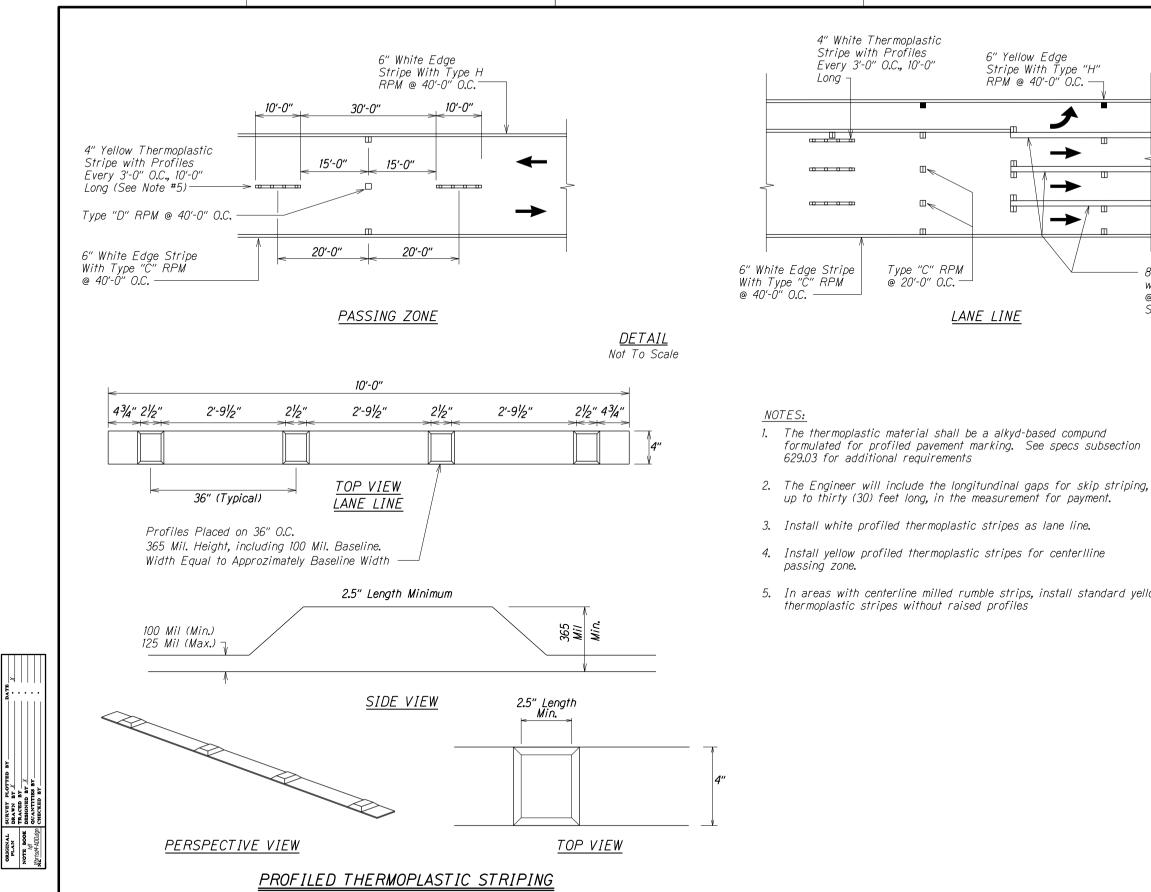


Not to Scale

FED. ROAD SHEET NO. STATE PRO L NO HAWAII 901A-01-19 2020 ADD, 64 167

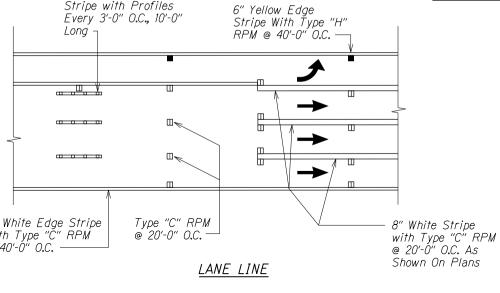

- 1. The thermoplastic material shall be a alkyd-based compund formulated for profiled pavement marking. See specs subsection
- up to thirty (30) feet long, in the measurement for payment.
- 4. Install yellow profiled thermoplastic stripes for centerlline
- 5. In areas with centerline milled rumble strips, install standard yellow

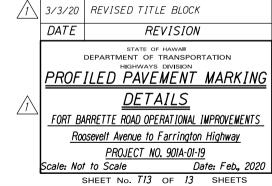

SIGNS AND MARKING NOTES:

- 1. All traffic sign and pavement marking installations shall be done in accordance with "Manual on Uniform Traffic Control Devices for Streets and Highways," 2009 Edition, as amended, the latest specifications from the Traffic Review Branch, Department of Planning and Permitting, and as shown on the plans.
- 2. Contractor shall notify and coordinate work with the Civil Engineering Branch, Department of Planning and Permitting, one (1) week in advance of commencing work at 768-8084.
- 3. Contractor shall submit material brochures for all signs and paint materials to the Civil Engineering Branch, Department of Planning and Permitting.
- 4. The signing and/or striping Contractor shall keep one (1) set of Approved Plans at the project site at all times during construction work.
- 5. Contractor shall paint temporary guidelines and outline of arrows, legends and crosswoalk with two inches (2") wide brushed line on the day the roadway is opened to traffic. These markings must be approved by the inspector from the Civil Engineering Branch, Department of Planning and Permitting.
- 6. Contractor shall notify the Civil Engineering Branch, Department of Planning and Permitting at 768-8084, three (3) days in advance of final inspection.
- 7. Contractor shall meet with the Inspector from the Civil Engineering Branch, Department of Planning and Permitting during the Final Inspection.
- 8. Within ten (10) days following notification of award of contract, the Contractor shall submit to the Department of Planning and Permitting (Phone: 768-8084) for approval, a list of any signing and pavement marking material which he proposes to install. The list shall be complete as to the name of manufacturer, catalog number, and shall be supplemented with material brochures.
- Upon final inspection of the project, the Contractor shall submit a letter of certification for all Traffic Signing and Pavement Marking Materials installed
- 10. Signs shall be attached to brackets with 5/16" Zinc Plated Steel Bolts, Nuts and Washers. Signs 48" wide or larger than 10 Sq. Ft. in area shall be mounted on two 2" Galv. Pipe post. The sign shall be installed with at least one (1) foot clearance from the sign edge to the curb face.
- 11. All Traffic signs shall be reflectorized.
- 12. Raised pavement markers shall be installed in accordance with the Department of Planning and Permitting Standards.
- 13. Location of "Stop" sign:
 - A. Install "Stop" sign at curb tangent point.
 - B. Install "Stop" sign on metal street light standard if a standard is located within 10 feet of curb return.
 - C. Install "Stop" sign in front of utility pole if a pole is located within 10 feet of curb return.

- 14. Pavement work and symbol markings shall be in accordance with the Department of Planning and Permitting Standards.
- 15. The Contractor shall use thermoplastic material, approved by the Civil Engineering Branch, Department of Planning and Permitting, for all crosswalks, stop bars, pavement arrows, center lines, lane lines, arc lines, channelized traffic island and legends.

TRAFFIC NOTES FOR WORK ON CITY & COUNTY STREETS:

- 1. A permit shall be obtained from the Department of Transportation Services before work on any portion of a public street or highway may begin. Construction Traffic Control Plans approved by the Department of Transportation Services and/or the Department of Planning and Permitting must be provided when applying for the permit.
- 2. The Contractor shall provide, install and maintain all necessary signs and other protective facilities, which shall conform with the "Hawaii Administration Rules Governing the use of Traffic Control Devices at Work Sites on or adjacent to Public Streets and Highways" adopted by the Director of Transportation, and the current U.S. Federal Highways Administration's "Manual on Uniform Traffic Control Devices for Street and Highways, Part VI Traffic Control Devices for Street and Highway Construction and Maintenance Operations."
- 3. Work on an city street area may be performed only between the hours of 8:30 A.M. to 3:30 P.M., Monday through Friday, unless otherwise permitted by the Department of Transportation Services.
- 4. During working hours, the Contractor shall provide for through traffic. During non-working hours, all trenches shall be covered with a safe non-skid bridging material and all lanes shall be open to Traffic.
 - As required by the Department of Transportation Services, The Contractor shall provide off-duty police officers to control the flow of traffic.
- 6. Where pedestrian walkways exist, they shall be maintained in passable condition or other facilities for pedestrians shall be privided. Passage between walkways at intersections shall likewise be provided.
- 7. Driveways shall be kept open unless the owners of the property using these rights-of-way are otherwise provided fro satisfactorily.
- 8. Contractor shall reference to the approval of the Department of Transportation Services and the Department of Planning and Permitting, all existing traffic signs, posts and pavement markings prior to the commencement of construction. The Contractor shall replace or repair all traffic sign, posts and pavement markings disturbed by his activites.
- 9. The Contractor shall notify the Department of Planning and Permitting at 768-8084 one (1) week prior to any work to be done on signs, post and pavement markings.
- 10. No equipment shall be stored within street rights-of-way except at locations designated in writing and approved by the Department of Transportation Services.

 FED. ROAD DIST. NO.
 STATE
 PROJ. NO.
 FISCAL YEAR
 SHEET NO.
 TOTAL SHEETS

 HAWAII
 HAW.
 901A-01-19
 2020
 ADD. 6651
 167

11. (Specify name of individual or company) shall ensure that the Contractor installs the construction traffic control devices in accordance with the MUTCD and the Hawaii Administration Rules as specified in traffic not #2.

FOR USE WITHIN CITY R.O.W. ONLY

STATE OF HAWAII
DEPARTMENT OF TRANSPORTATION

CITY AND COUNTY OF HONOLULU

GENERAL NOTES

FORT BARRETTE ROAD OPERATIONAL IMPROVEMENTS

Roosevelt Avenue to Farrington Highway
PROJECT NO. 901A-01-19

Scale: Not to Scale Date: Feb., 2020

ADD. 64S-1

| STANDOR | STREET FLOTTED BY | STANDOR | STAN

3/24/20 ADDED NEW PLAN SHEET

DATE REVISION

GENERAL NOTES FOR TRAFFIC CONTROL PLAN-

- 1. The Permittee shall make minor adjustments at intersections, driveways. bridges, structures, etc., to fit field conditions.
- 2. Cones or delineators shall be extended to point where they are visible to approaching traffic.
- 3. Traffic control devices shall be installed such that the sign or device farthest from the work area is placed first. The others shall then be placed progressively toward the work area.
- 4. Regulatory and warning signs within the construction zone that are in conflict with the traffic control plans shall be remvoed or covered.
- 5. flaggers and/or police officers shall be in sight of each other or in direct communication at all times.
- 6. When requried by the issuing office, the permittee shall install a flashing arrow signal as shown on the Traffic Control Plans.
- 7. All traffic lanes shall be a minimum of 10 feet wide.
- 8. All construction warning signs shall be promptly removed or covered whenever the message is not applicable or not in use.
- 9. The backs of all signs used for traffic control shall be appropriately covered to preclude the display of inapplicable sign messages (i.e., when signs have message on both faces).
- 10. Lane closure shall be limited only to the extent of accomplishing each day's work. As soon as each day's work is completed, the permittee shall remove all traffic control devices no longer needed to permit free and safe passage of public traffic. Removal shall be in the reverse order of installation. Existing faded or obliterated pavement markings that are necessary for safe traffic flow in the construction area shall be replaced with temporary or permanent marknas before opening the roadway to public traffic each day.
- 11. Permanent payement markings and traffic signs shall be replaced upon completion of each phase of work.
- 12. Cones and delineators shall be spaced at a maximum distance of 20 feet apart. A minimum of six channelizing devices shall be used for each taper length.
- 13. Driveways shal be kept open unless the owners of the property using the driveway are otherwise prvided for satisfactorily. Further, the permittee shall control traffic going into and out of diveways.
- 14. buffer and taper area on approach to any work area shall be kept clear of vehicles and equipment.
- 15. A high-level warning device (flag tree) shall be installed on approach to all work areas.
- 16. "No Parkng" signs shall beposted within any work area and for the buffer and tape areas approaching the work area.
- 17. Traffic Control Plans are approved for work on any city street area only between the hours of 08:30 A.M. and 03:30 P.M. (Monday - Friday).

MECHANICAL/FLECTRICAL DIVISION NOTES.

- 1. The Contractor shall notify the join pole committee two (2) weeks in advance of any relocation of utility pole(s) that may be necessary.
- 2. The Contractor shall notify the Mechanical/Electrical Division Department of Design and Construction, three (3) working days prior to commencing work on the street lighting system. (Phone: 768-8431)
- 3. The street lighting system shall be kept operational during construction. Any relocation required shall be approved by the Mechanical/Electrical Division, Department of Design and Construction, and paid for by the Contractor.
- 4. The locations of the existing underground street light facilities shown on the plans are from existing plans and are approximate only. The Contractor shall exercise caution when construction crosses or is in close proximity to the existing street light facilities. The Contractor shall be responsible for any damages to the existing street lighting facilities. Any and all damages to these facilities shall be repaired by the Contractor at his cost in accordance with the requirements of the City and County of Honolulu.
- 5. The Contractor shall be responsible for any damages to the city's existing communications fiber optic cable system, any and all damages to these facilities shall be repaired by the Contractor at his cost in accordance with the requirements of the City and County of Honolulu.

SHEET NO. EED BOAD STATE PROJ. NO. HAWAII 901Δ-01-19 2020 ADD 645-2 167

> FOR USE WITHIN CITY R.O.W. ONLY

STATE OF HAWAII
DEPARTMENT OF TRANSPORTATION

CITY AND COUNTY OF HONOLULU GENERAL NOTES

FORT BARRETTE ROAD OPERATIONAL IMPROVEMENTS

Roosevelt Avenue to Farrington Highway

SHEET No. 713B OF 13 SHEETS

PROJECT NO. 901A-01-19 Scale: Not to Scale Date: Feb., 2020


64S - 2


1 3/24/20 ADDED NEW PLAN SHEET


DATE

REVISION

SURVEY PLOTT
DRAWN BY X
TRACED BY
DESIGNED BY X
QUANTITIES BY
CHECKED BY

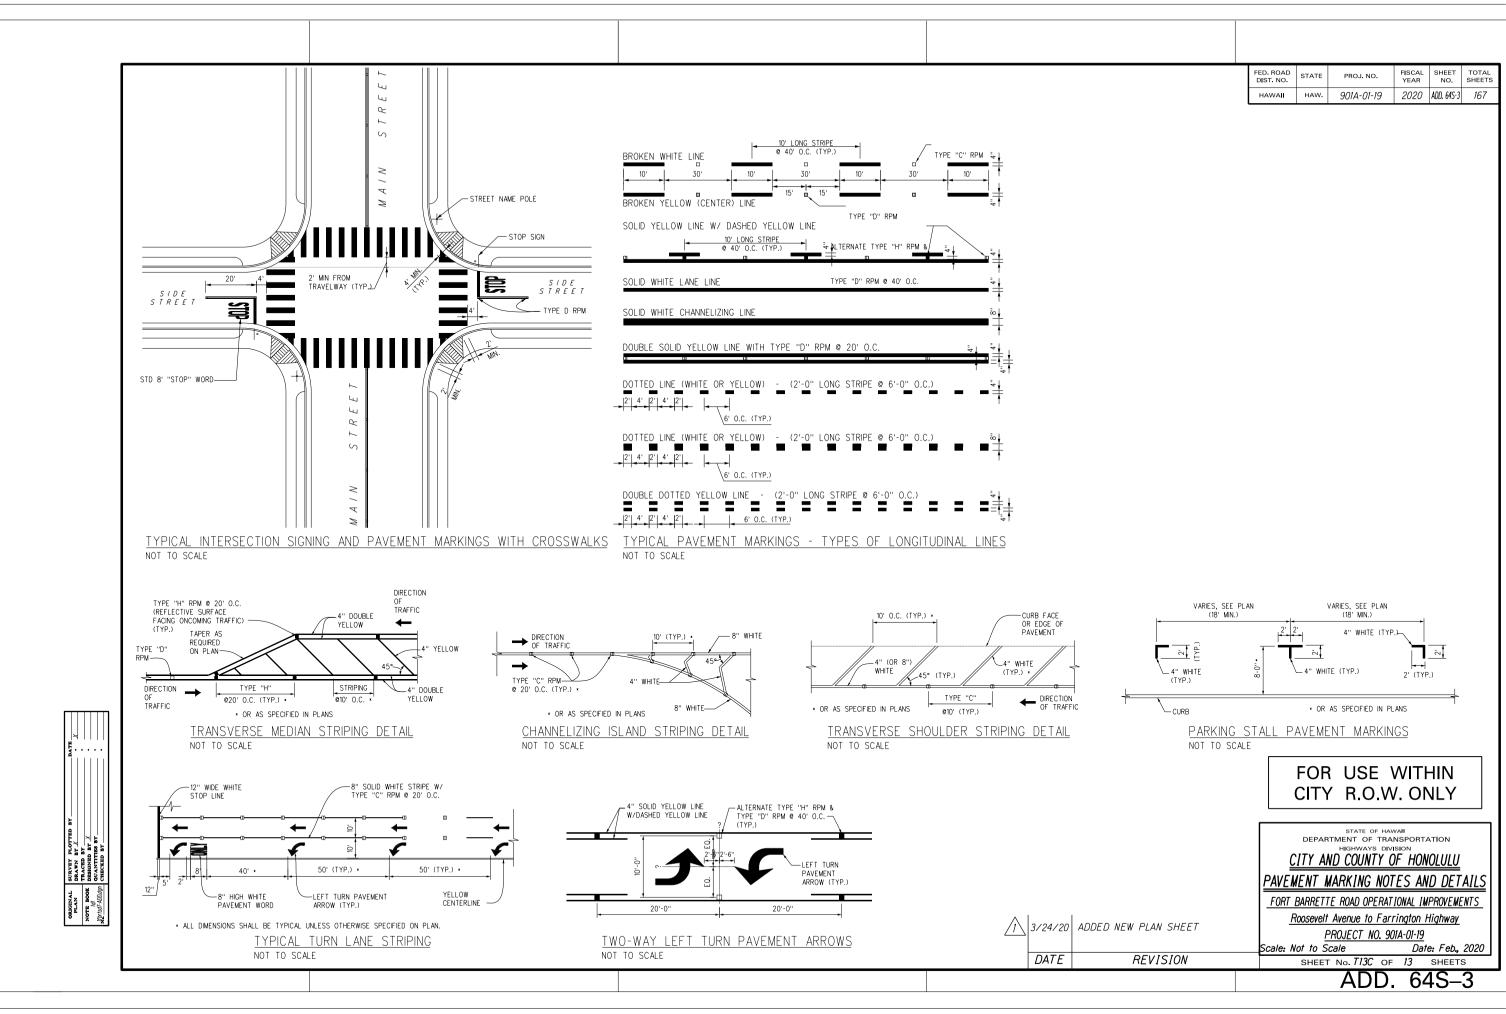

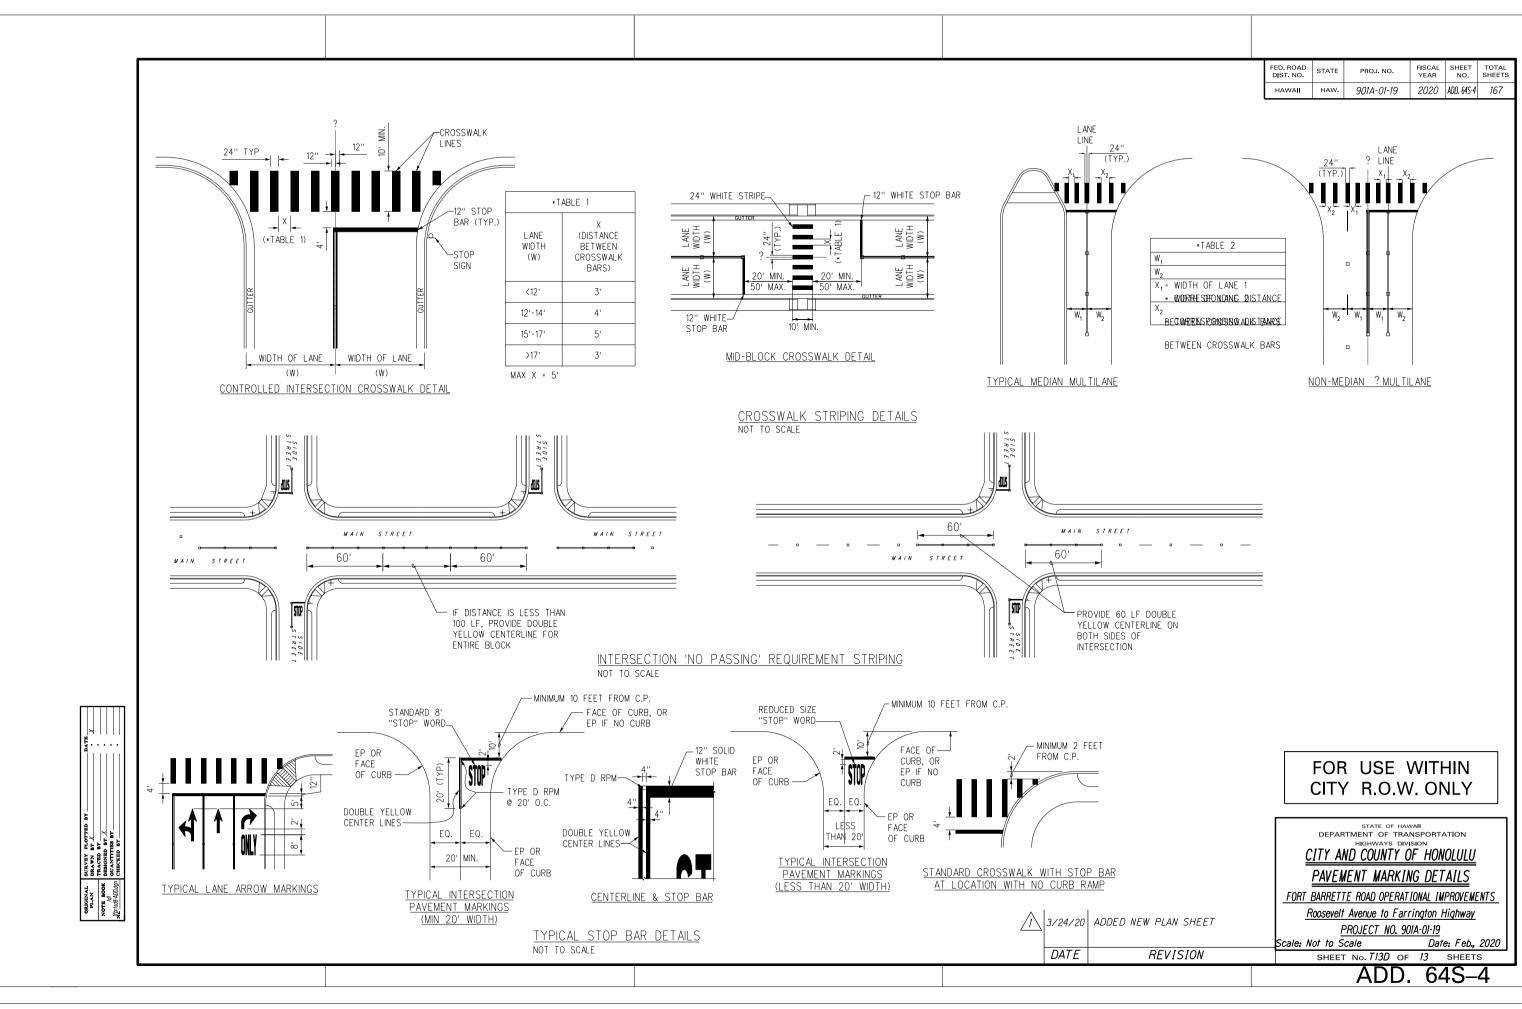

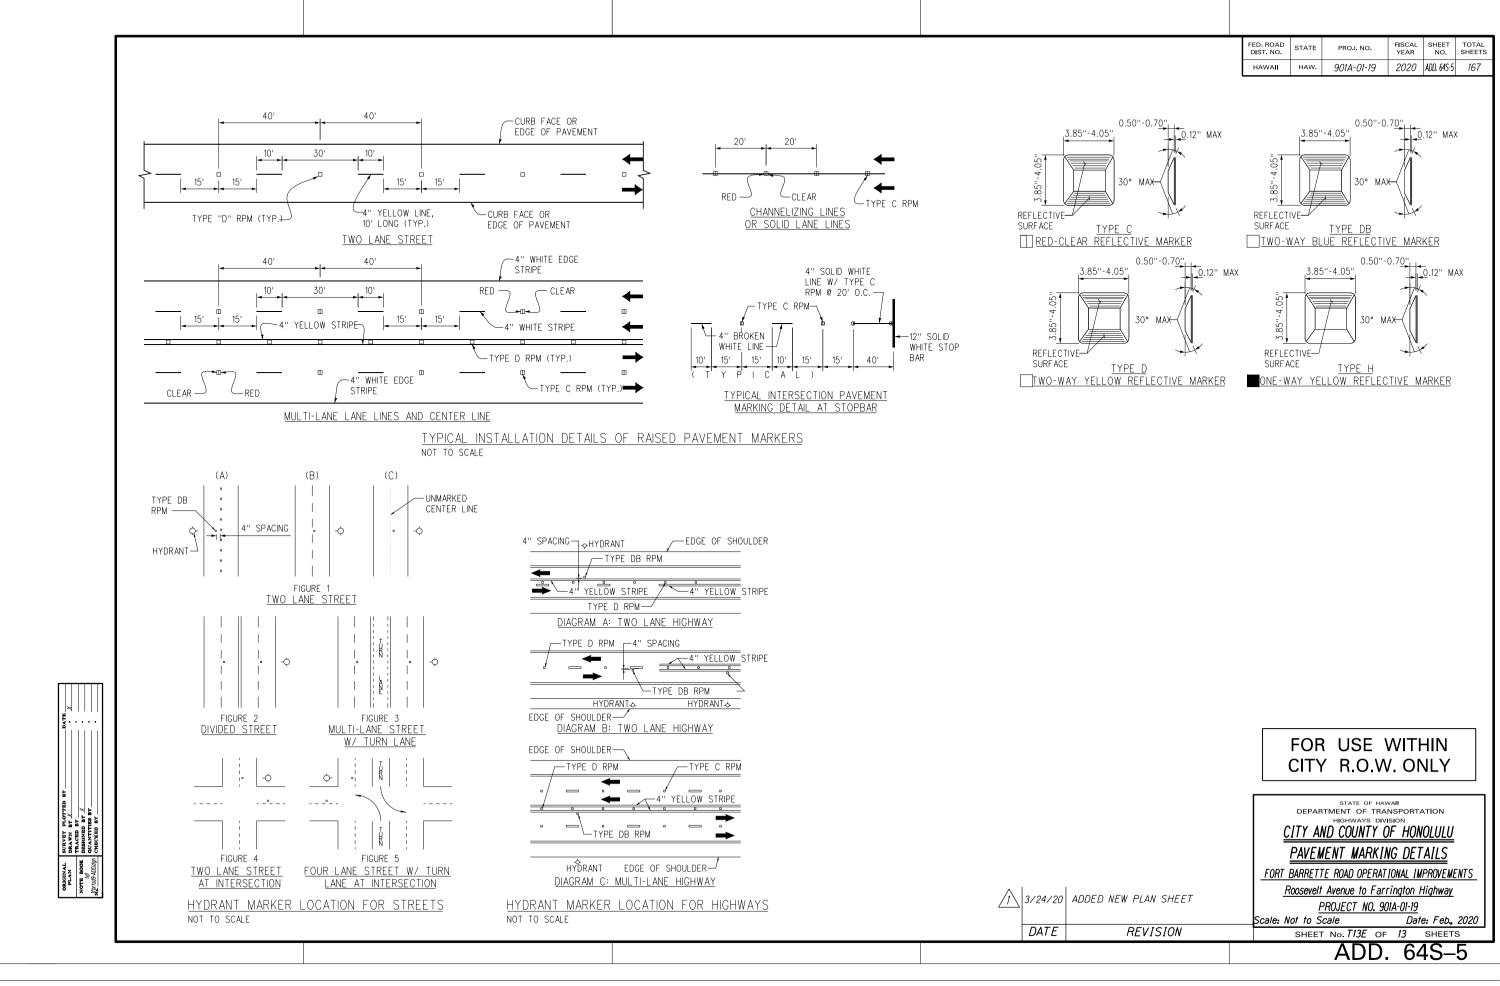

								FED. ROAD DIST. NO.	STATE	PROJ. NO.	YEAR	NO. SH	OTAL IEETS
								HAWAII	HAW.	901A-01-19	2020 AD). 64S-6	167
7'-10"	2" 20"	6'-0"	20" 6	6'-10"	16" 4"	9'	4" 16" 4" 16" 4" 16"	BE US	REDUCED ED FOR F	6'-4" 15" 4½" 15" 7½" SIZE "STOP" OADWAYS LES	WORD SHA		
ADMINISTRATION	NT ALPHABETS <u>SHALL</u> COM N PUBLICATION "MANUAL ON PUBLICATION, "TRAFFIC ST TS.	UNIFORM TRAFFIC CONT	FROL DEVICES" AND	THE CITY & COUNTY			6'	RED		SIZE "STOI			
	STANI NOT TO	DARD 8'-0'' PAVE scale	MENT WORDS	 	5'-8"		30"12						
8" 8"	1-5"	7'-2"	129"	181-0" 18-0" 18-0" 18-20" 18-10"	14 10 10 10 10 10 10 10 10 10 10 10 10 10	10 25"	DIRECTION OF TRAVEL * 20' FOR SPEED LIMIT 45 MPH ** 36" FOR SPEED LIMIT 45 MPH YIELD AHEAD TRIANGLE STYPICAL NOT TO SCA	or greater S <u>ymbol</u> YIELD LIN	<u>Y</u>	THE THE LINE LOW DETAIL	<u>AYOUT</u>	7	
10-18 10-18 10-18 10-18	- 4- - 4-	1.9			2'-0"					USE R.O.W	/. ONI		
12" RN ARROW	FOR DE	12" RAIGHT AND TURN ARRO' TAILED DIMENSIONS. MBINED ARROWS	WS	EDGE OF PAVEMENT	20°				CITY AN	MENT OF TRA HIGHWAYS DIV D COUNTY (ENT MARKI	NSPORTATI ISION DF HONOL NG DETAL	<u>ULU</u> LS	S
	TYPICAL PAVEMENT NOT TO SCALE	<u>ARROWS</u>		LANE RED	UCTION ARROW		ADDED NEW PLAN SHEET		Roosevelt .	Avenue to Far ROJECT NO. 90	rington Hig 01A-01-19		
						DATE	REVISION			No. <i>T13F</i> OF	<i>13</i> sı	HEETS	
										ADD	04	ס—כ	

8'-5" 20" 5½" 20" 5½" 20" 10", 20"

3'-4"

12''

STRAIGHT ARROW

ORIGINAL BURVEY PLOTTED B'
PLAN BRAWN BY X
NOTE BOOK BRIGKED BY X
GLANTTIES BY
GLANTTIES BY
CHECKED BY

6'-0''

3'-0"

2'-8"

TURN ARROW

FFD. ROAD SHEET NO. TOTAL FISCAL STATE PRO L NO DIST NO 2020 ADD 645-7 HAWAII 901Δ-01-19


IS ALLOWED. 4'-0" WHERE PARKING IS PROHIBITED. OR AS SHOWN ON PLAN \blacksquare 3'-4" ∽FACE OF CURB, OR EDGE OF TRAVELWAY

11'-O" WHERE PARKING

THE SHARED LANE MARKING SHALL BE PLACED IMMEDIATELY AFTER AN INTERSECTION AND SPACED AT INTERVALS NOT GREATER THAN 250 FEET THEREAFTER.

> SHARED LANE MARKING NOT TO SCALE

EXIST. CURB LINE -

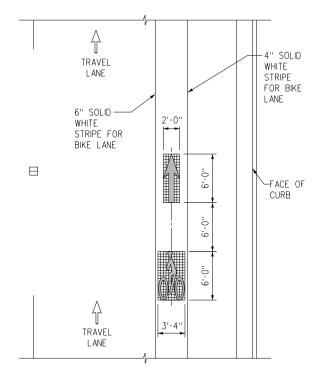

HELMETED BICYCLIST SYMBOL & ARROW NOT TO SCALE

ANCHOR POST NOTES:

STREET NAME

SIGNS

SIGN

INSTALLATION OF NEW SIGN POST WITH ANCHOR POST

- KEEP INSIDE OF 2-1/4" ANCHOR POST FREE FROM IMPEDIMENTS THAT MAY PREVENT PROPER SEATING OF 2" SIGN POST.
- SQUARE TUBING SIGN POST SHALL BE TELESCOPING TYPE WITH 7/16" DIA. HOLES AT 1" O.C. ON FOUR SIDES.
- 3. USE 5/16" X 2-3/4" BOLTS TO SECURE SQUARE TUBING POST ONTO THE 2-1/4" SQUARE TUBE ANCHOR POST.
- 4. VERIFY EXISTENCE AND LOCATION OF EXISTING UNDERGROUND UTILITIES PRIOR TO INSTALL ATION.
- 5. MINIMUM BURY DEPTH FOR THE 2-1/4" ANCHOR POST (WITHOUT CONCRETE FOOTING) SHALL BE AS FOLLOWS:

4'-0" MIN. AT POOR SOIL CONDITIONS 2'-6" MIN. AT ROCKY CONDITIONS

STREET NAME SIGN NOTES:

- REFERENCE STANDARD DETAILS T-1 AND T-14 FOR STREET NAME SIGN INSTALLATION. SEE STREET NAME SIGN DETAIL THIS SHEET.
- SUBMIT SHOP DRAWINGS OF STREET NAME SIGNS AND CONNECTION DETAILS PRIOR TO FABRICATION OF SIGNS.

INCREMENT OF 2/3 H IN EQUAL SPACING. EQUAL EQUAL 2/z H GALV. SQ. TUBE POST OR FLANGED CHANNEL POST -LOCK WASHER WITH %"ø BOLT HOLES -⁵⁄6''ø X 3'' GALV. BOLT. DRILLED AT APPROPRIATE NUT, LOCK WASHER & 7/8 LOCATIONS-"X0.06" STAINLESS STEEL −¾''ø BOLT FLAT WASHER WITH HOLE, TYP. SIGN PLATE NEOPRENE RUBBER GASKET **ELEVATION** PLAN POST MOUNTING INSTALLATION NOT TO SCALE

H = HEIGHT OF SIGN PANEL;

IF 2/3 H > 2', INSTALL ONE

HARDWARE FOR EVERY 18"


SET OF SIGN PANEL FASTENING

-SIGN PLATE




-STAINLESS STEEL BUCKLE; TWO REQUIRED FOR BIDIRECTIONAL MOUNTING OR WHEN USED IN CONJUNCTION WITH BAND BRACKETS -5/6" GALV. SCREW. NUT AND LOCK WASHER & √k" THICK %"X0.06" STAINLESS GALV. CLAMP STEEL FLAT WASHER WITH NEOPRENE RUBBER GASKET. -0.03" THICK STAINLESS STEEL BAND LEFT SIDE VIEW MOUNT SIGNS AT 7' MIN. BAND BRACKET HEIGHT TO BOTTOM OF SIGN.

NEW SIGN ON EXISTING STREET LIGHT POLE MOUNTING DETAIL NOT TO SCALE

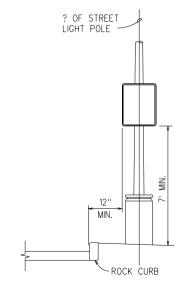

HEIGHT AND LATERAL LOCATION OF SIGN NOT TO SCALE

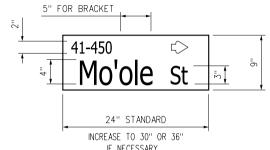

STREET NAME SIGN DETAIL NOT TO SCALE

1 3/24/20 ADDED NEW PLAN SHEET

DATE REVISION

FOR USE WITHIN CITY R.O.W. ONLY

STATE OF HAWAII
DEPARTMENT OF TRANSPORTATION CITY AND COUNTY OF HONOLULU PAVEMENT MARKING DETAILS

FORT BARRETTE ROAD OPERATIONAL IMPROVEMENTS

Roosevelt Avenue to Farrington Highway PROJECT NO. 901A-01-19

Scale: Not to Scale Date: Feb., 2020 SHEET No. 713G OF 13 SHEETS

SURVEY PLOTT
DRAWN BY X
TRACED BY
DESIGNED BY X
QUANTITIES BY
CHECKED BY


2" SQUARE SIGN POST 12 GA. VARIES GALVANIZED -5/16" x 2-3/4" GALVANIZED BOLTS. NUTS AND WASHERS ON BOTH SIDES -R. NEW FINISH GRADE EXIST. CURB -2 2-1/4" SQUARE TUBE ANCHOR POST -


NOT TO SCALE


MIN.


IF NECESSARY


64S - 7

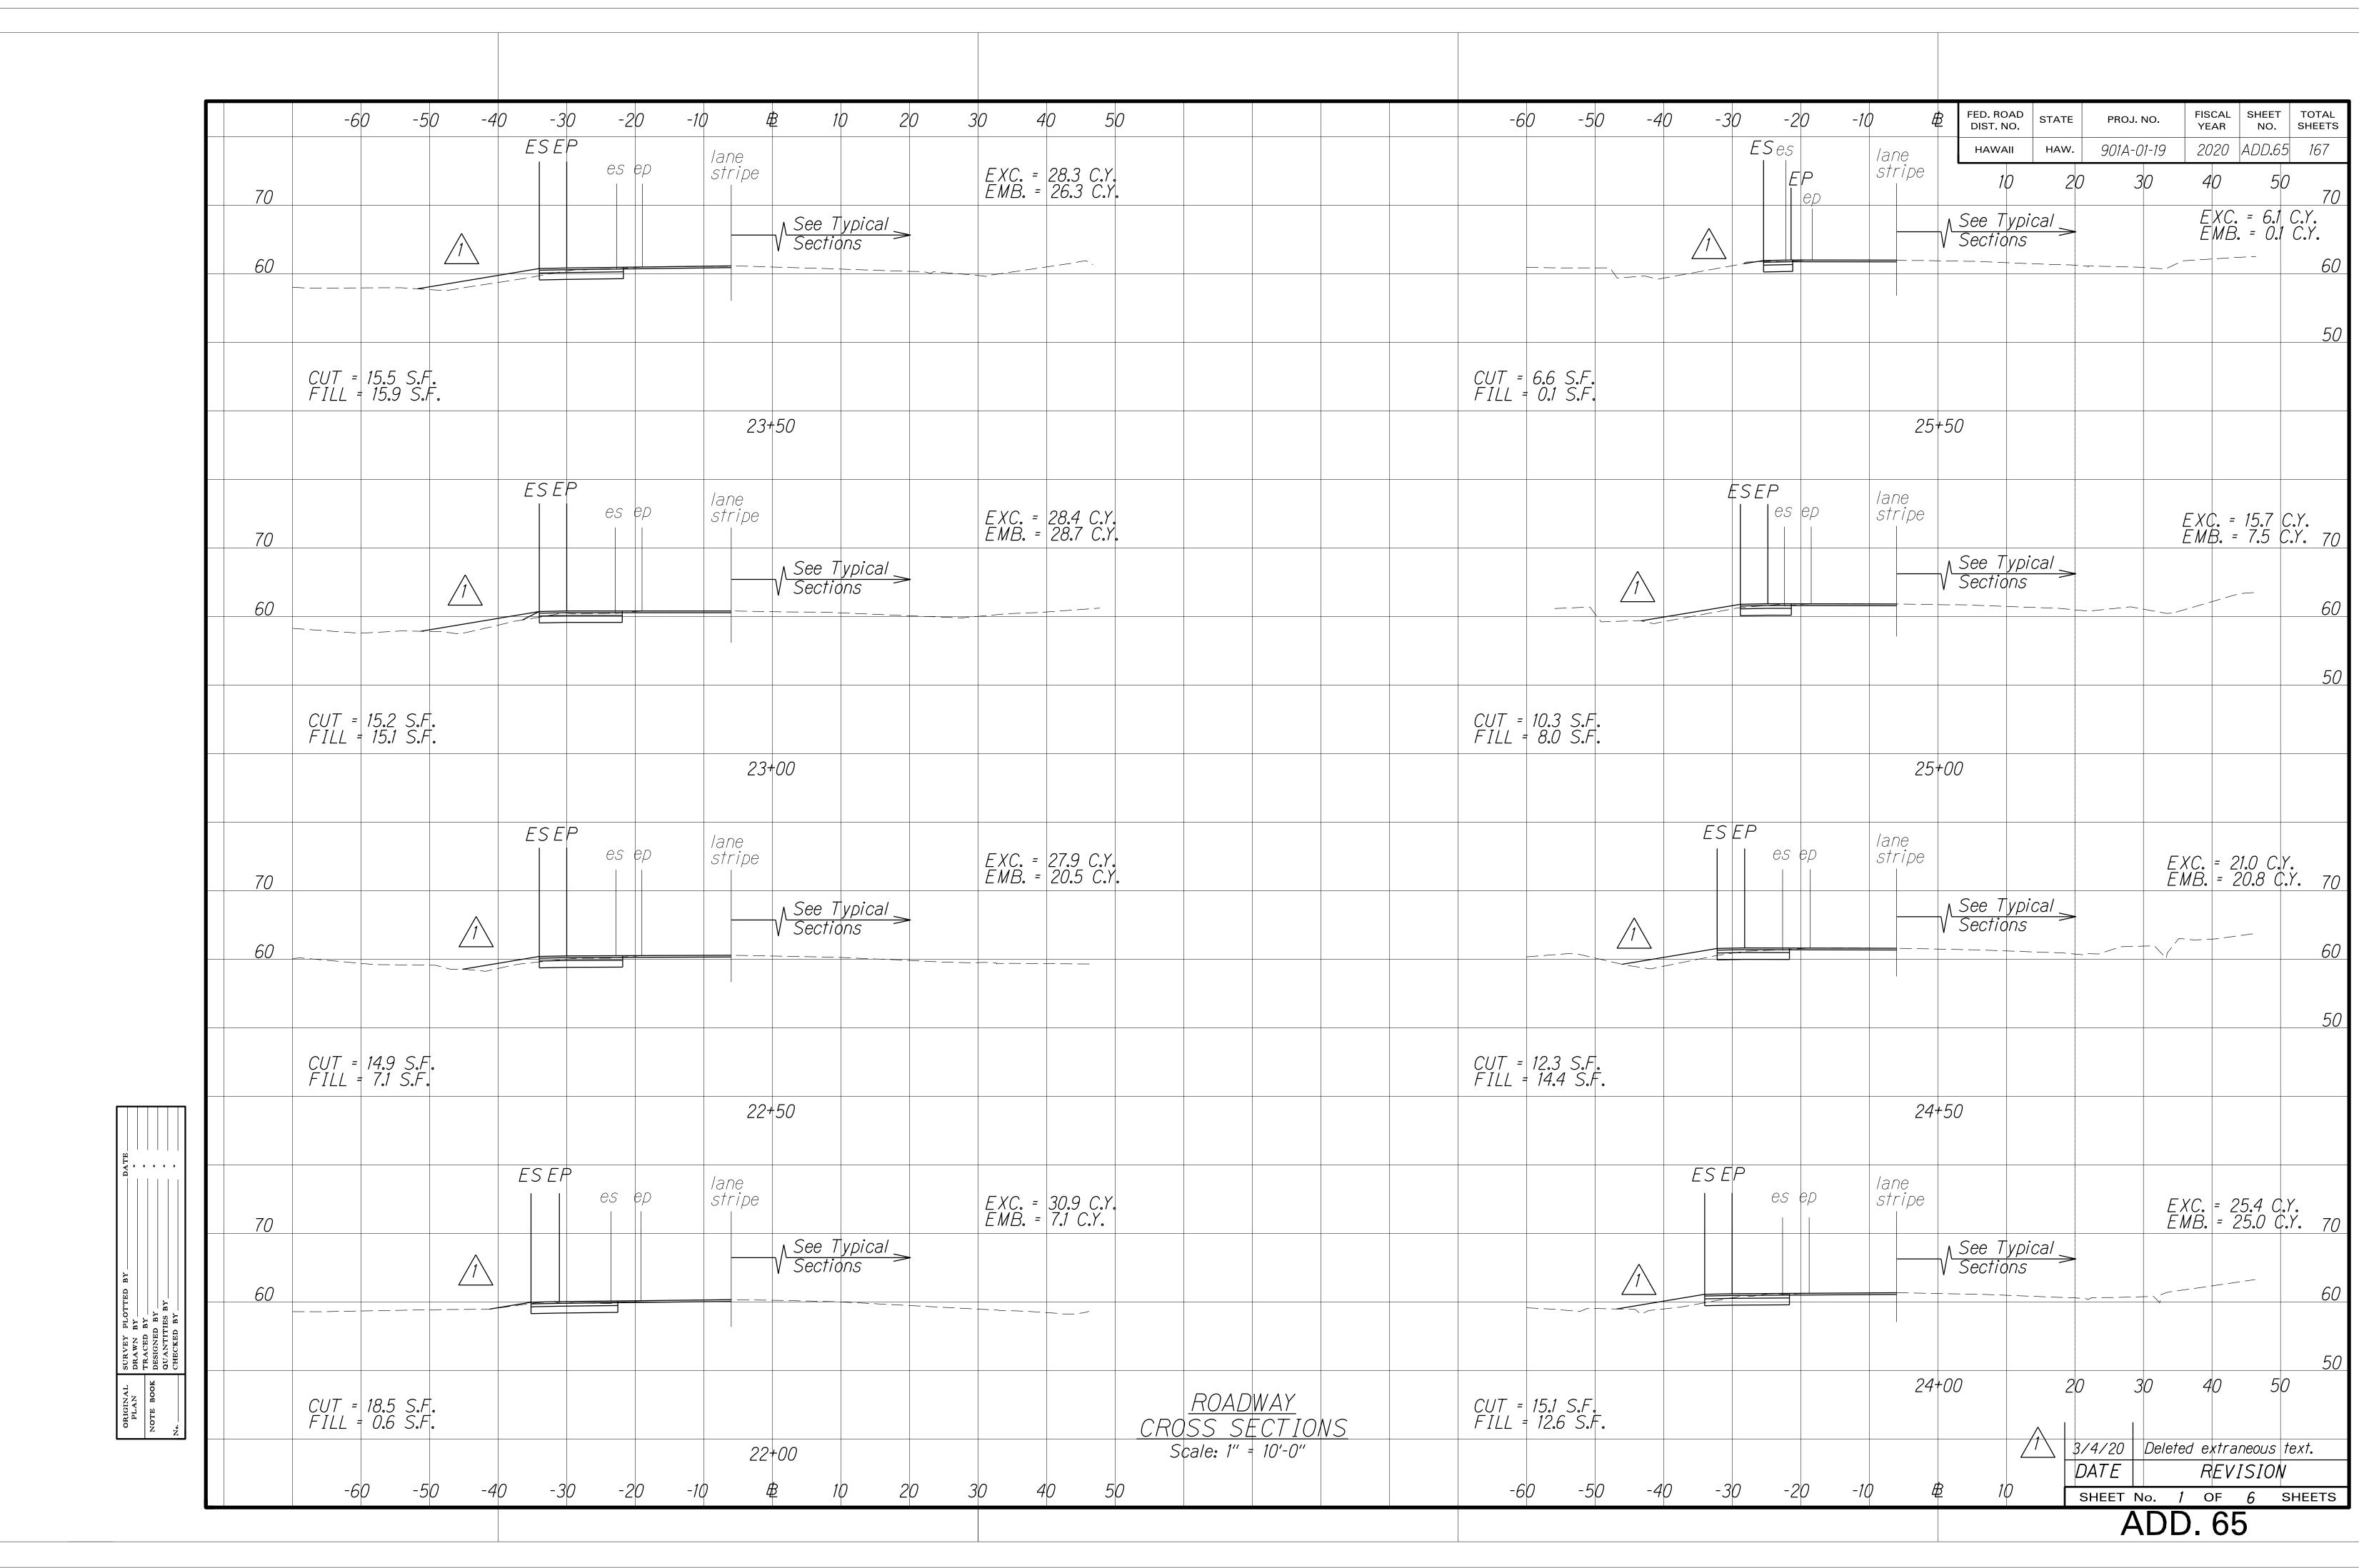


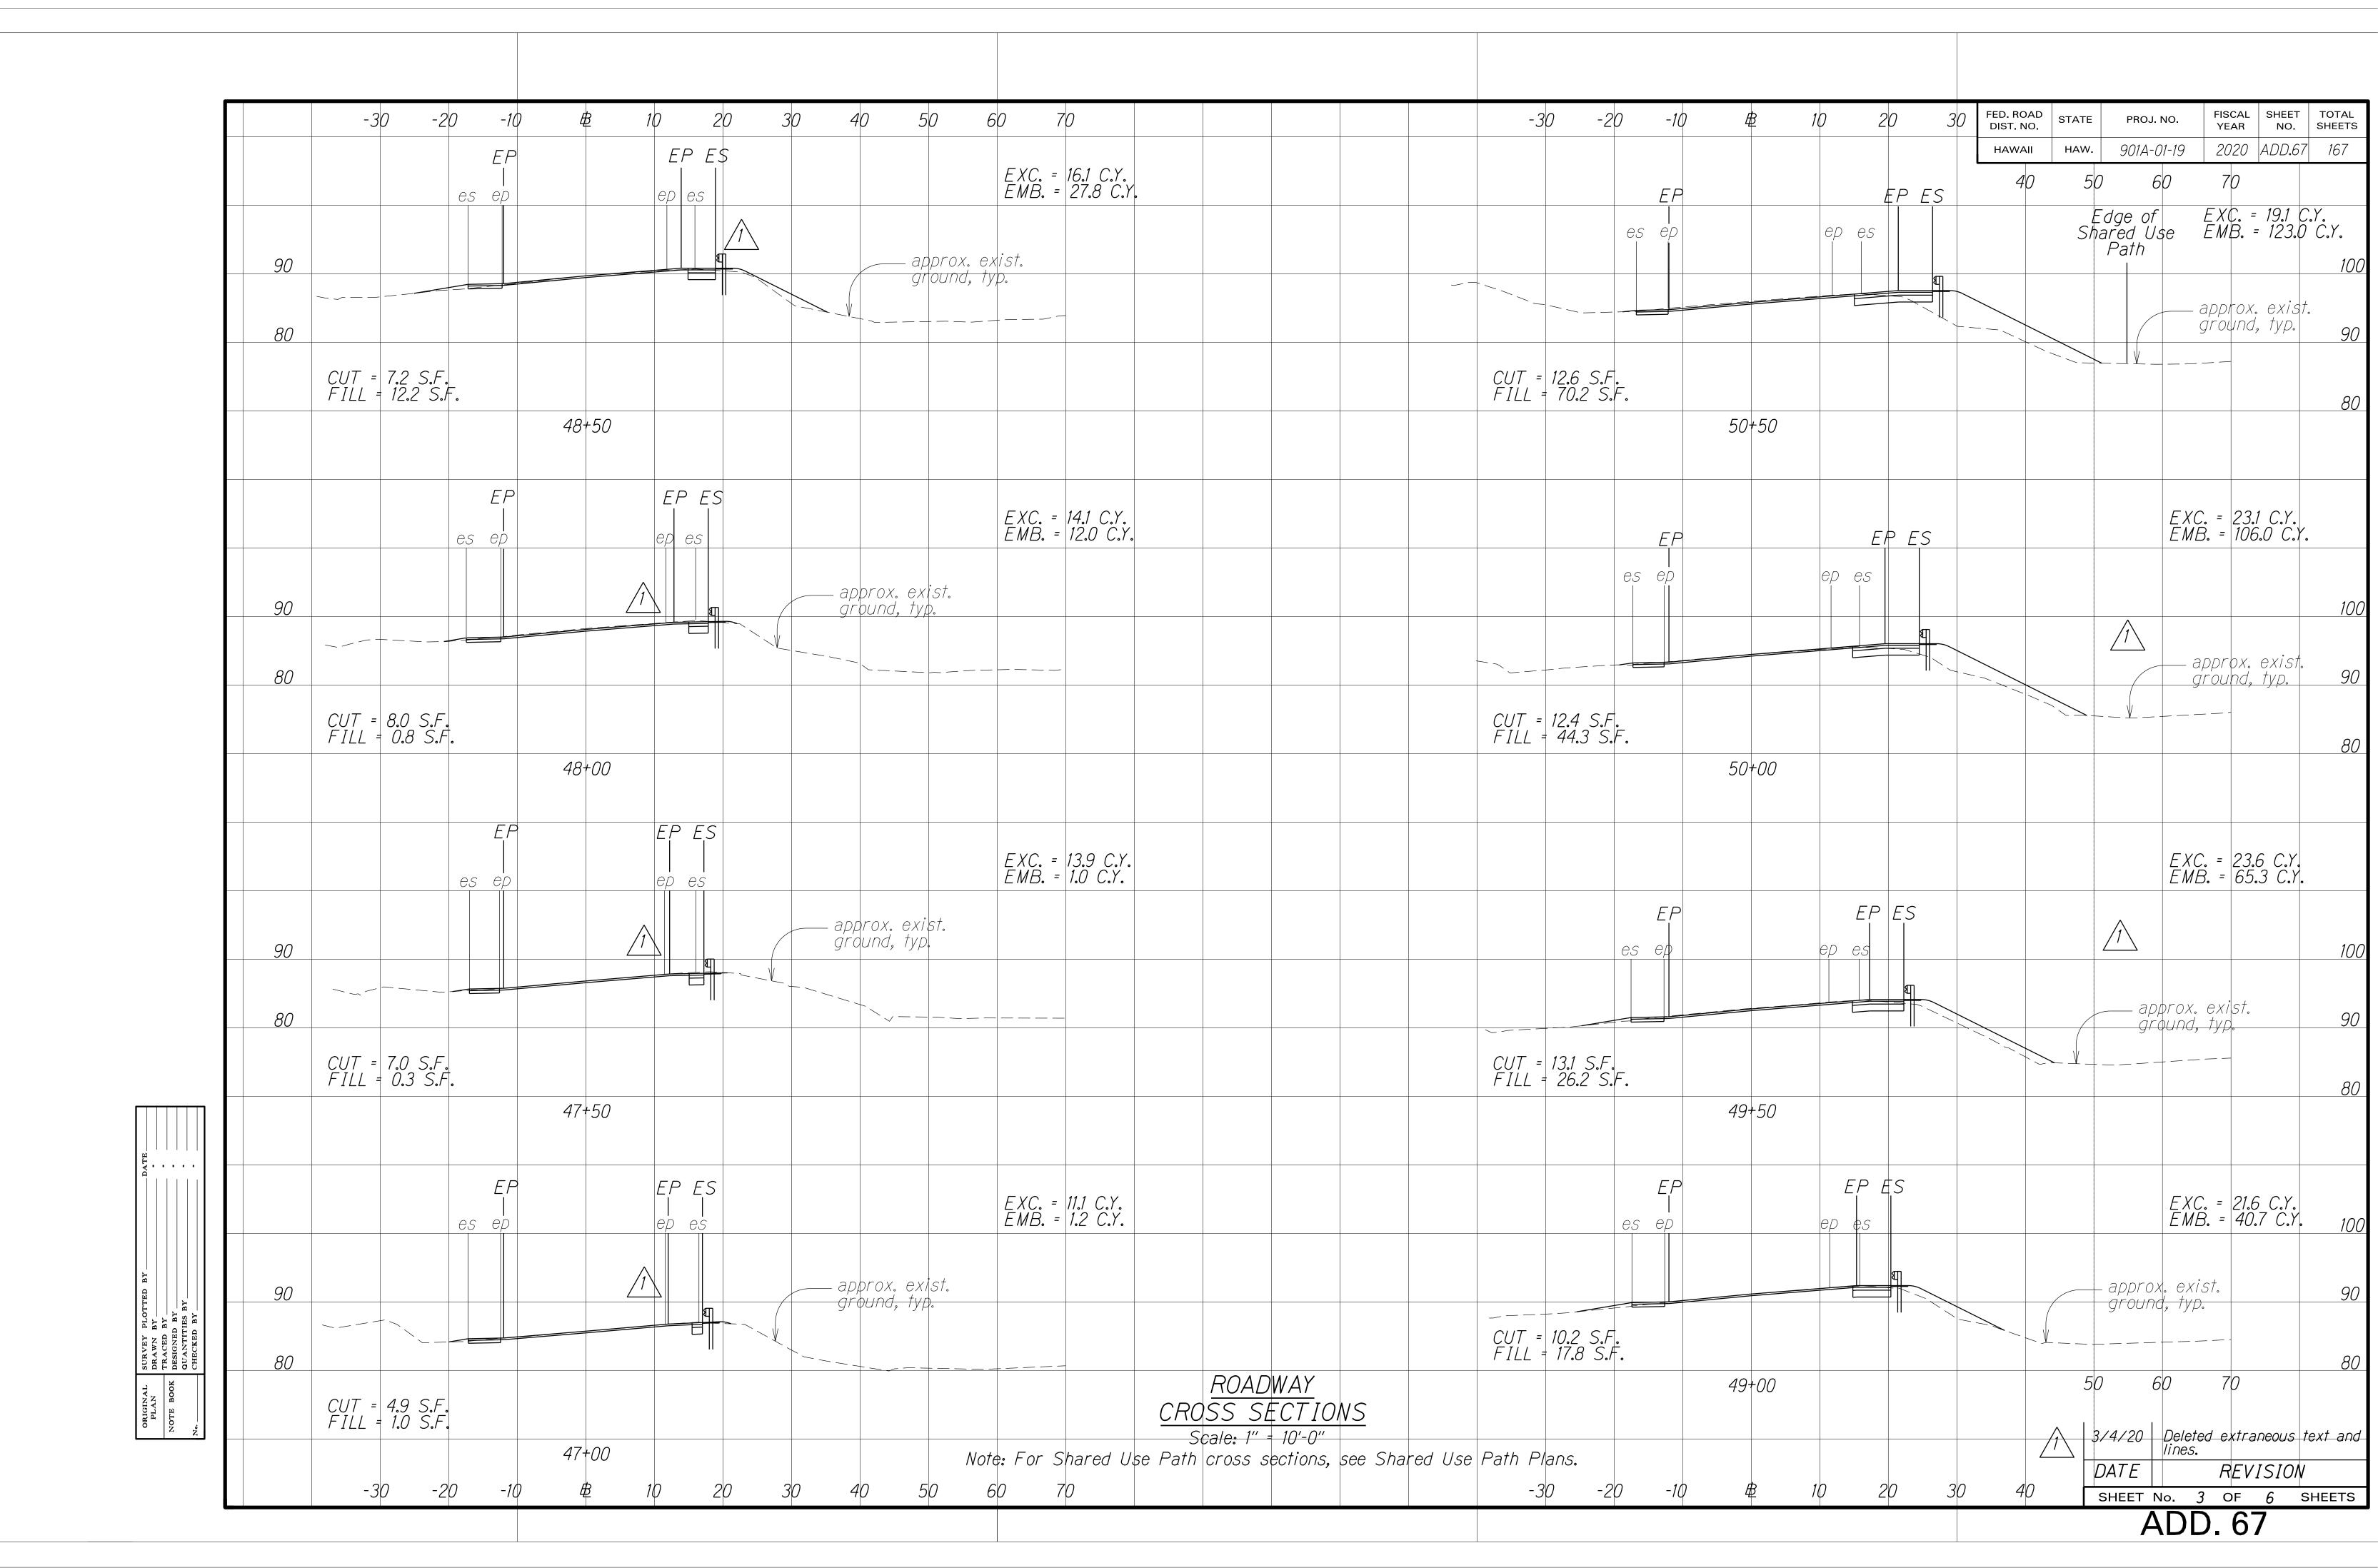


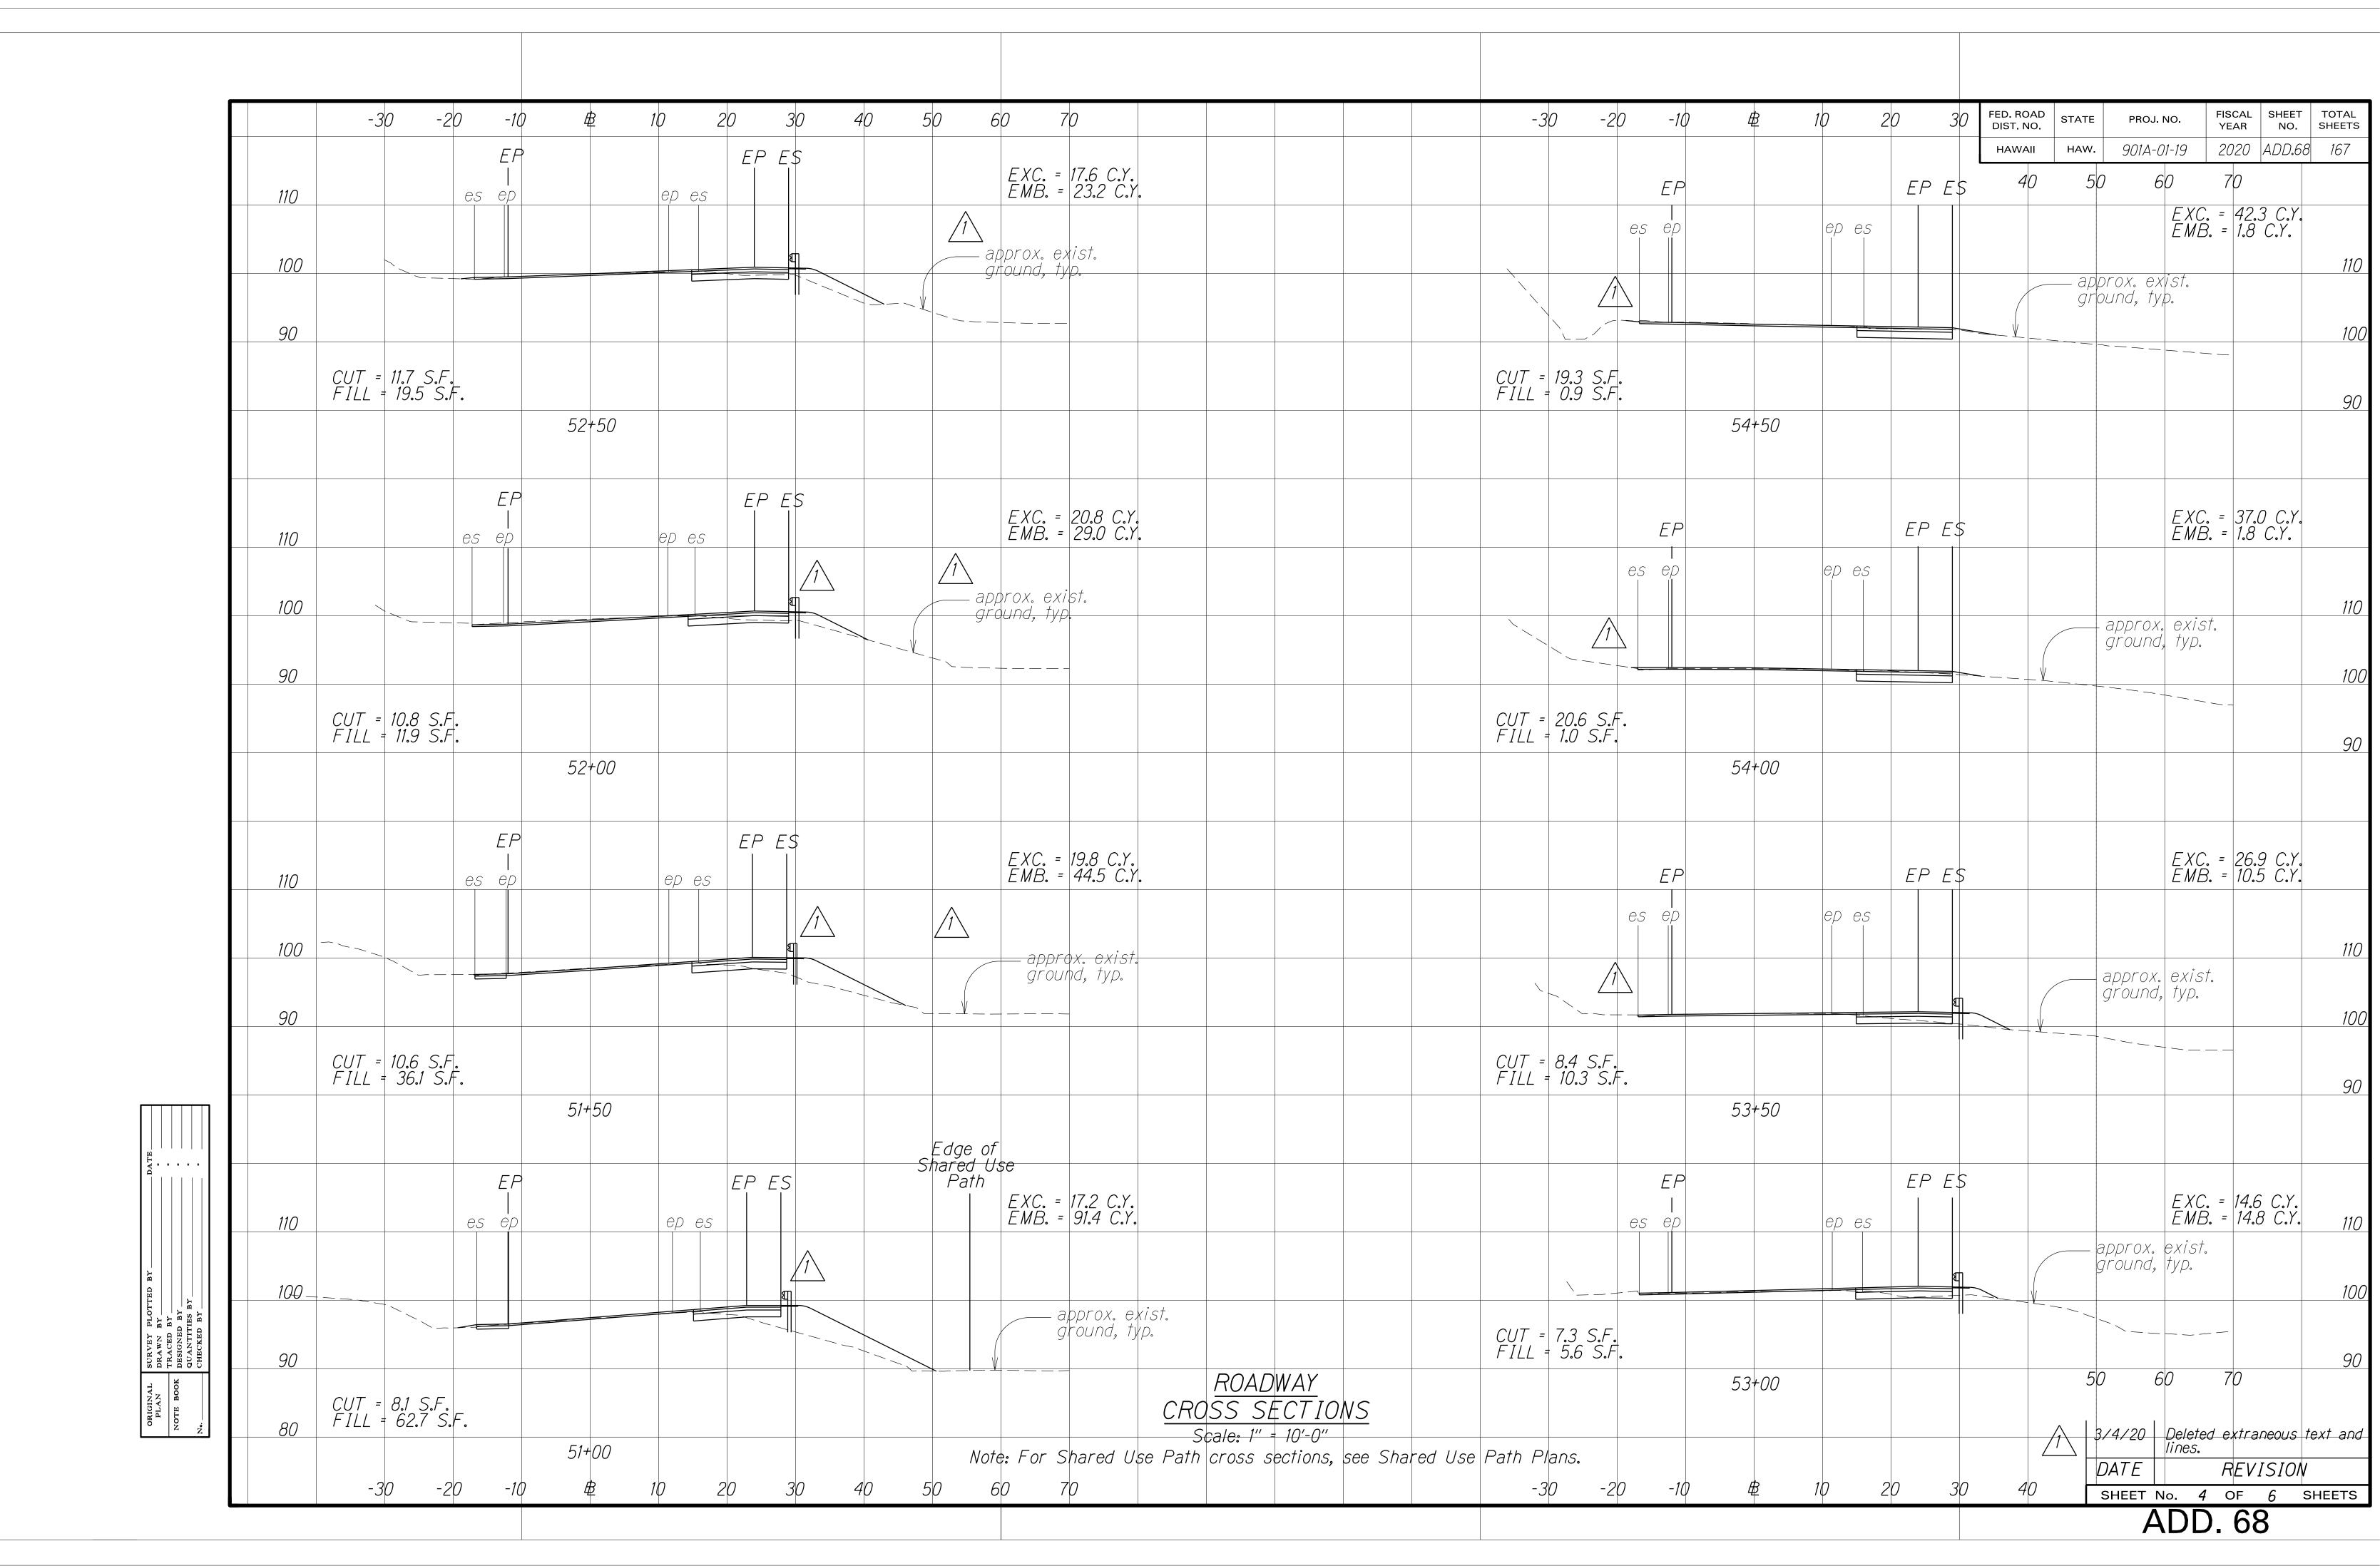


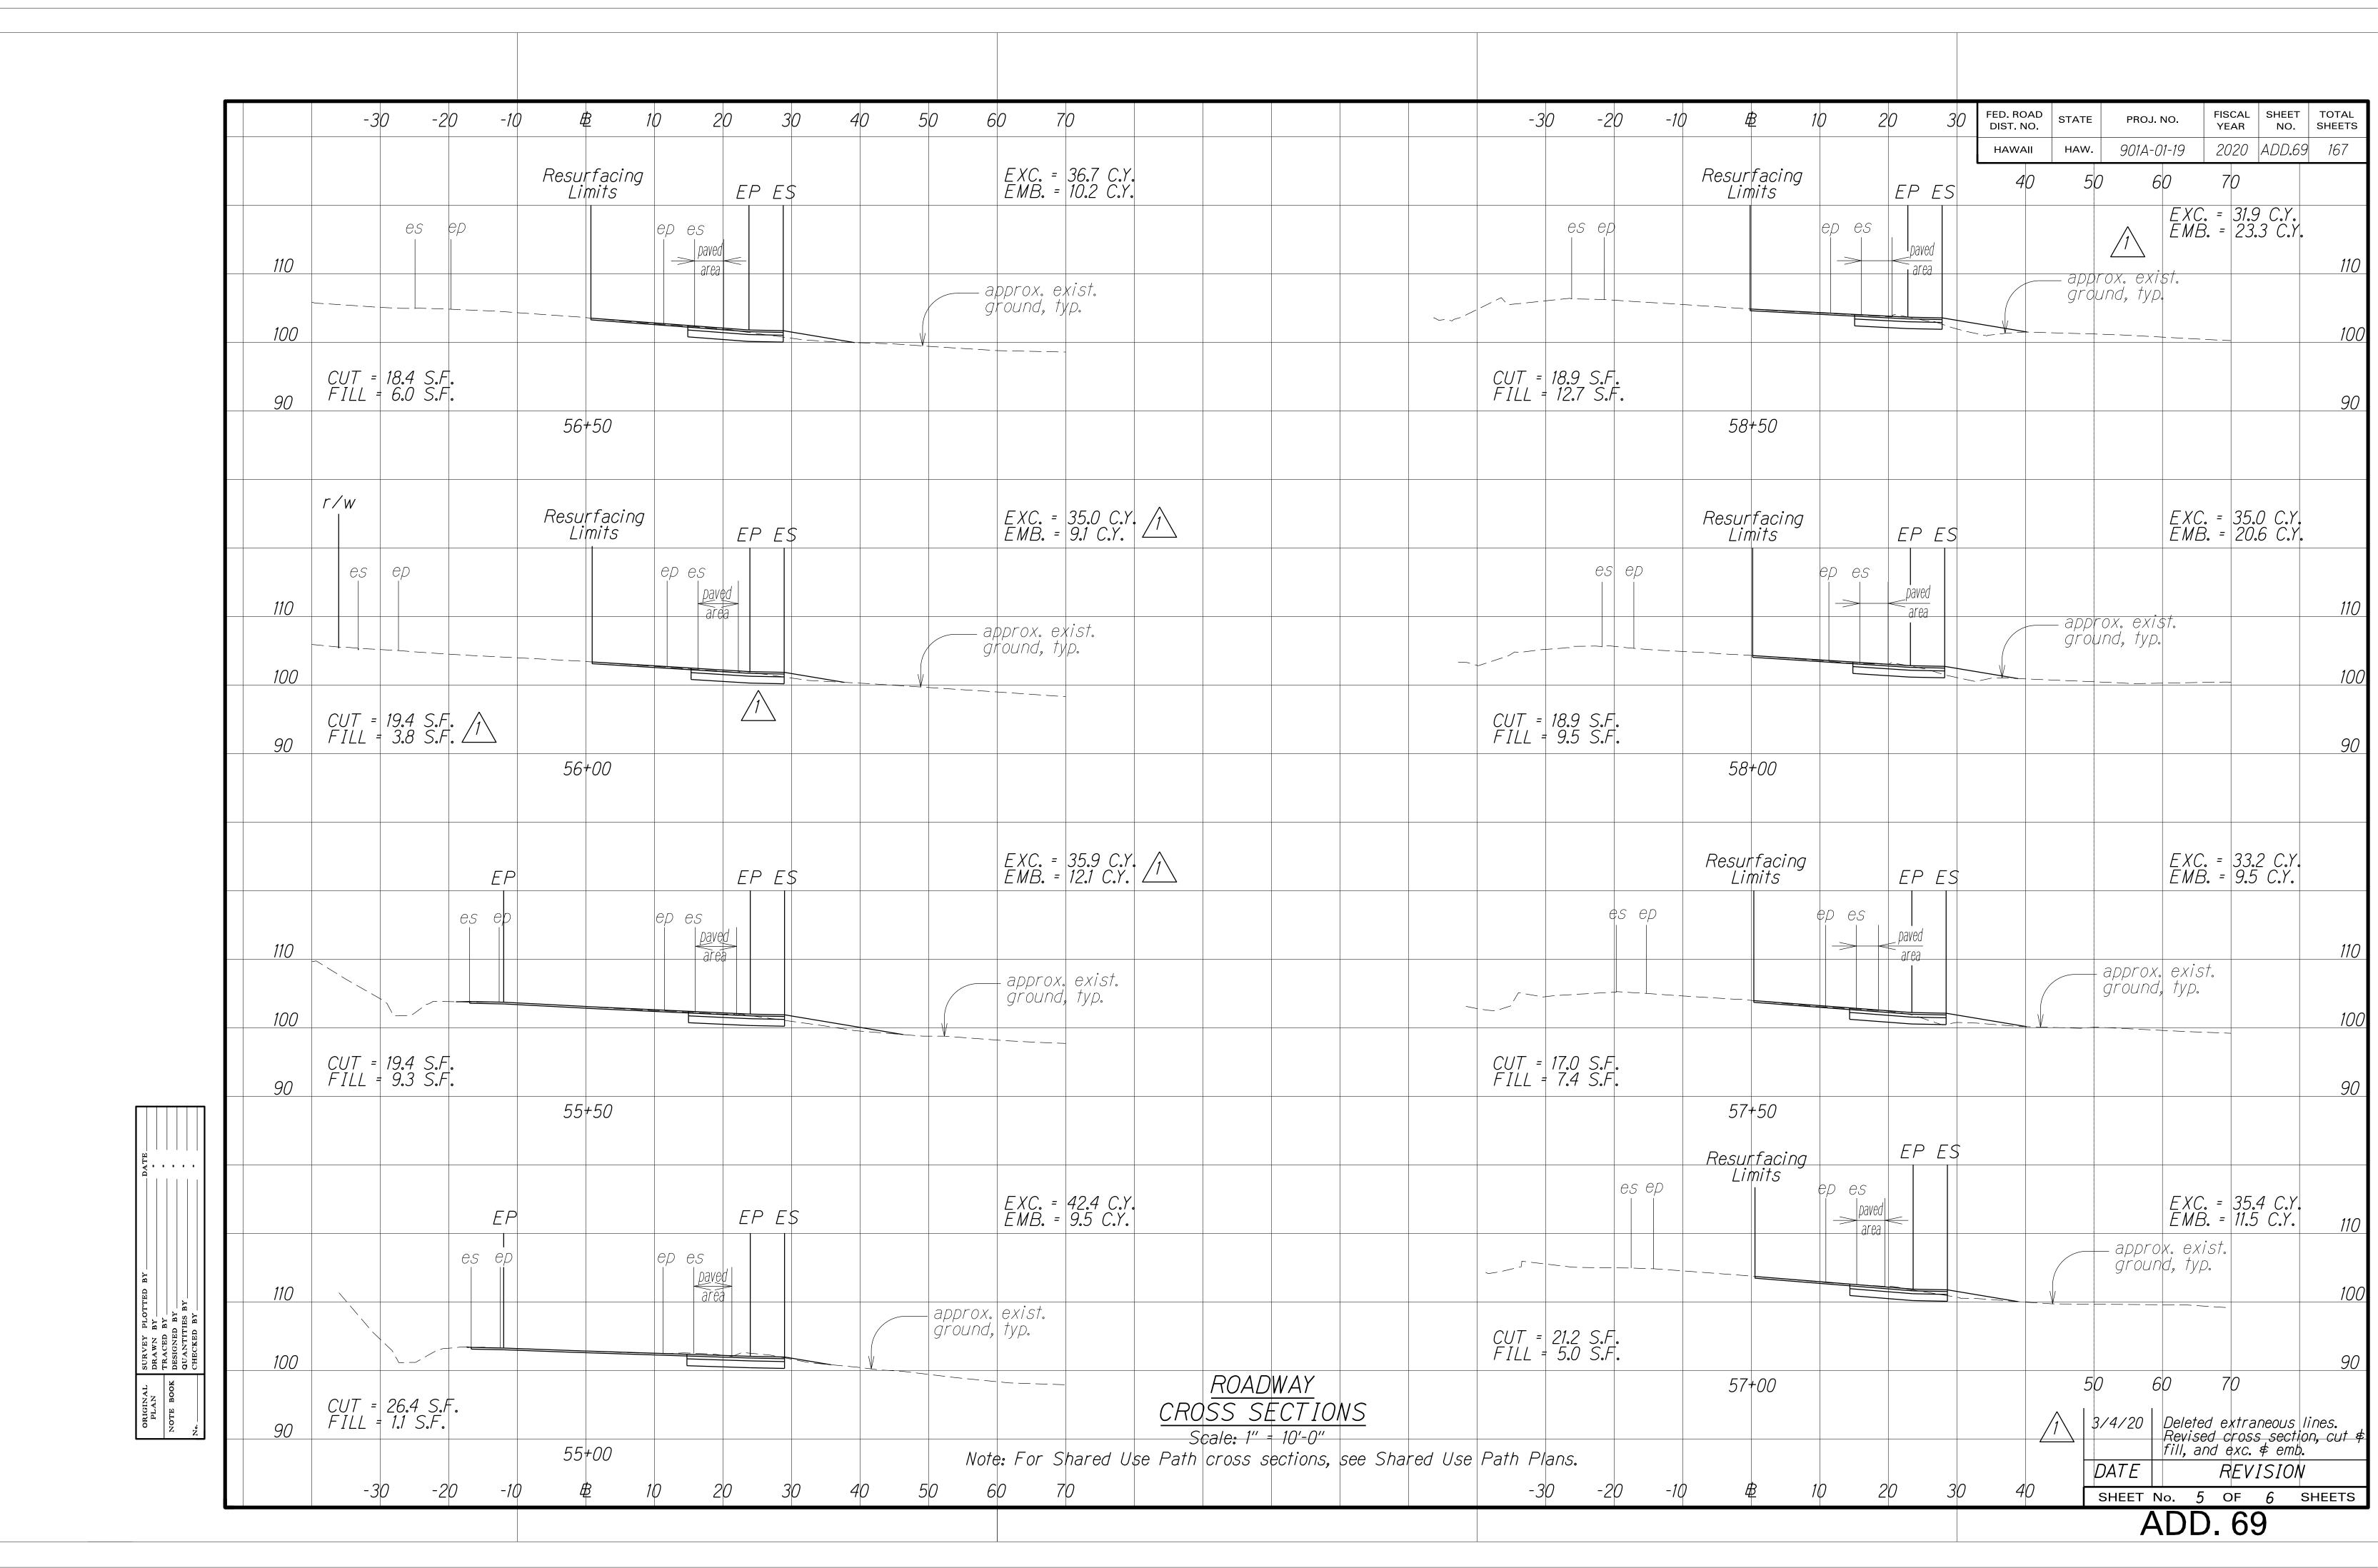


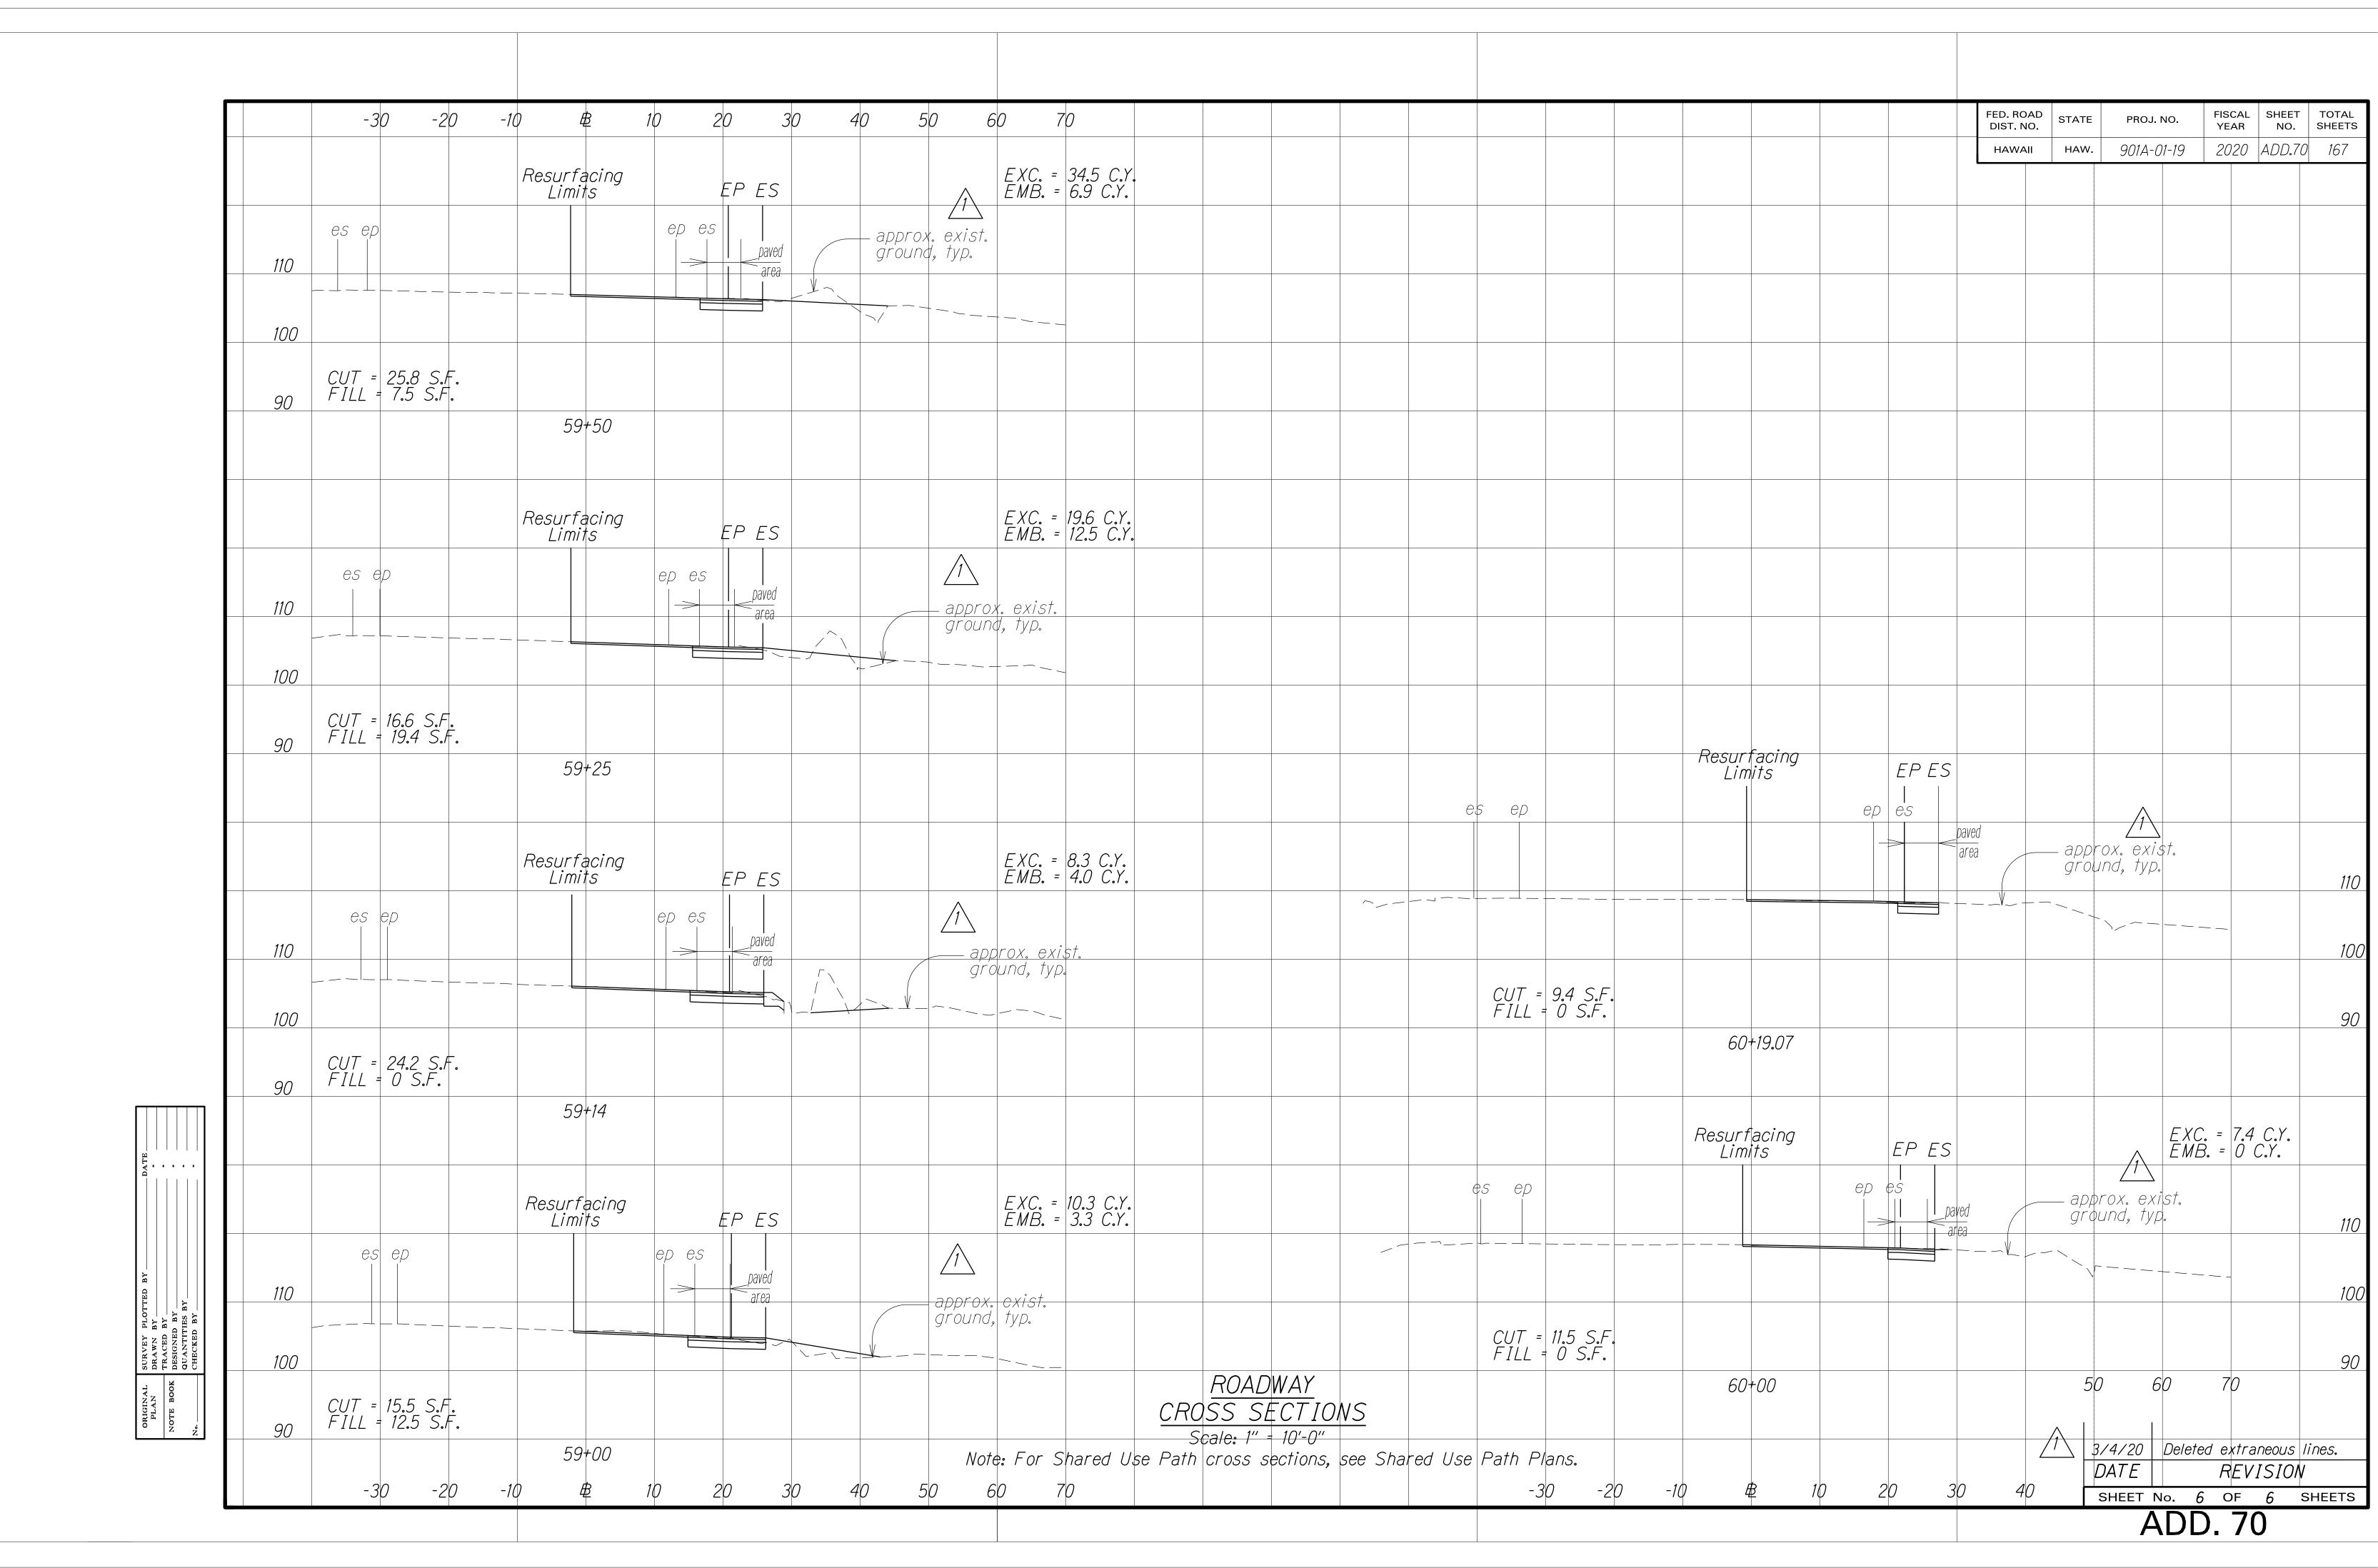


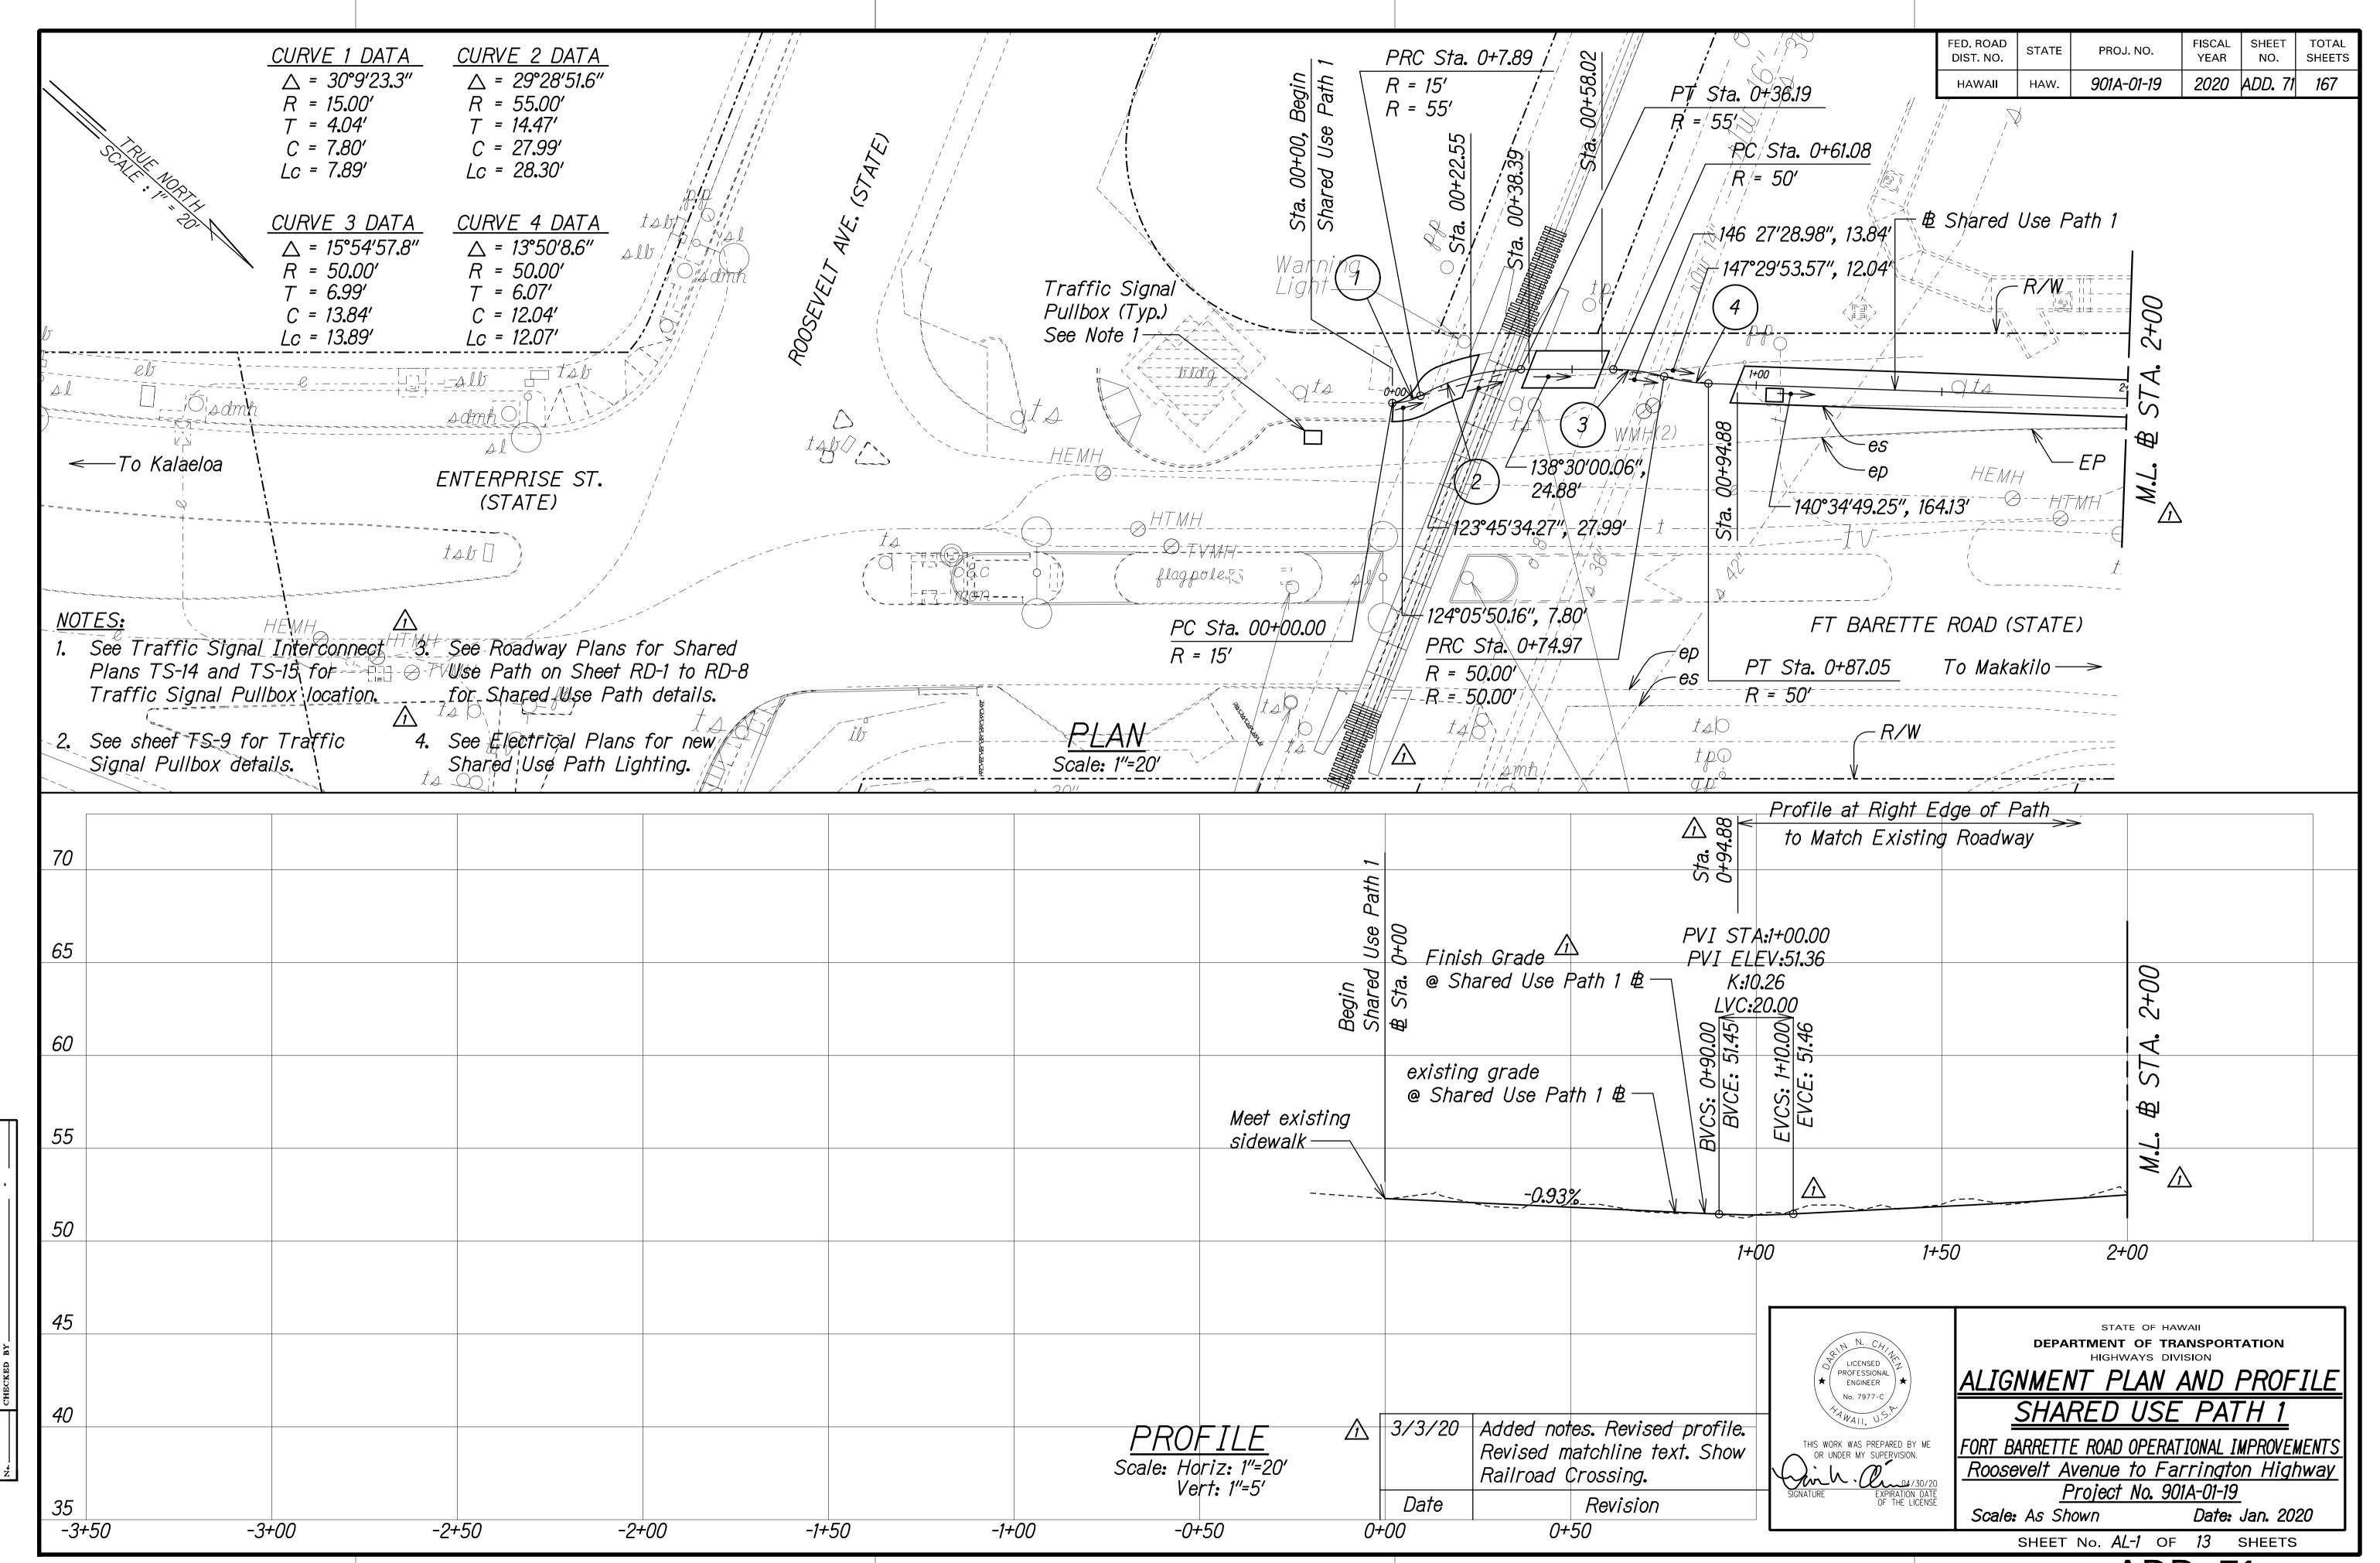


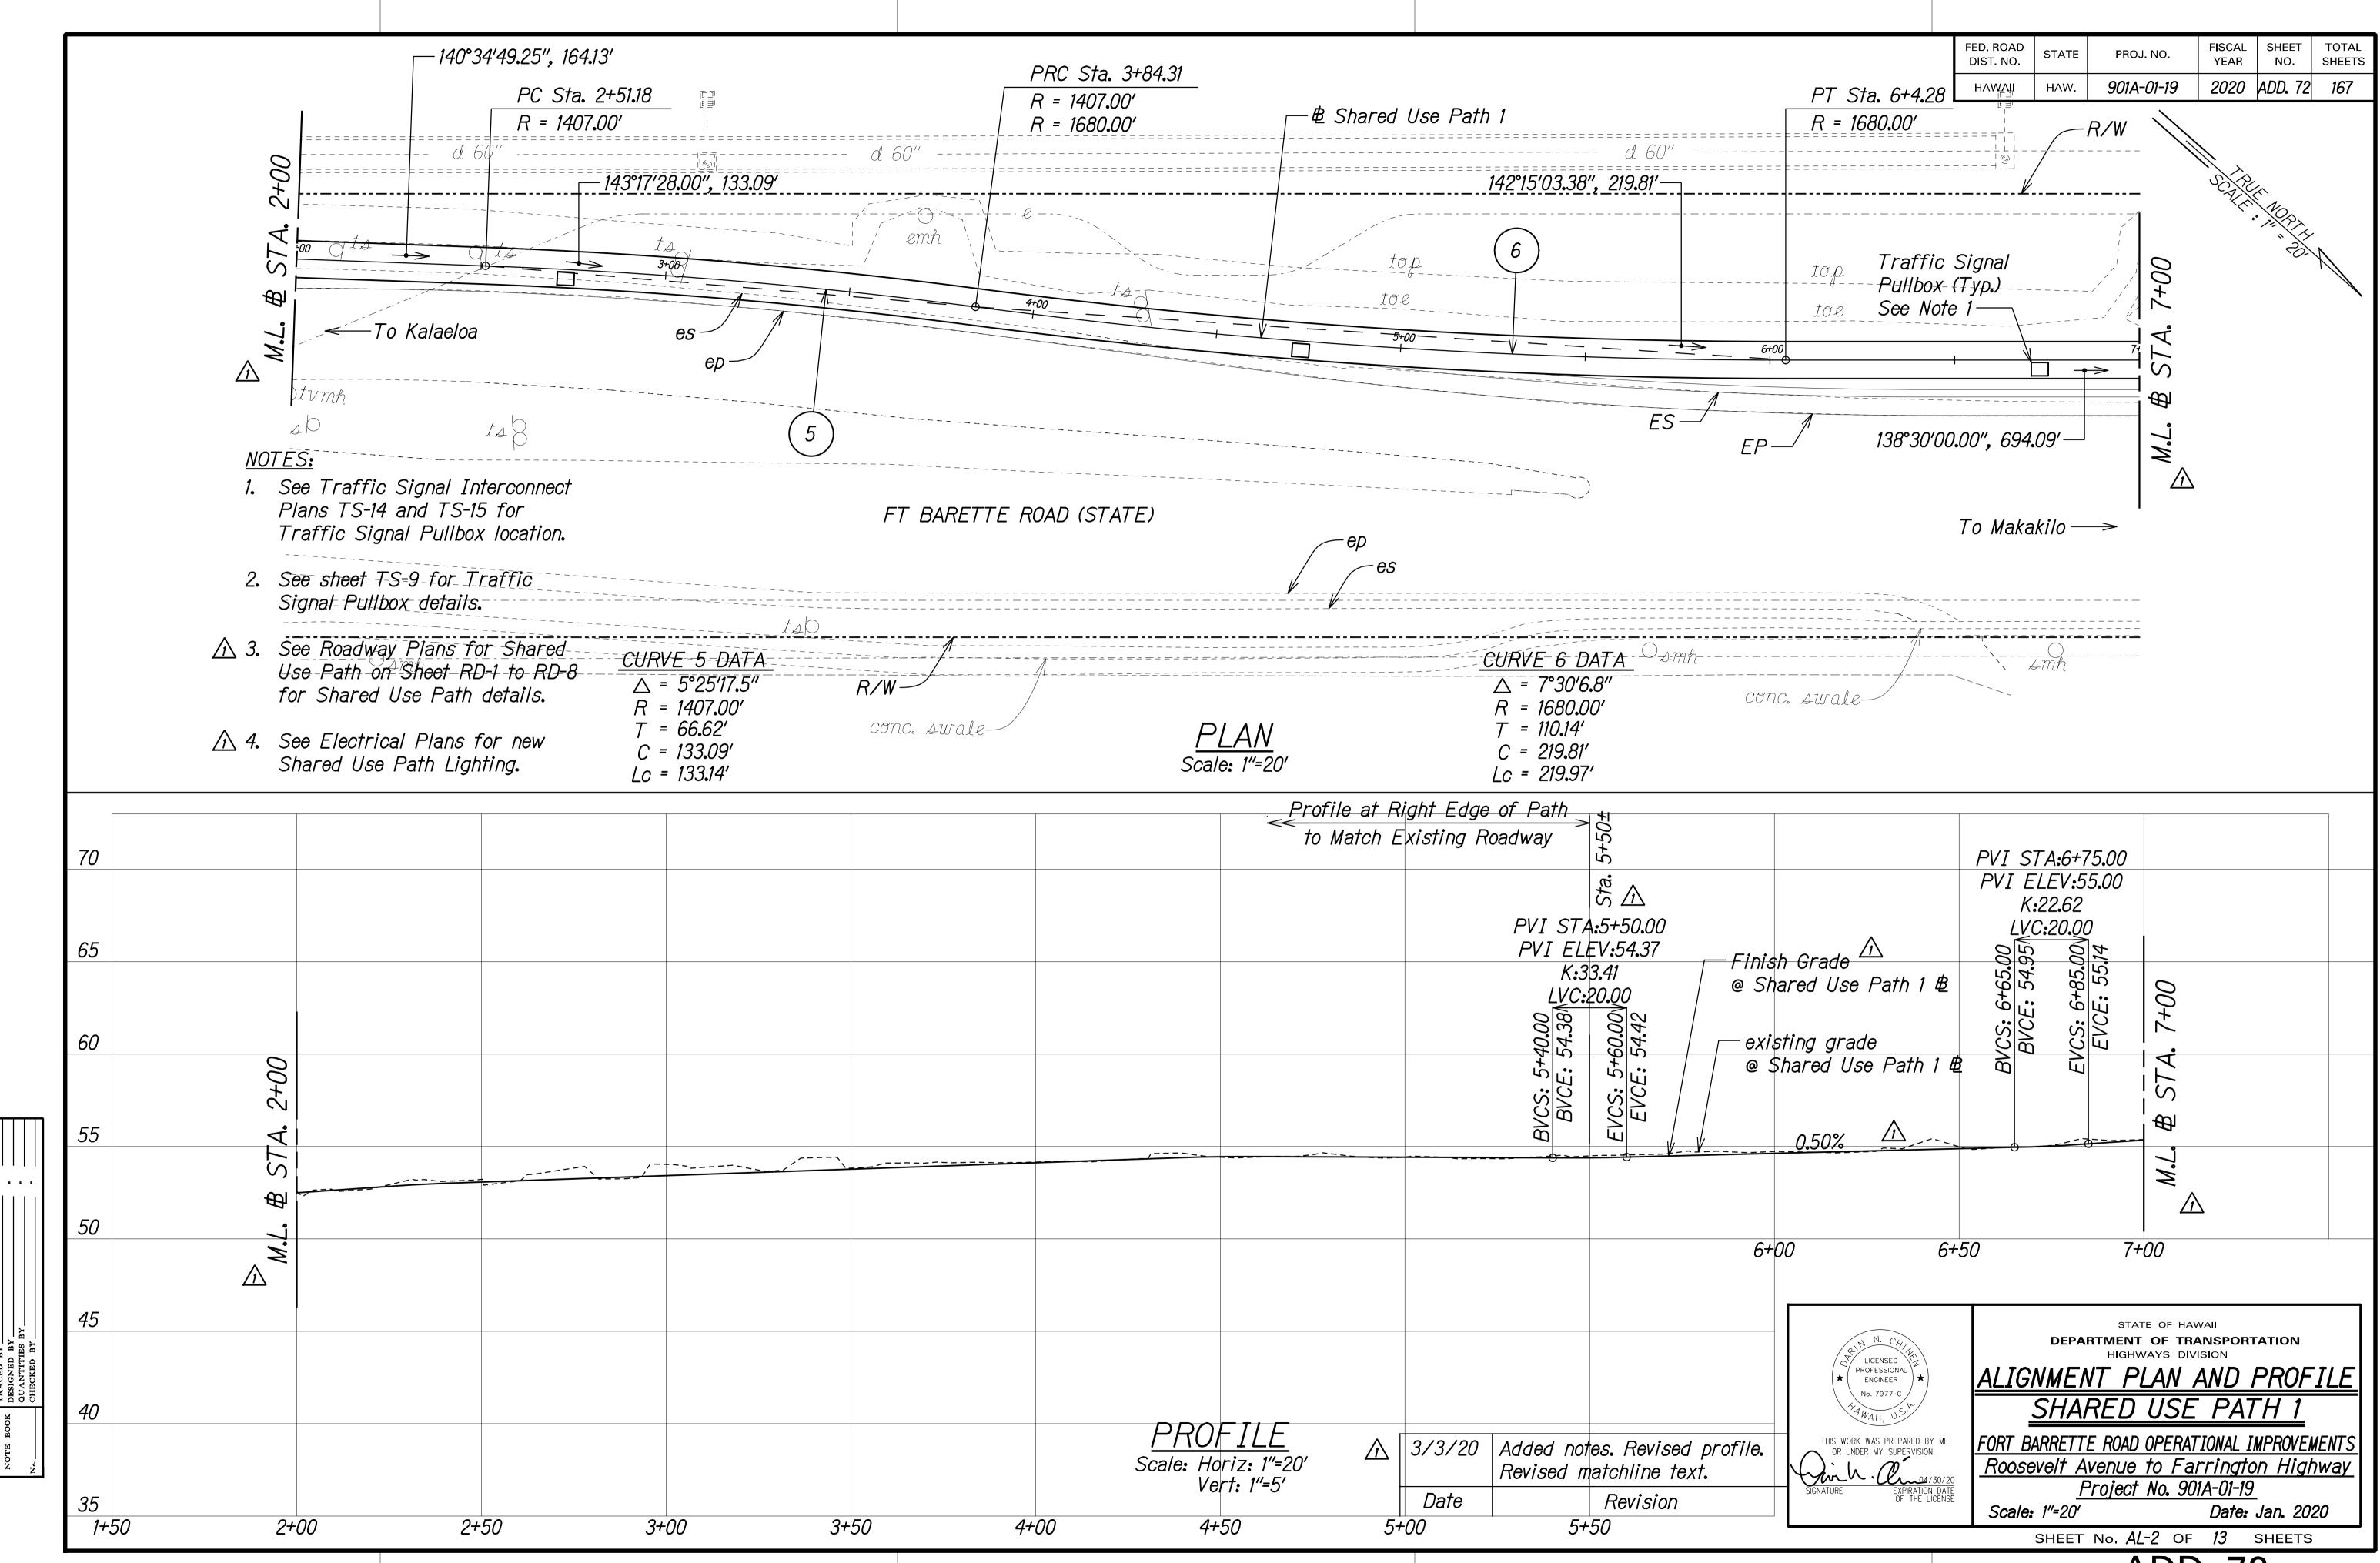


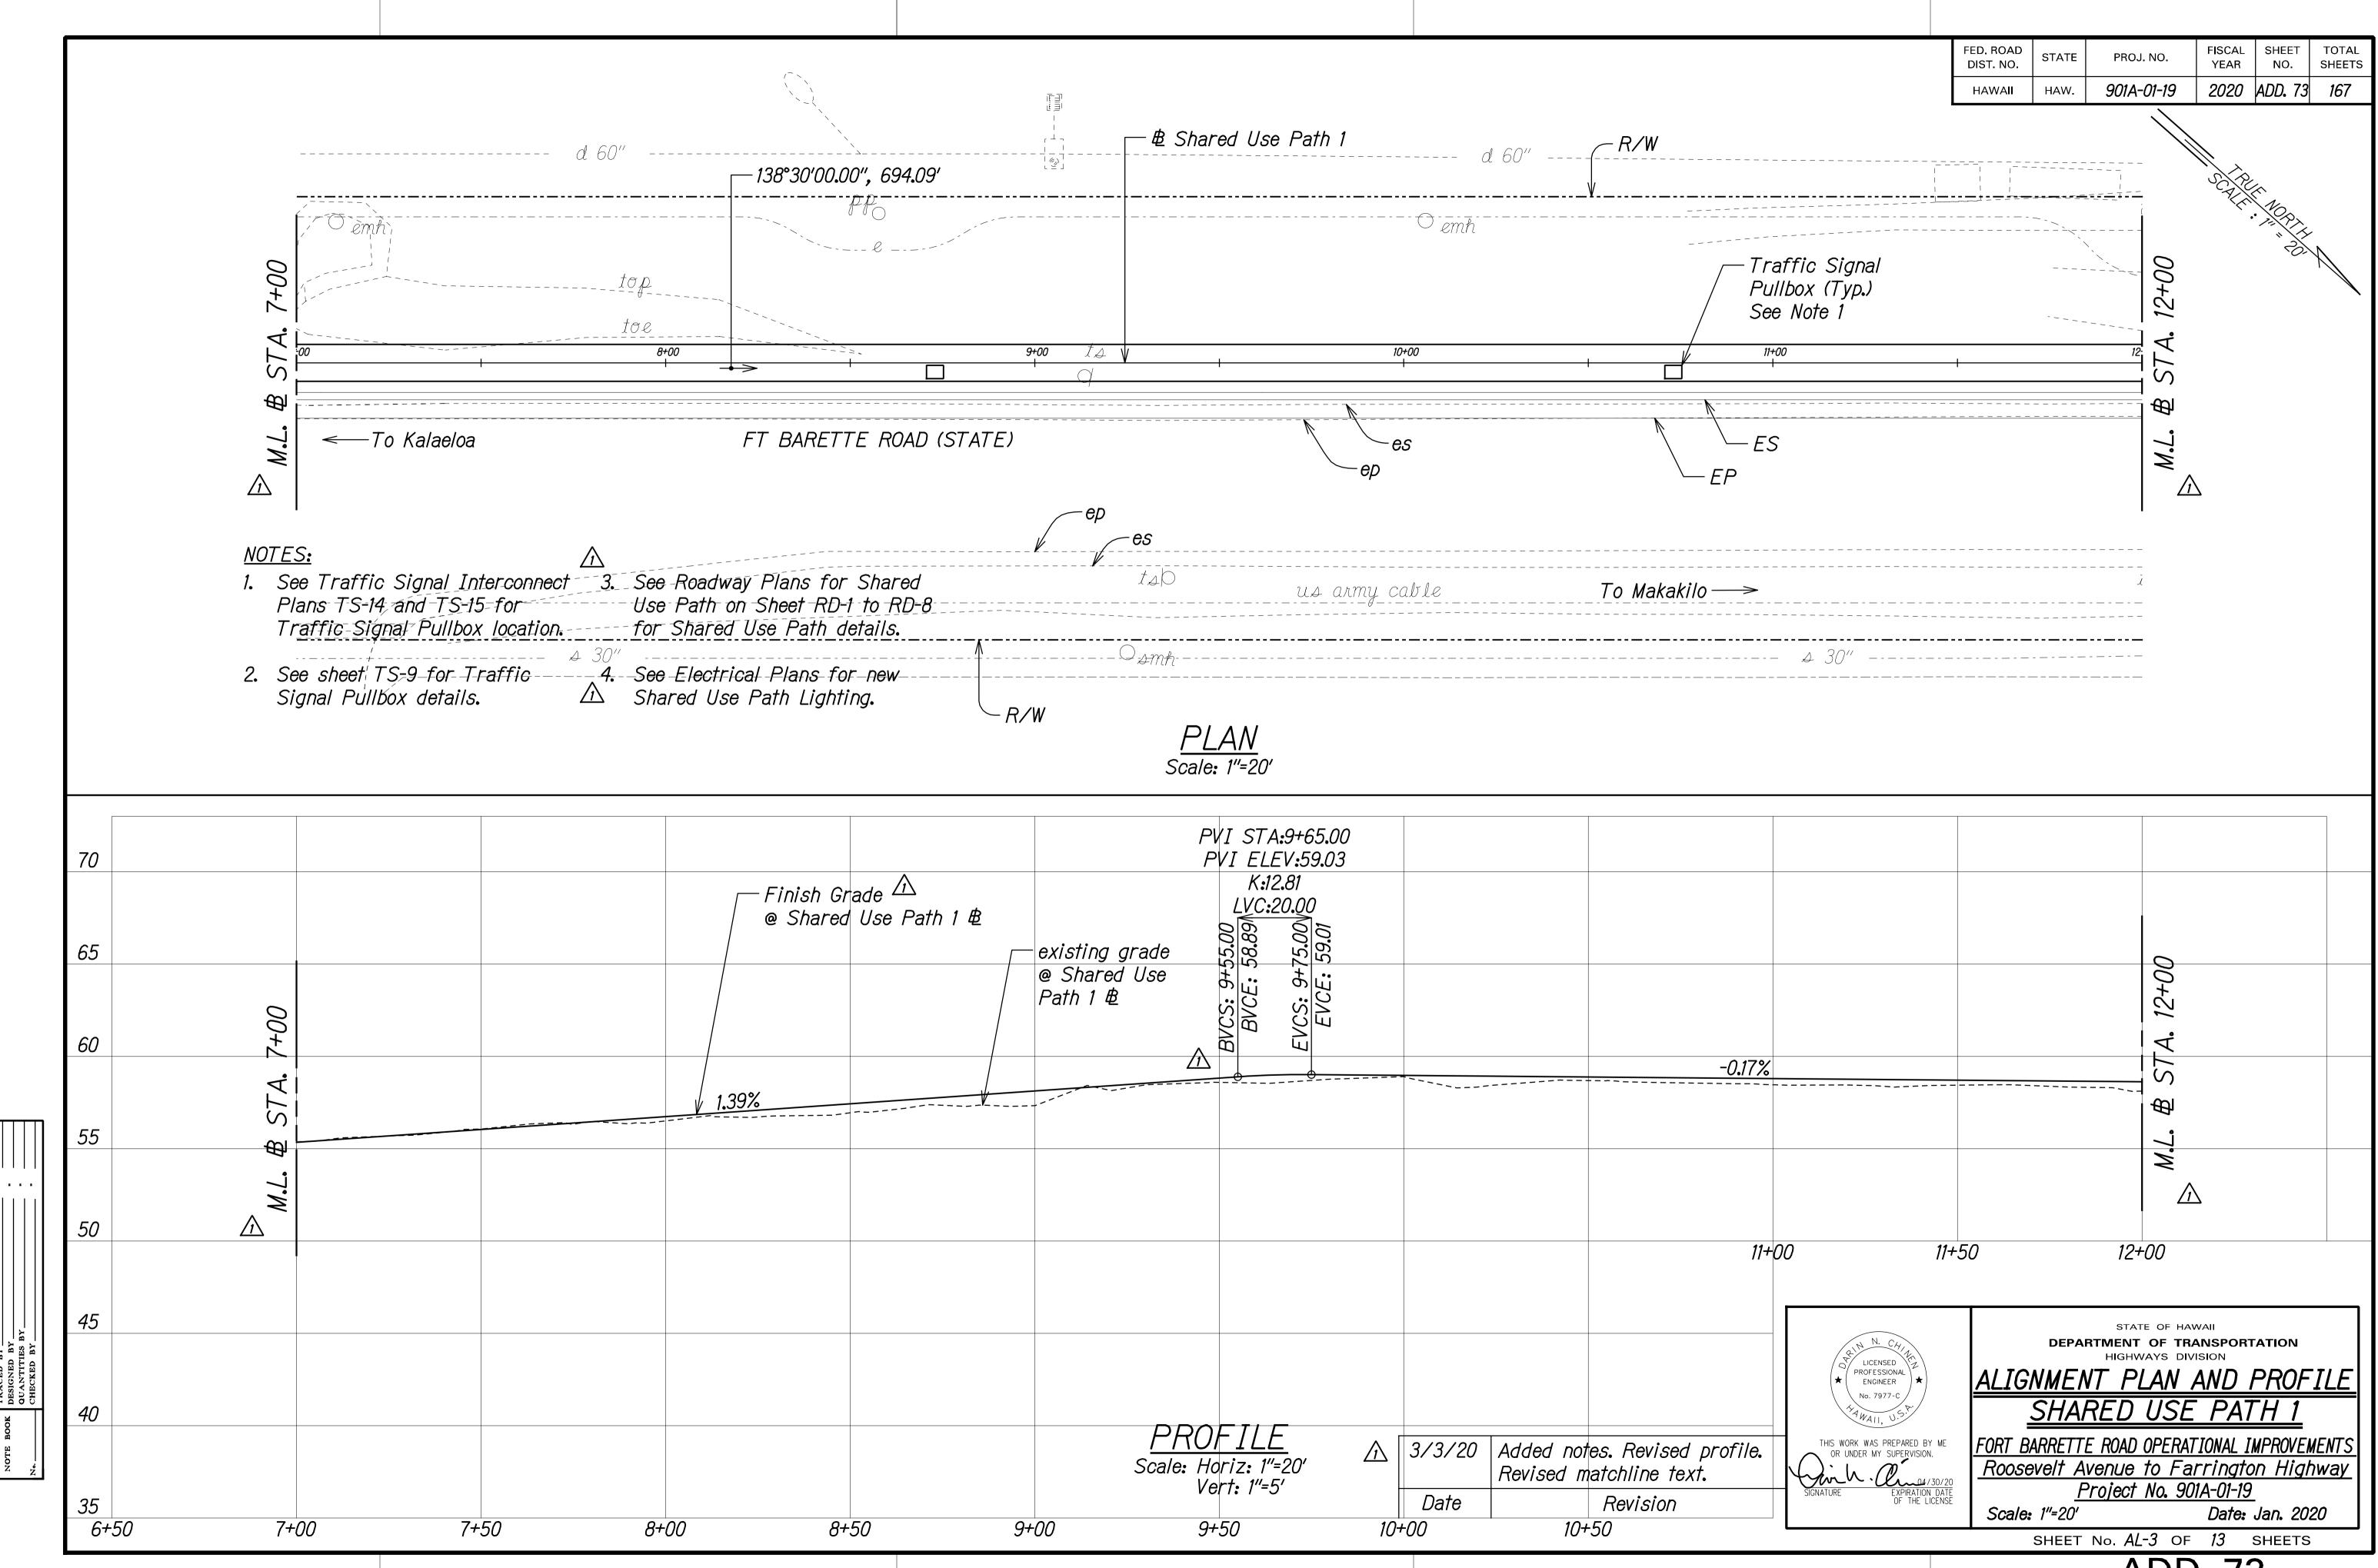


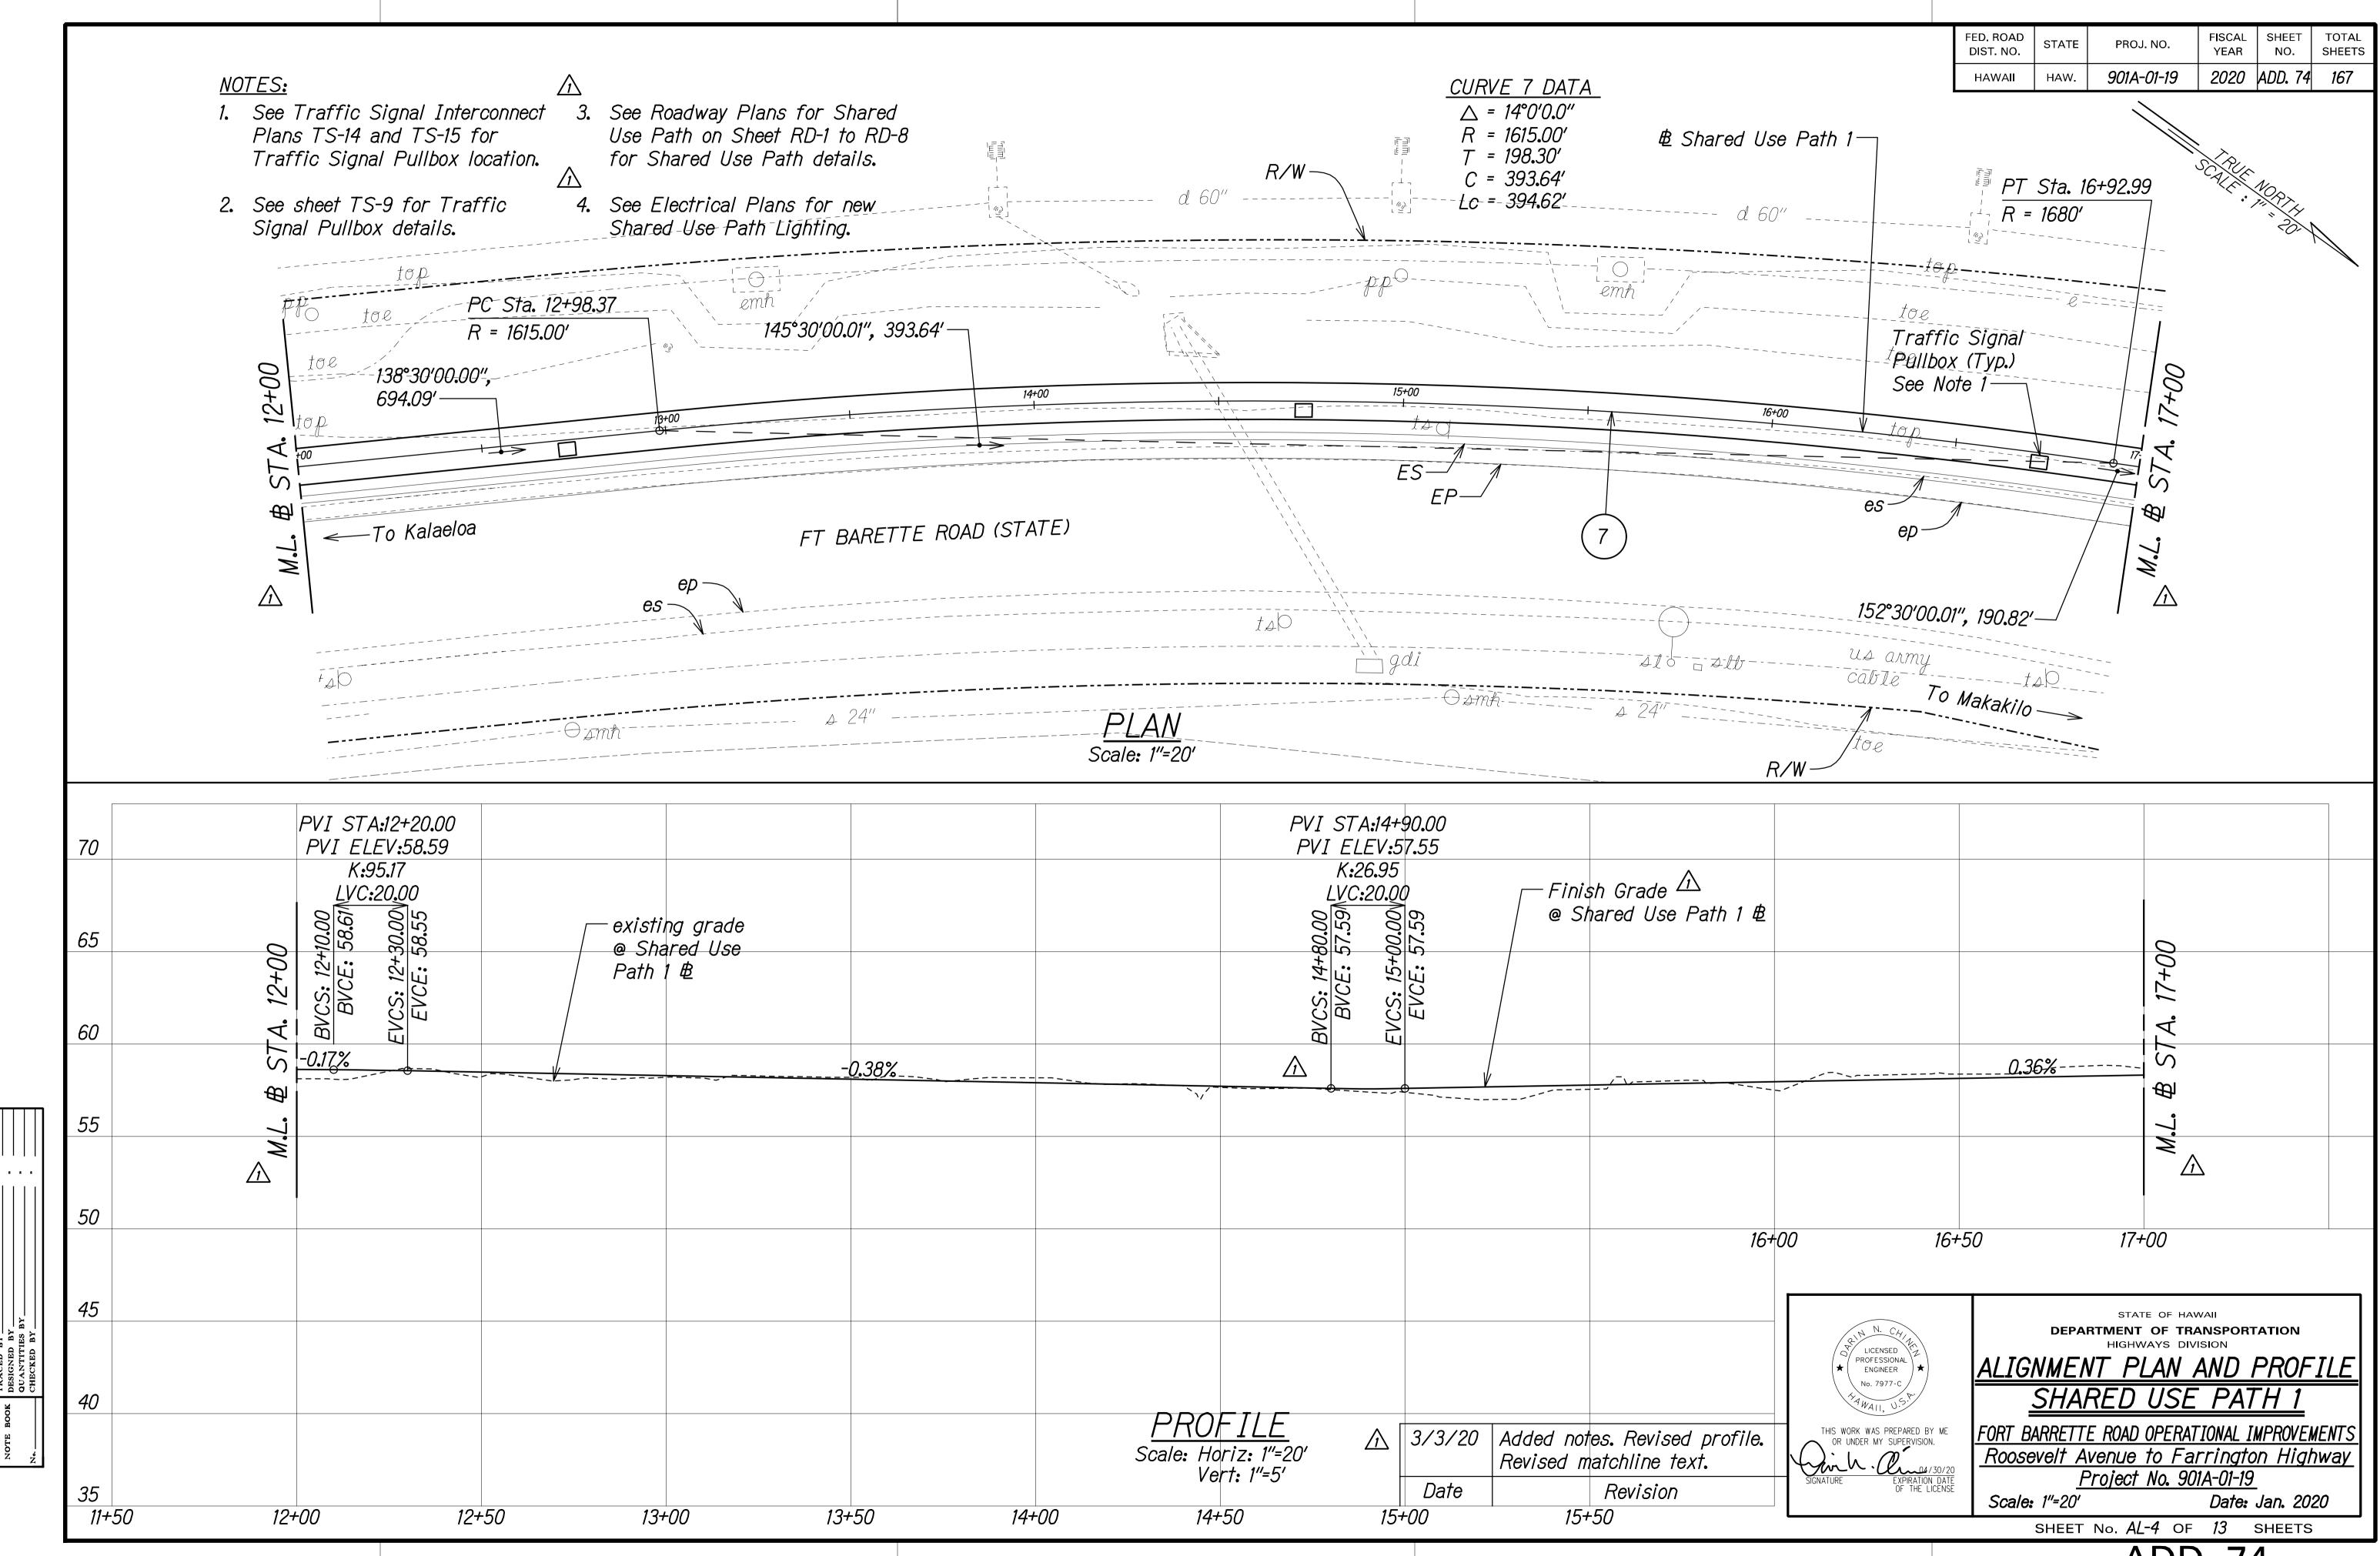


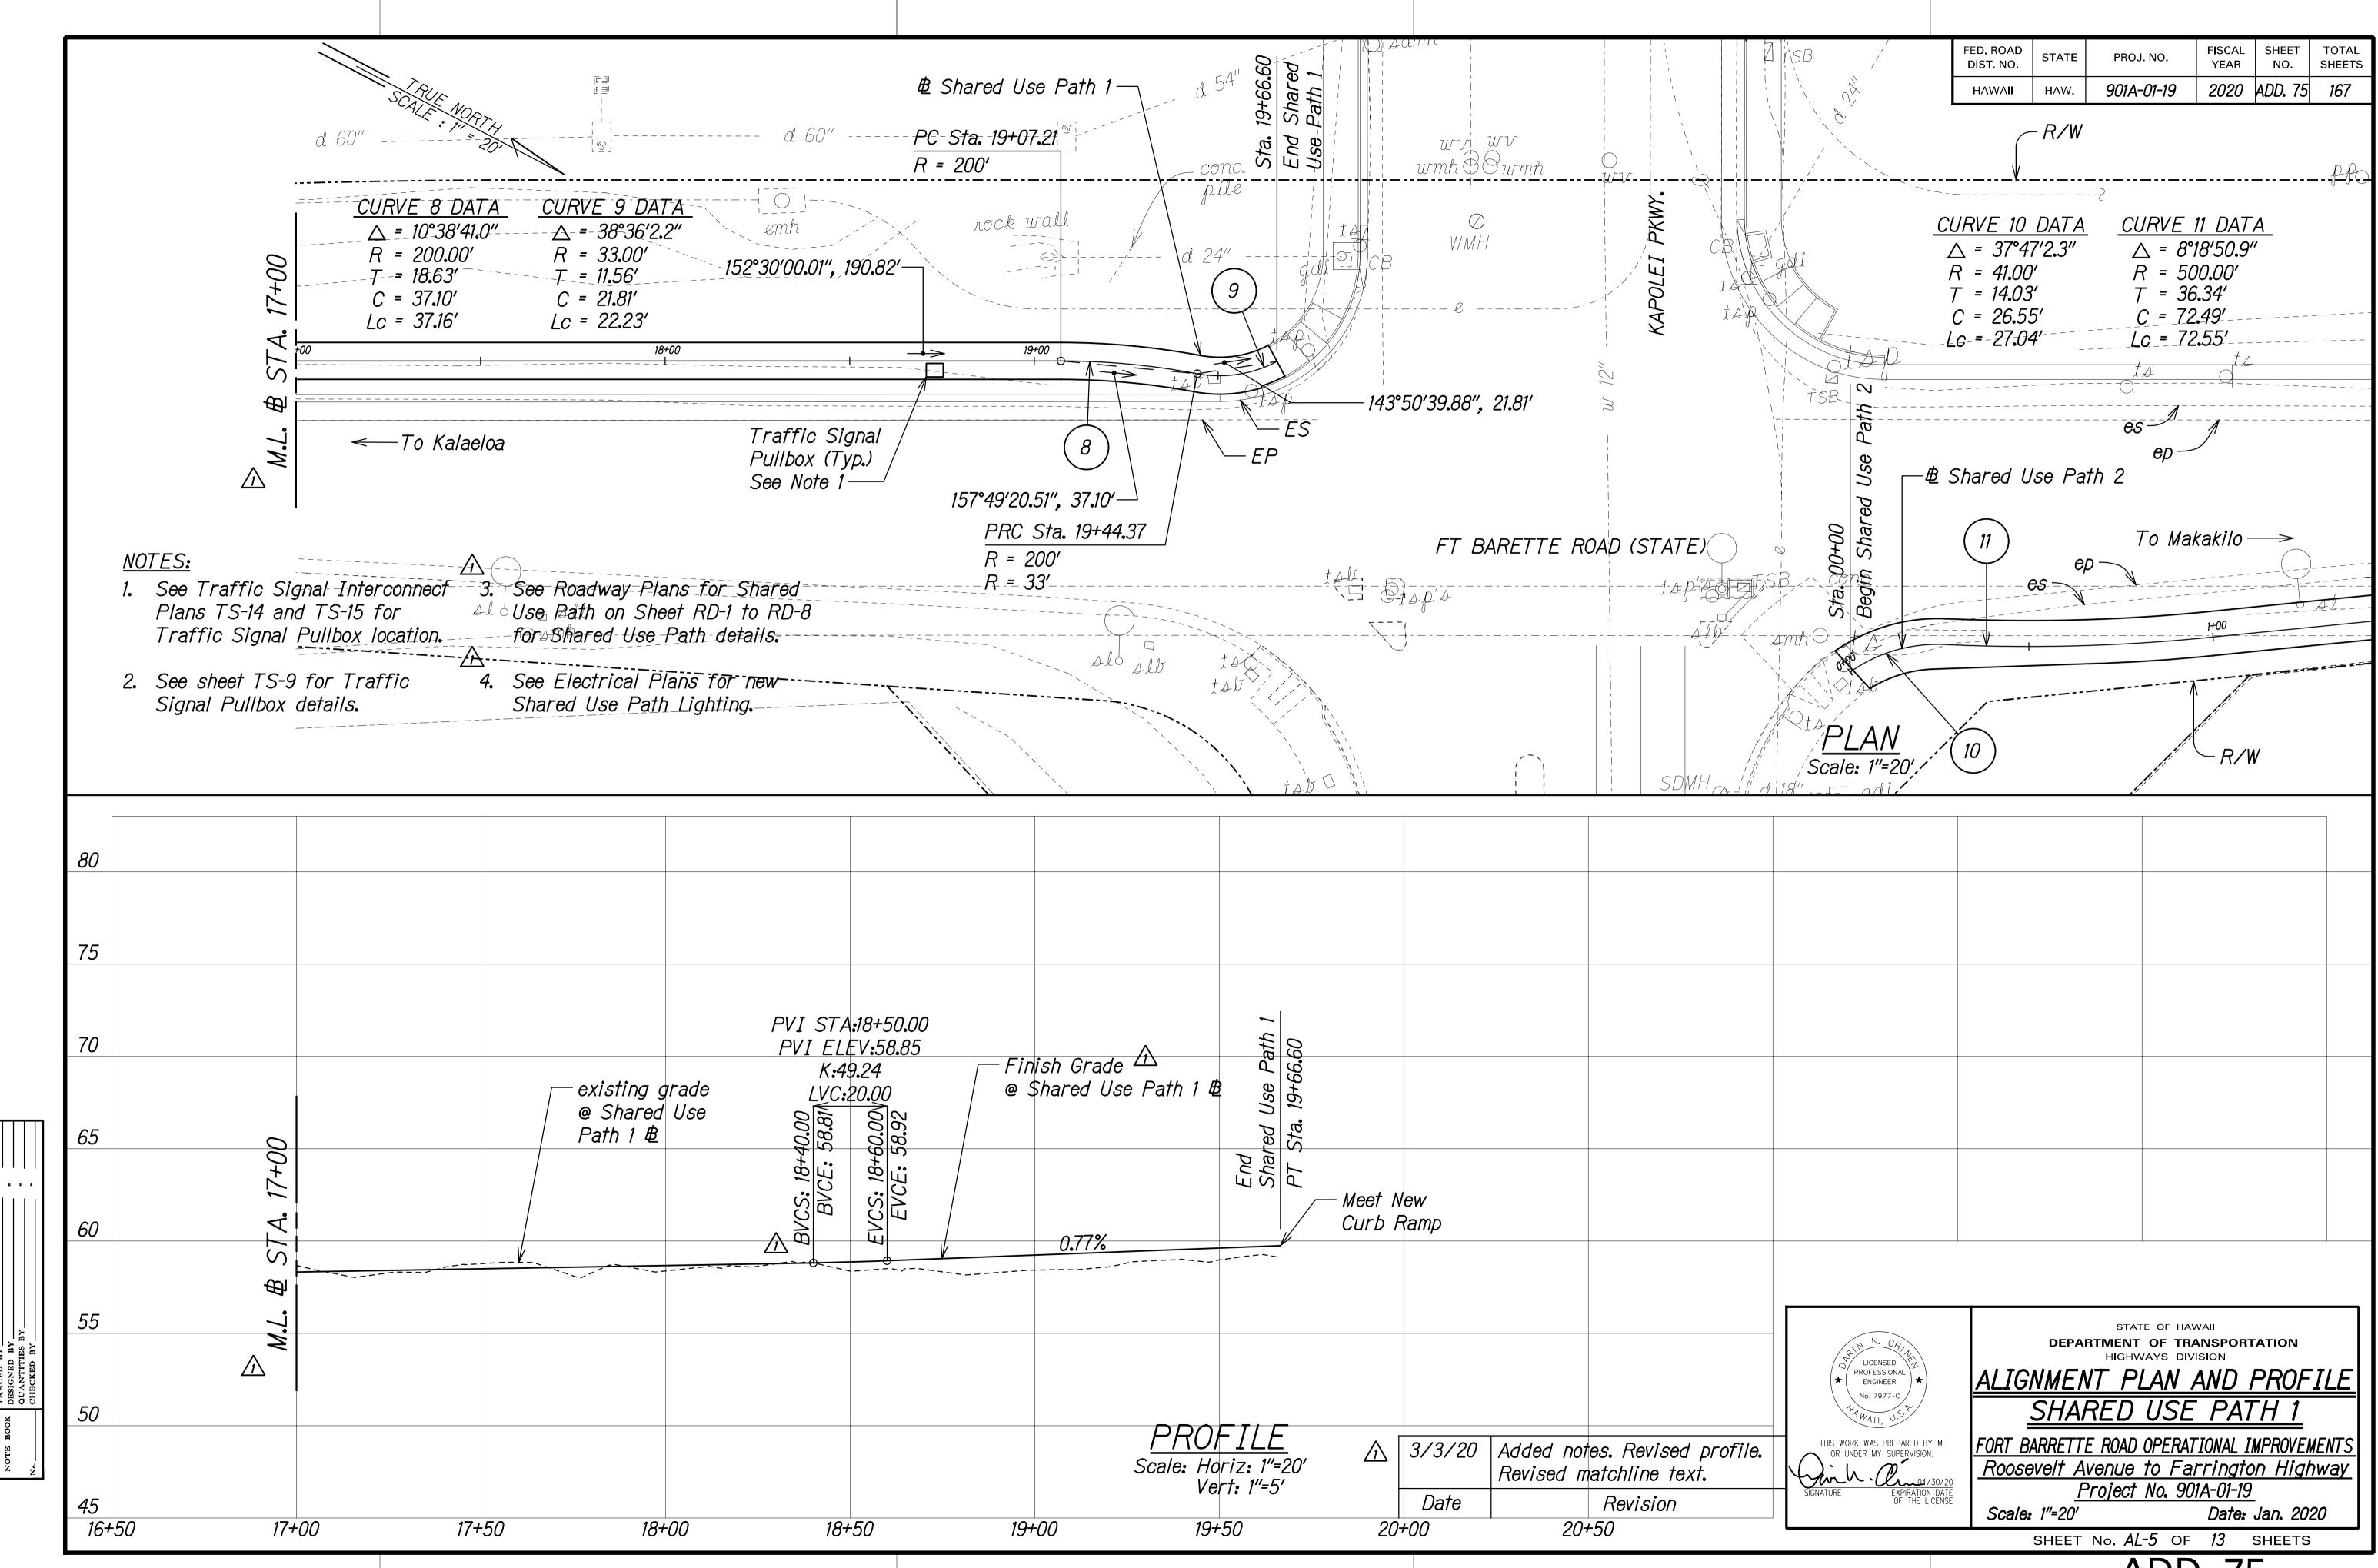


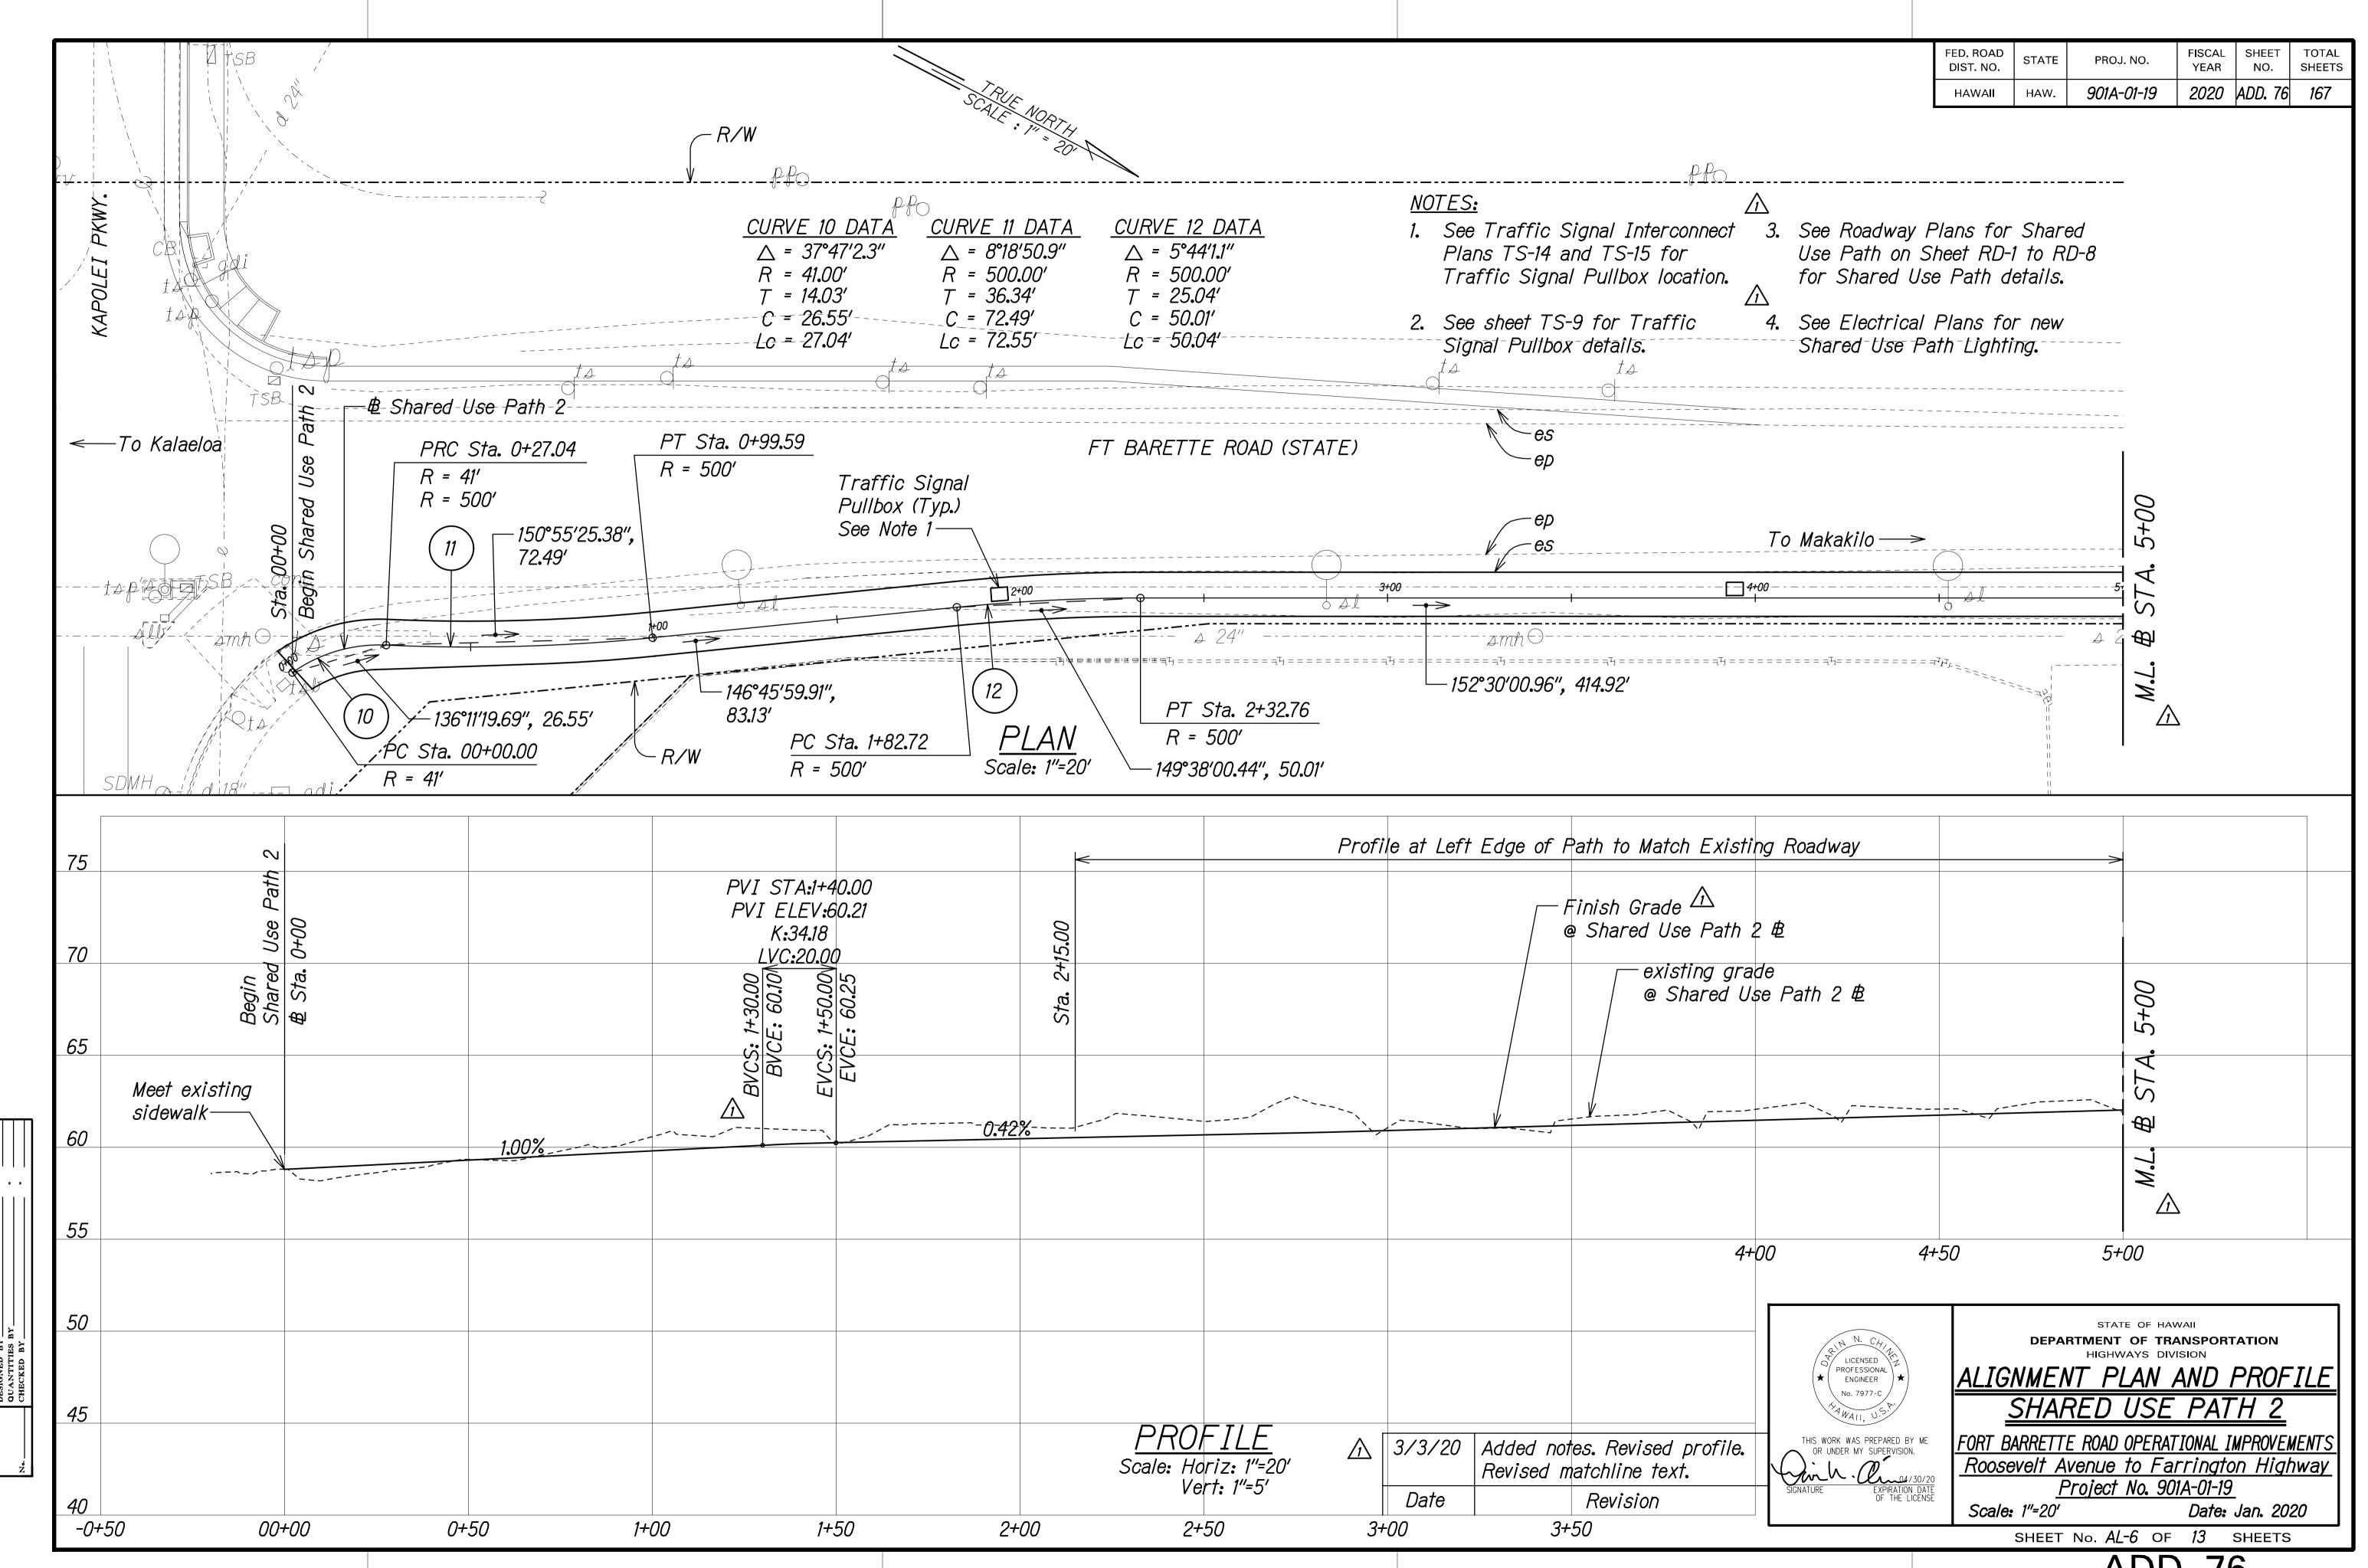


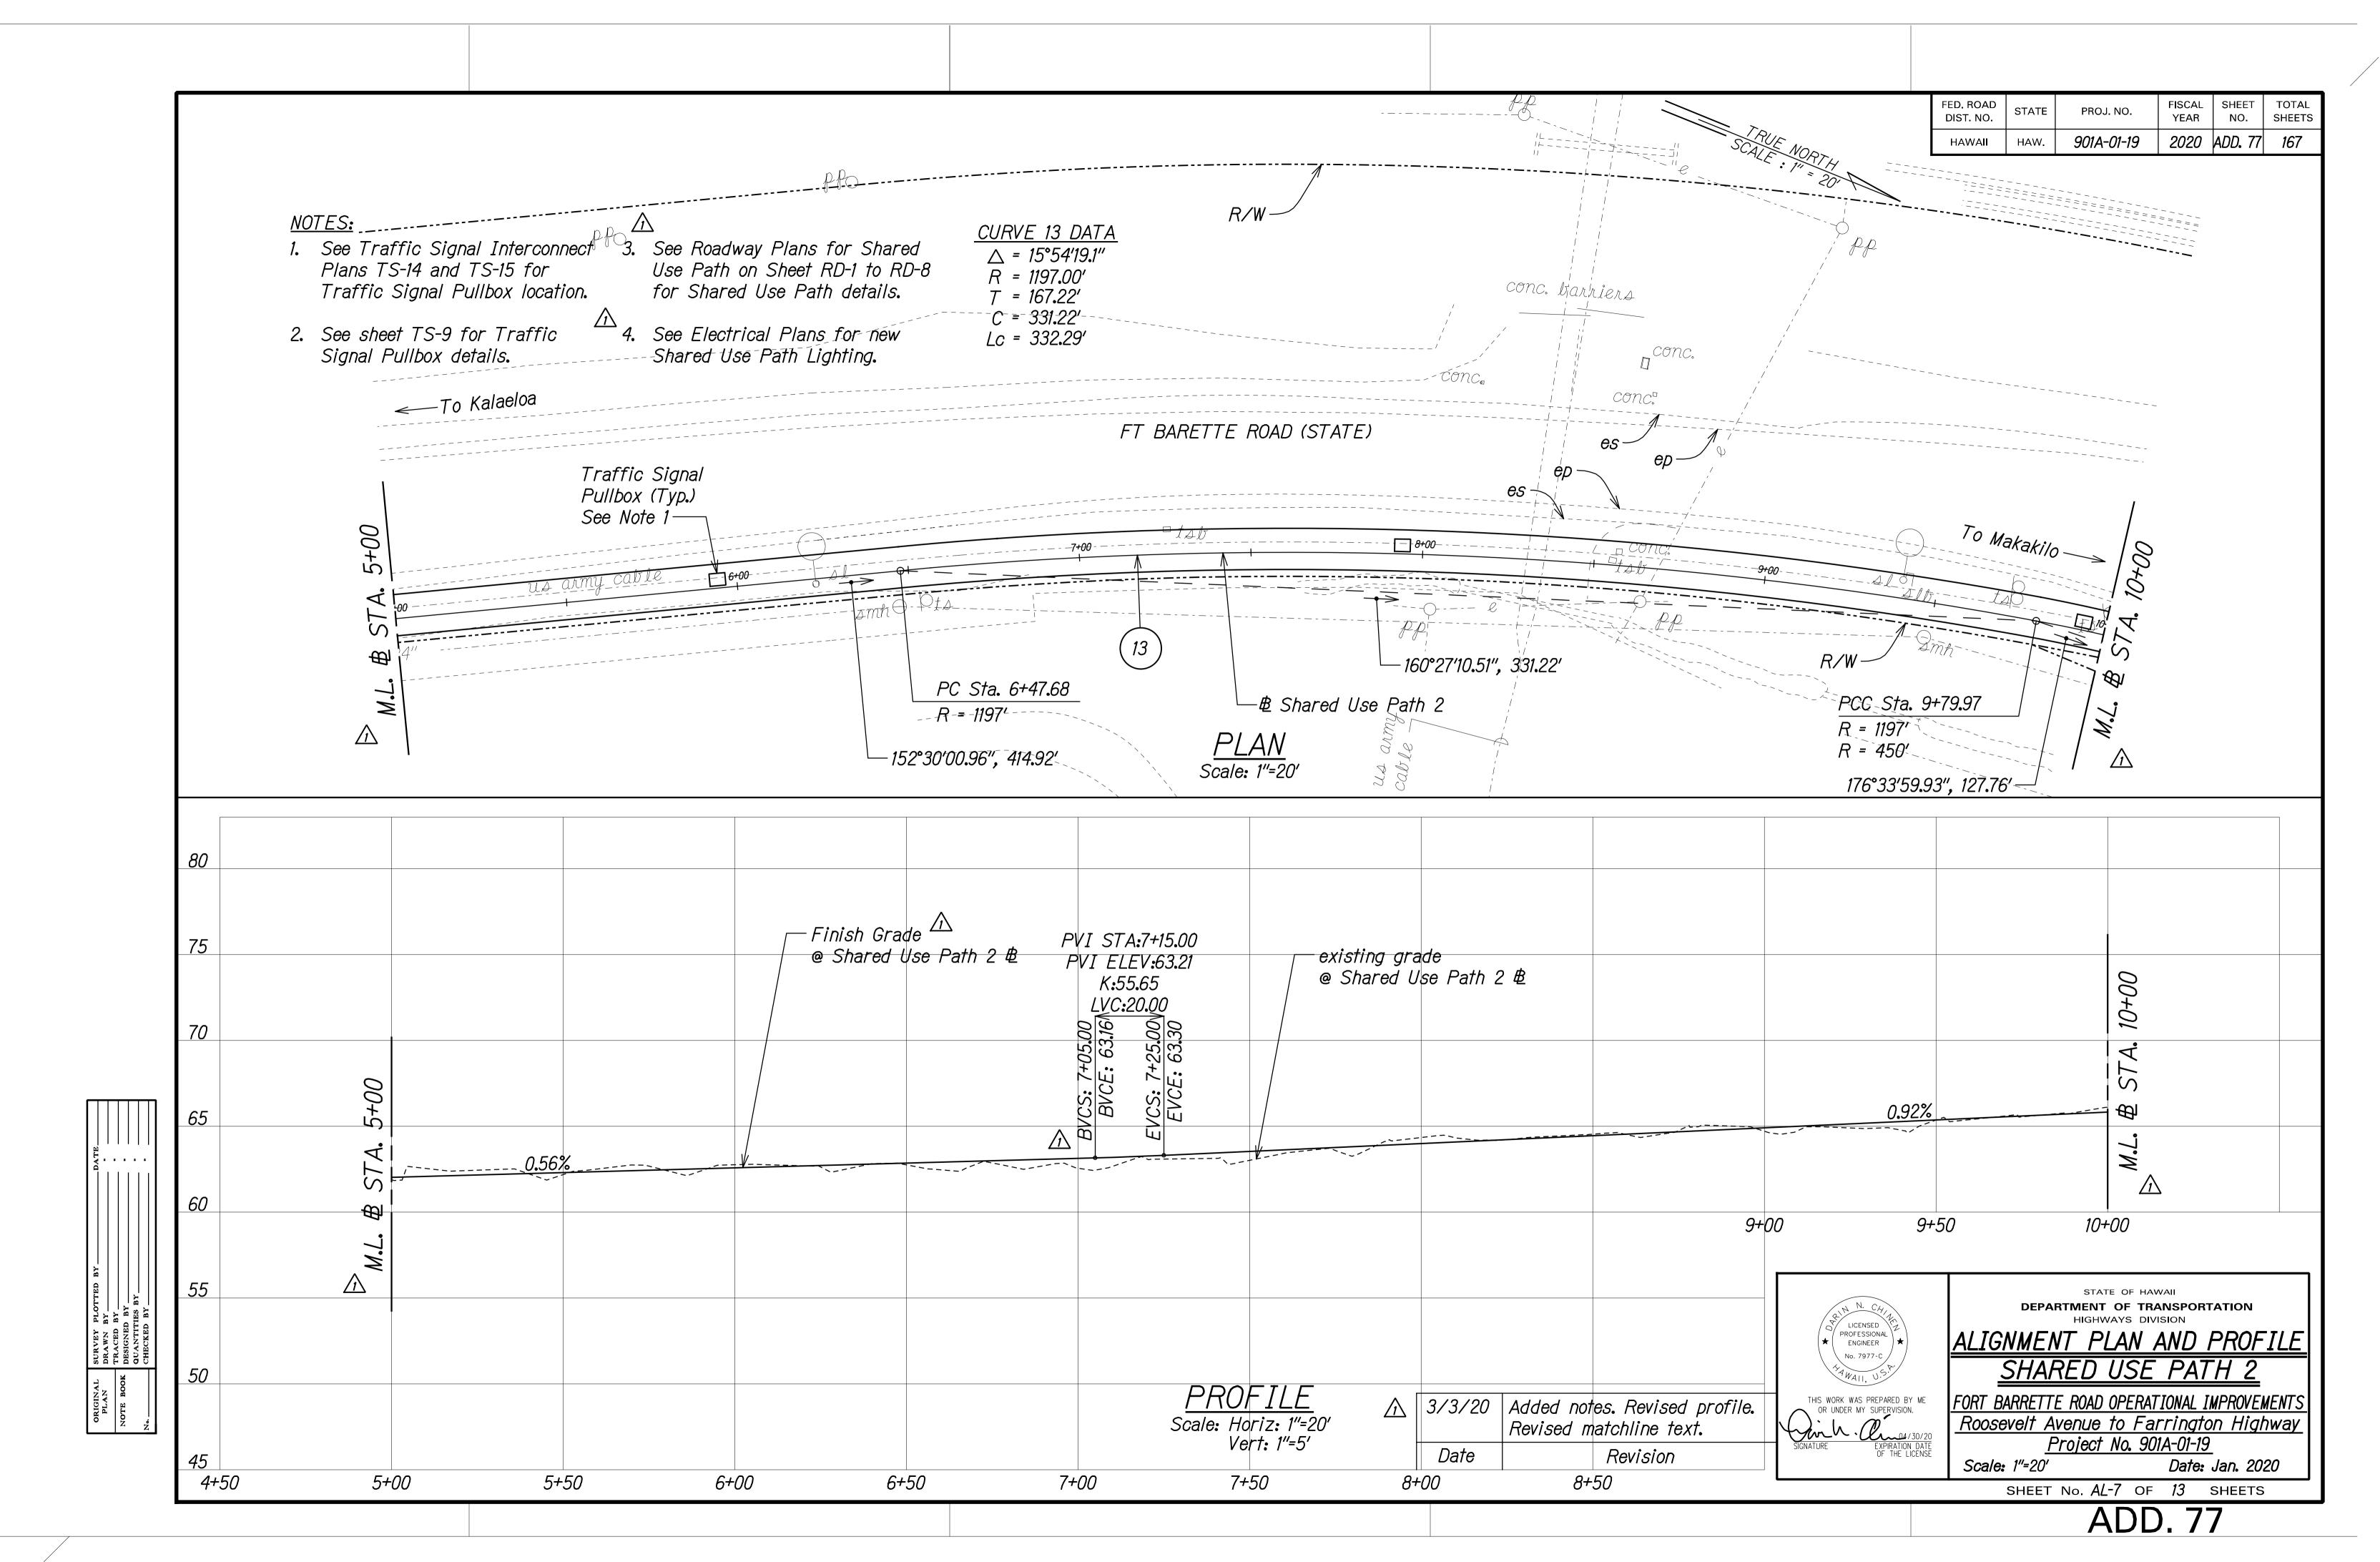


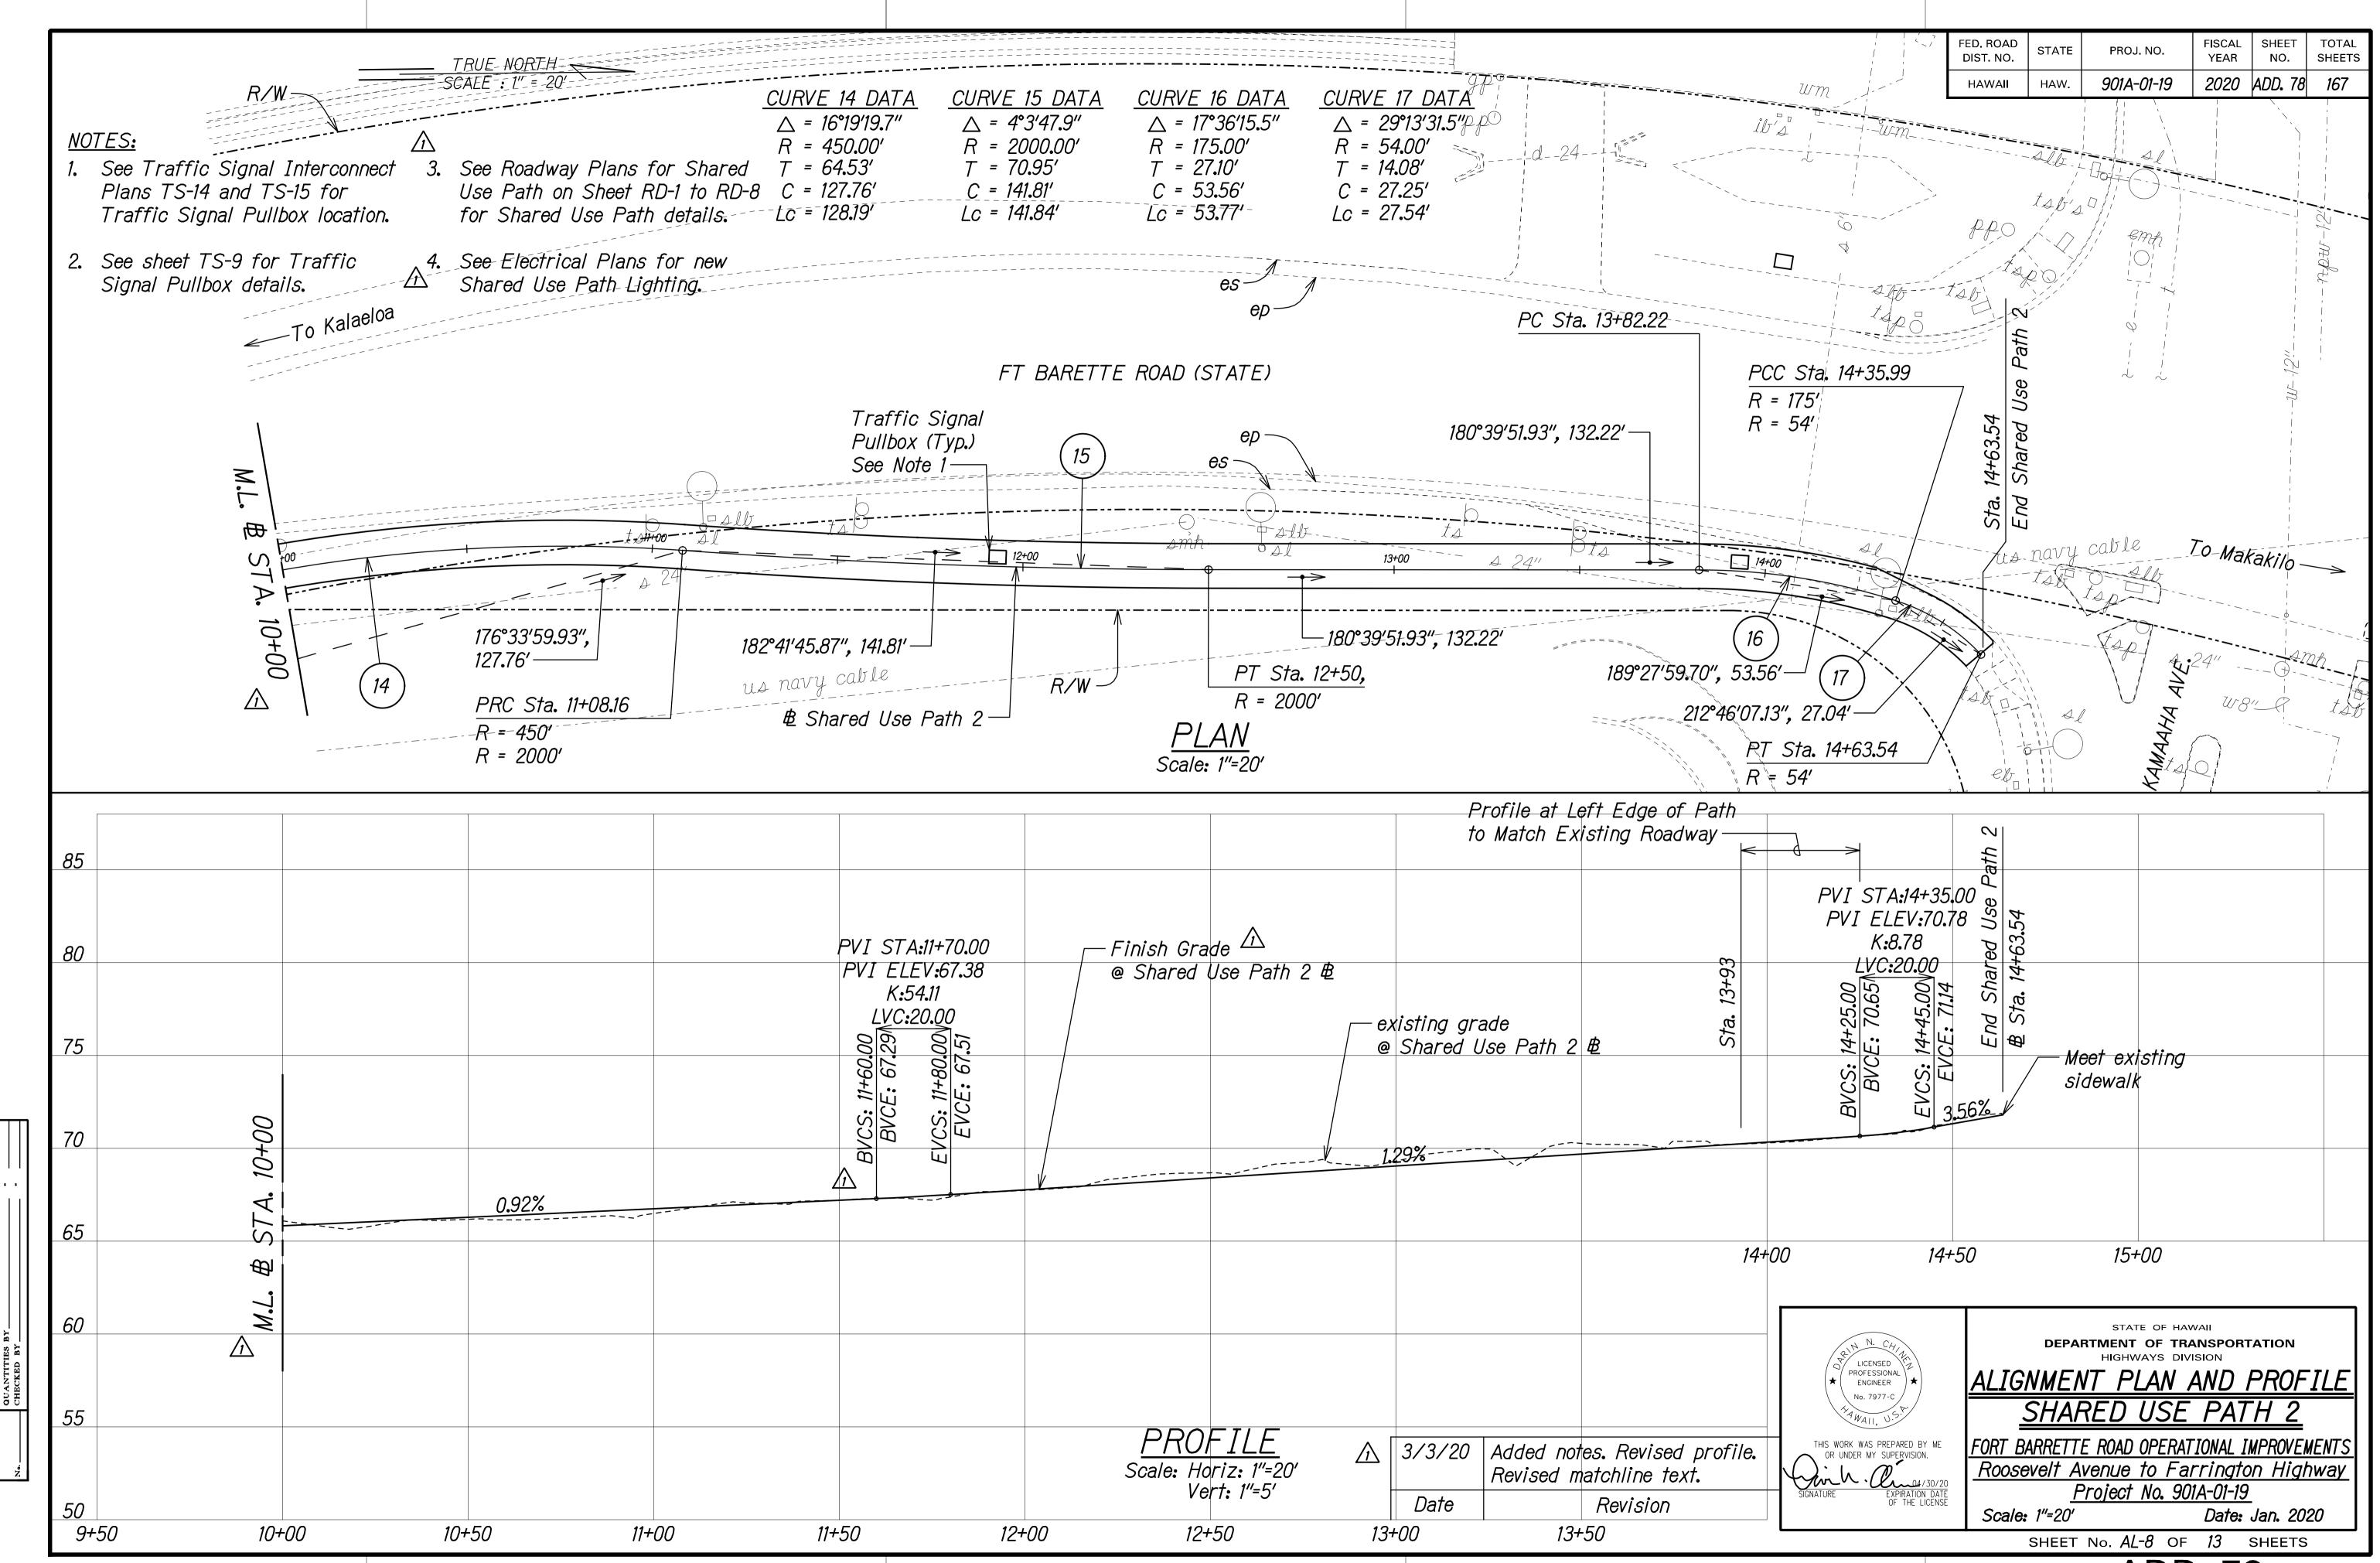


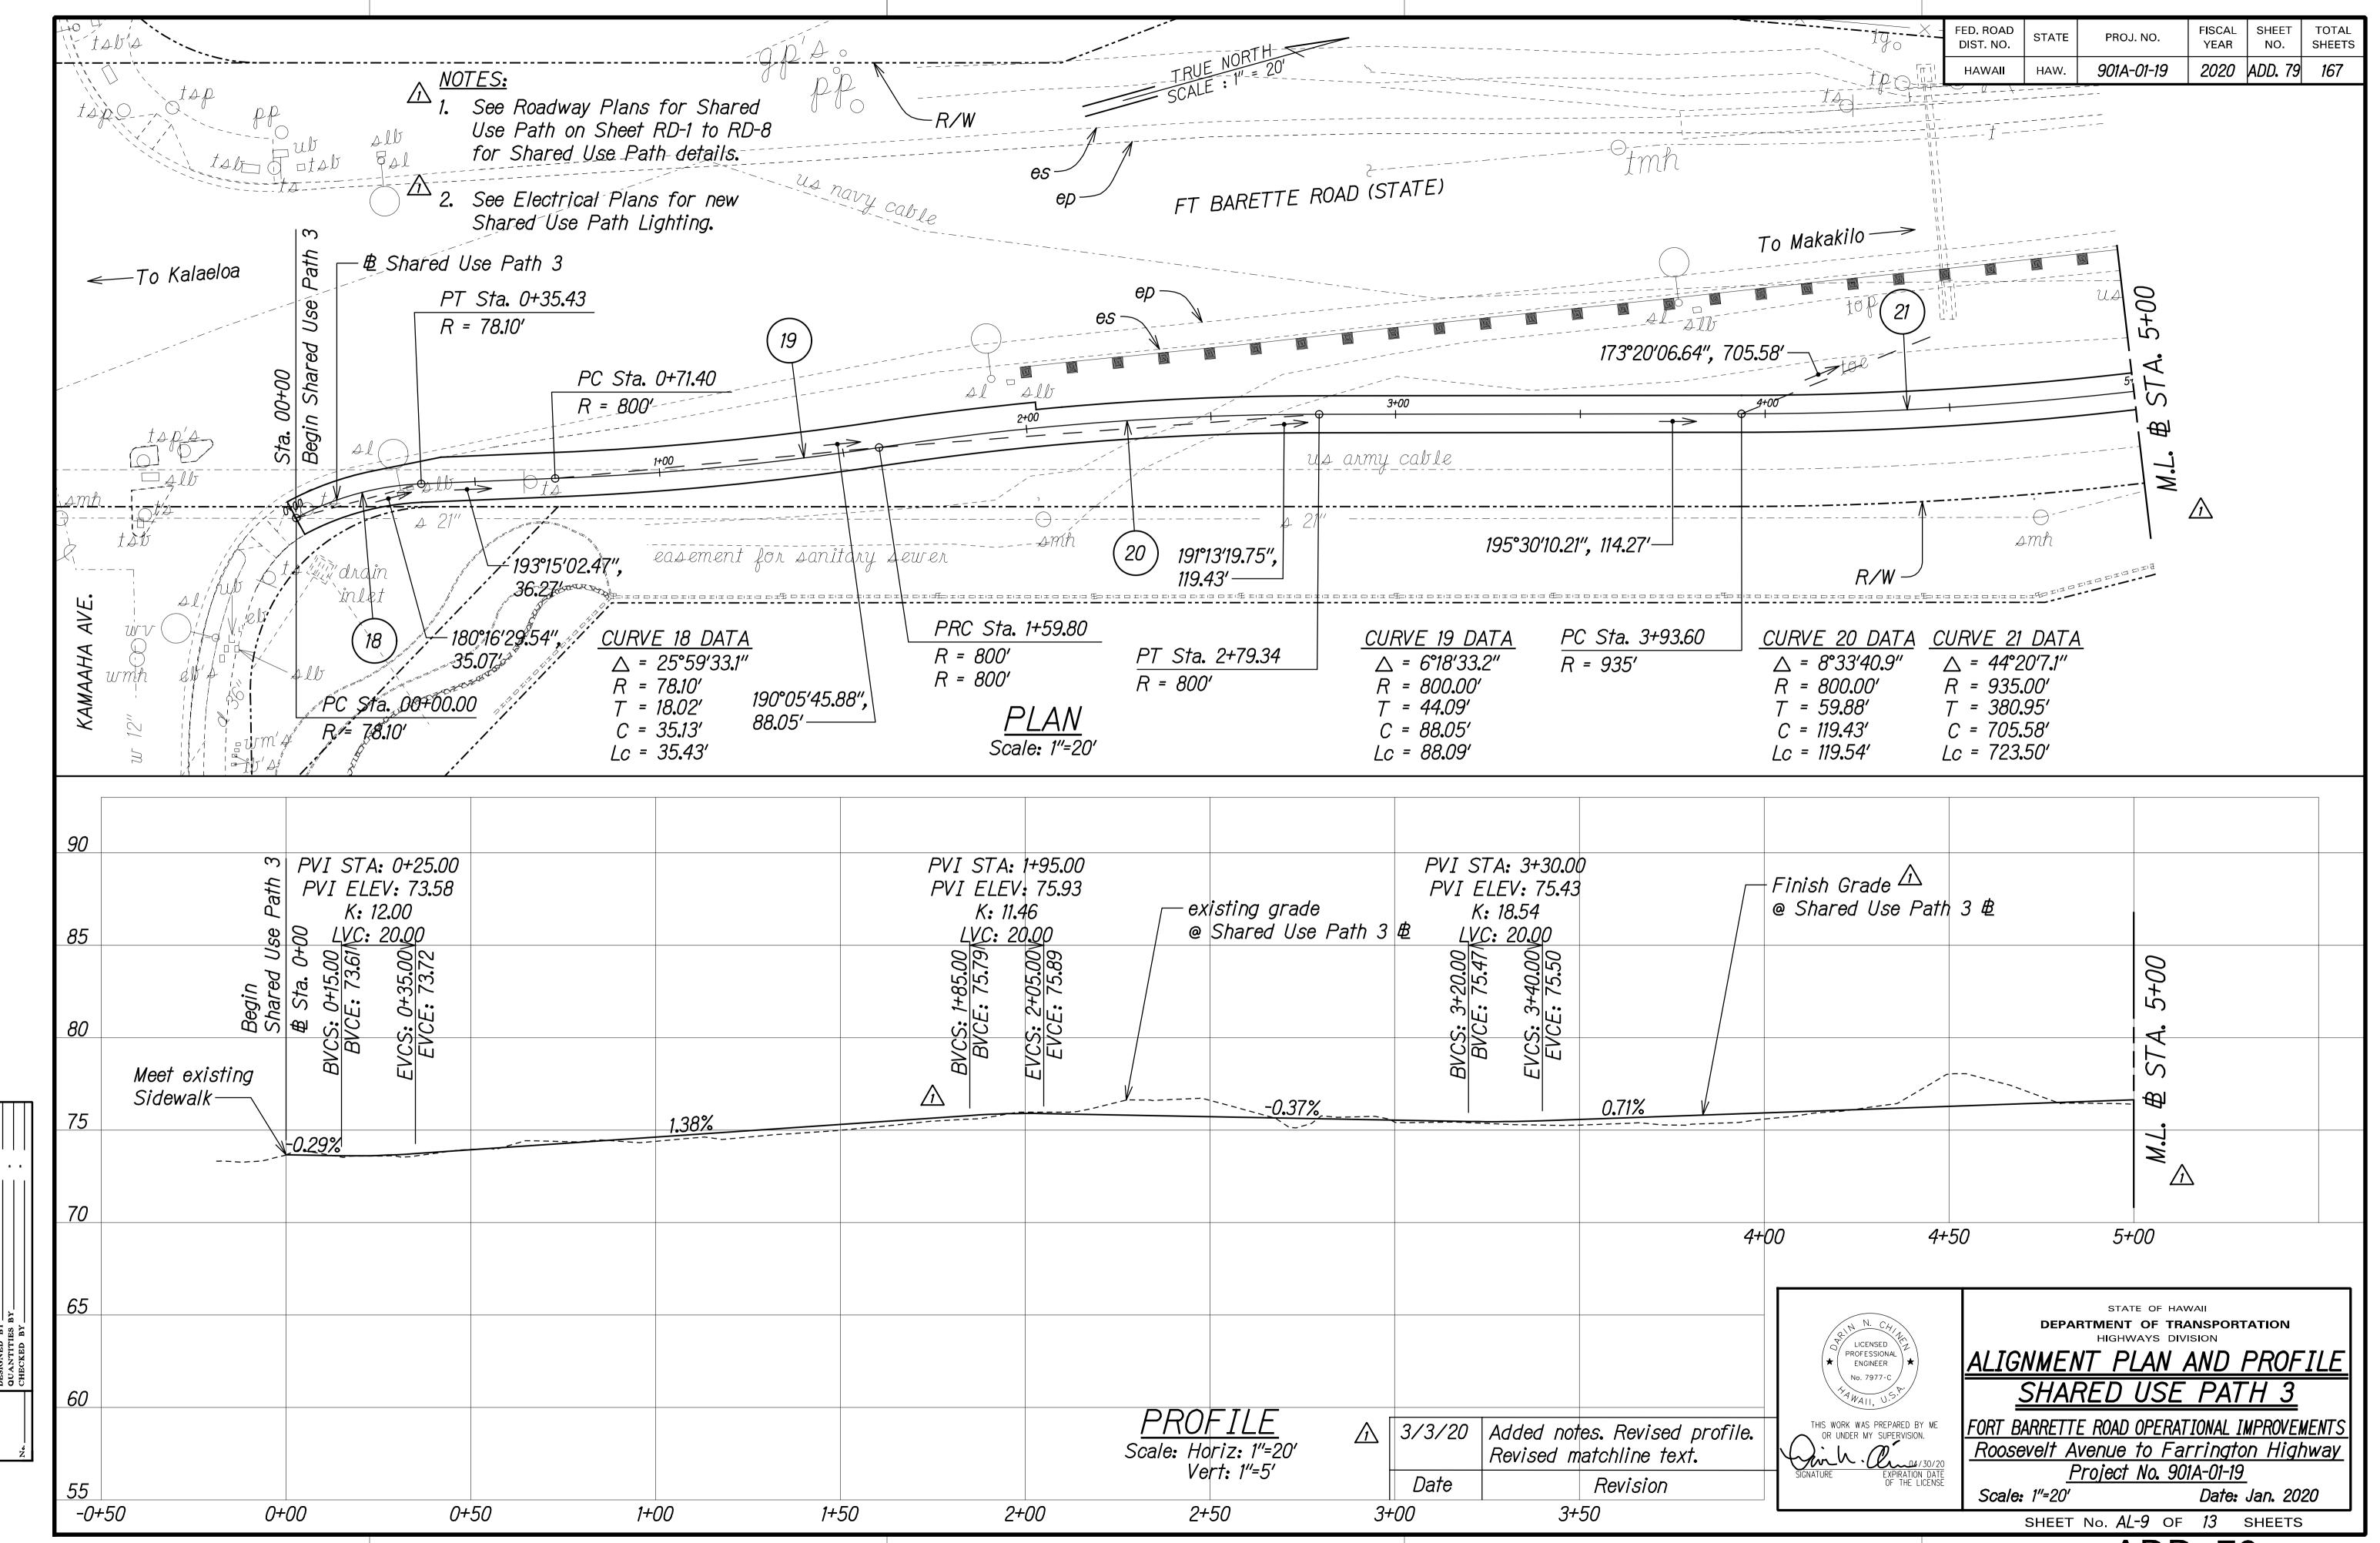


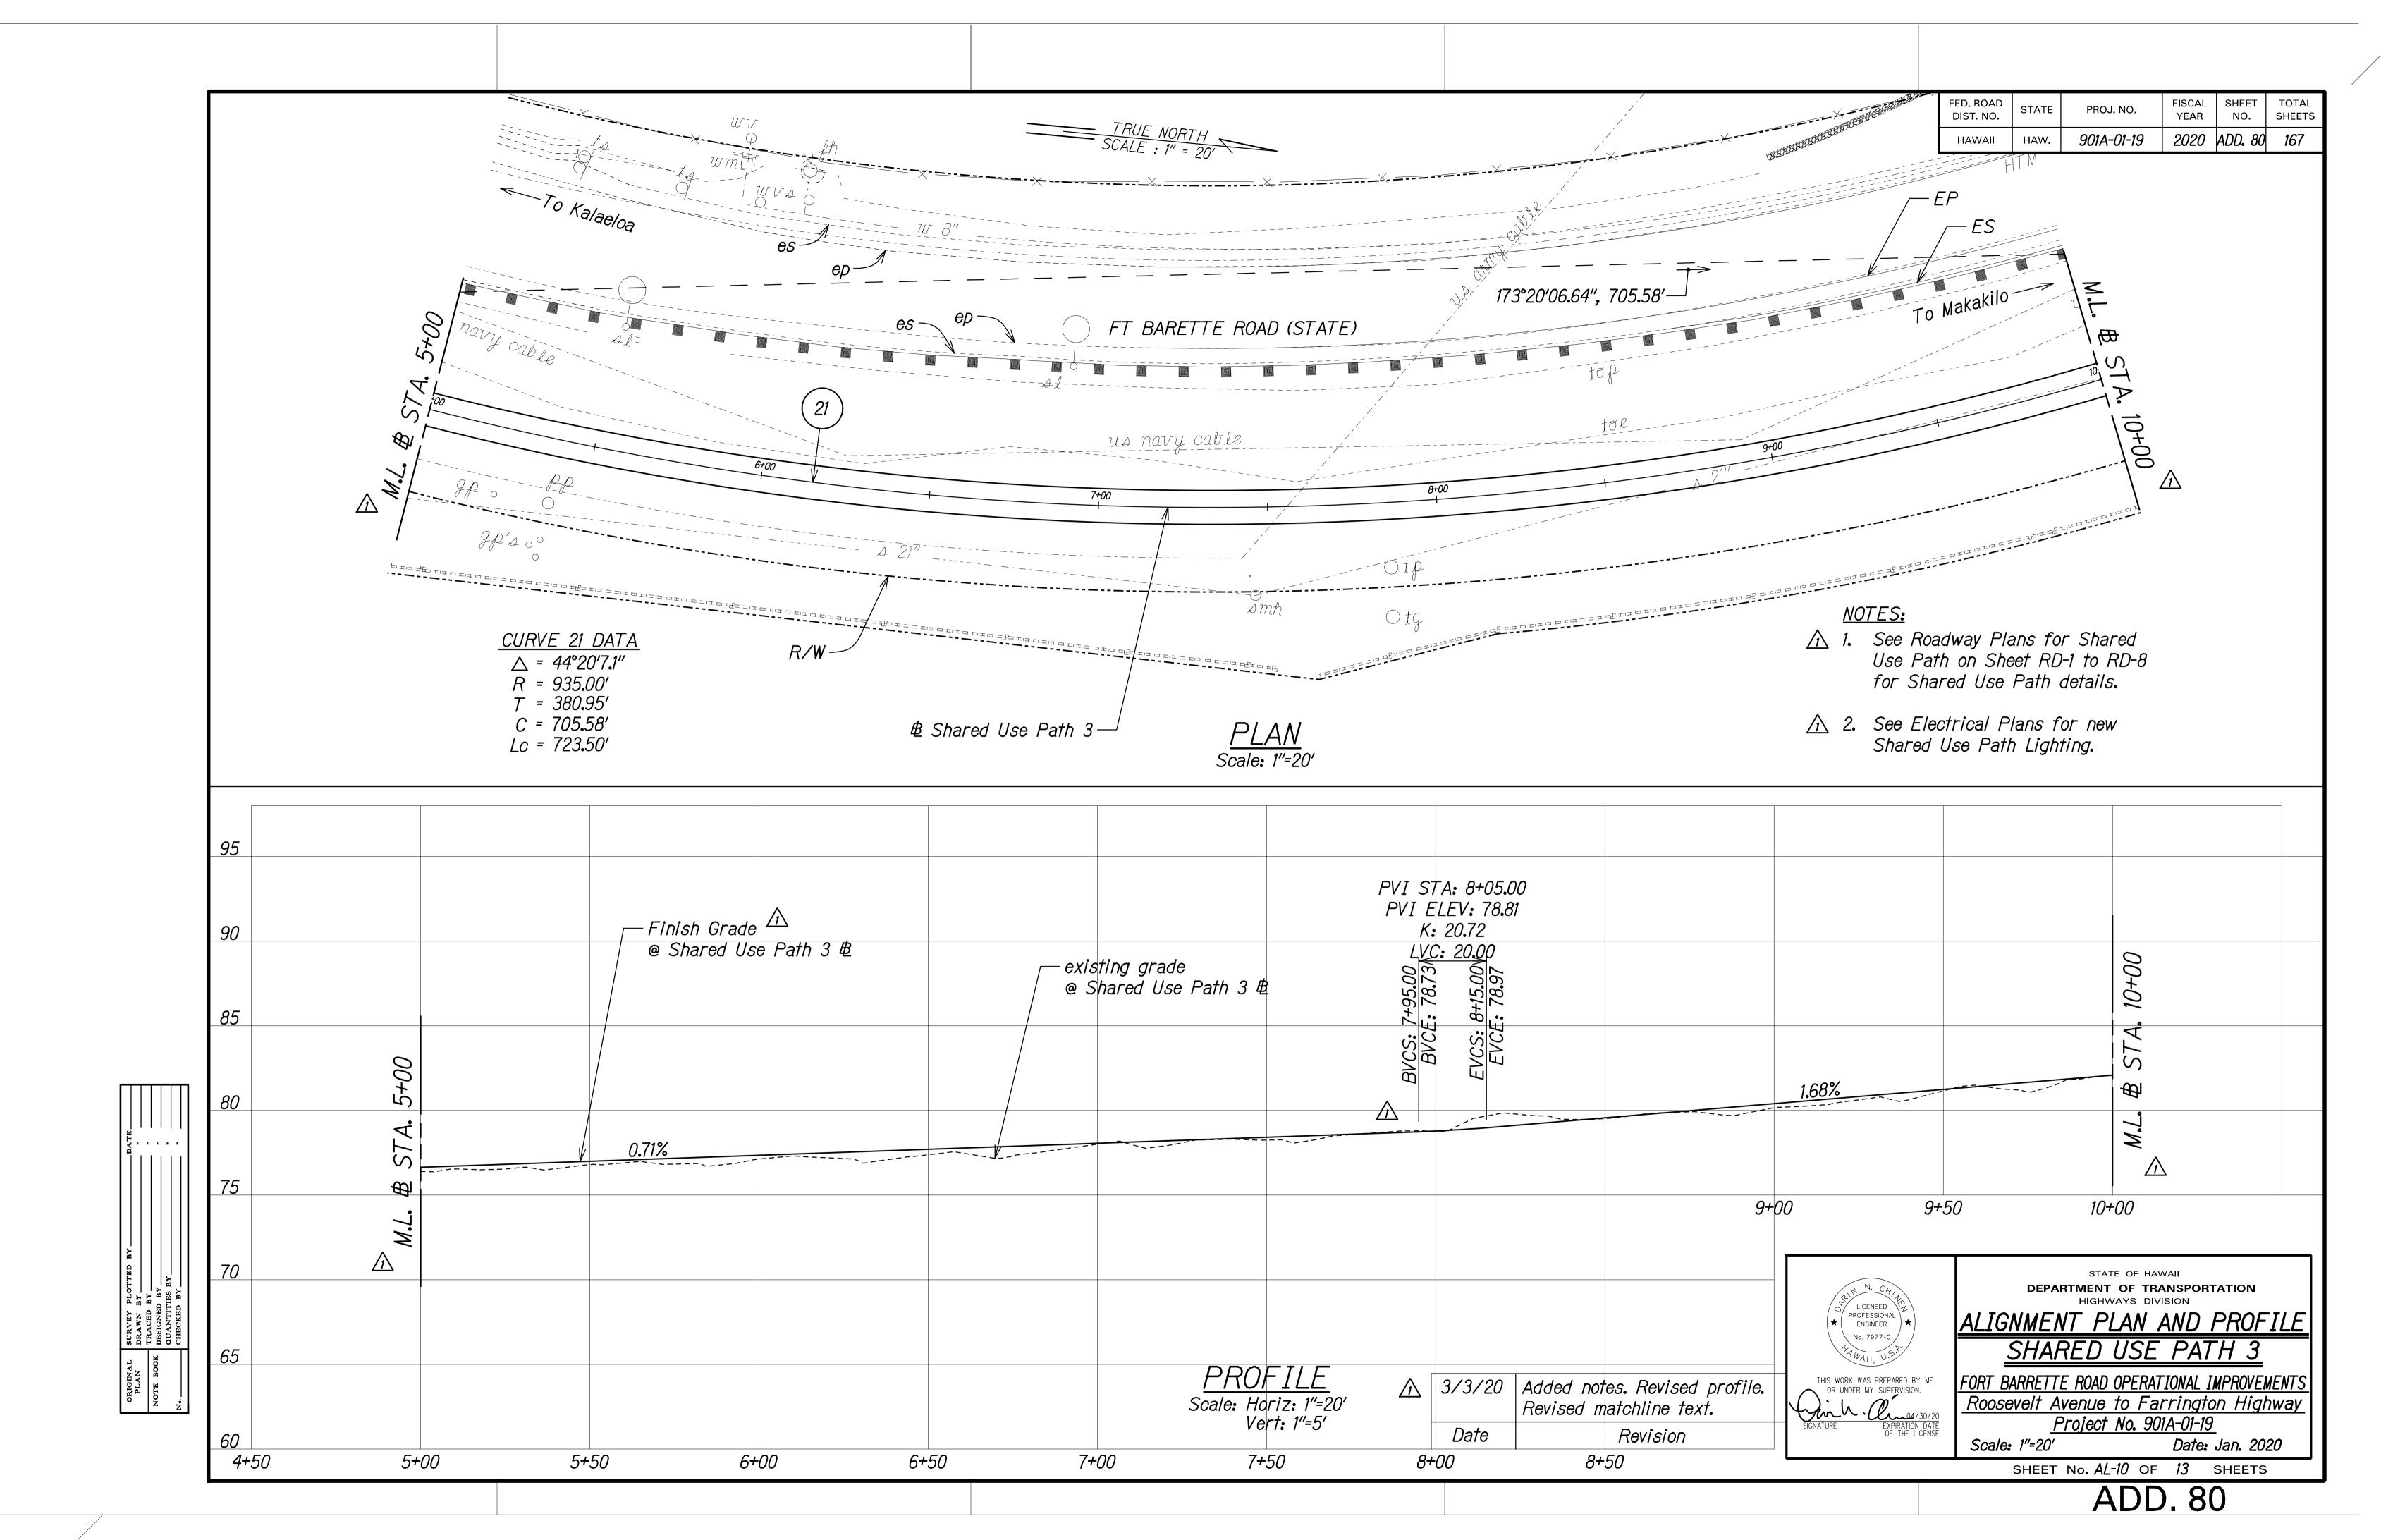


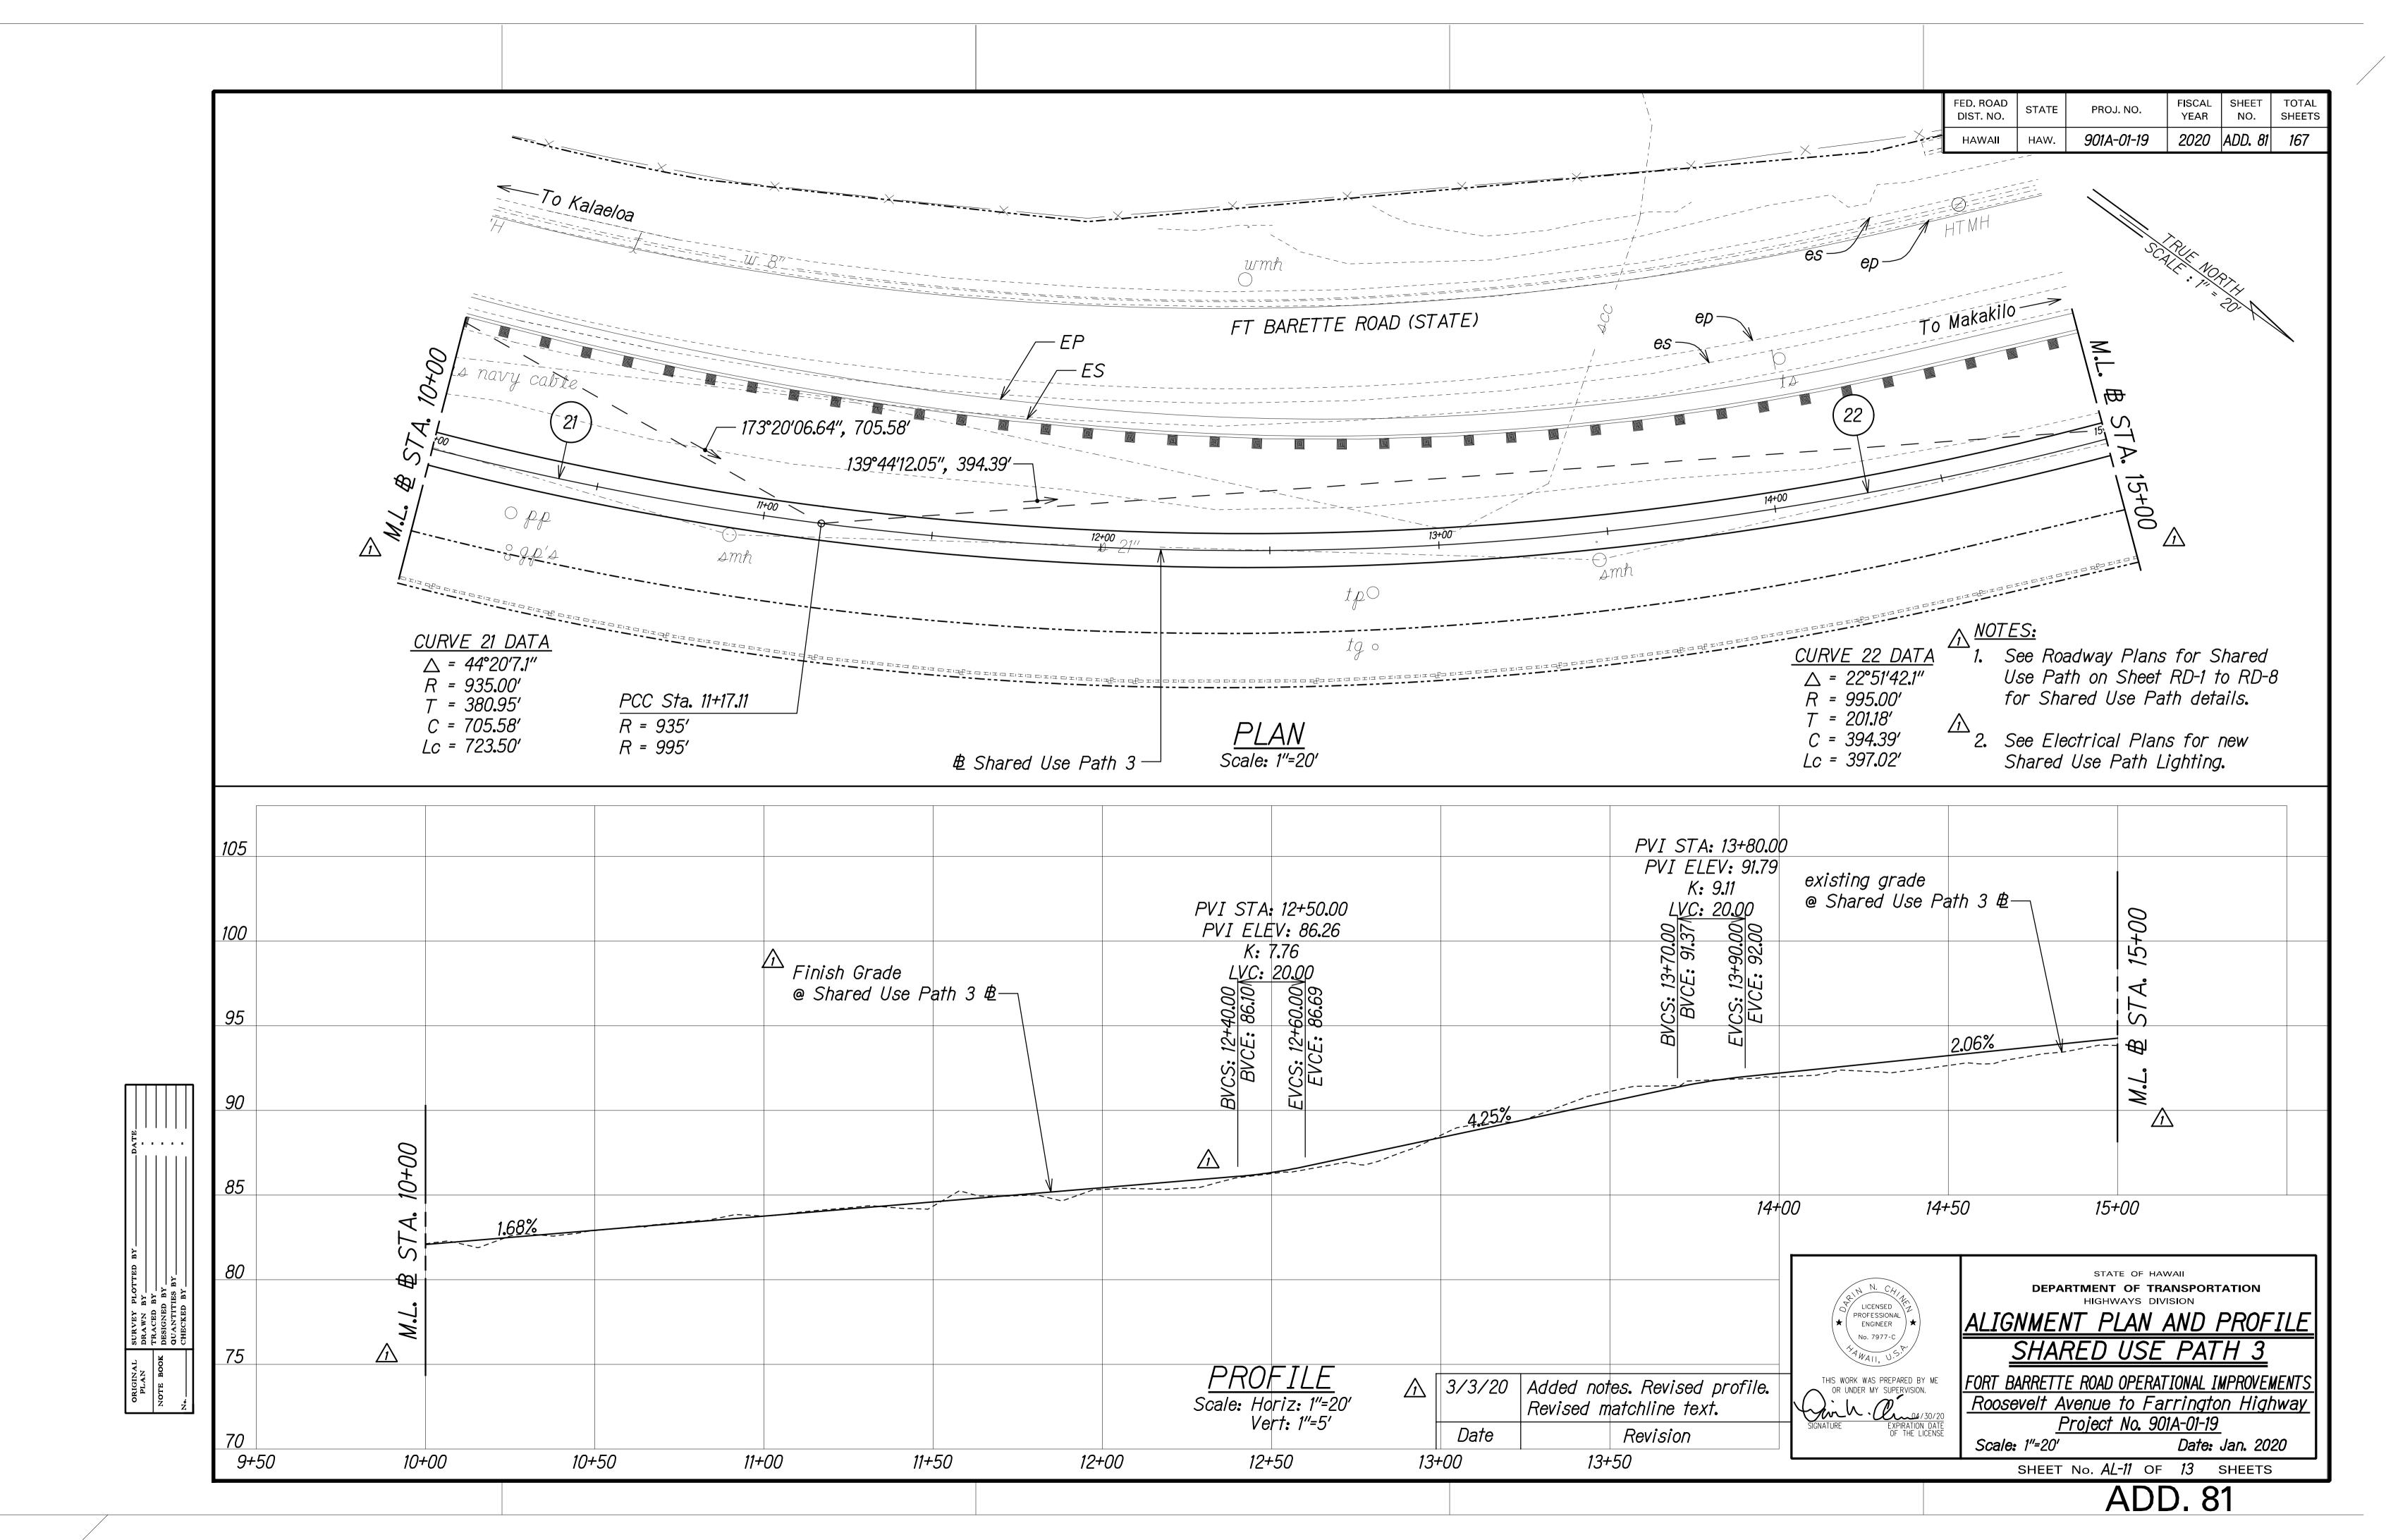


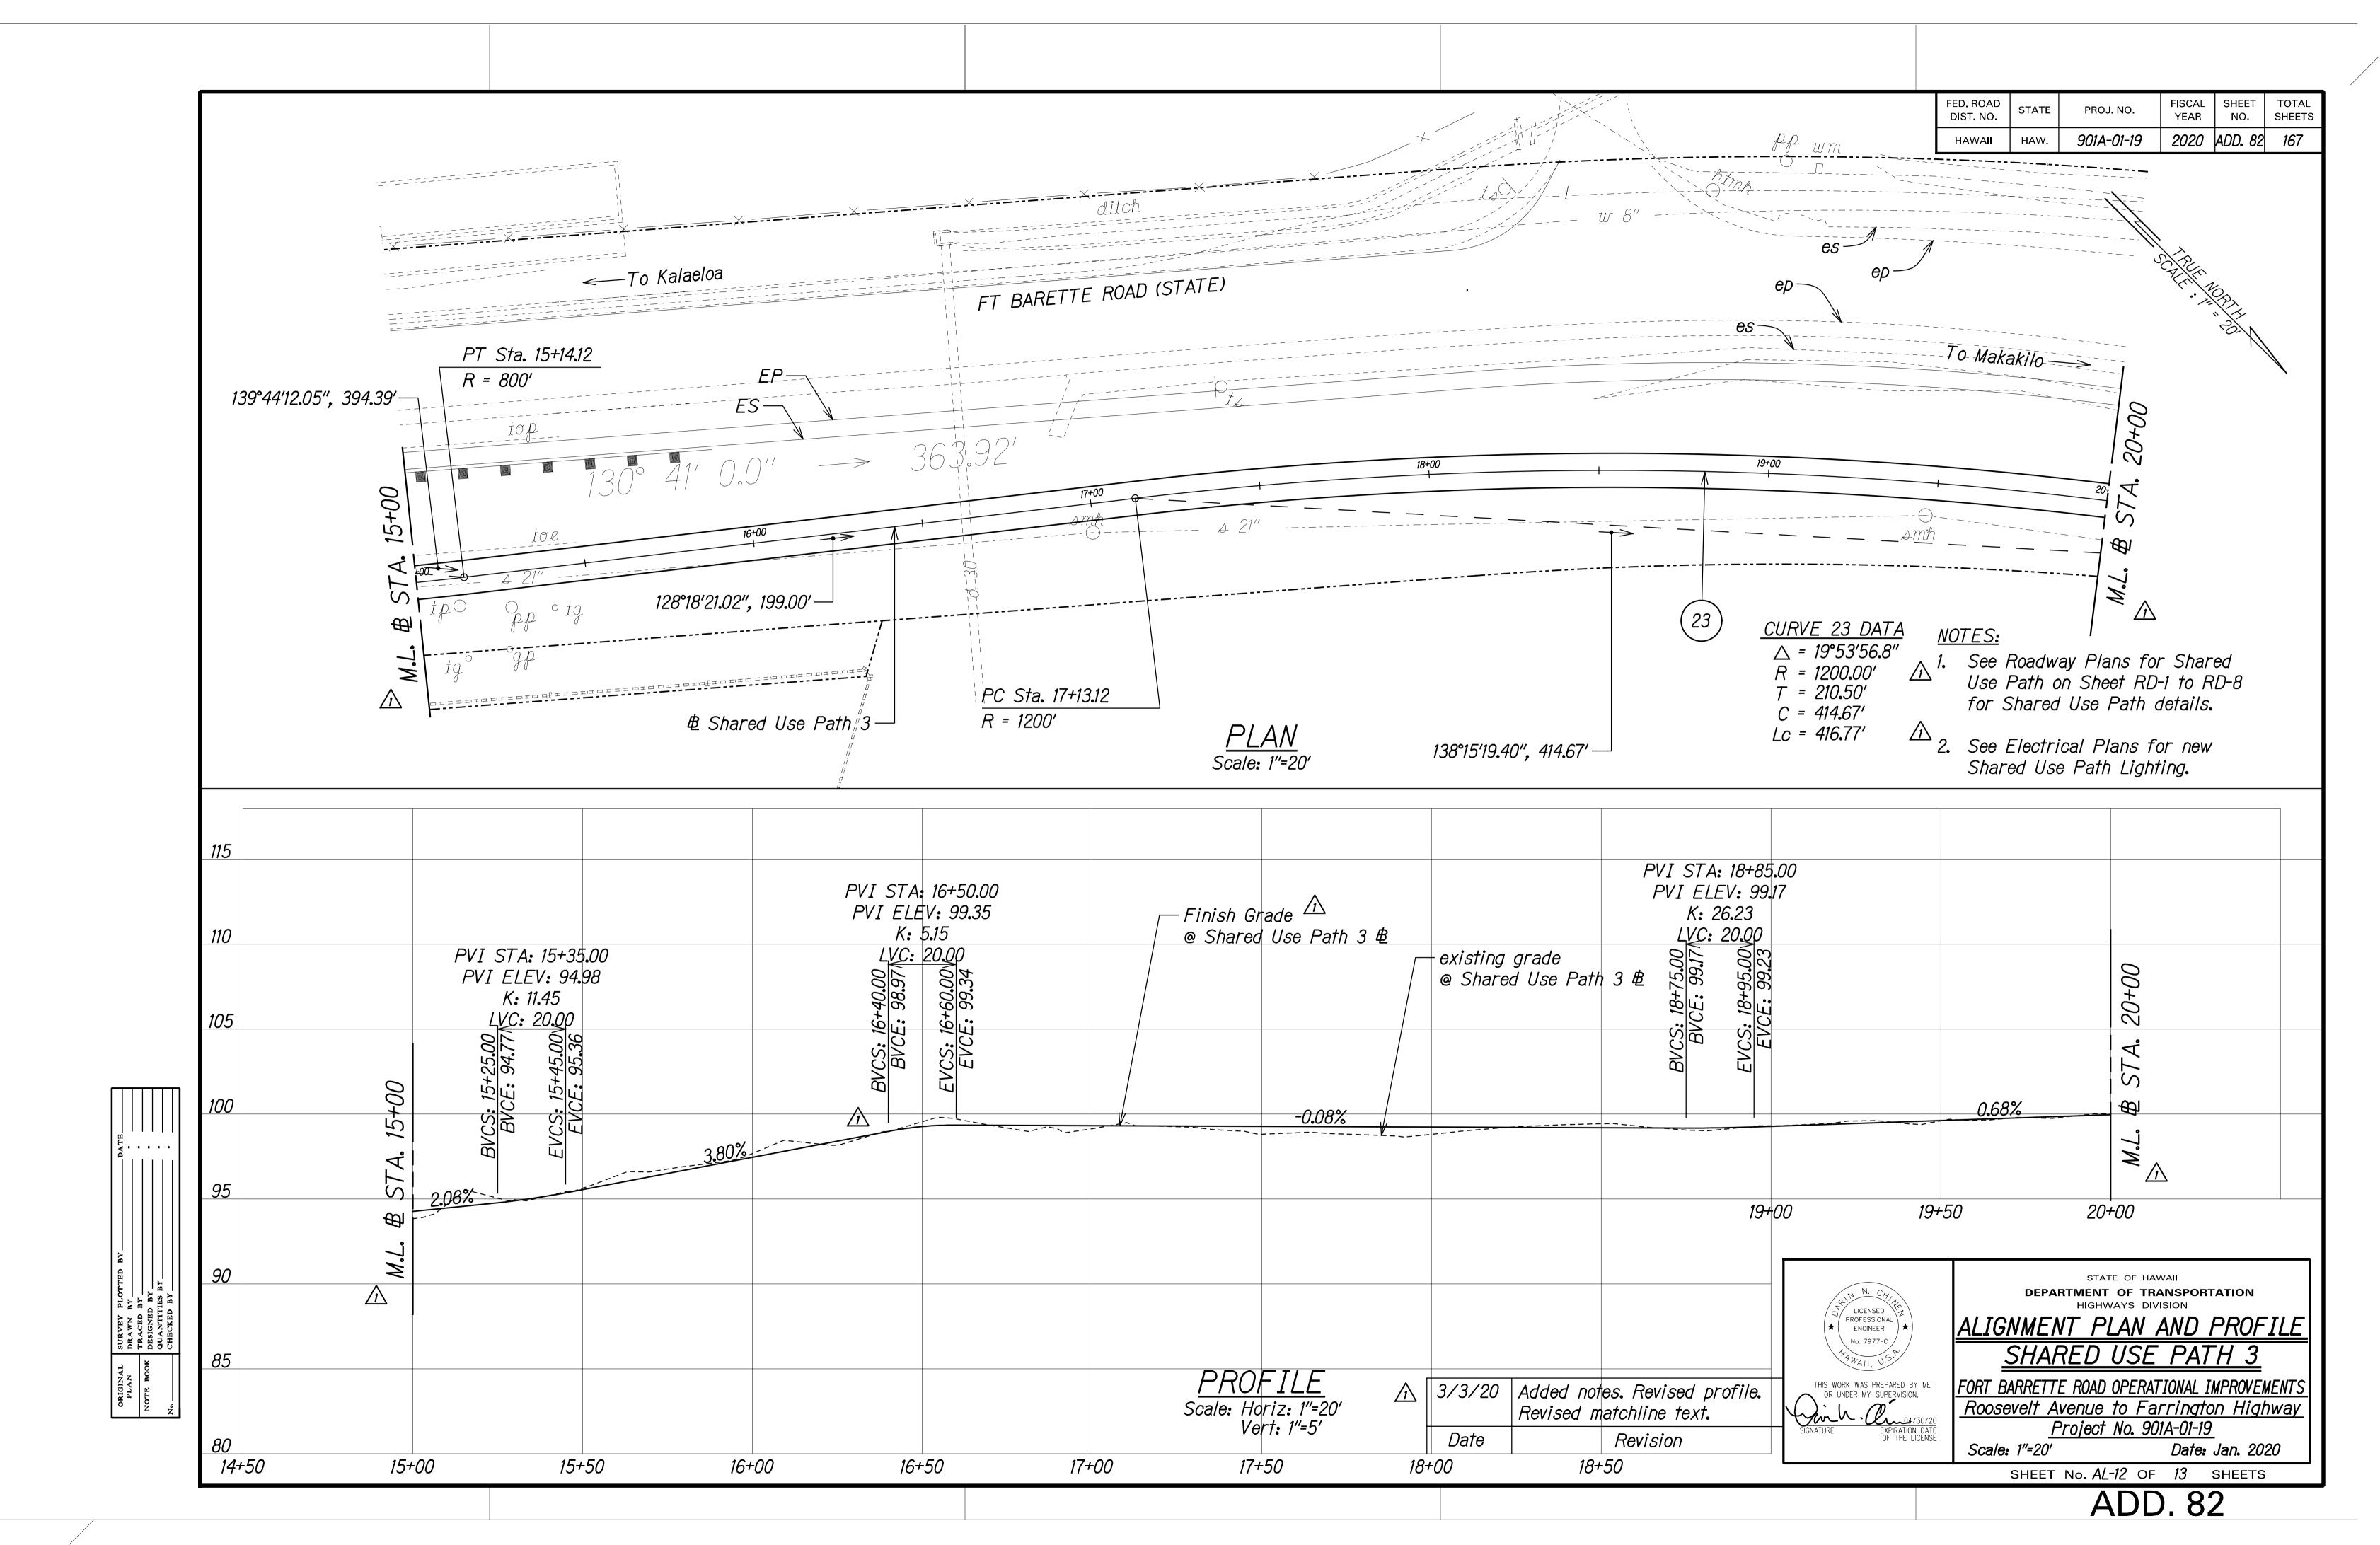


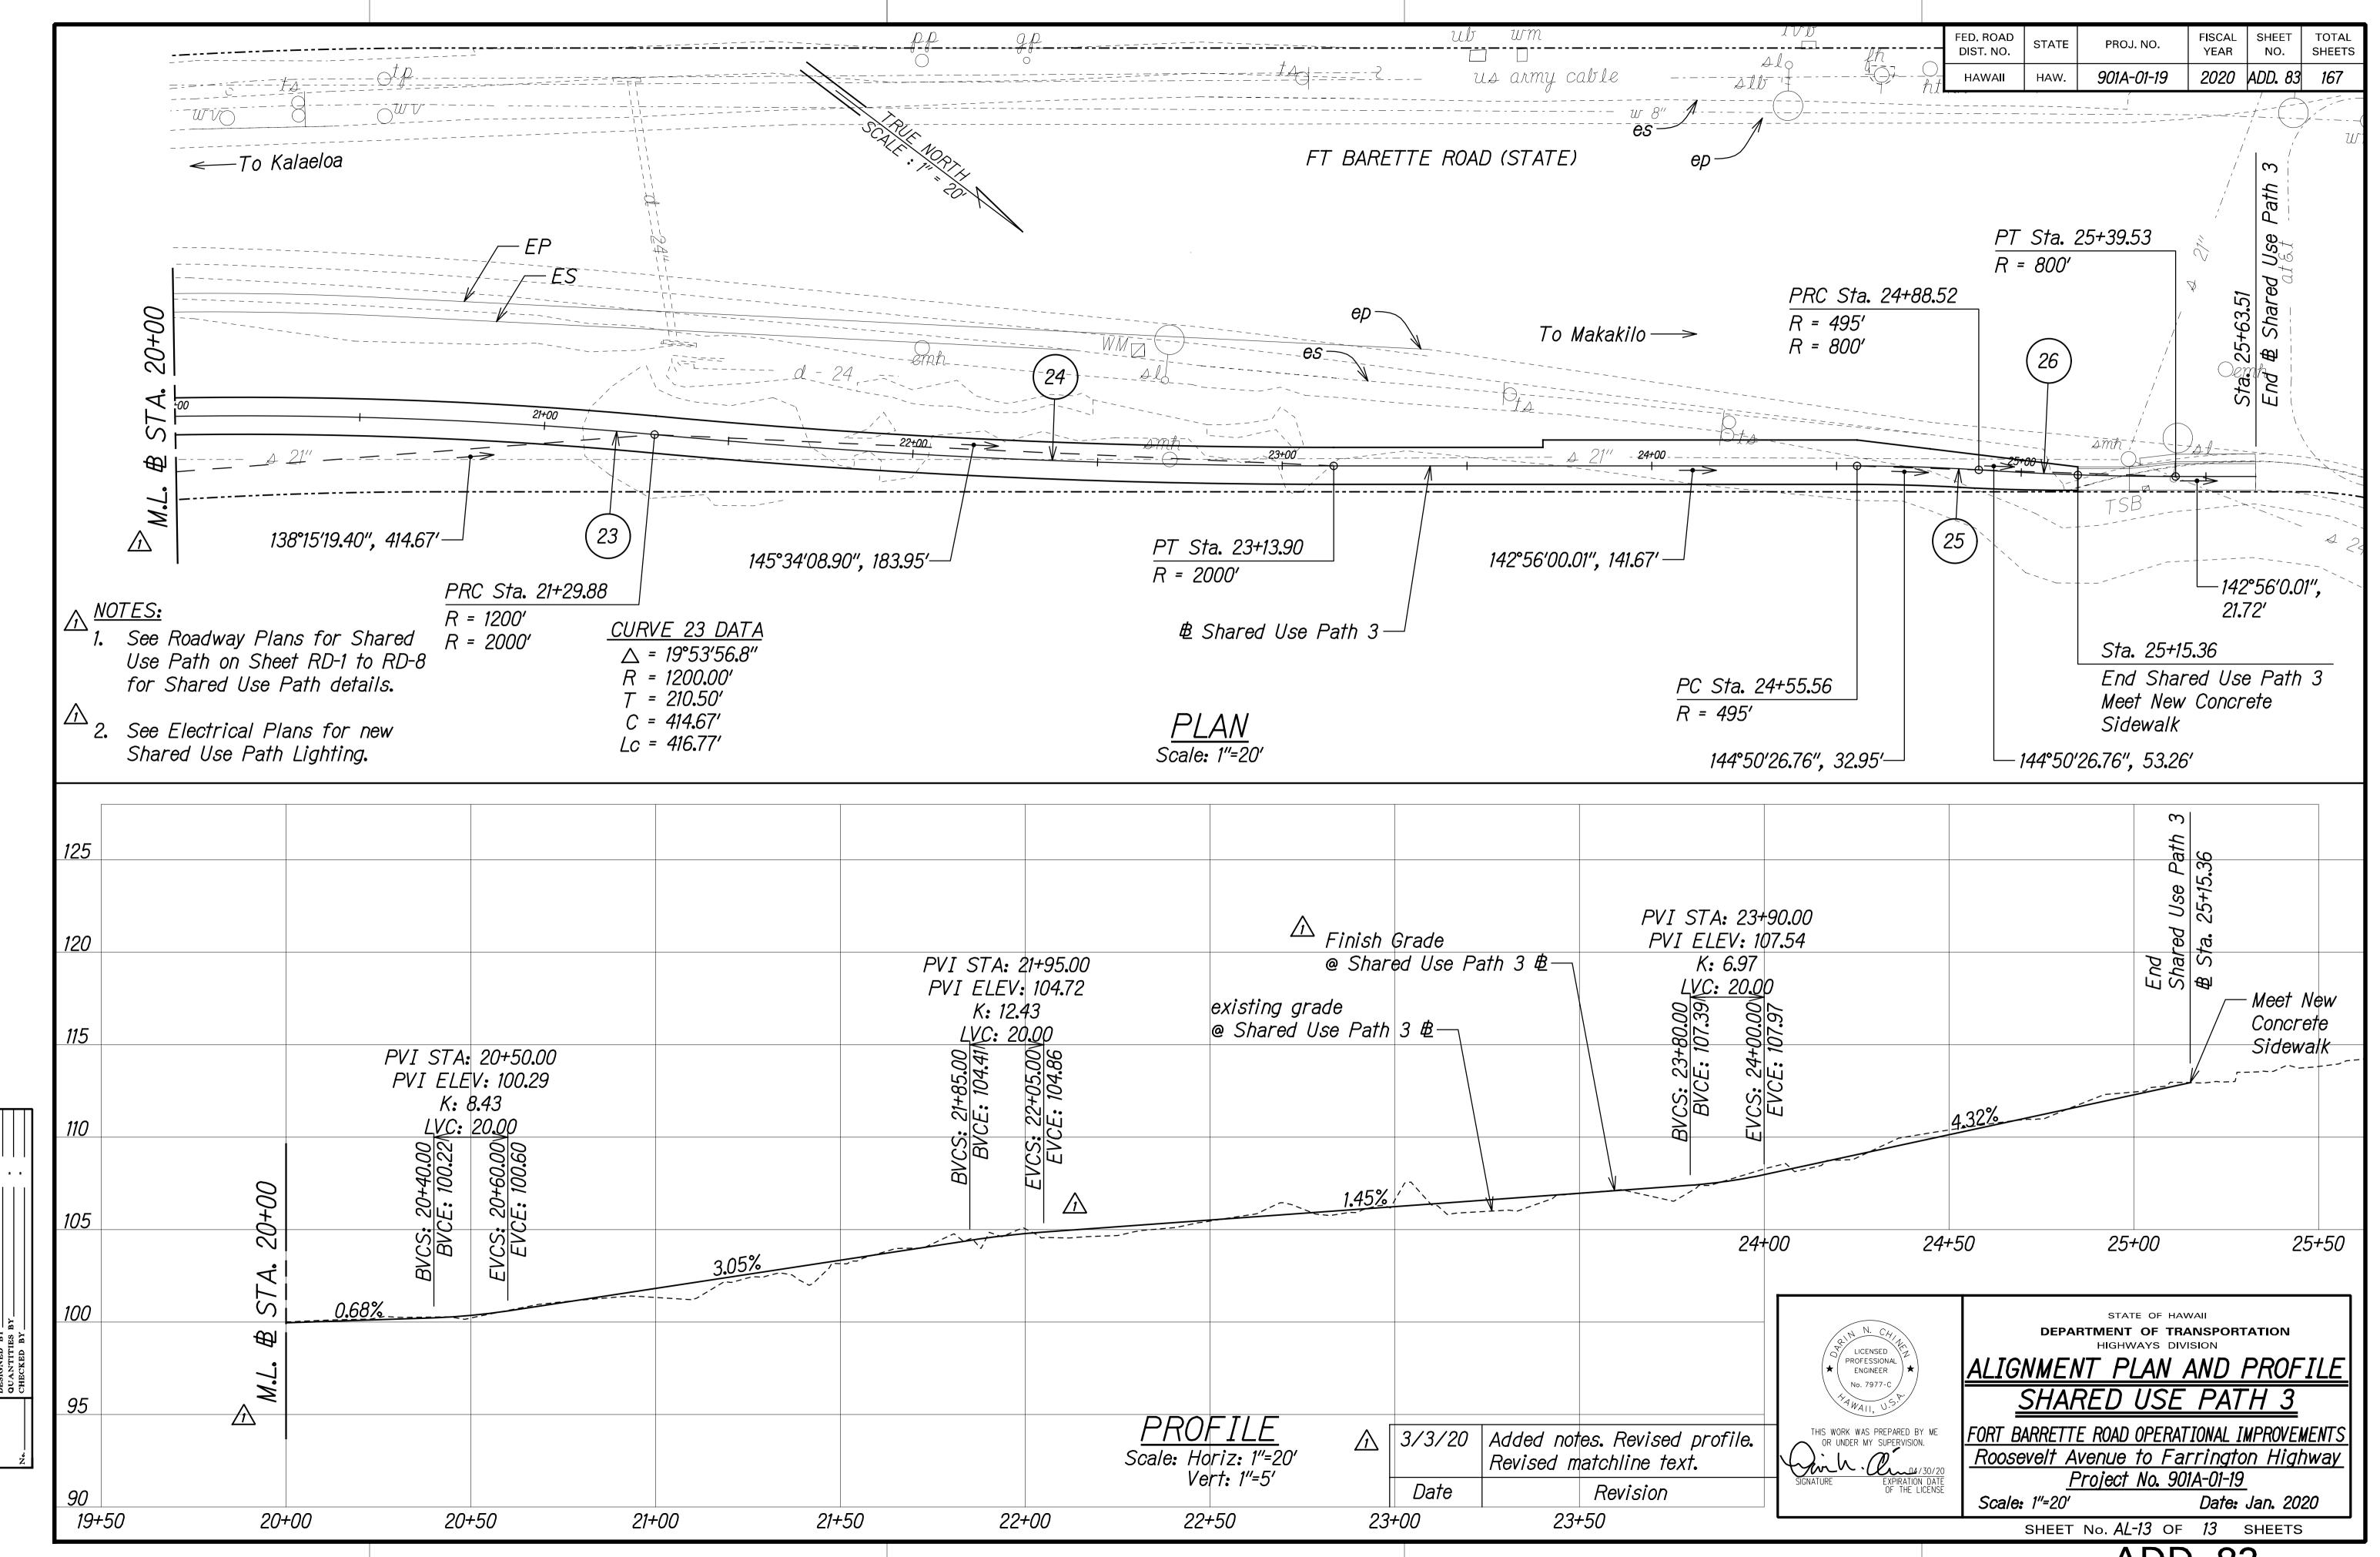


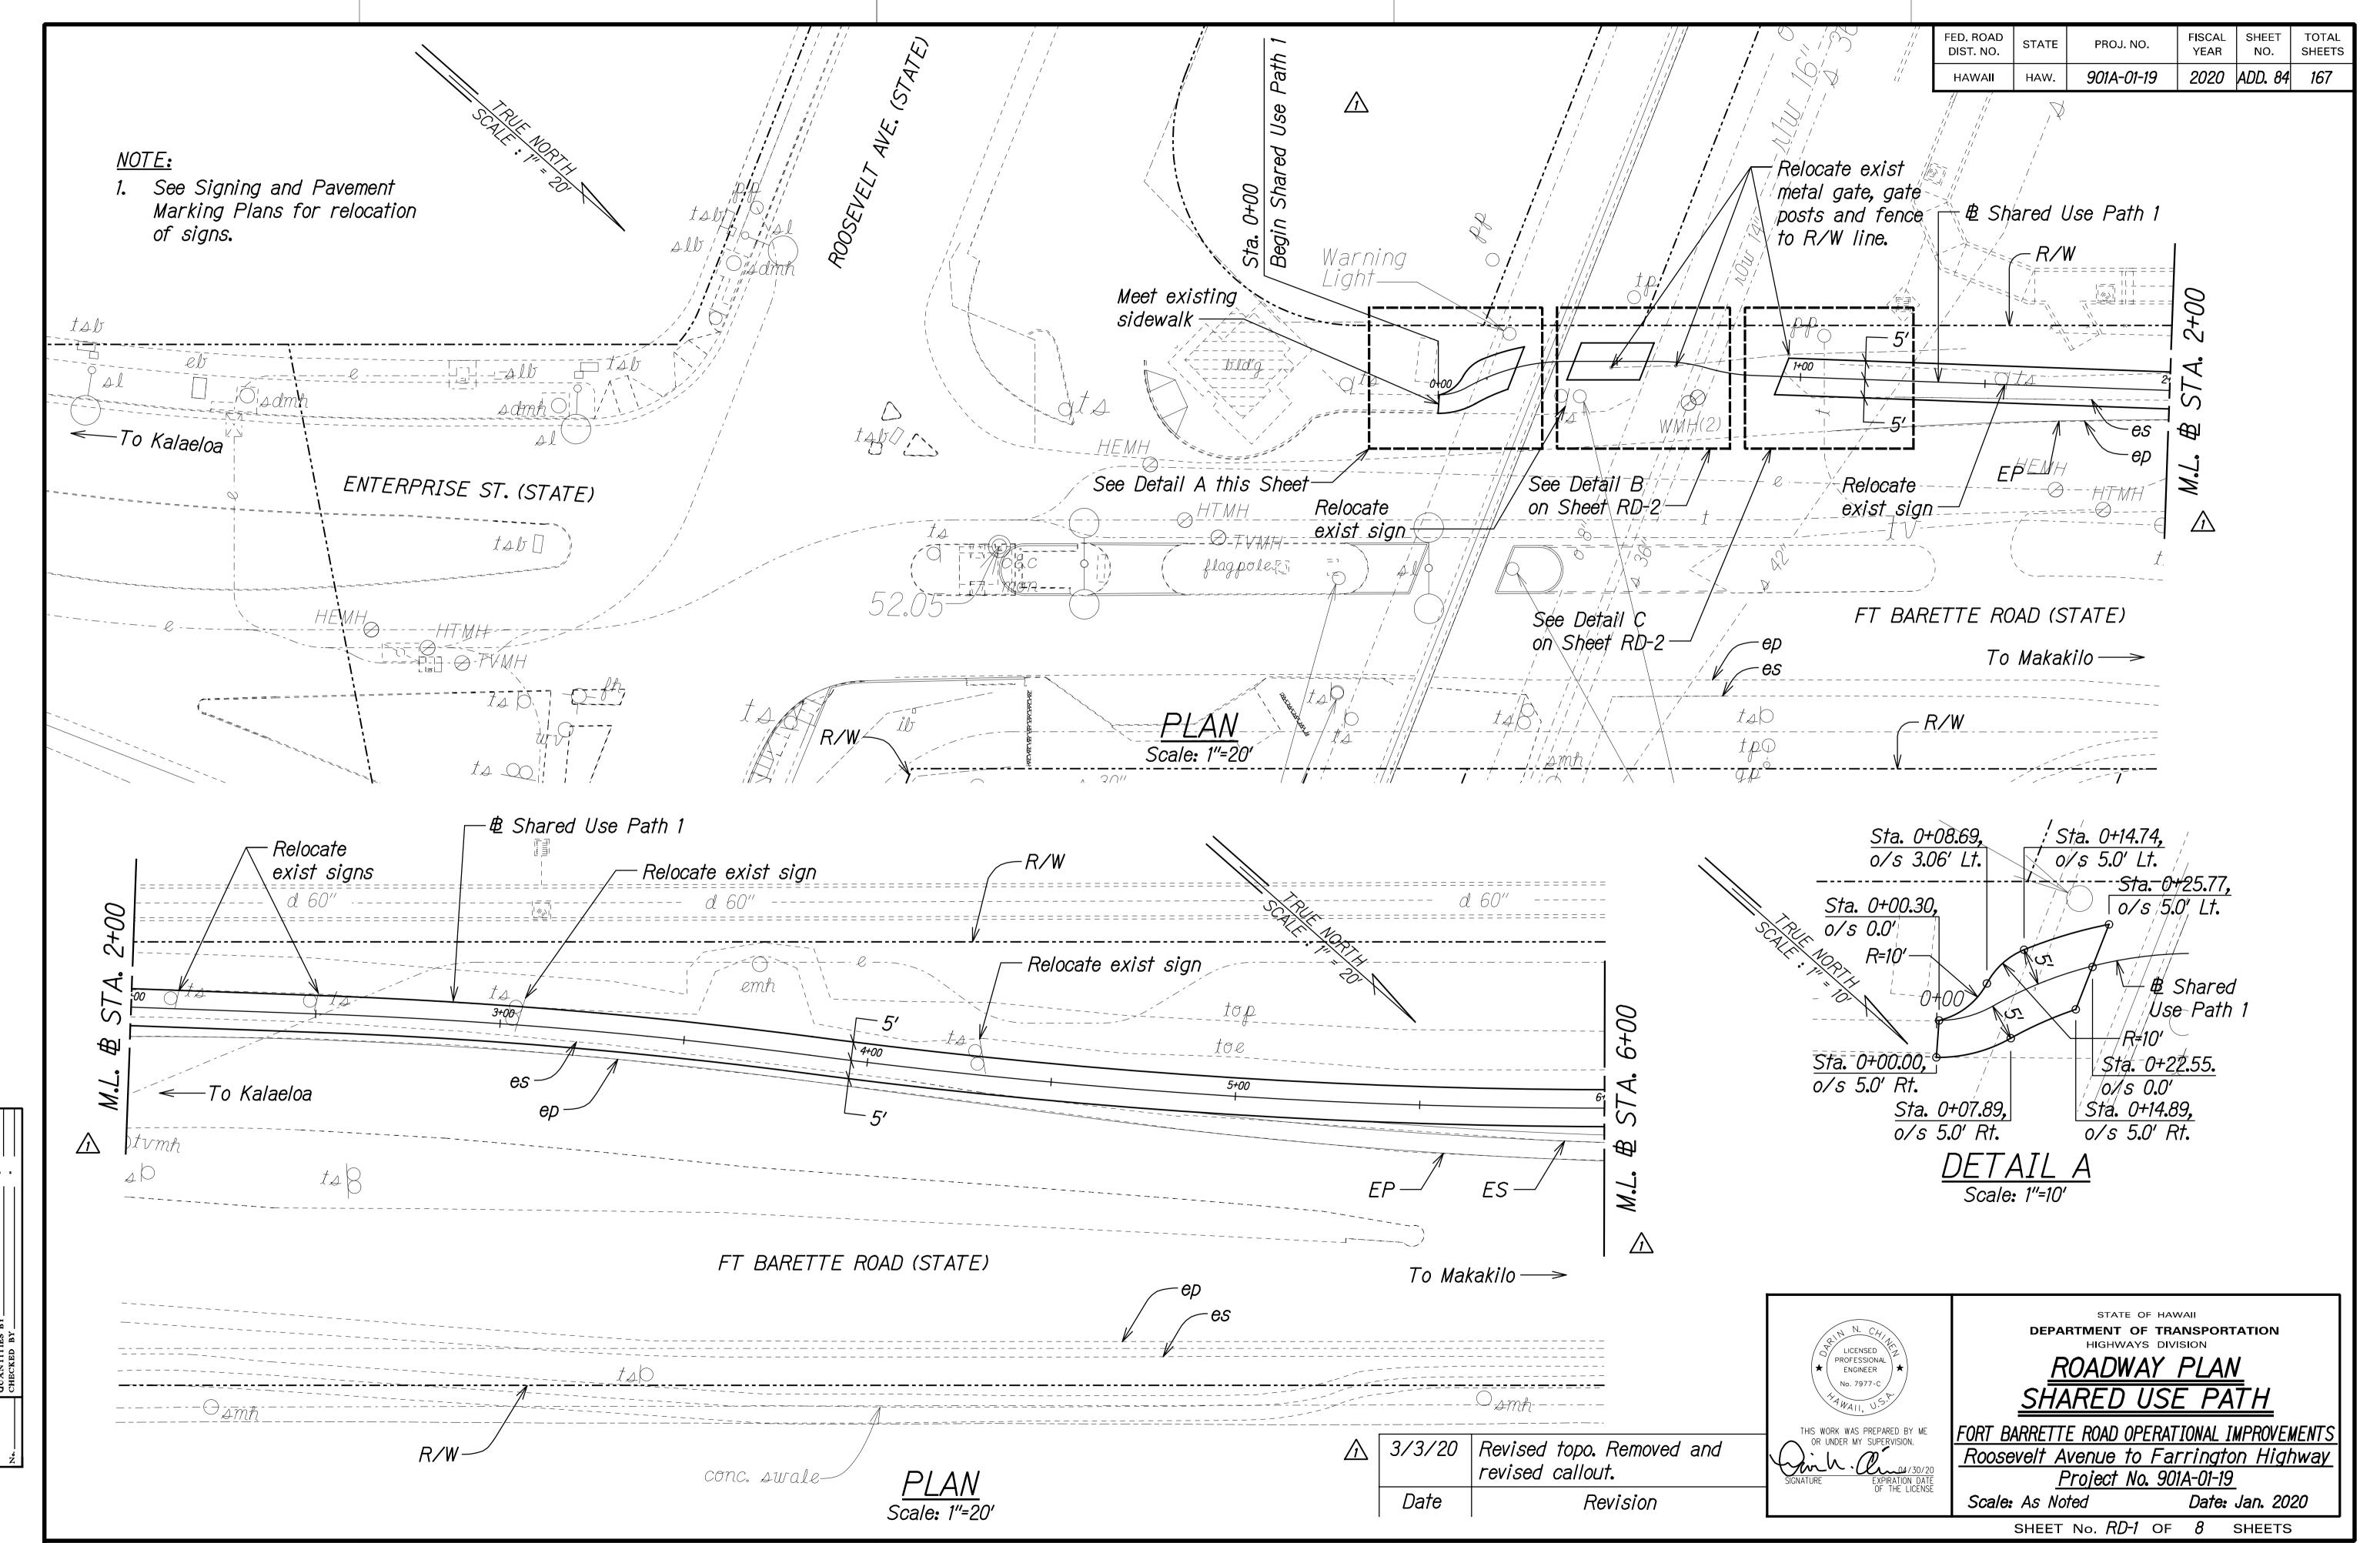


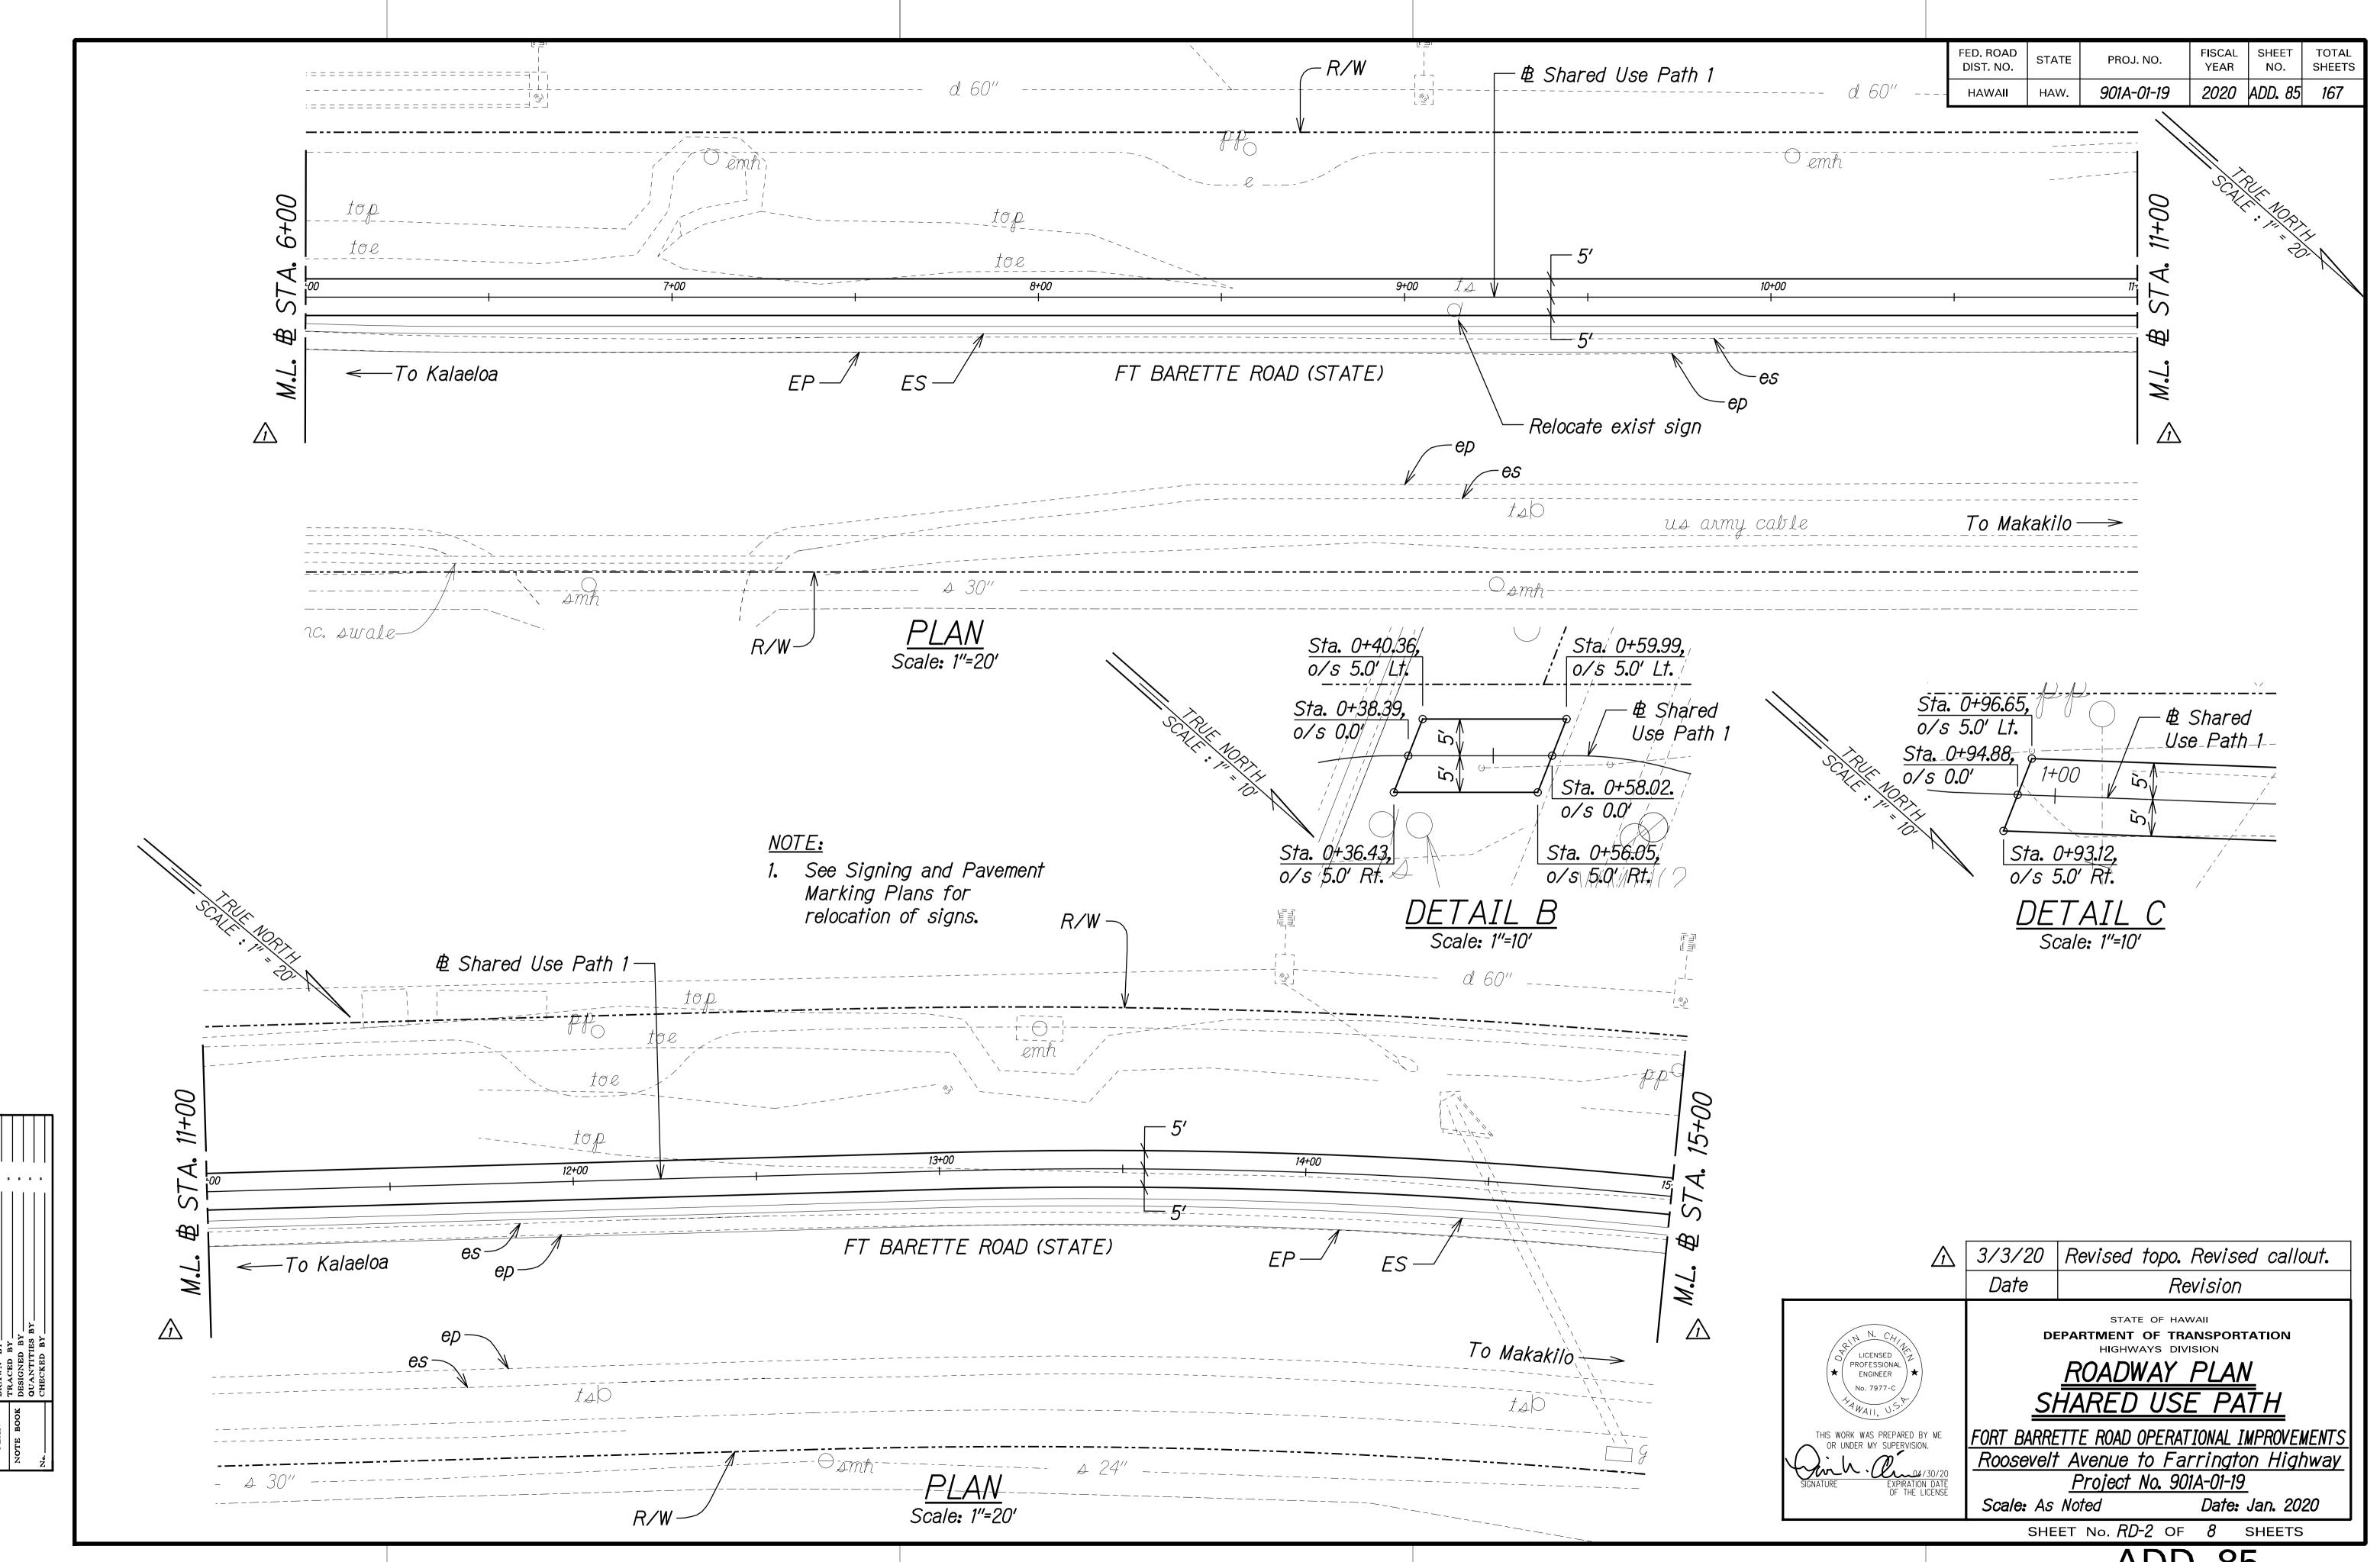


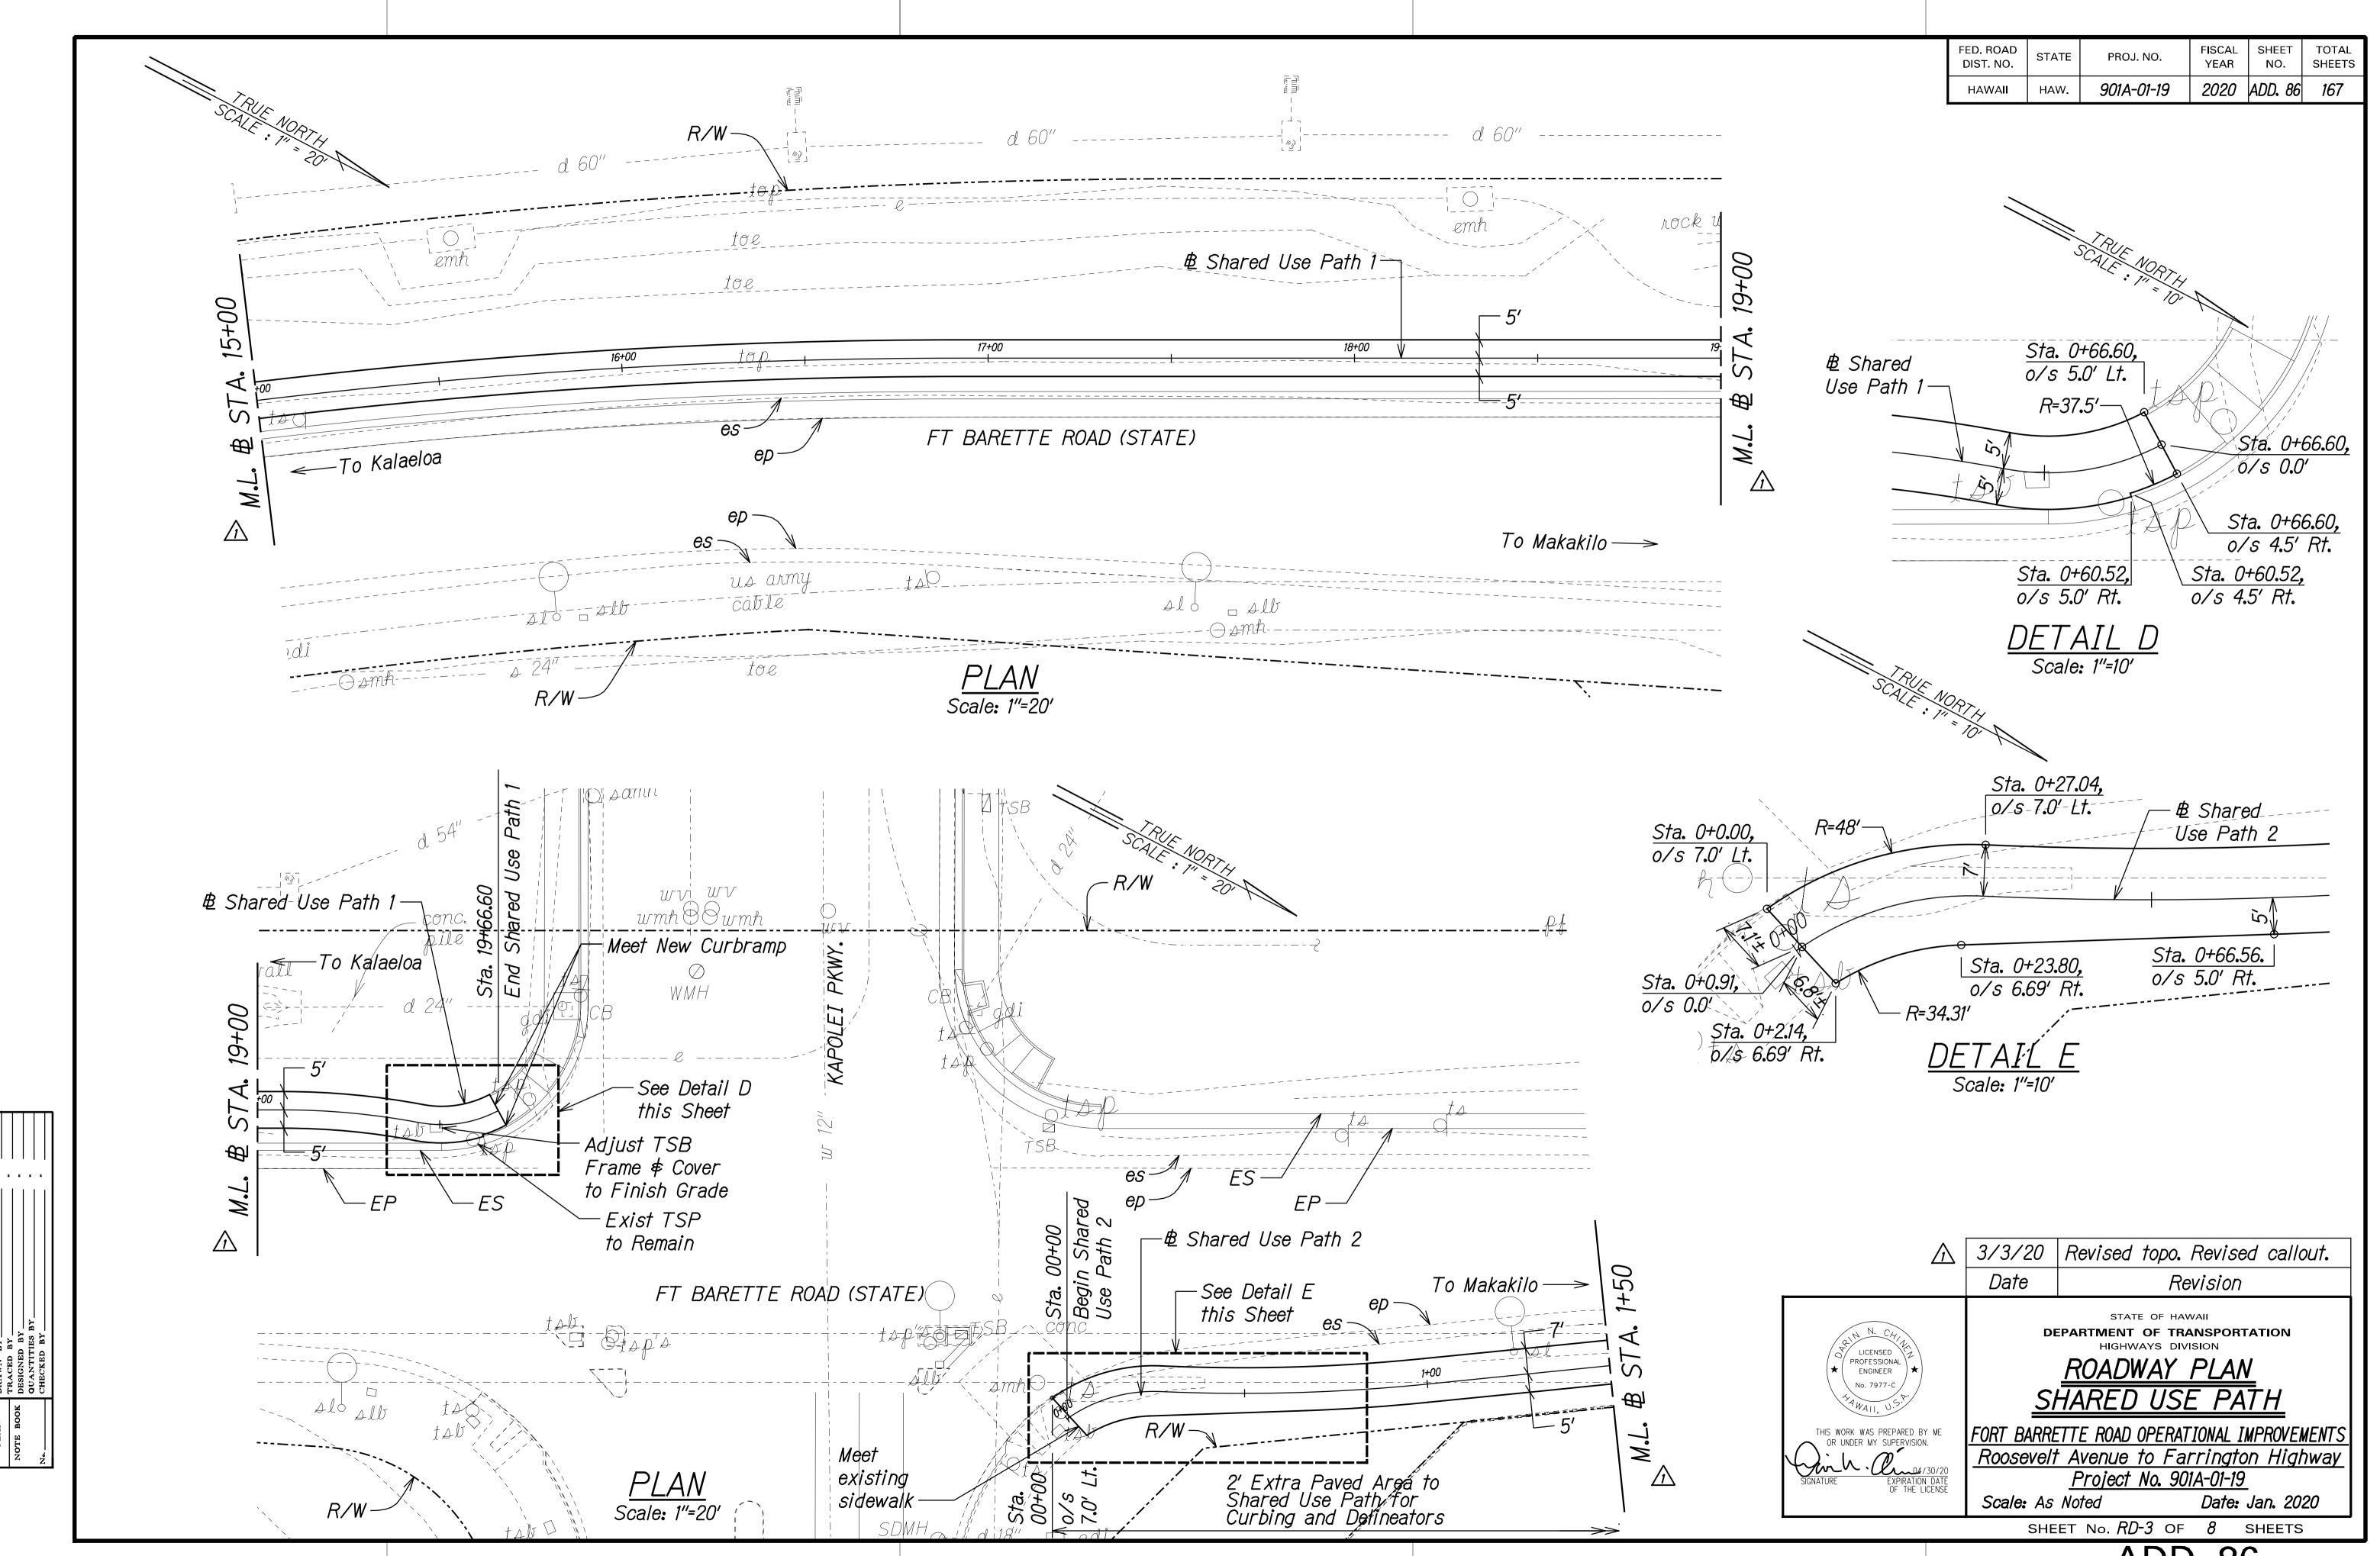


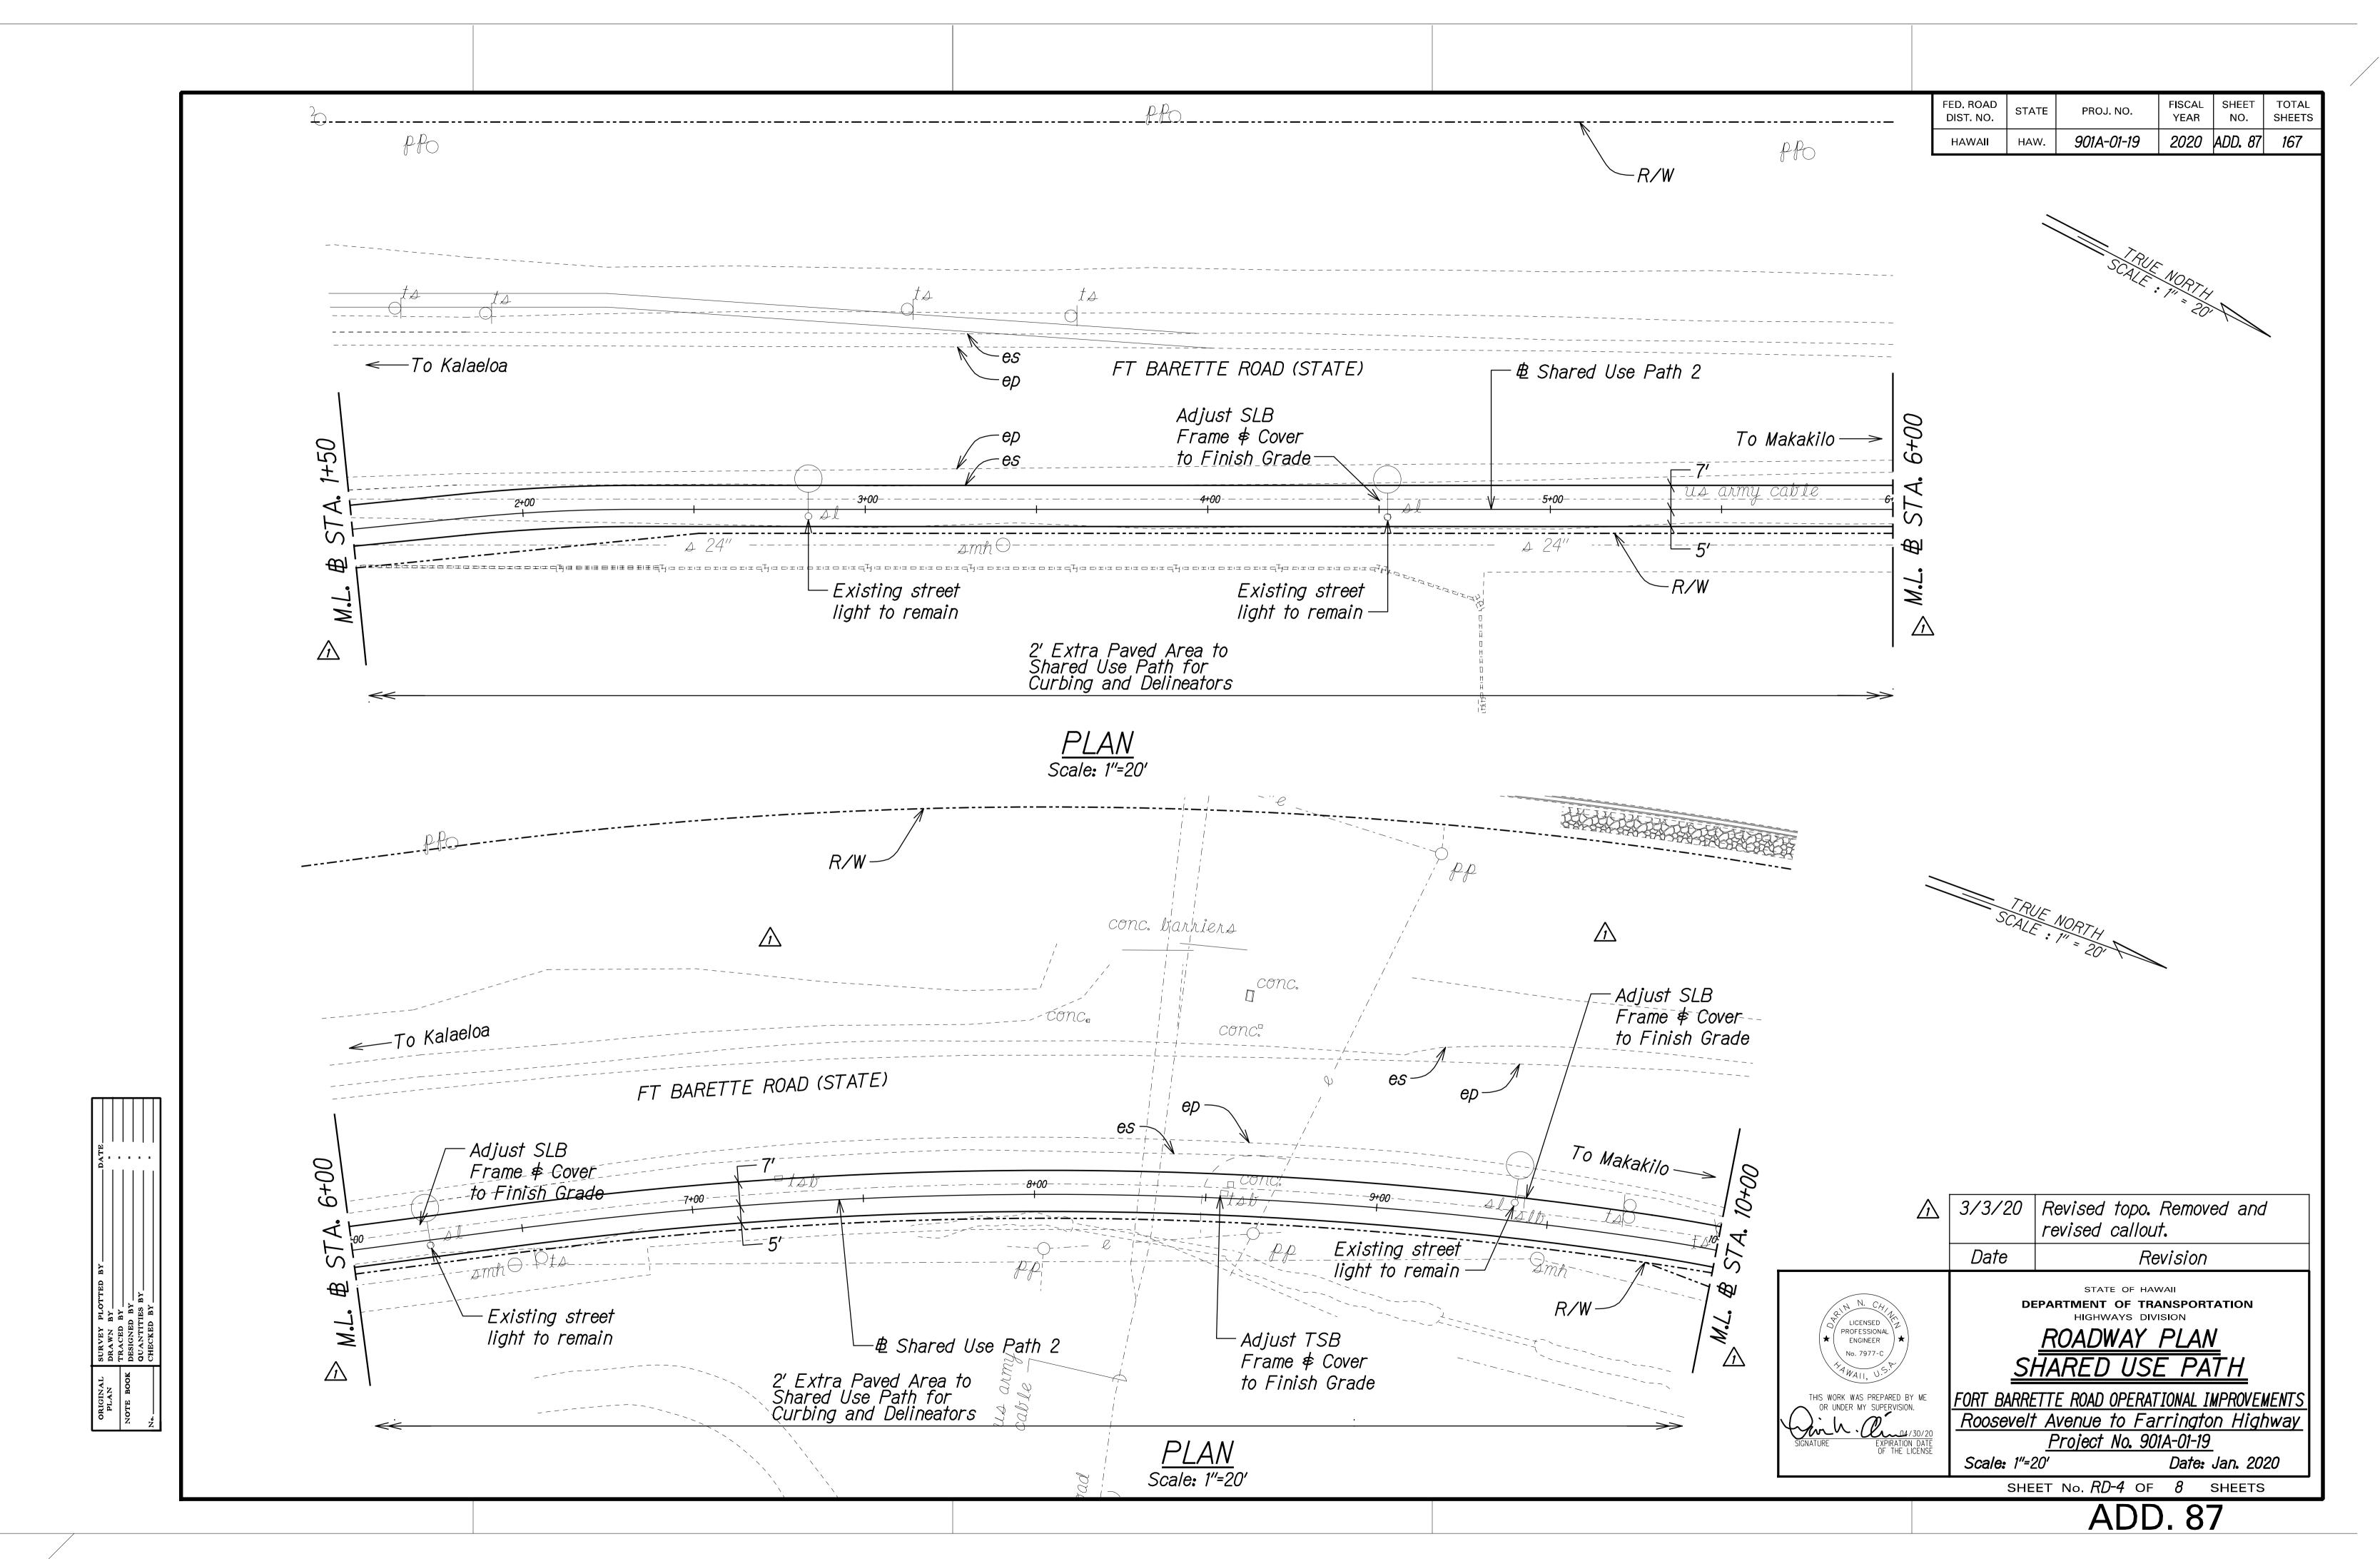

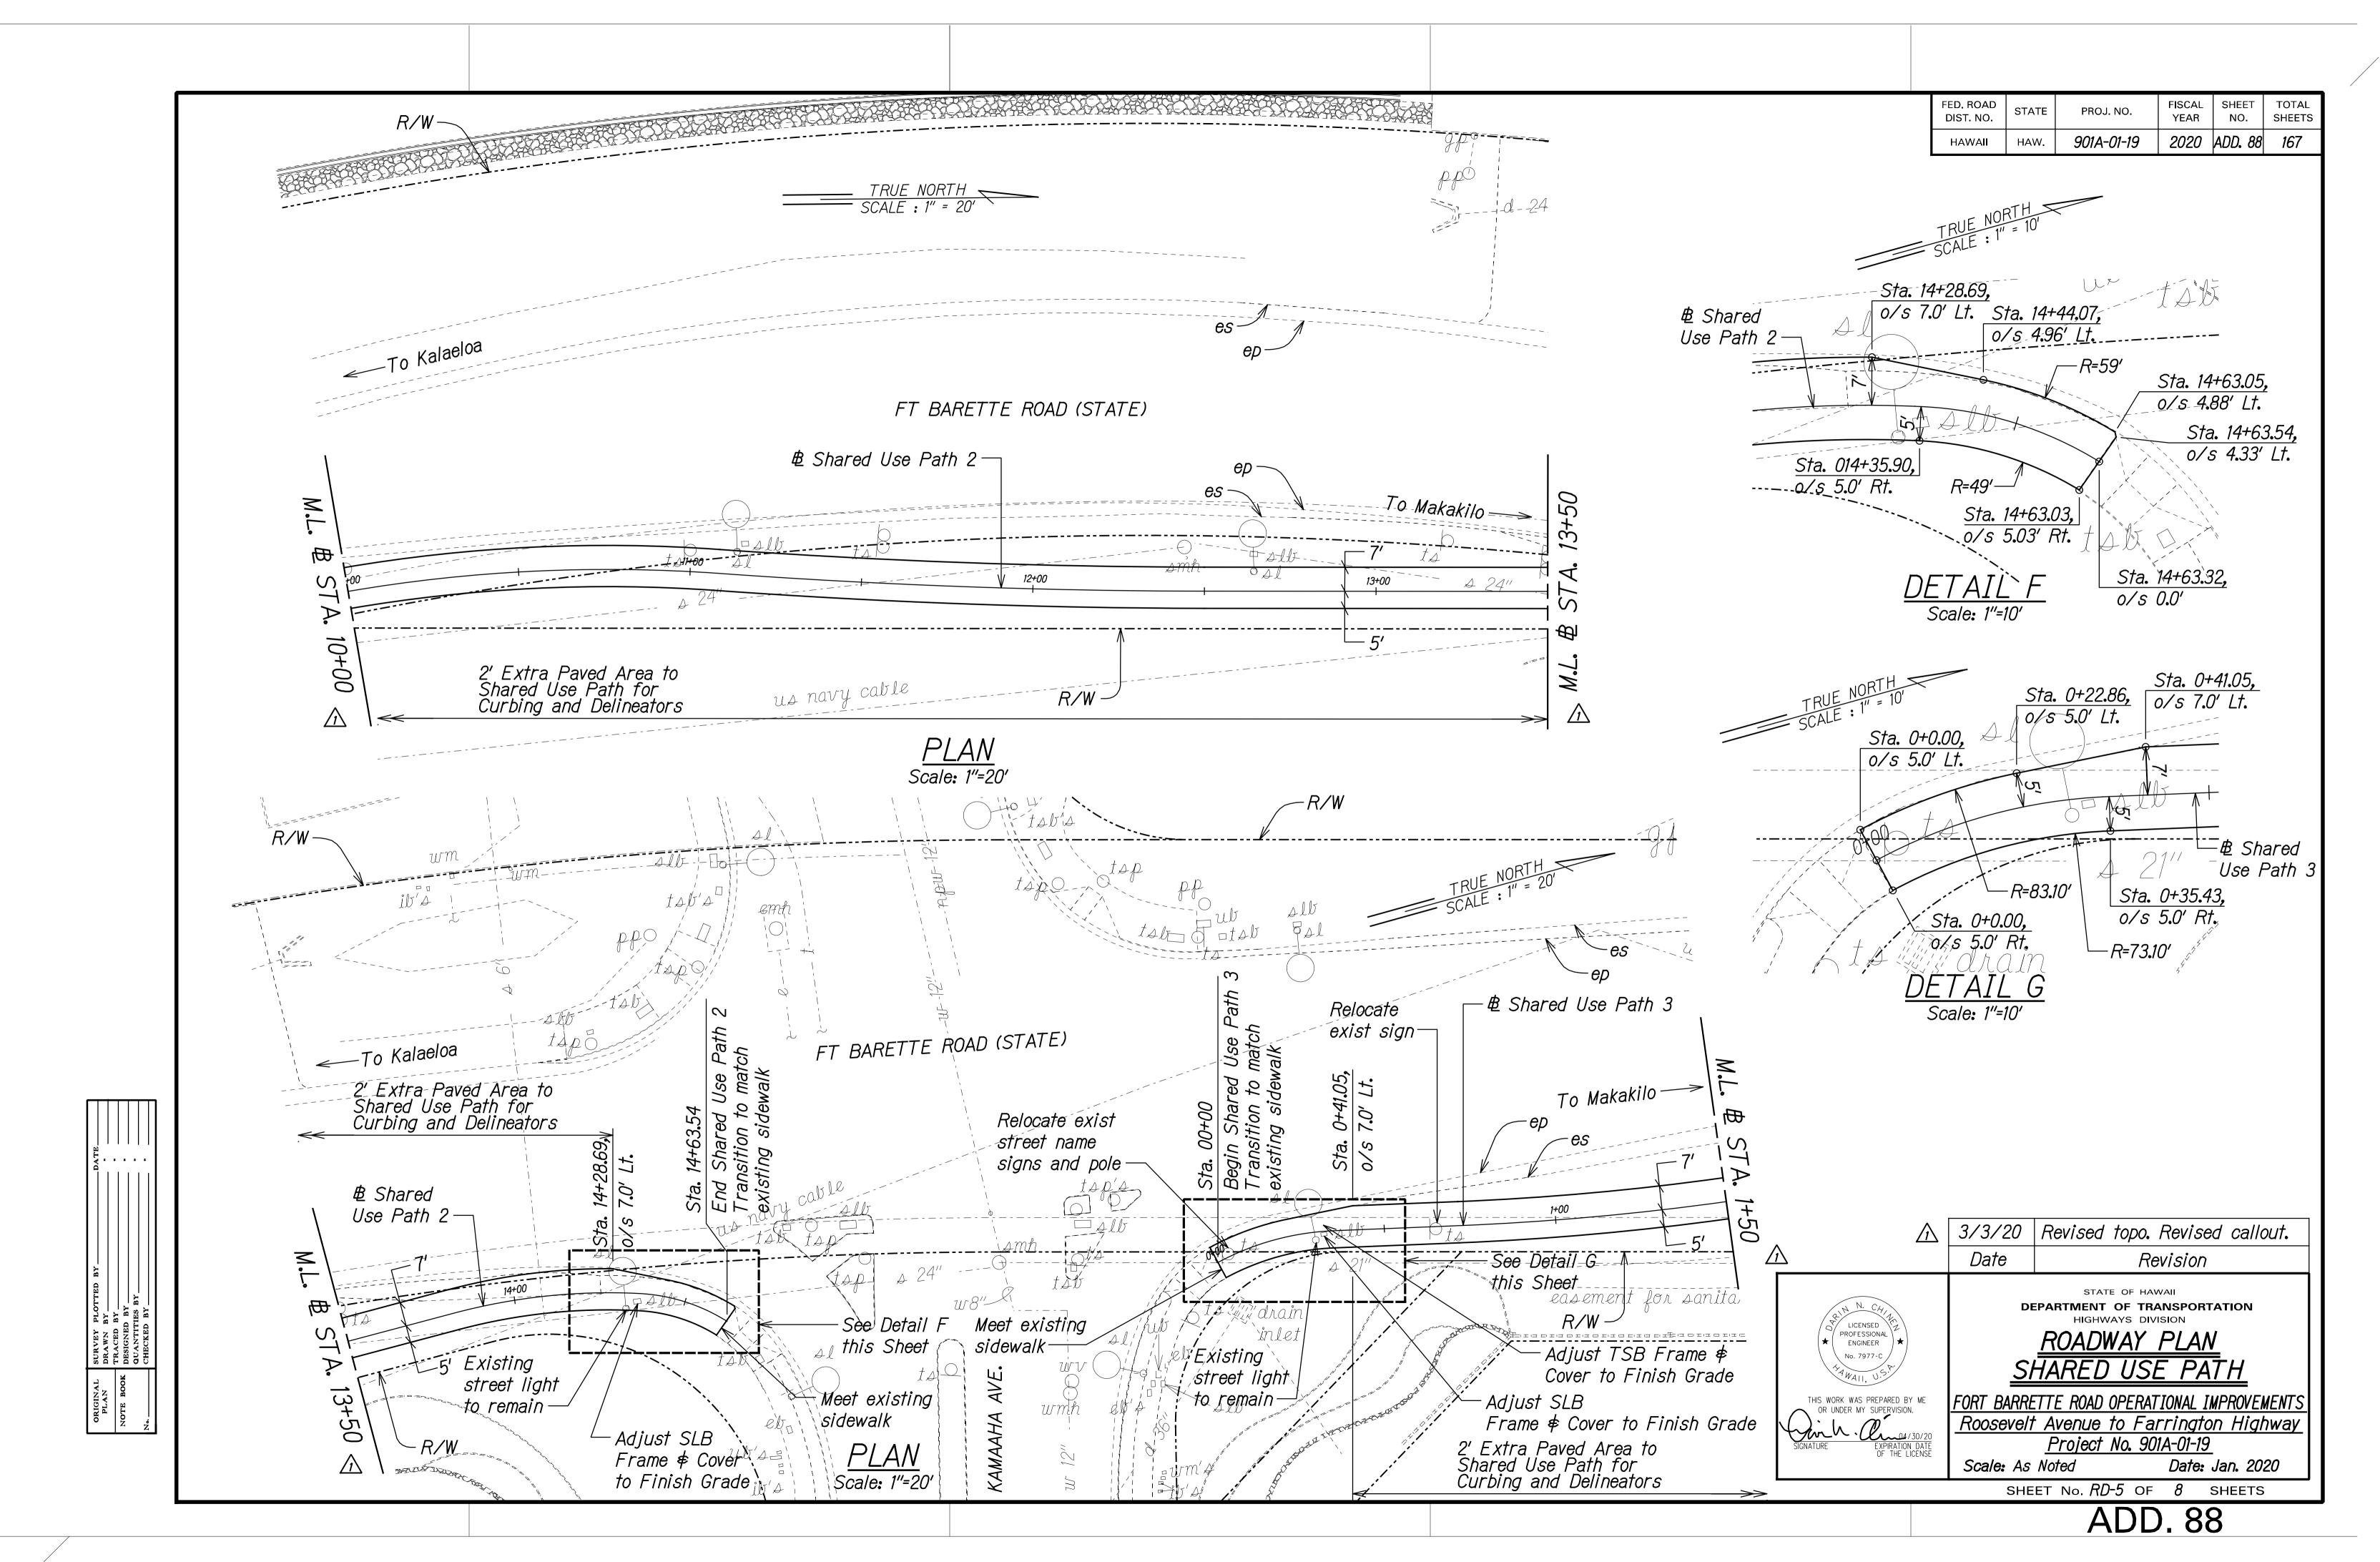


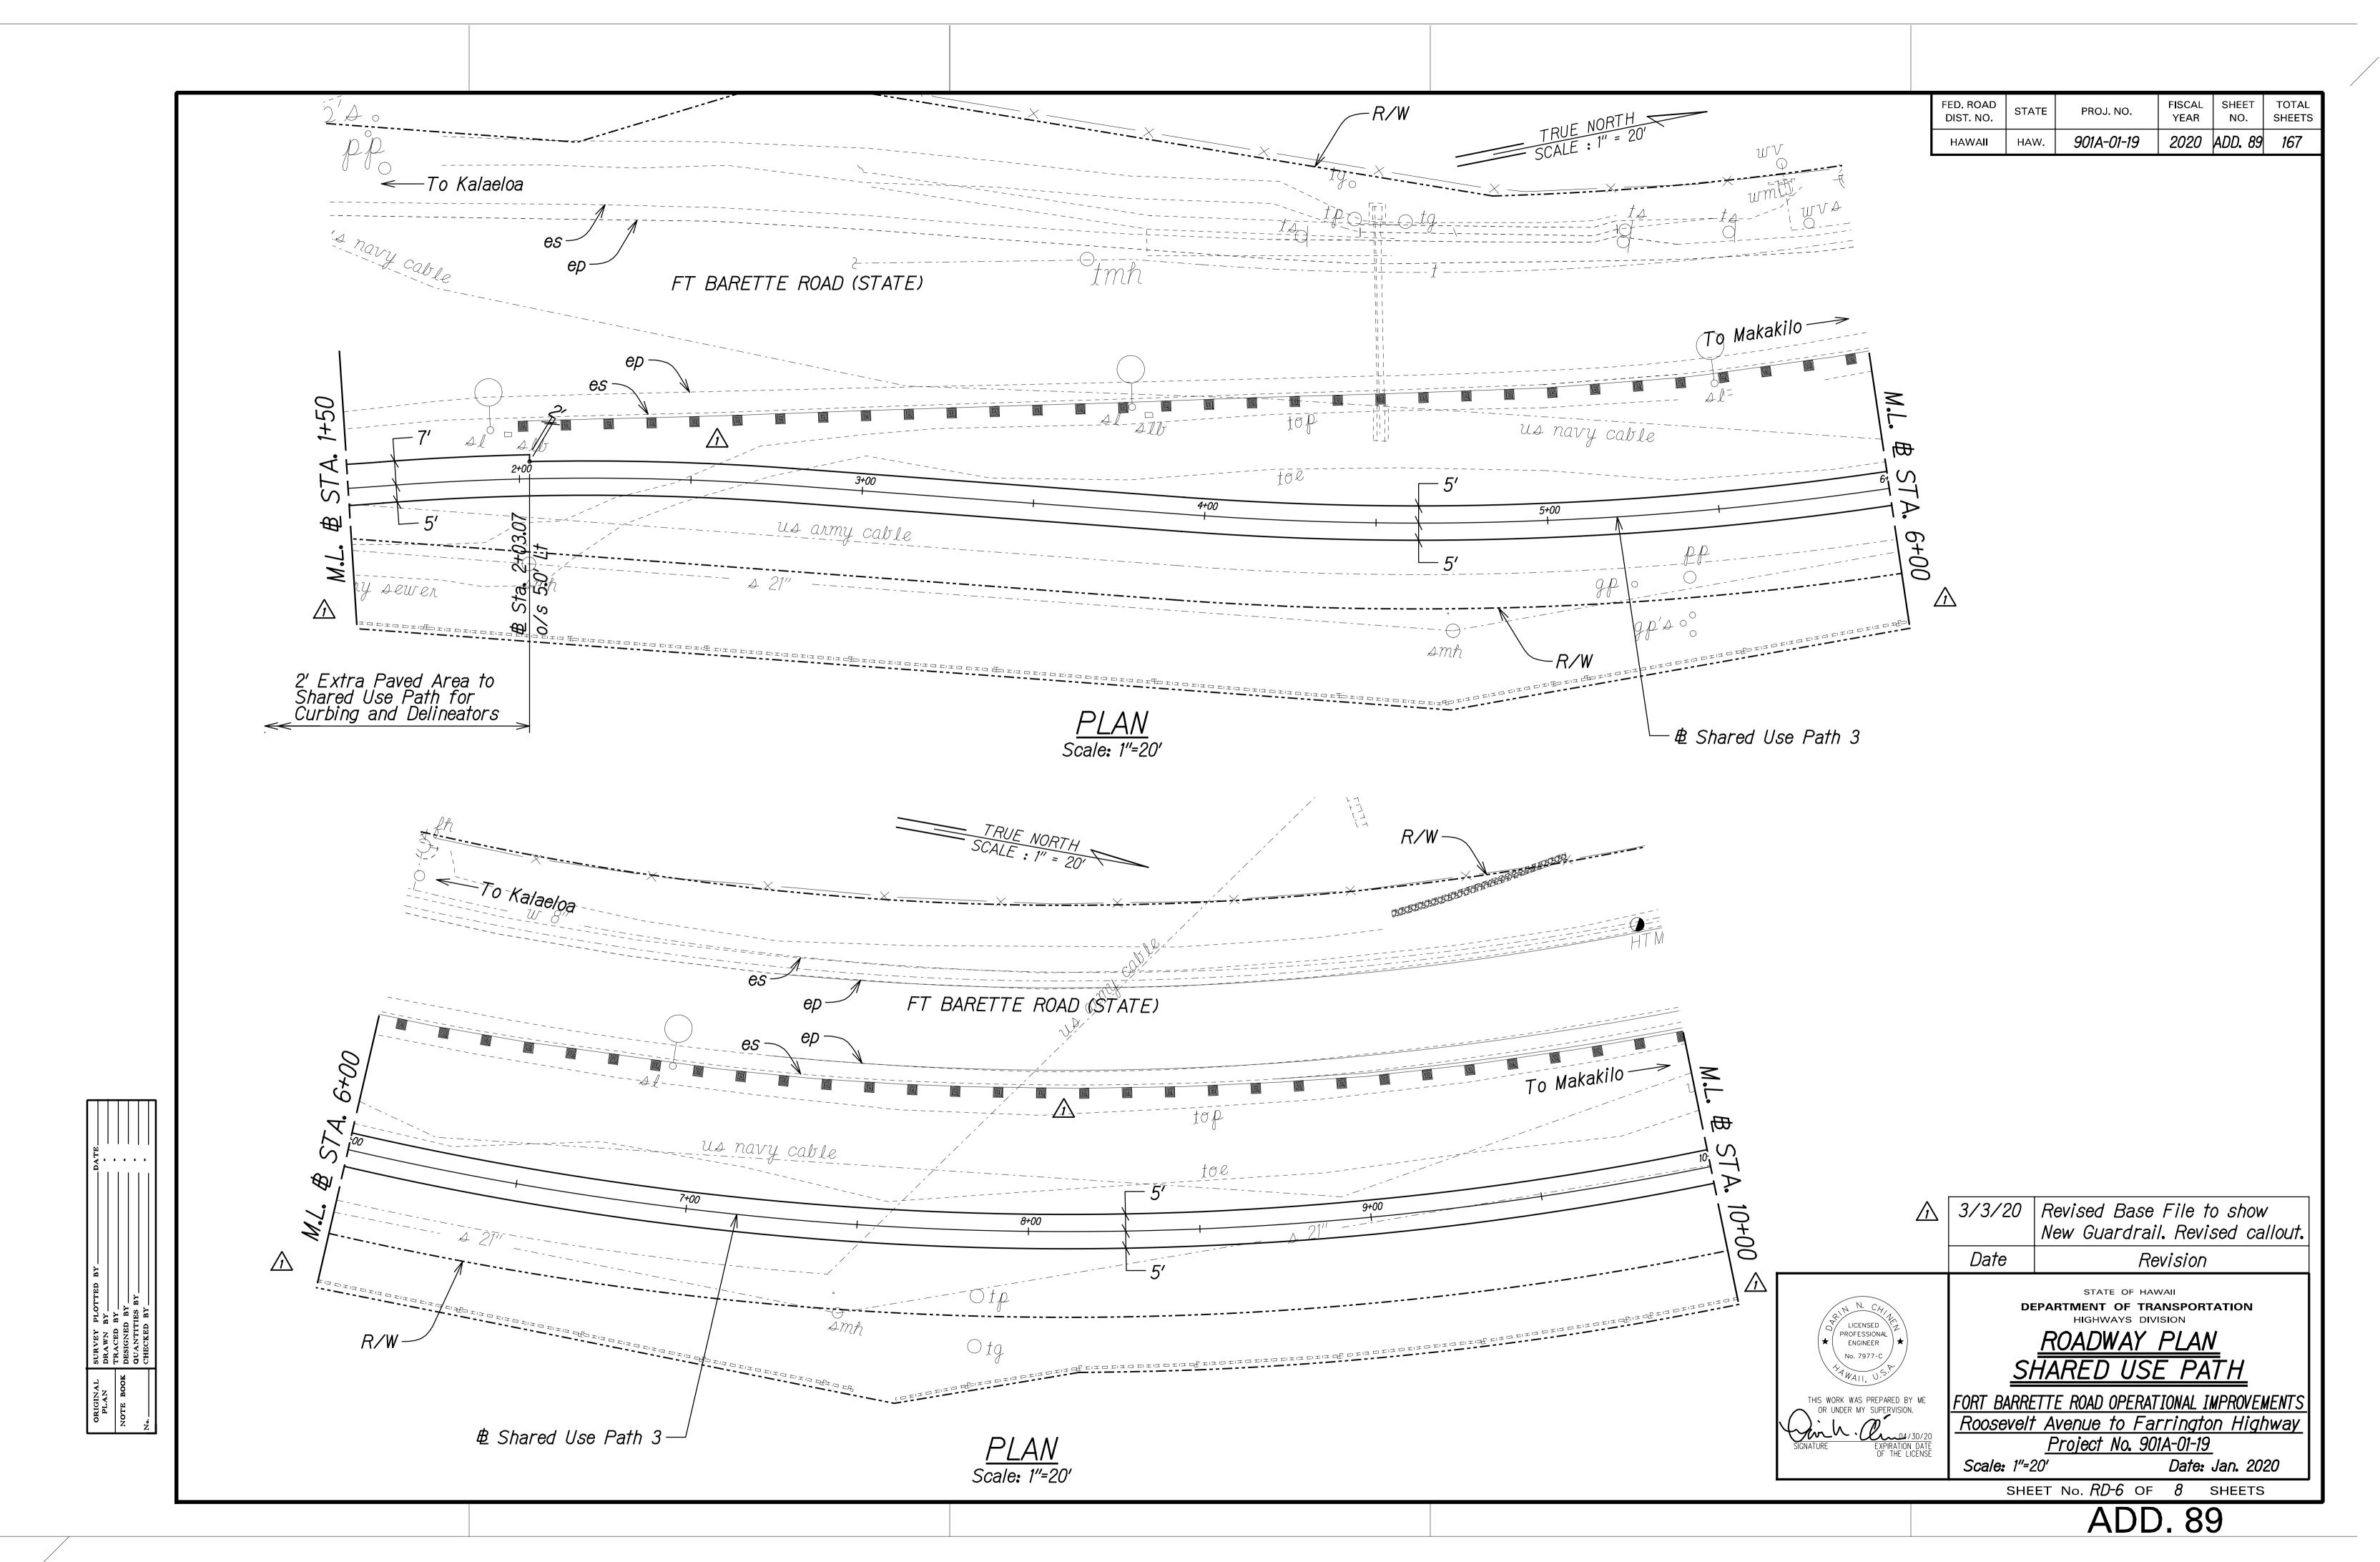

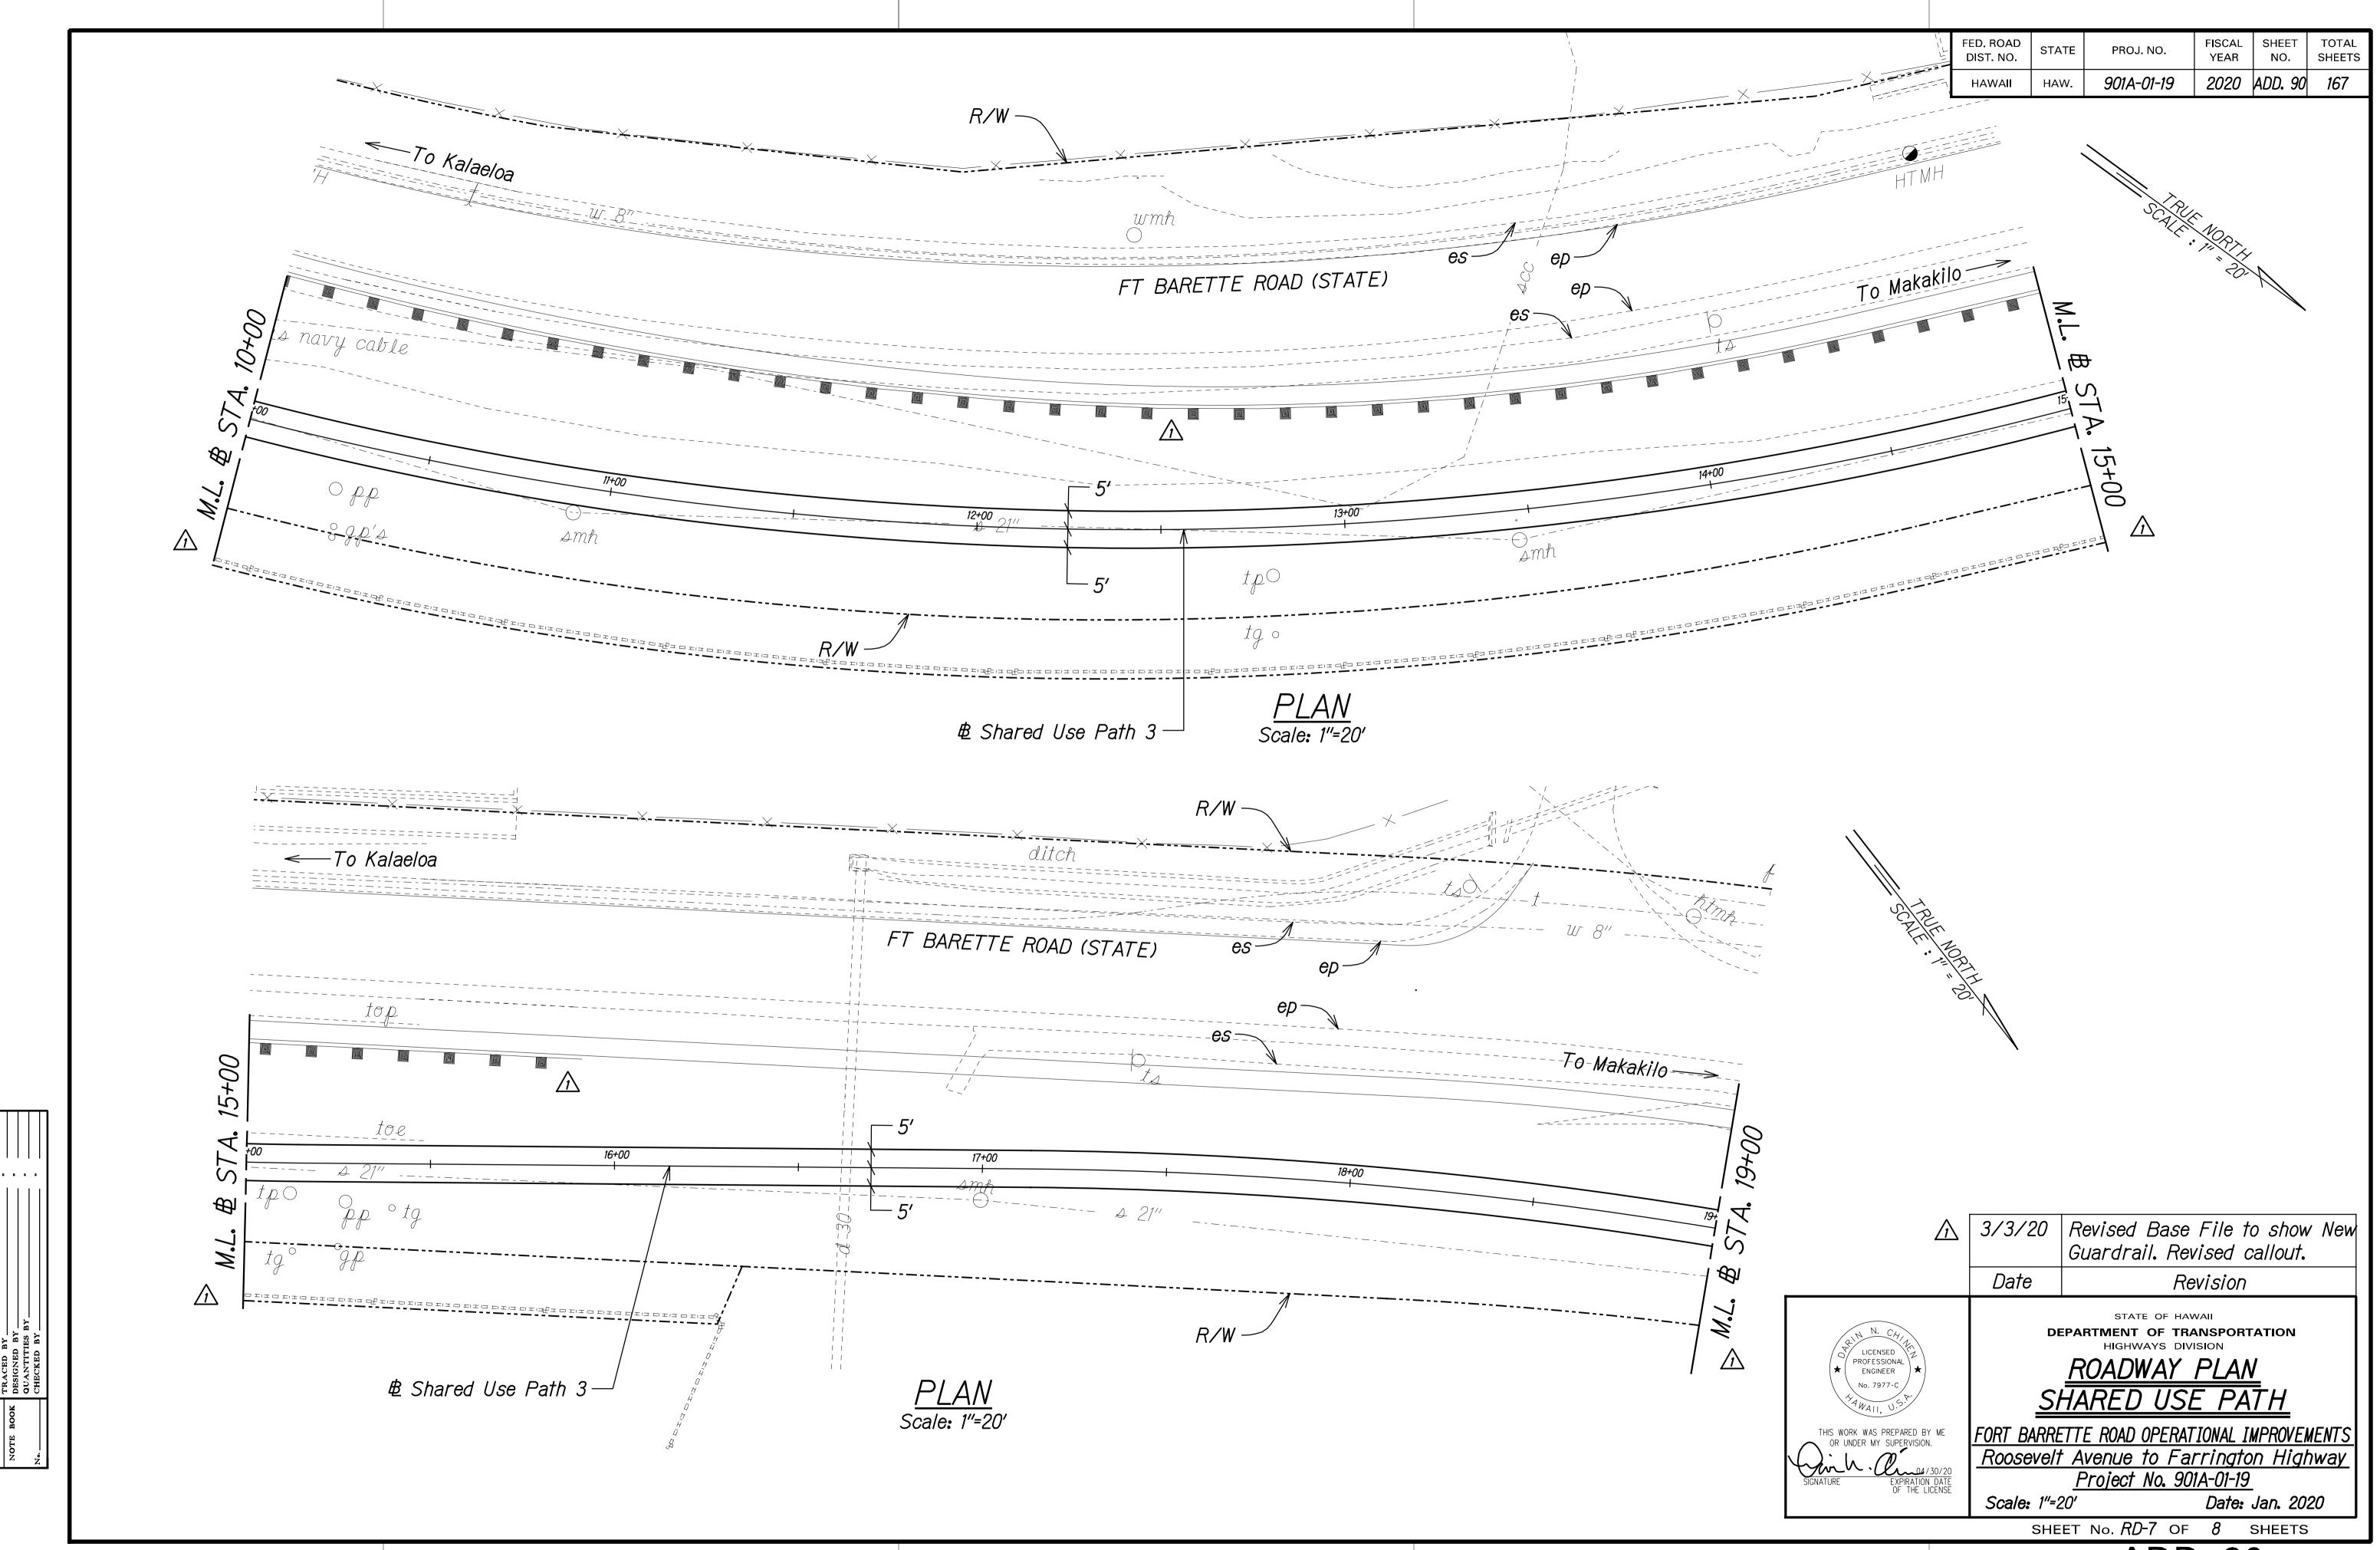

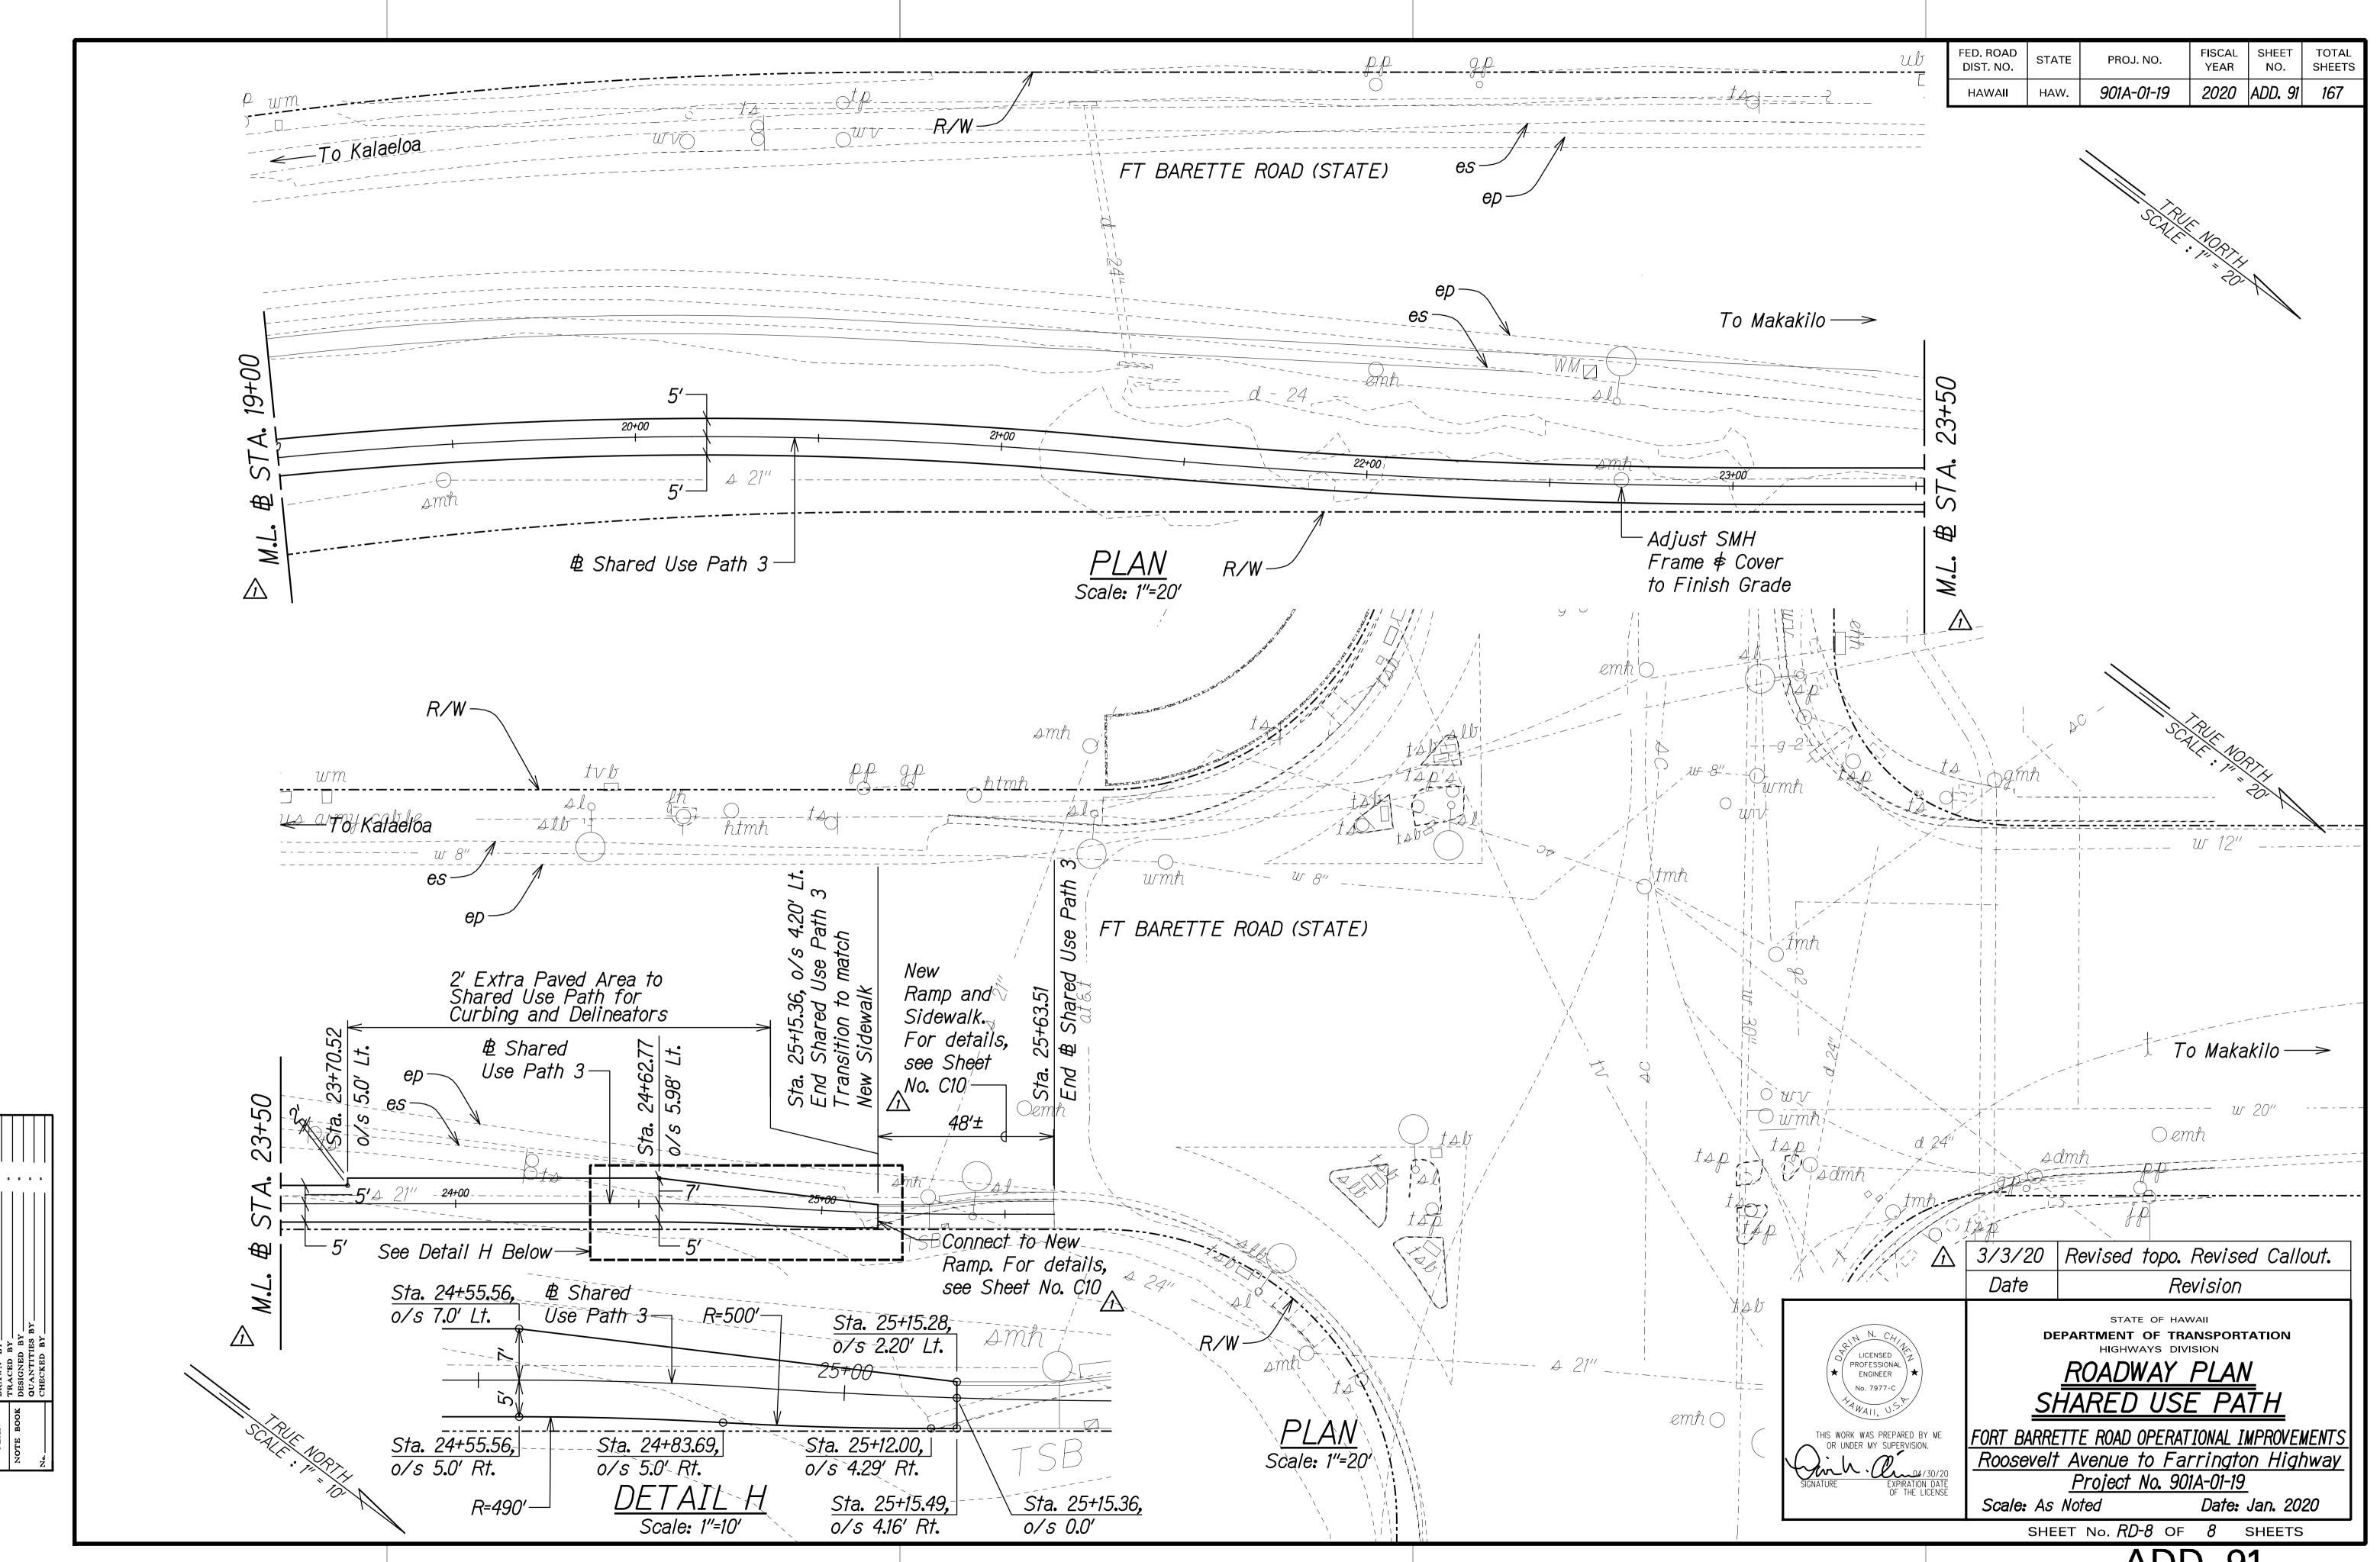

FED. ROAD DIST. NO.	STATE	PROJ. NO.	FISCAL YEAR	SHEET NO.	TOTAL SHEETS
HAWAII	HAW.	901A-01-19	2020	ADD. 92	<i>16</i> 7

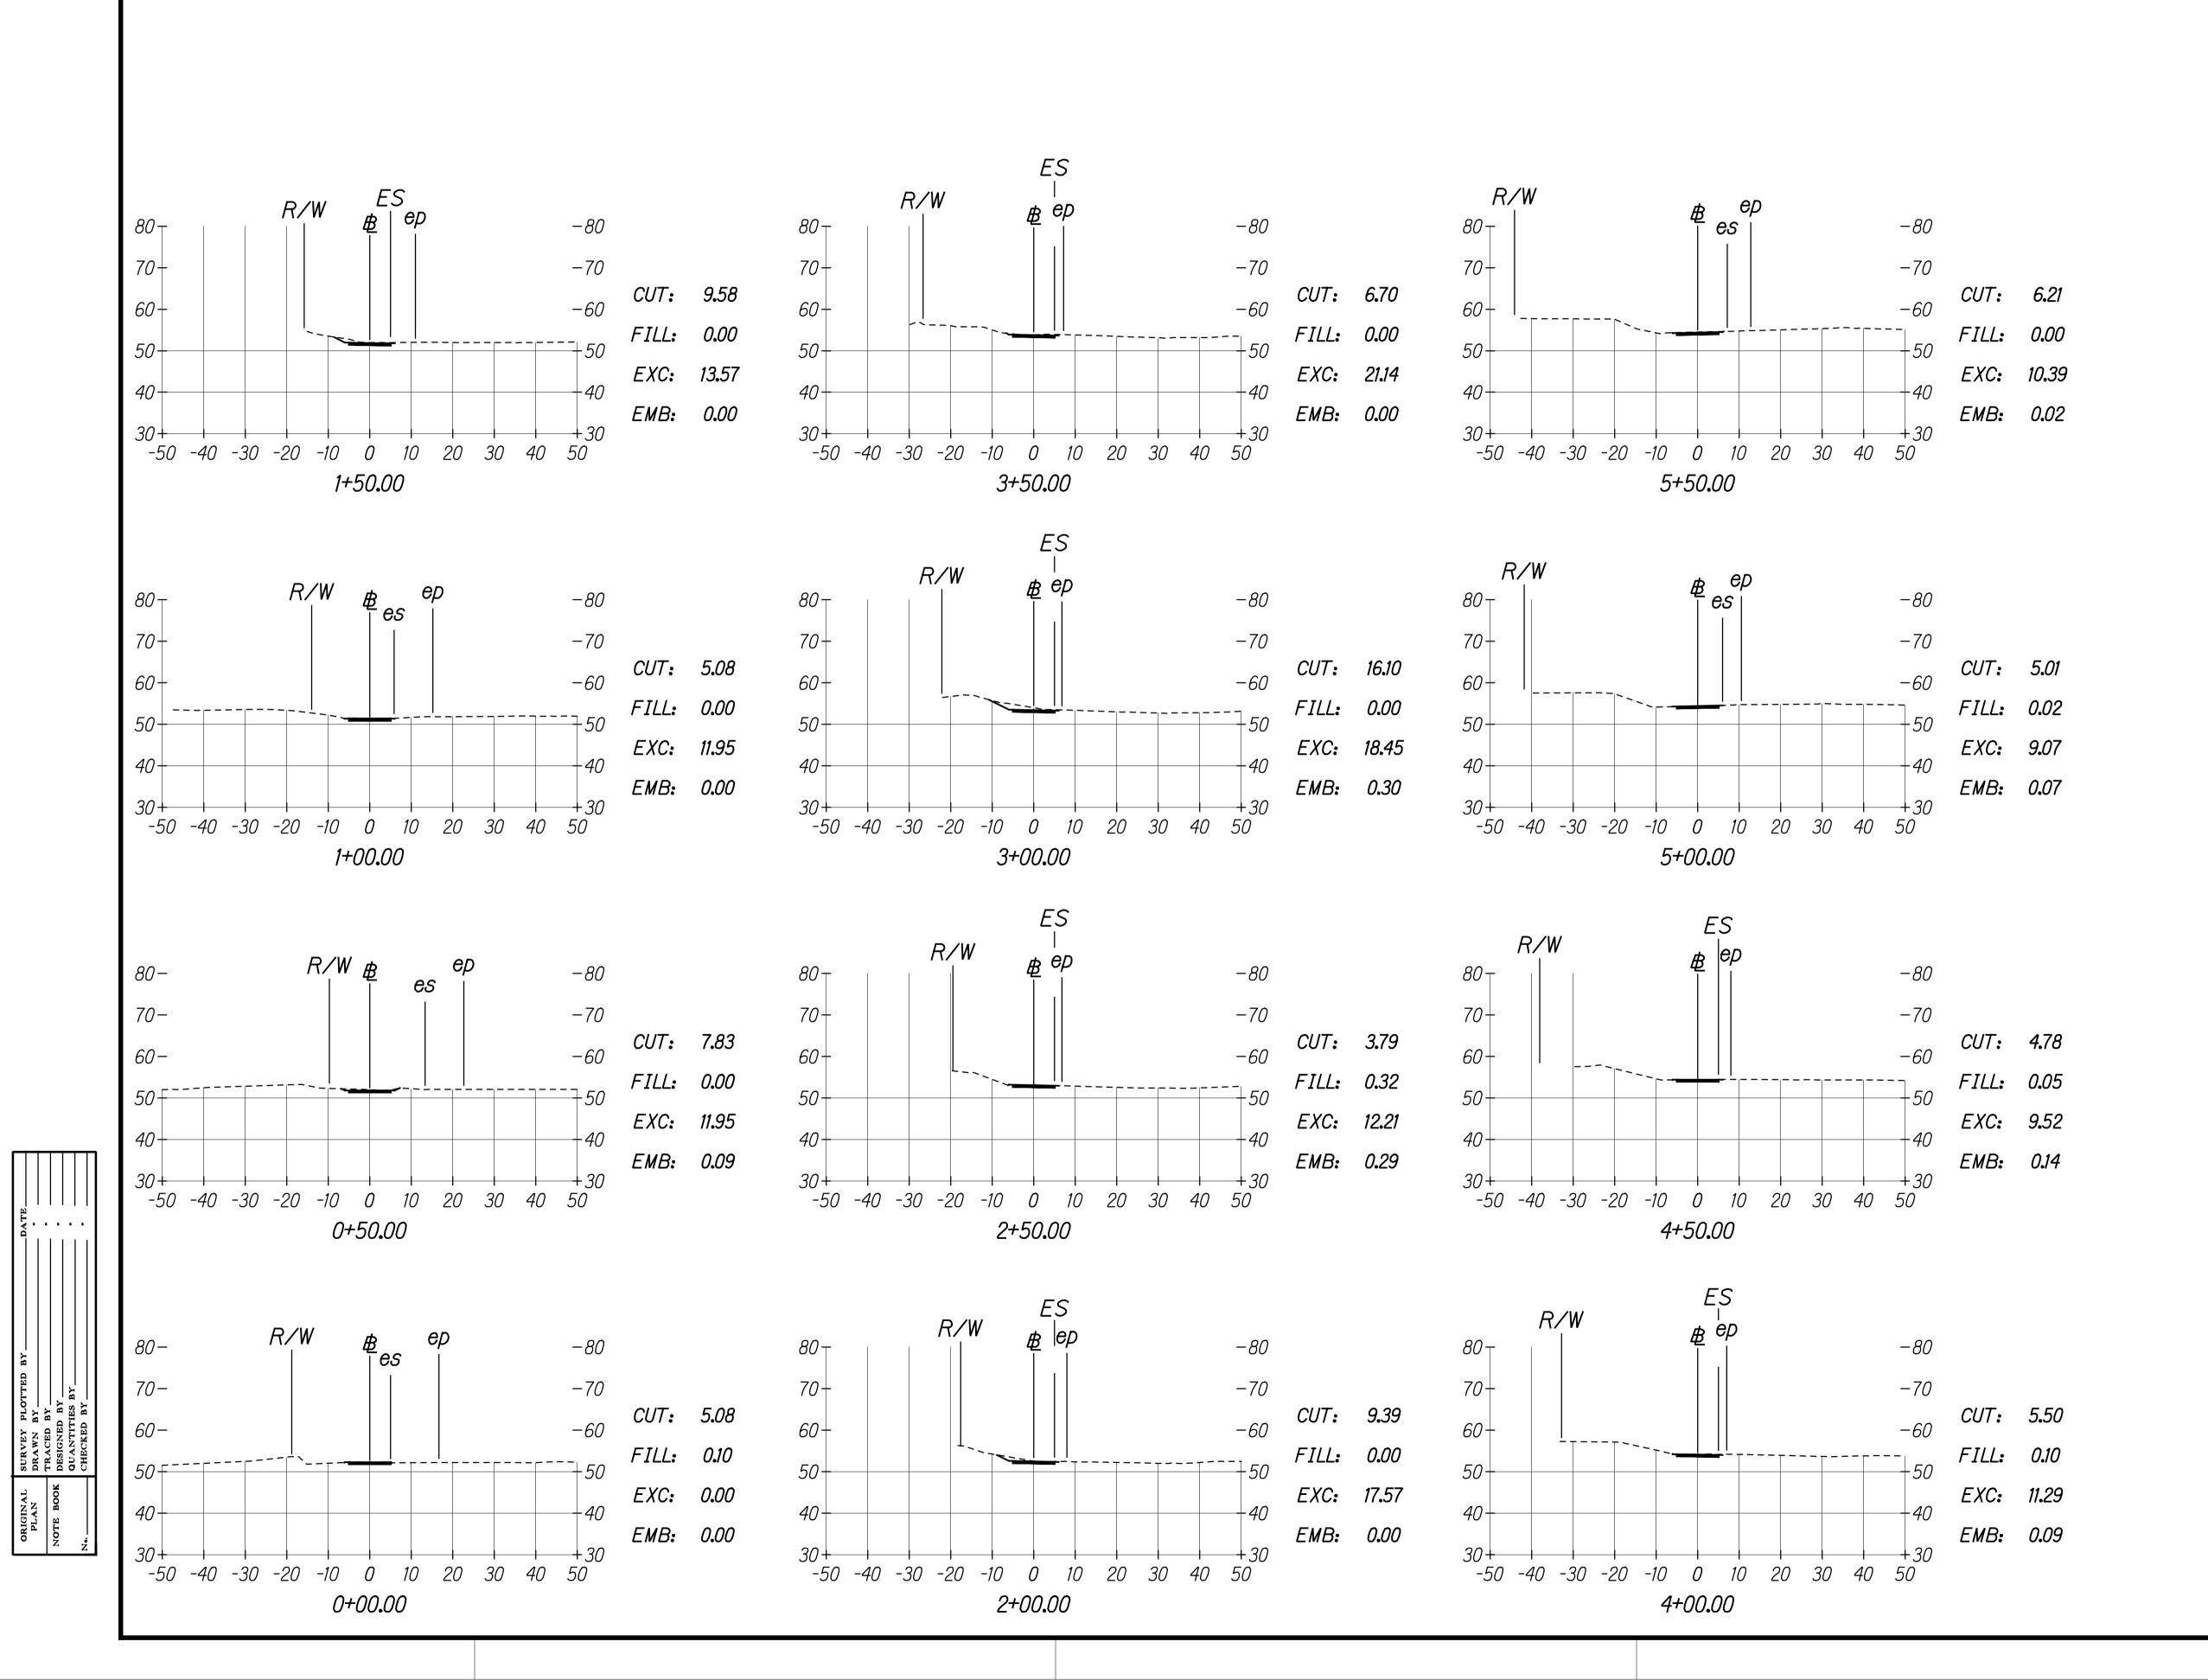




1 3/3/20 Revised All Cross Sections Revision **DEPARTMENT OF TRANSPORTATION**HIGHWAYS DIVISION CROSS SECTION FORT BARRETTE ROAD OPERATIONAL IMPROVEMENTS


Roosevelt Avenue to Farrington Highway Project No. 901A-01-19 Date: Jan. 2020

Scale: 1"=20'

SHEET No. XS-1 OF 12 SHEETS

FED. ROAD DIST. NO.	STATE	PROJ. NO.	FISCAL YEAR	SHEET NO.	TOTAL SHEETS
HAWAII	HAW.	901A-01-19	2020	ADD. 93	167

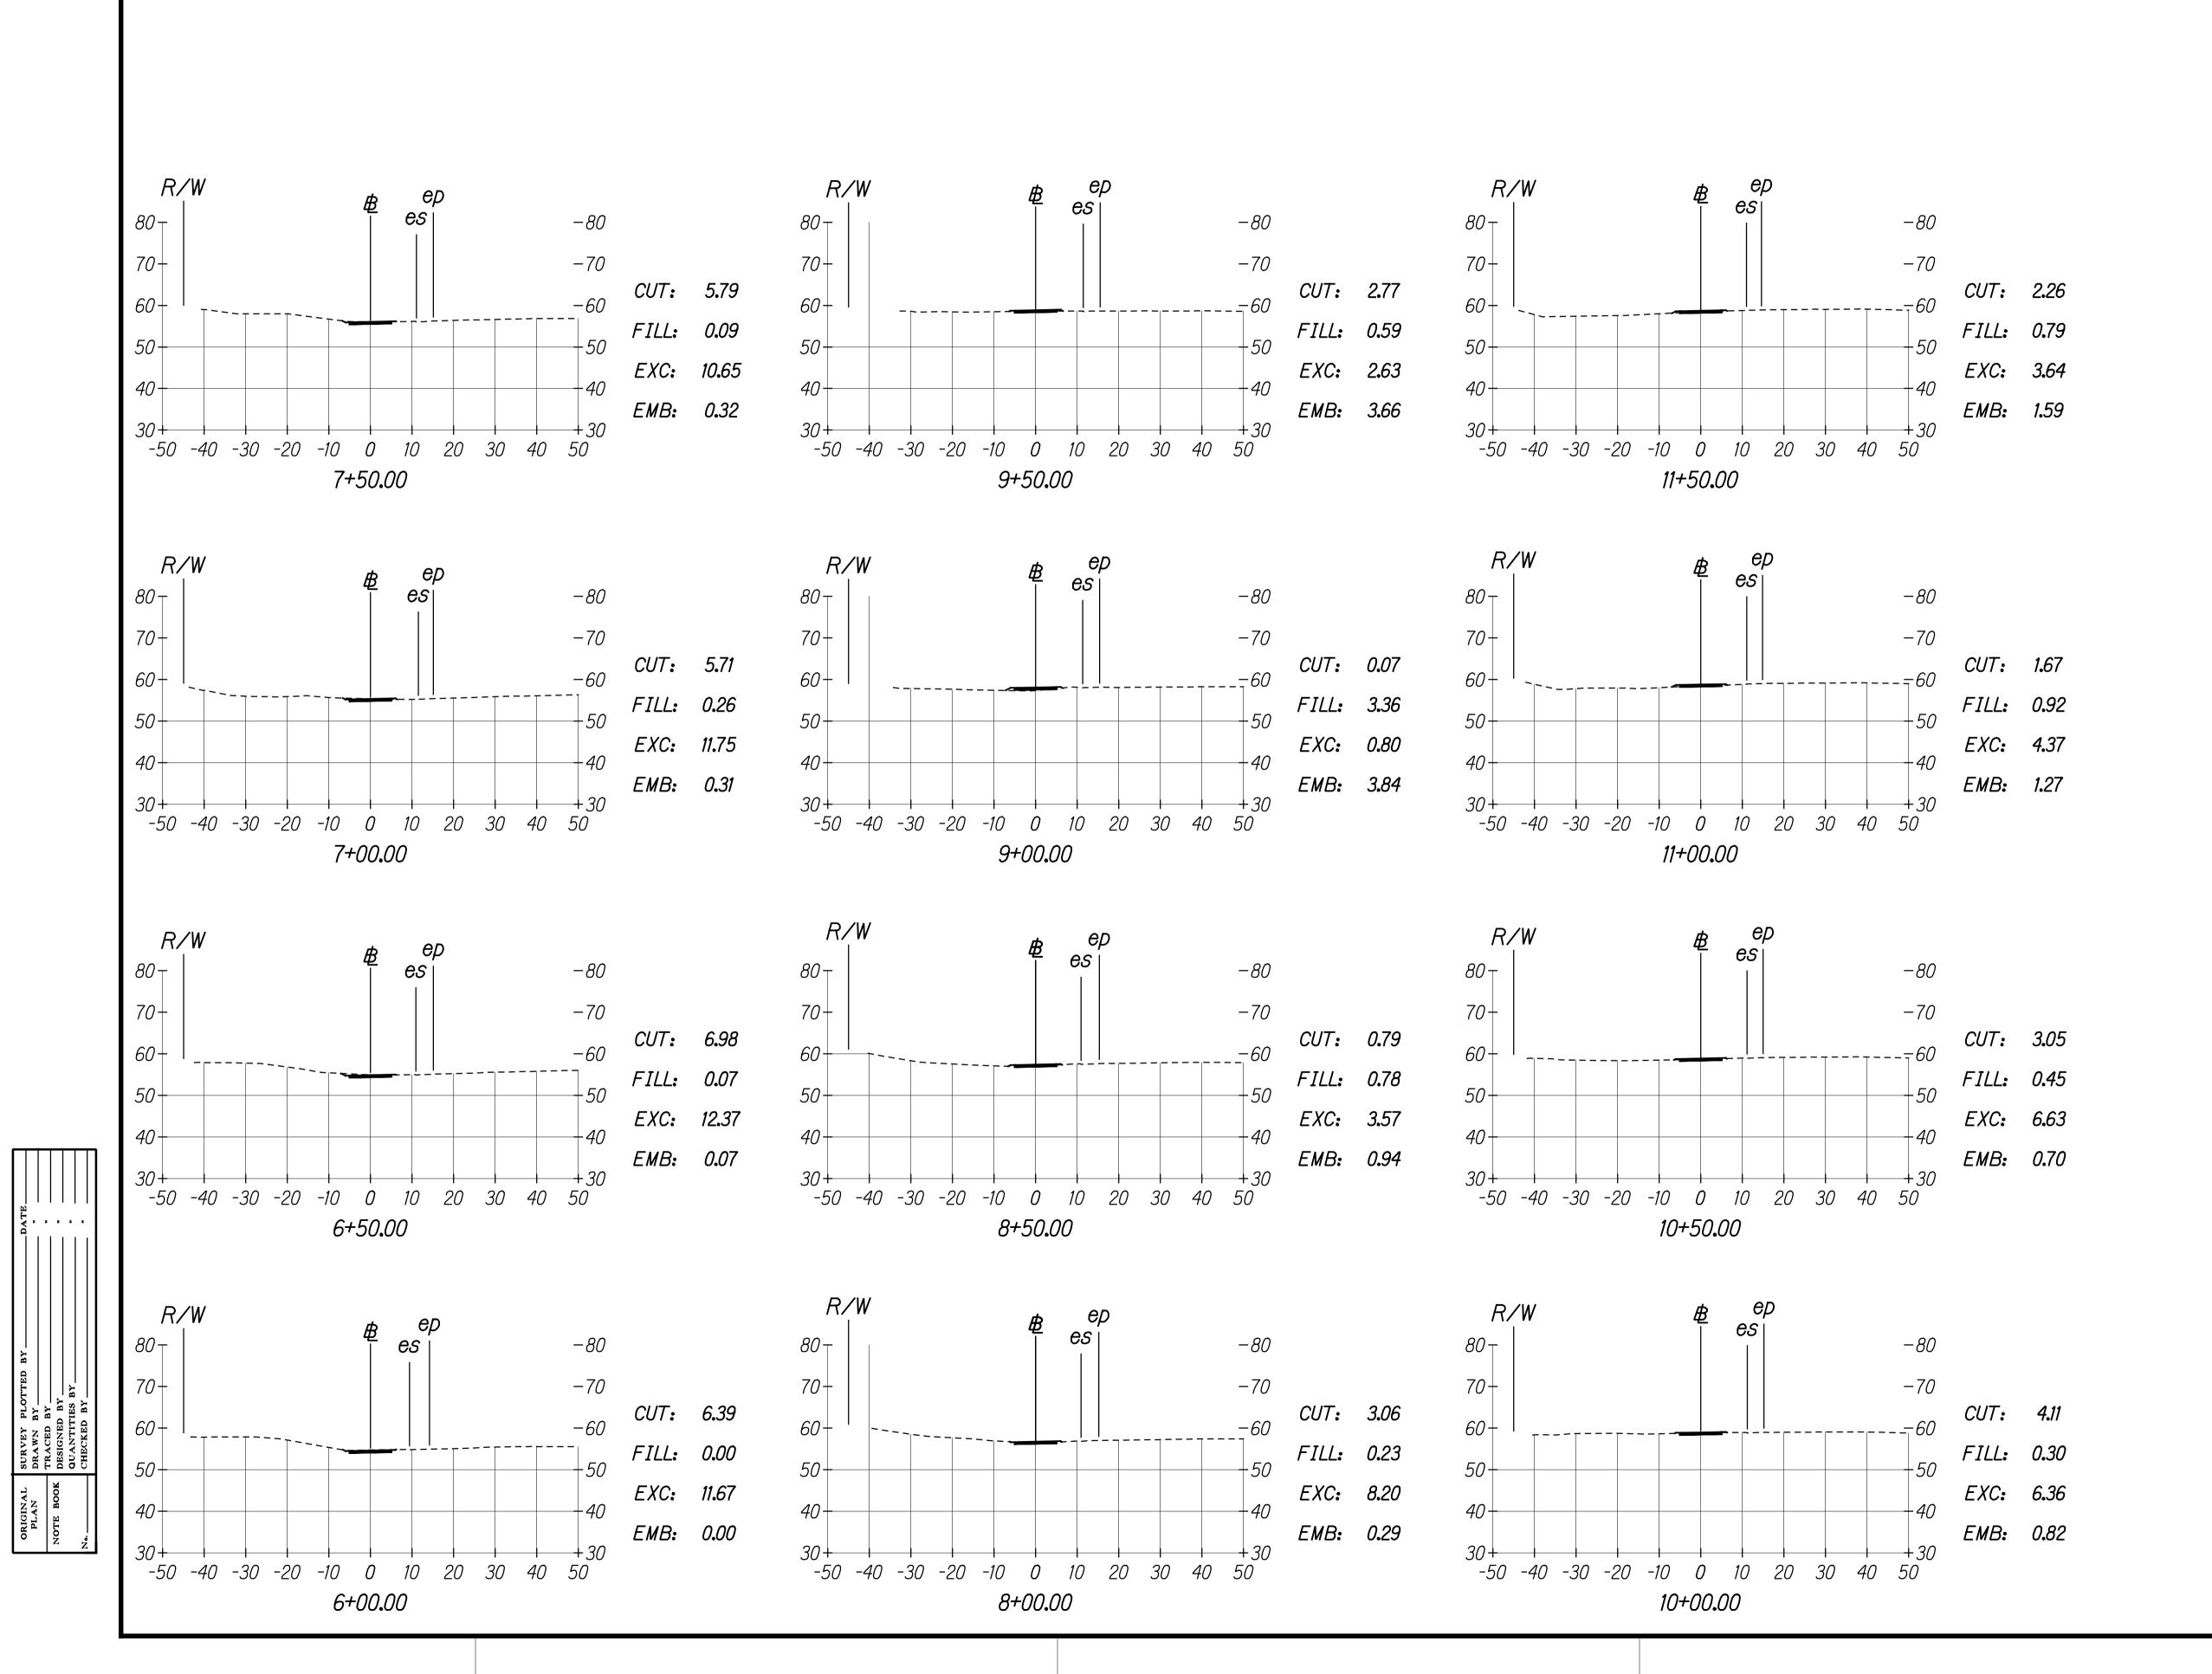

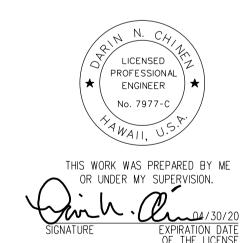

3/3/20 Revised All Cross Sections

Date Revision

STATE OF HAWAII

DEPARTMENT OF TRANSPORTATION
HIGHWAYS DIVISION

CROSS SECTION

SHARED USE PATH 1

FORT BARRETTE ROAD OPERATIONAL IMPROVEMENTS

FORT BARRETTE ROAD OPERATIONAL IMPROVEMENTS


Roosevelt Avenue to Farrington Highway

Project No. 901A-01-19

Scale: 1"=20' Date: Jan. 2020

SHEET No. XS-2 OF 12 SHEETS

FED. ROAD DIST. NO.	STATE	PROJ. NO.	FISCAL YEAR	SHEET NO.	TOTAL SHEETS
HAWAII	HAW.	901A-01-19	2020	ADD. 94	167

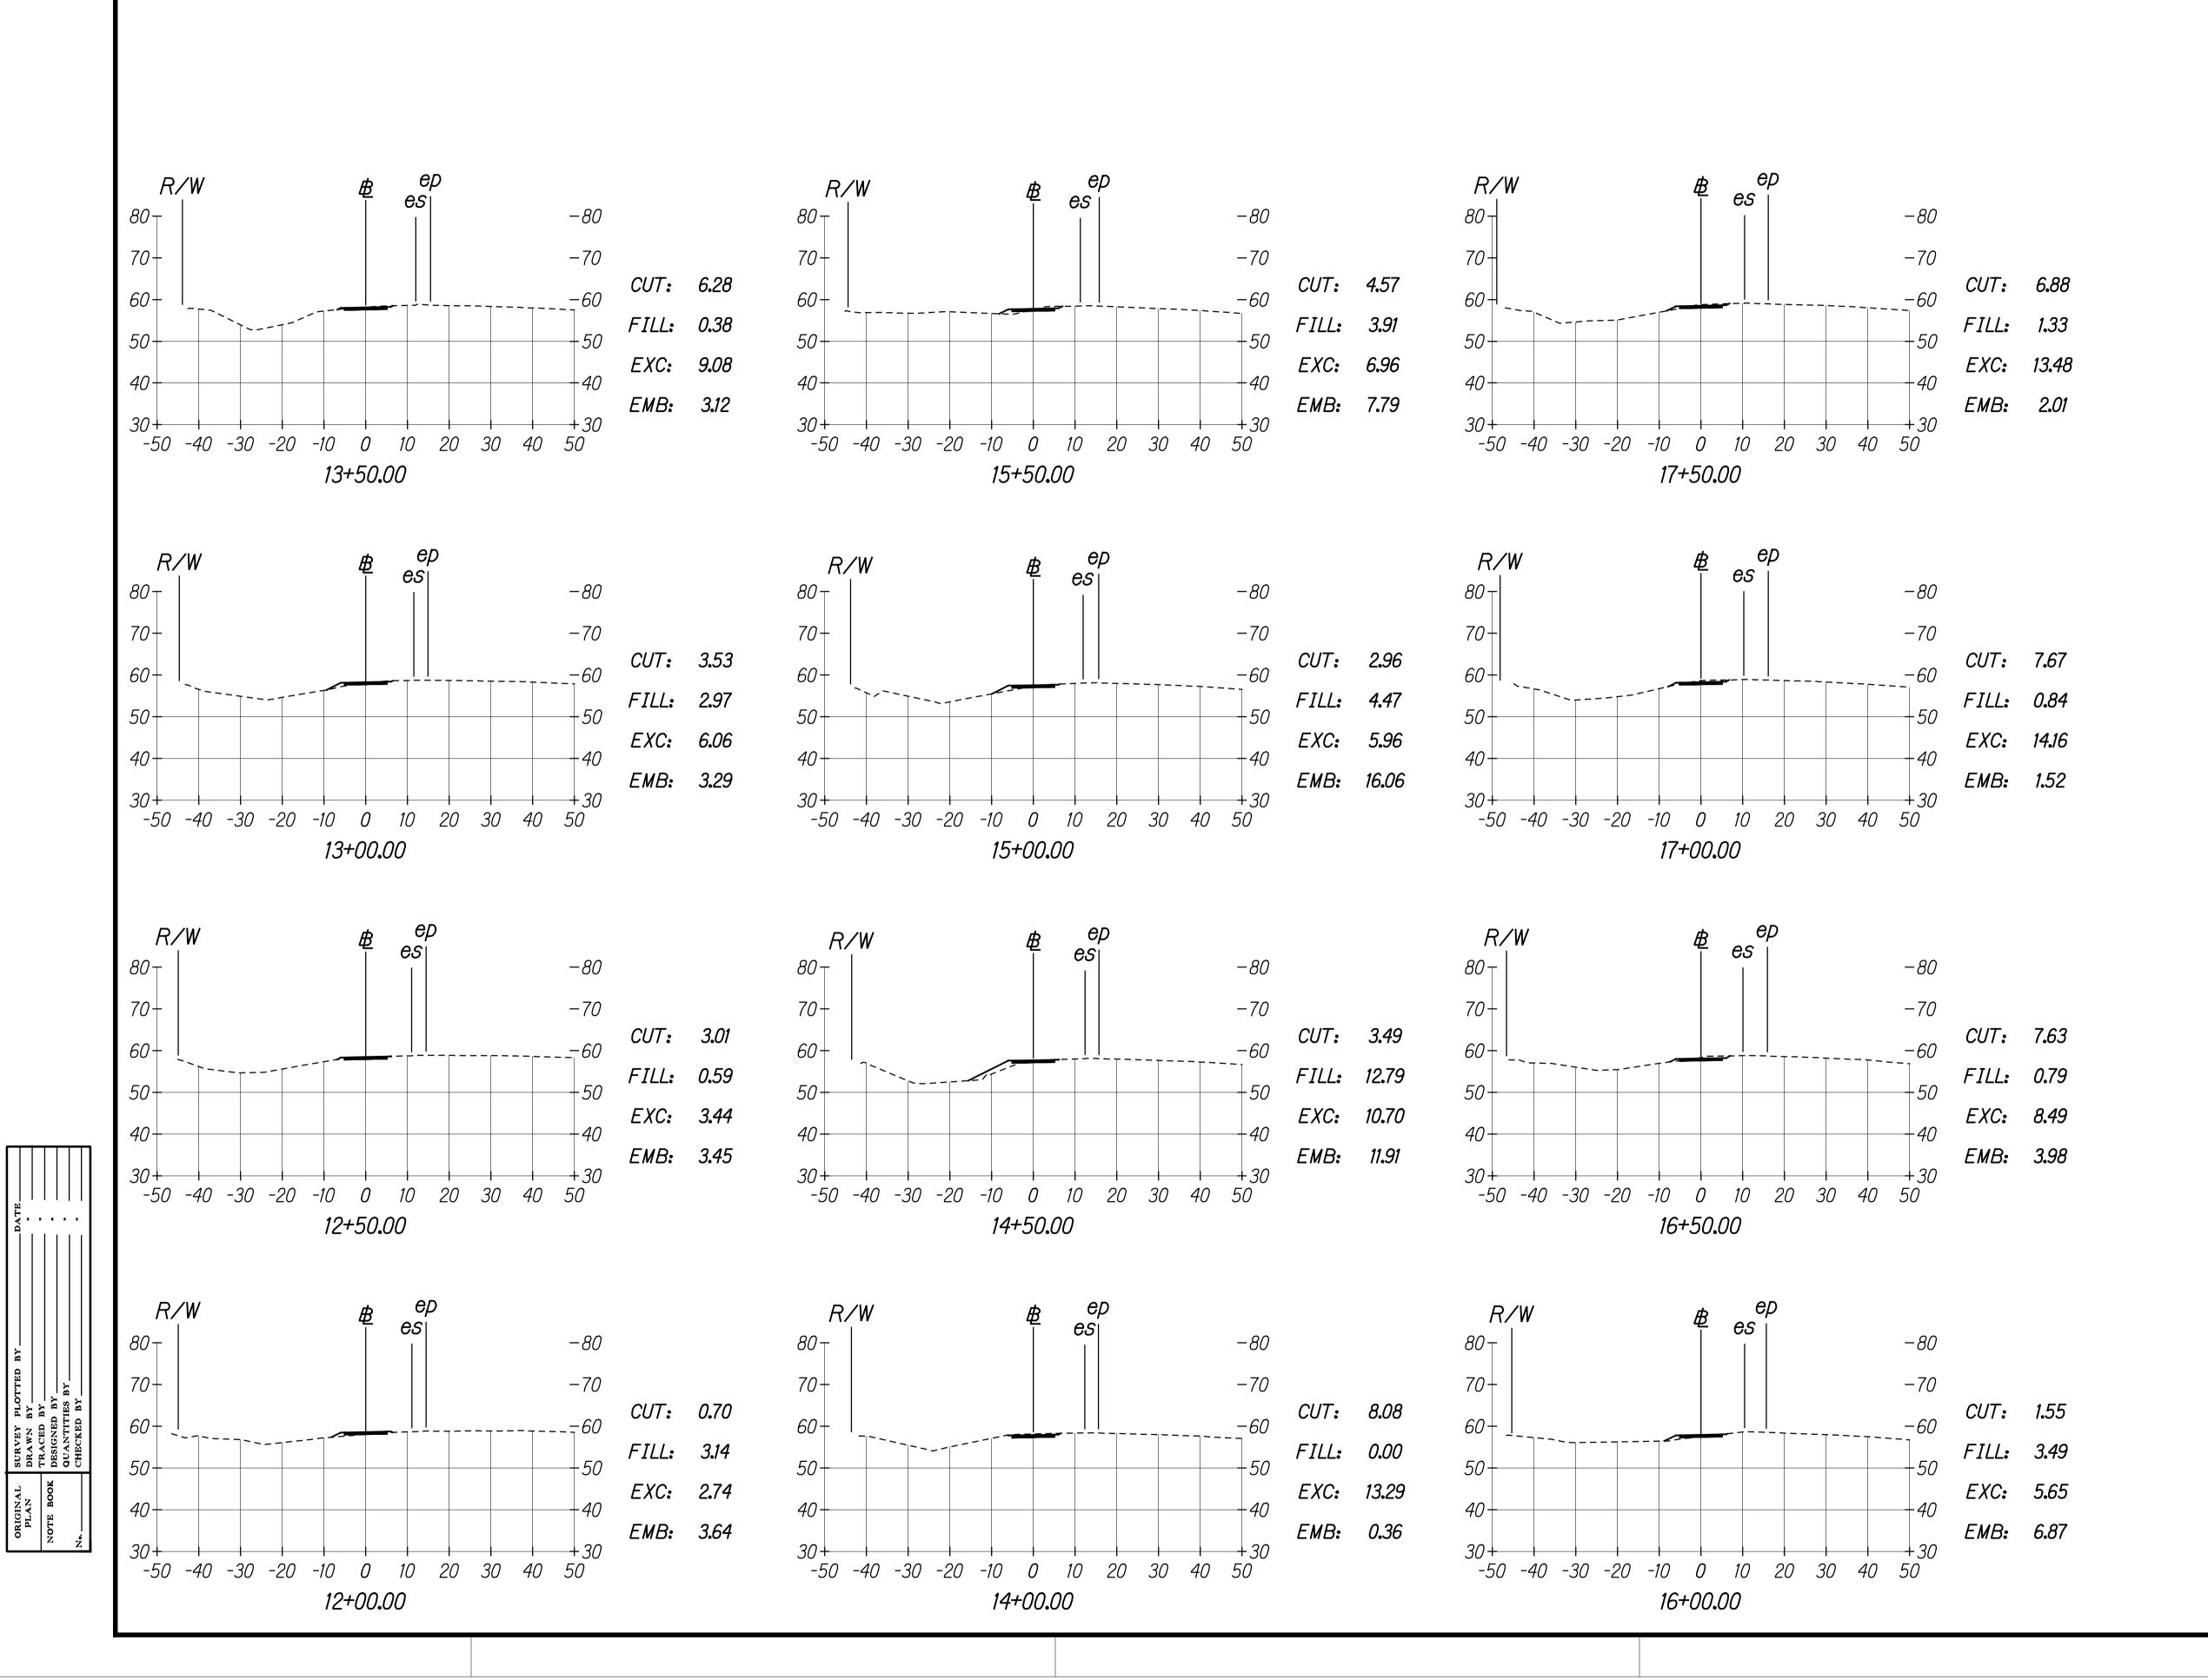




1 3/3/20 Revised All Cross Sections Revision STATE OF HAWAII **DEPARTMENT OF TRANSPORTATION**HIGHWAYS DIVISION CROSS SECTION


FORT BARRETTE ROAD OPERATIONAL IMPROVEMENTS Roosevelt Avenue to Farrington Highway Project No. 901A-01-19 Date: Jan. 2020


Scale: 1"=20'


SHEET No. XS-3 OF 12 SHEETS

FED. ROAD DIST. NO.	STATE	PROJ. NO.	FISCAL YEAR	SHEET NO.	TOTAL SHEETS
HAWAII	HAW.	901A-01-19	2020	ADD. 95	167

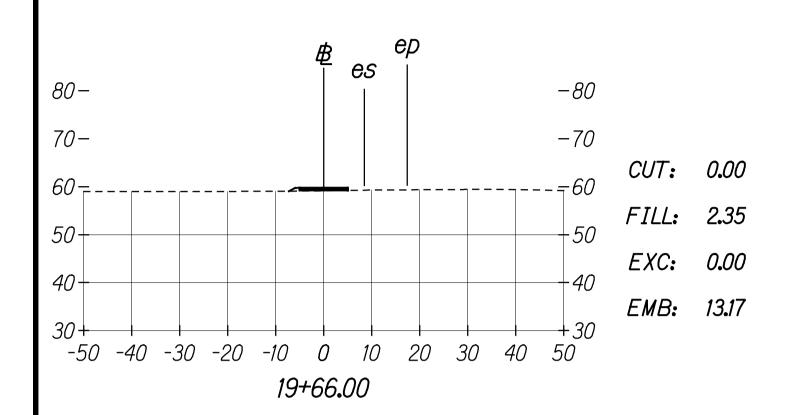

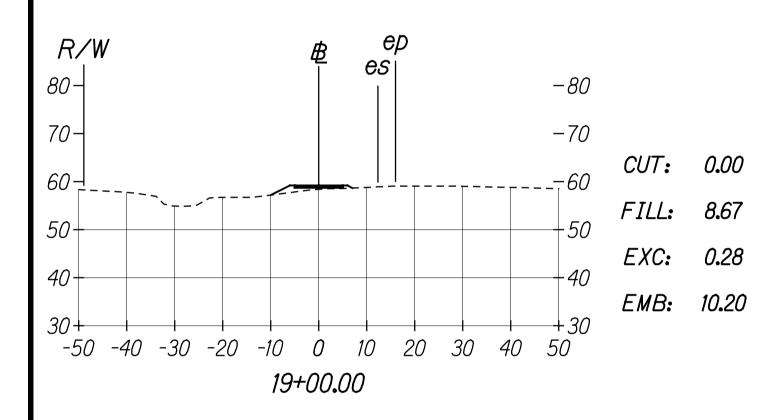


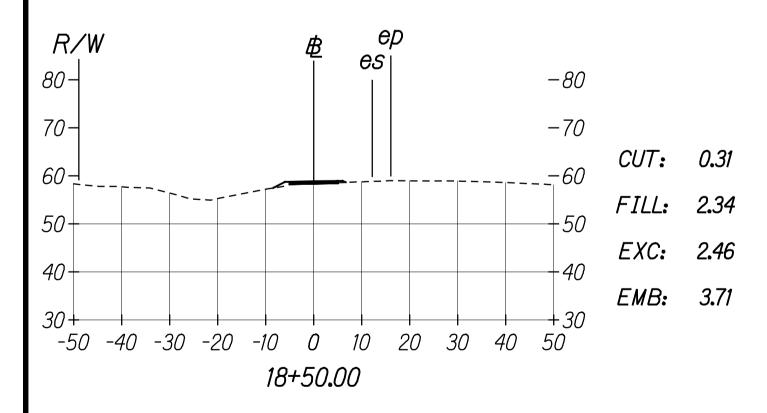

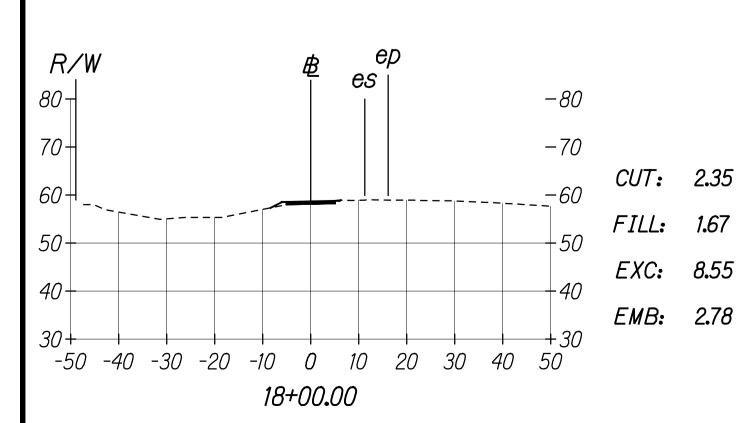

SUMMARY

SHARED USE PATH 1	EXC CU YD	EMB CU YD	
TOTAL	340	109	

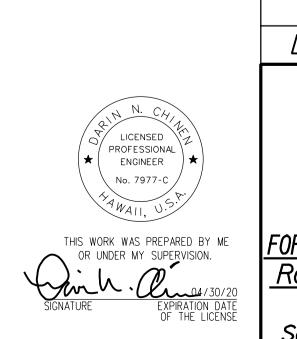

1/3/20 Revised All Cross Sections and Summary Schedule

Date Revision

STATE OF HAWAII

DEPARTMENT OF TRANSPORTATION
HIGHWAYS DIVISION

CROSS SECTION
SHARED USE PATH 1

FORT BARRETTE ROAD OPERATIONAL IMPROVEMENTS

Roosevelt Avenue to Farrington Highway


Project No. 901A-01-19

Scale: 1"=20'

SHEET No. XS-4 OF 12 SHEETS

Date: Jan. 2020

FED. ROAD DIST. NO.	STATE	PROJ. NO.	FISCAL YEAR	SHEET NO.	TOTAL SHEETS
HAWAII	HAW.	901A-01-19	2020	ADD. 96	167

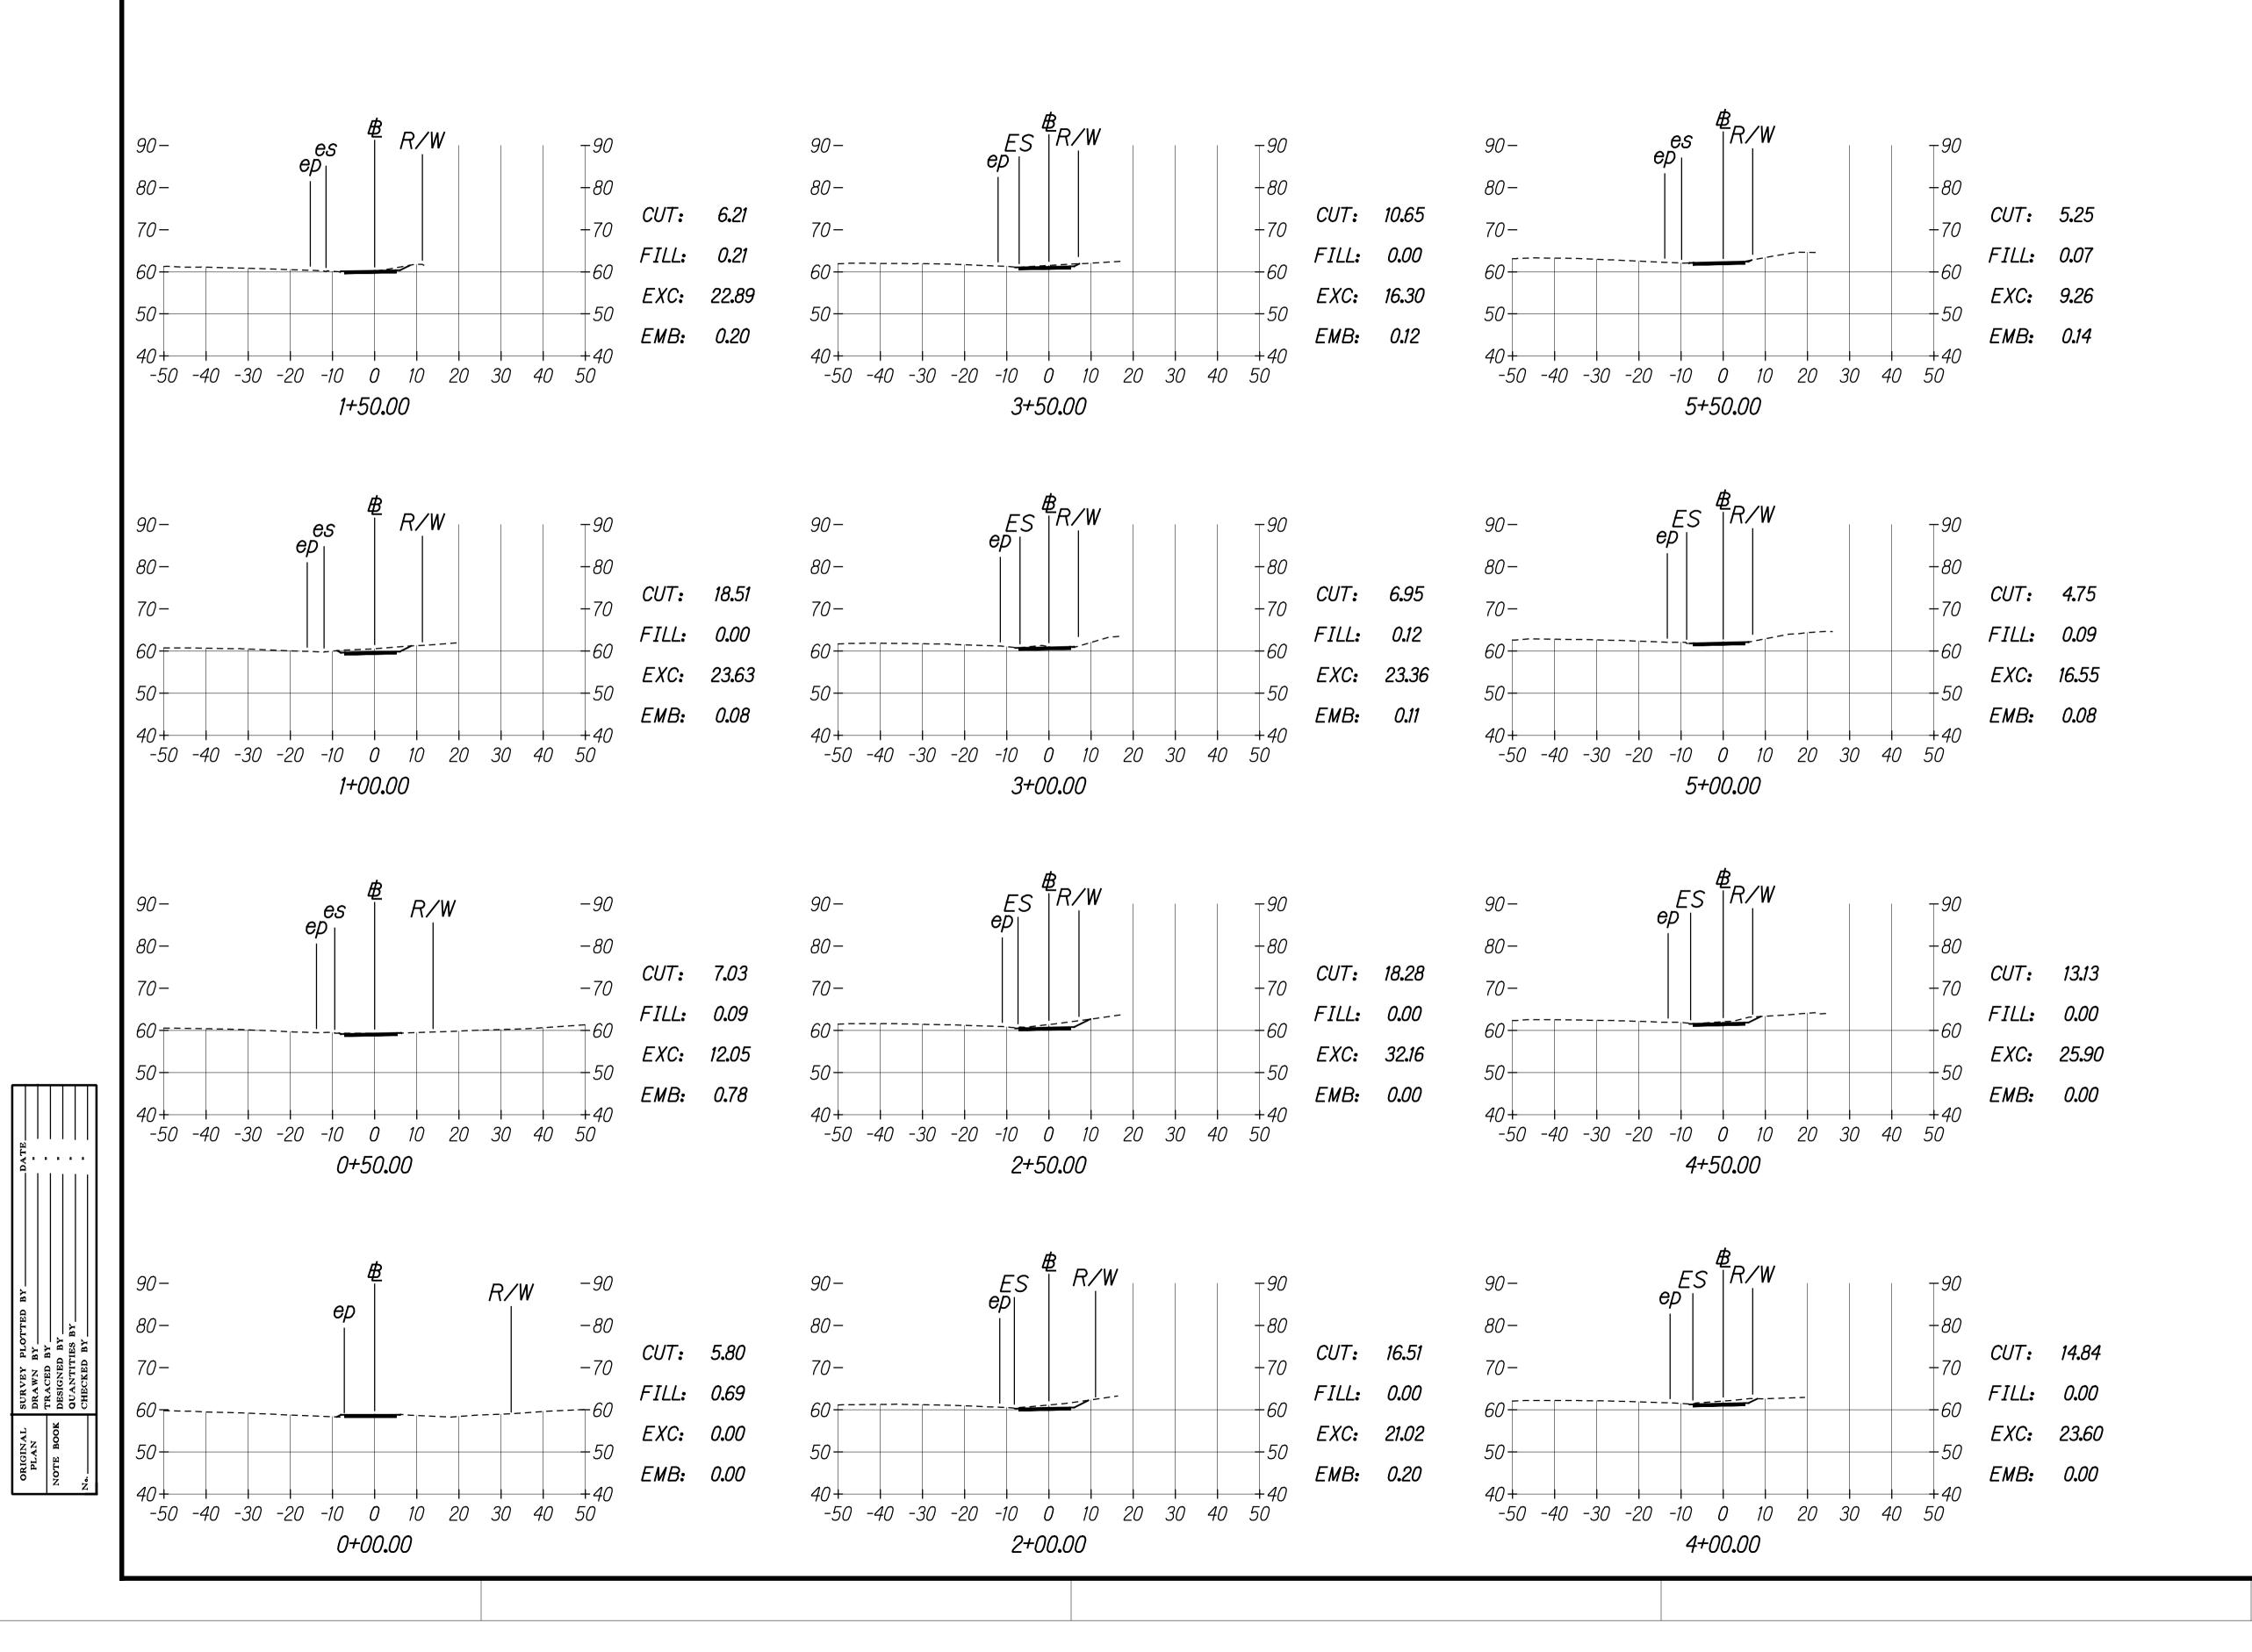





1 3/3/20 Revised All Cross Sections Revision STATE OF HAWAII **DEPARTMENT OF TRANSPORTATION**HIGHWAYS DIVISION CROSS SECTION

FORT BARRETTE ROAD OPERATIONAL IMPROVEMENTS Roosevelt Avenue to Farrington Highway Project No. 901A-01-19 Date: Jan. 2020 Scale: 1"=20'

SHEET No. XS-5 OF 12 SHEETS

FED. ROAD DIST. NO.	STATE	PROJ. NO.	FISCAL YEAR	SHEET NO.	TOTAL SHEETS
HAWAII	HAW.	901A-01-19	2020	ADD. 97	167

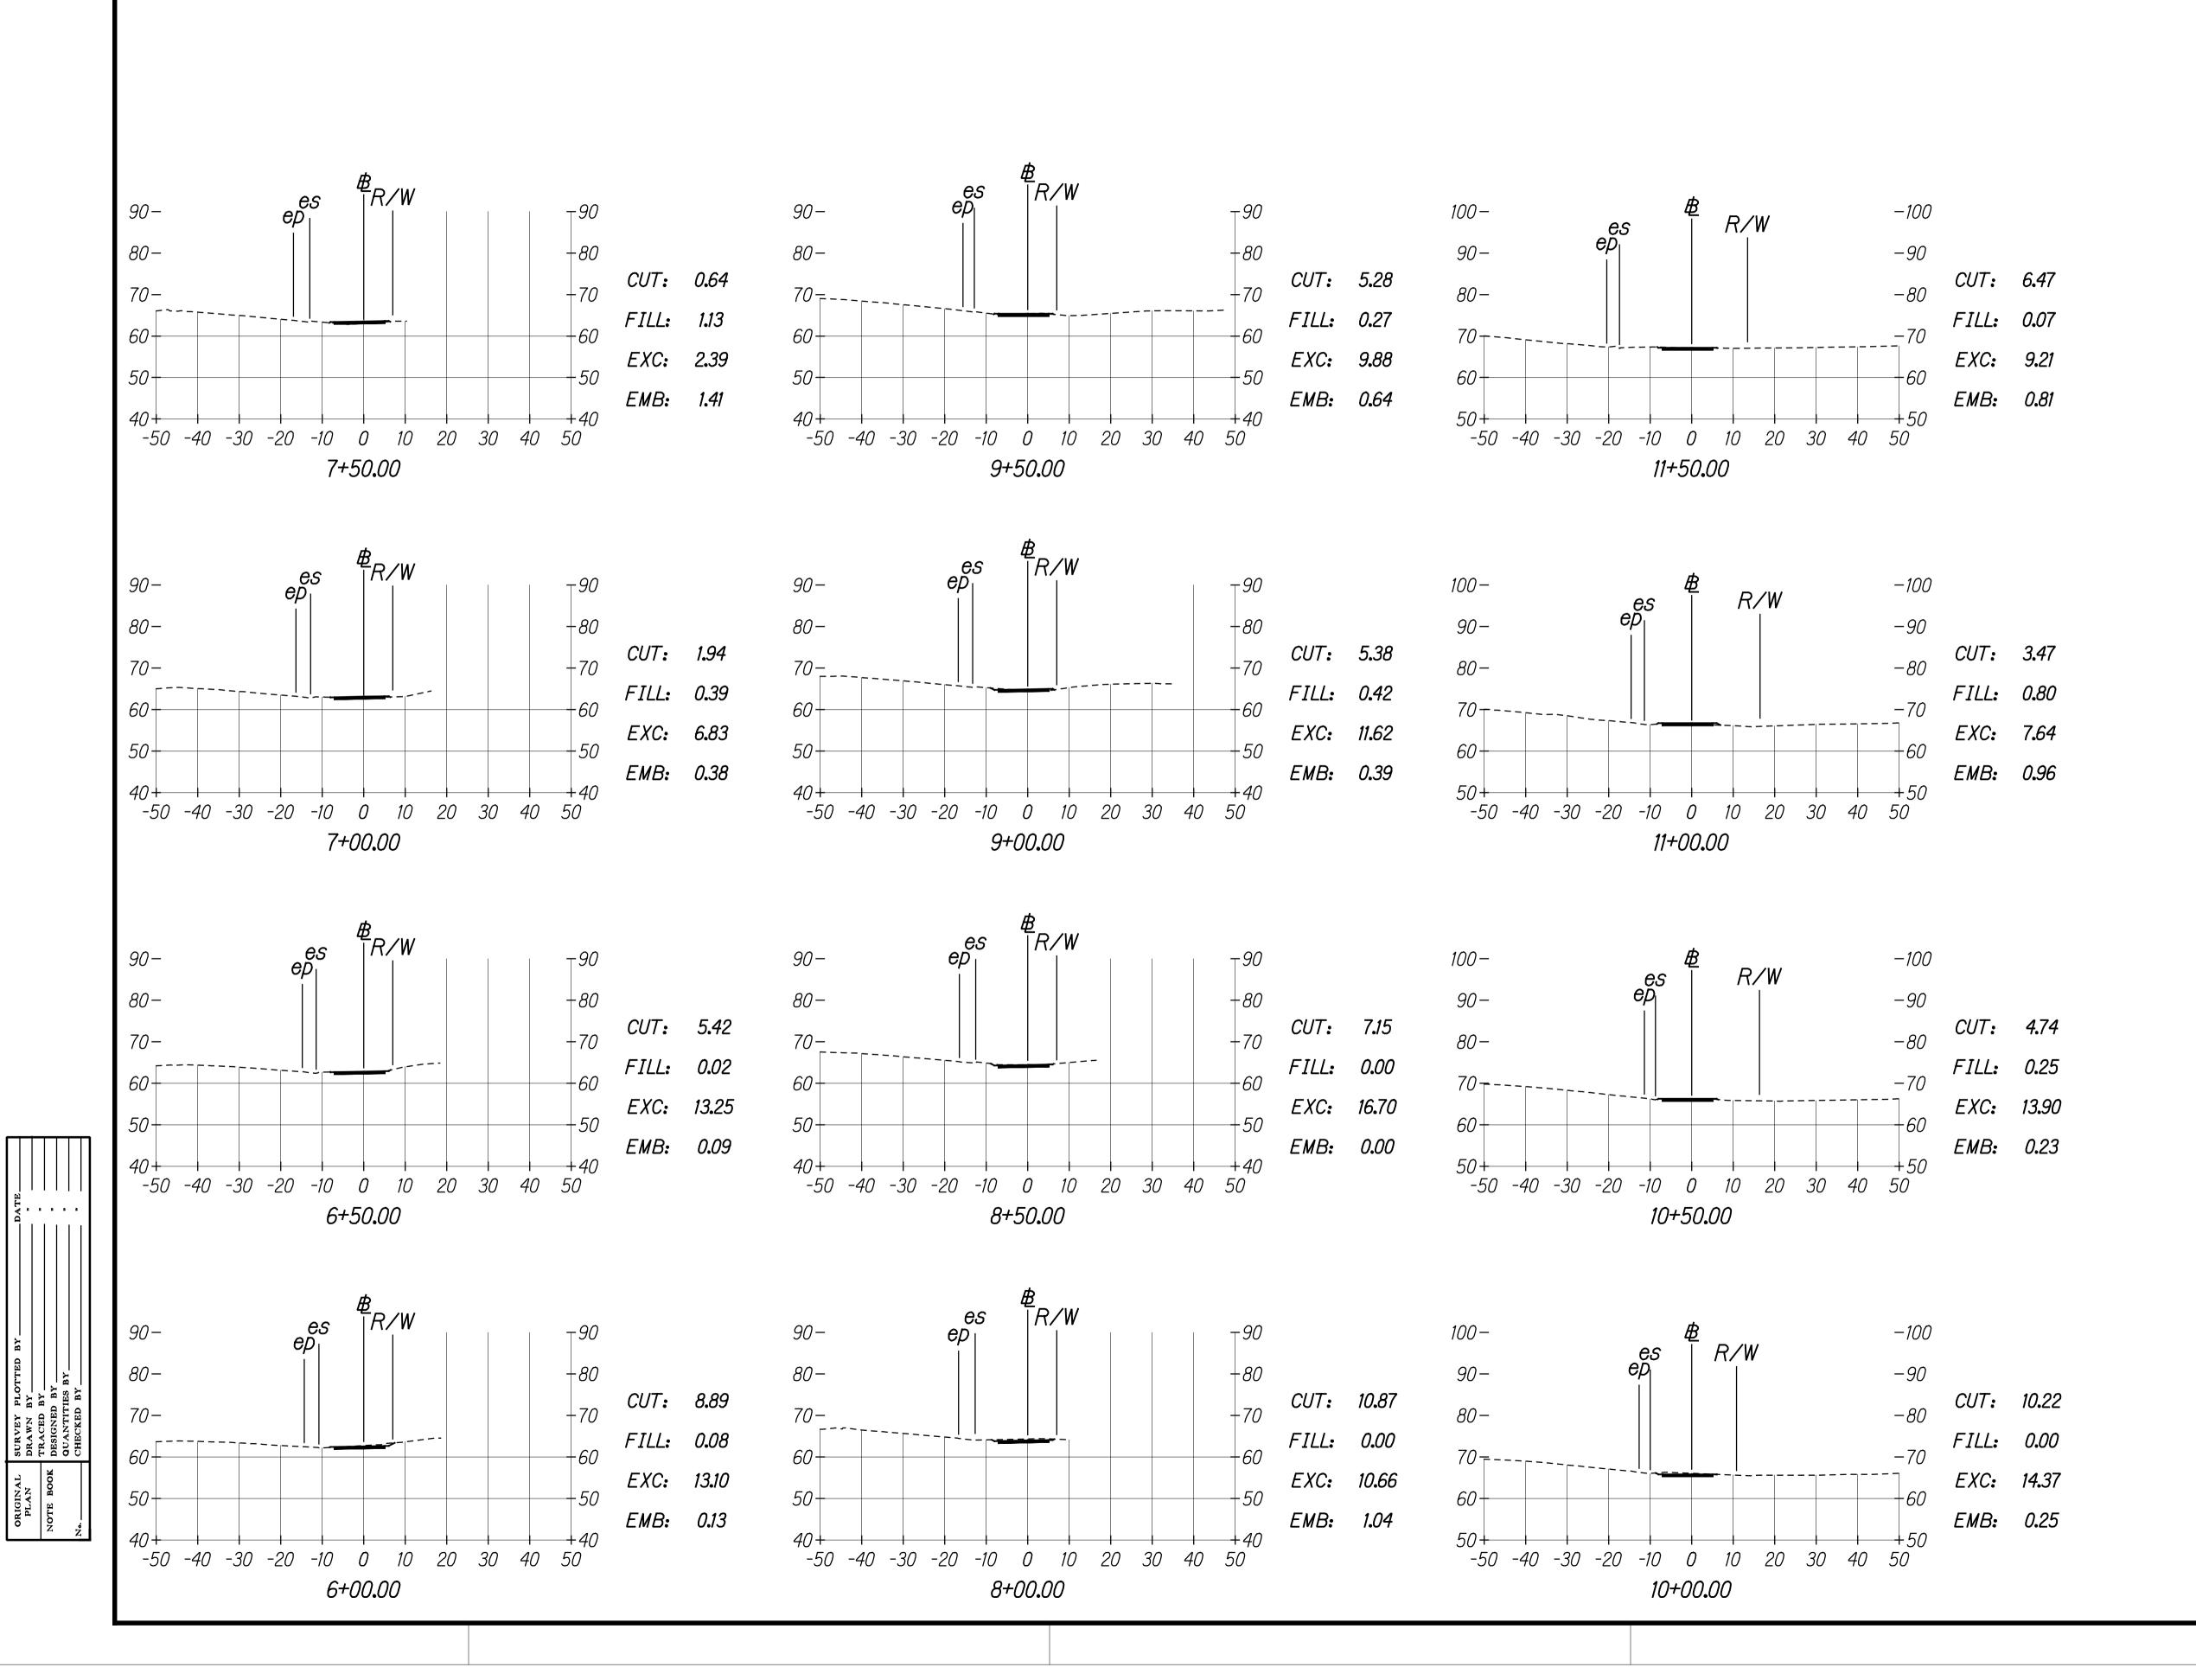

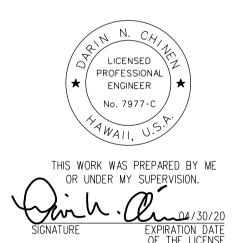

3/3/20 Revised All Cross Sections

Date Revision

STATE OF HAWAII

DEPARTMENT OF TRANSPORTATION
HIGHWAYS DIVISION

CROSS SECTION

SHARED USE PATH 2

FORT BARRETTE ROAD OPERATIONAL IMPROVEMENTS

FURI BARRETTE RUAD UPERATIONAL IMPROVEMENTS


Roosevelt Avenue to Farrington Highway

Project No. 901A-01-19

Scale: 1"=20' Date: Jan. 2020


SHEET No. XS-6 OF 12 SHEETS

FED. ROAD DIST. NO.	STATE	PROJ. NO.	FISCAL YEAR	SHEET NO.	TOTAL SHEETS
HAWAII	HAW.	901A-01-19	2020	ADD. 98	167

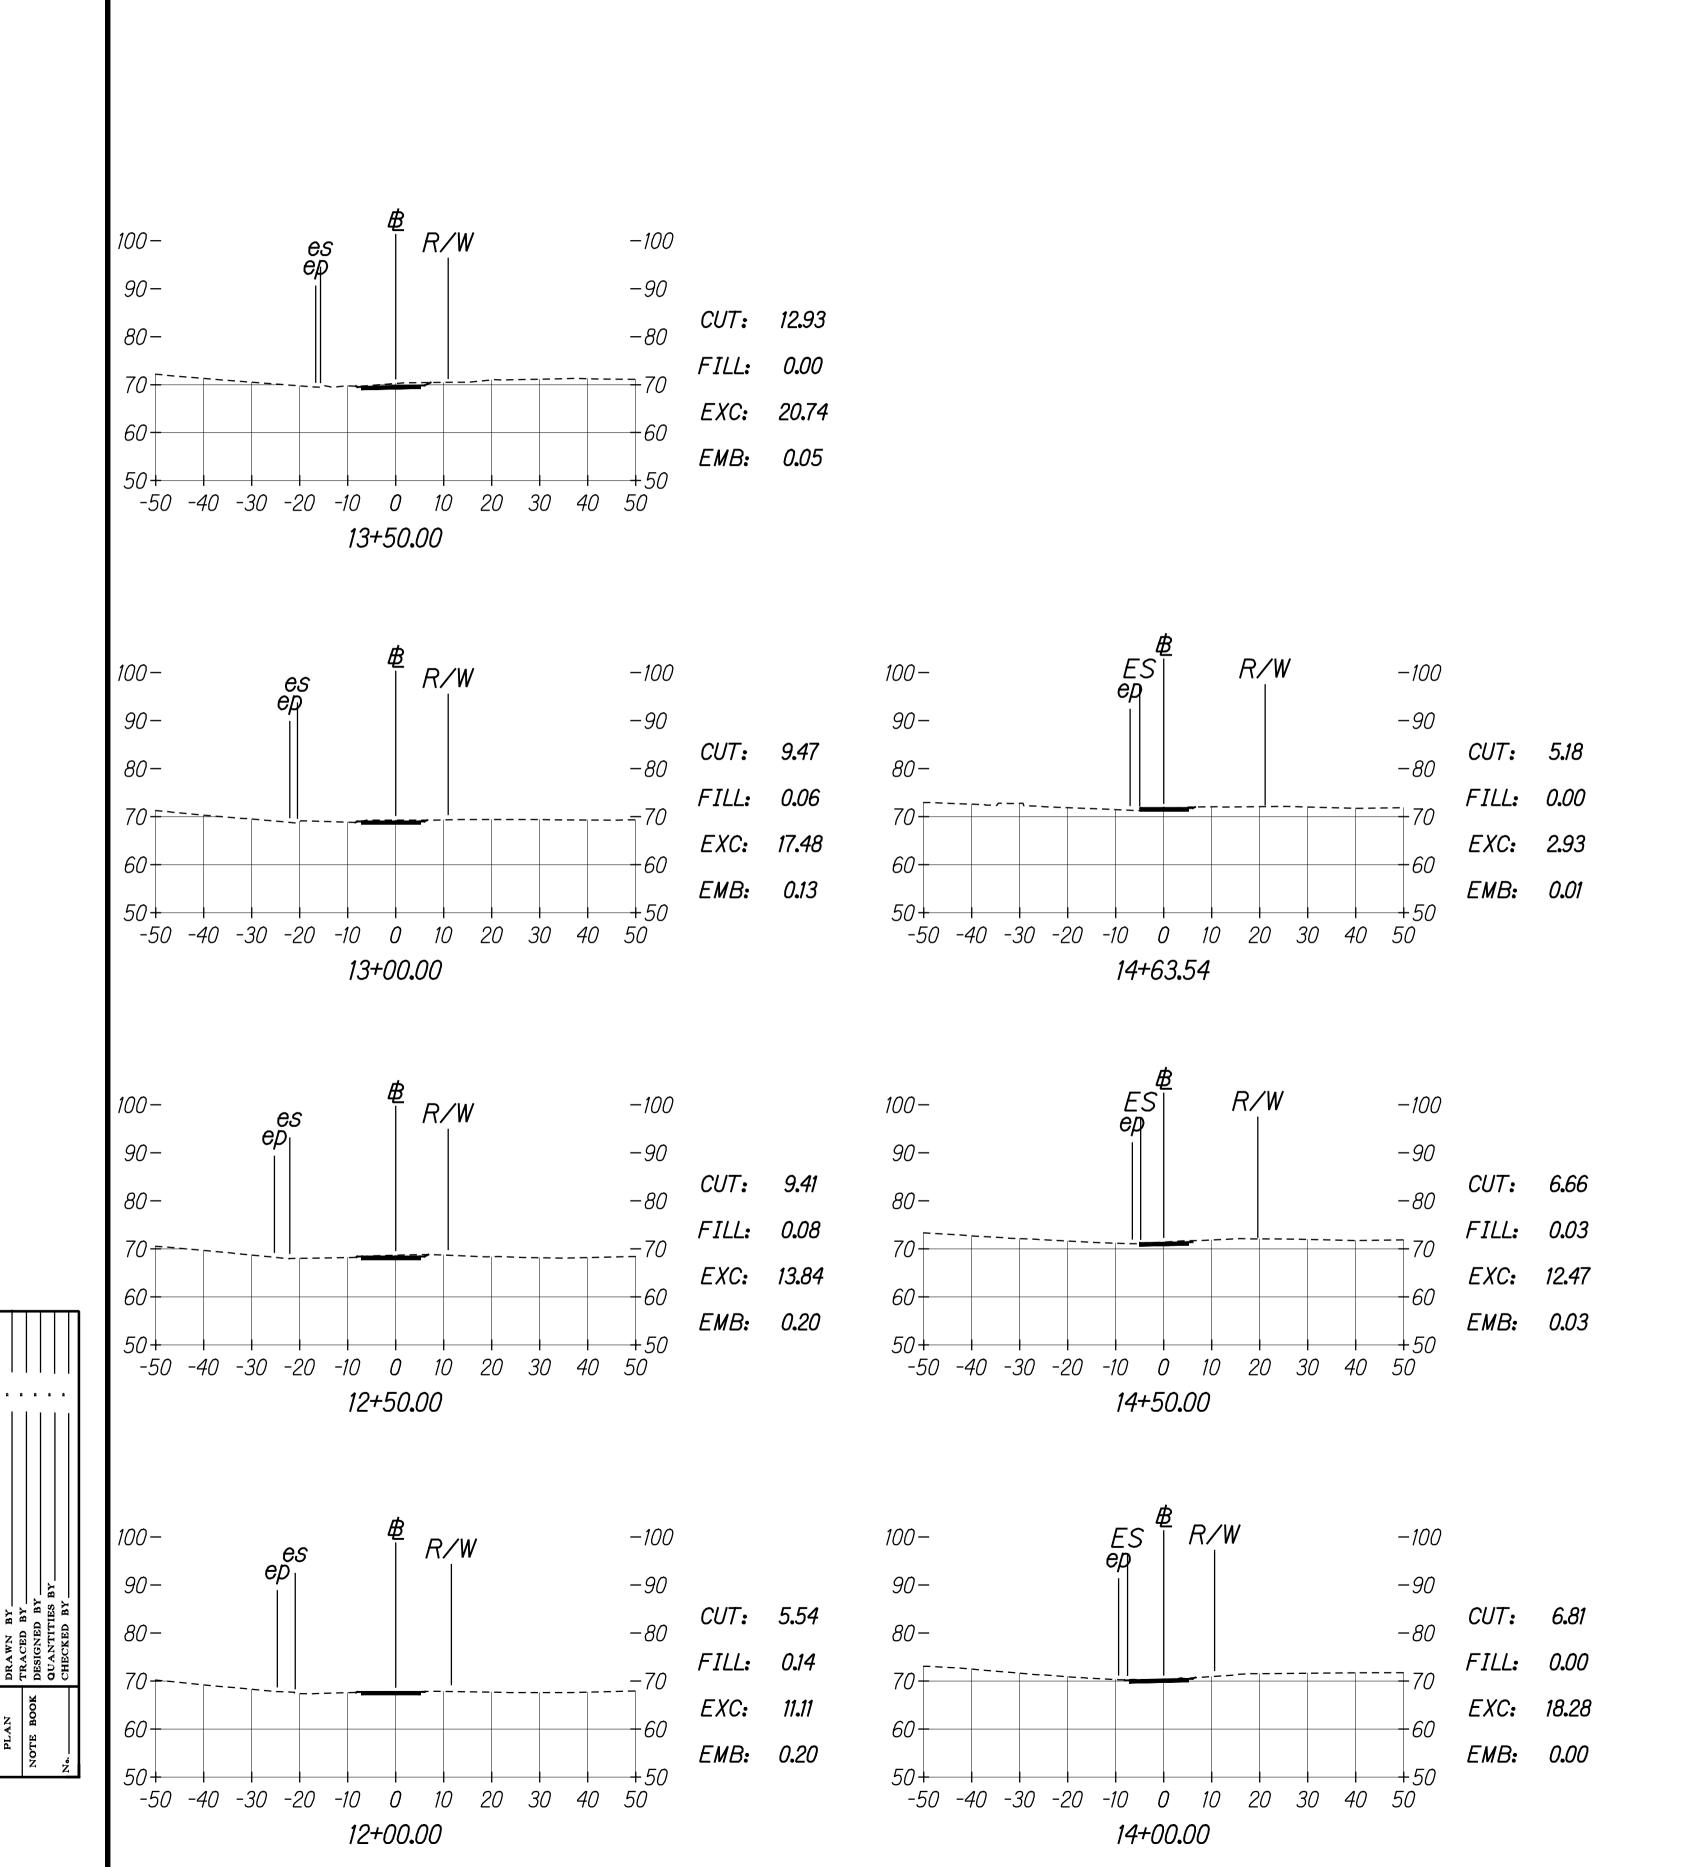

SUMMARY

SHARED USE	EXC	EMB	<u> </u>
PATH 2	CU YD	CU YD	
TOTAL	453	9	

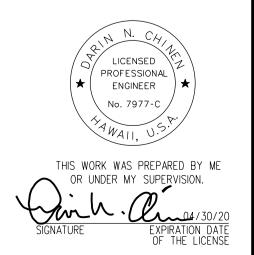

3/3/20	Revised All Cross Sections
	and Summary Schedule

Pate Revision

STATE OF HAWAII

DEPARTMENT OF TRANSPORTATIONHIGHWAYS DIVISION

<u>CROSS SECTION</u> SHARED USE PATH 2

FORT BARRETTE ROAD OPERATIONAL IMPROVEMENTS


Roosevelt Avenue to Farrington Highway

Project No. 901A-01-19

Scale: 1"=20' Date: Jan. 2020

SHEET No. XS-7 OF 12 SHEETS

FED. ROAD DIST. NO.	STATE	PROJ. NO.	FISCAL YEAR	SHEET NO.	TOTAL SHEETS
HAWAII	HAW.	901A-01-19	2020	ADD. 99	167

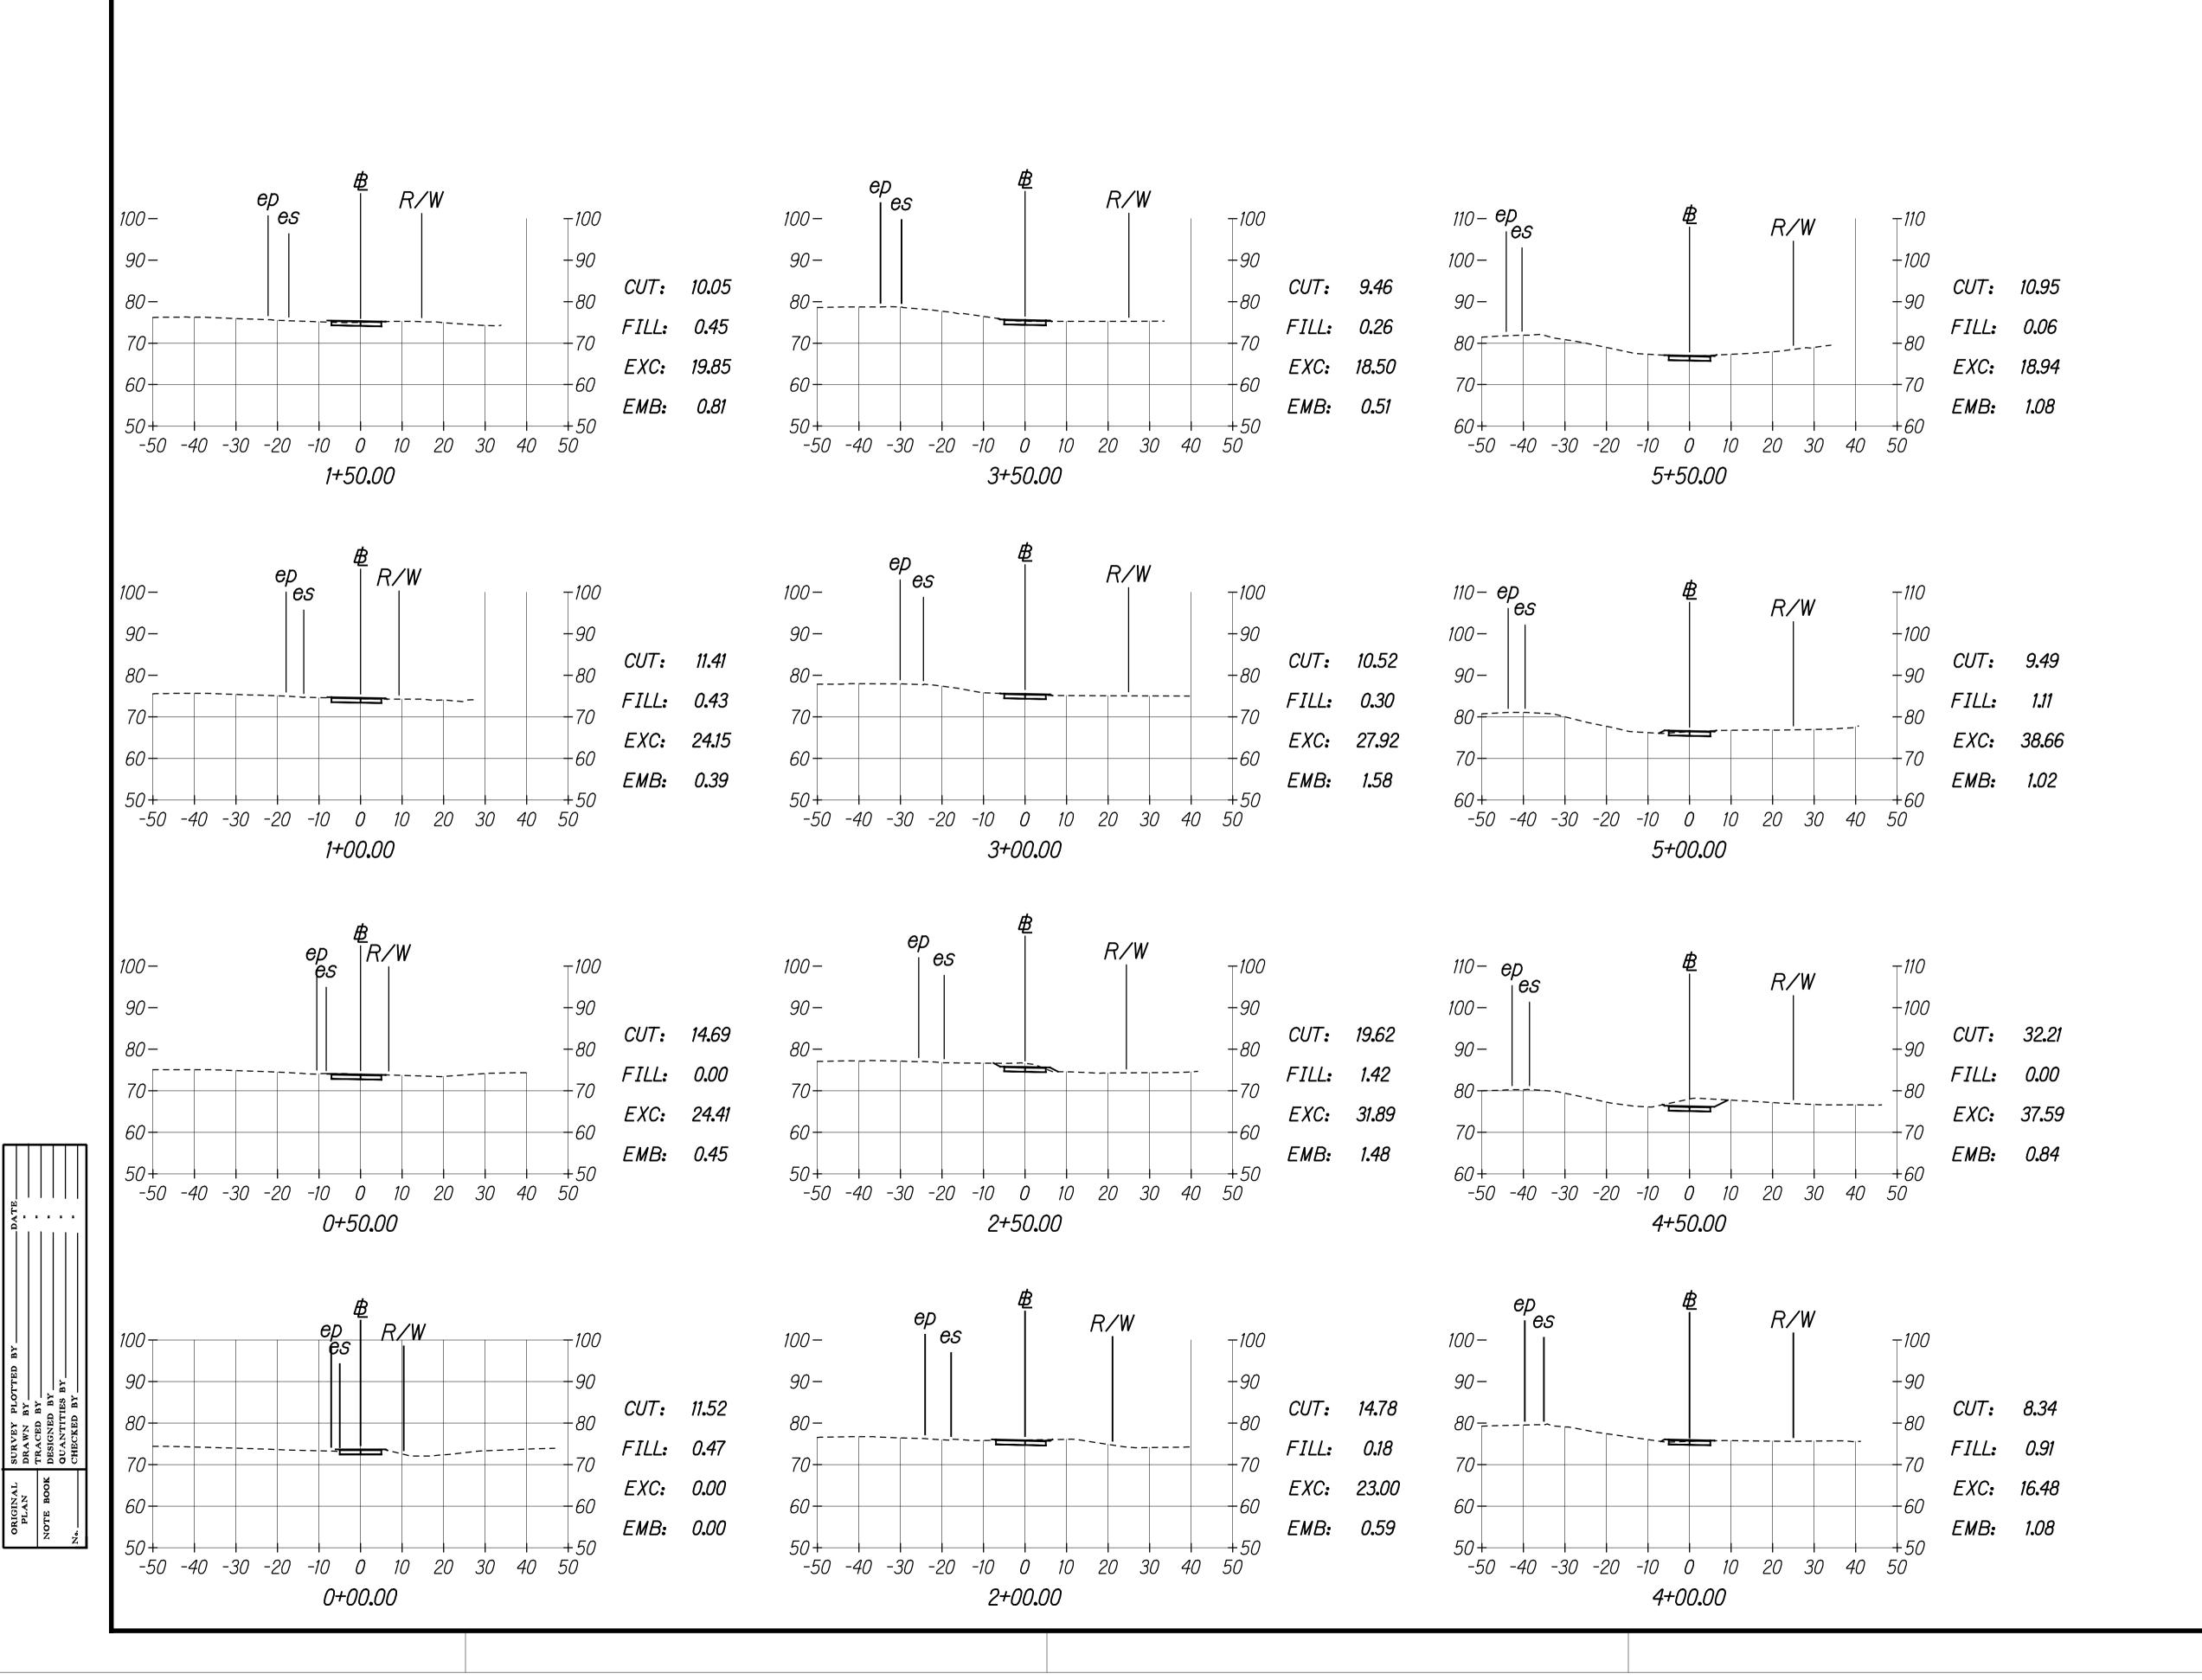



A 3/3/20 Revised All Cross Sections

Date Revision

STATE OF HAWAII

DEPARTMENT OF TRANSPORTATION
HIGHWAYS DIVISION

CROSS SECTION

SHARED USE PATH 3

FORT BARRETTE ROAD OPERATIONAL IMPROVEMENTS


Roosevelt Avenue to Farrington Highway

Project No. 901A-01-19

Scale: 1"=20' Date: Jan. 2020

SHEET No. XS-8 OF 12 SHEETS

FED. ROAD DIST. NO.	STATE	PROJ. NO.	FISCAL YEAR	SHEET NO.	TOTAL SHEETS
HAWAII	HAW.	901A-01-19	2020	ADD. 100	167

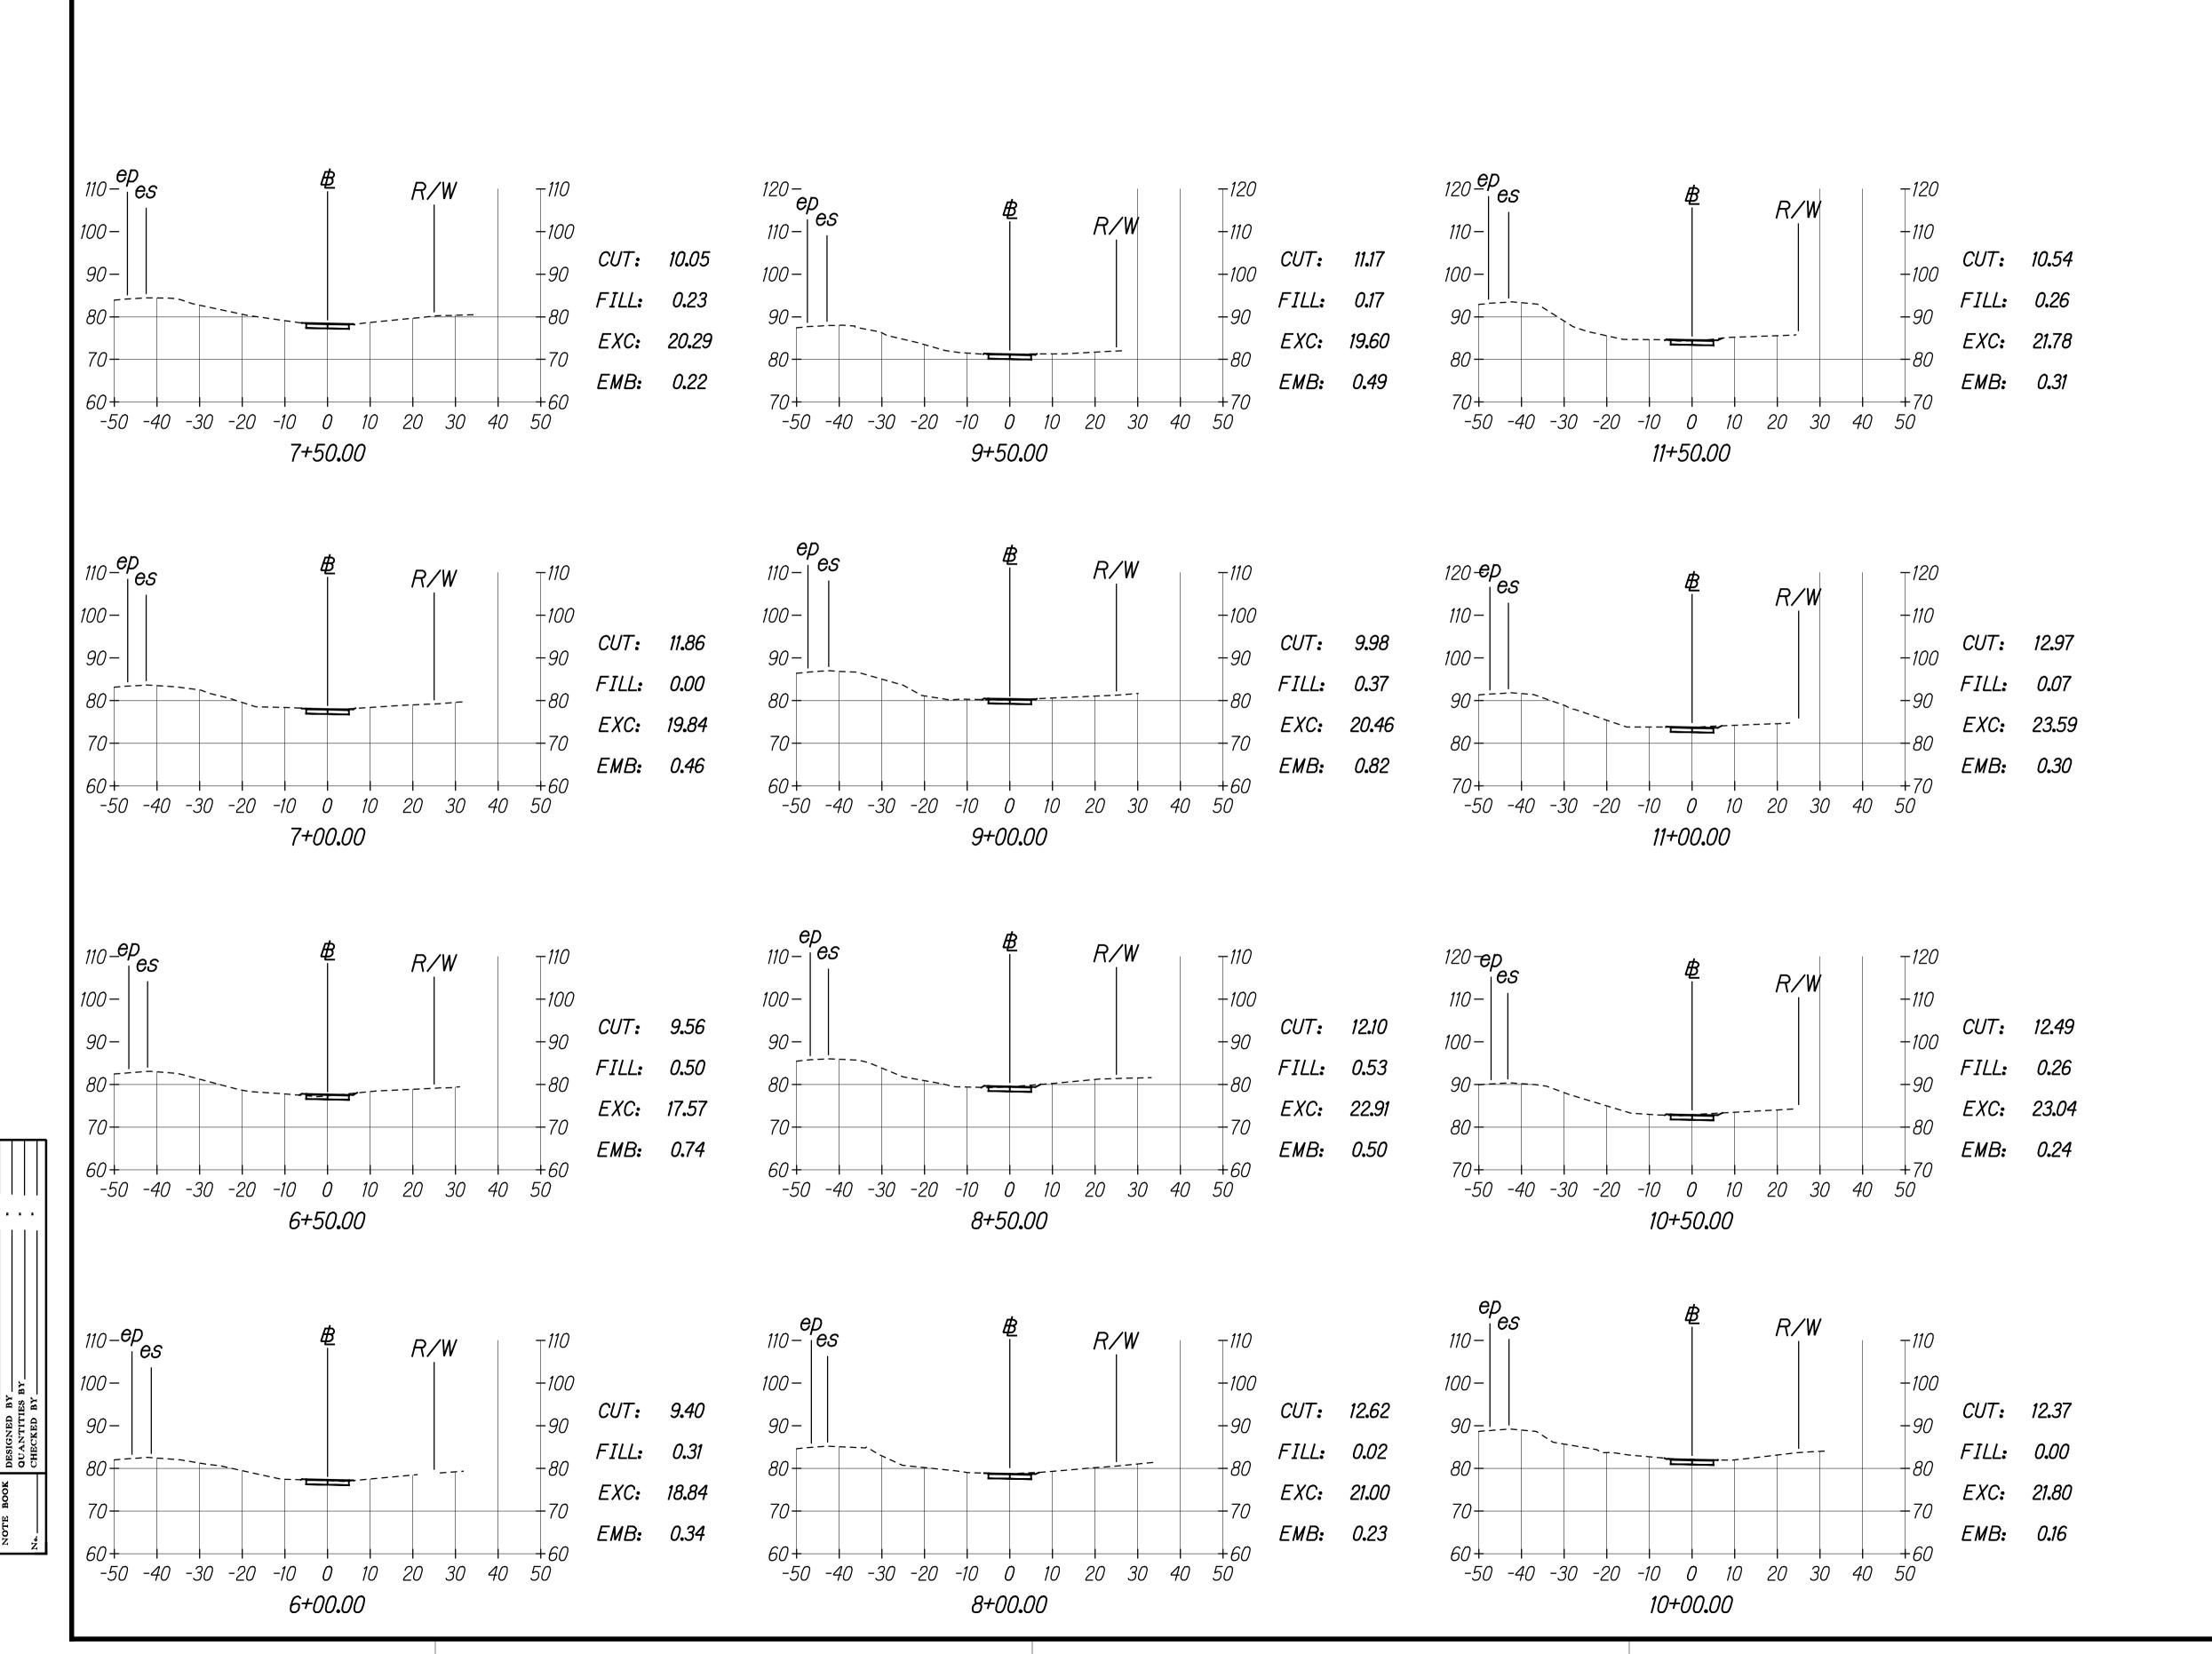




1 3/3/20 Revised All Cross Sections Revision STATE OF HAWAII **DEPARTMENT OF TRANSPORTATION**HIGHWAYS DIVISION CROSS SECTION

FORT BARRETTE ROAD OPERATIONAL IMPROVEMENTS Roosevelt Avenue to Farrington Highway Project No. 901A-01-19 Date: Jan. 2020

Scale: 1"=20'

SHEET No. XS-9 OF 12 SHEETS

FED. ROAD DIST. NO.	STATE	PROJ. NO.	FISCAL YEAR	SHEET NO.	TOTAL SHEETS
HAWAII	HAW.	901A-01-19	2020	ADD. 101	<i>16</i> 7

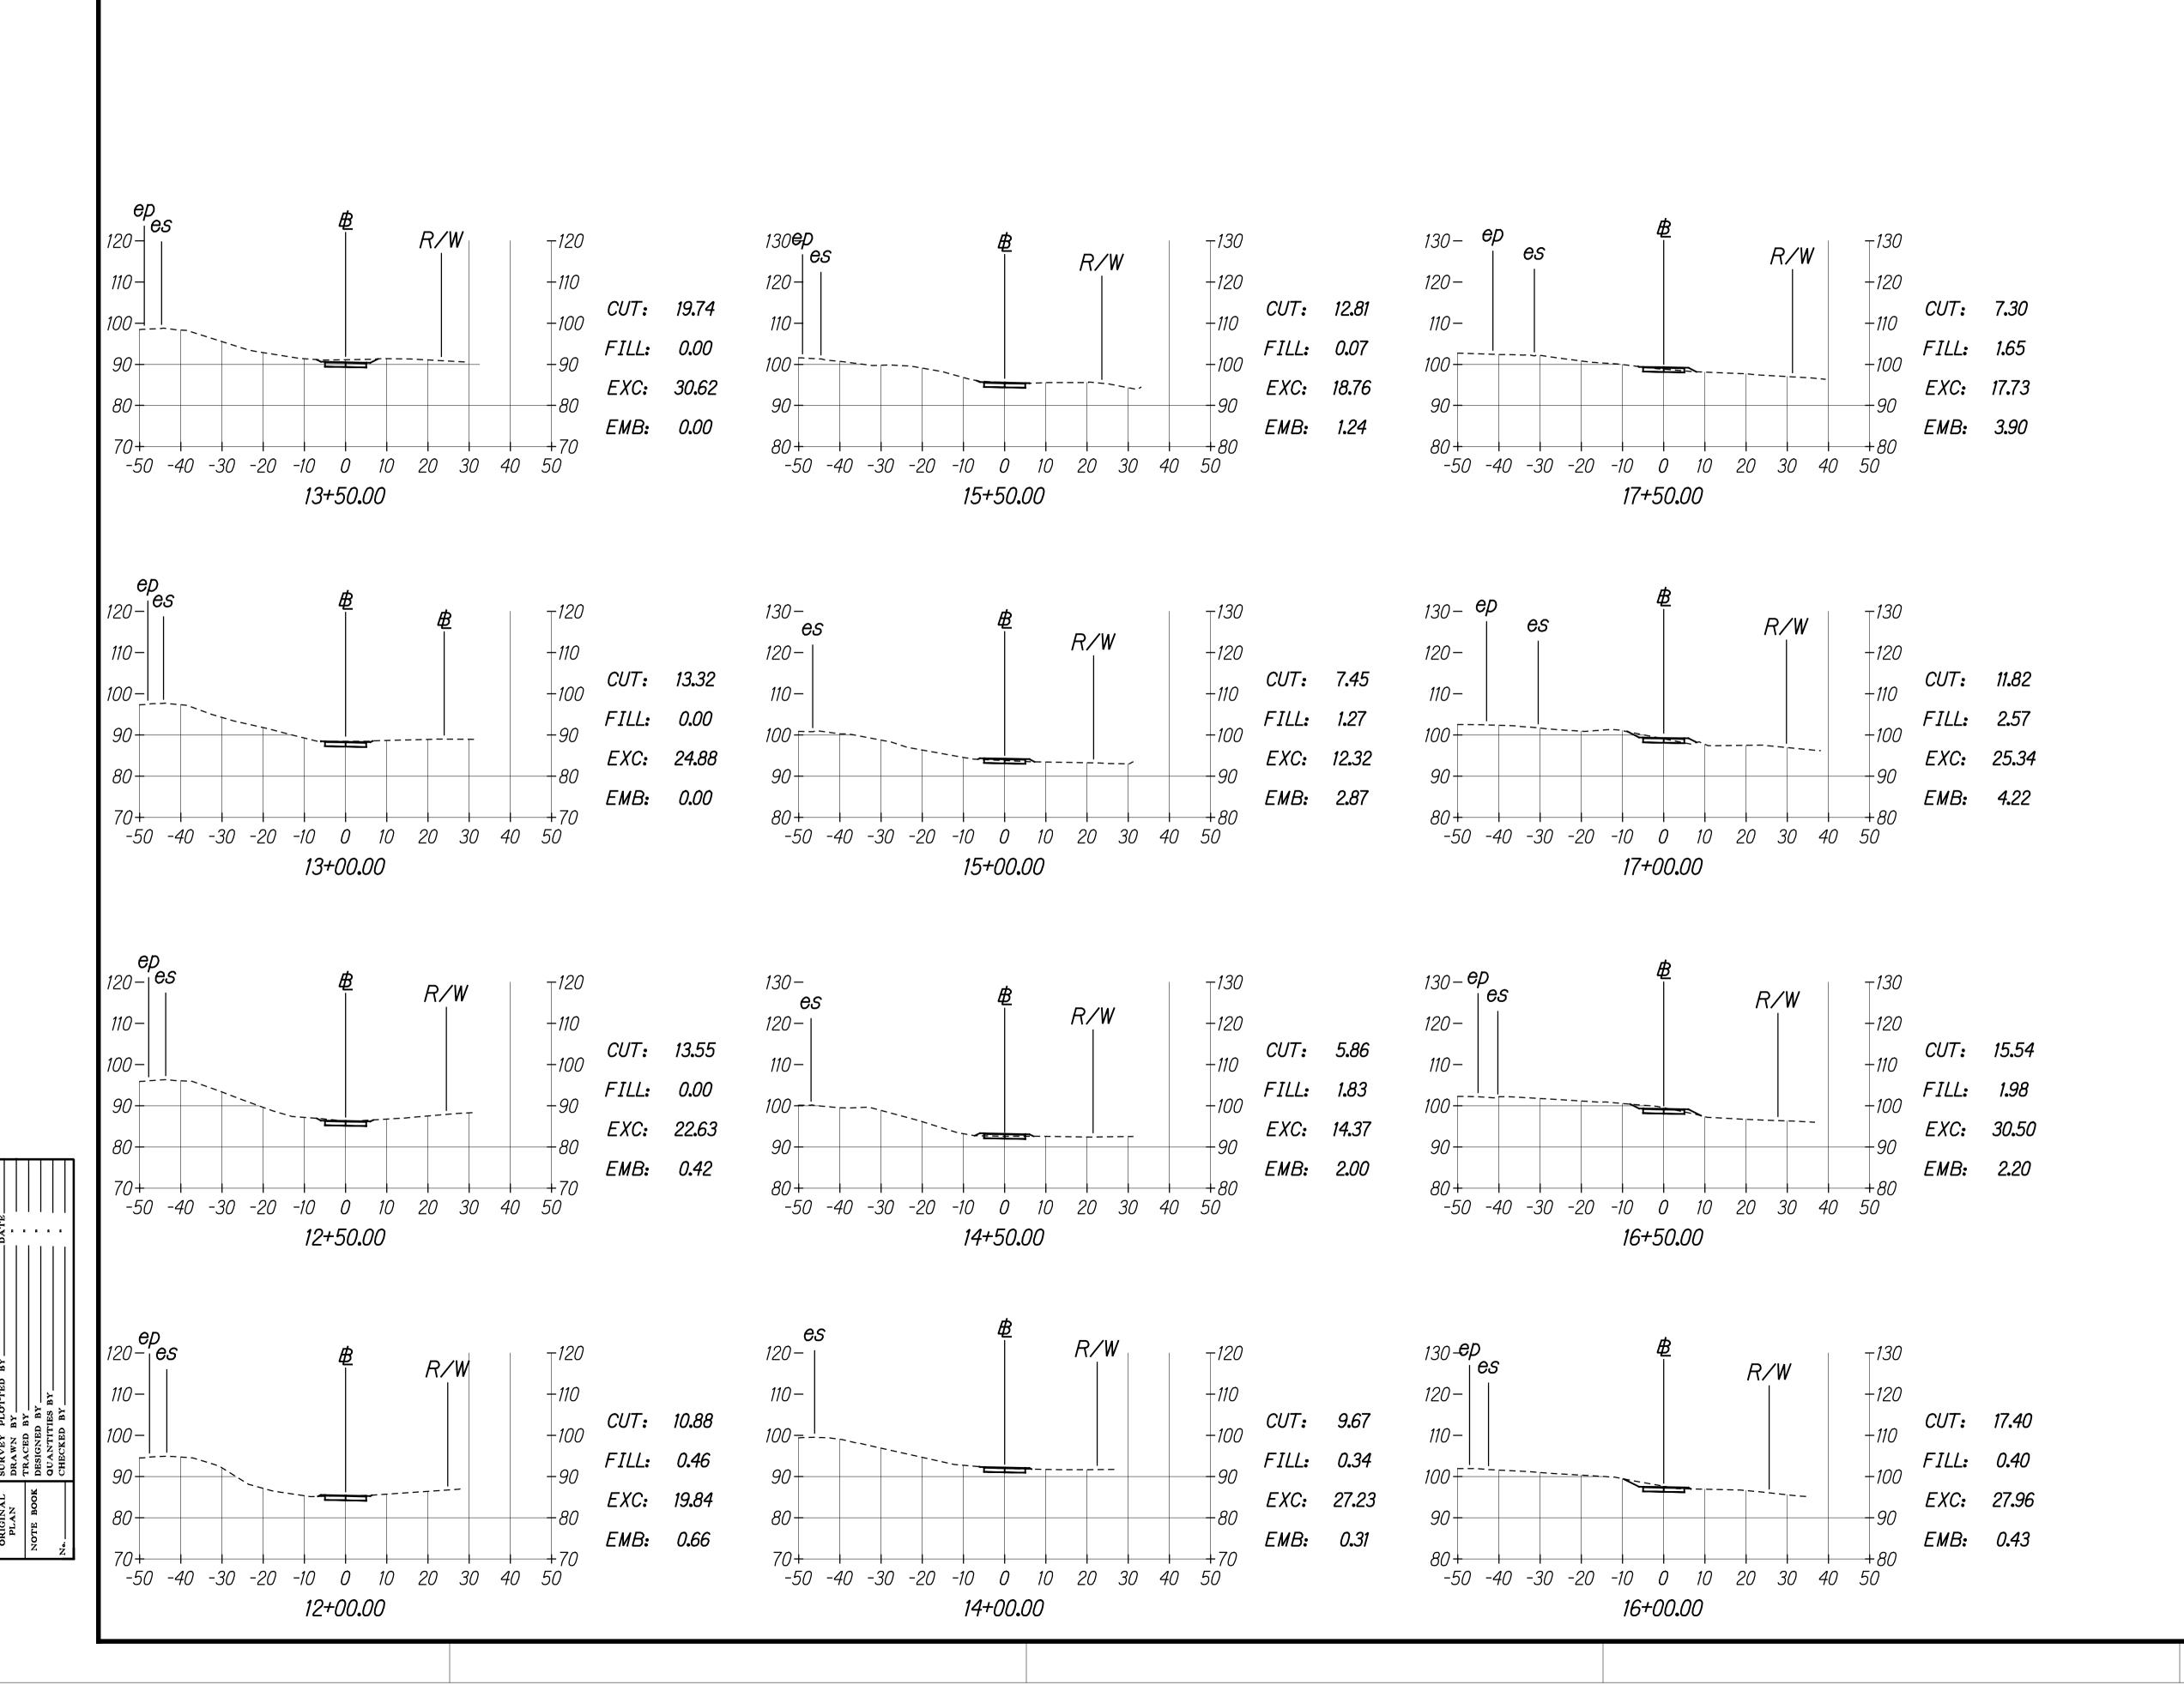



3/3/20 Revised All Cross Sections

Date Revision

STATE OF HAWAII

DEPARTMENT OF TRANSPORTATION
HIGHWAYS DIVISION

CROSS SECTION

SHARED USE PATH 3

FORT BARRETTE ROAD OPERATIONAL IMPROVEMENTS
Roosevelt Avenue to Farrington Highway


Project No. 901A-01-19


"=20' Date: Jan. 2020

 Scale: 1"=20'
 Date: Jan. 202

 SHEET No. XS-10 OF
 12 SHEETS

FED. ROAD DIST. NO.	STATE	PROJ. NO.	FISCAL YEAR	SHEET NO.	TOTAL SHEETS
HAWAII	HAW.	901A-01-19	2020	ADD. 102	167

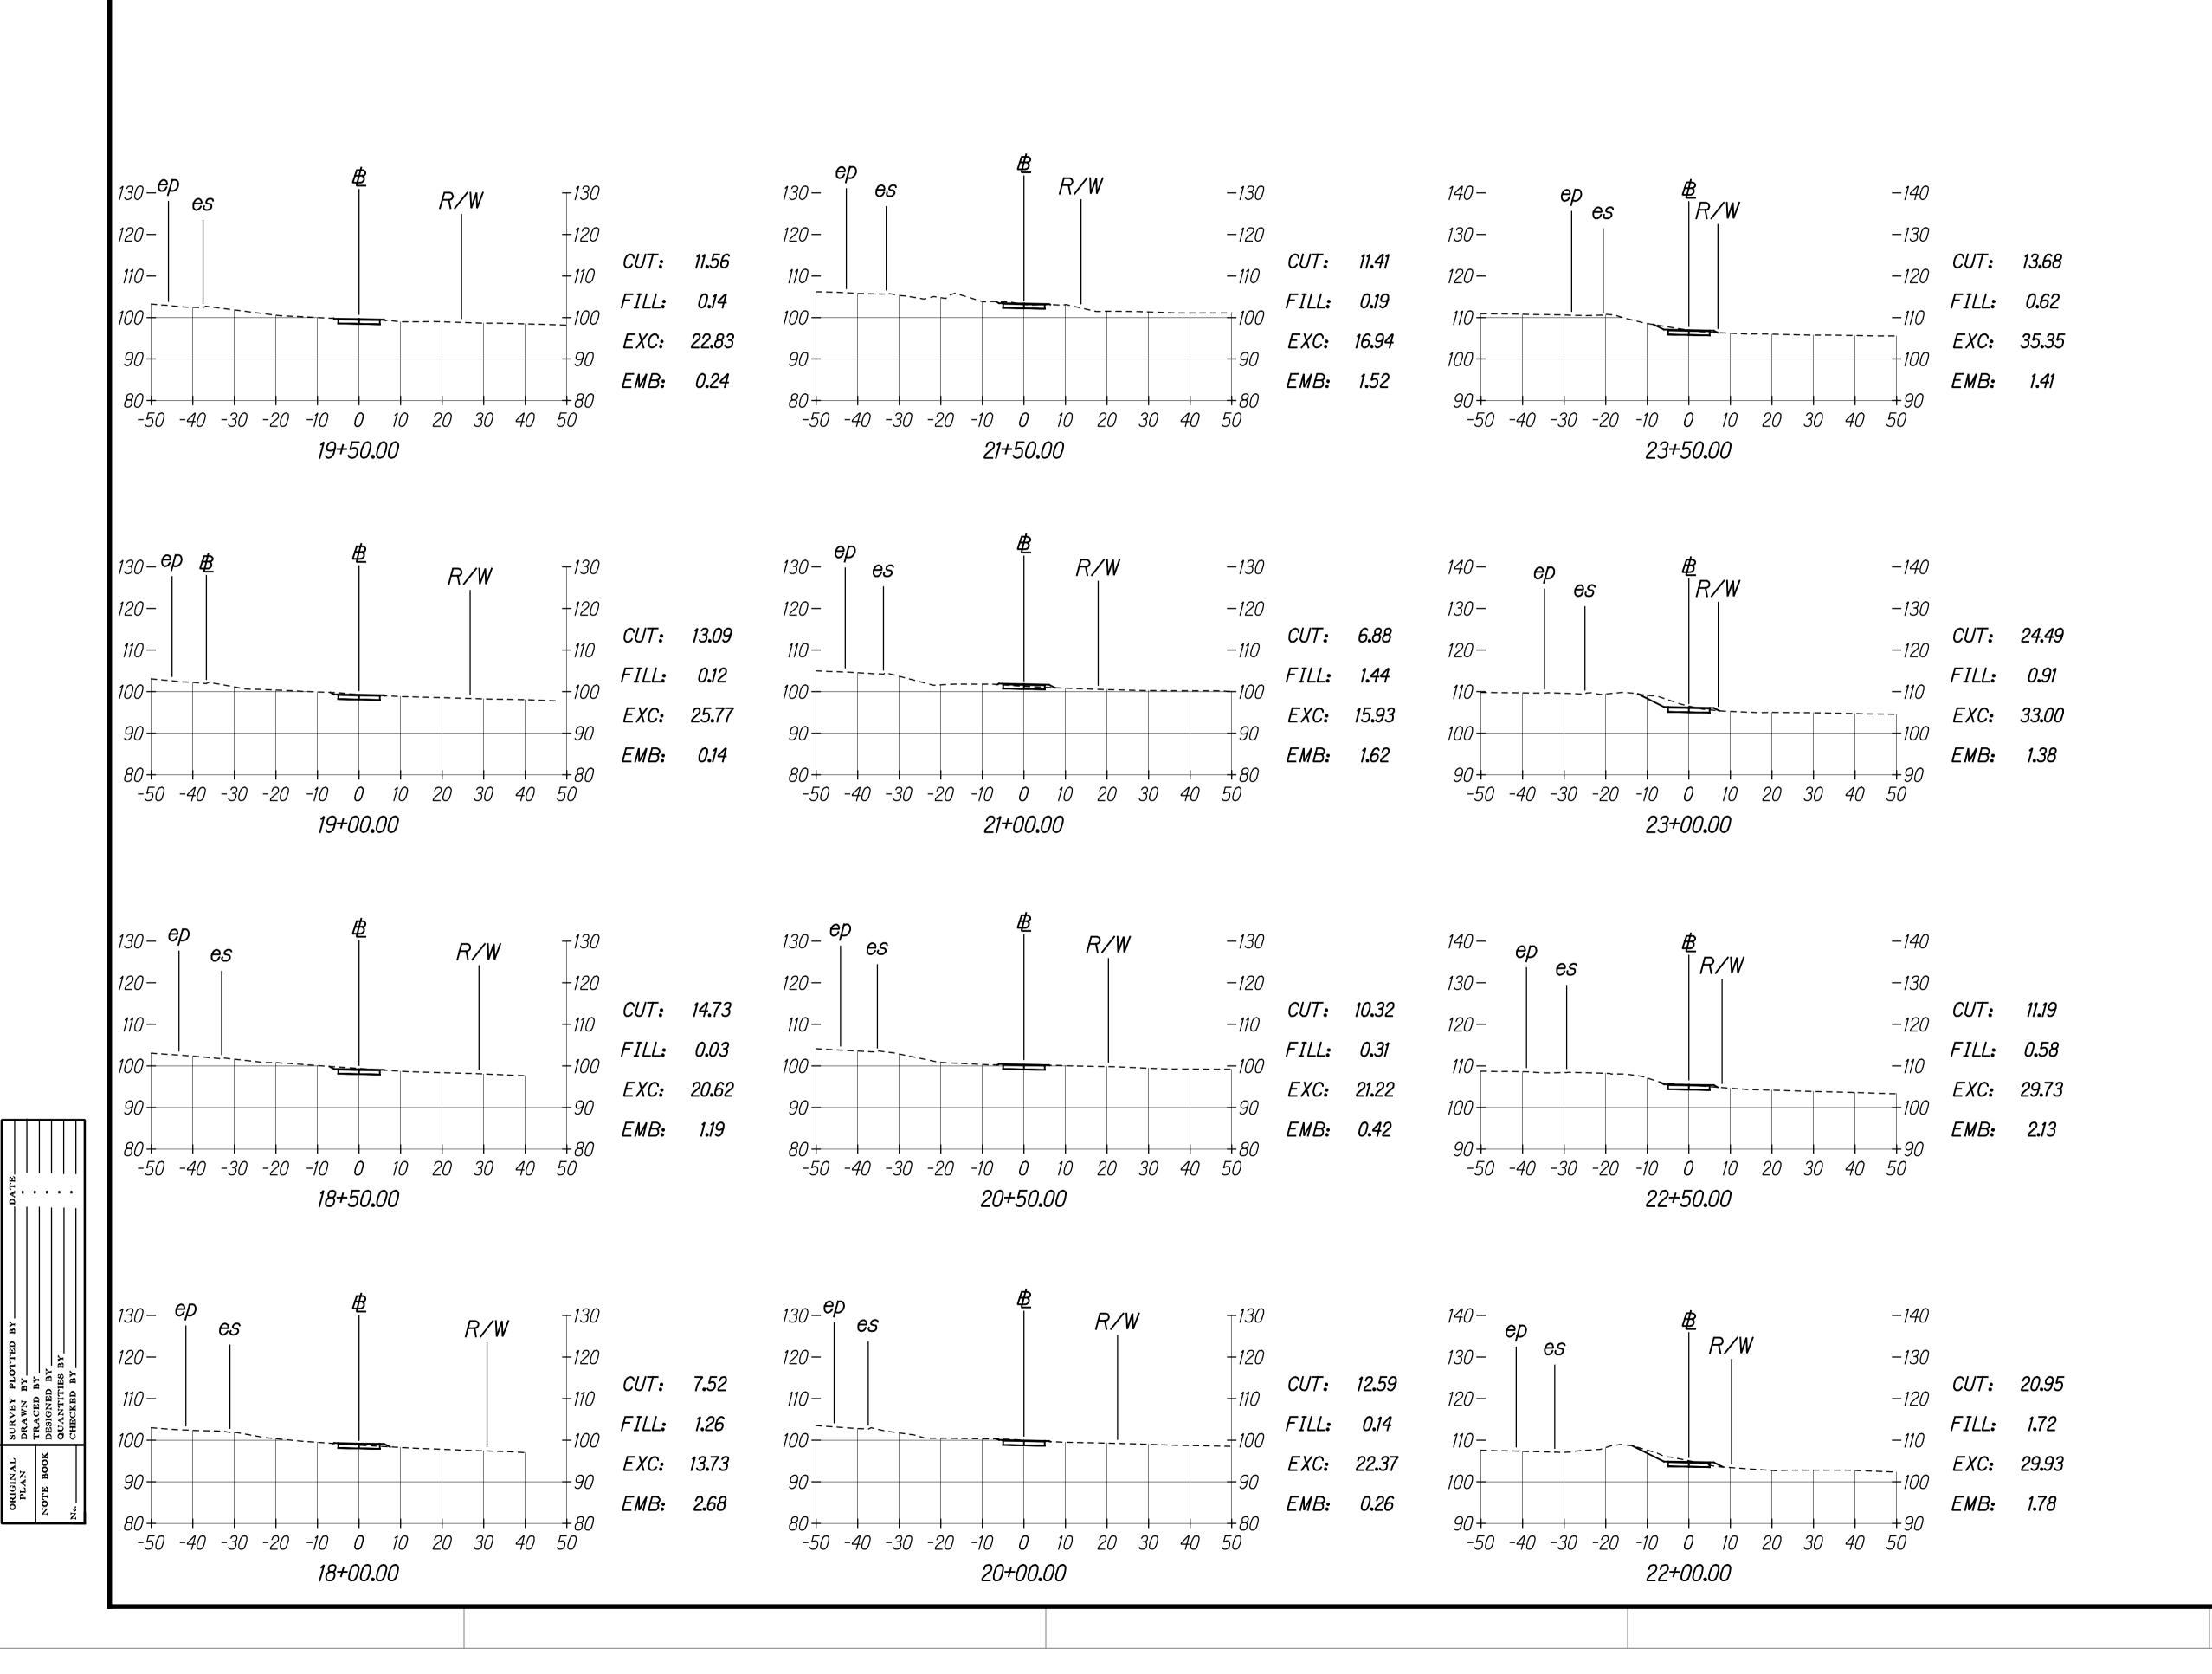

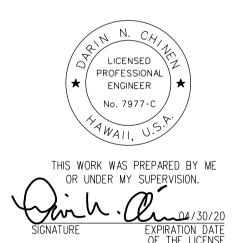

3/3/20 Revised All Cross Sections

Date Revision

STATE OF HAWAII

DEPARTMENT OF TRANSPORTATION
HIGHWAYS DIVISION

CROSS SECTION

SHARED USE PATH 3

FORT BARRETTE ROAD OPERATIONAL IMPROVEMENTS

FORT BARRETTE ROAD OPERATIONAL IMPROVEMENTS


Roosevelt Avenue to Farrington Highway


Project No. 901A-01-19


Scale: 1"=20' Date: Jan. 2020


SHEET No. XS-11 OF 12 SHEETS

FED. ROAD DIST. NO.	STATE	PROJ. NO.	FISCAL YEAR	SHEET NO.	TOTAL SHEETS
HAWAII	HAW.	901A-01-19	2020	ADD. 103	<i>16</i> 7

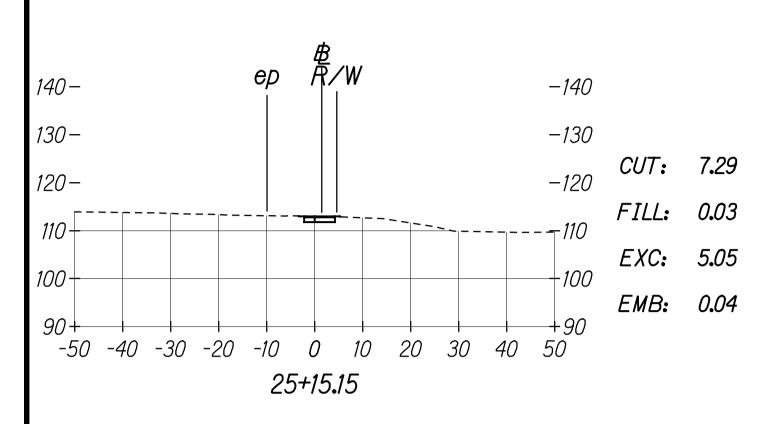

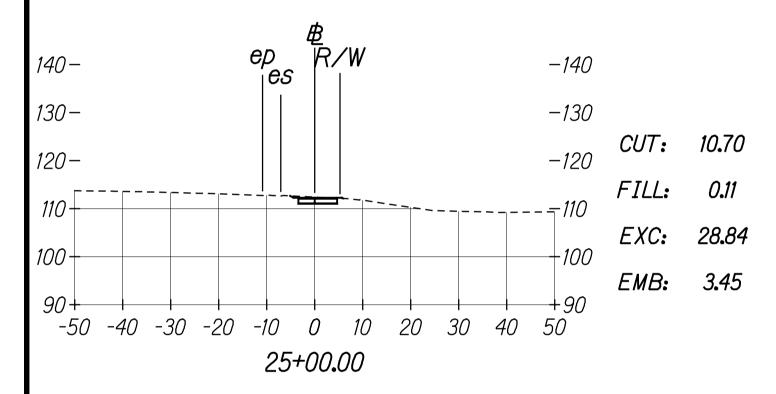


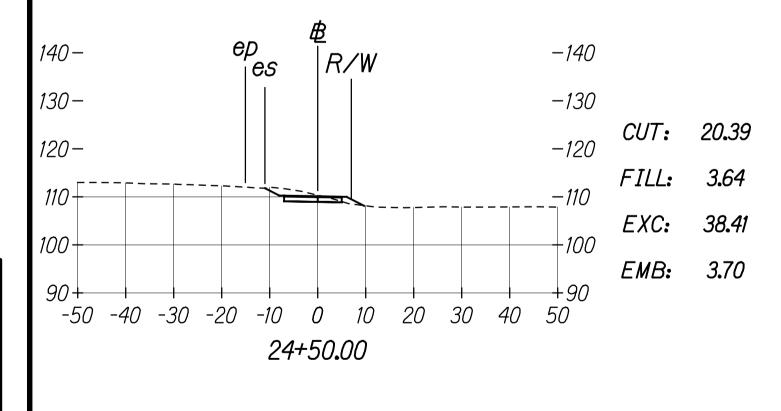

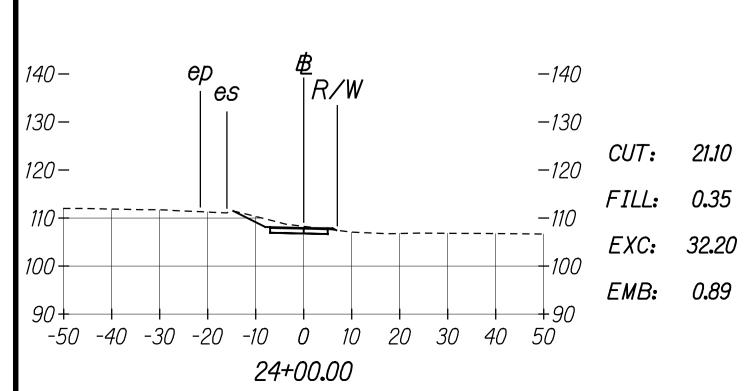

SUMMARY

SHARED USE PATH 3	EXC CU YD	EMB CU YD	/1
TOTAL	1196	56	

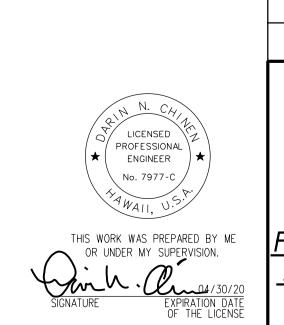

1/3/20 Revised All Cross Sections and Summary Schedule

Revision

STATE OF HAWAII

DEPARTMENT OF TRANSPORTATION
HIGHWAYS DIVISION CROSS SECTION

SHARED USE PATH 3

FORT BARRETTE ROAD OPERATIONAL IMPROVEMENTS Roosevelt Avenue to Farrington Highway Project No. 901A-01-19 Scale: 1"=20' Date: Jan. 2020

SHEET No. XS-12 OF 12 SHEETS

GENERAL TRAFFIC SIGNAL NOTES:

- 1. All Traffic Signal work shall conform to the requirements of the Manual on Uniform Traffic Control Devices for Streets and Highways, U.S. Department of Transportation, Federal Highways Administration, 2009 Edition, and Amendments.
- 2. Contractor to verify location and condition of existing traffic signal standards, traffic signal standards with mast arm, traffic controller, transformer, pullboxes, conduits, cabling, \$ loop detectors out in the field and to inform the Engineer of condition of items mentioned prior to construction and installation. Contractor to inform Engineer of any discrepancy between existing conditions and locations found out in the field compared to the existing conditions as shown on plans.
- 3. The locations of the traffic signal standards, traffic signal standards with mast arm, traffic controller, transformer, pullboxes, conduits, \$ loop detectors shall be staked out in the field by the Contractor and locations accepted by the Engineer prior to construction and installation. Locations shown on plans shall be adjusted as necessary to prevent conflict with existing or new facilities.
- 4. All direct-buried conduits shall be PVC Schedule 80.
- 5. Loop detectors shall be installed according to Loop Detector Details shown on the Plans.
- 6. Lead-in wires in pullbox near loops shall be tagged with Loop Number(s).
- 7. See sheet TS-6 for Restoration of Non-Roadway Areas and Restoration of Existing Pavement Details due to Trench Excavation.
- 8. Steel plates for covering trenches shall have skid resistant surface.
- 9. All structures, pavements, utilities, landscaping, and other topographical features shown on the Plans are existing and shall remain unless noted or indicated otherwise. All grassed areas damaged by construction activities shall be top soiled and grassed.
- 10. A solid #8 bare copper wire shall be pulled in all conduits with the traffic control cable for equipment ground.
- 11. All splicing shall be done in the pullboxes.
- 12. All traffic signal controller equipment shall be completely wired in the cabinet and shall control the traffic signal as called for in the Plans.
- 13. The loop amplifier units furnished for this project shall be capable of operating the loop detector configurations shown on the Plans.
- 14. The Contractor shall verify with the respective utility companies and government agencies, the locations of all electric, telephone, traffic signal, street light, cable television, fire alarm, gas, water, sewer, drain and other lines crossing the excavation path or in excavation areas.
- 15. All work and materials for the traffic signal system shall conform to Special Provisions Section 623 - Traffic Signal System, except as otherwise provided on the Plans.
- 16. Provide ground rod in all pullboxes, pullboxes adjacent to signal standards, pedestals, controller cabinets, and other locations ordered by the Engineer. Approved: Ground rod connectors shall be copper welded and shall meet ground to earth resistance as specified by the National Electric Code or local inspecting agency.

- 17. Underground pipes, cables, or ductlines known to exist are indicated on the Plans. The Contractor shall verify the locations and depths of the facilities and exercise proper care in excavating in the area. Wherever connections of new utilities to existing utilities are shown on the Plans, the Contractor shall expose the existing lines at the proposed connections to verify their locations and depths prior to excavation for the new lines.
- 18. During non-working hours, the Contractor shall provide two lanes for through traffic. On streets too narrow to make this practicable, the Contractor may work in one half of the roadway keeping one lane open to traffic and alternating the flow of traffic. Payment for contraflow during non-working hours is incidental and will not be paid for separately. During non-working hours, all trenches shall be covered with a safe, non-skid, traffic-bearing bridging material and all lanes shall be open to traffic.
- 19. Where pedestrian walkways exist, they shall be maintained in passable condition or other facilities for pedestrians shall be provided. Passage between walkways at intersections shall likewise be provided.
- 20. Driveways shall be kept open unless the owners of the property using these rights-of-way are otherwise provided for satisfactorily.
- 21. No material and/or equipment shall be stockpiled or otherwise stored within street rights-of-way except at locations designated in writing and accepted by the Engineer.
- 22. Traffic Signal Supports and Foundations shall conform with the AASHTO LRFD Specifications for Structural Supports for Highway Signs, Luminaires and Traffic Signals, 1st Edition, with latest Interim Revisions and as modified by HDOT Memorandum with subject title, "Changes to Design Criteria for Bridges and Structures" (Letter No. HWY-DB 2.5098) dated January 8, 2018.
- 23. Existing traffic signal standards to be replaced shall be removed together with its respective footing. The Contractor may elect to remove only the top portion of the footing. In such cases, the Contractor shall ensure that the remaining footing shall be 12 inches below the existing or finished grade.
- 24. The existing traffic signal system, including interconnect, shall remain in operation until the new traffic signal system is put into service. The Contractor shall arrange his work accordingly to provide temporary relocations and wirings, as necessary.
- 25. Contractor shall coordinate with C&C DTS Signal Shop (Supervisor Wally Nakihira @ 564-6101) for all traffic signal-related work. Schedule with C&C DTS Signal Shop at least two weeks in advance of the actual work, including pavement cold planing removing the existing loop detector.
- 26. Contractor shall perform all traffic signal-related work following field instructions from DTS Signal Shop personnel. Such field instructions shall include, but not limited to, the final location and quantity of the temporary microwave sensor's and permanent detector loops. DTS Signal Shop personnel will be responsible for traffic signal controller programming at the traffic signal cabinet to accomodate the temporary and permanent operations.
- 27. Contractor shall promptly take down and turnover the temporary microwave sensors to DTS when the permanent detector loops are in place and operational. Contractor shall perform all necessary work to restore traffic signal system back to a neat appearance of the electrical trade.

Approved:

FISCAL SHEET YEAR NO. STATE PROJ. NO. DIST. NO. SHEETS 2020 ADD. 104 167 901A-01-19 HAWAII

-×- †s --×--

____/

CCTV/

Existing Traffic

Existing Traffic Signal

Existing Traffic Signal

Existing Signal Standard

with Mast Arm Type II, or

Existing Controller Cabinet

Items to be removed

Existing Pedestrian

Head with New Back Plate

Signal Head

Signal Head

Type III

Existing Signal

H=3', 7' or 10'

Existing CCTV

Controller Cabinet

Existing CCTV Camera

Standard Type I,

Existing Pullbox

FED. ROAD

TRAFFIC SIGNAL LEGEND AND ABBREVIATIONS: Conduits and Cables,

Conduit Run X 12" R-Y-↑ Traffic Signal Head

12" R-Y-G Traffic Signal Head $\rightarrow \triangleright$ 12" R-Y-← Traffic Signal Head Pedestrian Signal Head

12" R-Y-↑ Traffic Signal Head with Back Plate 12" R-Y-G Traffic Signal Head

with Back Plate 12" R-Y-← Traffic Signal Head with Back Plate

12" R-Y-G-← Traffic Signal Head with Back Plate Signal Standard with Mast Arm

Loop Detectors

Mast arm, Pole X, Footing Type C Signal Standard Type I, Pole X, H=3', 7' or 10', Footing Type A

Type II, or Type III L=Length of

Pullbox Type A (Old Type "B") Pullbox Type B (Old Type "C")

Pullbox Type C (Old Type "D") Pedestrian Push Button Assembly


(Arrow denotes direction on Push Button Sign)

Traffic Controller Model 170E and 332A Cabinet with Type D Concrete Base for Controller Cabinet

CCTV Controller Cabinet

New CCTV Camera Street Sign Mounted to Mast Arm

> 3/3/20 Revised Legend. Added TRB Approval. Date Revision

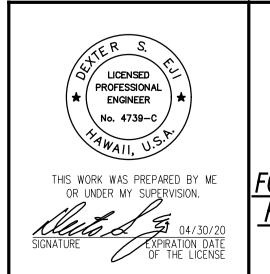

STATE OF HAWAII **DEPARTMENT OF TRANSPORTATION**

TRAFFIC SIGNAL NOTES AND LEGEND


FORT BARRETTE ROAD OPERATIONAL IMPROVEMENTS Roosevelt Avenue to Farrington Highway Project No. 901A-01-19 Scale: None Date: Jan. 2020

SHEET No. TS-1 OF 16 SHEETS

SURVEY
DRAWN
TRACED
DESIGNEI
QUANTIT

Chief, Traffic Review Branch, DPP

Chief, Traffic Signals & Technology Division, DTS

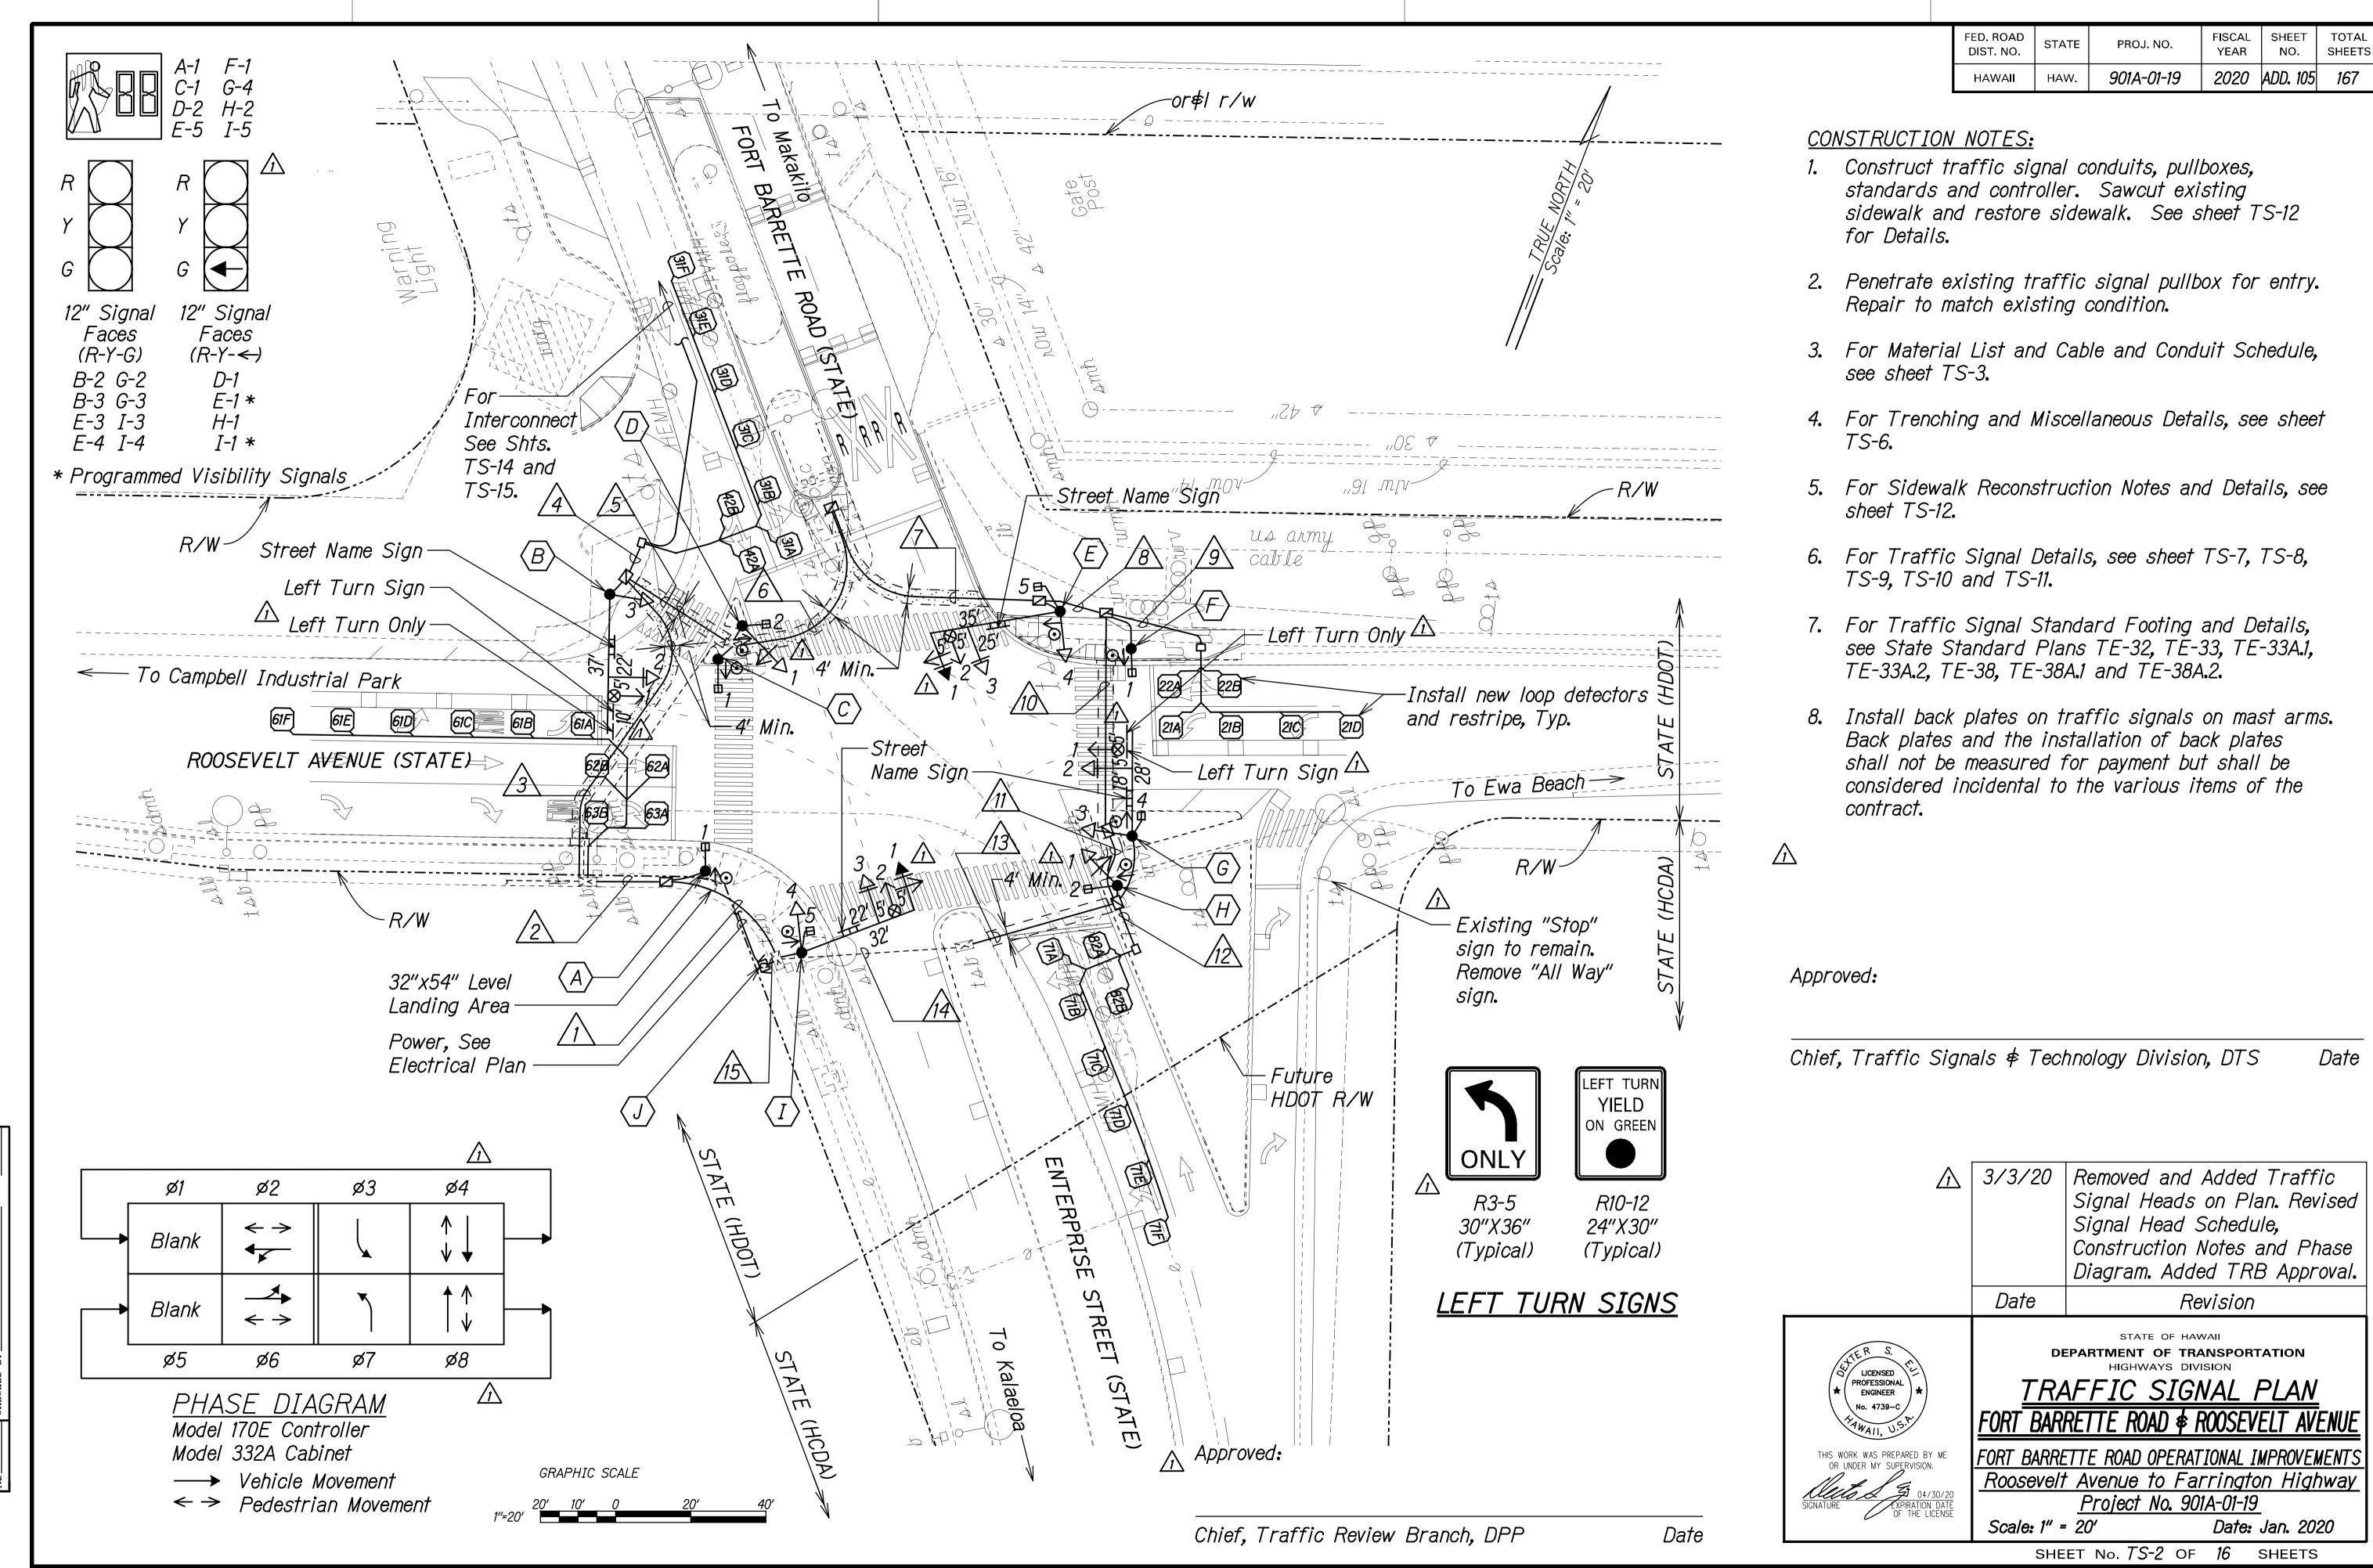

ı	FED. ROAD DIST. NO.	STATE	PROJ. NO.	FISCAL YEAR	NO.	SHEETS
ı	HAWAII	HAW.	<i>901A-01-19</i>	2020	ADD. 106	<i>16</i> 7

\triangle				Material List	
	Pole	Base Type	Standard Type	Mounting Type	PPB Assembly
	Α	Α	I-10	(1) TP-1W	1
	В	С	II-37	(1) Opticom (Horiz.)	
				(2) MA-1W	
				(3) B-1W	
	С	Α	I-10	(1) TP-1W (Pedhead)	1
	D	Α	I-10	(1) TP-1W	
				(2) B-1W (Pedhead)	1
	Ε	С	II-35	(1)(3) MA-1W	
				(2) Opticom (Horiz.)	
				(4) B-1W	
				(5) US-1W (Pedhead)	1
	F	Α	I-10	(1) TP-1W (Pedhead)	1
	G	С	II-28	(1) Opticom (Horiz.)	
				(2) MA-1W	
				(3) B-1W	
				(4) US-1W (Pedhead)	1
	Н	Α	I-10	(1) TP-1W	
				(2) B-1W (Pedhead)	1
	I	С	II-32	(1)(3) MA-1W	
				(2) Opticom (Horiz.)	
				(4) B-1W	
				(5) US-1W (Pedhead)	1
				(6) CCTV Camera	
	J	D		170E Controller	
				332A Cabinet and Base	


For Traffic Signal Pole Base, See Std. Plan TE-32, TE-33, TE-33A.1 and TE-33A.2.

			2C#14	Conduit 12PR#19			Othor
Run	Conduit					<i>3C#6</i>	Other
\wedge	Size	Signal	PPB/	Inter- Connect	Opticom	Power/	
		Control	Loops	Connect		Service	
1	2-2"	2					
	2-2"		7				
	2"						
	2"			1			
	2"				2		
	2"			SPARE			
2	2-2"	2					
	2-2"		7				
	2"						
	2"			1			
	2"				2		
	2"			SPARE	•	<u> </u>	
3	2-2"	2					
	2-2"		7				
	2"						
	2"			1			
	2"			·	2		
	2"			SPARE			
4	2"		2	77772			
•	2"						
	2"			1			
	2"			SPARE			
5	2-2"	2					
	2"		1				
	2"		,		1		
	2"			SPARE	<u>'</u>		
6	2-2"	2					
	2"		1				
	2"		•		1		
	2"			SPARE	'		
7	2-2"	2					
•	2"		1				
	2"		'	SPARE	L		
8	2-2"	2					
	2"				1		
	2"			SPARE			
9	2"		2				
<u> </u>	2-2"	2					
10	2"		3				
	2"		3		1		
	2"			SPARE	/		

] 2			Cá	able and	Conduit	Schedule		
	Run	<u> </u>	26C#14	2C#14	12PR#19	3C#20	<i>3C#6</i>	Other
		Conduit Size	Signal Control	PPB/ Loops	Inter- Connect	Opticom	Power/ Service	
	11	2-2"	2					
		2"		3				
		2"				1		
		2"			SPARE			
	12	2"		2				
	13	2-2"	2					
		2-2"		6				
		2"				2		
		2"			SPARE			
	14	3"(E)	2					
		3"(E)		6				
		2"(E)				2		
		2"(E)			SPARE		-	
	15	4-2"	4					
		2-2"		7				
		2-2"		6				
		2"						
		2"			1			
		2-2"				4		
		2"			SPARE			

Approved:			
Chief, Traffic Review	w Branch,	DPP Date	
Approved:			
Chief, Traffic Signa	Is ∲ Tech	nology Division, DTS	
\triangle	3/3/20	Revised Schedule. Added TRB Approval.	
	Date	Revision	
LICENSED PROFESSIONAL ENGINEER	CABI F	STATE OF HAWAII EPARTMENT OF TRANSPORTATIO HIGHWAYS DIVISION AND CONDITT COHE	N N

Scale: None

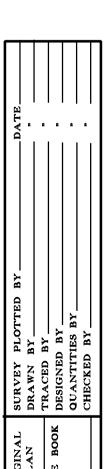


SHEET No. *TS-3* OF *16* SHEETS **ADD. 106**

Date: Jan. 2020

FORT BARRETTE ROAD & ROOSEVELT AVENUE

FORT BARRETTE ROAD OPERATIONAL IMPROVEMENTS
Roosevelt Avenue to Farrington Highway
Project No. 901A-01-19

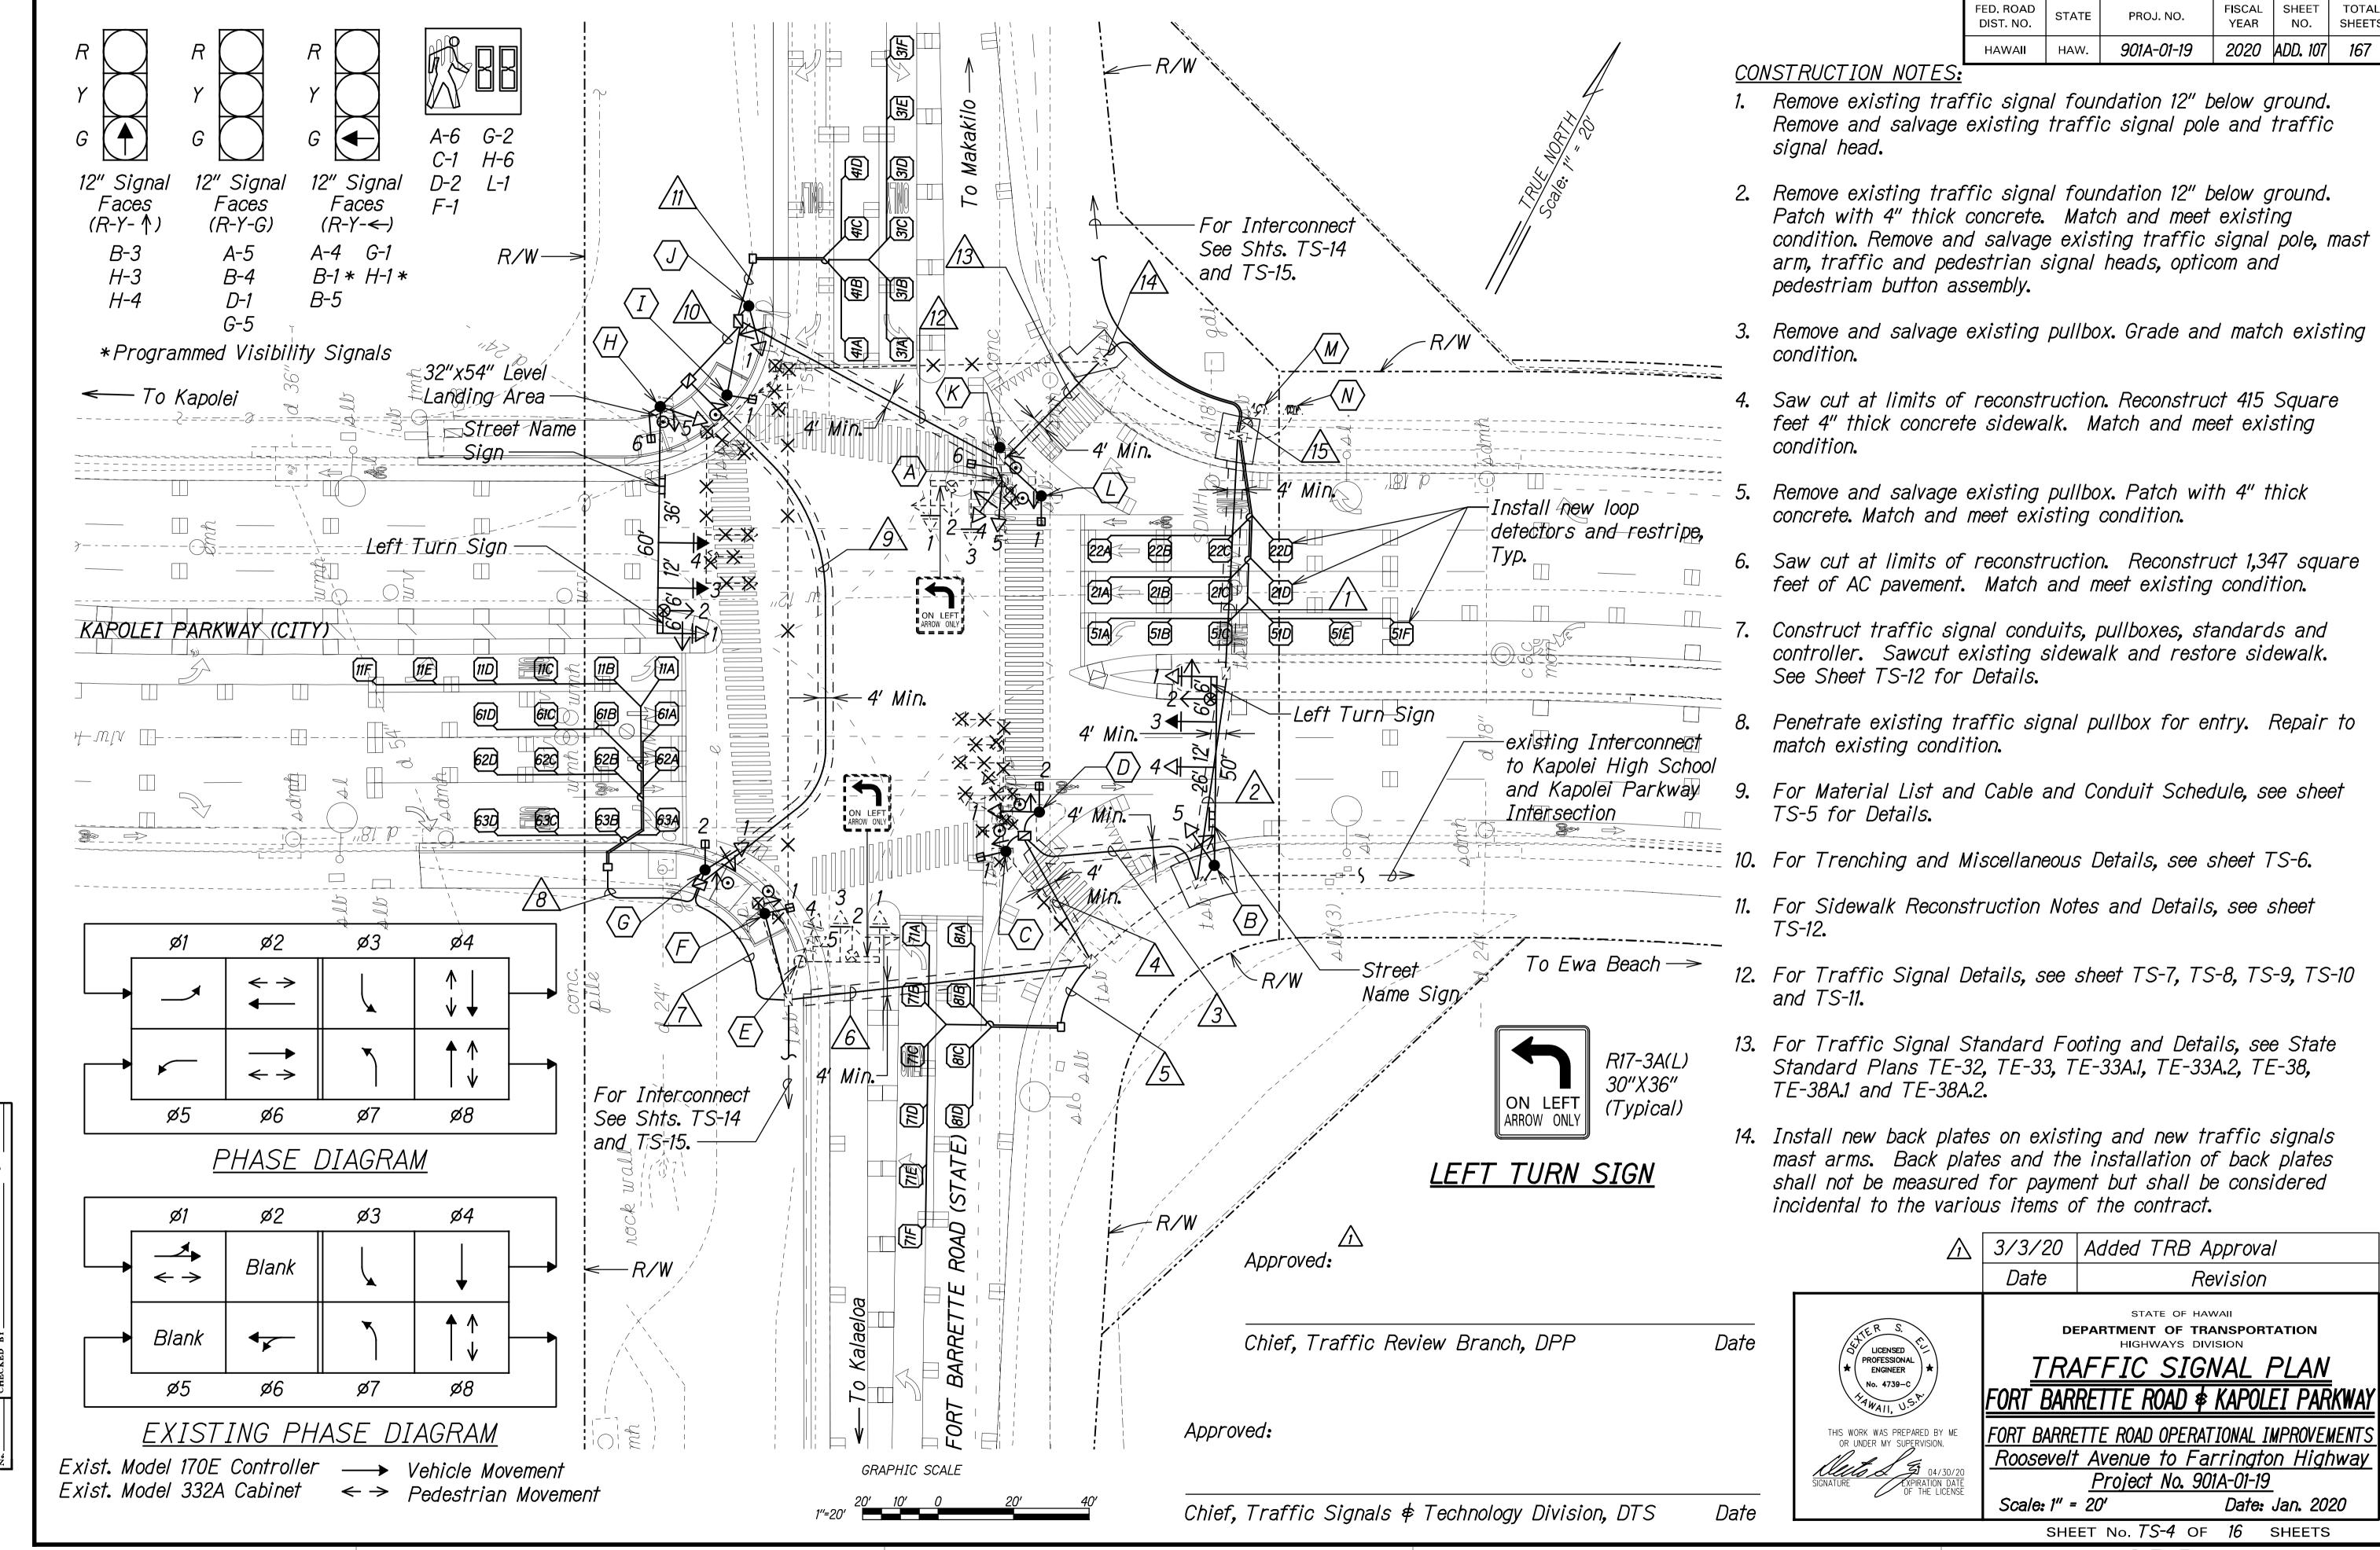

FED. ROAD DIST. NO.	STATE	PROJ. NO.	FISCAL YEAR	SHEET NO.	TOTAL SHEETS
HAWAII	HAW.	901A-01-19	2020	ADD . 108	167

\hat{L}				Material List	
	Pole	Base Type	Standard Type	Mounting Type	PPB Assembly
	Α	Exist	II-(E)	(1)(3) MA-1W (Exist.)	
				(2) Opticom (Exist.)	
				(4)(5) B-2W	
				(6) US-1W (Pedhead)	1
	В	С	II-50	(1)(3)(4) MA-1W	
				(2) Opticom (Horiz.)	
				(5) B-1W	
	С	Α	I-10	(1) TP-1W	1
	D	Α	I-10	(1) TP-1W	
				(2) B-1W (Pedhead)	1
	Ε	Exist	II-(E)	(1)(3) MA-1W (Exist.)	
				(2) Opticom (Exist.)	
				(4) B-1W (Exist.)	
				(5) CCTV Camera (Exist.)	
	F	A	I-10	(1) TP-1W	
				(2) B-1W (Pedhead)	1
	G	A	I-10	(1) TP-1W (Pedhead)	1
	Н	C	II-60	(1)(3)(4) MA-1W	
				(2) Opticom (Horiz.)	
				(5) B-1W	
				(6) US-1W (Pedhead)	1
	I	Α	I-10	(1) TP-1W (Pedhead)	1
	J	Α	I-10	(1) TP-1W	
	K	Α	<i>I-3</i>		
	L	Α	I-10	(1) TP-1W	1
	М	Exist		170E Controller (Exist.)	
				332A Cabinet (Exist.)	
	N	Exist		CCTV Cabinet (Exist.)	

For Traffic Signal Pole Base, See Std. Plan TE-32, TE-33, TE-33A.1 and TE-33A.2.

		26C#14	2C#14	nd Conduit Fiber Optic		3C#6	Other
Run	Conduit				30 20		011101
	Size	Signal Control	PPB/ Loops	Inter- Connect	Opticom	Power/ Service	
			LOOPS	COMMECI		Service	
	2-2"	2					
	2-2"		8				
	2"			1			
	2"				2		
	2"			SPARE			
2	2-2"	2					
	2-2"		8				
	2"			1			
	2"				2		
	2"			SPARE			
3	2-2"	2					
	2-2"		8				
	2"				1		
	2"			SPARE			
4	2-2"	2					
	2-2"		7				
	2"				1		
	2"			SPARE			
5	2"		2				
6	2-2"	2					
	2-2"		6				
	2"				1		
	2"			SPARE		<u> </u>	
7	2-2"	2					
	2-2"		5				
	2"			1			
	2"			SPARE		I	
8	2-2"		4				
9	2-2"	2					
	2"		1				
	2"			1			
	2"		<u> </u>	SPARE		<u> </u>	
10	2-2"	2					
	2"		1				
	2"		-	1			
	2"		<u> </u>	SPARE			
11	2"		1				
12	2-2"	2	*				
, _	2"	_	4				
	2"		•	1			
	2"			<u>'</u>	1		
	2"			SPARE	, , , , , , , , , , , , , , , , , , ,		
	. –	Ī					

			Cable a	nd Conduit	Schedule		
Rup		26C#14	2C#14	Fiber Optic	<i>3C#20</i>	<i>3C#6</i>	Other
Run	Conduit Size	Signal Control	PPB/ Loops	Inter- Connect	Opticom	Power/ Service	
13	2-2"	2					
	2"		4				
	2"			1			
	2"				2		
	2"	SPARE					
14	2-2"	2					
	2"		4				
	2"			1			
	2"				2		
	2"			SPARE			
15	4-2"	4					
	4-2"		16				
	2"			2			
	2-2"				4		
	2"	SPARE					

Approved:

Chief, Traffic Review Branch, DPP Date


Approved:

Chief, Traffic Signals \$ Technology Division, DTS

\(\triangle \) 3/3/20 Revised Schedule.

Added TRB Approval.

Date Revision

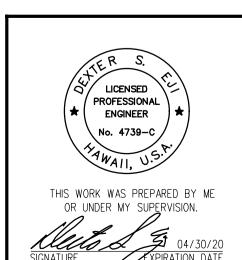

STATE OF HAWAII

DEPARTMENT OF TRANSPORTATION
HIGHWAYS DIVISION

CABLE AND CONDUIT SCHEDULE
FORT BARRETTE ROAD & KAPOLEI PARKWAY


FORT BARRETTE ROAD OPERATIONAL IMPROVEMENTS


Roosevelt Avenue to Farrington Highway

Project No. 901A-01-19

Scale: None Date: Jan. 2020

SHEET No. TS-5 OF 16 SHEETS

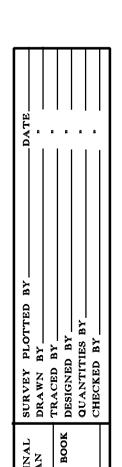


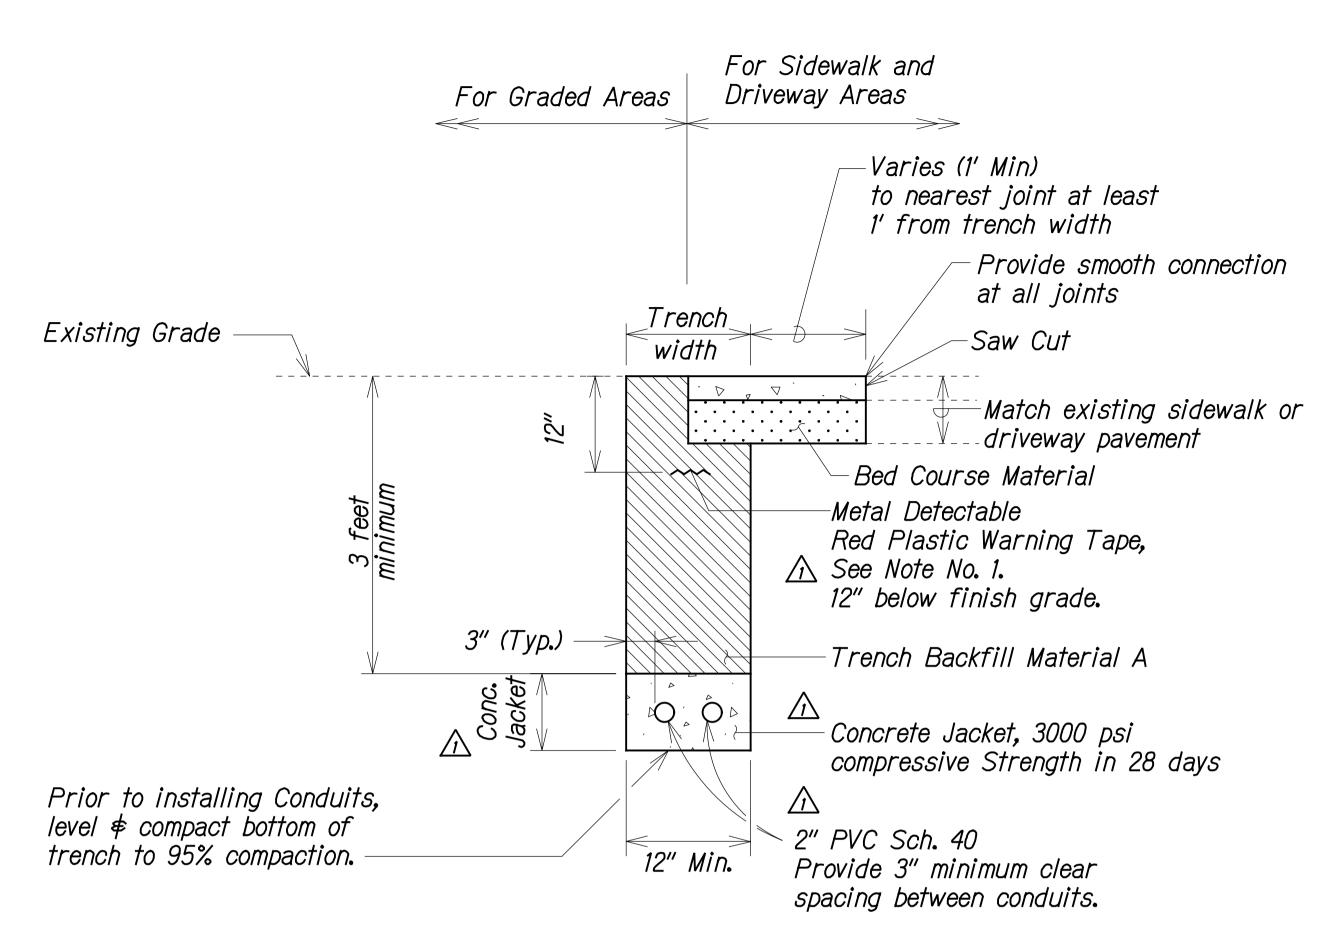

RESTORATION OF NON-ROADWAY AREAS DUE TO TRENCH EXCAVATION Not to Scale

A GENERAL NOTES

- The Metal Detectable Red Plastic Warning Tape shall be a minimum 5 mils thick and 4" wide with a continuous metallic backing and corrosion resistant 1± mil thick foil core. The message on the tape shall read, "CAUTION STATE TRAFFIC SIGNAL AND/OR HWY. LIGHTING BURIED BELOW," utilizing 1-1/2 inches series "C" black lettering. The message will be repeated with a 4-1/4" spacing between top line of message and start of next repeat.
- 2. The Contractor may begin backfilling the conduit trench when the concrete reaches 3000 psi compressive strength after 3 days.
- 3. Maximum four (4) conduits per row for multiple conduit duct section.
- 4. After installing all the traffic signal cables, the Contractor shall duct seal all conduits in the pullboxes, traffic signal standards and traffic signal controller cabinet concrete base. The duct seal material shall be approved by the Engineer and shall not be paid for separately but considered incidental to the direct buried and/or concrete encased conduits.

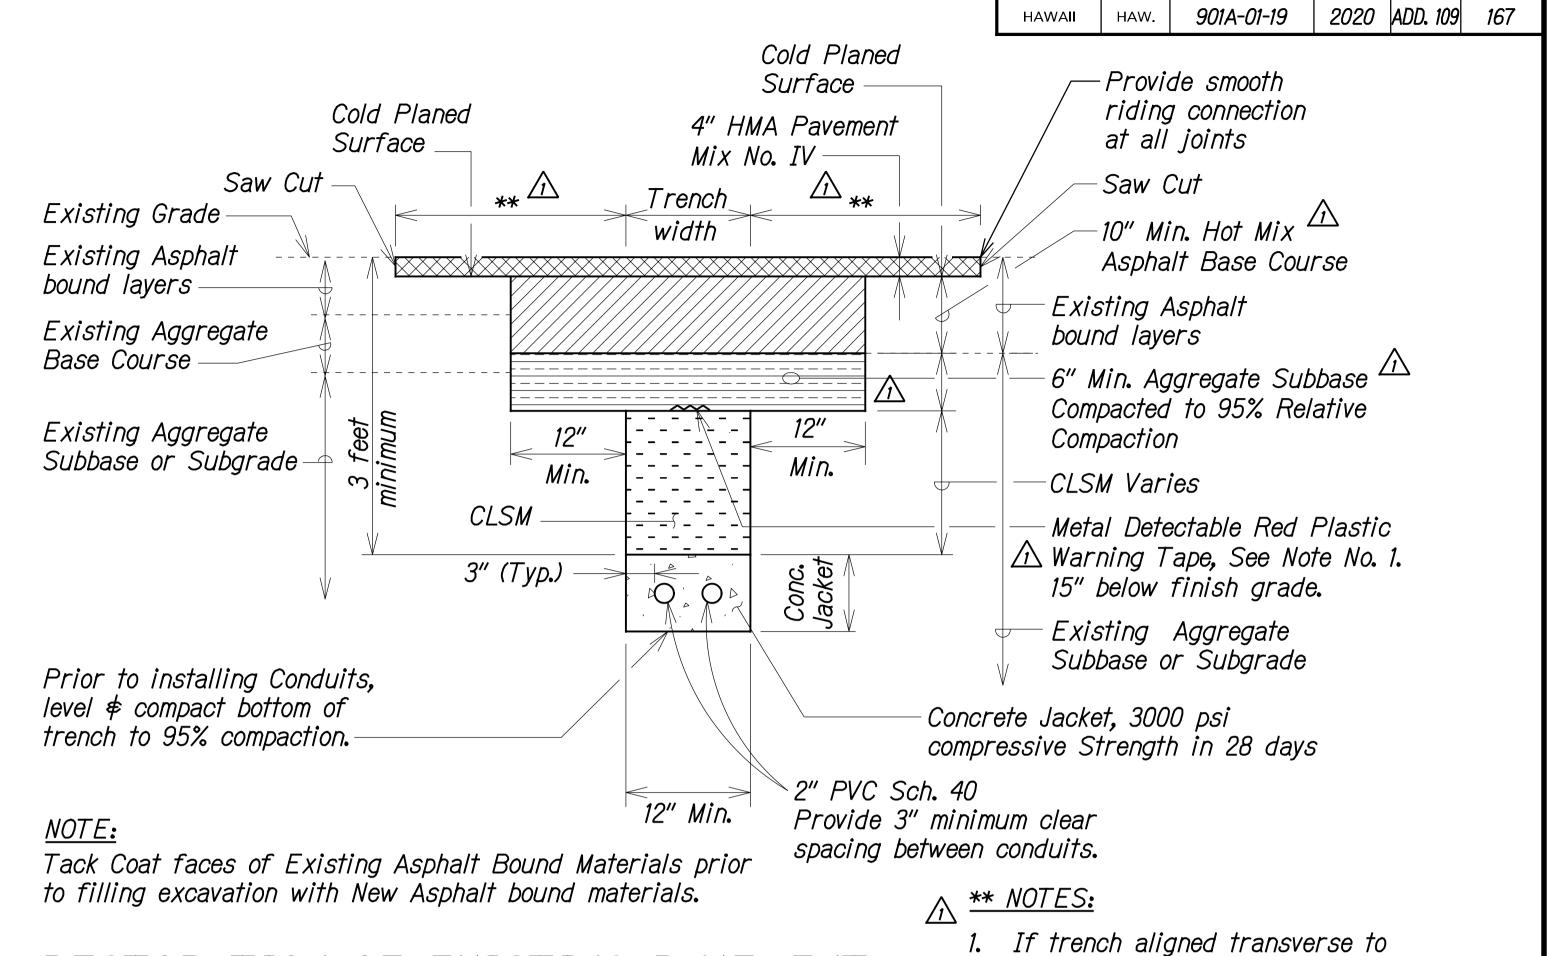

FED. ROAD DIST. NO.

STATE

FISCAL SHEET YEAR NO.

SHEETS

PROJ. NO.

RESTORATION OF EXISTING PAVEMENT DUE TO TRENCH EXCAVATION Not to Scale

CAUTION-STATE TRAFFIC SIGNAL AND/OR CAUTION-STATE TRAFFIC SIGNAL AND/OR
HWY LIGHTING BURIED BELOW

1-1/2" Series "C"
Black Letters

5 mils thick (min.)
Plastic Warning Tape
For additional information, see Note No. 1.

METAL DETECTABLE RED PLASTIC WARNING TAPE Not to Scale

Approved:

Chief, Traffic Review Branch, DPP

Date

Approved:

Chief, Traffic Signals & Technology Division, DTS

for trench restoration through Kamaaha Avenue.

2. If trench aligned along direction of travel, to edge of lane in which edge

direction of travel, 6 feet minimum on

each side of trench. See plan sheet

no. ADD. 37 for resurfacing width

3. Smoothness of paved surfaces; the distance from the paved surface to the testing edge of a ten-foot straight edge between two points of contact shall not exceed 3/16"

of trench is located.

3/3/20 Revised and added notes to detail. Added TRB Approval. Revised General Notes.

Date Revision

STATE OF HAWAII

LICENSED PROFESSIONAL ENGINEER

THIS WORK WAS PREPARED BY ME OR UNDER MY SUPERVISION.

Date



FORT BARRETTE ROAD OPERATIONAL IMPROVEMENTS


Roosevelt Avenue to Farrington Highway


Project No. 901A-01-19

Scale: NTS

Date: Jan. 2020

SHEET No. *TS-6* OF *16* SHEETS

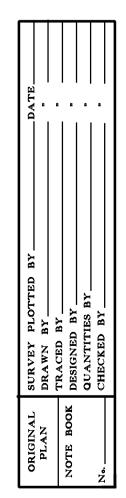

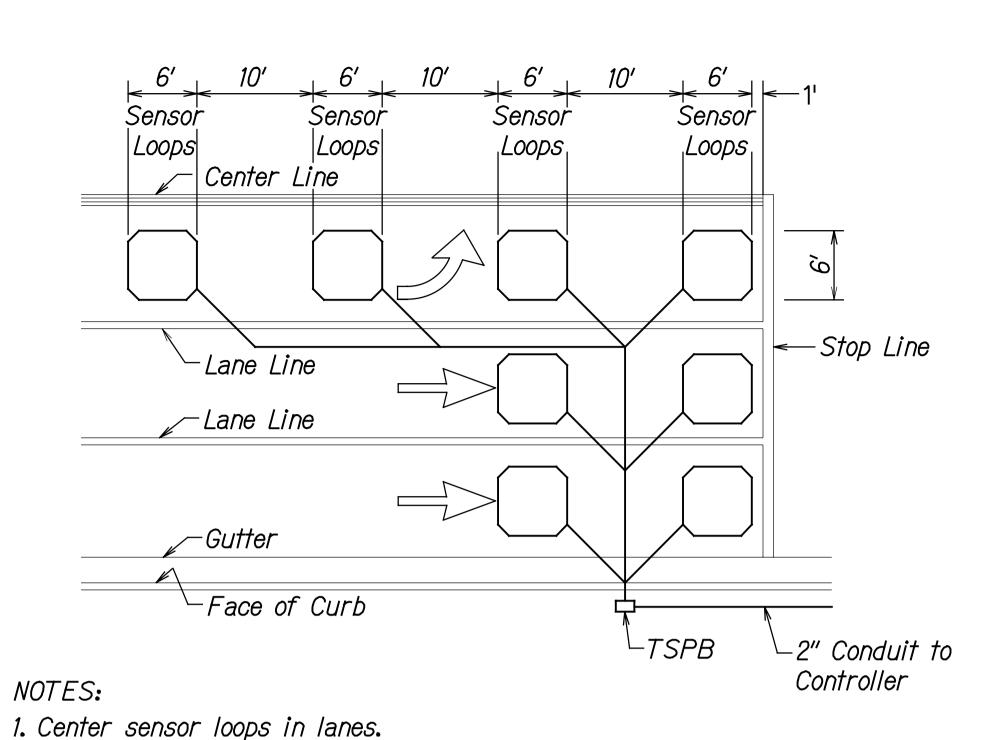

4. Number and locations of collector sawcuts may be varied in the field to suit.

TYPICAL SENSOR LOOP LAYOUT

TYPICAL SENSOR LOOP SAWCUT DETAIL


NOTE: Length of overcuts shall be kept

be back filled with hot tar.

to a minimum. All overcuts shall

(B)

-Collector Sawcuts

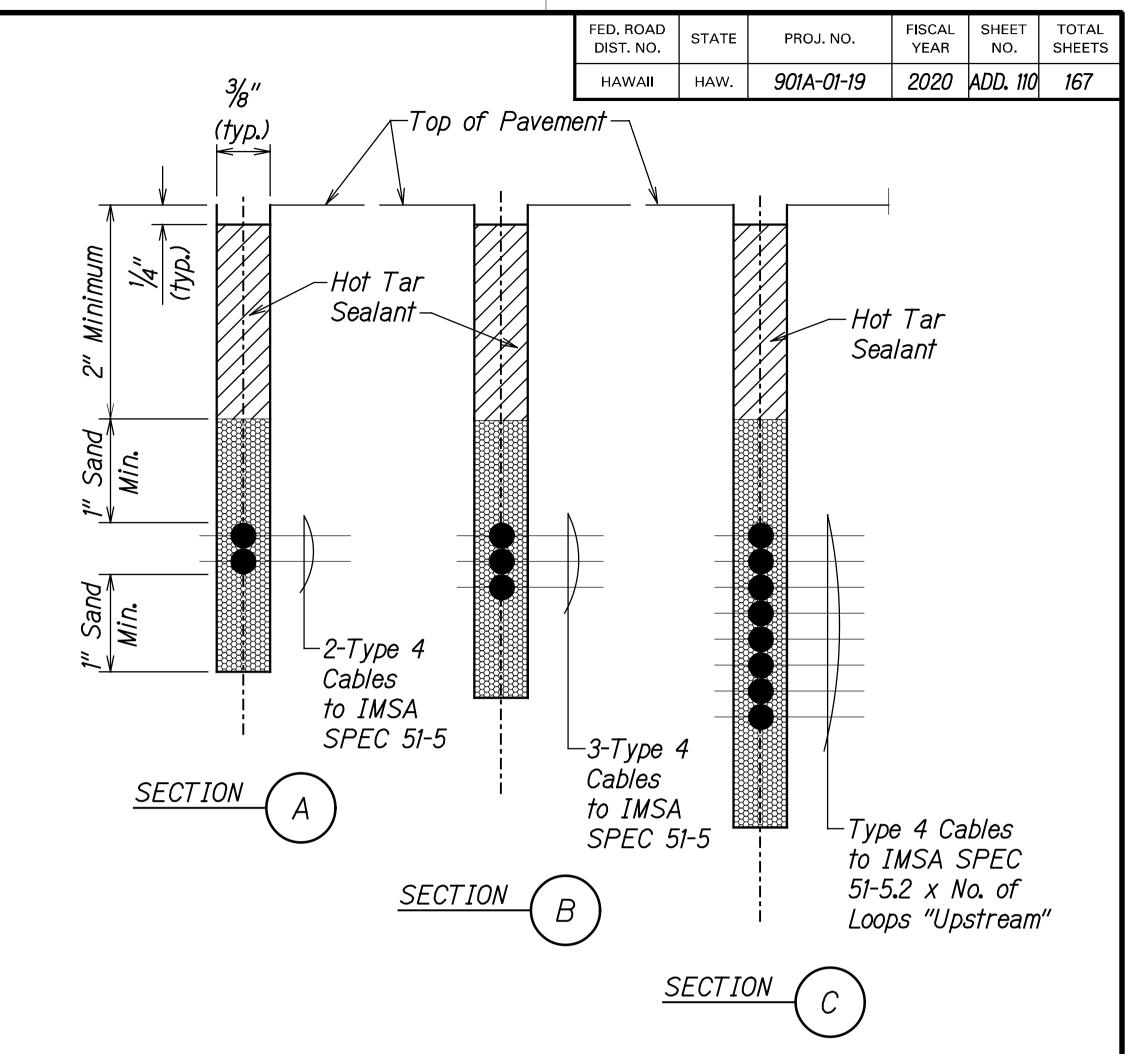


TYPICAL SECTION THROUGH SENSOR LOOP

- Deepen Reconstruct Curb Sawcut near and Gutter -Conduit $TSPB \neg$ -Sealant Paving— -Type 4 Bulkhead -2" Steel Conduit

2. Collector cables shall be twisted 2 turns per foot.

3. Number of loops and locations vary. See project plans.

DETAIL OF SENSOR LOOP INSTALLATION AT EDGE OF ROADWAY

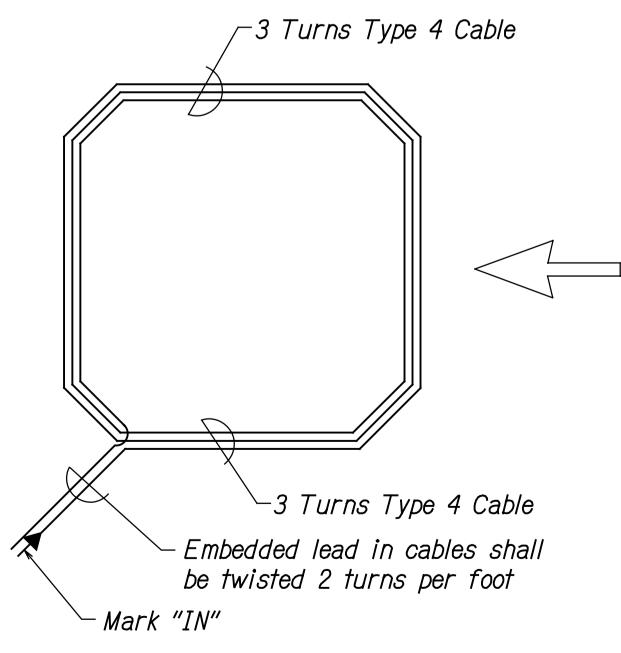

Typical

Overcuts -

TYPICAL SENSOR LOOP WIRING DIAGRAM

TYPES OF CABLES

4 6

- Type 1 Signal Loop Cable: Stranded No. 14, 26 conductors
- Type 2 Detector lead in cable and pedestrian push button circuit cable: Stranded, No. 14, two conductors
- Type 3 Interconnect Cable: Solid No. 19, 12
- Type 4 Loop Sensor Cable: Solid No. 12, single conductor to IMSA spec. 51-5
- Type 5 Cable from signal loop to signal head: Stranded, No. 14, four conductors
- Type 6 Service Cable: Solid, No. 6, three conductors
- Type 7 Optical Detector Cable: Berktek Type B, Stranded, No. 20, three conductors
- Type 8 Drop Cable: Solid, No. 14, four conductors

Approved:

Chief, Traffic Review Branch, DPP

Date

Date

Approved:

Chief, Traffic Signals & Technology Division, DTS

LICENSED PROFESSIONAL ENGINEER No. 4739−C / THIS WORK WAS PREPARED BY ME OR UNDER MY SUPERVISION.


1 3/3/20 | Added TRB Approval Date Revision


> **DEPARTMENT OF TRANSPORTATION** HIGHWAYS DIVISION


LOOP DETECTOR DETAILS


FORT BARRETTE ROAD OPERATIONAL IMPROVEMENTS Roosevelt Avenue to Farrington Highway Project No. 901A-01-19

Scale: None Date: Jan. 2020 SHEET No. TS-7 OF 16 SHEETS

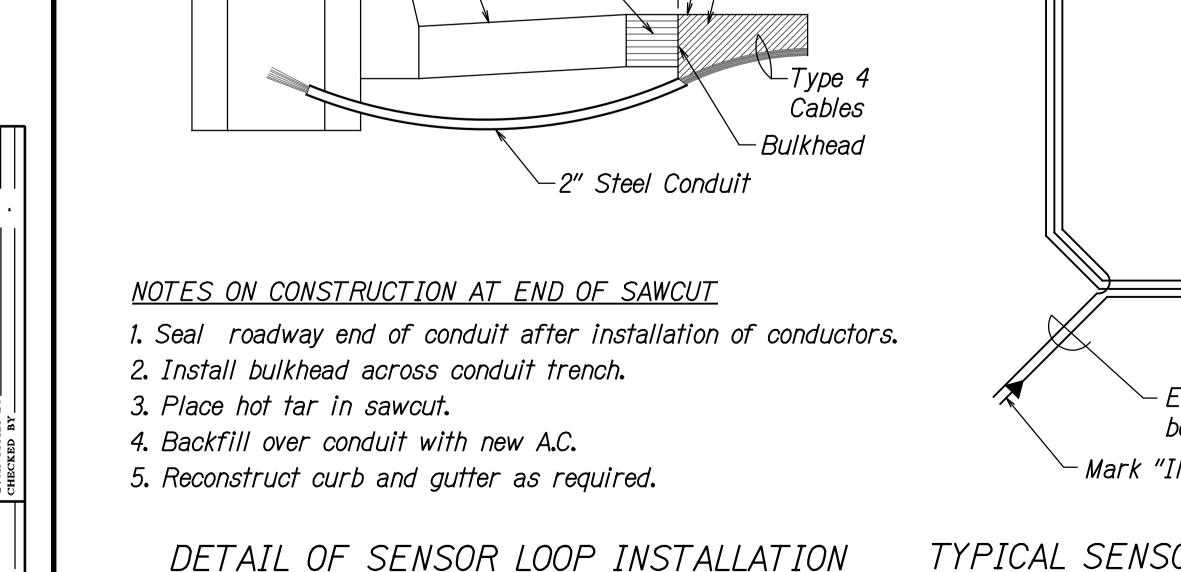

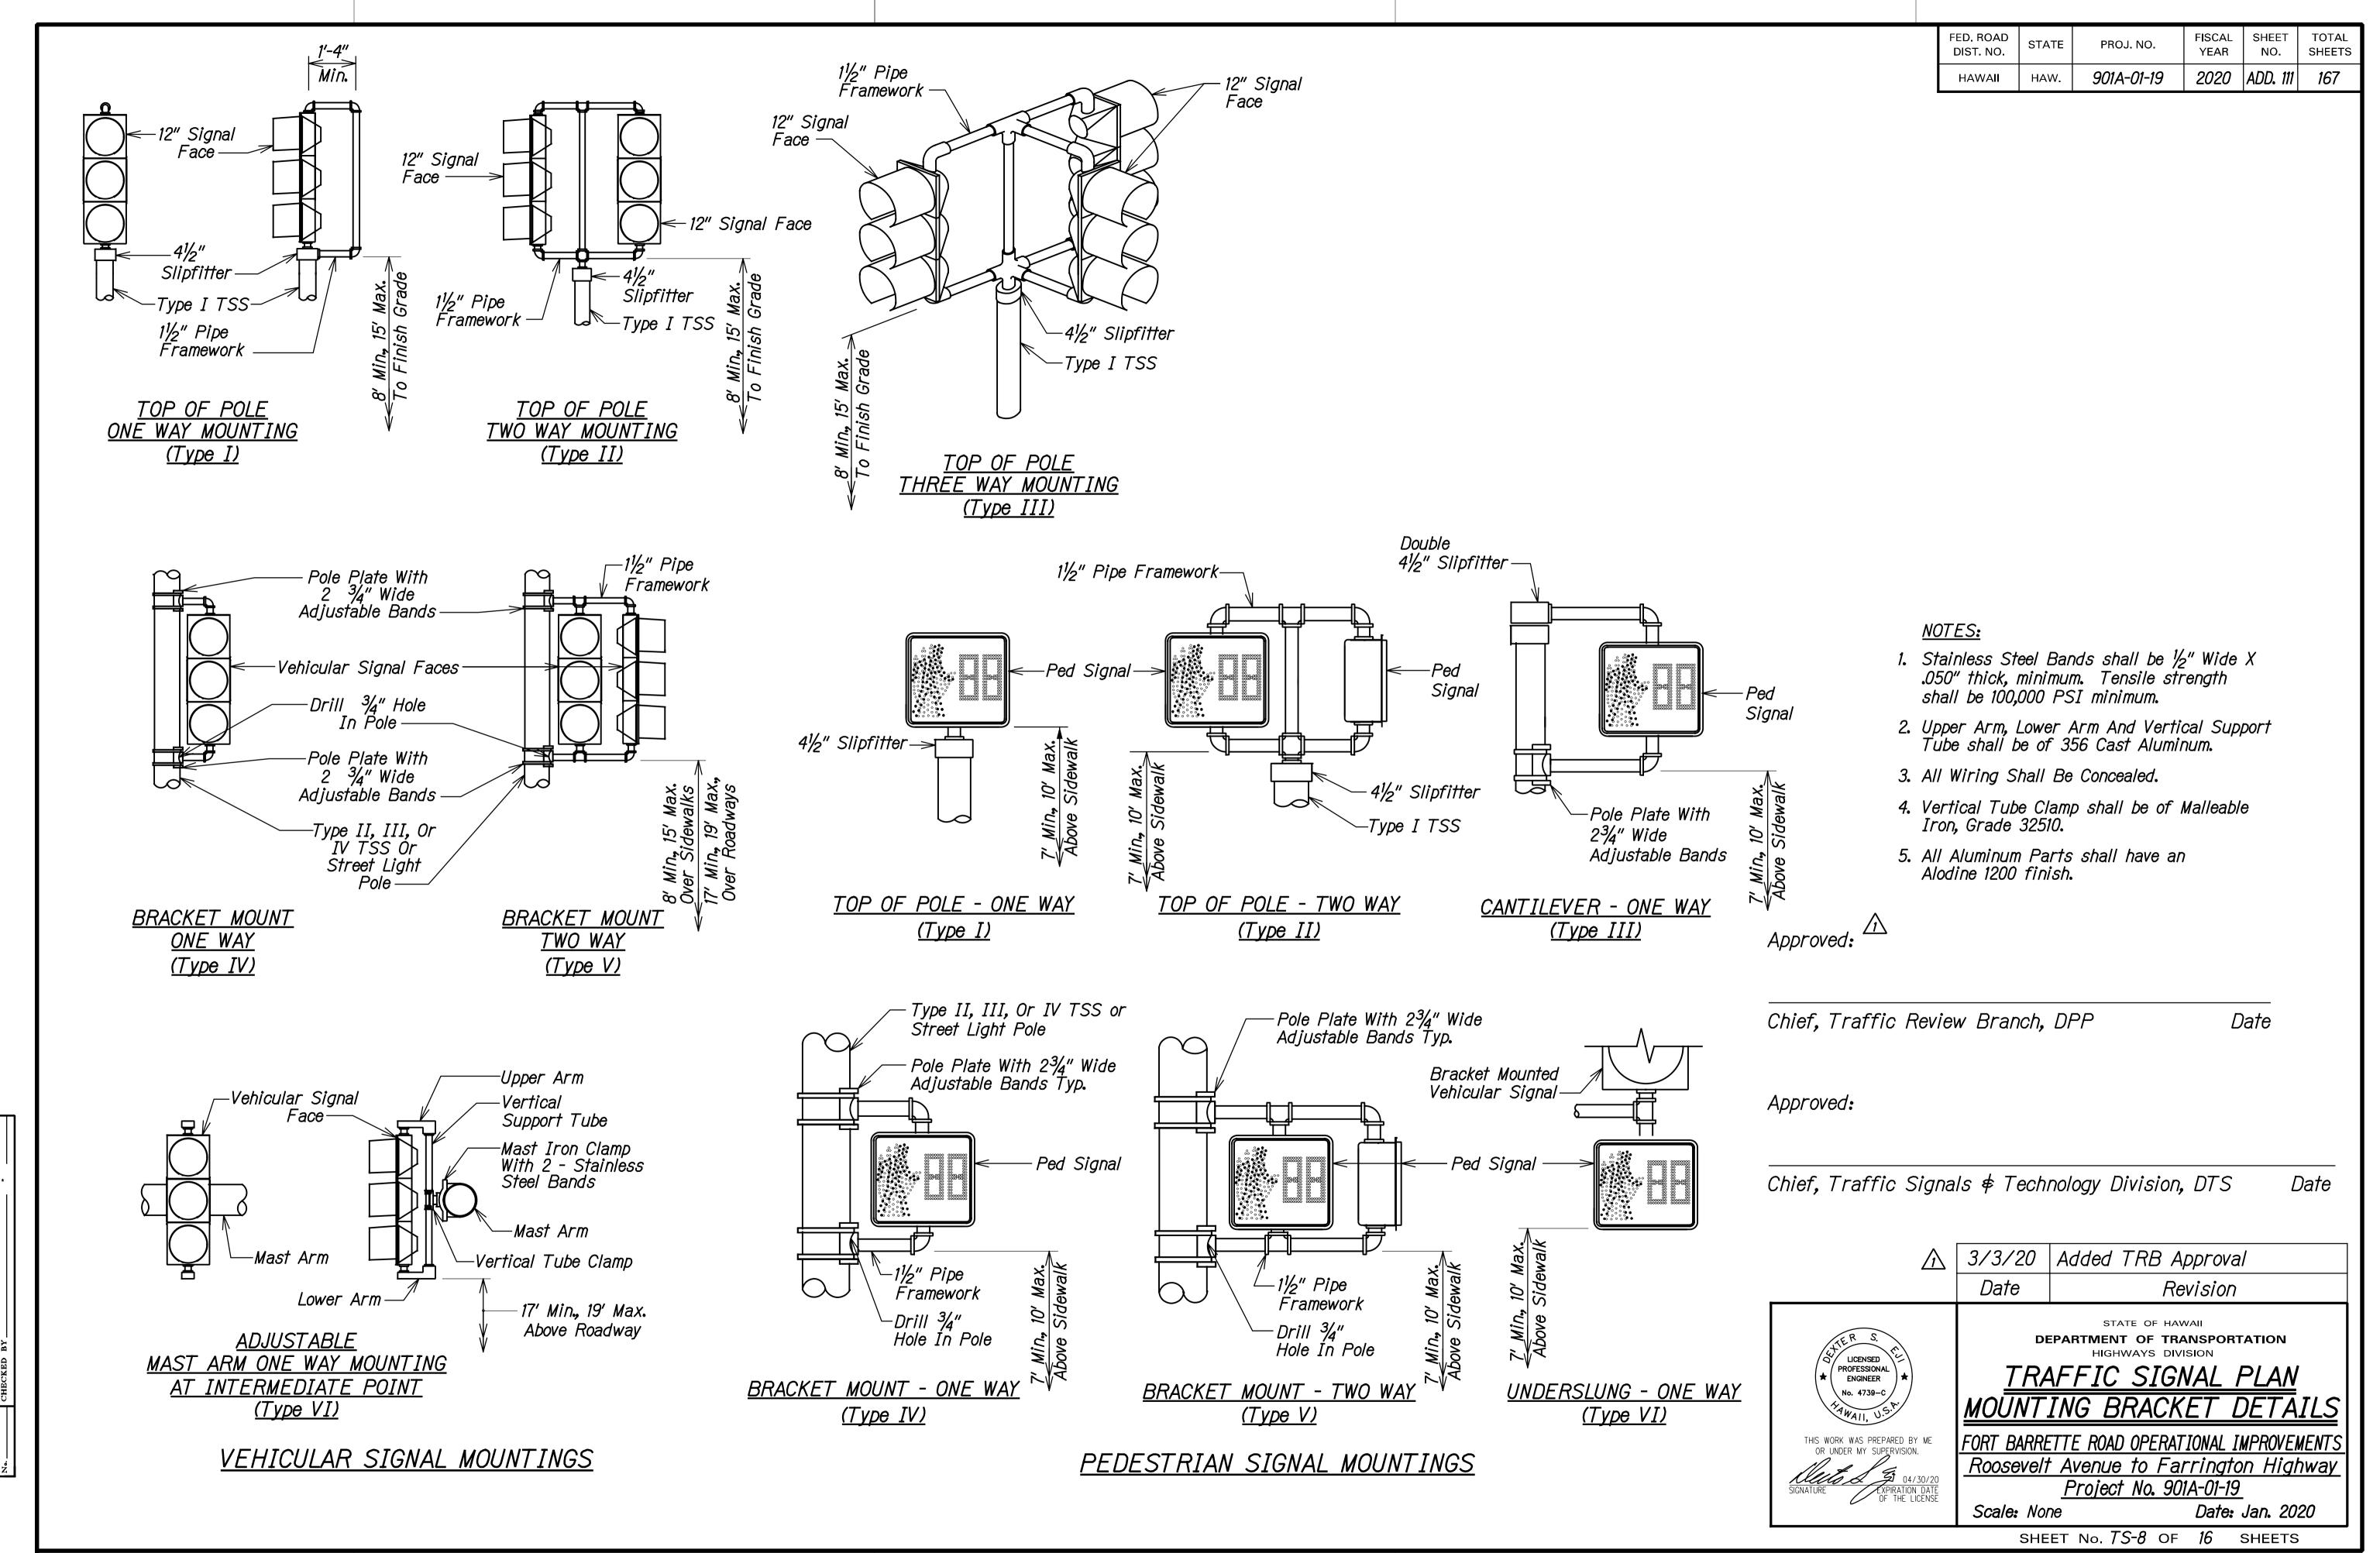

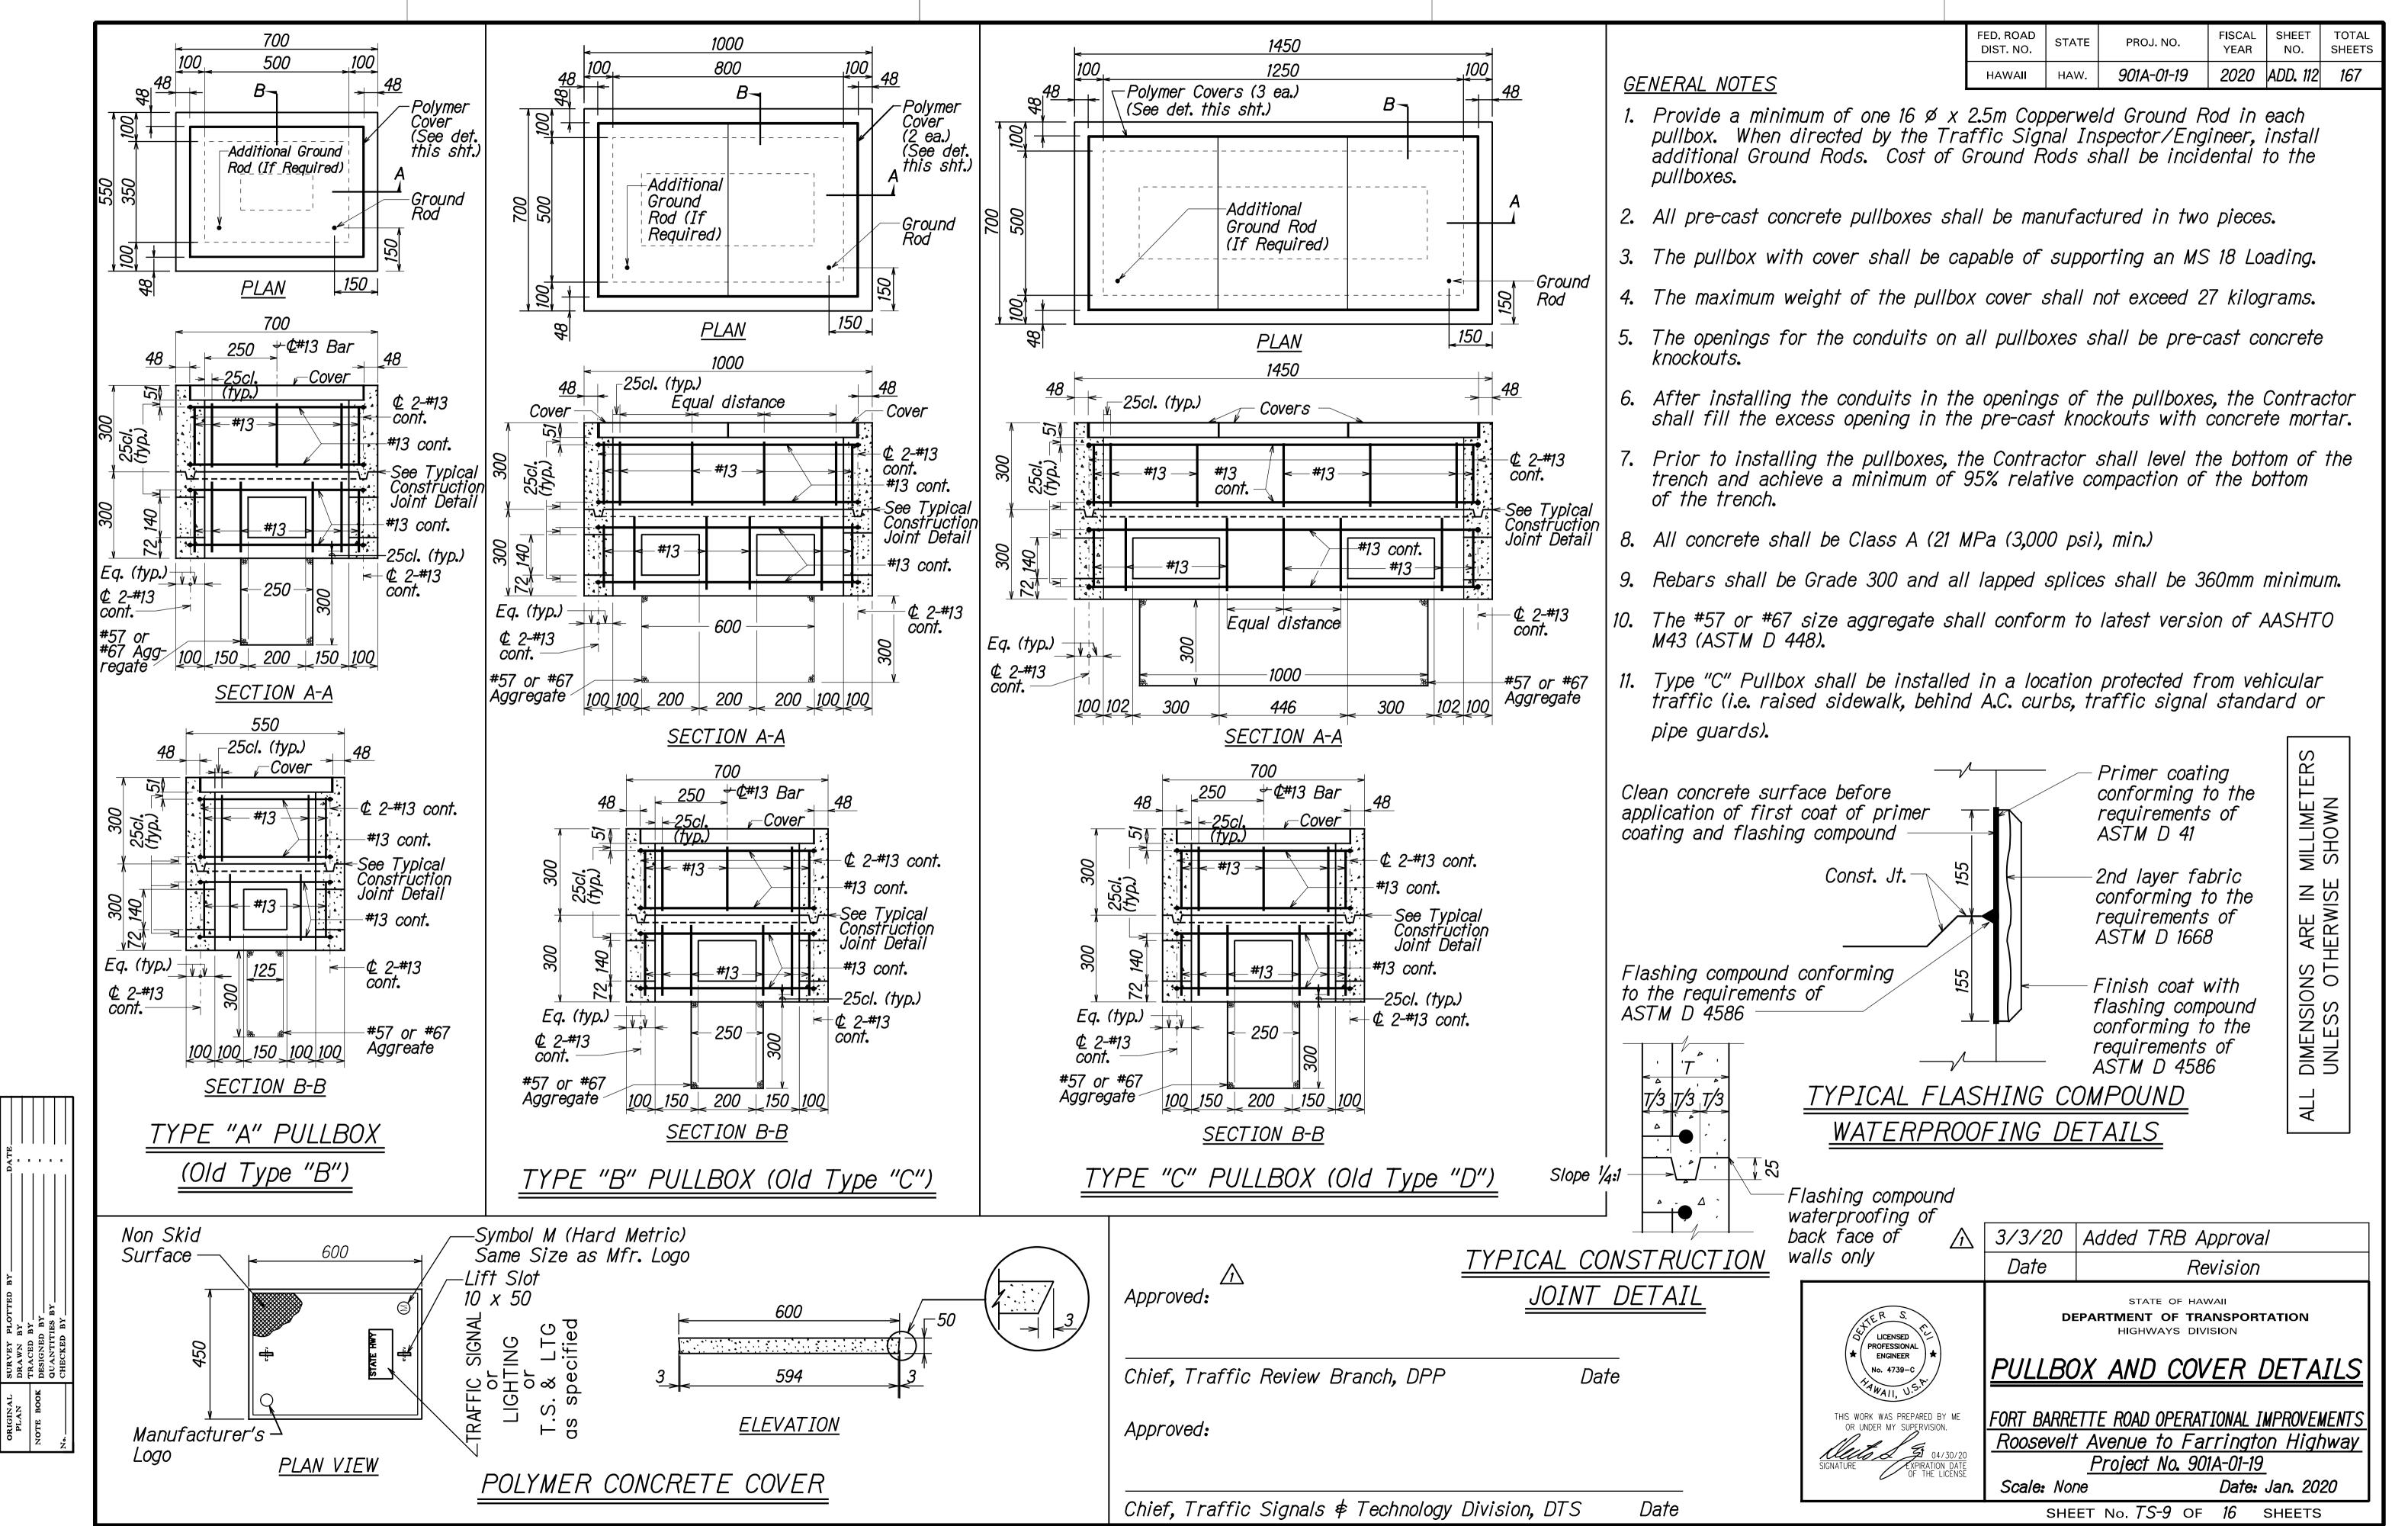

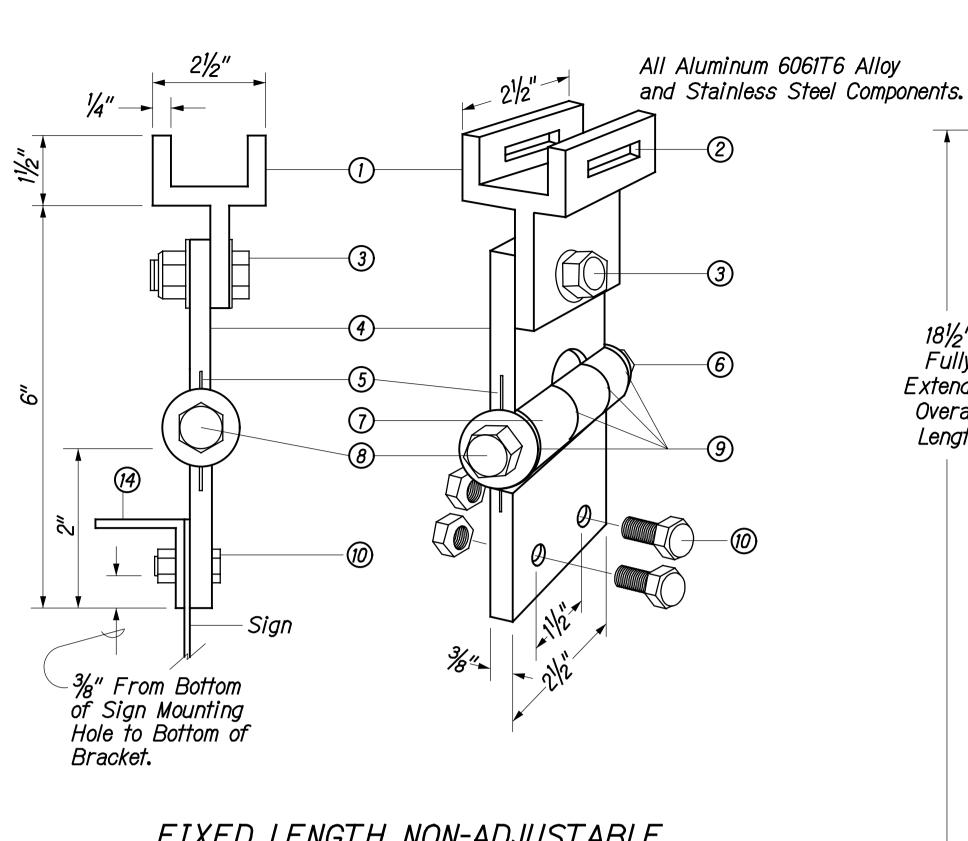


FIXED LENGTH NON-ADJUSTABLE SWING SIGN BRACKET

- (1) Pivotal Upper Bracket
- 2) 15/8" X1/4" Slot for Double Strapping to Electrolier Mast Arm. (M2G-34S(HD) .030" X 3/4" Heavy Duty Stainless Steel Strap With M2G-34B(HD) Buckle Recommended.)
- ③ ½" 13 X 1½" Stainless Steel Hex Head Bolt with Stainless Steel Hex Lock Nut and 1/16" Stainless Steel Washer (Both Sides). Allows Upper Bracket to Pivot and Align with Electolier Mast Arm.
- (4) 6" Overall Drop with Fixed Length Sign Bracket
- (5) Stainless Steel Damperer Spring (Removable)
- (6) Stainless Steel Hex Lock Nut with 1/16" Stainless Steel Washer
- (7) 1" O.D. Axle Housing
- (8) $\frac{1}{2}$ " 13 X 4" Stainless Steel Hex Head Bolt with $\frac{1}{16}$ " Stainless
- 9) Oilite Bushing
- 10 Sign Mounting Sets, Consisting of Two Each 5/16" 18 X 1" Stainless Steel Hex Head Bolt with Stainless Steel Hex Lock Nut. Two Holes on 1½' Centers Provide Positive Lock
 Sign Mounted to Bracket.
- (1) 81/4" Overall Length Upper Adjustable Sigh Bracket Section
- 12) 9" Overall Length Lower Adjustable Sign Bracket Section, Including Axle Housing (8" Overall Length to Top of Axle Housing)
- (13) ½" 13 X 1½" Stainless Steel Hex Bolt with Stainless Steel Hex Lock Nut and ½" Stainless Steel Washer (Both Sides).

 Loosen Lock Nut . Adjust Bracket Teeth to Level Sign.
- (14) 11/4" X 11/4" X1/8" Aluminum Angle



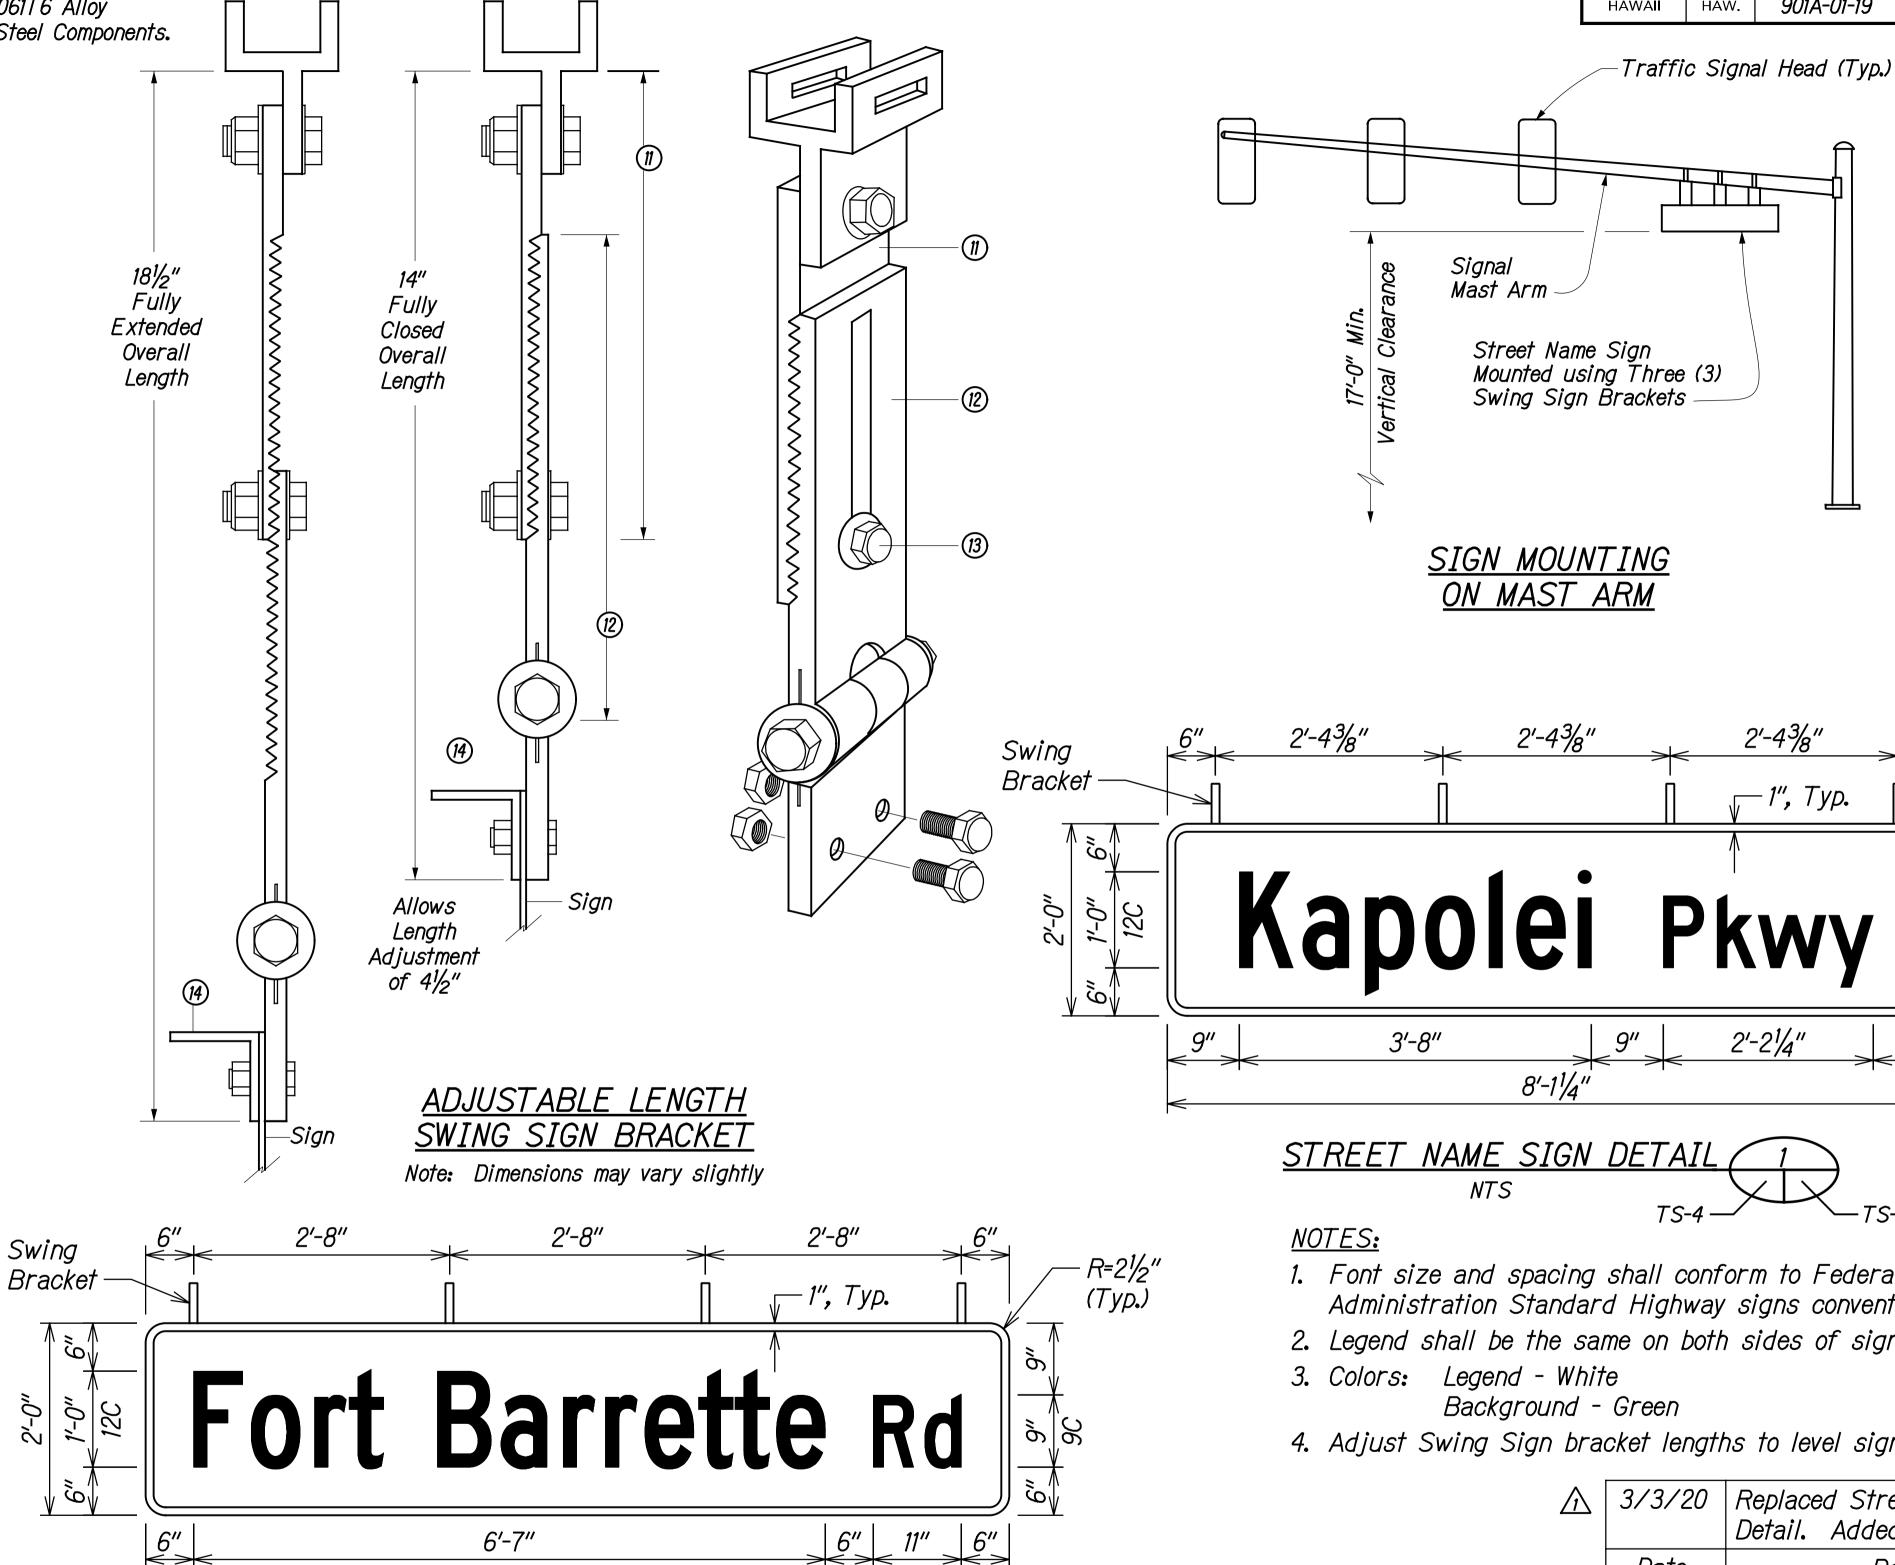

9'-0"

TS-2, TS-4

Approved:

STREET NAME SIGN DETAIL

Date

NOTES:

3′-8″

2'-43/8"

1. Font size and spacing shall conform to Federal Highway Administration Standard Highway signs convention.

FED. ROAD DIST. NO.

HAWAII

Street Name Sign Mounted using Three (3)

Swing Sign Brackets

SIGN MOUNTING

ON MAST ARM

2'-43/8"

Signal Mast Arm

FISCAL SHEET YEAR NO.

901A-01-19

Traffic Signal Head (Typ.)

2'-43/8"

, Typ.

2'-21/4"

2020 ADD. 113 167

SHEETS

 $R=2\frac{1}{2}$ "

(Typ.)

- 2. Legend shall be the same on both sides of sign.
- 3. Colors: Legend White Background - Green

STREET NAME SIGN DETAIL

NTS

4. Adjust Swing Sign bracket lengths to level sign.

1 3/3/20 | Replaced Street Name Sign Detail. Added TRB Approval. Date Revision STATE OF HAWAII **DEPARTMENT OF TRANSPORTATION** HIGHWAYS DIVISION LICENSED PROFESSIONAL ENGINEER SIGN BRACKET DETAILS THIS WORK WAS PREPARED BY ME OR UNDER MY SUPERVISION. FORT BARRETTE ROAD OPERATIONAL IMPROVEMENTS


Roosevelt Avenue to Farrington Highway Project No. 901A-01-19 Scale: None Date: Jan. 2020

SHEET No. TS-10 OF 16 SHEETS

Chief, Traffic Review Branch, DPP

Chief, Traffic Signals & Technology Division, DTS

Date

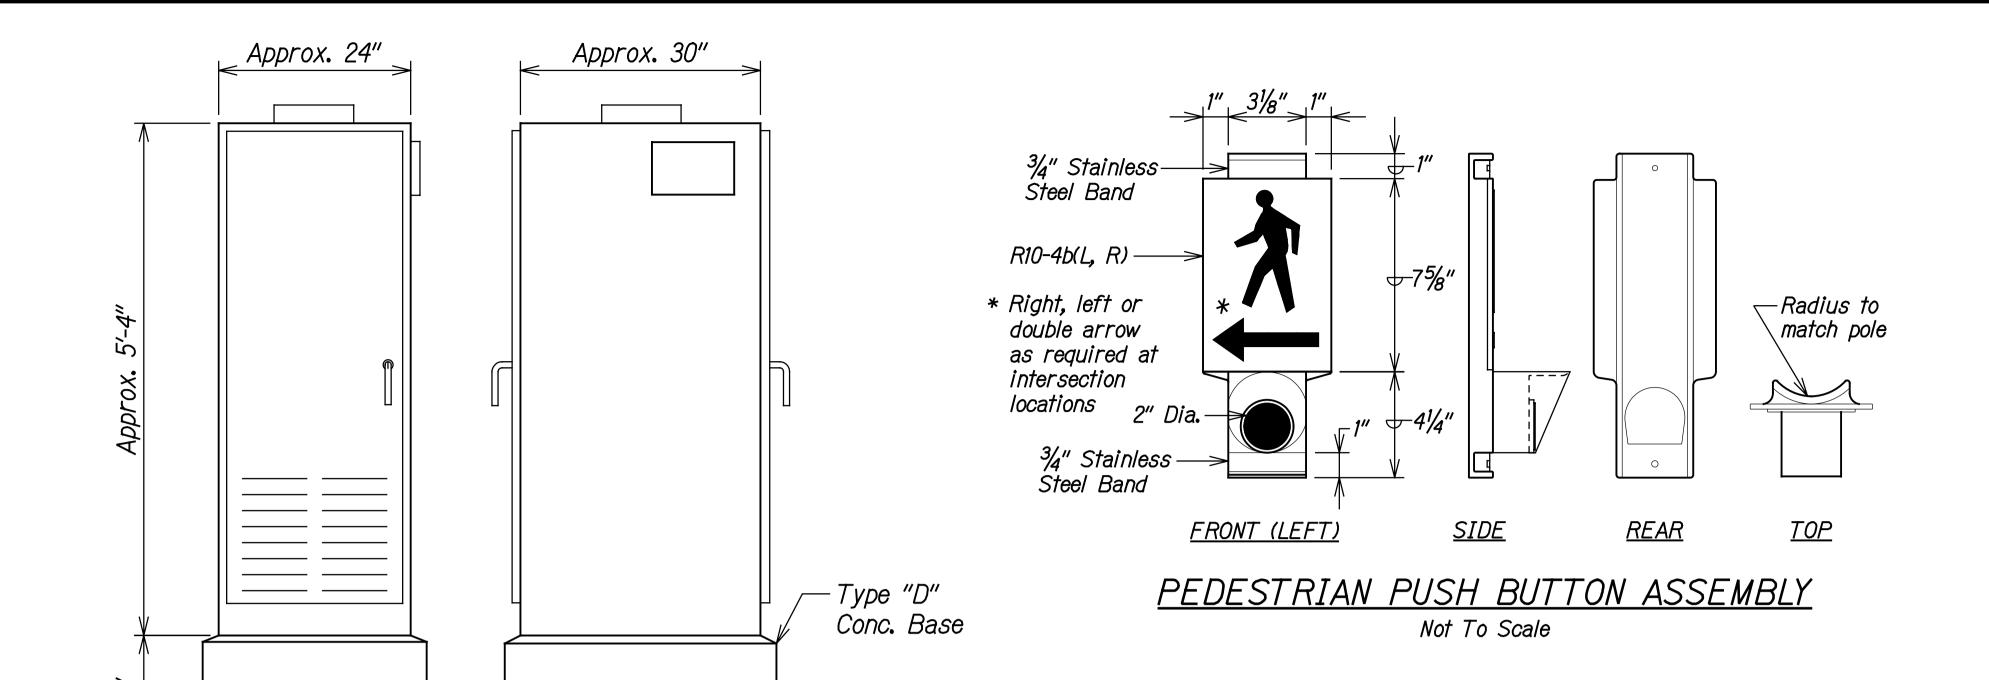

 \bigwedge

- Finished

Grade

Pedestrian Push
Button Assembly

*Walking man symbol with arrow as shown on plan.

HAWAII HAW. 901A-01-19 2020 ADD. 114 167

Traffic Signal Standard

Top of Sidewalk or Finished Grade

STATE

FISCAL SHEET YEAR NO.

SHEETS

PROJ. NO.

PEDESTRIAN AND AUDIO PEDESTRIAN PUSH BUTTON PLACEMENT

FED. ROAD DIST. NO.

Not To Scale


FRONT VIEW

SIDE VIEW

TYPE 332A CABINET

Not To Scale

			CONCRETE BASE SCHEDULE		
Intersection	l	Standard	Concrete Base	Ground Water	Soil Type
Fort Barette Rd.	Type A	Type I-10	Standard Plan TE-32	Walti	
/Roosevelt Ave.	C	II-28	Standard Plan TE-33A.2	Above	Stiff Silty
	С	II-32	Standard Plan TE-33A.2	Above	Clay over Silty
	С	II-35	Standard Plan TE-33A.2	Above	Coral Sand
	С	II-37	Standard Plan TE-33A.2	Above	and Gravel over Coral
					Formation
	D	Controller	Department of Transportation Standard Plan TS-15		
Fort Barette Rd.		<i>I-3</i>	Standard Plan TE-32		
/Kapolei Pkwy.	Α	I-10	Standard Plan TE-32		
	С	II-50	See Drilled Foundation For Traffic		
			Signal, Sheet TS-16		
	C	II-60	See Drilled Foundation For Traffic Signal, Sheet TS-16		

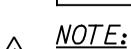

See Traffic Signal Foundation General Notes on sheet TS-16. The Contractor shall be responsible to coordinate the foundation with the Traffic Signal Standards provided; any changes required to the foundation due to the latest interim revisions and as modified by HDOT's memorandum with subjet title "Changes to Design Criteria for Bridge and Structure" (Letter No. Hwy-DB 2.5098) dated January 8, 2018 and shall be designed by a Structural Engineer licensed in the State of Hawaii. All design and construction costs for these changes shall be borne by the Contractor.



Use Metal Nipple When Detector Assembly Is Mounted On Pedestal, - Detector Cable Signal Head Framework, Apply Teflon Brand Or Mast Arm — Tape To Threads Before Mounting (Bottom View) O ým -Knock Out Weep Hole Before Installing Detector Reception Angle Varies With Distance. It Is Approximately 8° at 1800 Feet (0.54km). Due To Maximum Reflection Reception, Angle Is Range Is 1800 Feet Increased At Close Range. The (0.54 KM) Detector must be Aligned Within - Detector 8° of The Farthest Point Where Alignment Priority Vehicle Is To Be Sensed. Angle

TYPICAL MAST ARM INSTALLATION


OF EVP DETECTOR

Not To Scale

Date

Approved:

Chief, Traffic Signals & Technology Division, DTS

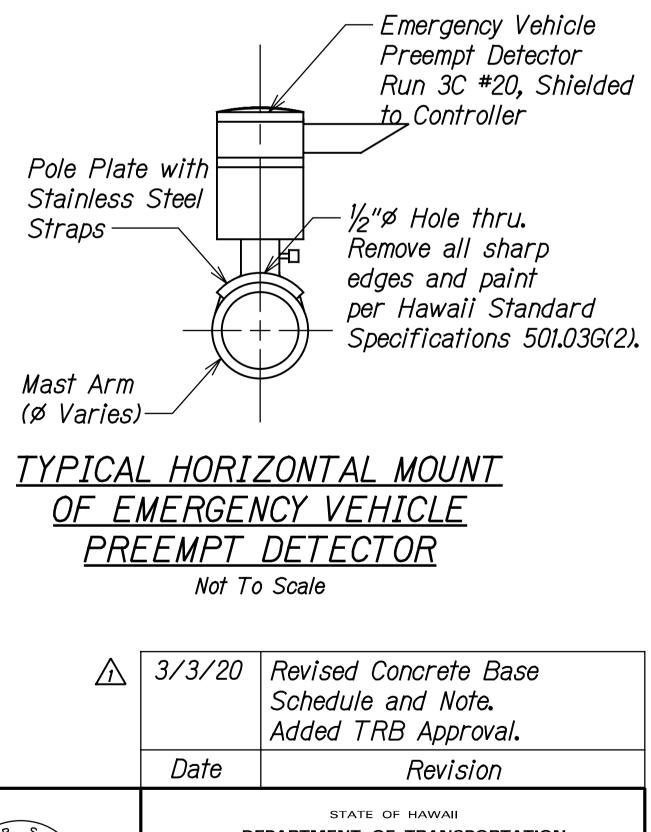

THIS WORK WAS PREPARED BY ME
OR UNDER MY SUPERVISION.

STATE OF HAWAII

DEPARTMENT OF TRANSPORTATION

HIGHWAYS DIVISION

MISCELLANEOUS DETAILS

FORT BARRETTE ROAD OPERATIONAL IMPROVEMENTS

Roosevelt Avenue to Farrington Highway

Project No. 901A-01-19

Scale: NTS

Date: Jan. 2020


SHEET No. *TS-11* OF *16* SHEETS




FED. ROAD DIST. NO.	STATE	PROJ. NO.	FISCAL YEAR	SHEET NO.	TOTAL SHEETS
HAWAII	HAW.	901A-01-19	2020	ADD. 115	167

SIDEWALK RECONSTRUCTION NOTES:


- Pavement structure shall be equal to or better than existing in thickness and quality.
- 2. For road grades 0% to 7.99% Prime Coat is not required.
- 3. All disturbed pavement markings shall be replaced and all required utility adjustments such as manhole covers etc. shall be done by the Permittee.
- 4. All required A.D.A. Improvements shall be undertaken by the Permittee.
- 5. Permittee shall coordinate work with all other utility entities and the Department of Facility Maintenance.
- 6. For minimum utility depths within the City's road rights-of-way, See Engineering and Policy Memorandum No. CEB-1-08, dated Feb. 15, 2008.
- 7. Contractor shall comply with the City Administration's Memorandum, dated September 30, 2004, regarding Trenching Permits and Repaving of Streets.
- 8. Joints within reconstructed sidewalk shall comply with the requirements of the City and County of Honolulu "Engineering and Policy Memorandum" No. CEB-1-09" dated April 6, 2009.

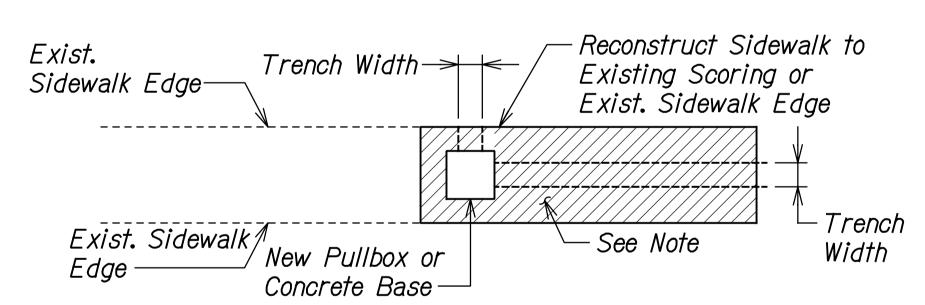

AT SINGLE BLOCK-WIDTH SIDEWALKS

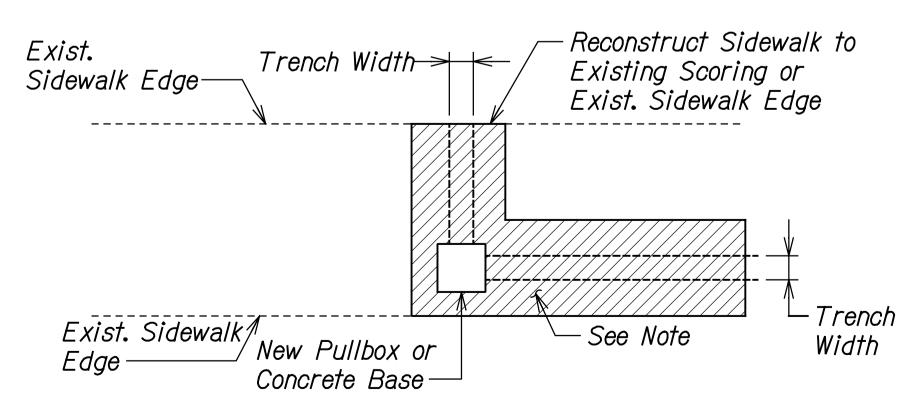

AT MULTIPLE BLOCK-WIDTH SIDEWALKS SIDEWALK RECONSTRUCTION DETAILS Not to Scale

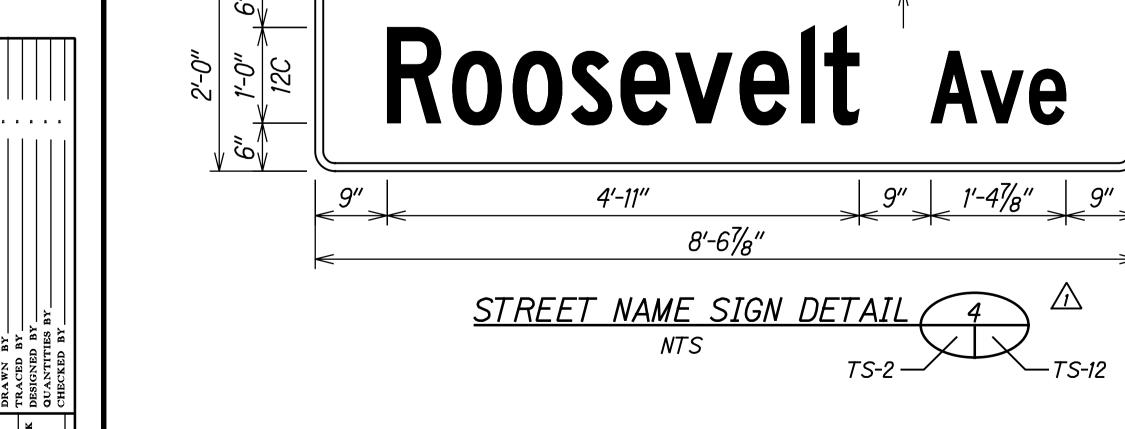

2'-61/4"

2'-45/8"

Swing

Bracket -

Swing

Bracket -

2'-45/8"

Enterprise St

8'-2"

2'-61/4"

5′-2″

STREET NAME SIGN DETAIL

2'-45/8"

9" 9" 9"

2'-61/4"

— 1", Typ.

____ 1", Typ.

R=21/2"

- R=2½"

(Typ.)

(Typ.)

Approved:

Chief, Traffic Review Branch, DPP


Date


Added Street Name Sign Details. Added TRB Approval. Revision **DEPARTMENT OF TRANSPORTATION** LICENSED PROFESSIONAL ENGINEER TRENCHING AND MISCELLANEOUS DETAILS FORT BARRETTE ROAD OPERATIONAL IMPROVEMENTS THIS WORK WAS PREPARED BY ME OR UNDER MY SUPERVISION. Roosevelt Avenue to Farrington Highway

Project No. 901A-01-19 Date: Jan. 2020

Scale: NTS

SHEET No. TS-12 OF 16 SHEETS ADD. 115

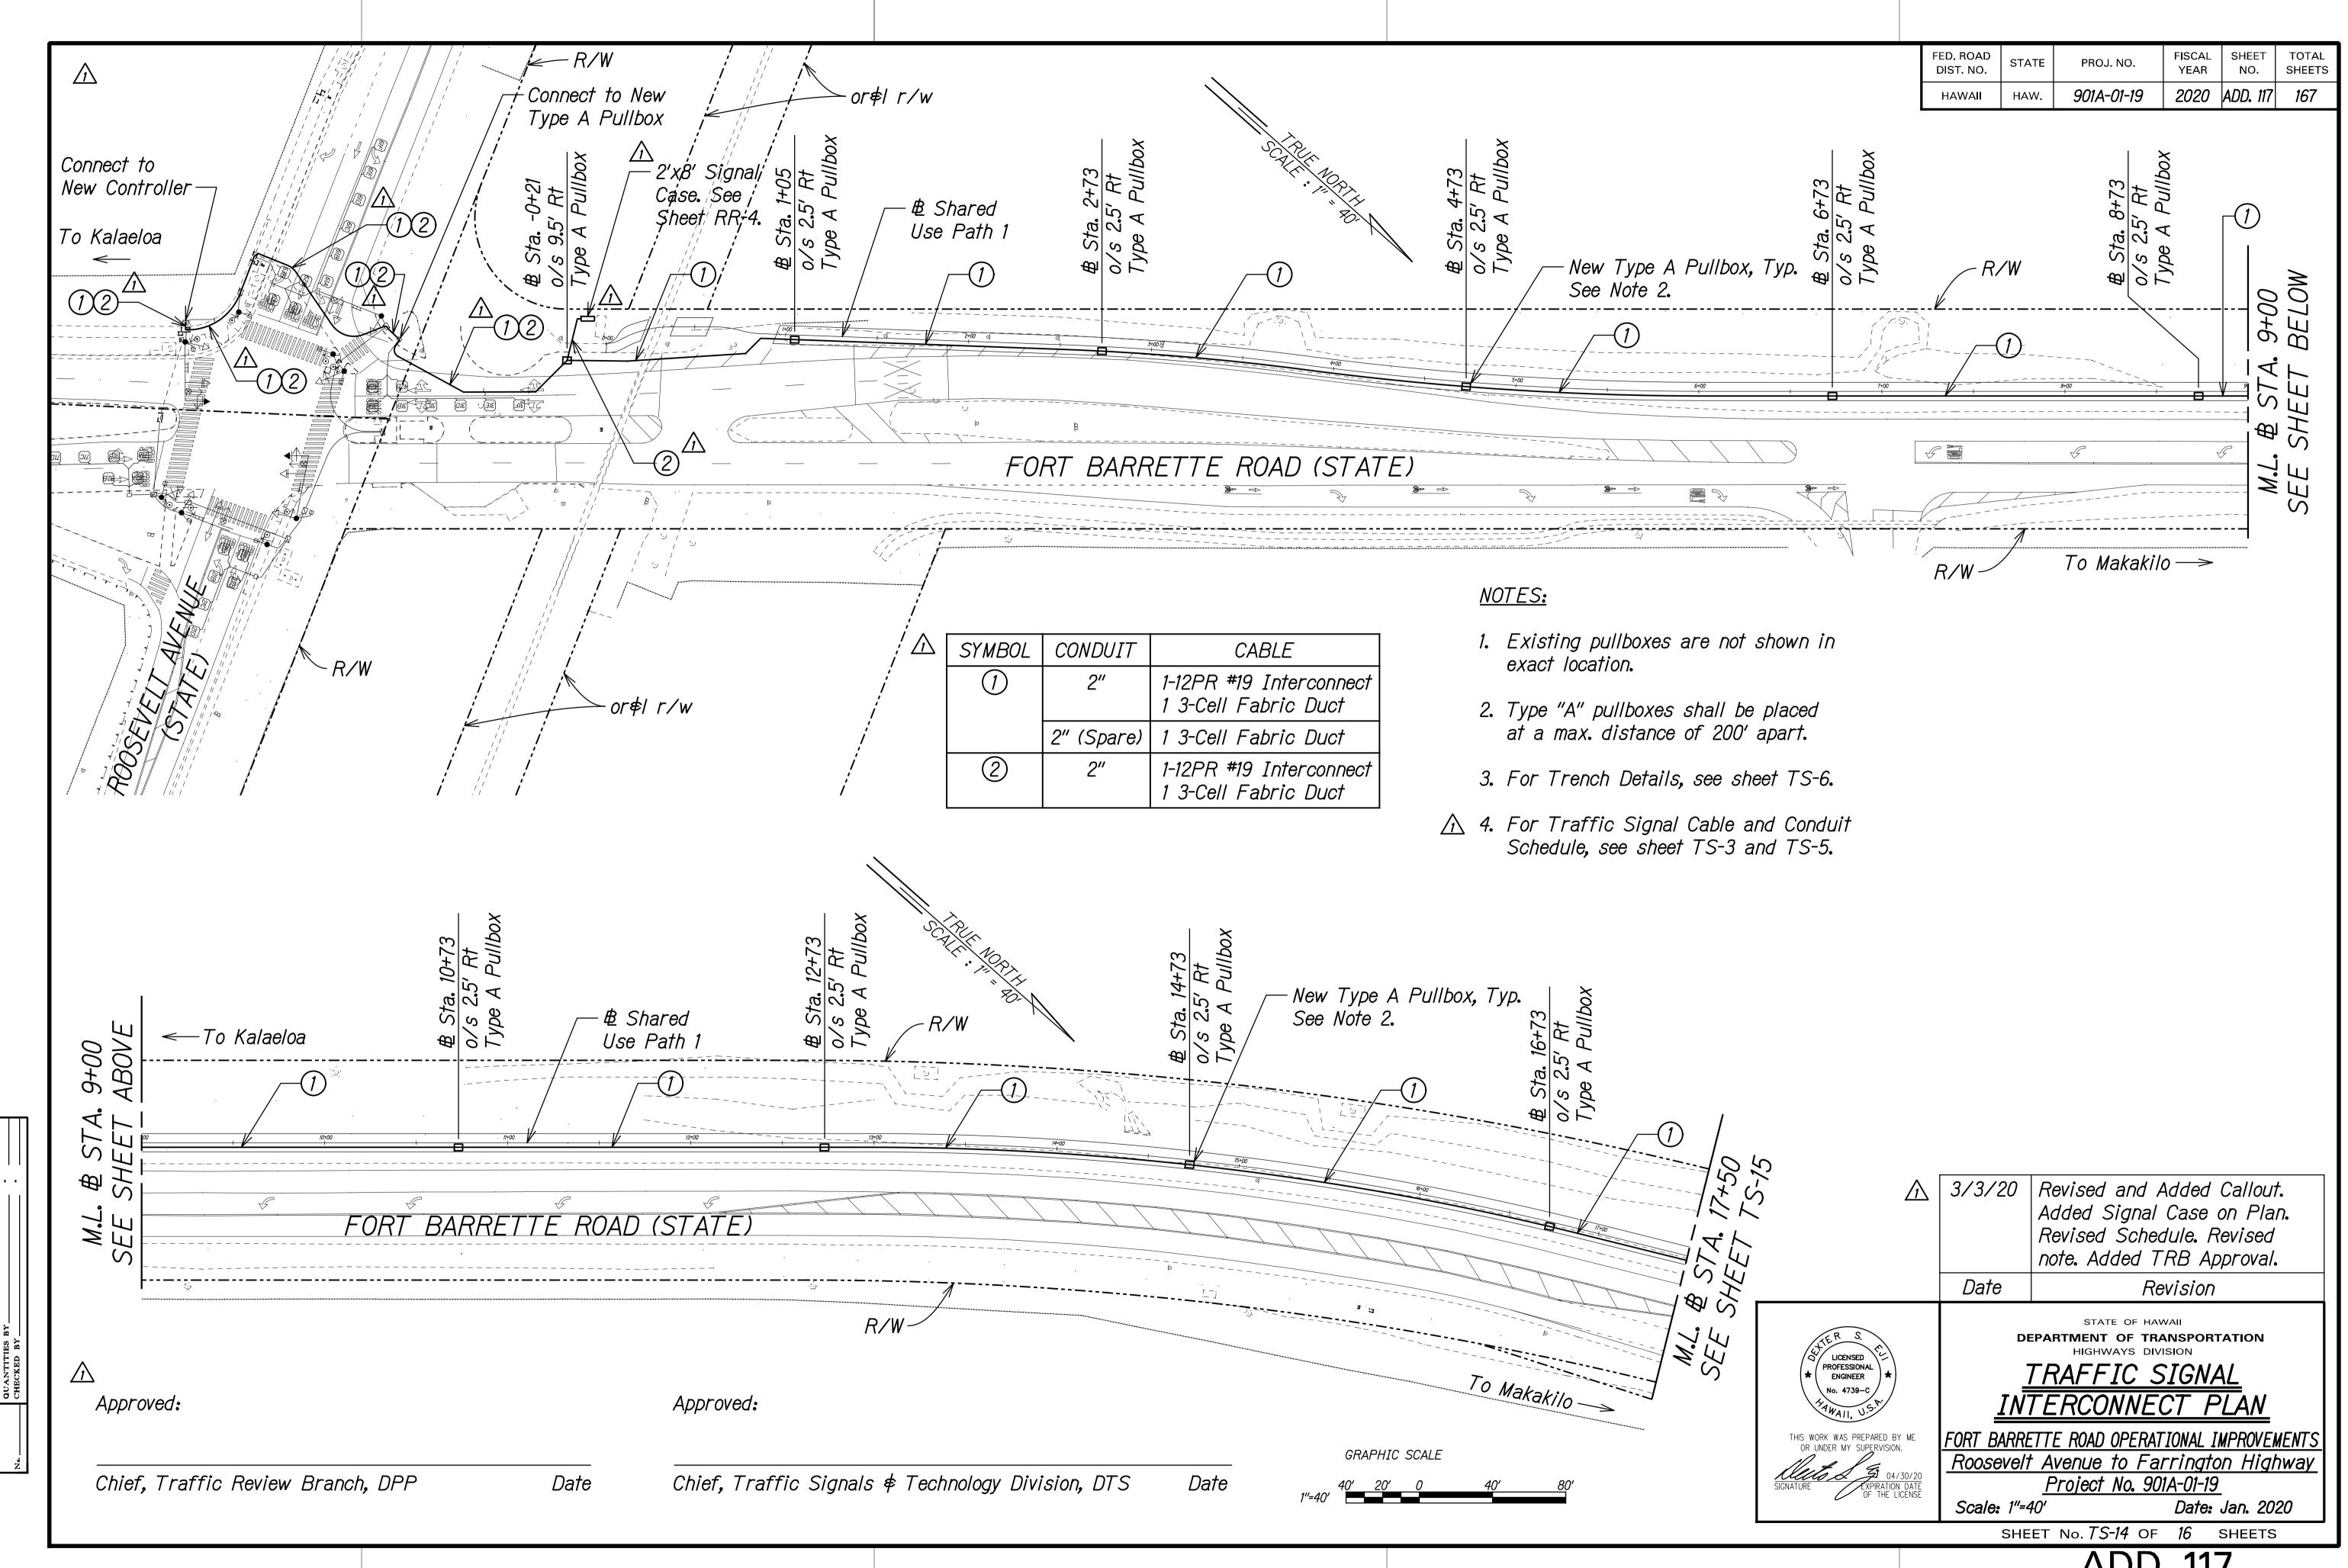

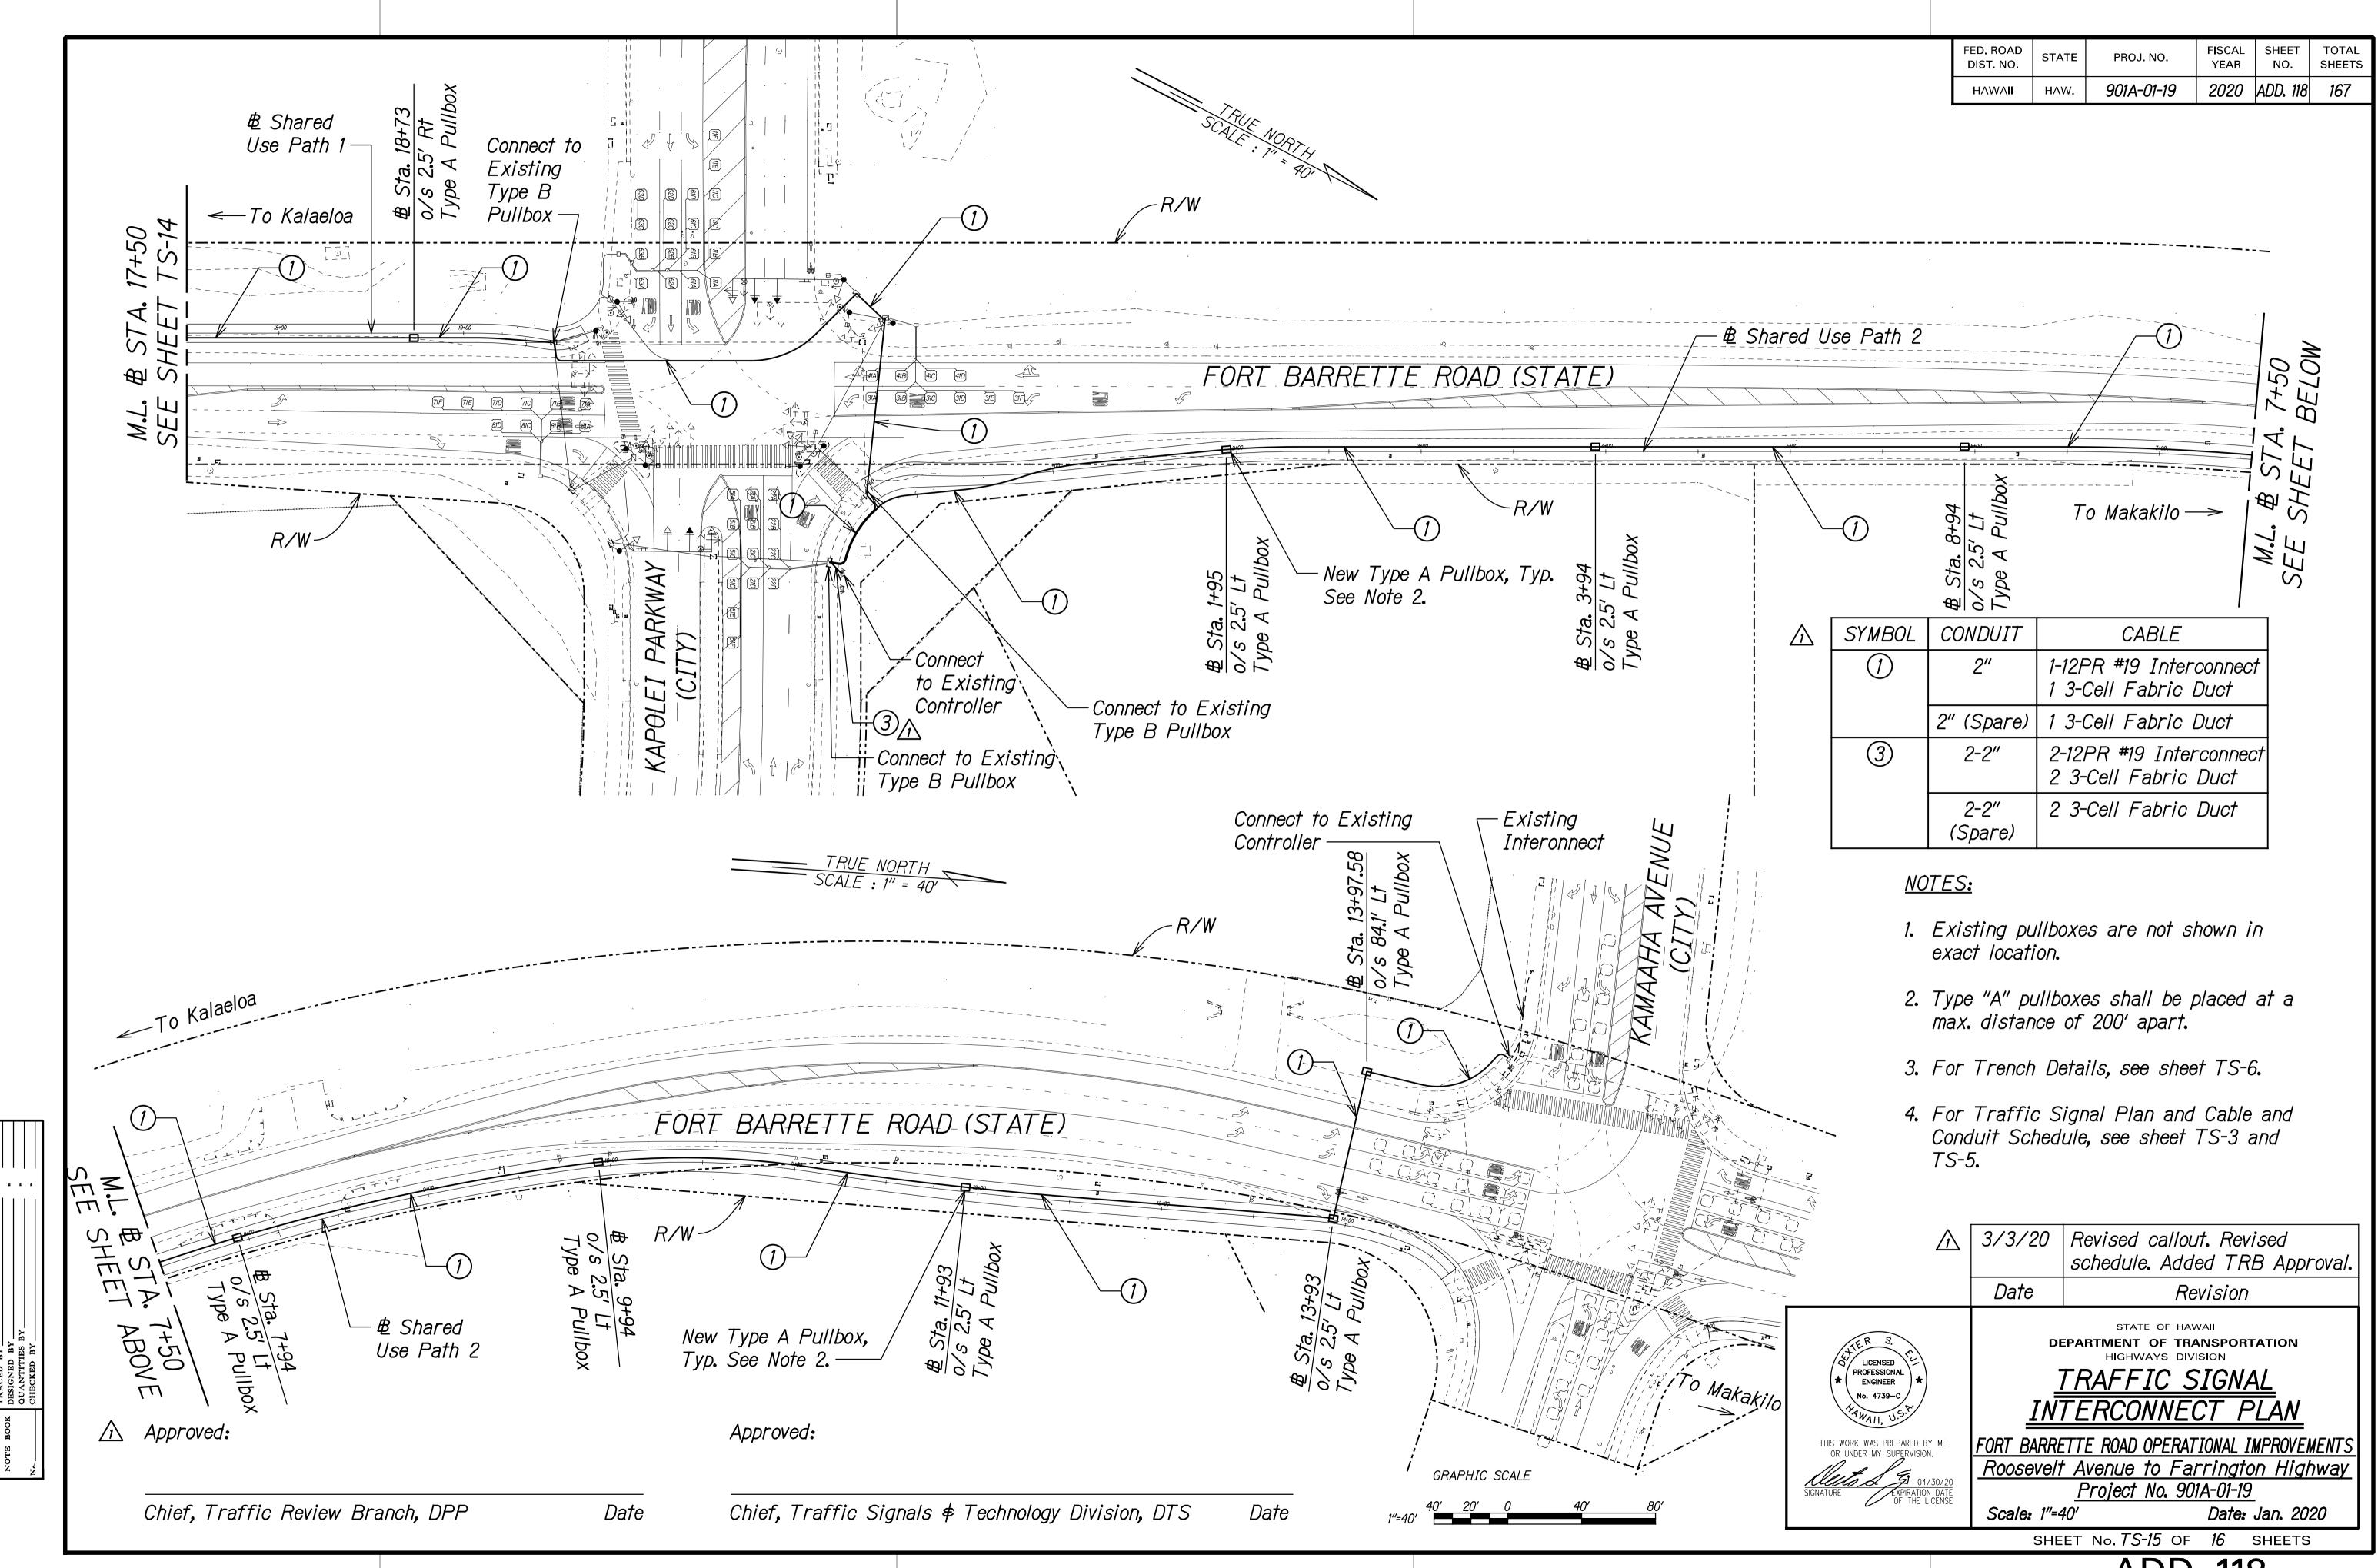

TRAFFIC SIGNAL FOUNDATION GENERAL NOTES:

<u>Design Specifications:</u>

- A. American Association of State Highway and Transportation Officials (AASHTO) 2017 LRFD Bridge Design Specifications, Eigth Edition, including the 2015 Interim revision edition as amended by Hawaii Department of Transportation (HDOT) document dated August 8, 2014 with subject title "Design Criteria for Bridges and Structures" and HDOT memorandum dated January 8, 2018 with subject title "Changes to Design Criteria for Bridges and Structures".
- B. Design shall conform with the AASHTO LRFD Specifications for Structural Supports for Highway Signs, Luminaires, and Traffic Signals, First Edition 2015 with 2020 Interim Revisions.
- C. See Structural General Notes on Sheet S0.0 for further information. Loads:
- A. Basic Wind Speed: 145 mph.
 - Recurrence Interval of 1700 years.
 - C. Fatigue importance factor, I_f , shall be based on Fatigue Category I for cantilevered traffic signal structures.
 - D. Vortex shedding induced loads shall be considered for cantilevered mast arms and pole shafts that do not have tapers or have tapers of less than 0.14 in/ft.
 - E. Traffic signal structures shall be designed for a truck induced gust based on a truck speed of 20 mph over the posted speed.
 - F. Galloping and natural wind gusts shall be considered for cantilevered traffic signal structures.
 - G. Natural Wind Gusts shall be considered for all traffic signal structures.

3. <u>Materials:</u>


- A. Concrete for traffic signal foundation shall develop a minimum 28-day compressive strength of 4,500 psi with a maximum w/c ratio of 0.45.
- B. All concrete shall contain corrosion inhibitor. Dosage shall be as recommended by the manufacturer. 🛆
- C. All reinforcing steel shall be ASTM A615 Grade 60 deformed bars unless otherwise noted.
- D. All connection bolts shall be AASHTO M164 bolts and anchor bolts shall be AASHTO M314-105 bolt.
- E. Aluminum members and surfaces in contact with structural steel shall be isolated with neoprene material as approved by the Engineer.

4. General:


- A. The recommendations of the traffic pole manufacturer shall be followed. Manufacturer shall select pole, anchor bolts, etc. based on criteria given in the contract documents. The Contractor shall submit catalog cuts and calculations to the Engineer for approval.
- B. The Contractor shall use templates while installing the anchor bolts. Anchor bolts shall be vertical.
- C. The Contractor shall adjust the spiral vertical spacing to allow installation of anchor bolts and plates.
- D. Wire cloth shall be galvanized steel standard grade plain weave 2x2 mesh 0.063 inch diameter wires. Wrap around base plate perimeter with 3" minimum lap. Fasten with $\frac{1}{4}$ " diameter capscrew ASTM F593 with SS washer spaced at approximately 9" o.c., drilled and tapped into perimeter of base plate.

Geotechnical Notes:

- A. Soil profile consists of very stiff silty clay over silty coral sand and gravel over coral formation.
- B. Assumed Undrained Cohesion of Soil 3,000 psf (20.8 psi)
- C. Assumed Youngs Modulus of Soil = 5,000 psi
- D. Assumed Poisson's Ratio = 0.3
- E. Design Loads:
 - i. Max. Moment = 338 ^{k-ft}.
 - ii. Max. Shear = 11.41 k

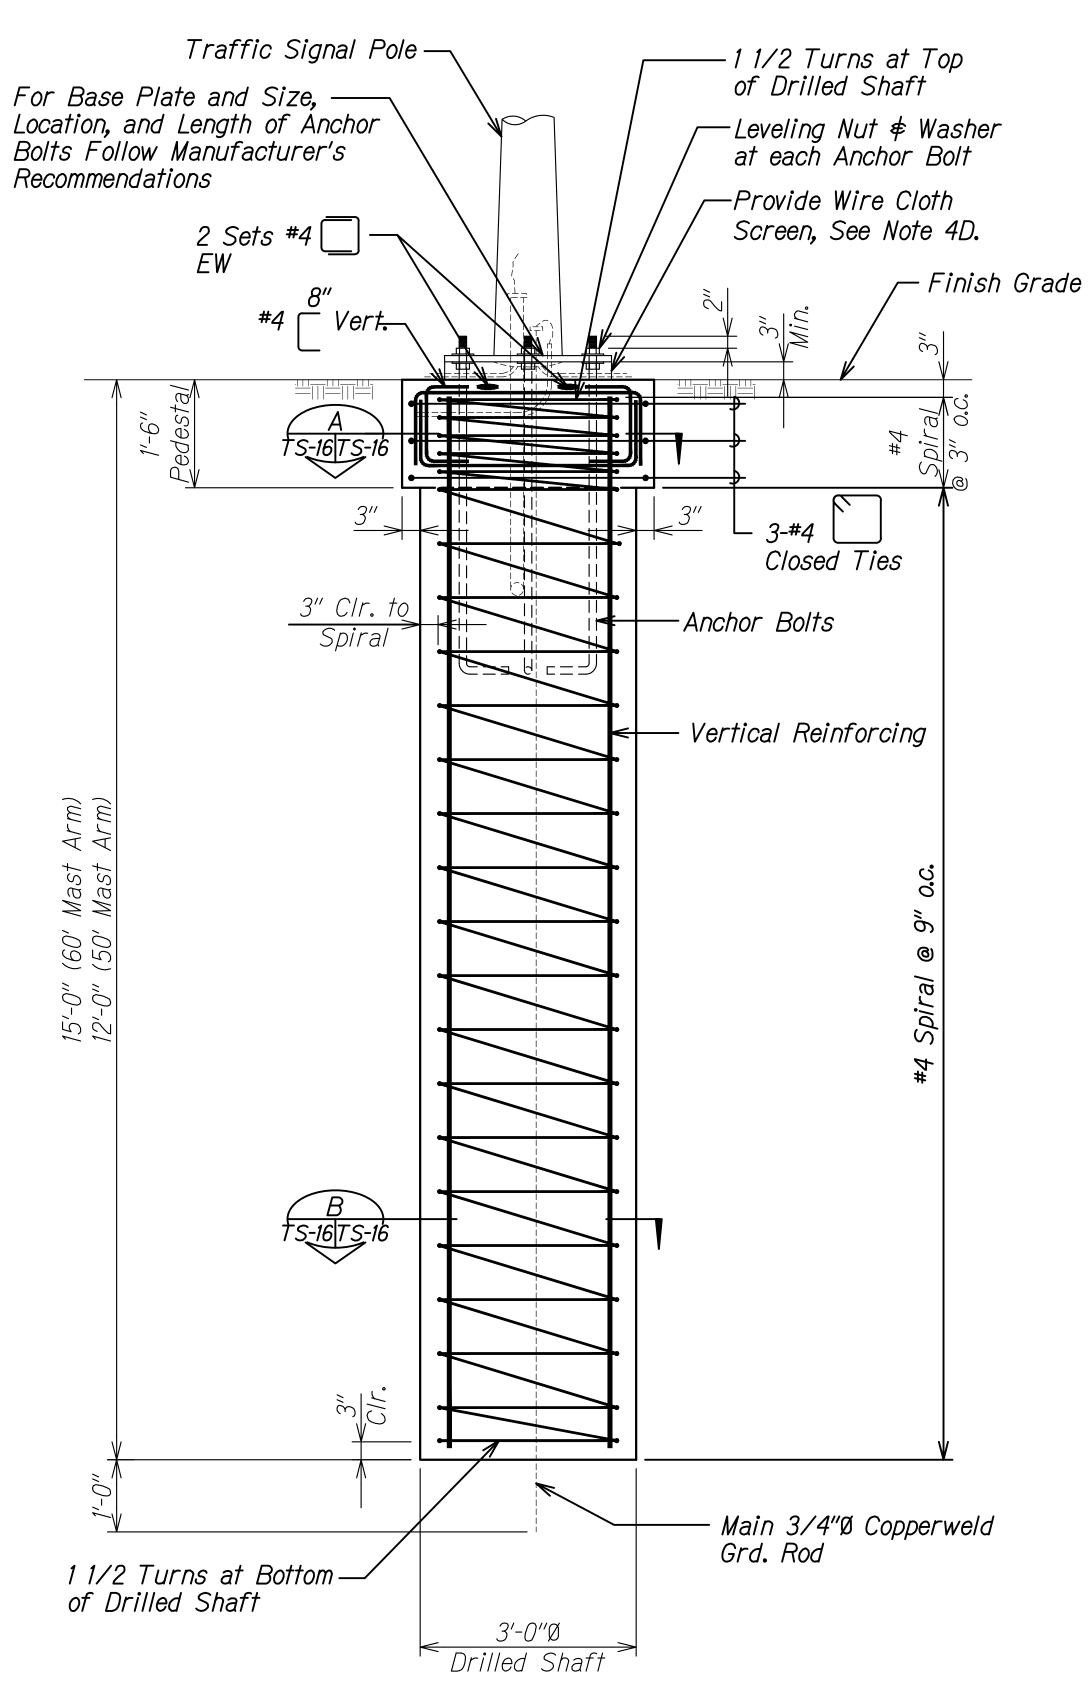

ELEVATION Scale: 3/4" = 1'-0"

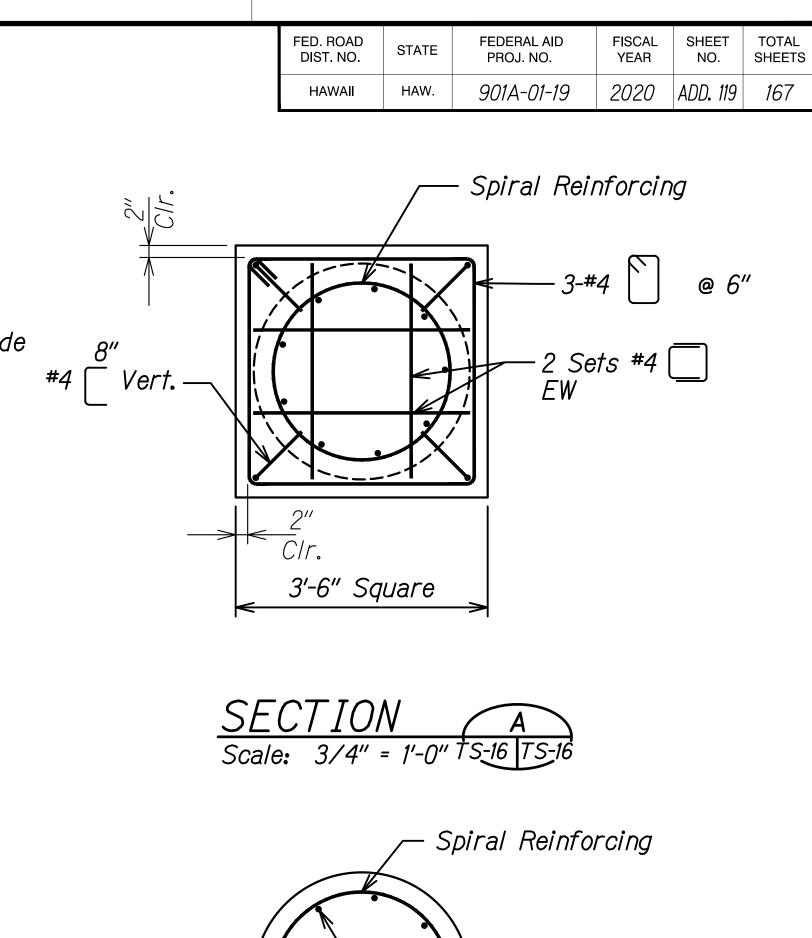


SECTION Scale: 3/4" = 1'-0" TS-16 TS-16

3′-0′′Ø

Drilled Shaft

NOTE:

Detail of conduits, anchor bolts, etc, are approximate only. Manufacturer's recommendations shall be followed. Contractor shall submit catalog cuts to the Engineer for approval.

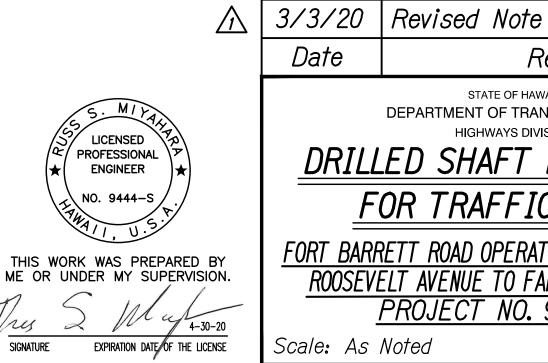

9-#10

Revision STATE OF HAWAI'I HIGHWAYS DIVISION DRILLED SHAFT FOUNDATION FOR TRAFFIC SIGNAL FORT BARRETT ROAD OPERATIONAL IMPROVEMENTS

3" Clr. to

Spiral Reinf.

ROOSEVELT AVENUE TO FARRINGTON HIGHWAY PROJECT NO. 901A-01-19 Scale: As Noted Date: Jan. 2020

SHEET No. TS-16 OF 16 SHEETS

FED. ROAD DIST. NO.	STATE	PROJ. NO.	FISCAL YEAR	SHEET NO.	TOTAL SHEETS
HAWAII	HAW.	901A-01-19	2020	ADD. 120	167

HAWAIIAN RAILWAY SOCIETY (HRS) NOTE:

CONSTRUCTION OF THIS RAILROAD AT-GRADE CROSSING SHALL BE COORDINATED WITH HRS (STEVE VENDT, 808-681-5461) FOR RAILROAD OPERATING SCHEDULE. CONSTRUCTION OF THE CROSSING SHALL BE DONE DURING WEEKDAYS (MON-FRI). THE TRACK SHALL BE IN SERVICE FOR ALL SCHEDULED TRAINS AND MAINTENANCE OPERATIONS. CONTRACTOR SHALL NOTIFY HRS AT LEAST TWO WEEKS PRIOR TO ANY TRACK CONSTRUCTION ACTIVITIES.

INDEX:

RR-1	HRS NOTE, INDEX, LEGEND AND ABBREVIATIONS
RR-2	TRACK PLAN AND PROFILE
RR-3	TRACK DETAILED CROSSING PLAN
RR-4	TYPICAL TRACK SECTIONS
RR-5	TYPICAL TRACK DETAILS
RR-6	FLASHING LIGHT SIGNAL AND GATE ARM
	INSTALLATION DETAIL
RR-7	CROSSING LOCATION PLAN
RR-8	XP4 CONTROL PLAN
RR-9	RECORDER PLAN
<i>RR-10</i>	GATE 1 AND PEDESTRIAN FLASHER 1 PLAN
<i>RR-11</i>	GATE 2 PLAN
RR-12	GATE 3 PLAN
<i>RR-13</i>	GATE 4 PLAN
<i>RR-14</i>	POWER DISTRIBUTION PLAN
<i>RR-15</i>	CASE LAYOUT PLAN
<i>RR-16</i>	RELAY PLAN

ABBREVIATIONS:

Main Track

Not in Contract

Point of Curve

Point on Curve

1/2" Point of Frog

Point of Intersection

Perforated

Other Track Material

Point of Compound Curve

Point of Curve to Spiral

Not to Scale

North

Number

Overhead

Pound

Manual on Uniform Traffic Control Devices

AAR	Association of American Railroads	PIT0	Point of Intersection of Turnout
AASHT0	American Association of State Highway	POB	Point of Beginning
	Transportation Officials	POTO	Power Operated Turnout
AB	Aggregate Base	PROP	Proposed
AC	Asphalt Concrete	PS	Point of Spiral
ARA	American Railway Association	PSC	Point of Spiral to Curve
ASCE	American Society of Civil Engineering	PT	Point of Tangent
AREMA	American Railway Engineering and	PTSW	Point of Switch
	Maintenance of Way Association	PVC	Point of Vertical Curve/Polyvinyl Chloride
AVE	Avenue	PPVI	Point of Vertical Intersection
BLDG	Building	PVT	Point of Vertical Tangent
Ę	Centerline	RH	Right Hand
CLR PT	Clear Point	RR	Railroad
Conc	Concrete	RT	Right
CWR	Continuous Welded Rail	Rwy	Railway
CY	Cubic Yards	R/W	Right of Way
*	Degree(s)	SCH	Schedule
DIA	Diameter	SECS	Seconds
DIA DR	Drive	SF	Square Feet
DWG	Drawing	SHT	Sheet
E	East	SLDR	Shoulder
EL	Elevation	S	South
EOT	End of Track	ST	Street
EXIST	Existing	STA	Station
LXISI	Foot, Feet or Minute(s)	STD	Standard
FG	Finished Grade	TC	Track Centers
HH	Head Hardened	TF	Track Feet
HORIZ	Horizontal	TO	Turnout
HTTO	Hand Throw Turnout	T/R	Top of Rail
П110 "	Inch, Inches or Seconds	TRK	Track
7	Total Intersection Angle	TYP	Typical
1 7 I	Insulated Joints	UG	Underground
IJ INV	Invert	VERT	Vertical
INV Jtd	Jointed Rail	V	Velocity
JIU	Length	V/L	Average Change in Gradient per 100'
L	Lineal Feet	W	West
LF	Left Hand	XING	Crossing
LH	Length of Spiral	XOVER	Cross-Over
LS	Left	XOVEN	CI USS UVGI
LT	Maximum		
MAX	Minimum		
MIN	Mile Marker		
MM			
MP	Miles Post		
MPH	Miles Per Hour		

SYMBOLS:

Flashing Light Warning Device

Flashing Light Warning Device


with Gate

Milepost

Milemarker

TRACKS:

Centerline of Track

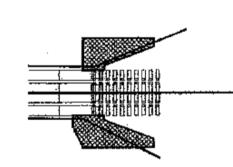


Typical Walkways at Grade Crossings

U.S. DOT CROSSING INVENTORY:

DOT: 918996X

⚠ RR MP: 19.71

ROAD: FT. BARRETTE ROAD

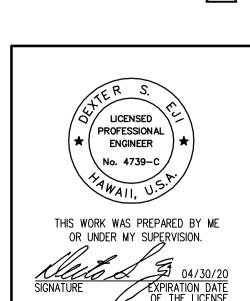

3/3/20 Revised Text.

Date Revision

STATE OF HAWAII
DEPARTMENT OF TRANSPORTATION
HIGHWAYS DIVISION

HRS NOTE, RAILROAD INDEX, LEGEND AND ABBREVIATIONS


FORT BARRETTE ROAD OPERATIONAL IMPROVEMENTS


Roosevelt Avenue to Farrington Highway


Project No. 901A-01-19


Scale: AS NOTED Date: Jan. 2020


SHEET No. RR-1 OF 16 SHEETS

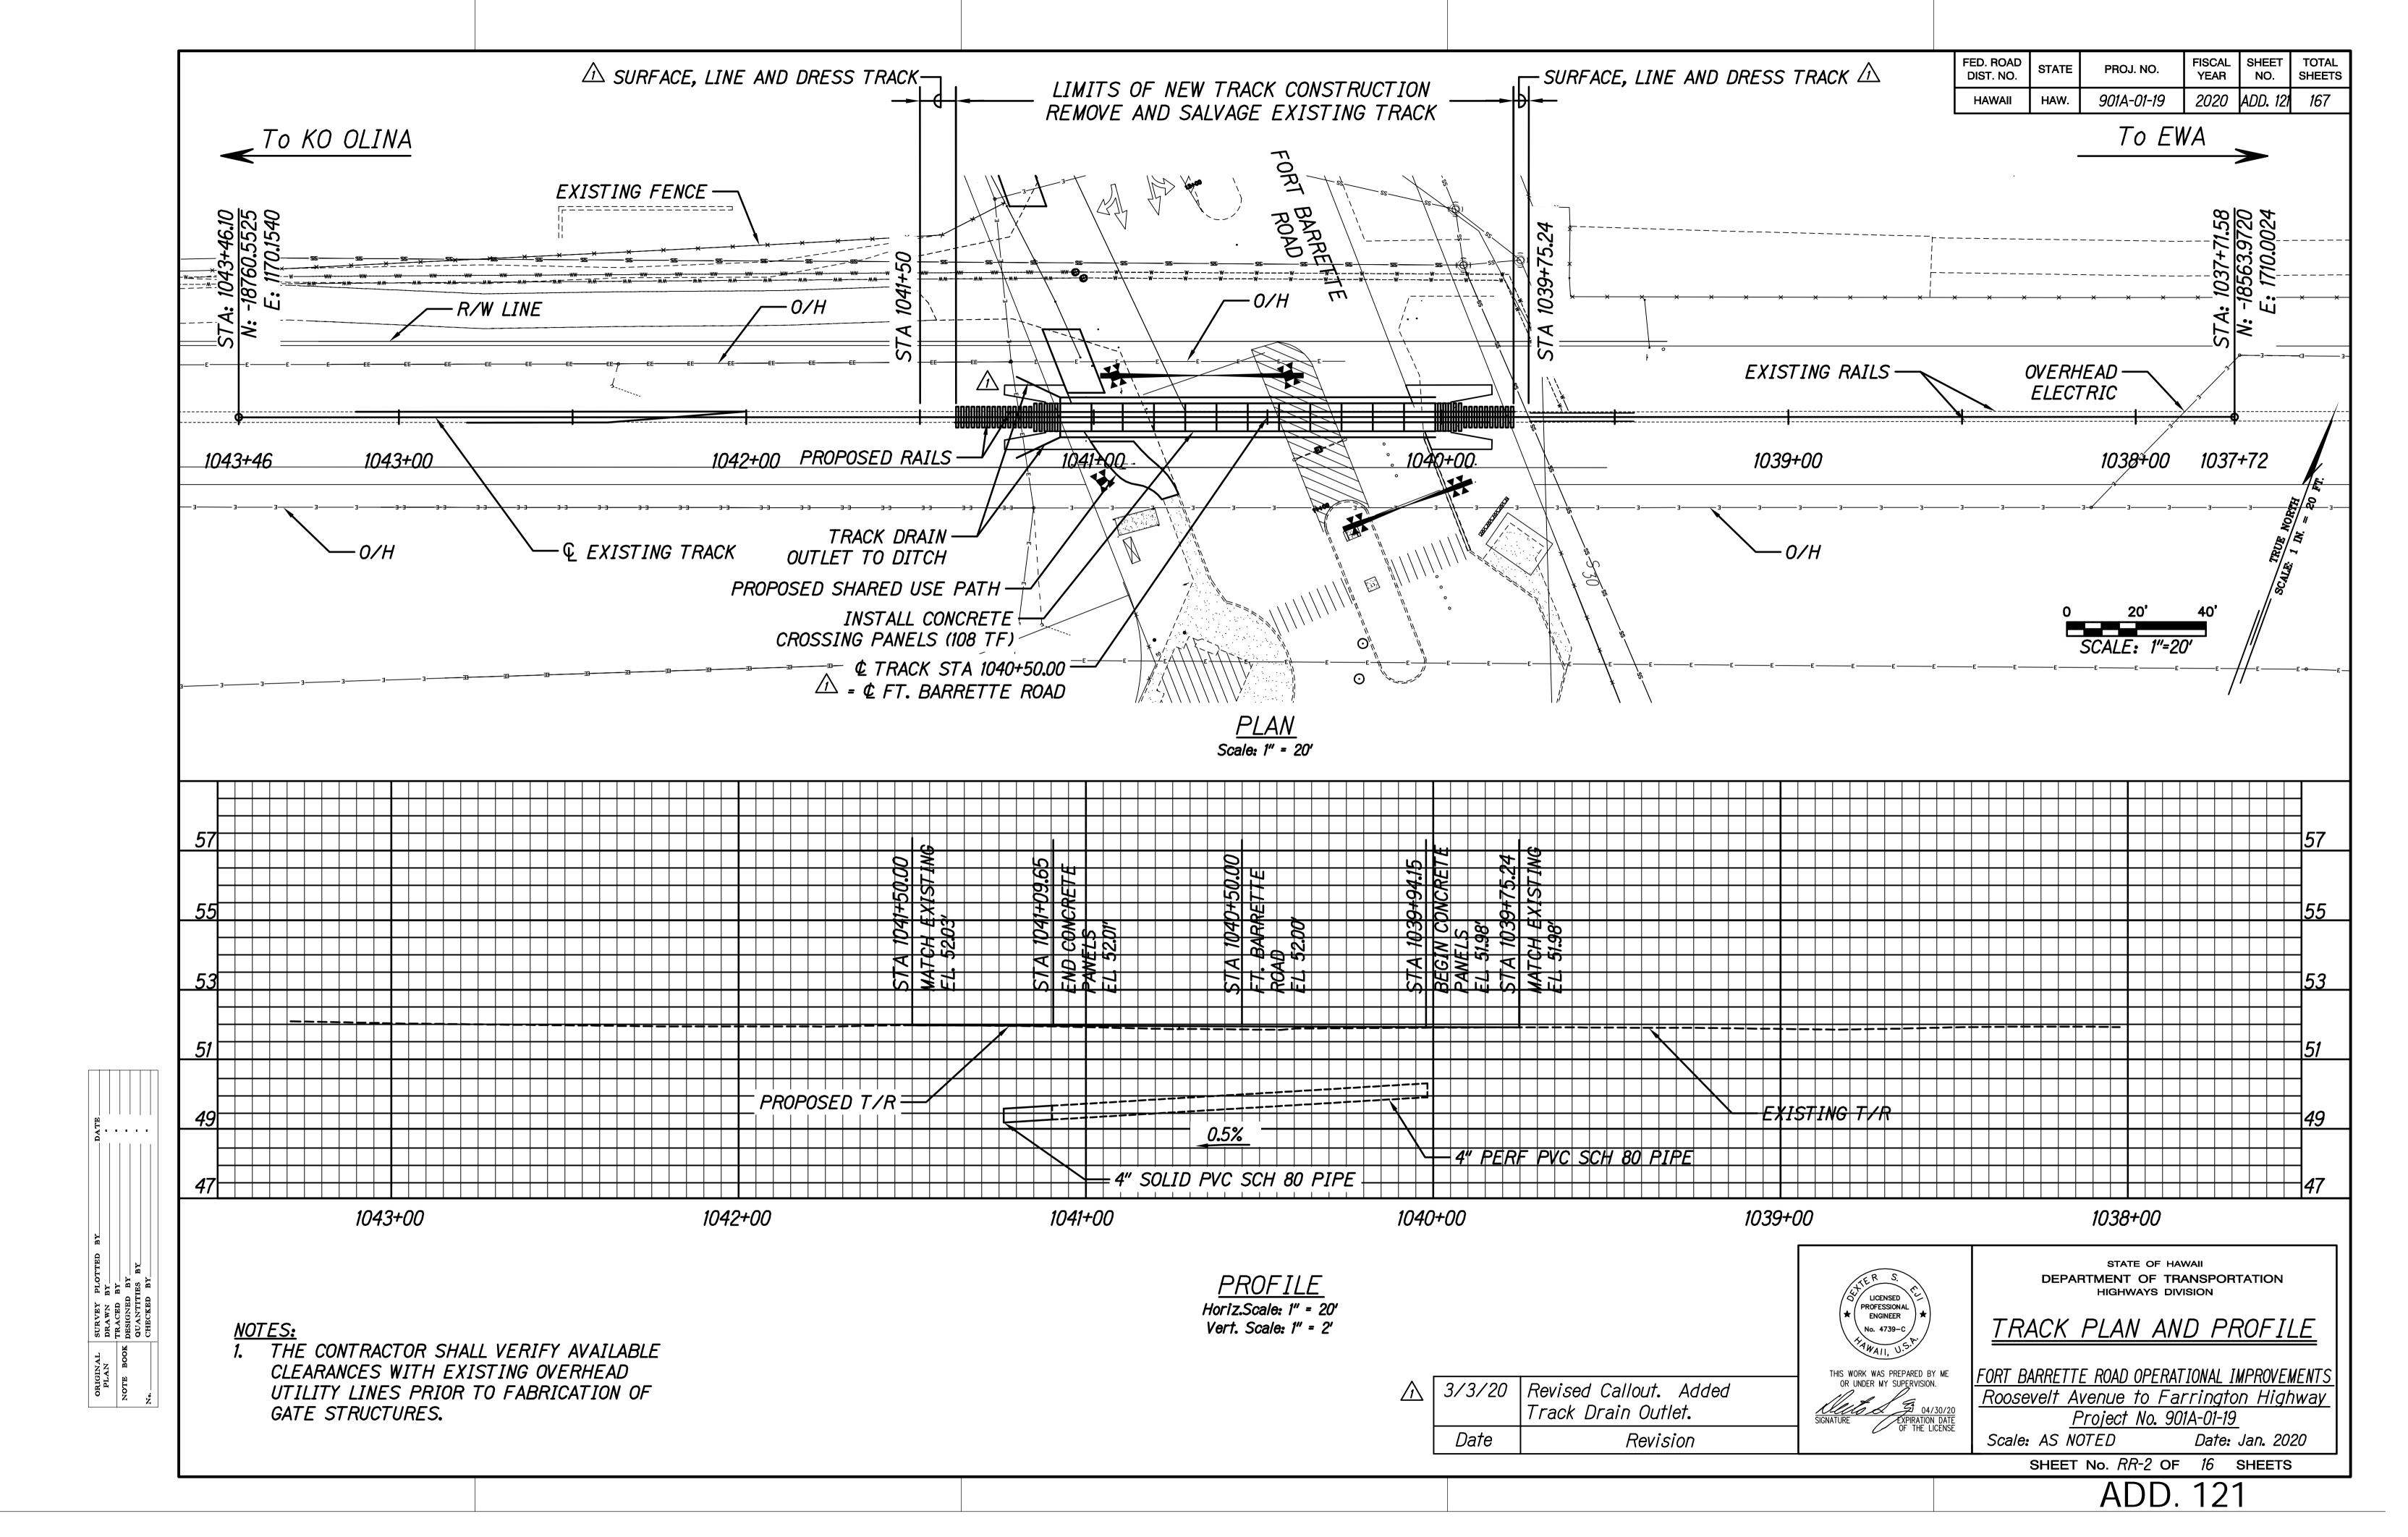

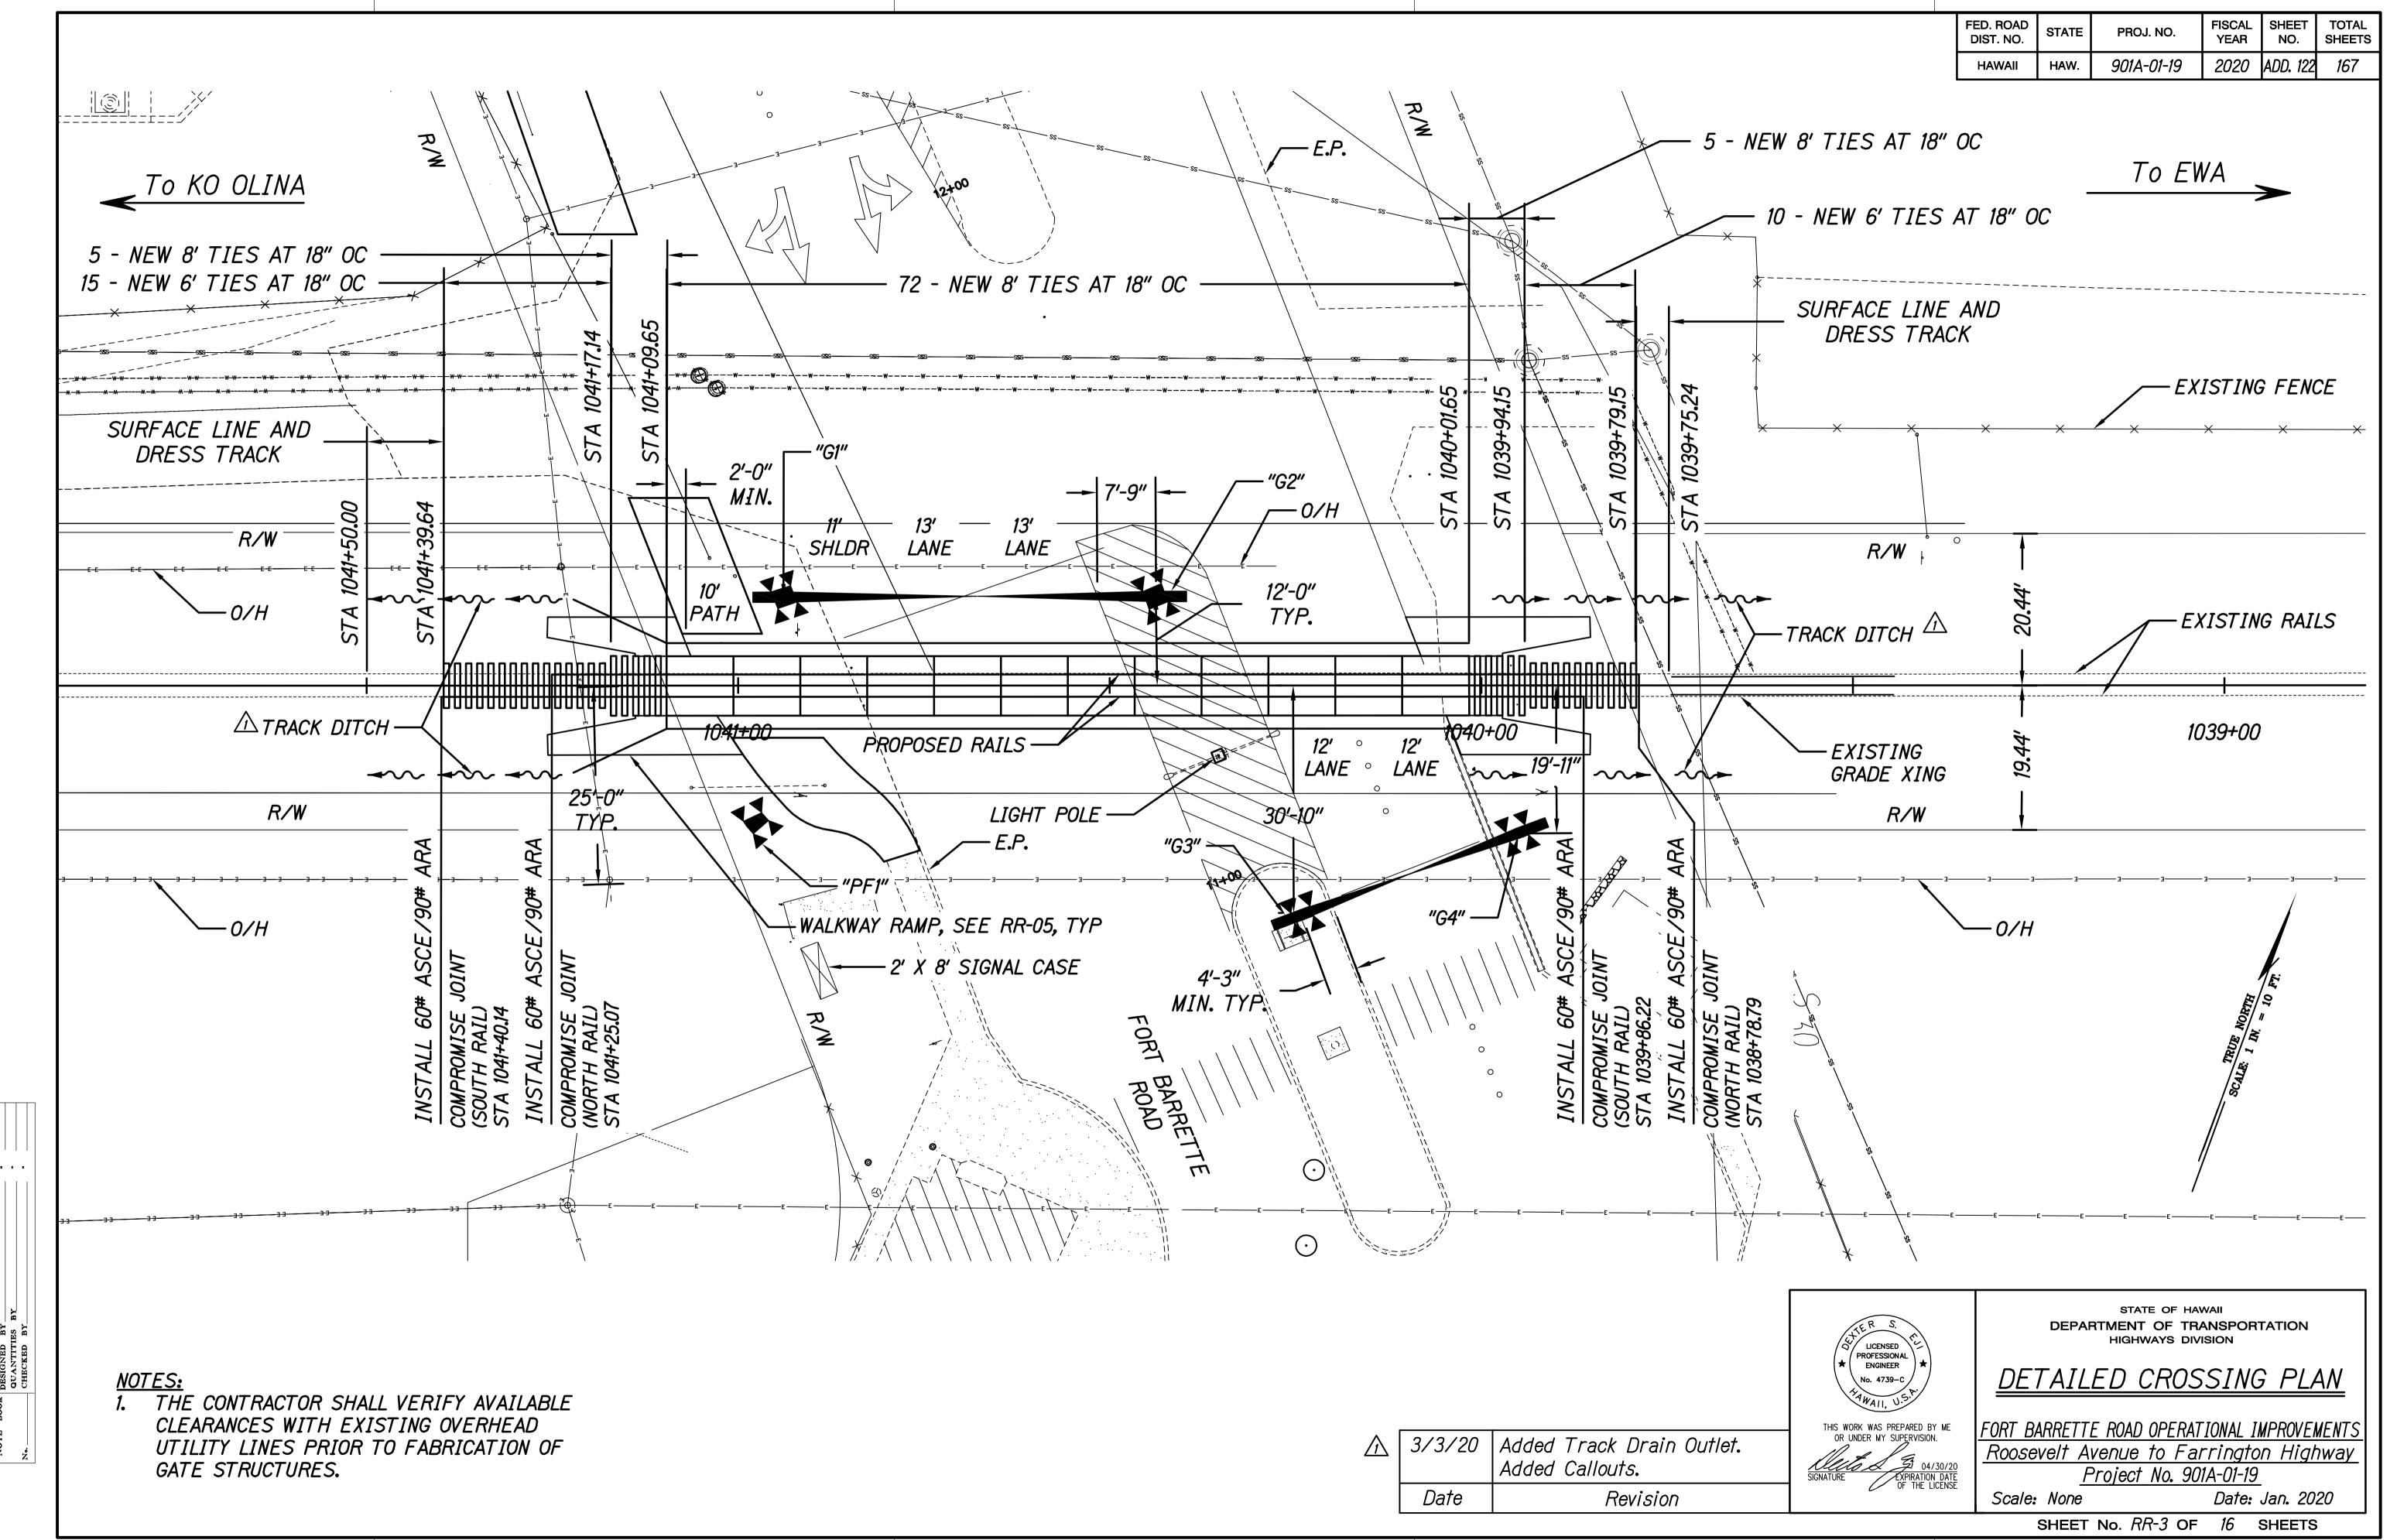

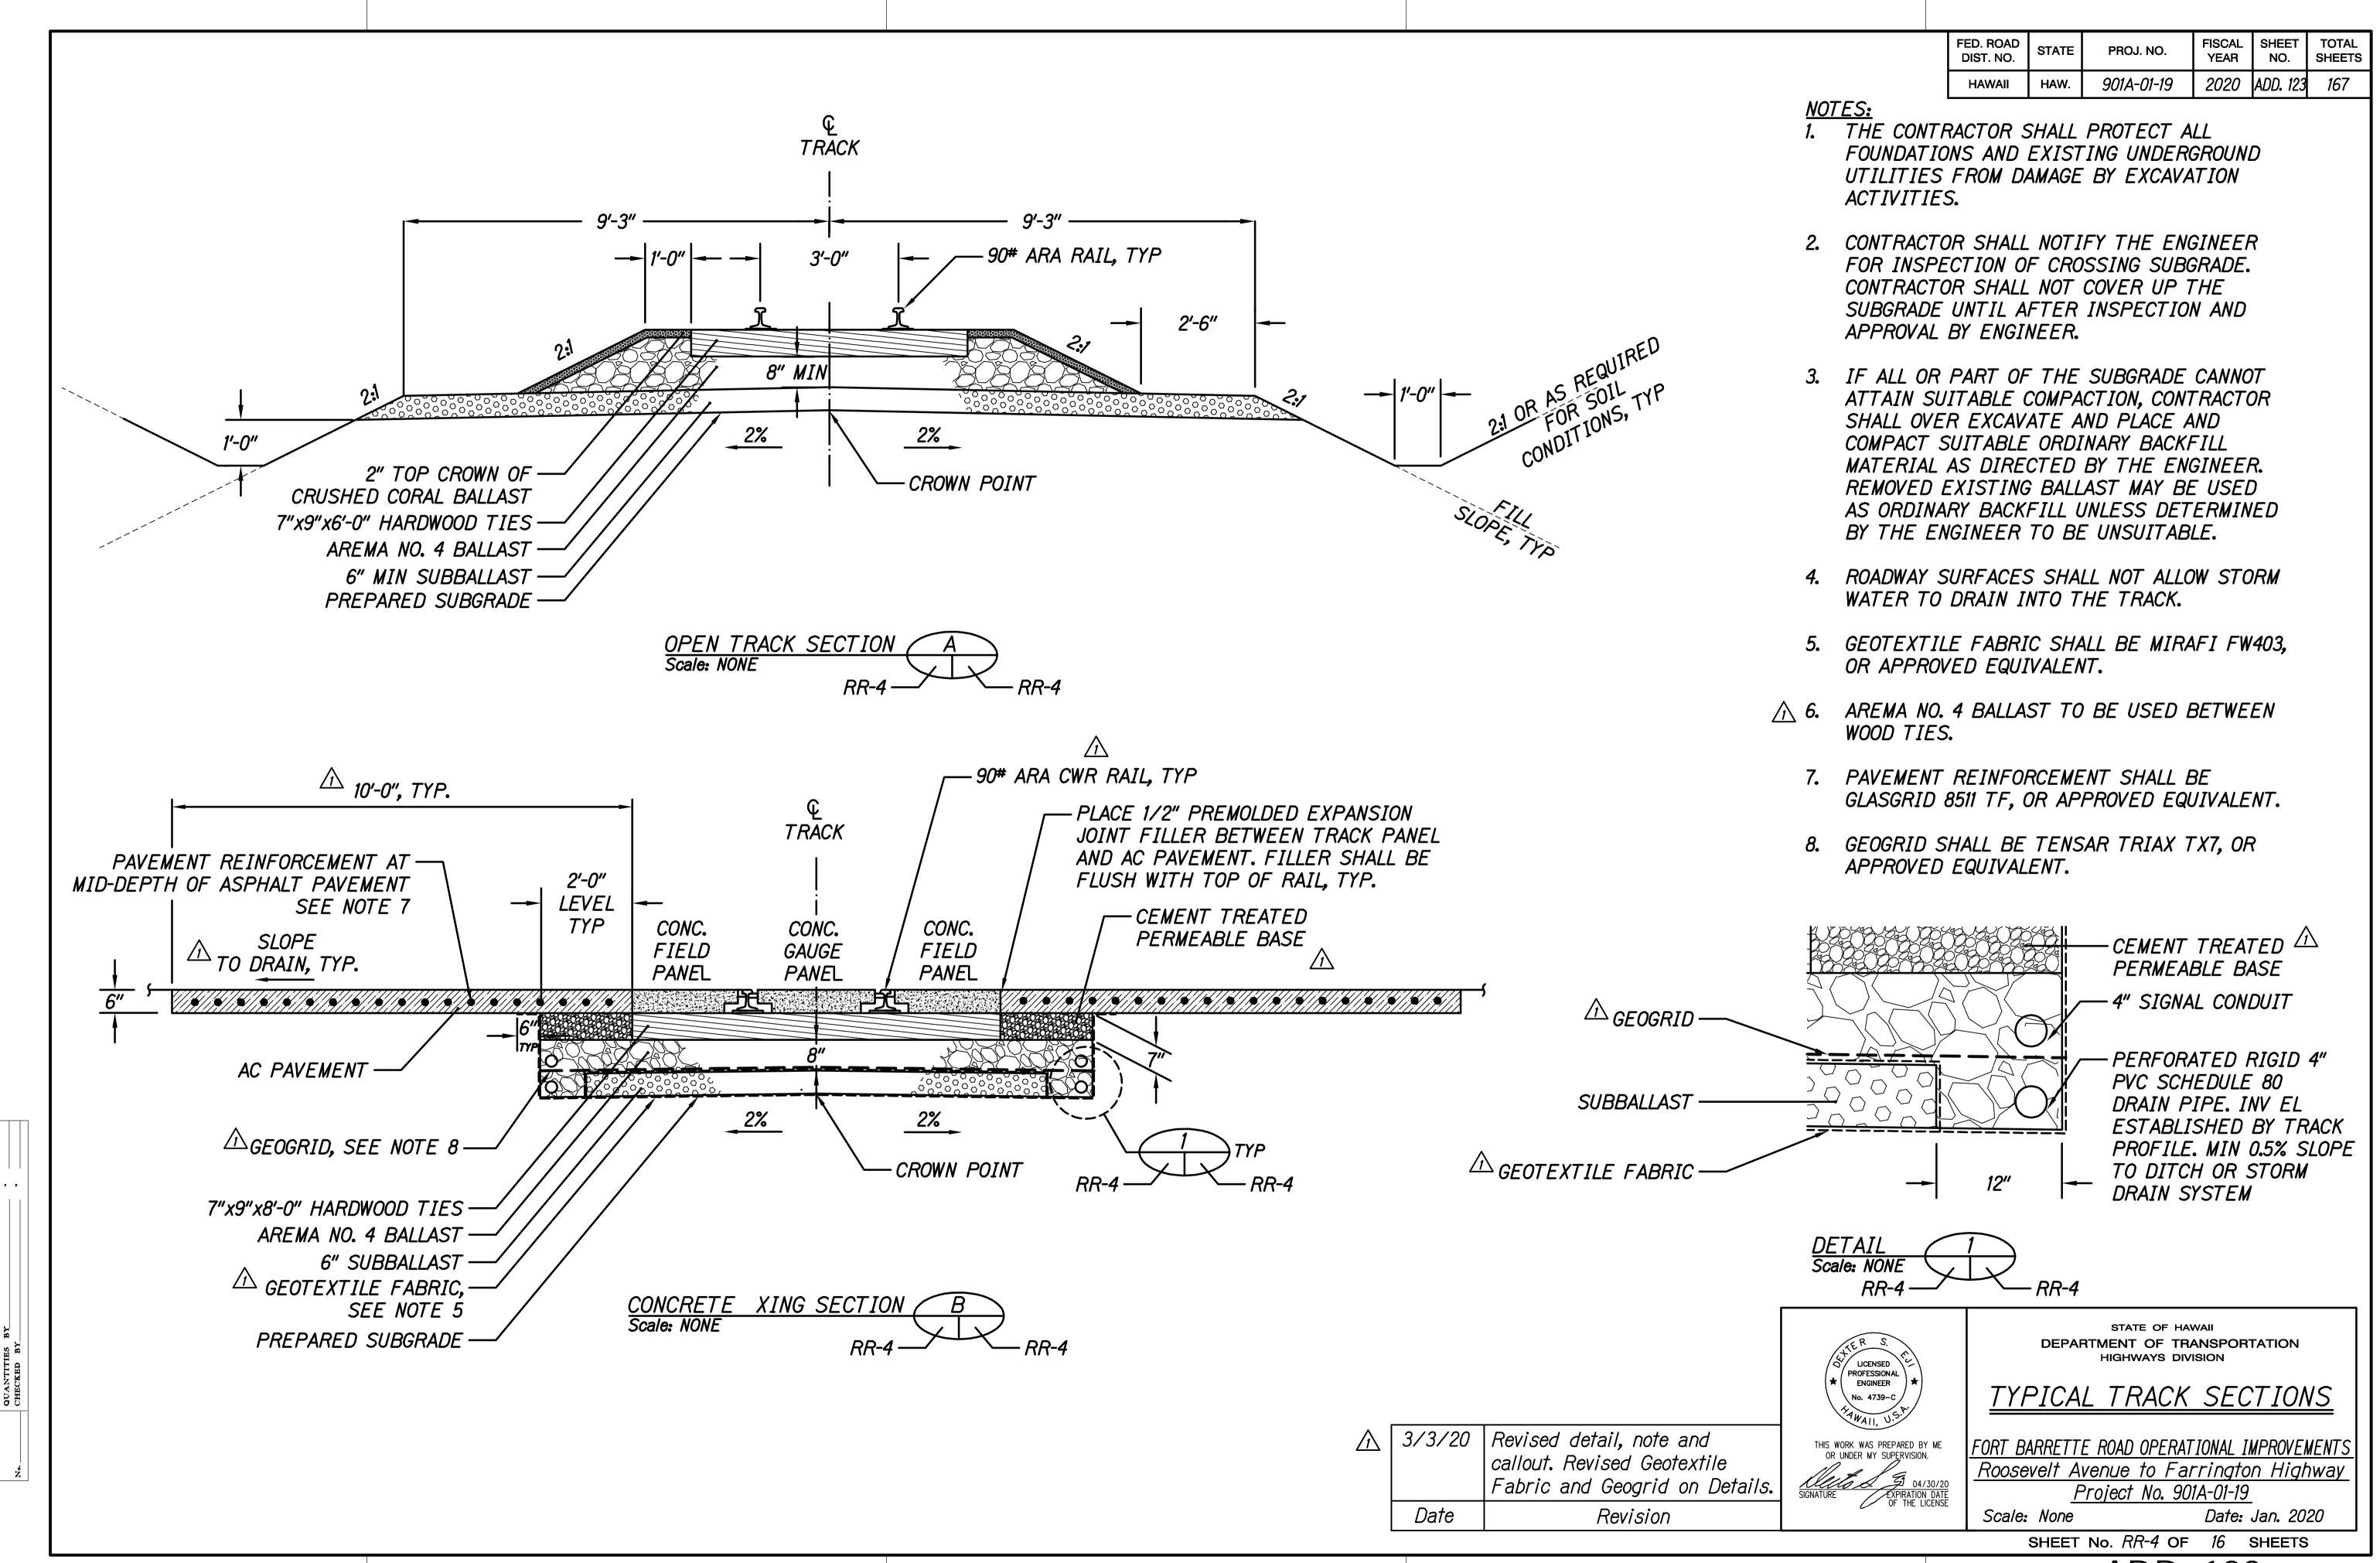

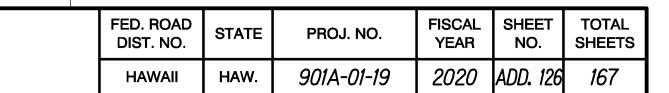

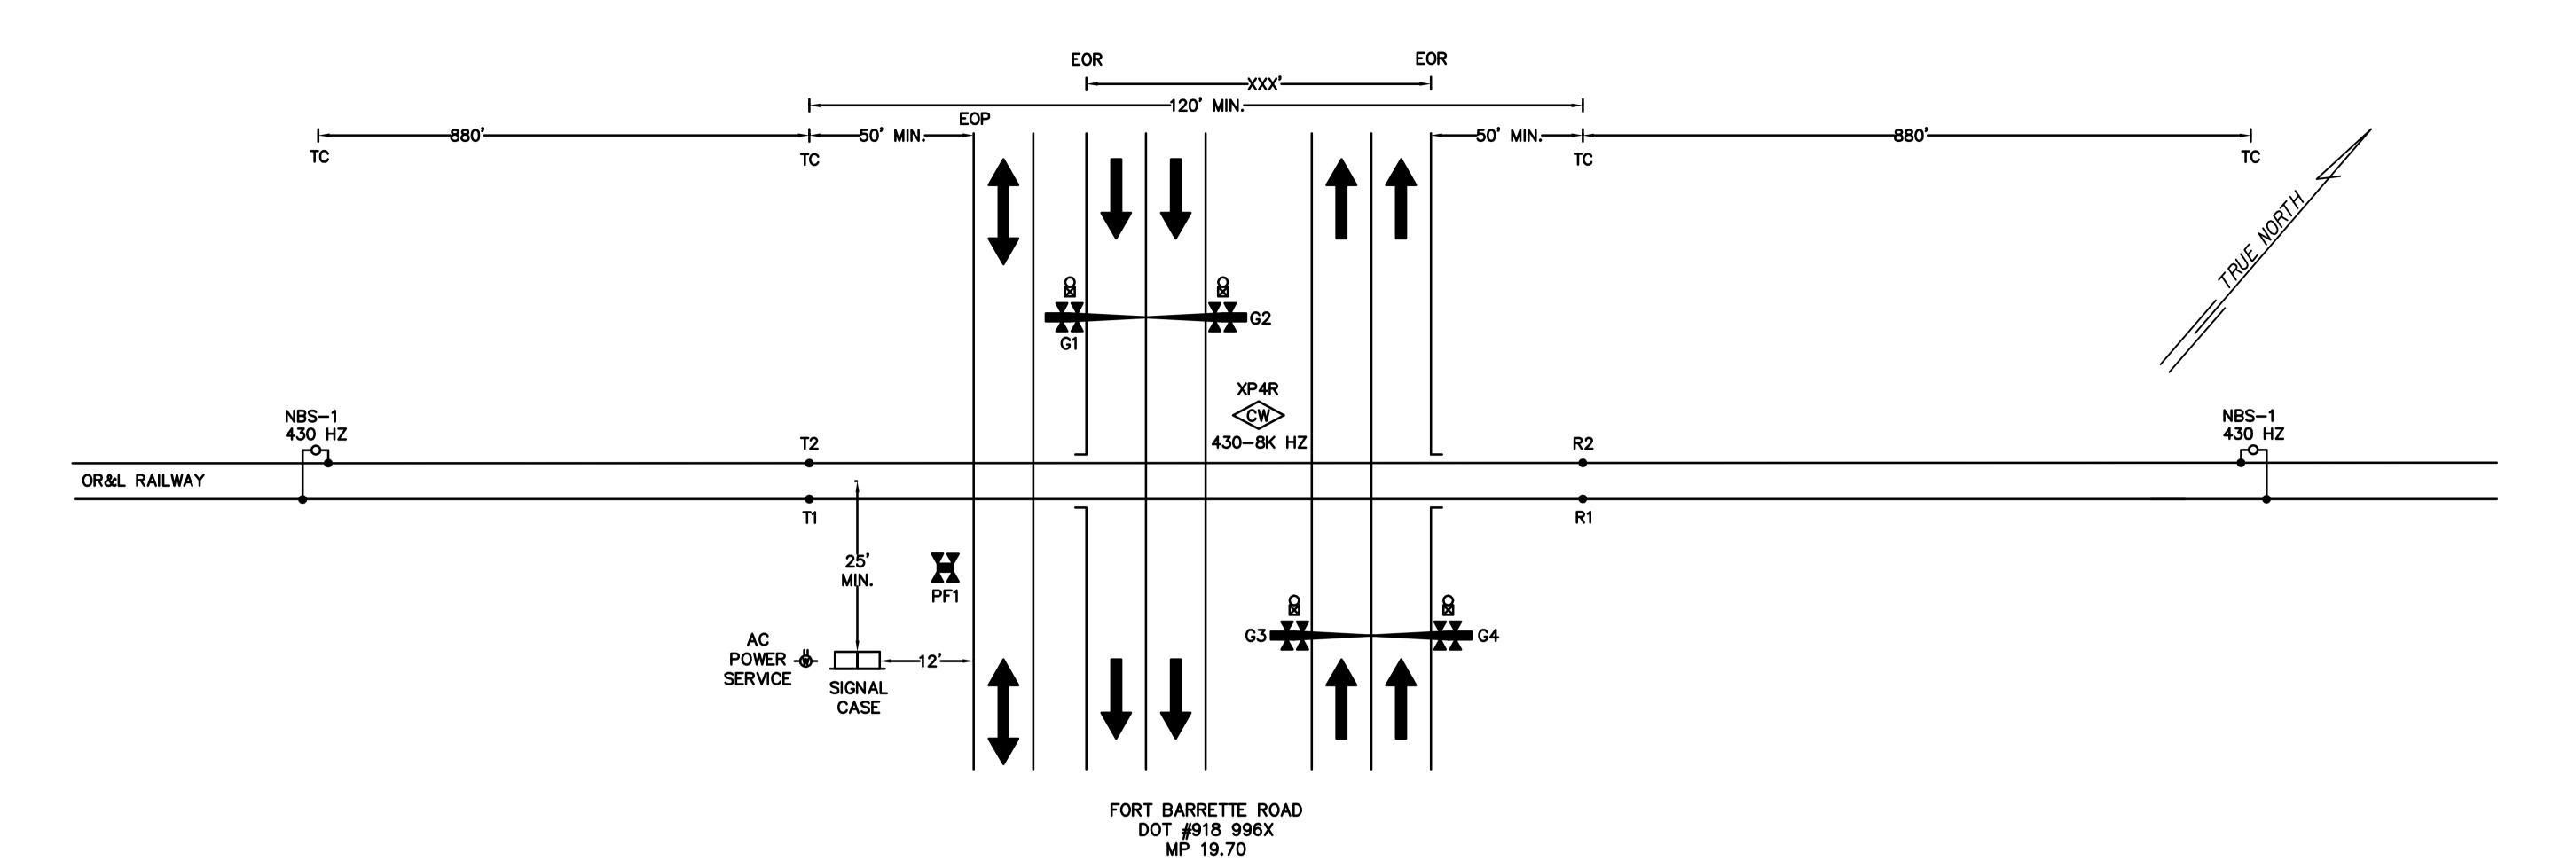

	SIGNAL CASE	
T1/T2	2C #6 TW 2C #6 TW	R1/R2
G1	7C #6 7C #14 7C #6 7C #14	G3
G2	7C #6, 7C #14	G4
AC POWER	3C #2 W/GND 5C #6	PF1

NOTES:

- 1. MINIMUM ISLAND LENGTH IS 120 FEET
- 2. SIGNAL CASE TO BE LOCATED MINIMUM 12' FROM ROADWAY SHOULDER AND 25' FROM TRACK CENTERLINE.
- 3. ALL LAMPS SHALL BE LED.
- 4. ALL WIRES #16 AWG UNLESS OTHERWISE NOTED.

 5. ALL RAIL JOINTS SHALL BE BONDED WITHIN CIRCUIT AREA.

WARNING TIME:

- 1. EQUIPMENT IS DESIGNED FOR 20 SECONDS MINIMUM WARNING TIME AT 10 MPH.
- 2. APPROACHES WERE LENGTHENED 0 SECOND(S) FOR WIDE OR ANGLED CROSSING (CT).
 3. APPROACHES WERE LENGTHENED 5 SECONDS FOR BUFFER TIME (BT).
- 4. APPROACHES WERE LENGTHENED 30 SECONDS FOR ADVANCED PREEMPTION (APT).
- 5. APPROACHES WERE LENGTHENED 5 SECONDS FOR EQUIPMENT RESPONSE TIME (ERT).

SYMBOLS AND ABBREVIATIONS:

TC - TRACK CONNECTION

EOR - EDGE OF ROADWAY

EOP - EDGE OF PATHWAY

NBS - NARROW BAND SHUNT

CW - CONSTANT WARNING (ALSTOM XP4R, FREQUENCY 430 HZ, 8.0KHZ ISLAND)

BELL

- AC POWER SERVICE

— – FLASHING LIGHTS AND GATE

- PEDESTRIAN FLASHING LIGHT UNIT

_____ - SIGNAL CASE

- TEST TERMINAL

_ _ LINE ARRESTER


EQUALIZER

Revision

3/3/20 Added note

Date

- TWISTED WIRE, 2 TURNS PER FOOT

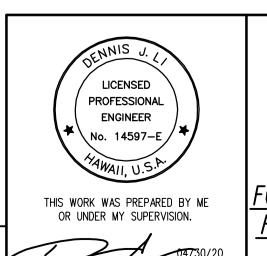



DEPARTMENT OF TRANSPORTATION HIGHWAYS DIVISION


CROSSING LOCATION PLAN


FORT BARRETTE ROAD OPERATIONAL IMPROVEMENTS Roosevelt Avenue to Farrington Highway Project No. 901A-01-19


Scale: None Date: Jan. 2020 SHEET No. RR-7 OF 16 SHEETS

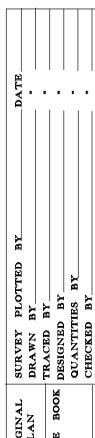


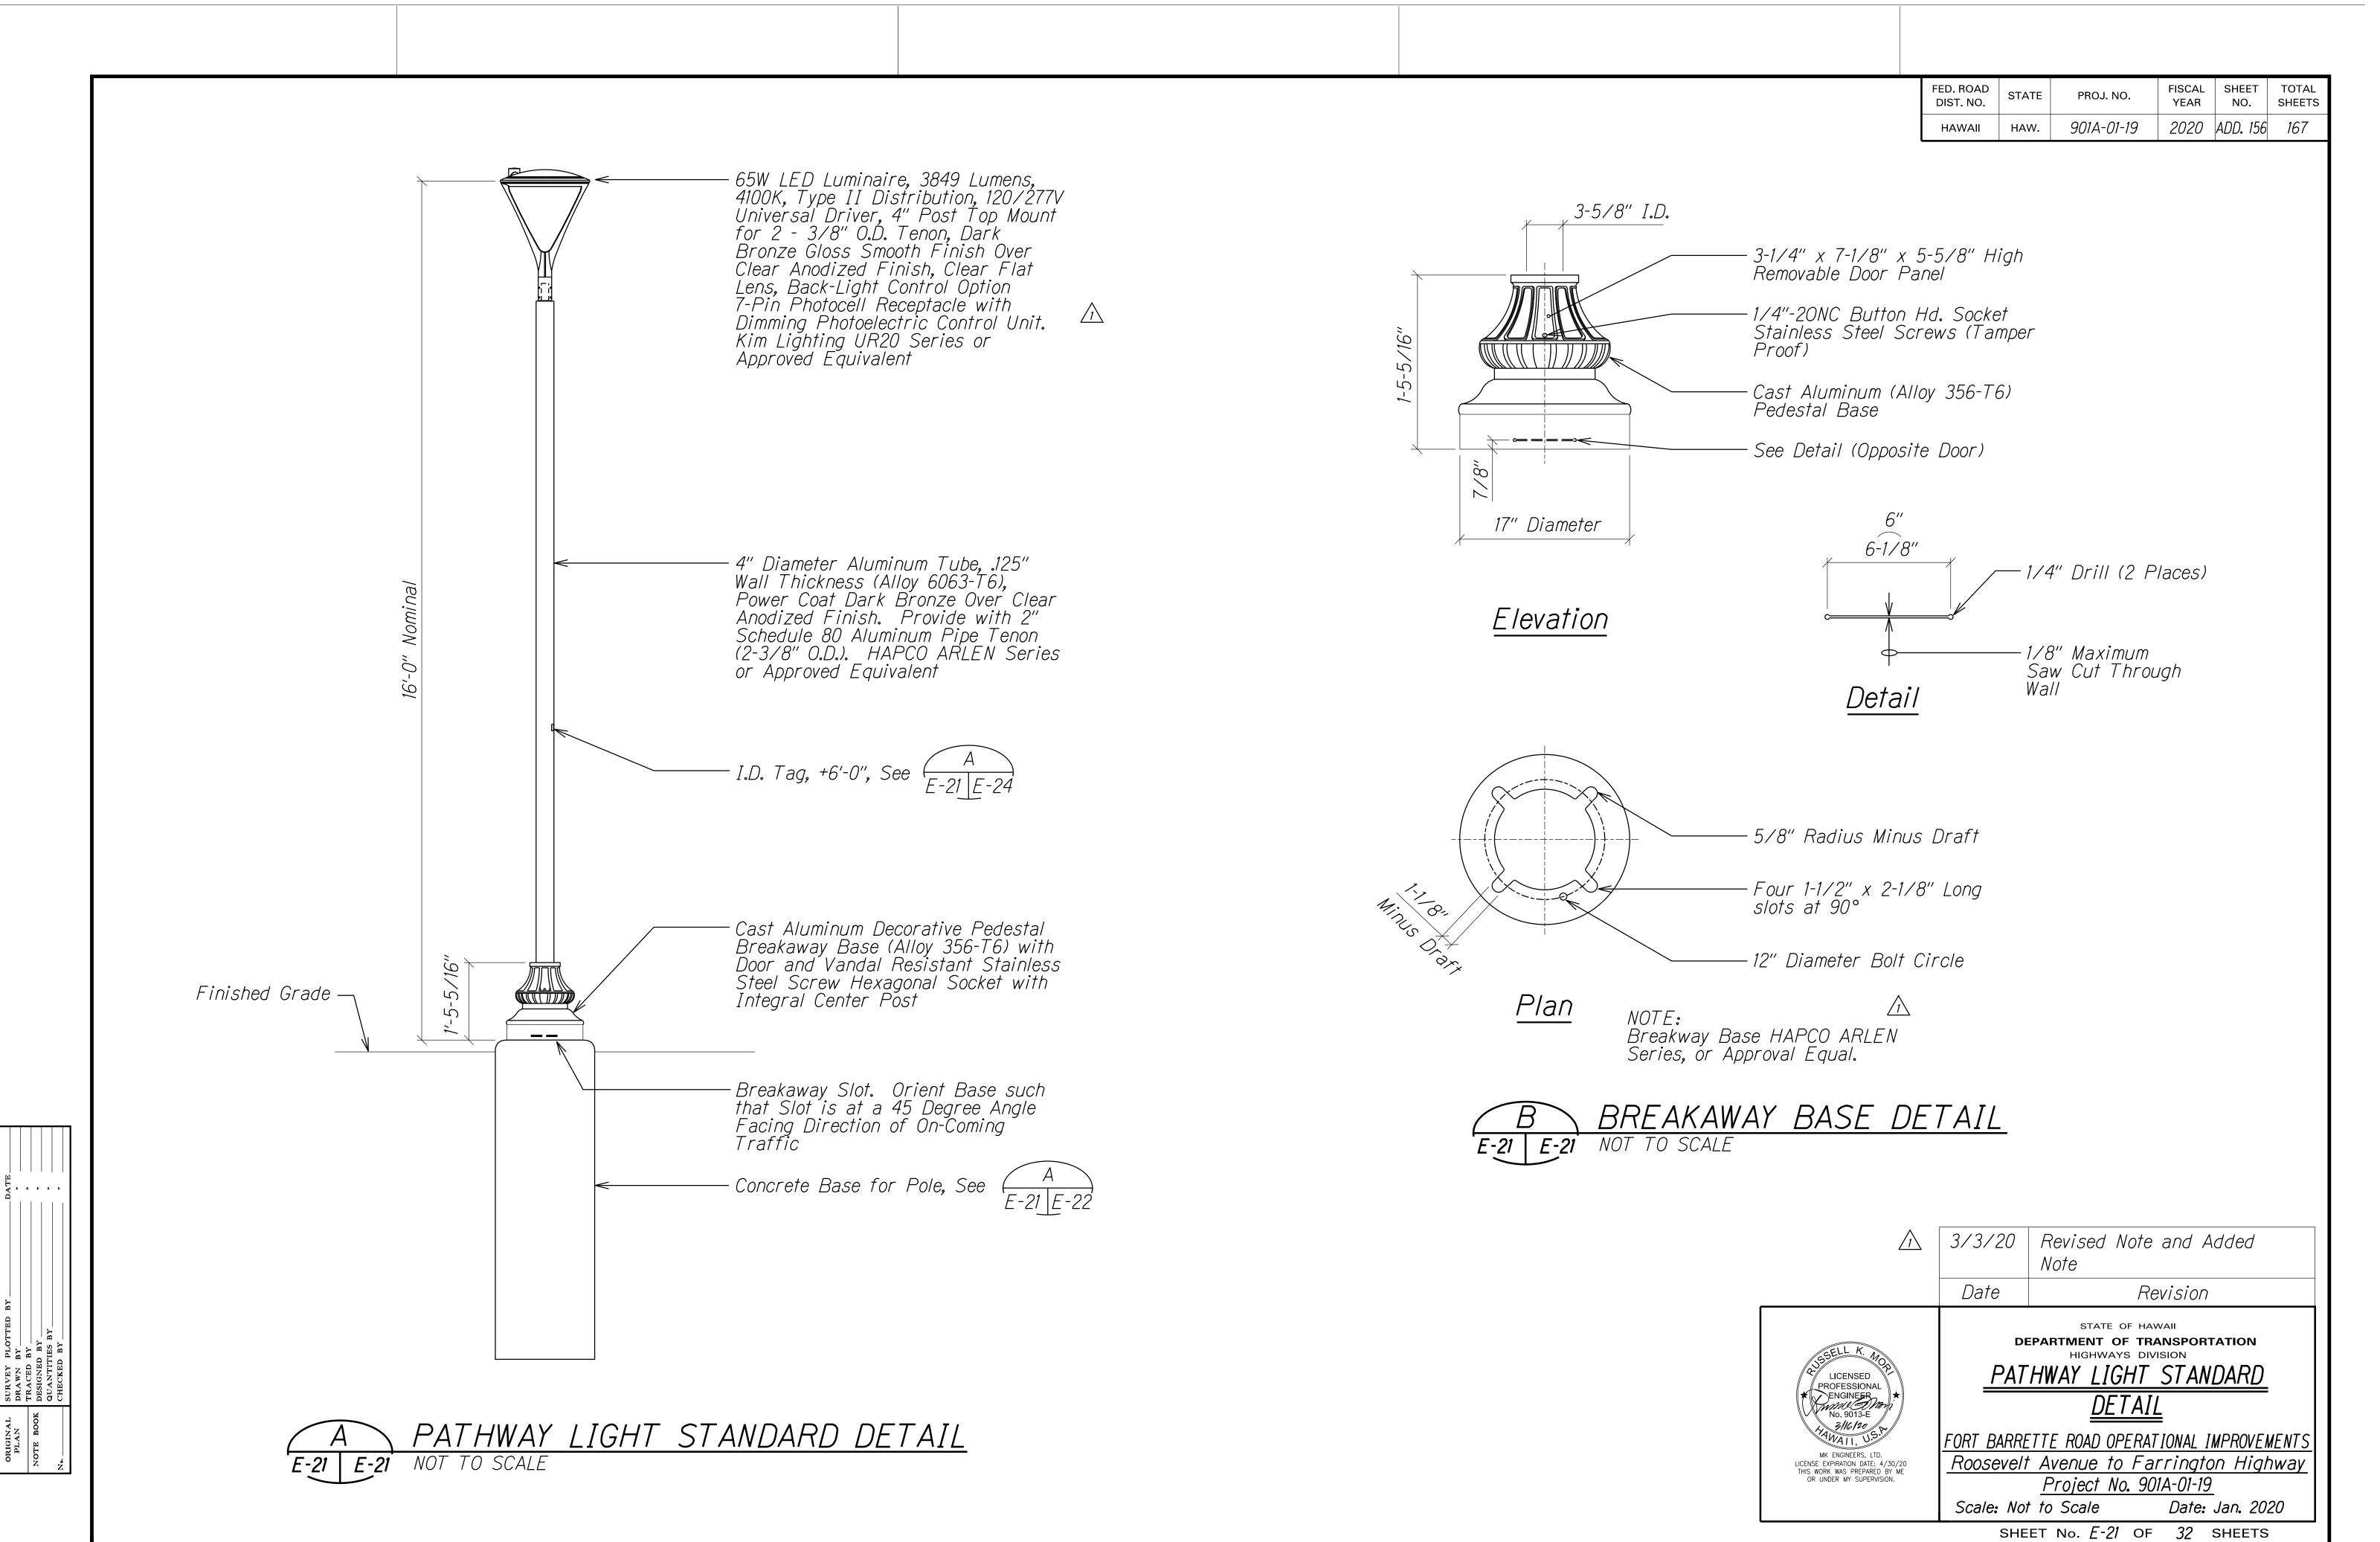

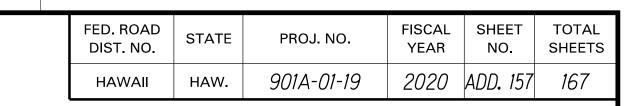

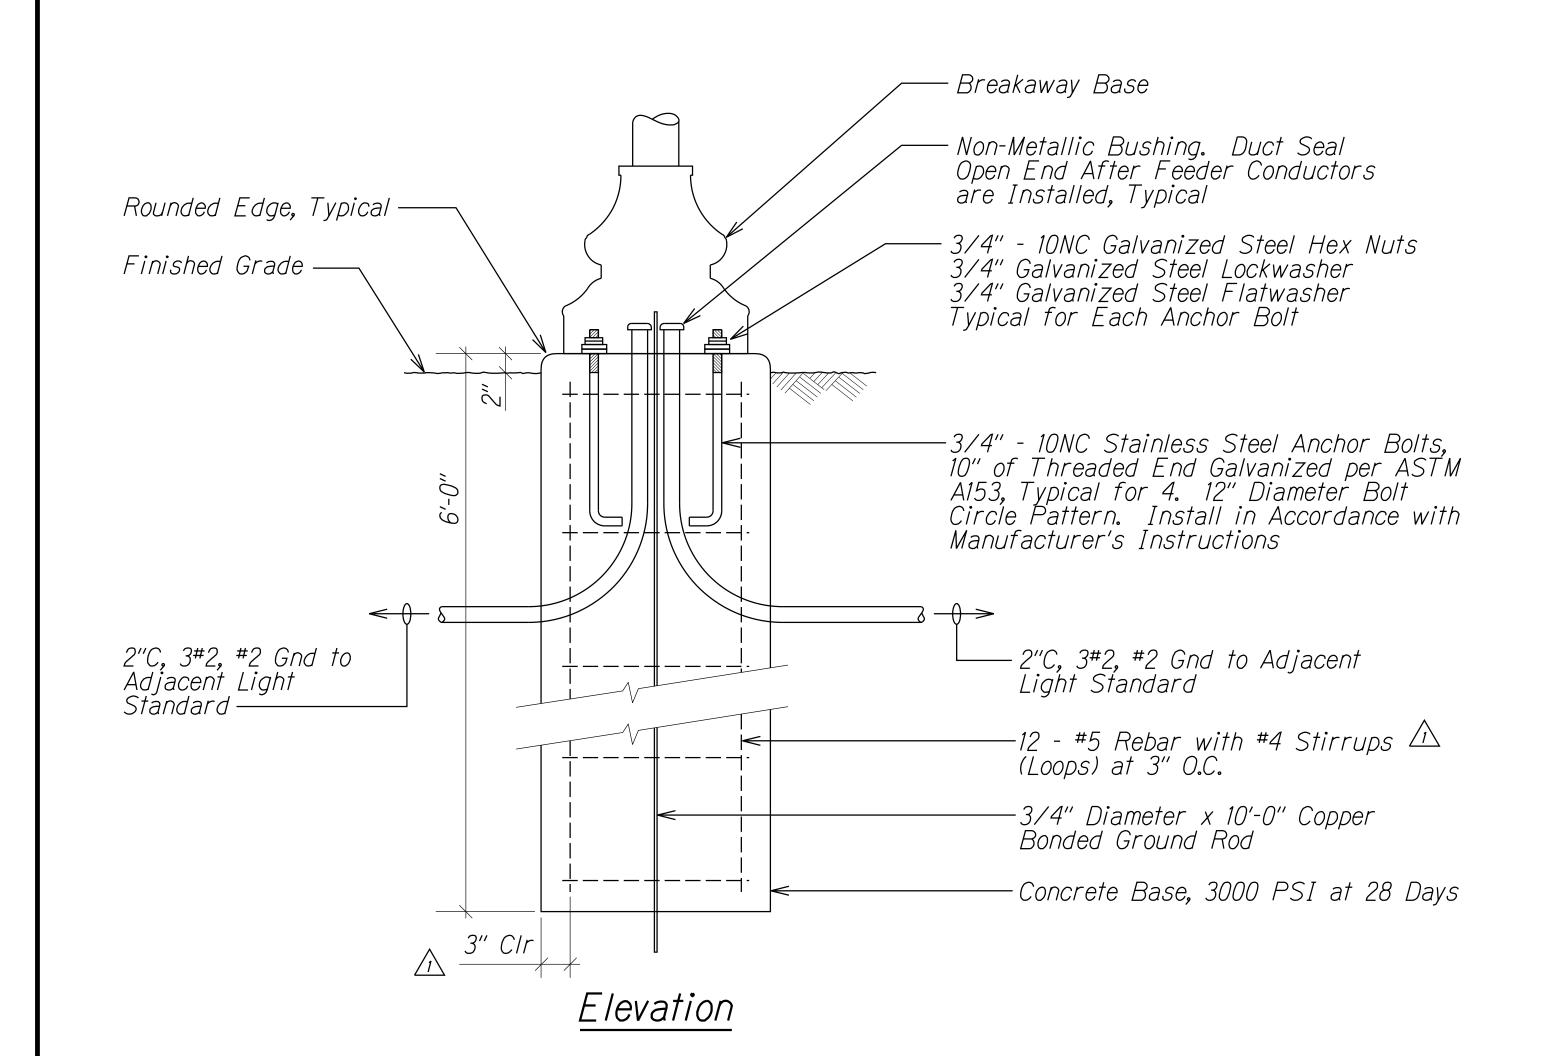


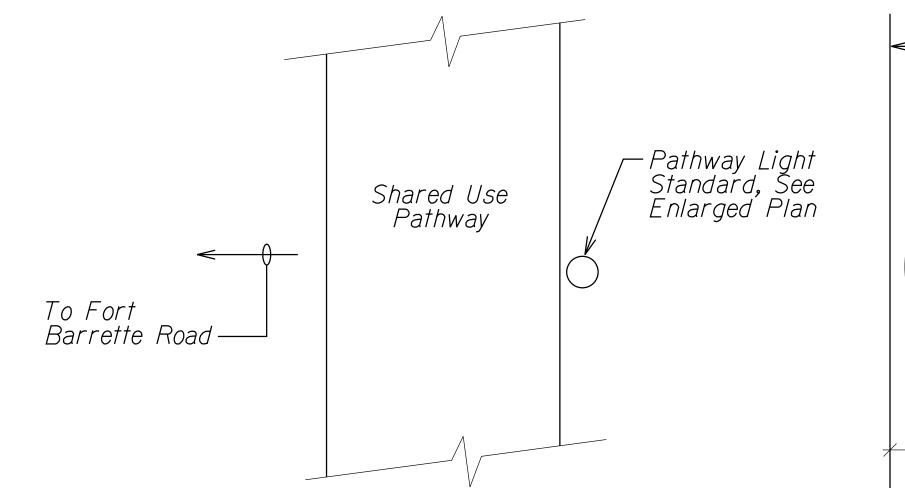

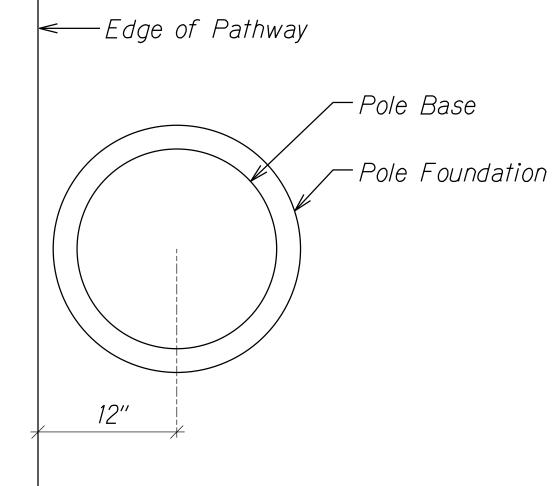

<u>Partial Plan</u> <u>At Shared Used Pathway</u>

<u>Enlarged Plan</u> At Light Standard

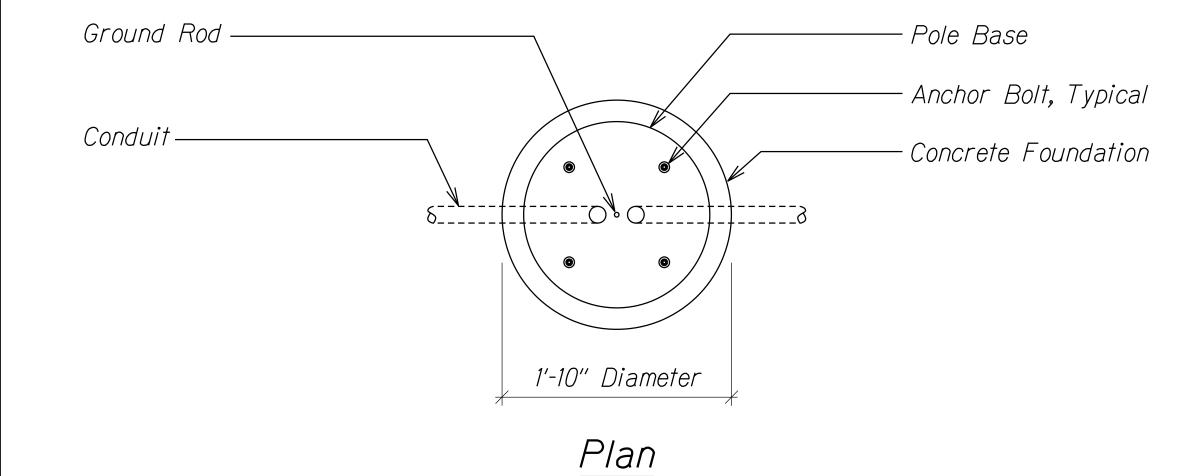



A TYPICAL POLE BASE DETAIL


E-21 E-22 NOT TO SCALE

3/3/20 Revised Note and Added a Dimension

Date Revision

STATE OF HAWAII

DEPARTMENT OF TRANSPORTATION
HIGHWAYS DIVISION

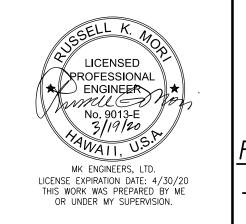

TYPICAL POLE BASE DETAIL

FORT BARRETTE ROAD OPERATIONAL IMPROVEMENTS


Roosevelt Avenue to Farrington Highway

Project No. 901A-01-19

Scale: Not to Scale Date: Jan. 2020

SHEET No. *E-22* OF *32* SHEETS

FED. ROAD DIST. NO. FISCAL SHEET TOTAL YEAR NO. SHEETS PROJ. NO. 901A-01-19 2020 ADD. 164 167 HAW.

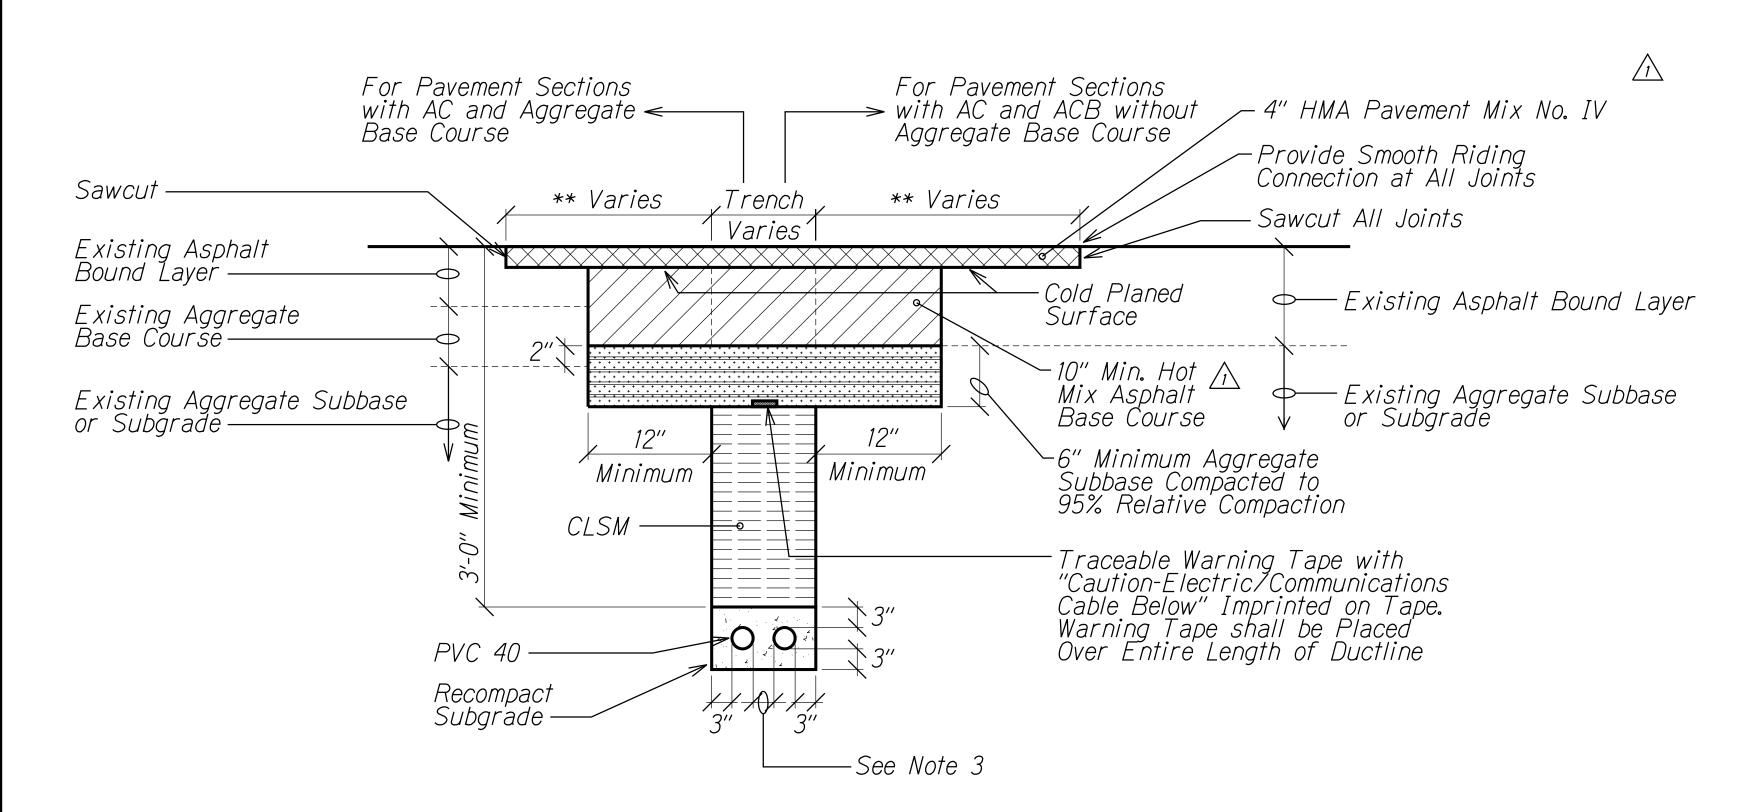




NOTES:

- 1. This Trench Restoration is to be Used Wherever the Pavement is an Asphalt Surface Including Medians and Paved Areas Between Guardrails. For Trenches Located in Unpaved Areas, the Backfill Need Not be CLSM and Can be Backfilled as Specified in the Standard Specifications.
- 2. Electrical, Telephone, and CATV Ducts Similar.
- 3. Provide 2" Separation Between Ducts of Same System and 3" Between Ducts of Different Systems.
- 4. Tack Coat Existing Asphalt Bound Material Faces Prior to Filling Excavation with Asphalt Bound Material.
- 5. When Ground Water is Encountered in Trenches, Backfill with Gravel Conforming to ASTM C-33, Size 67 Material Until One Foot Above the Water Level. Encapsulate the Size 67 Material with a Perméable Separator that Lines the Bottom and Sides of the Trench and Overlaps at the Top of the Material for the Width of the Trench. Complete Backfilling the Trench per Detail.
- 6. Trench Restoration Work, Including but Not Limited to Pavement and Striping, Shall be Considered Incidental to Item No. 627.1001 Pathway Lighting System.

** NOTES:


 \triangle

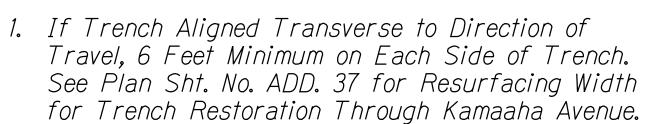

- 2. If Trench Aligned Along Direction of Travel, to Edge of Lane in Which Edge of Trench is Located.
- 3. Smoothness of Paved Surfaces; the Distance from the Paved Surface to the Testing Edge of a Ten-Foot Straight Edge Between Two Points of Contact Shall Not Exceed 3/16".

3/3/20 | Added Note No. 6, Removed Notes and Revised Notes

Revision

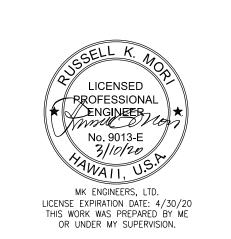

STATE OF HAWAII **DEPARTMENT OF TRANSPORTATION** TYPICAL DUCT SECTION (CONC ENCASED) FOR PAVED AREAS

FORT BARRETTE ROAD OPERATIONAL IMPROVEMENTS Roosevelt Avenue to Farrington Highway Project No. 901A-01-19 Scale: Not to Scale Date: Jan. 2020

SHEET No. *E-29* OF 32 SHEETS

