



ASBUILT DRAWINGS

FED. ROAD DIST. NO.	STATE	PROJ. NO.	FISCAL YEAR	SHEET NO.	TOTAL SHEETS
HAWAII	HAW.	901A-01-19	2020	40	167

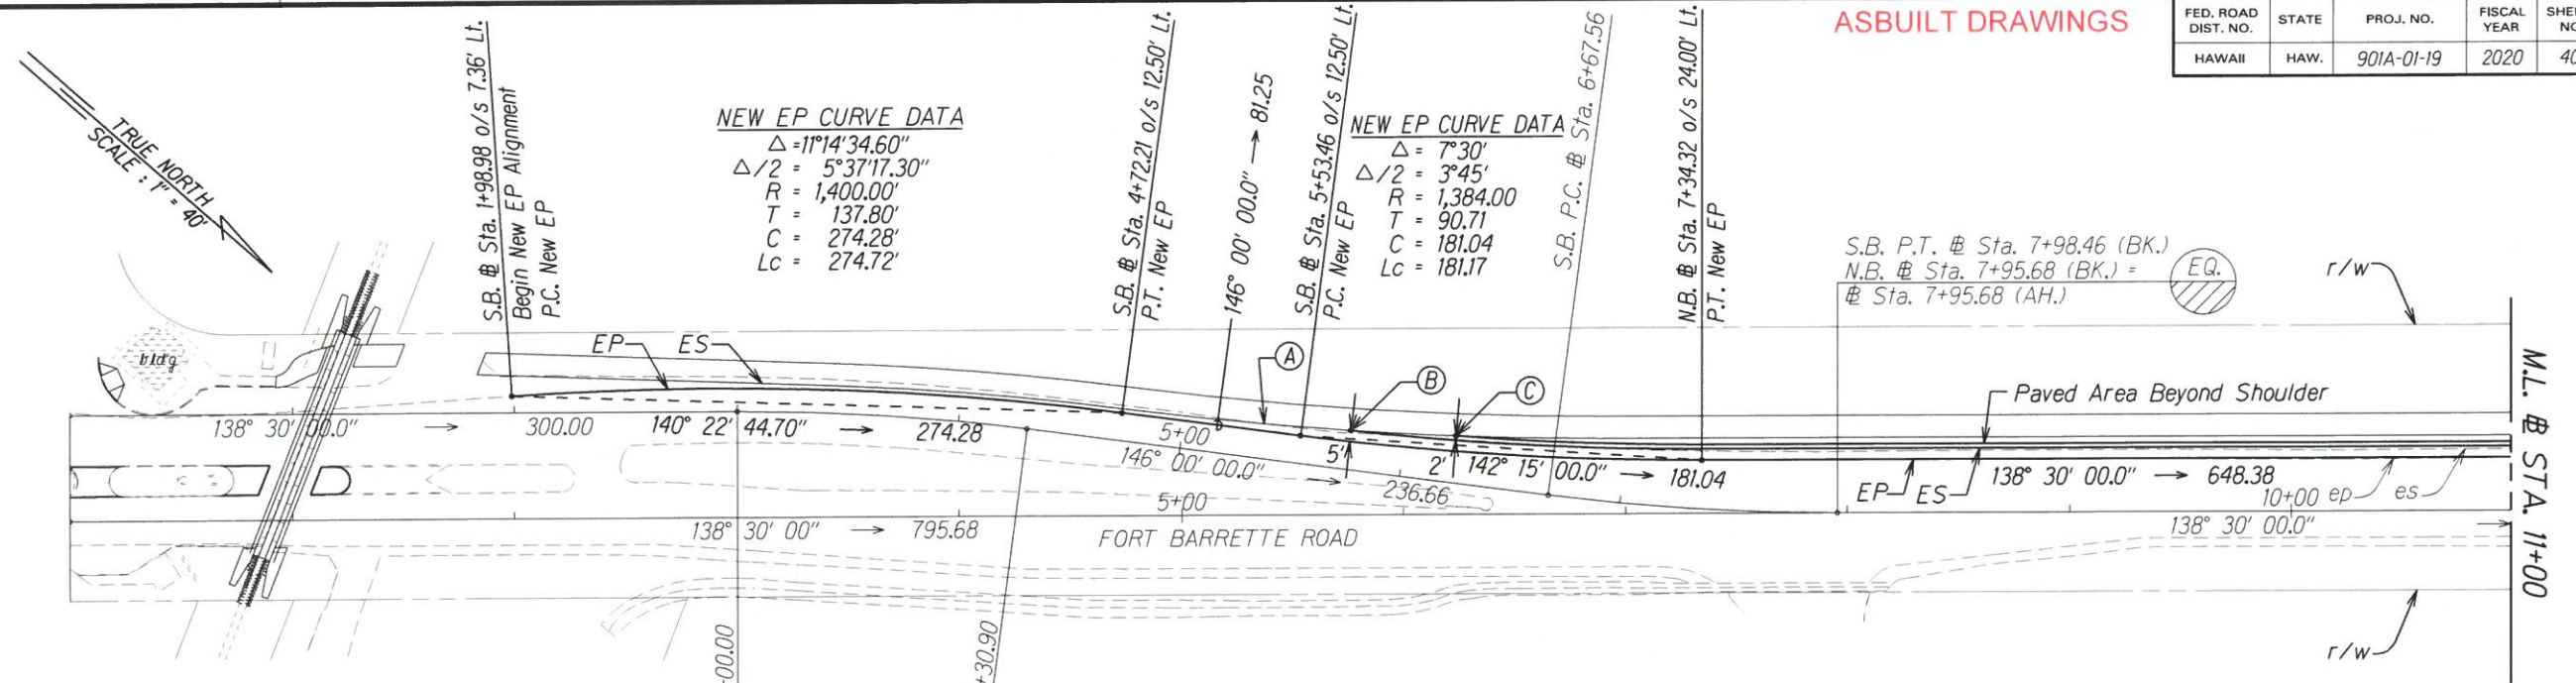

- (A) S.B. @ Sta. 5+36.49± o/s 15.72' Lt. Begin Shoulder Widening
- (B) S.B. @ Sta. 5+75.80± o/s 17.68' Lt. Begin New 5' Shoulder
- (C) S.B. @ Sta. 6+23.14± o/s 21.26' Lt. Begin New 2' Paved Area Beyond Shoulder
- (D) @ Sta. 20+29.85± o/s 26.00' Lt. End New 2' Paved Area Beyond Shoulder
- (E) Kapolei Parkway @ Sta. 1+27.82± o/s 49.20' Lt. End Shoulder Widening

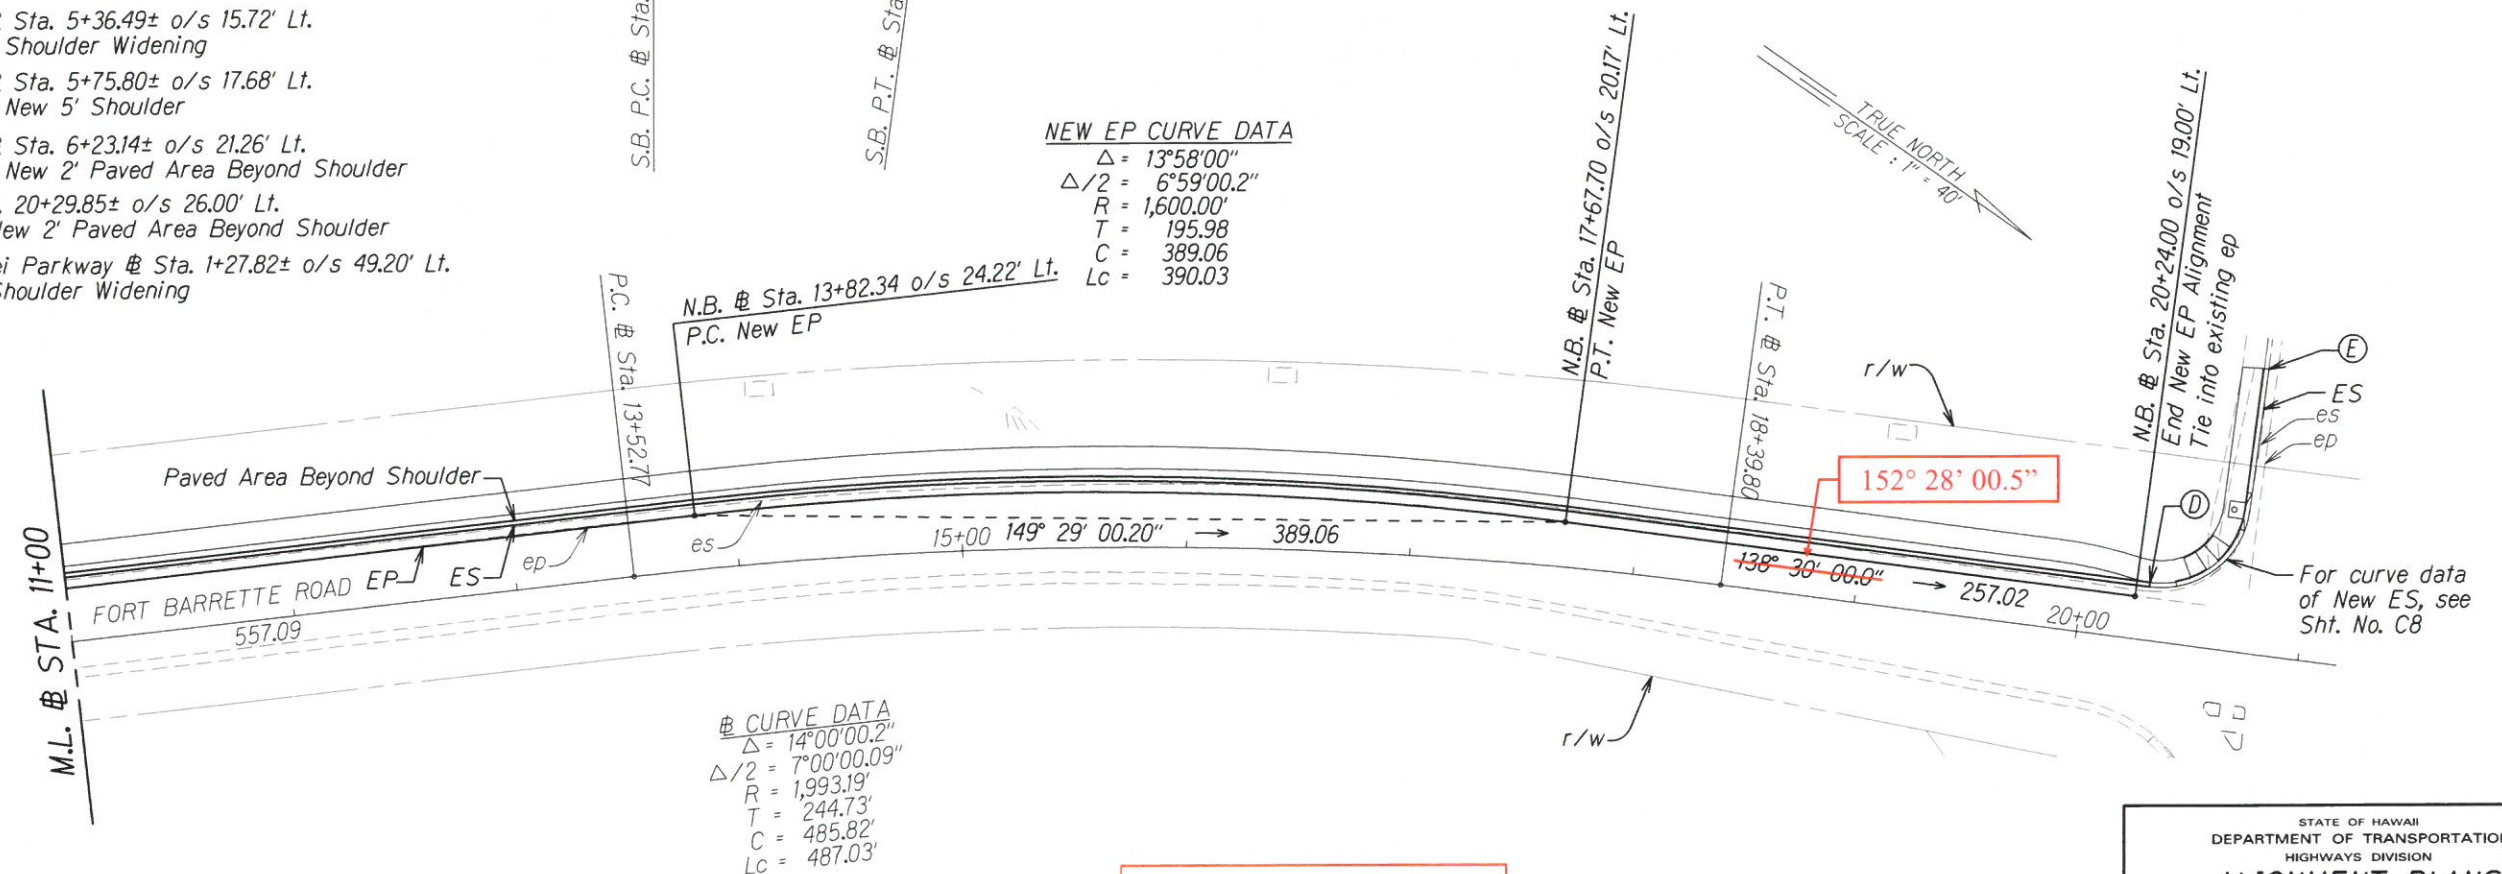

ORIGINAL PLAN	DATE
DESIGNED BY	
CHECKED BY	
DATE	

AS-BUILT
 PAUL'S ELECTRICAL CONTRACTING, LLC
 SIGNATURE DATE 10/3/22

STATE OF HAWAII
 DEPARTMENT OF TRANSPORTATION
 HIGHWAYS DIVISION
ALIGNMENT PLANS
NEW EDGE OF PAVEMENT
 FORT BARRETTE ROAD OPERATIONAL IMPROVEMENTS
 Roosevelt Avenue to Farrington Highway
 Project No. 901A-01-19
 Scale: 1" = 40.0' Date: January, 2020
 SHEET No. 1 OF 1 SHEETS

"AS-BUILT"