



FED. ROAD DIST. NO.	STATE	PROJ. NO.	FISCAL YEAR	SHEET NO.	TOTAL SHEETS
HAWAII	HAW.	901A-01-19	2020	46	167

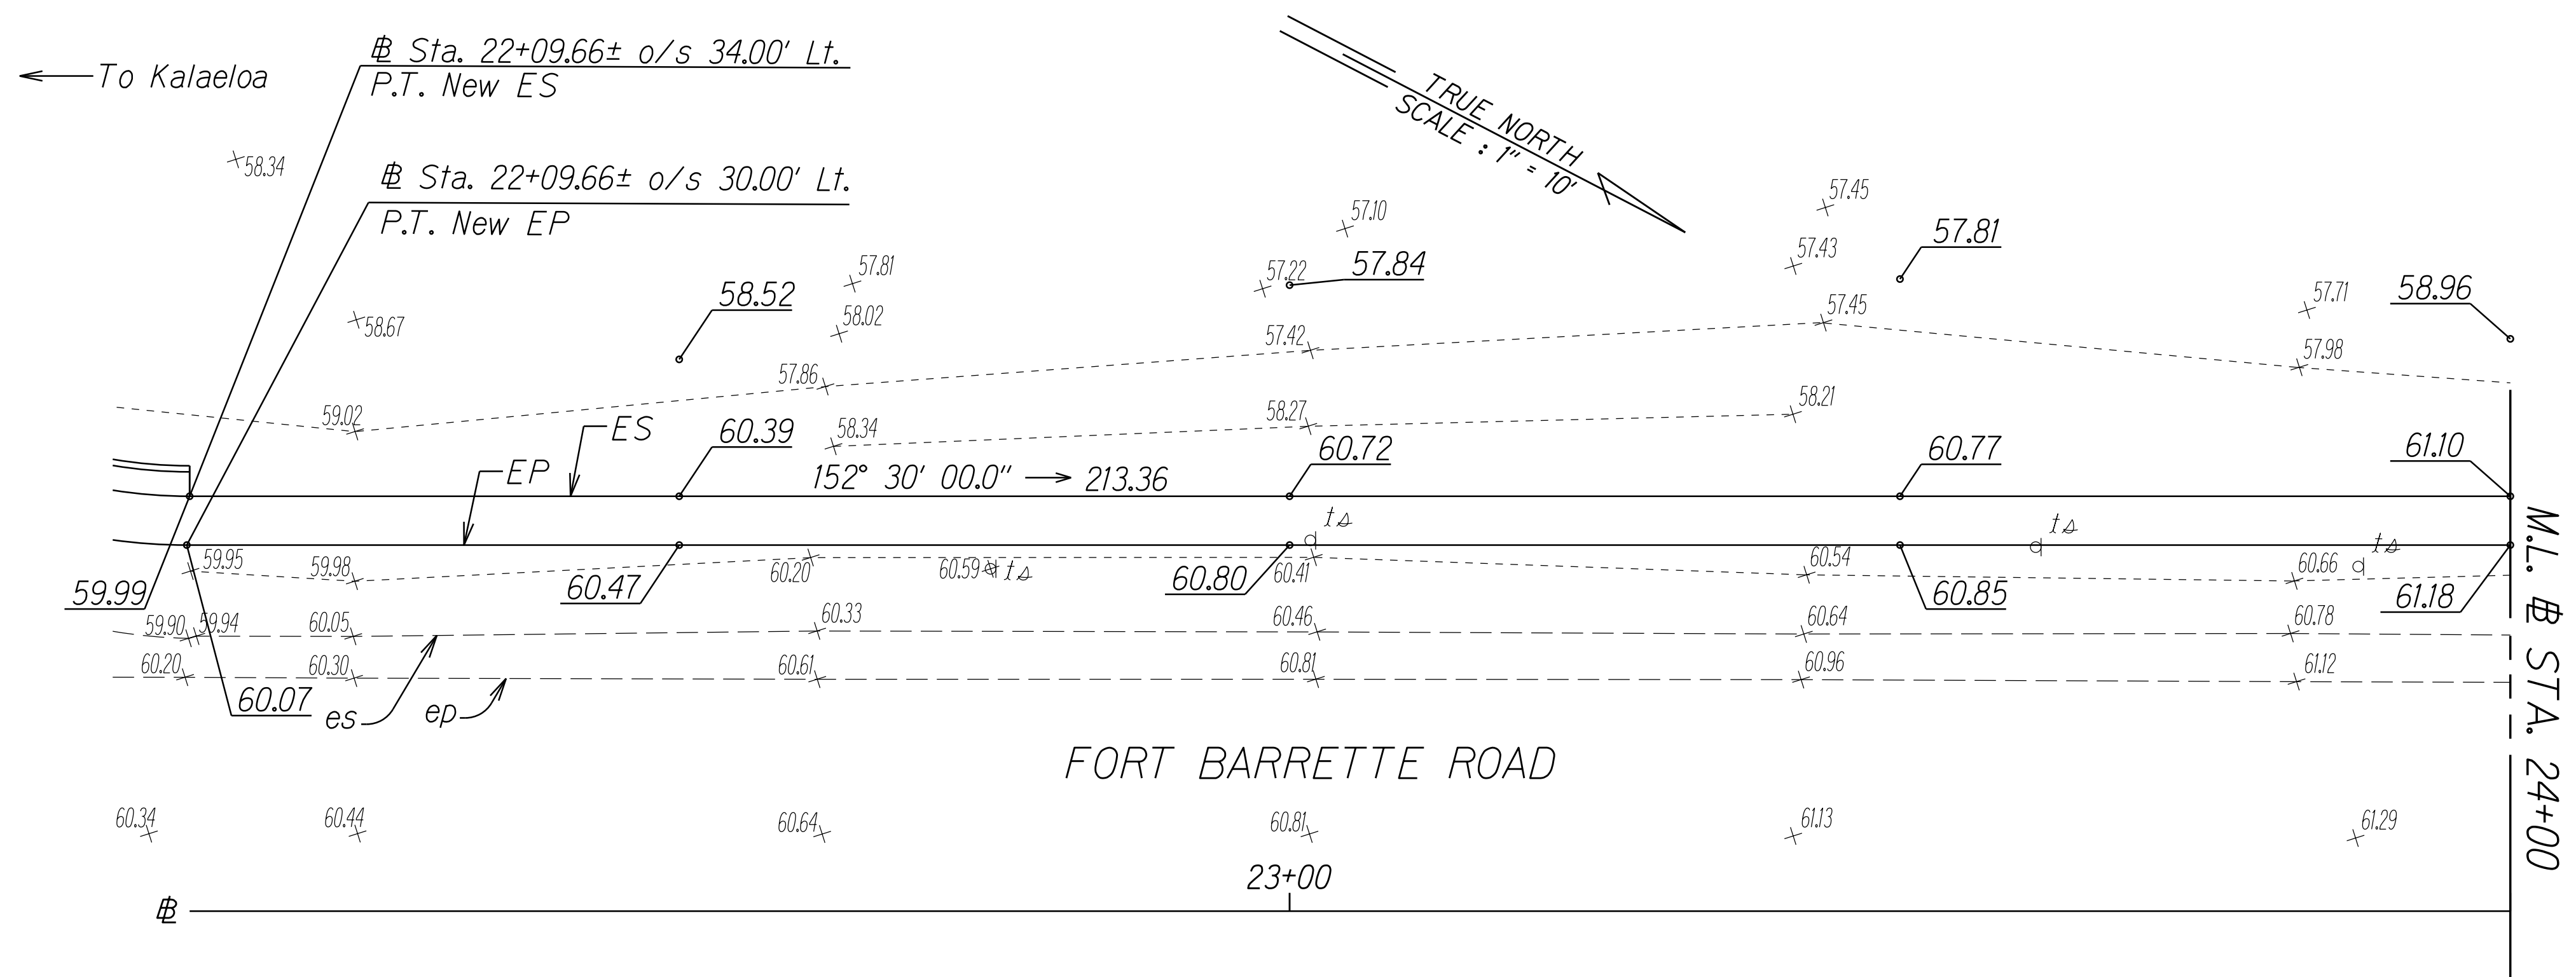

- Notes:
- See Roadway Cross Sections.
 - See Sht. No. C9 for Right Turn Curve details.

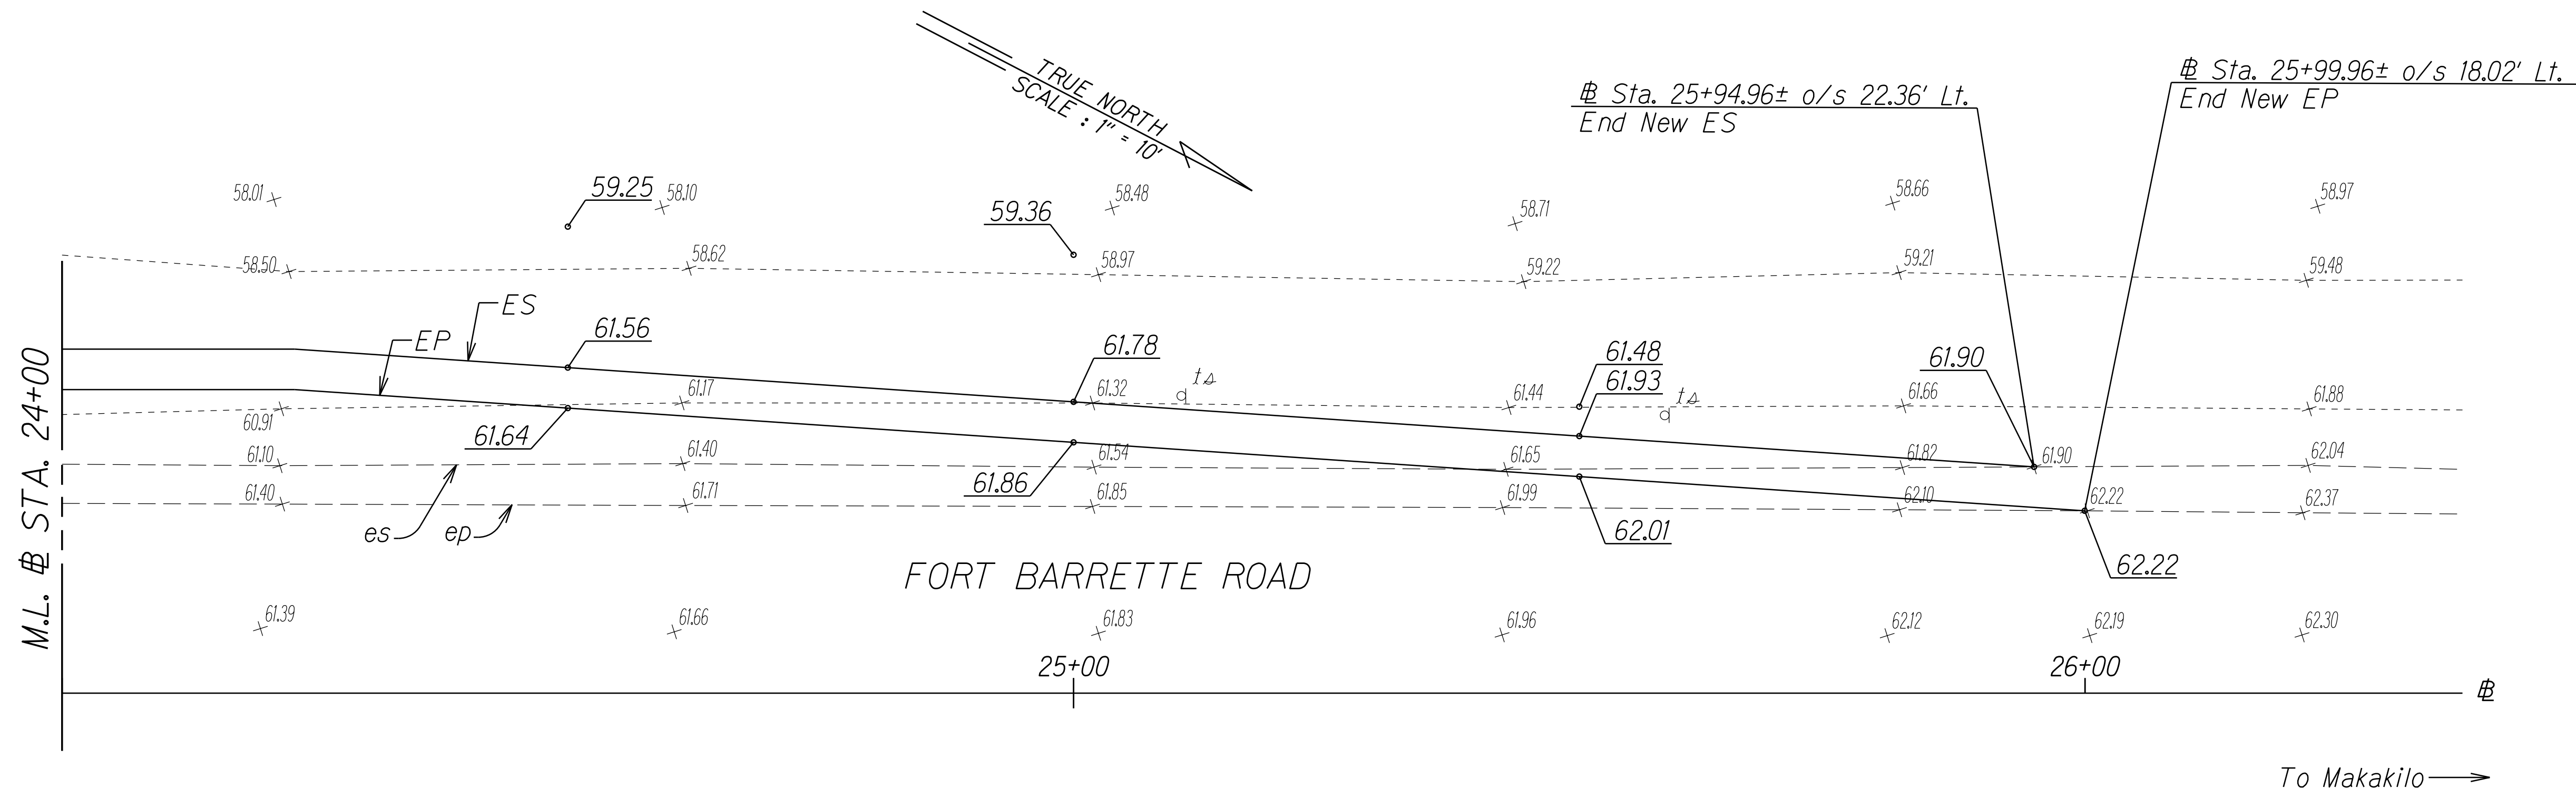

RIGHT TURN LANE PLAN
Sta. 22+09.66± LT. TO Sta. 25+99.96± LT.

ORIGINAL PLAN	SURVEY PLOTTED BY	DATE
NOTE BOOK	DRAWN BY	
	DESIGNED BY	
	CHECKED BY	

STATE OF HAWAII
DEPARTMENT OF TRANSPORTATION
HIGHWAYS DIVISION

PAVEMENT GRADE PLANS

FORT BARRETTE ROAD OPERATIONAL IMPROVEMENTS
Roosevelt Avenue to Farrington Highway
Project No. 901A-01-19

Scale: 1" = 10.0' Date: January, 2020

SHEET No. 1 OF 1 SHEETS

ASBUILT DRAWINGS

AS-BUILT
PAUL'S ELECTRICAL CONTRACTING, LLC




SIGNATURE

10/3/22

DATE

FED. ROAD DIST. NO.	STATE	PROJ. NO.	FISCAL YEAR	SHEET NO.	TOTAL SHEETS
HAWAII	HAW.	901A-01-19	2020	C.O. 46S-1	167

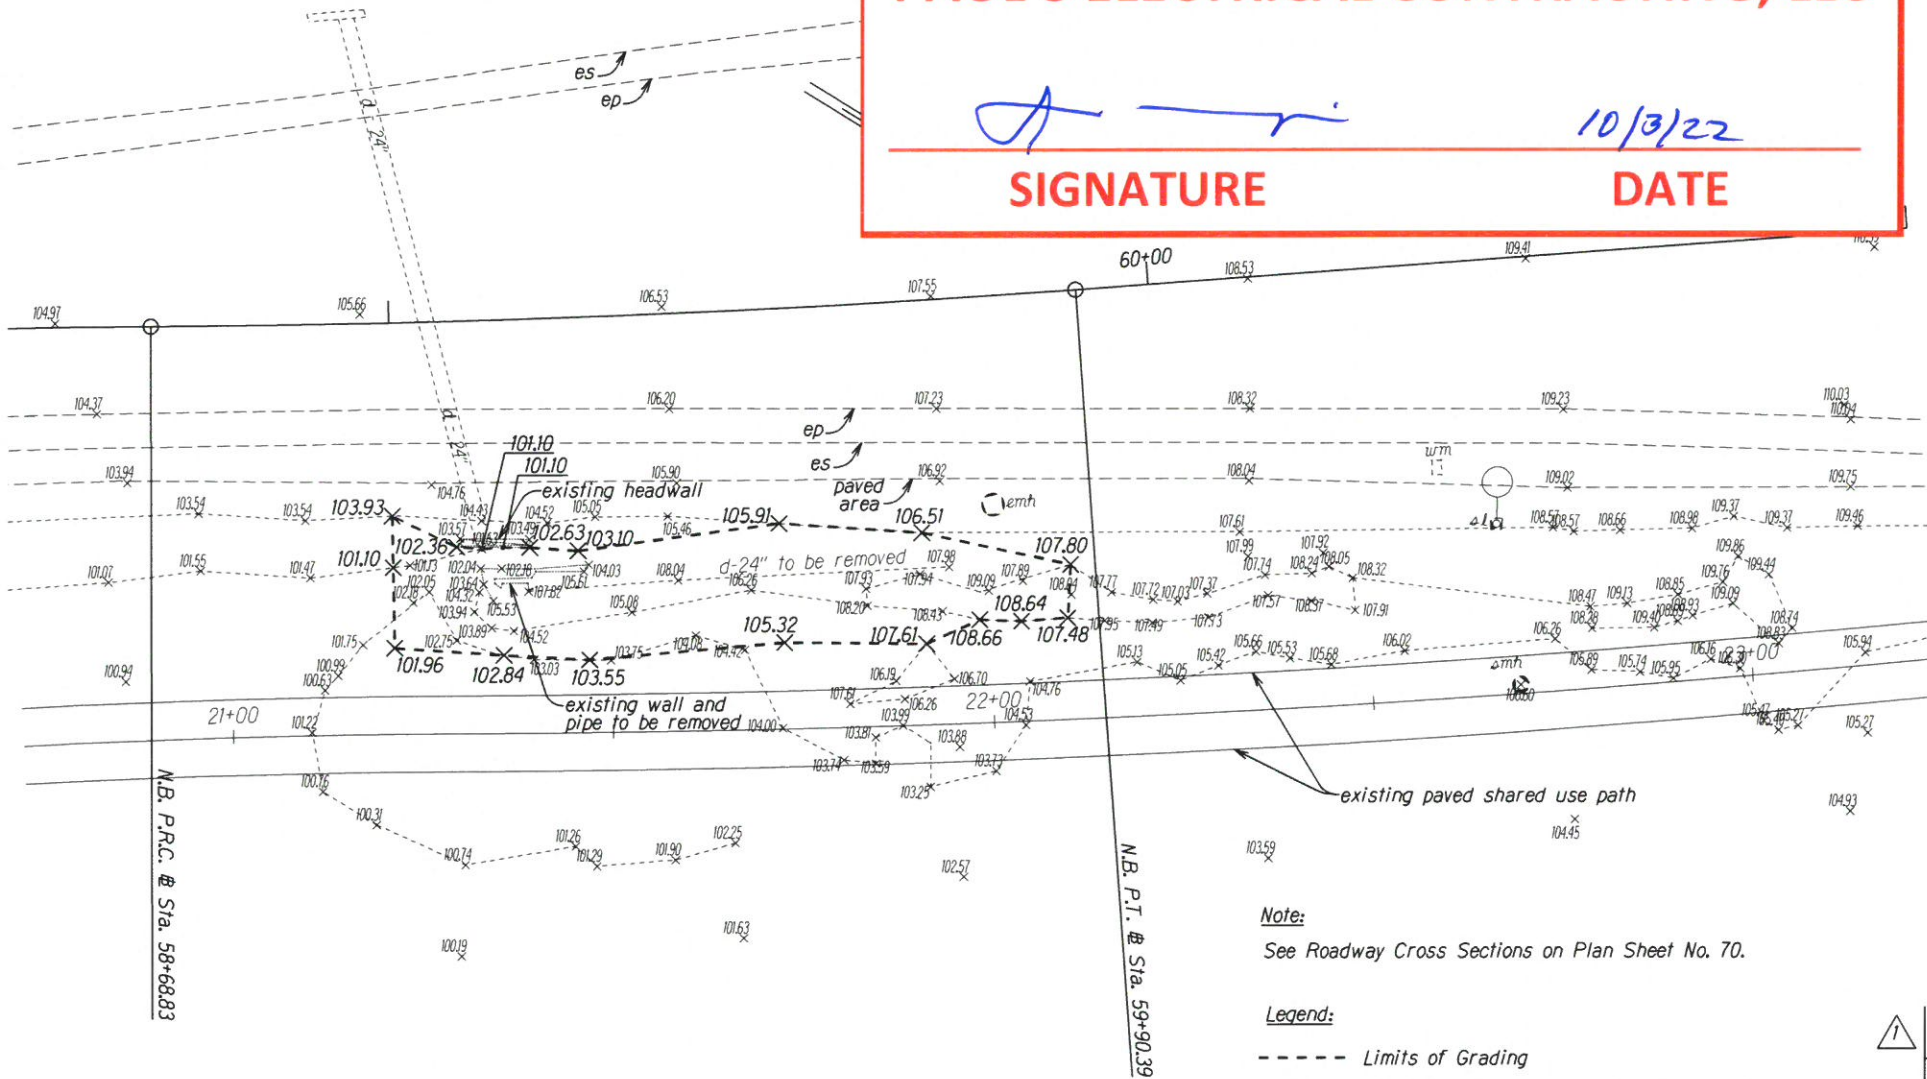

GRADING PLAN AT EXISTING IRRIGATION PIPE REMOVAL
N.B. @ Sta. 59+00± Rt. to Sta. 59+87.2± Rt.
Scale: 1" = 10.0'

Note:
See Roadway Cross Sections on Plan Sheet No. 70.

Legend:
--- Limits of Grading
100.00 x Finish Elevation to Match Existing Elevation
100.00 Finish Elevation

2/22/22	Added new sheet.
DATE	REVISION
STATE OF HAWAII DEPARTMENT OF TRANSPORTATION HIGHWAYS DIVISION	
GRADING PLAN	
FORT BARRETTE ROAD OPERATIONAL IMPROVEMENTS Roosevelt Avenue to Farrington Highway Project No. 901A-01-19	
Scale: 1" = 10.0' Date: January, 2020	
SHEET No. 1 OF 1 SHEETS	

"AS-BUILT"

C.O. 46S-1