


FED. ROAD DIST. NO.	STATE	FED. AID PROJ. NO.	FISCAL YEAR	SHEET NO.	TOTAL SHEETS
HAWAII	HAW.	901A-01-19	2020	C.O.41	167

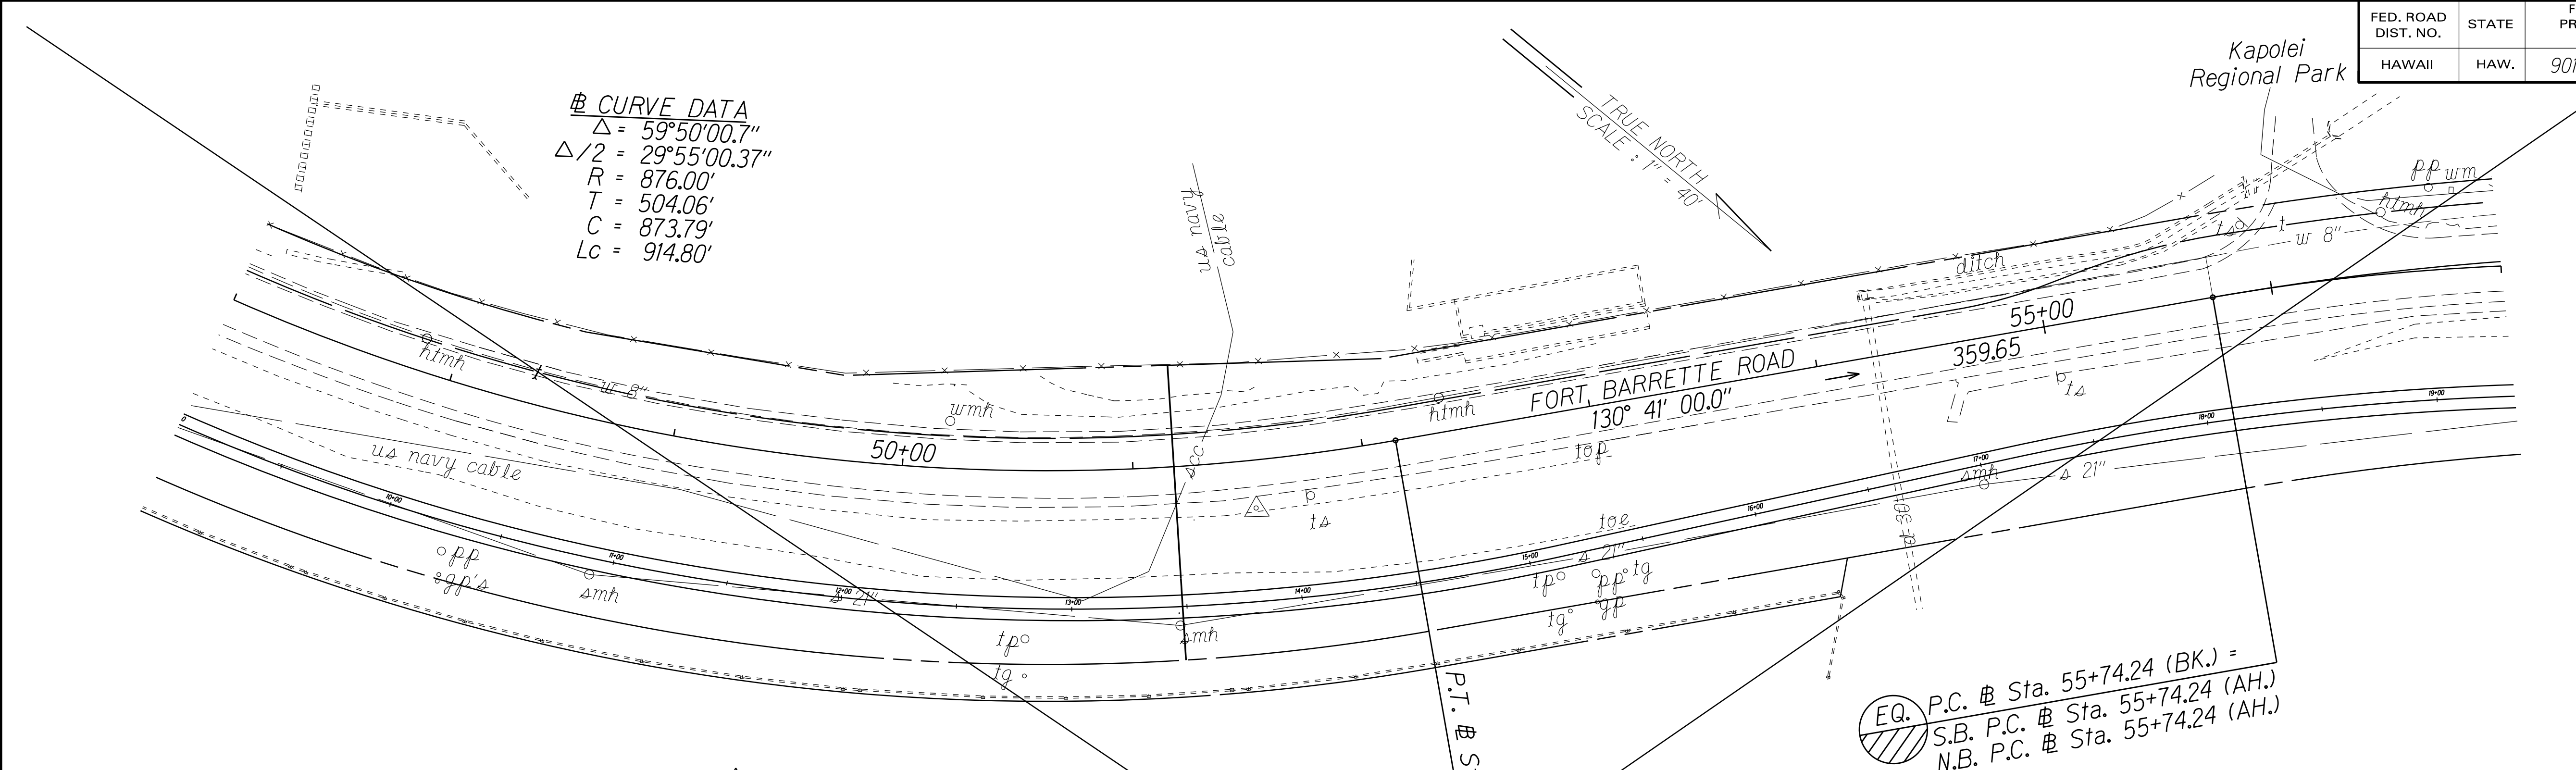


CURVE DATA
 $\Delta = 59^{\circ}50'00.7''$
 $\Delta/2 = 29^{\circ}55'00.37''$
 $R = 876.00'$
 $T = 504.06'$
 $C = 873.79'$
 $Lc = 914.80'$

1 N.I.C.

EQ. P.C. # Sta. 55+74.24 (BK.) =
S.B. P.C. # Sta. 55+74.24 (AH.)
N.B. P.C. # Sta. 55+74.24 (AH.)

Note:
See Roadway Plans for complete information.

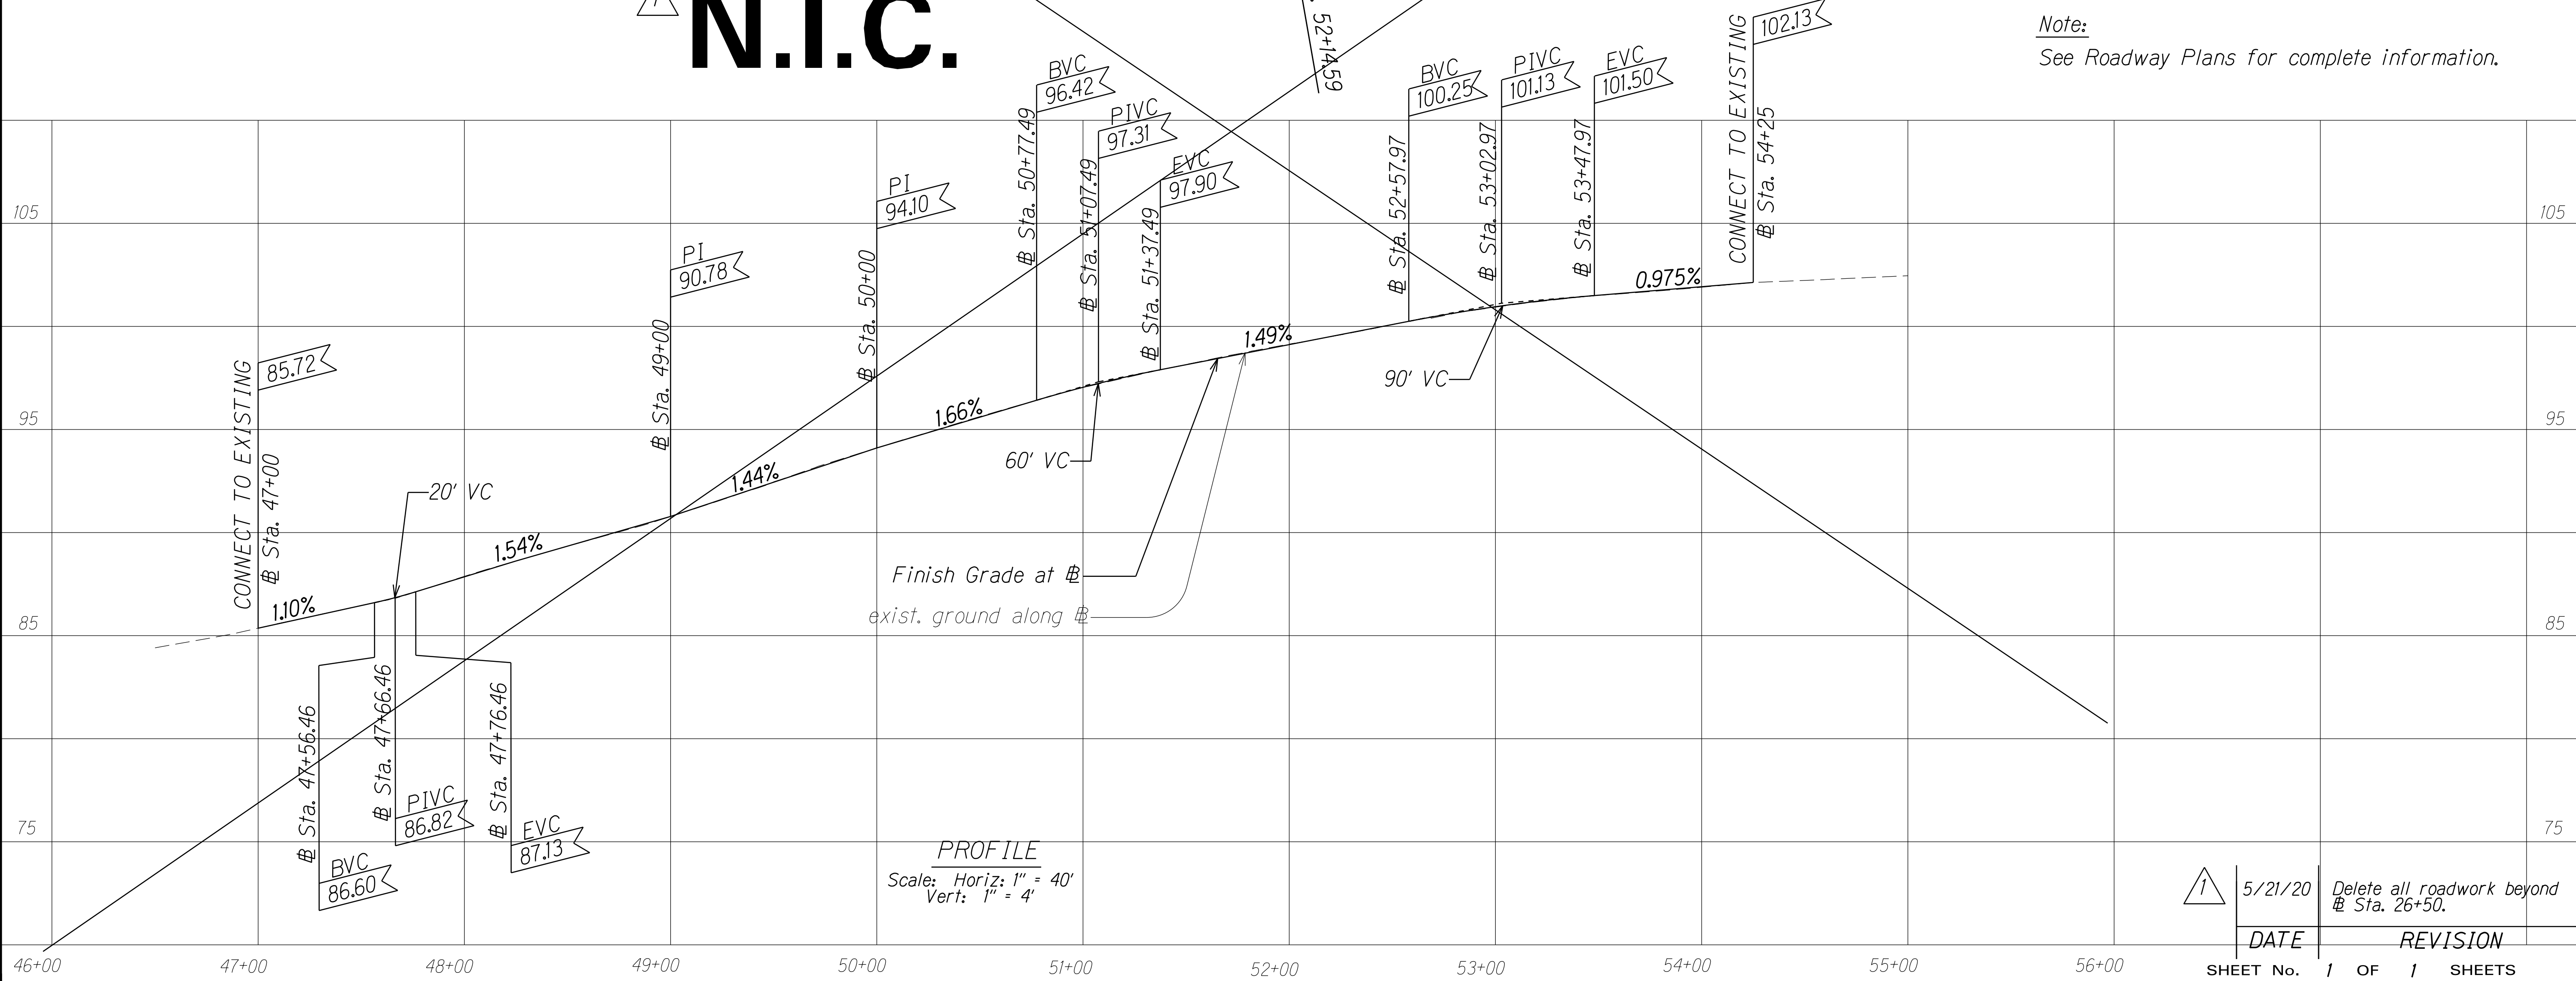

PROFILE
Scale: Horiz: 1" = 40'
Vert: 1" = 4'

ORIGINAL PLAN	SURVEY PLOTTED BY	DATE
NOTE BOOK	DRAWN BY	
	DESIGNED BY	
	CHECKED BY	

1	5/21/20	Delete all roadwork beyond # Sta. 26+50.
DATE	REVISION	

SHEET No. 1 OF 1 SHEETS