



10 20 30 40 50 70

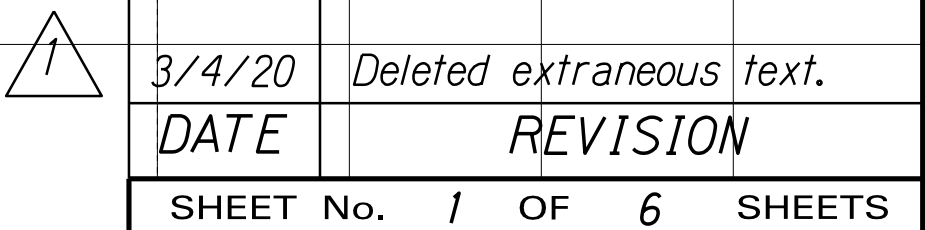


ORIGINAL PLAN	SURVEY PLOTTED BY _____	DATE _____
NOTE BOOK	DRAWN BY _____	_____
	TRACED BY _____	_____
	DESIGNED BY _____	_____
	QUANTITIES BY _____	_____
N _e _____	CHECKED BY _____	_____

40	50	60	70	
----	----	----	----	--

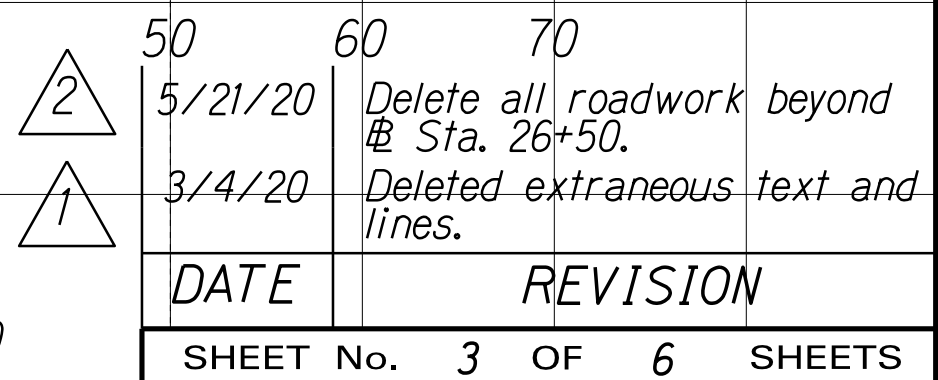


ORIGINAL PLAN	SURVEY PLOTTED BY _____	DATE _____
NOTE BOOK	DRAWN BY _____	•
	TRACED BY _____	•
	DESIGNED BY _____	•
	QUANTITIES BY _____	•
N _o _____	CHECKED BY _____	•

40 50 60 70

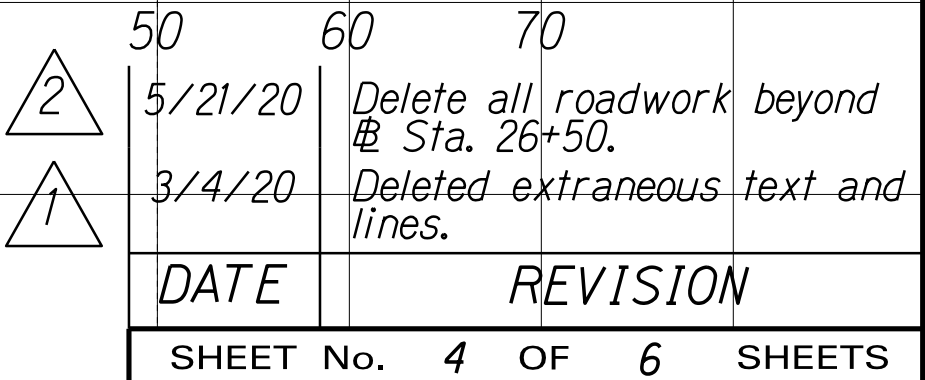


ORIGINAL PLAN	SURVEY PLOTTED BY _____	DATE _____
NOTE BOOK	DRAWN BY _____	•
	TRACED BY _____	•
	DESIGNED BY _____	•
	QUANTITIES BY _____	•
N _o _____	CHECKED BY _____	•

40 50 60 70

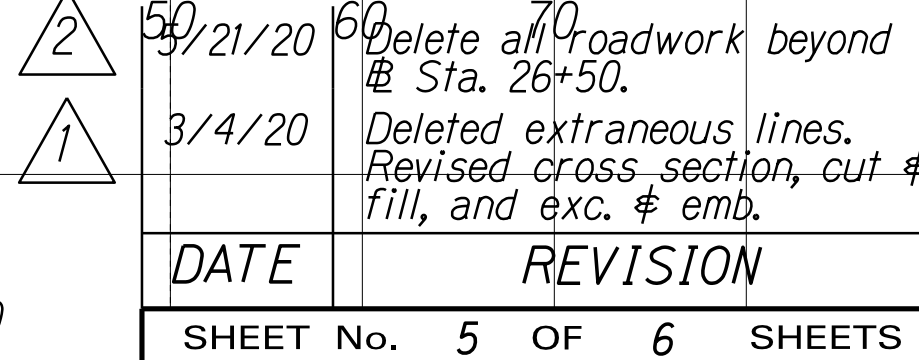

ORIGINAL PLAN	SURVEY PLOTTED BY _____	DATE _____
NOTE BOOK	DRAWN BY _____	_____
	TRACED BY _____	_____
	DESIGNED BY _____	_____
	QUANTITIES BY _____	_____
N _e _____	CHECKED BY _____	_____

DESIGNED BY	DATE
TRACED BY	
NOTED BY	
CHECKED BY	
N.	

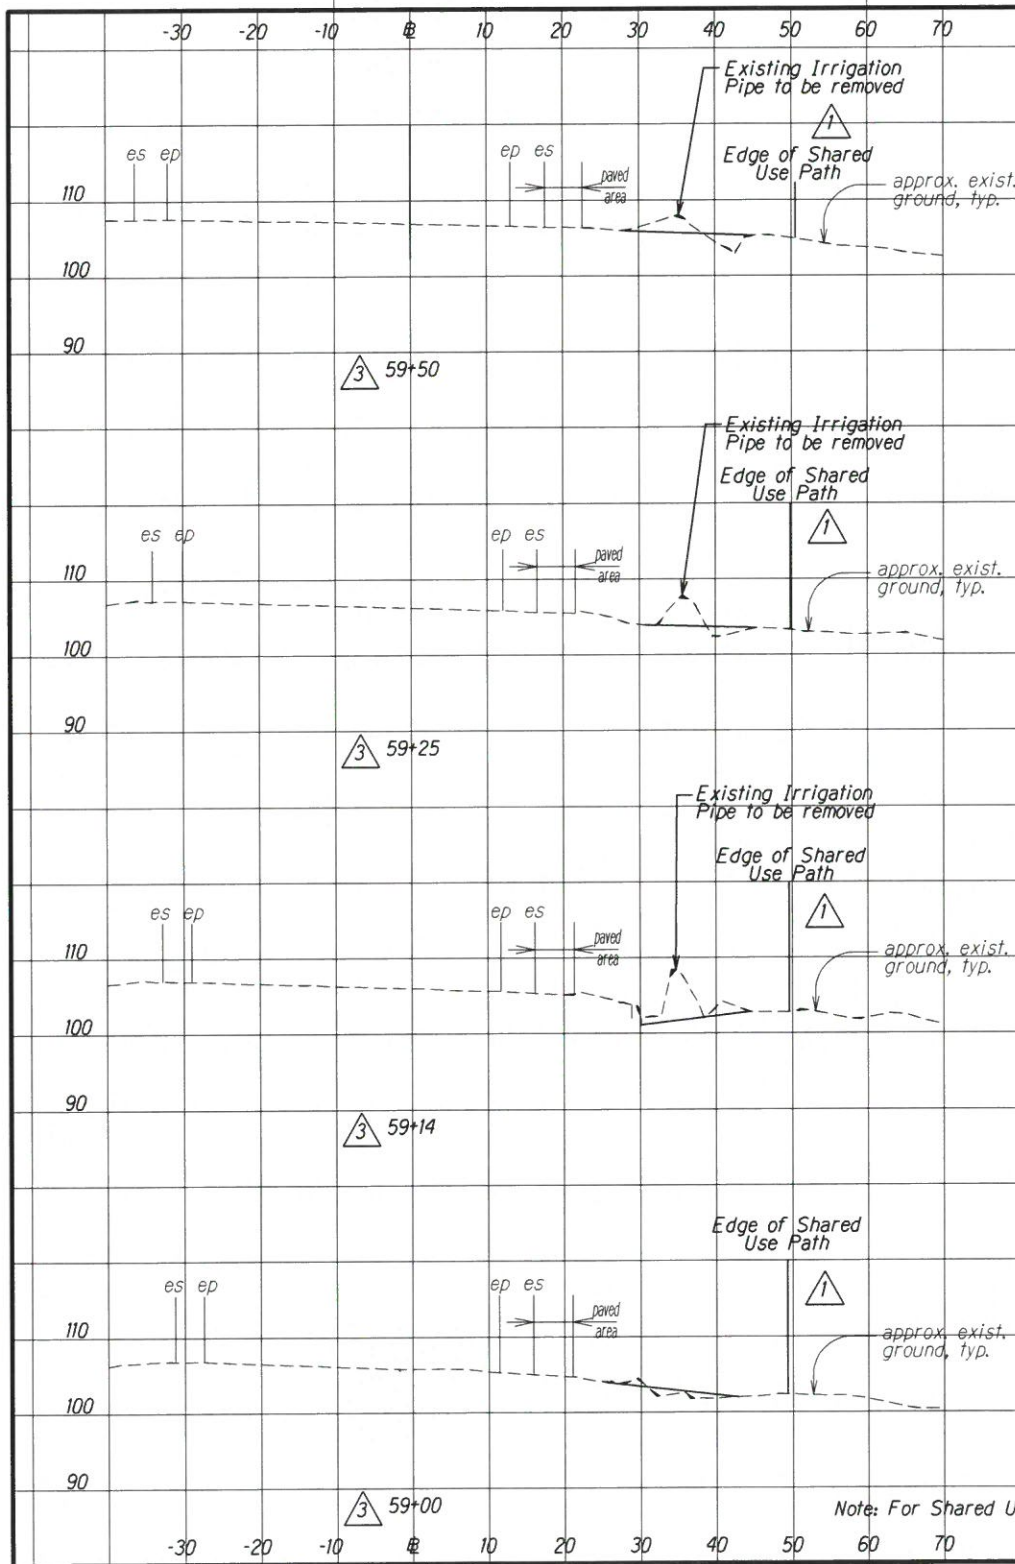

ROADWAY
CROSS SECTIONS
Scale: 1" = 10'-0"

Note: For Shared Use Path cross sections, see Shared Use Path Plans.

ASBUILT DRAWINGS

AS-BUILT


PAUL'S ELECTRICAL CONTRACTING, LLC

SIGNATURE

10/3/22

DATE

2 N.I.C.

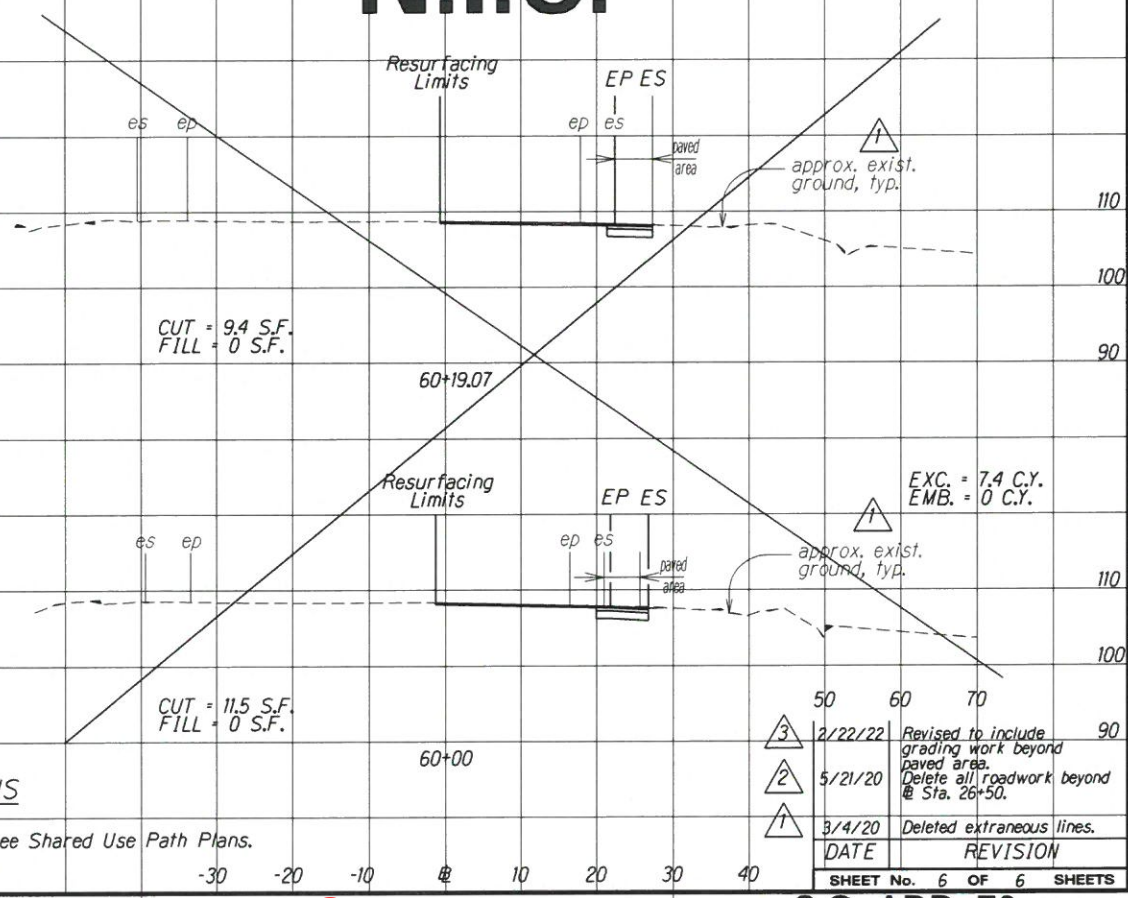

3	2/22/22	Revised to include grading work beyond paved area.
2	5/21/20	Delete all roadwork beyond Sta. 26+50.
1	3/4/20	Deleted extraneous lines.
DATE		REVISION

"AS-BUILT"

C.O. ADD. 70

FED. ROAD DIST. NO.	STATE	PROJ. NO.	FISCAL YEAR	SHEET NO.	TOTAL SHEETS
HAWAII	HAW.	901A-01-19	2020	C.O. ADD. 70	167