
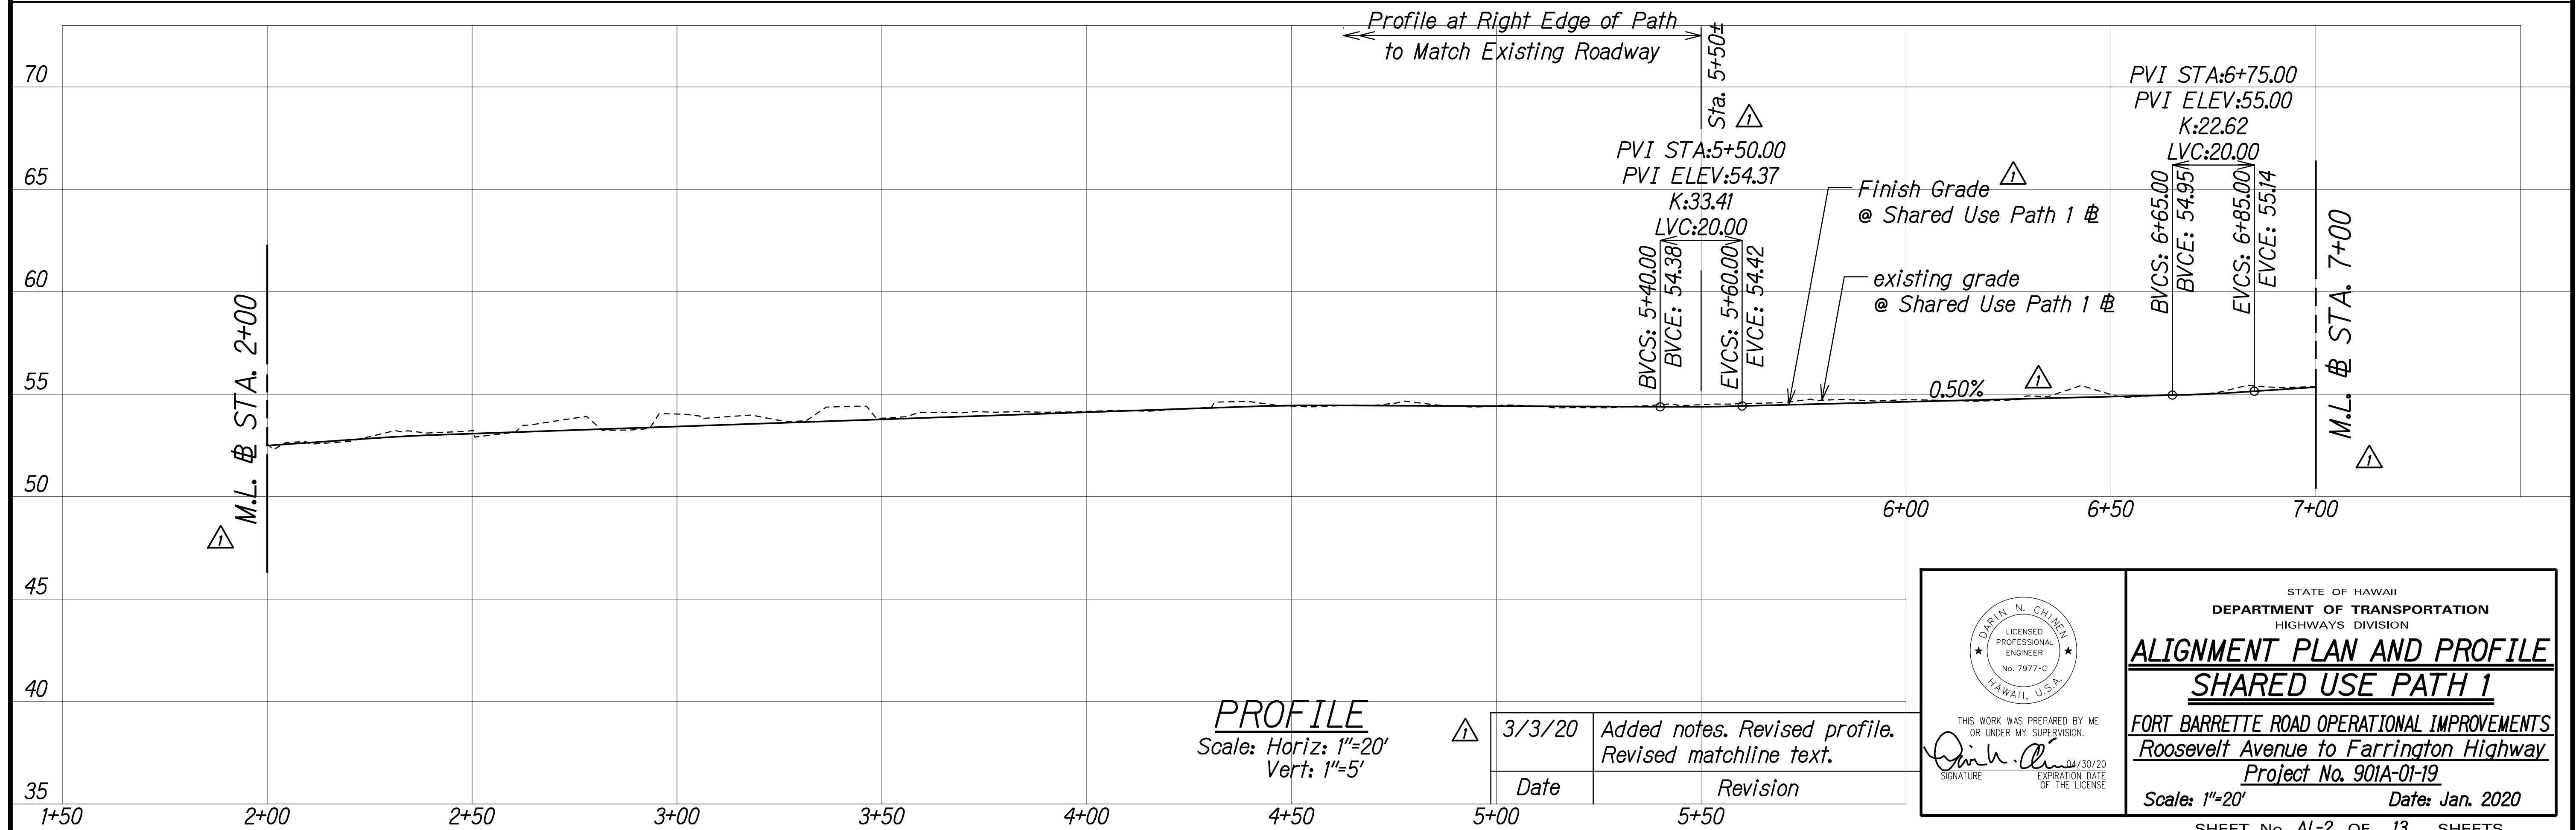


FED. ROAD DIST. NO.	STATE	PROJ. NO.	FISCAL YEAR	SHEET NO.	TOTAL SHEETS
HAWAII	HAW.	901A-01-19	2020	ADD. 72	167

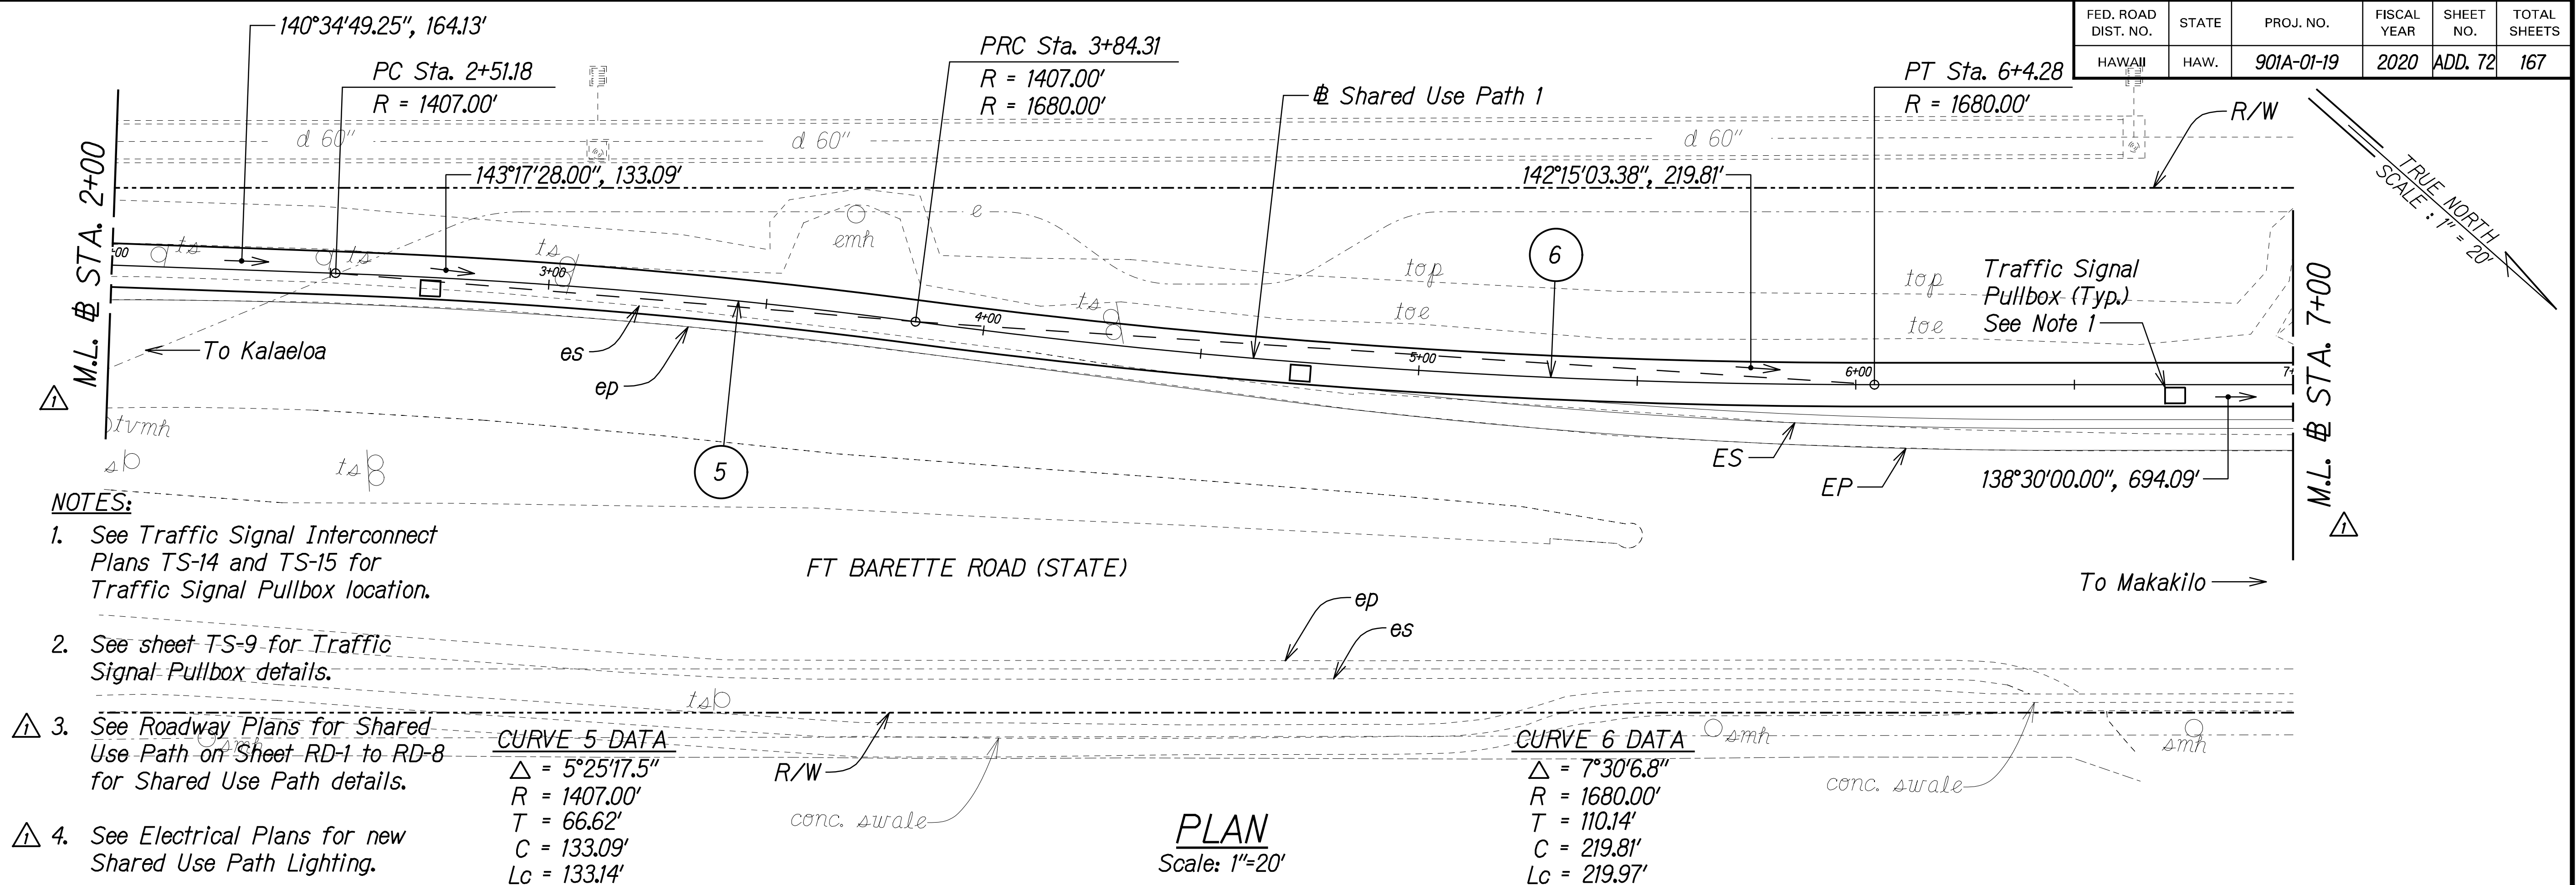


SURVEY PLOTTED BY	DATE
DRAWN BY	
DESIGNED BY	
QUANTITIES BY	
CHECKED BY	

THIS WORK WAS PREPARED BY ME OR UNDER MY SUPERVISION.

Signature: *Darin N. Chinen*

EXPIRATION DATE OF THE LICENSE: 04/30/20


FED. ROAD DIST. NO.	STATE	PROJ. NO.	FISCAL YEAR	SHEET NO.	TOTAL SHEETS
HAWAII	HAW.	901A-01-19	2020	ADD. 73	167

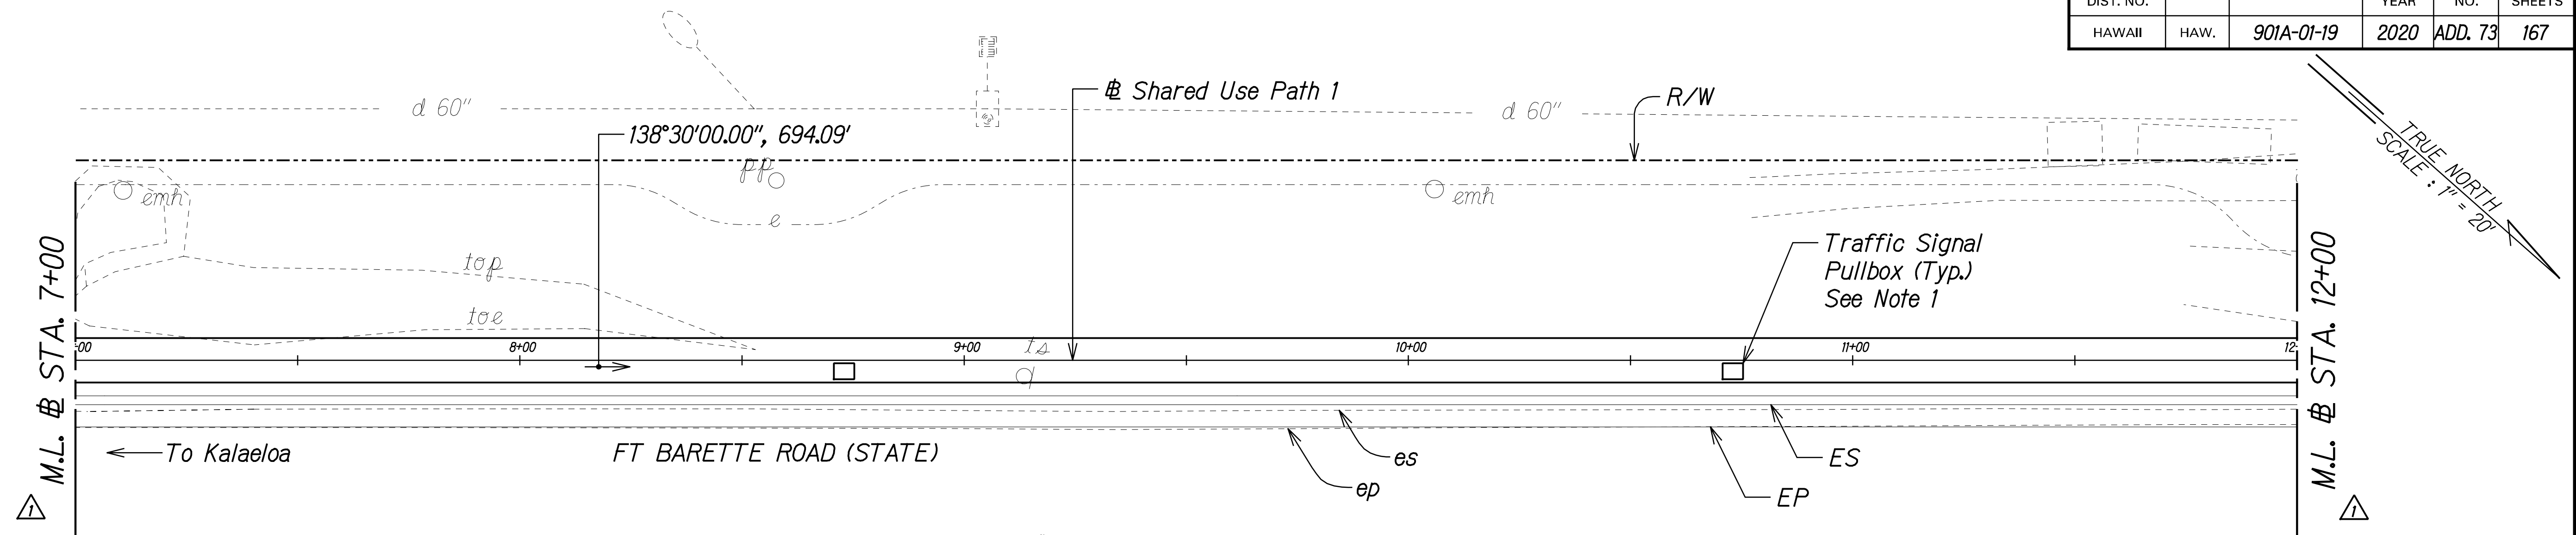

NOTES:

- See Traffic Signal Interconnect Plans TS-14 and TS-15 for Traffic Signal Pullbox location.
- See sheet TS-9 for Traffic Signal Pullbox details.
- See Roadway Plans for Shared Use Path on Sheet RD-1 to RD-8 for Shared Use Path details.
- See Electrical Plans for new Shared Use Path Lighting.

PLAN
Scale: 1"=20'

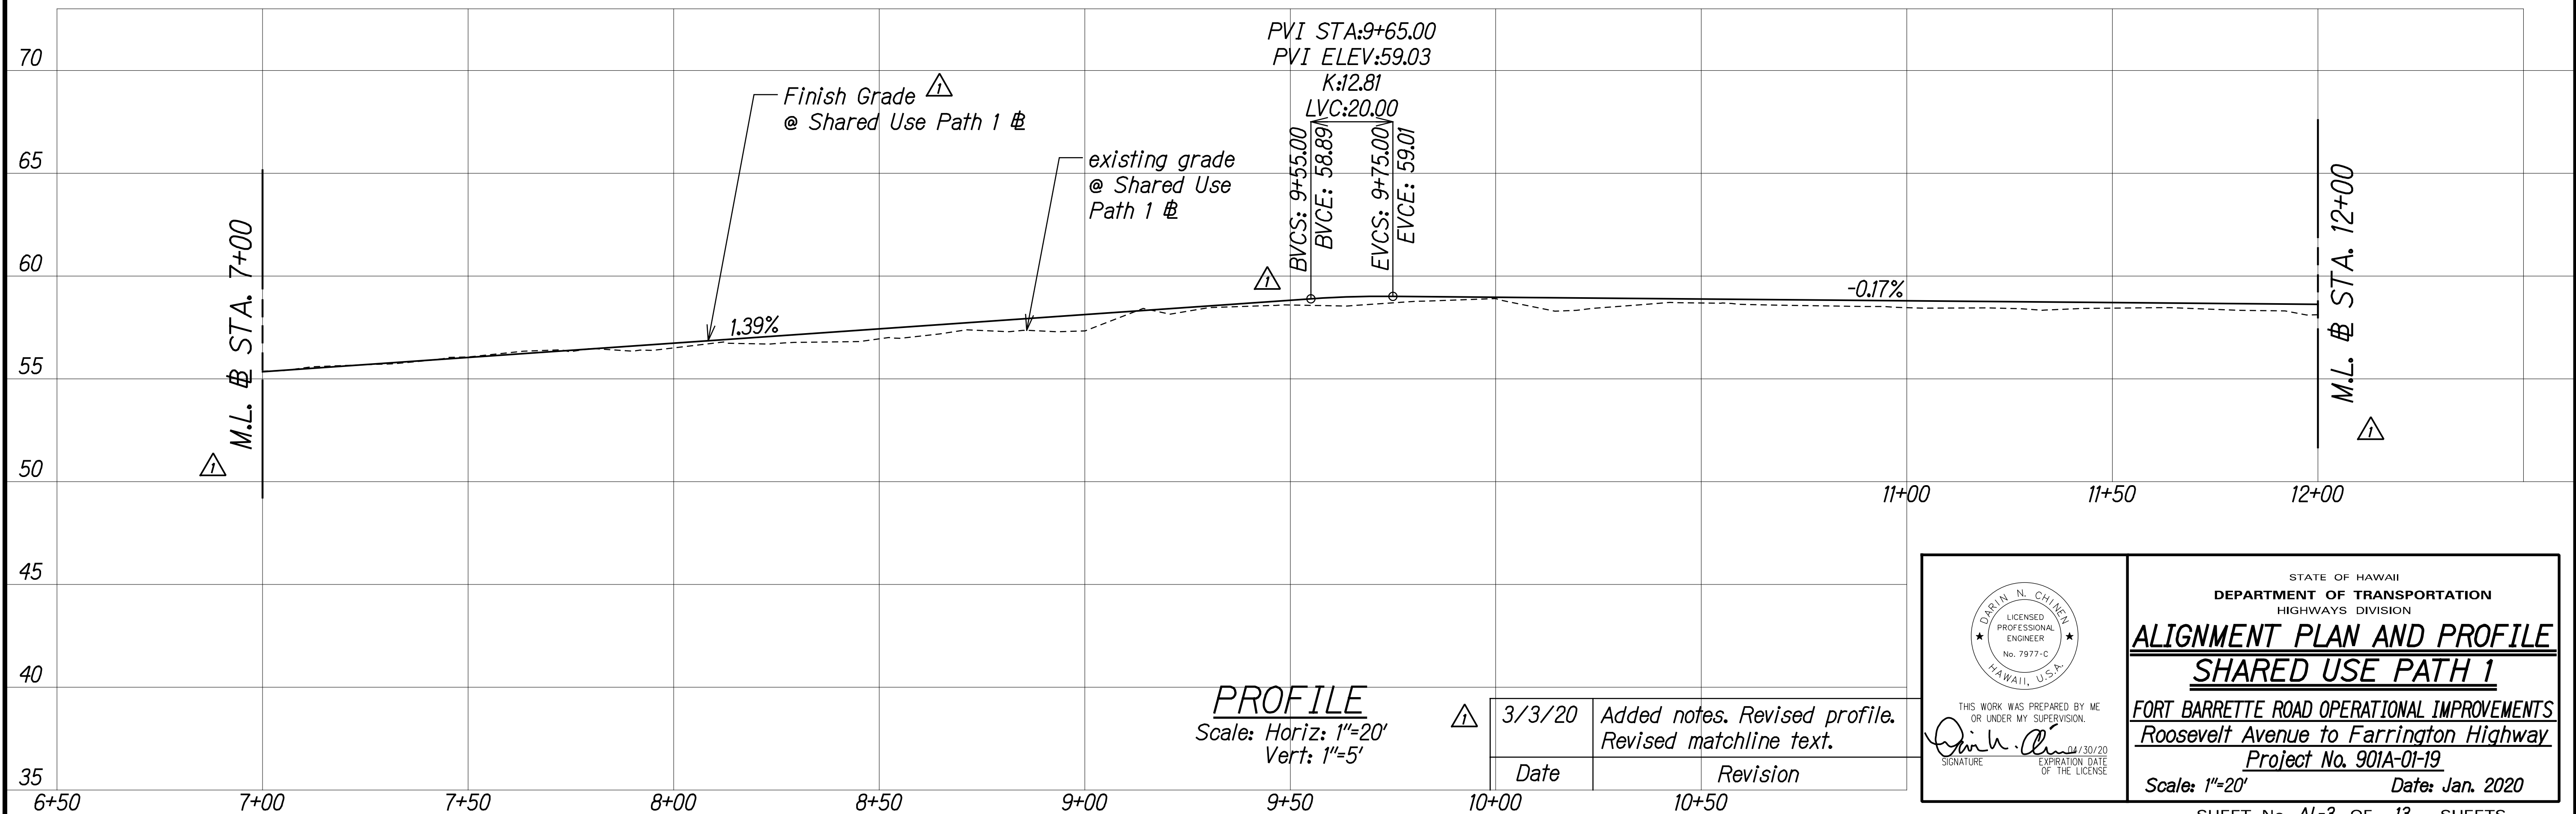

PROFILE
Scale: Horiz: 1"=20'
Vert: 1"=5'

3/3/20	Added notes. Revised profile. Revised matchline text.
Date	Revision

STATE OF HAWAII
DEPARTMENT OF TRANSPORTATION
HIGHWAYS DIVISION

ALIGNMENT PLAN AND PROFILE
SHARED USE PATH 1

FORT BARRET

FED. ROAD DIST. NO.	STATE	PROJ. NO.	FISCAL YEAR	SHEET NO.	TOTAL SHEETS
HAWAII	HAW.	901A-01-19	2020	ADD. 74	167

NOTES:


1. See Traffic Signal Interconnect Plans TS-14 and TS-15 for Traffic Signal Pullbox location.

2. See sheet TS-9 for Traffic Signal Pullbox details.
3. See Roadway Plans for Shared Use Path on Sheet RD-1 to RD-8 for Shared Use Path details.


4. See Electrical Plans for new Shared Use Path Lighting.

CURVE 7 DATA

$\Delta = 14^{\circ}0'0.0''$
 $R = 1615.00'$
 $T = 198.30'$
 $C = 393.64'$
 $Lc = 394.62'$

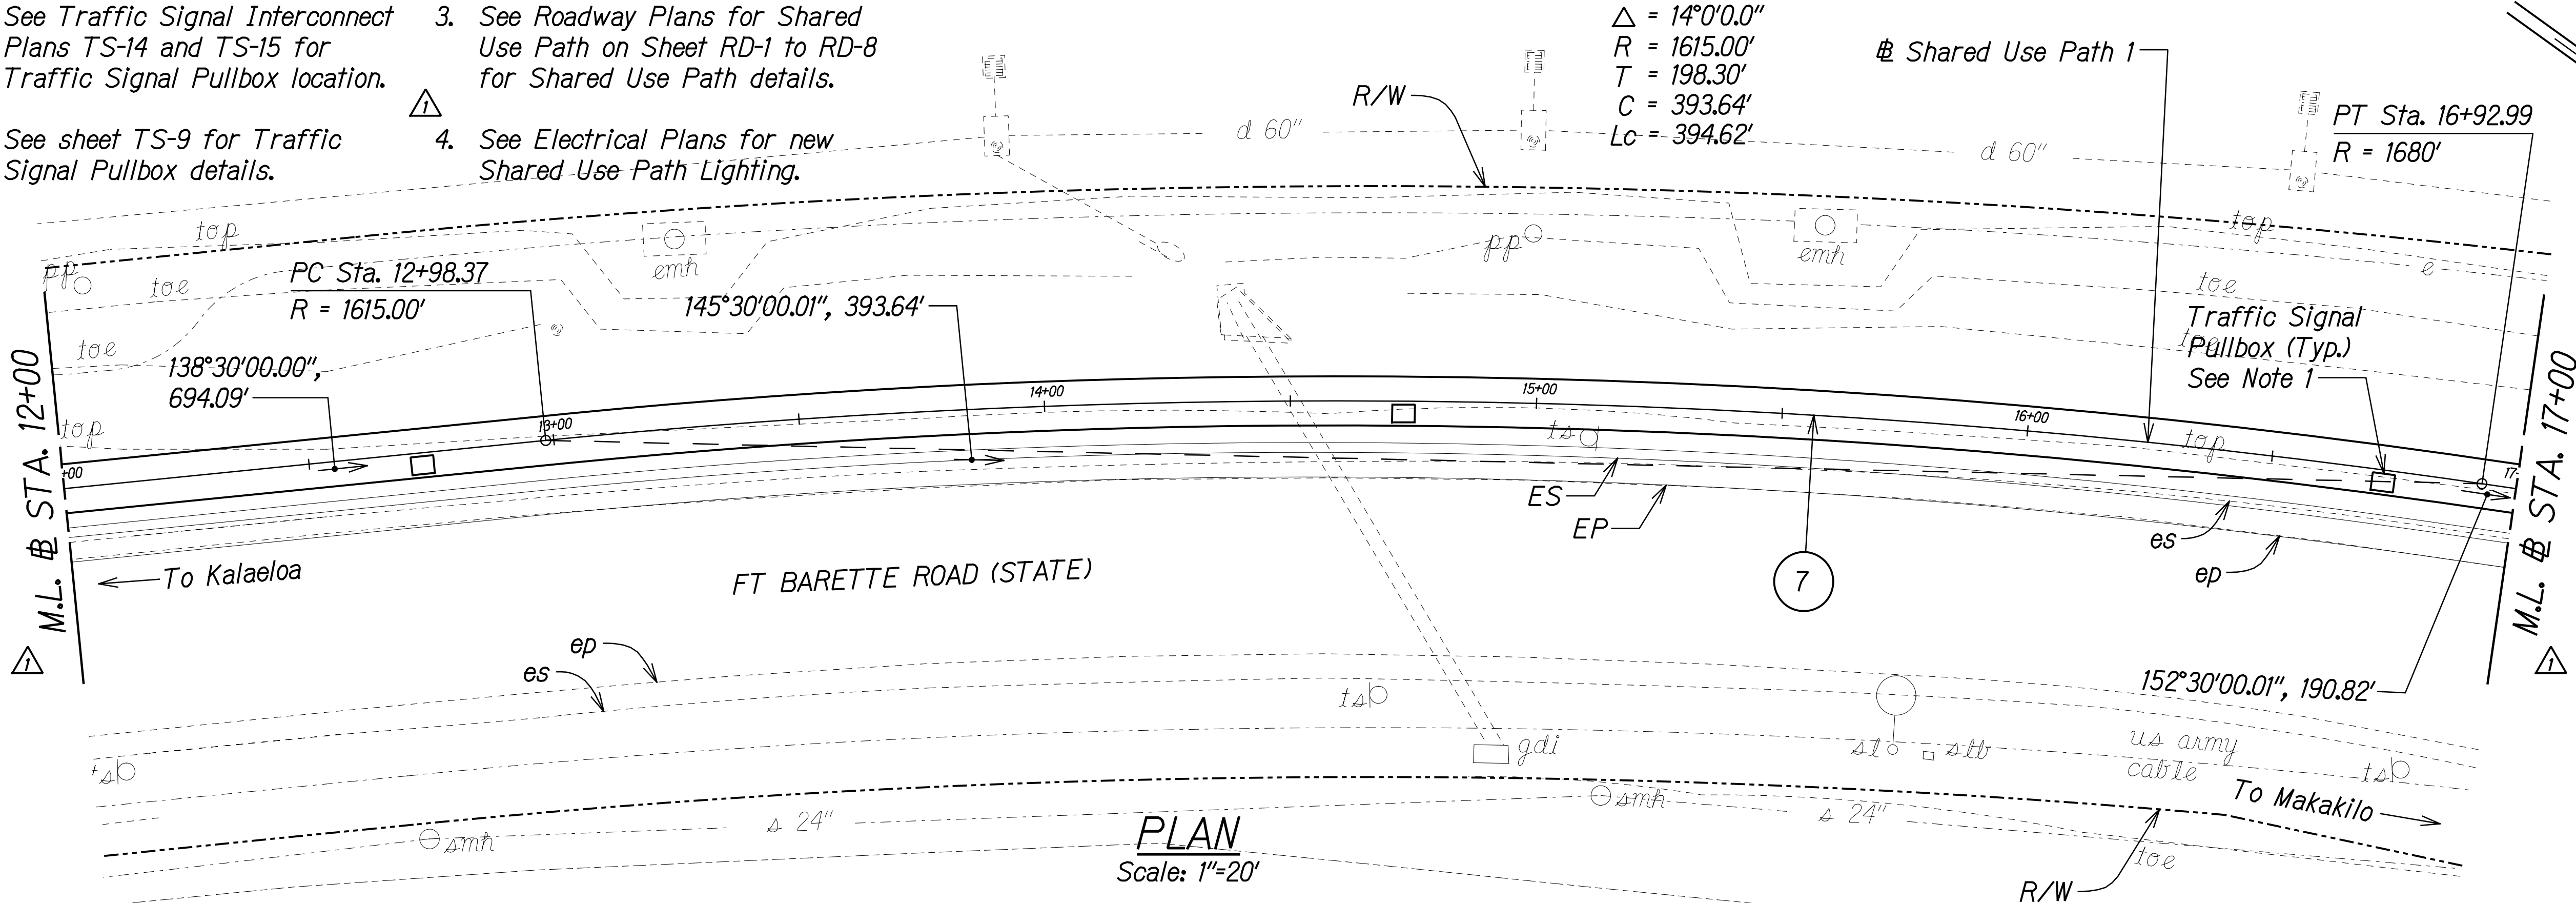

PLAN
Scale: 1"=20'

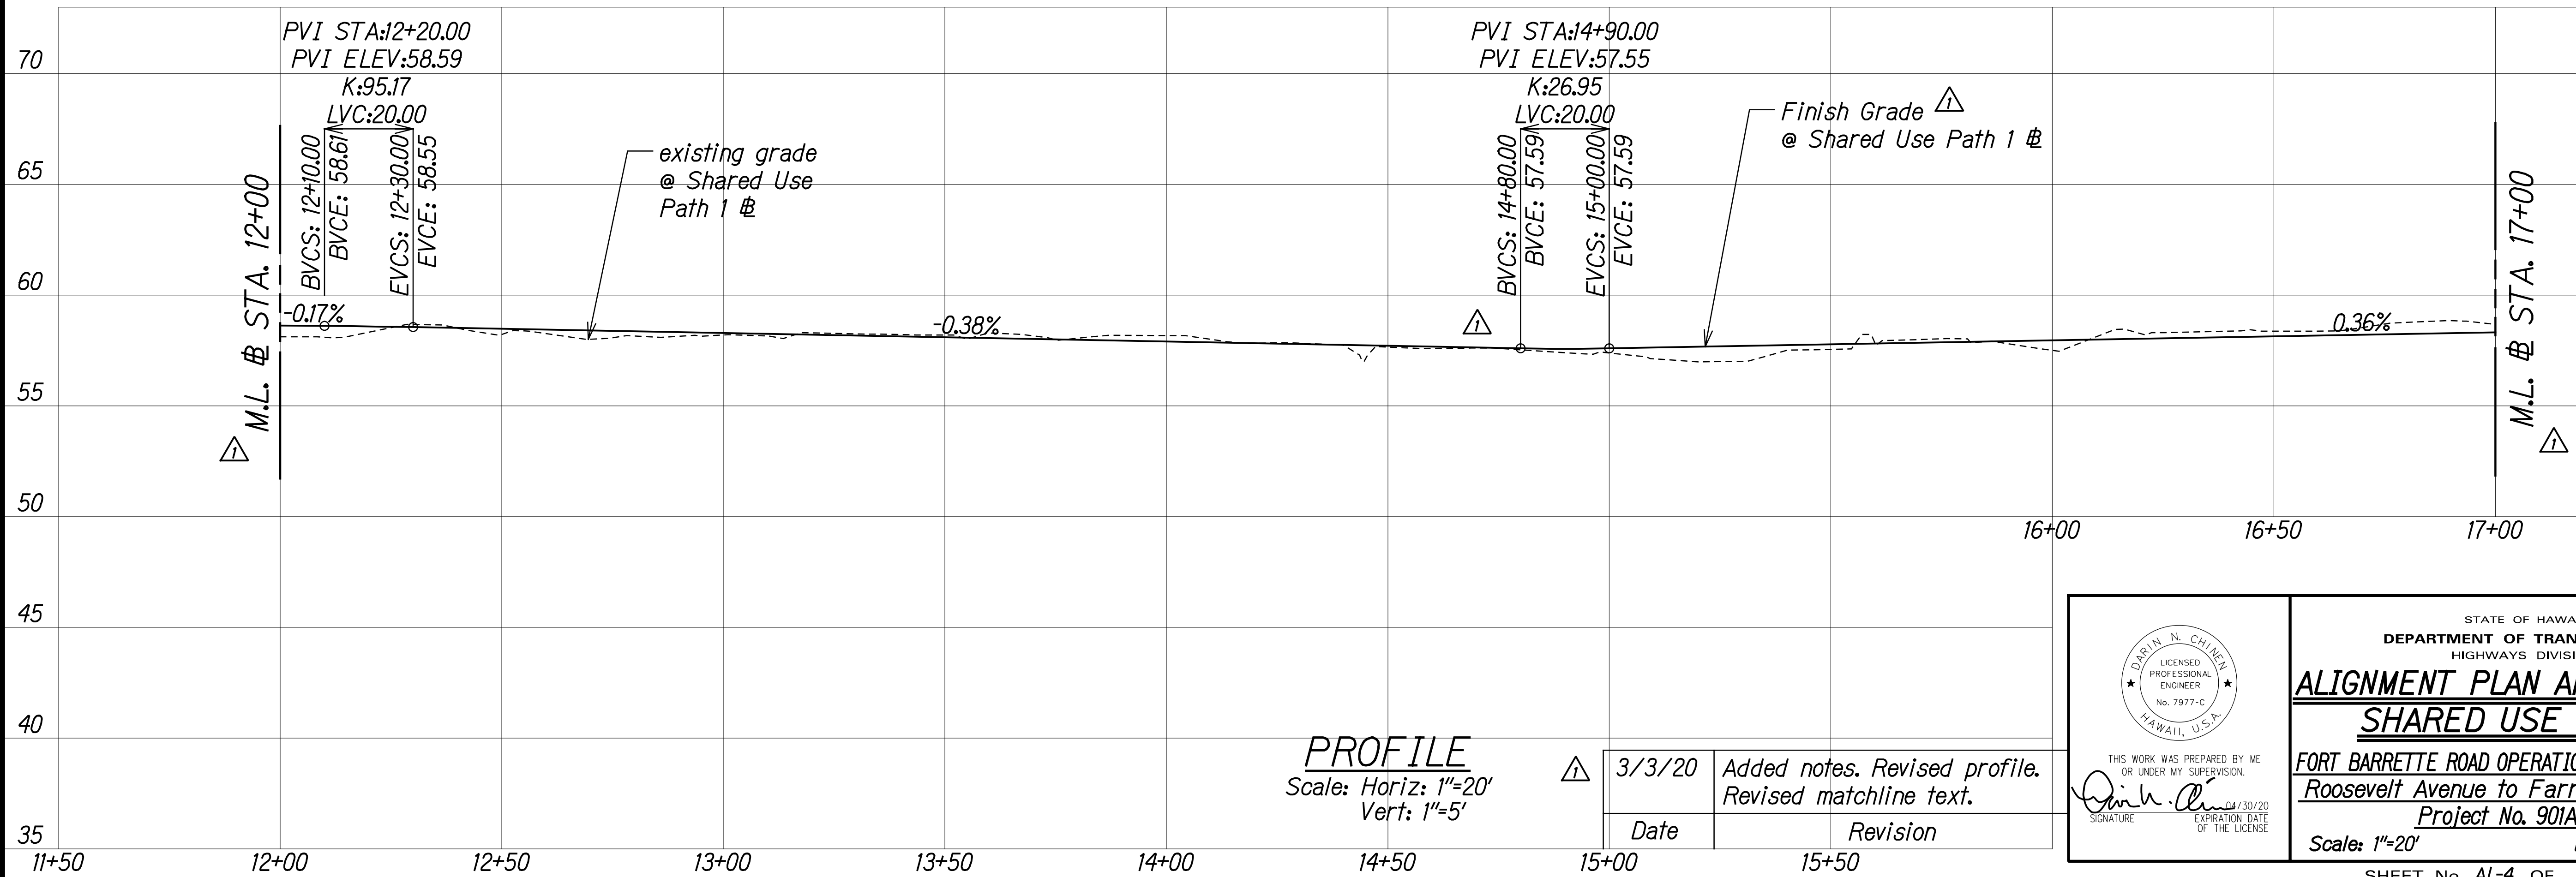

PROFILE
Scale: Horiz: 1"=20'
Vert: 1"=5'

3/3/20	Added notes. Revised profile. Revised matchline text.
Date	Revision

DATE

DRAWN BY

TRACED BY

DESIGNED BY

QUANTITIES BY

CHECKED BY

ORIGINAL PLAN

NOTE BOOK

N°

THIS WORK WAS PREPARED BY ME OR UNDER MY SUPERVISION.

Signature

EXPIRATION DATE OF THE LICENSE

7977-C

7/30/20

STATE OF HAWAII

DEPARTMENT OF TRANSPORTATION

HIGHWAYS DIVISION

ALIGNMENT PLAN AND PROFILE

SHARED USE PATH 1

FORT BARRETTE ROAD OPERATIONAL IMPROVEMENTS

Roosevelt Avenue to Farrington Highway



Project No. 901A-01-19

Scale: 1"=20'

Date: Jan. 2020





SHEET No. AL-4 OF 13 SHEETS

FED. ROAD DIST. NO.	STATE	PROJ. NO.	FISCAL YEAR	SHEET NO.	TOTAL SHEETS
HAWAII	HAW.	901A-01-19	2020	ADD. 75	167

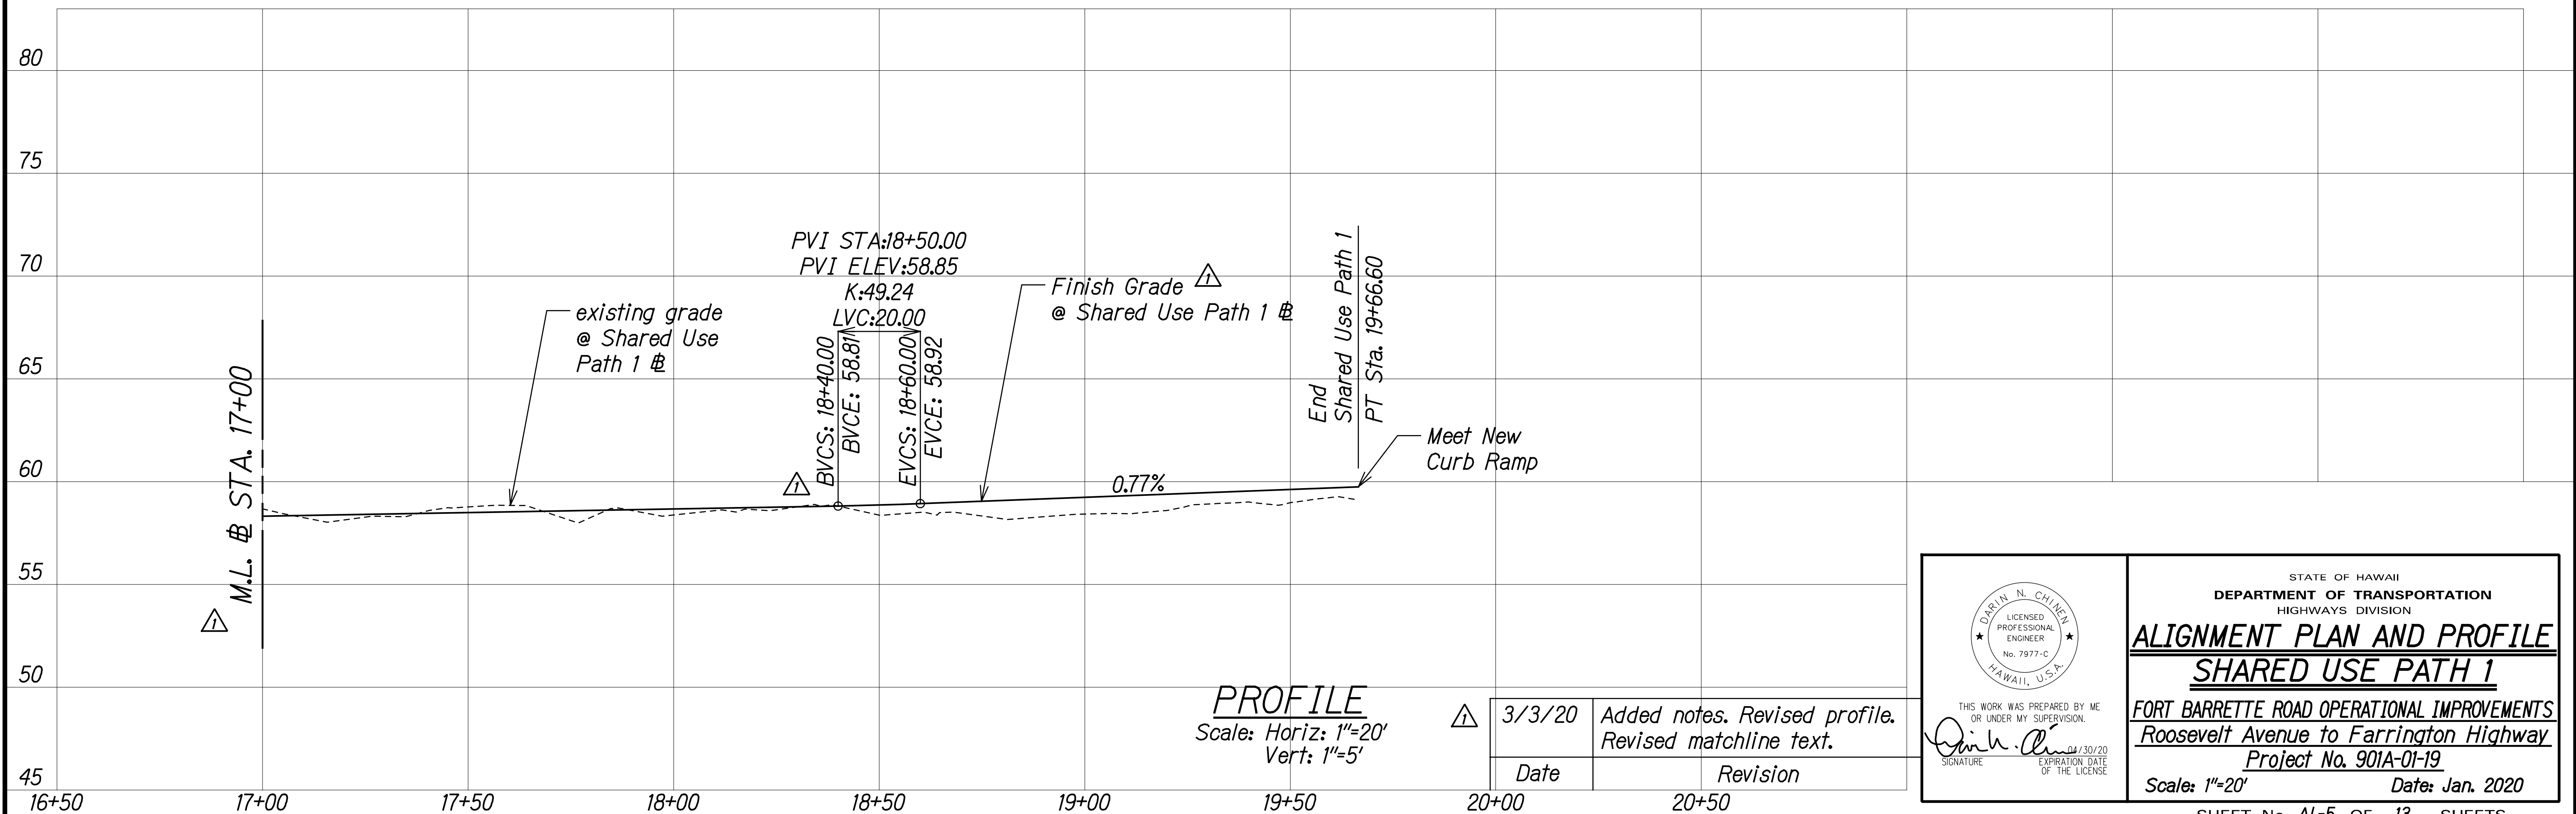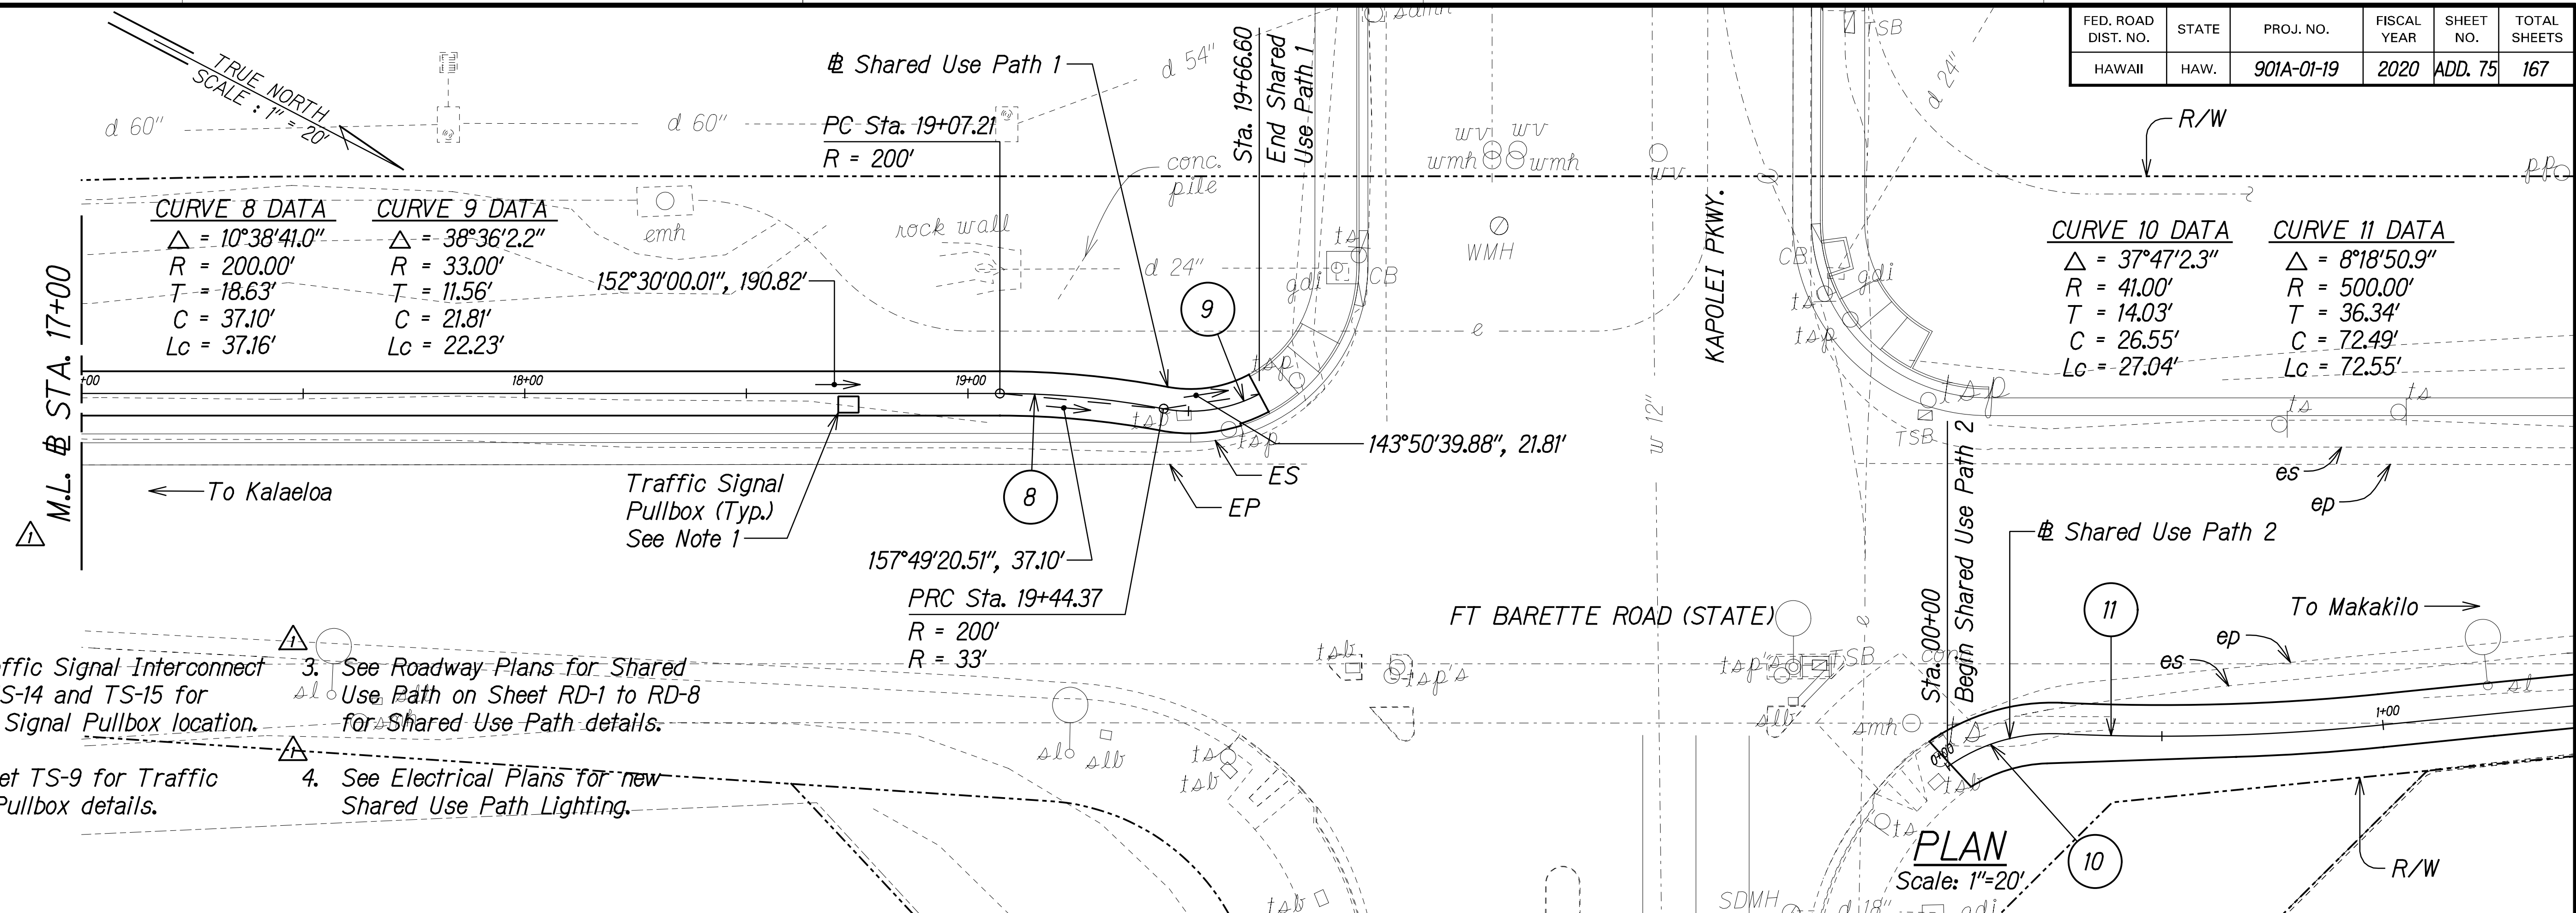

ORIGINAL PLAN


FED. ROAD DIST. NO.	STATE	PROJ. NO.	FISCAL YEAR	SHEET NO.	TOTAL SHEETS
HAWAII	HAW.	901A-01-19	2020	ADD. 103	167

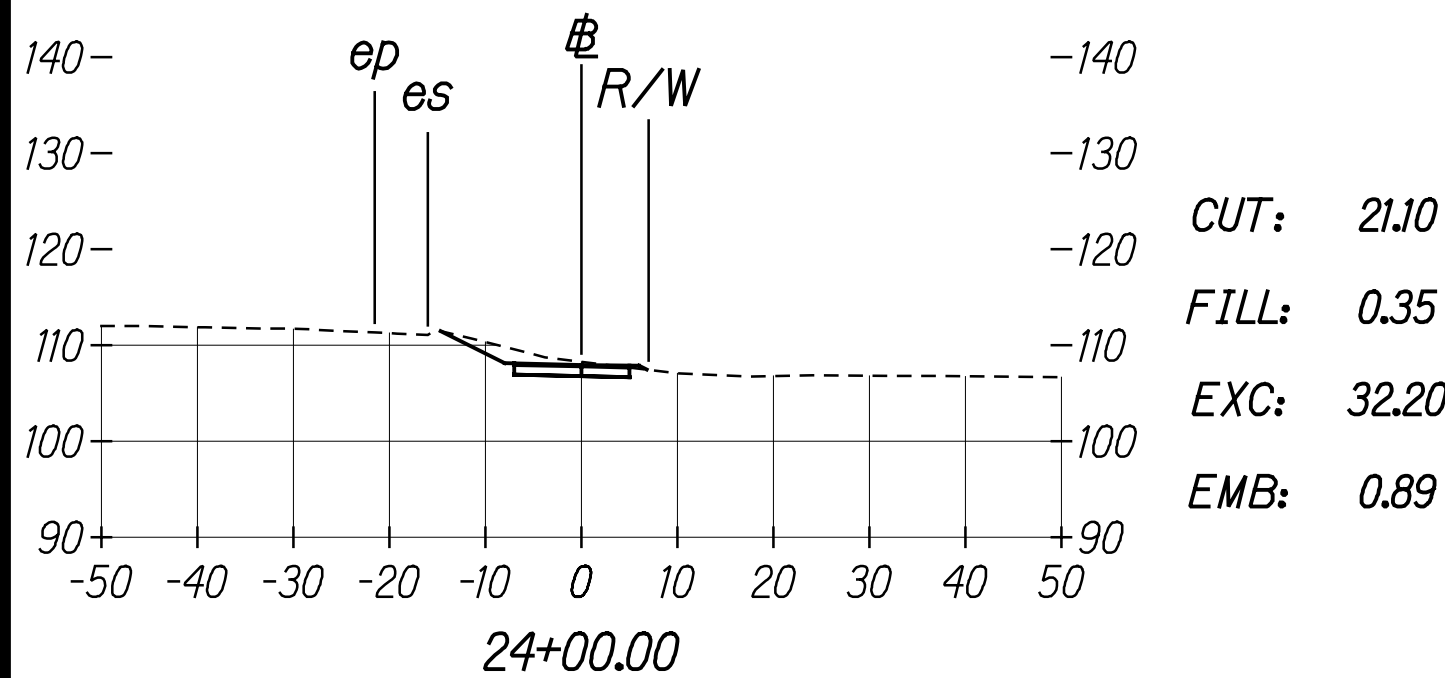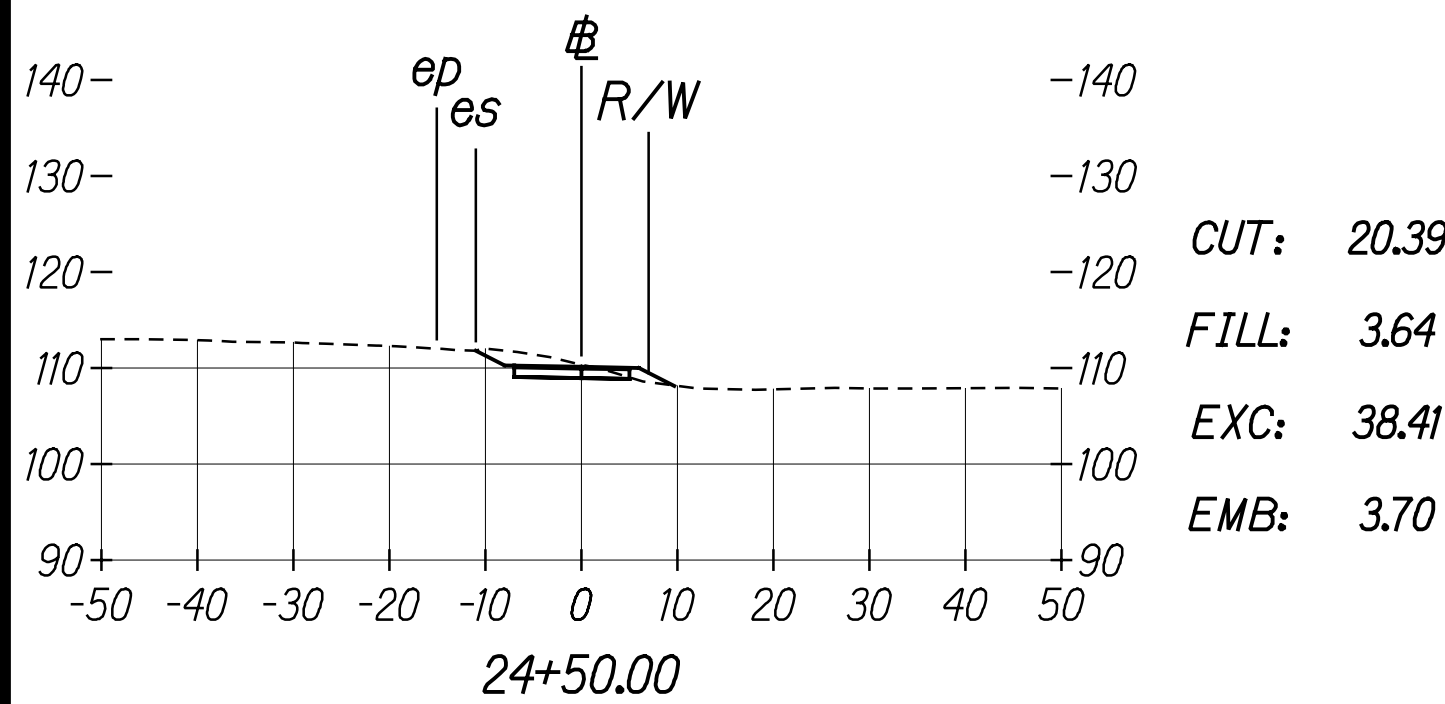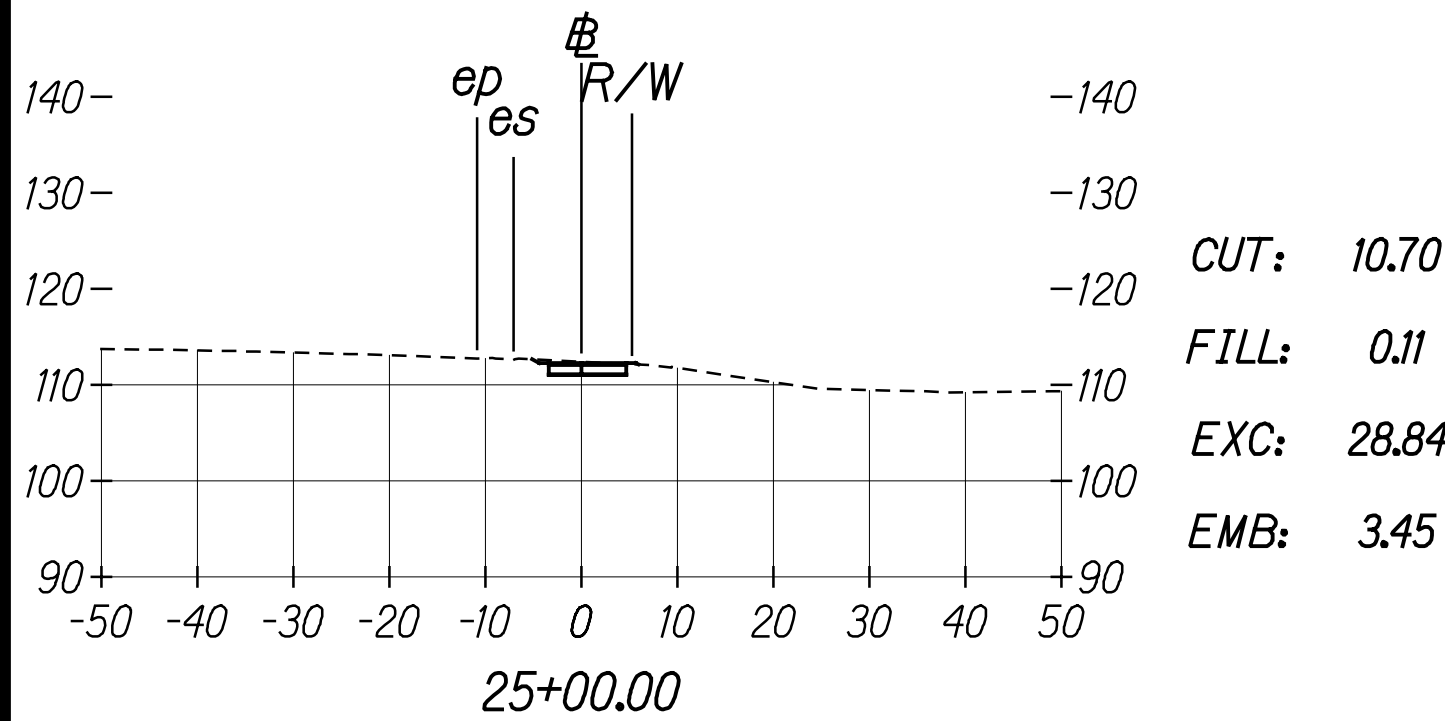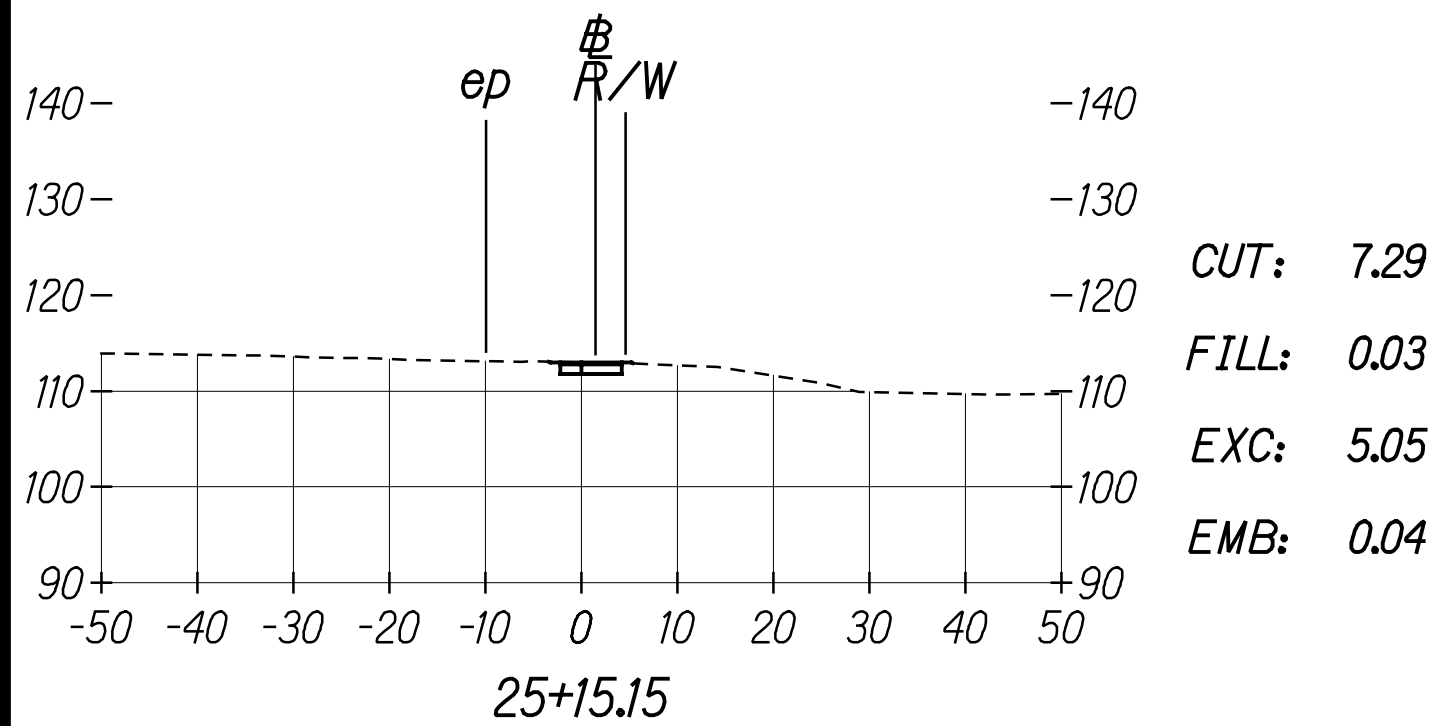

SUMMARY

SHARED USE PATH 3	EXC CU YD	EMB CU YD
TOTAL	1196	56

ORIGINAL PLAN	SURVEY PLOTTED BY	DATE
NOTE BOOK	DRAWN BY	
	DESIGNED BY	
	QUANTITIES BY	
	CHECKED BY	

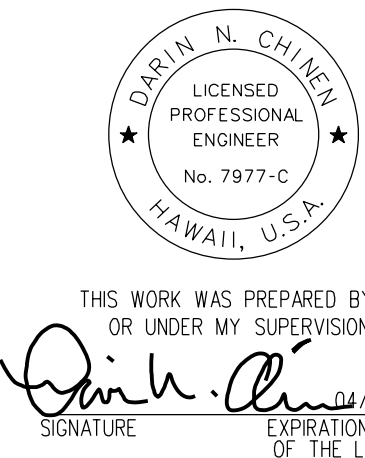

3/3/20	Revised All Cross Sections and Summary Schedule
Date	Revision
STATE OF HAWAII DEPARTMENT OF TRANSPORTATION HIGHWAYS DIVISION CROSS	