


FED. ROAD DIST. NO.	STATE	FEDERAL AID PROJ. NO.	FISCAL YEAR	SHEET NO.	TOTAL SHEETS
HAWAII	HAW.	HSIP-RR-0901(017)	2023	ADD. 18	117

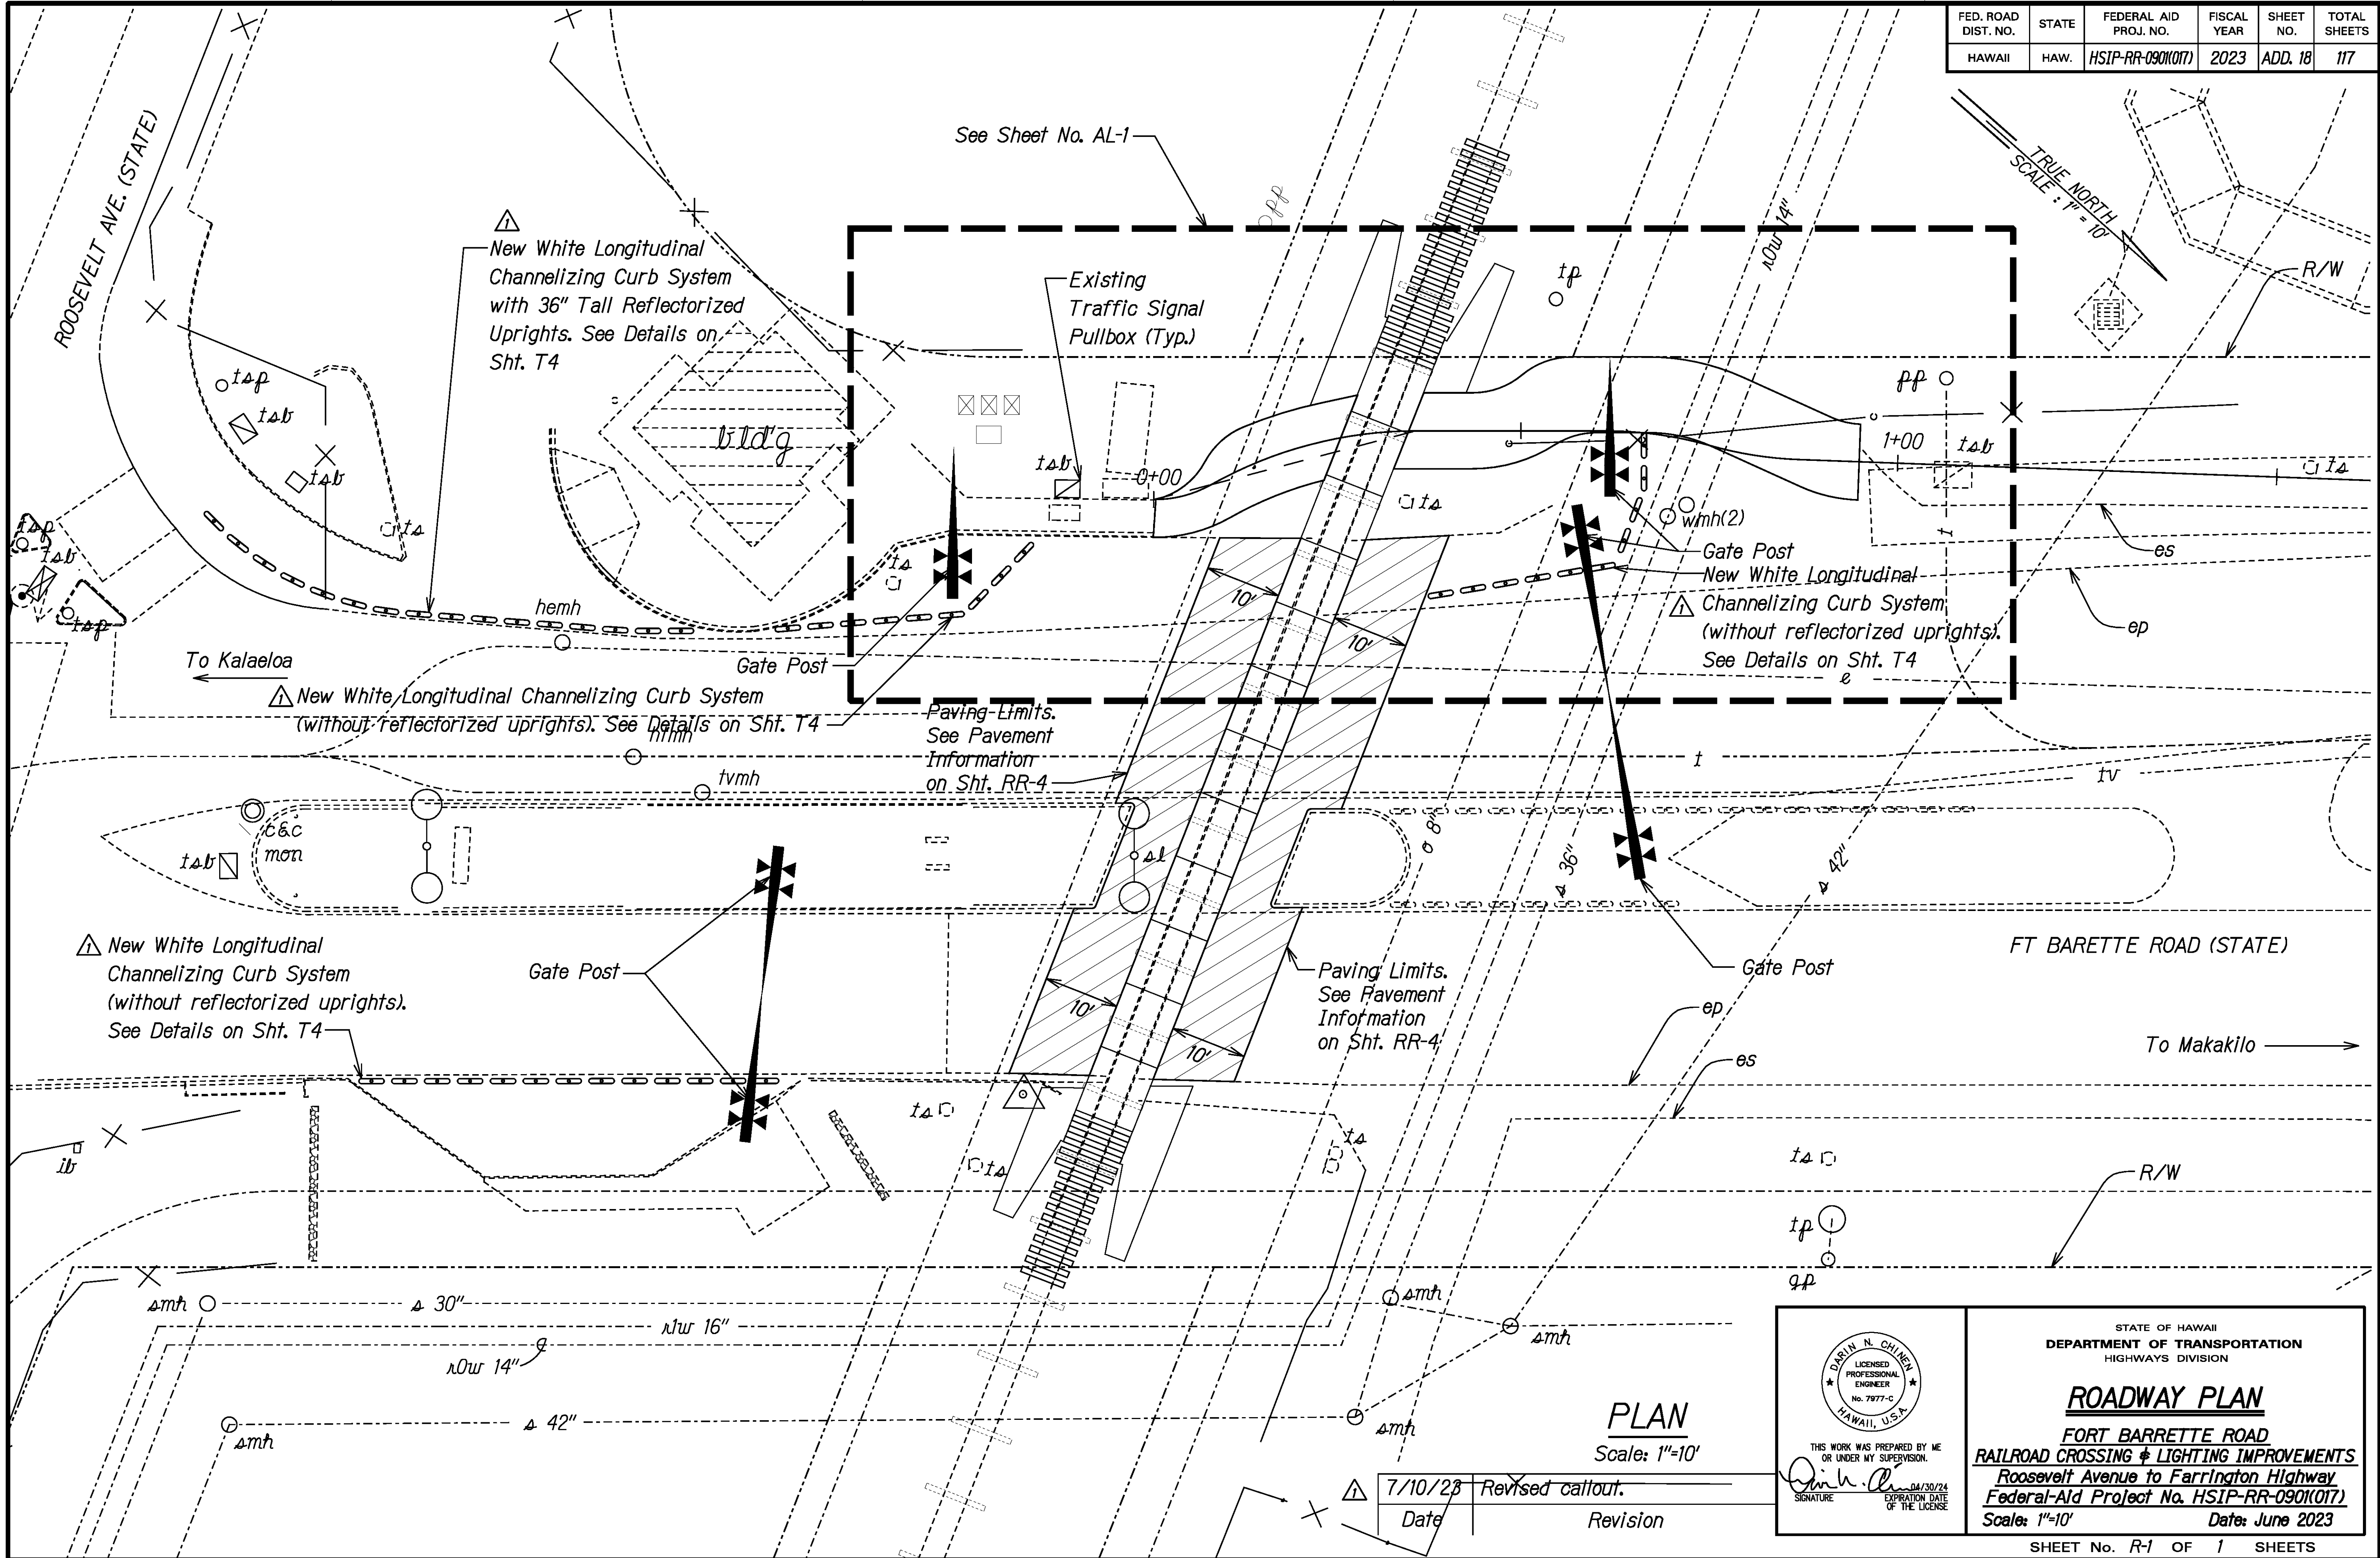

DARIN N. CHEN

LICENSED PROFESSIONAL ENGINEER

No. 7977-C

HAWAII, U.S.A.

THIS WORK WAS PREPARED BY ME OR UNDER MY SUPERVISION.

SIGNATURE

04/30/24

EXPIRATION DATE OF THE LICENSE

STATE OF HAWAII

DEPARTMENT OF TRANSPORTATION

HIGHWAYS DIVISION

ROADWAY PLAN

FORT BARRETTE ROAD

RAILROAD CROSSING & LIGHTING IMPROVEMENTS

Roosevelt Avenue to Farrington Highway

Federal-Aid Project No. HSIP-RR-0901(017)


Scale: 1"=10'

Date: June 2023

SHEET No. R-1 OF 1 SHEETS

SURVEY PLOTTED BY	DATE
DRAWN BY	
DESIGNED BY	
NOTED BY	
CHECKED BY	

FED. ROAD DIST. NO.	STATE	FEDERAL AID PROJ. NO.	FISCAL YEAR	SHEET NO.	TOTAL SHEETS
HAWAII	HAW.	HSIP-RR-0901(017)	2023	ADD. 22	117

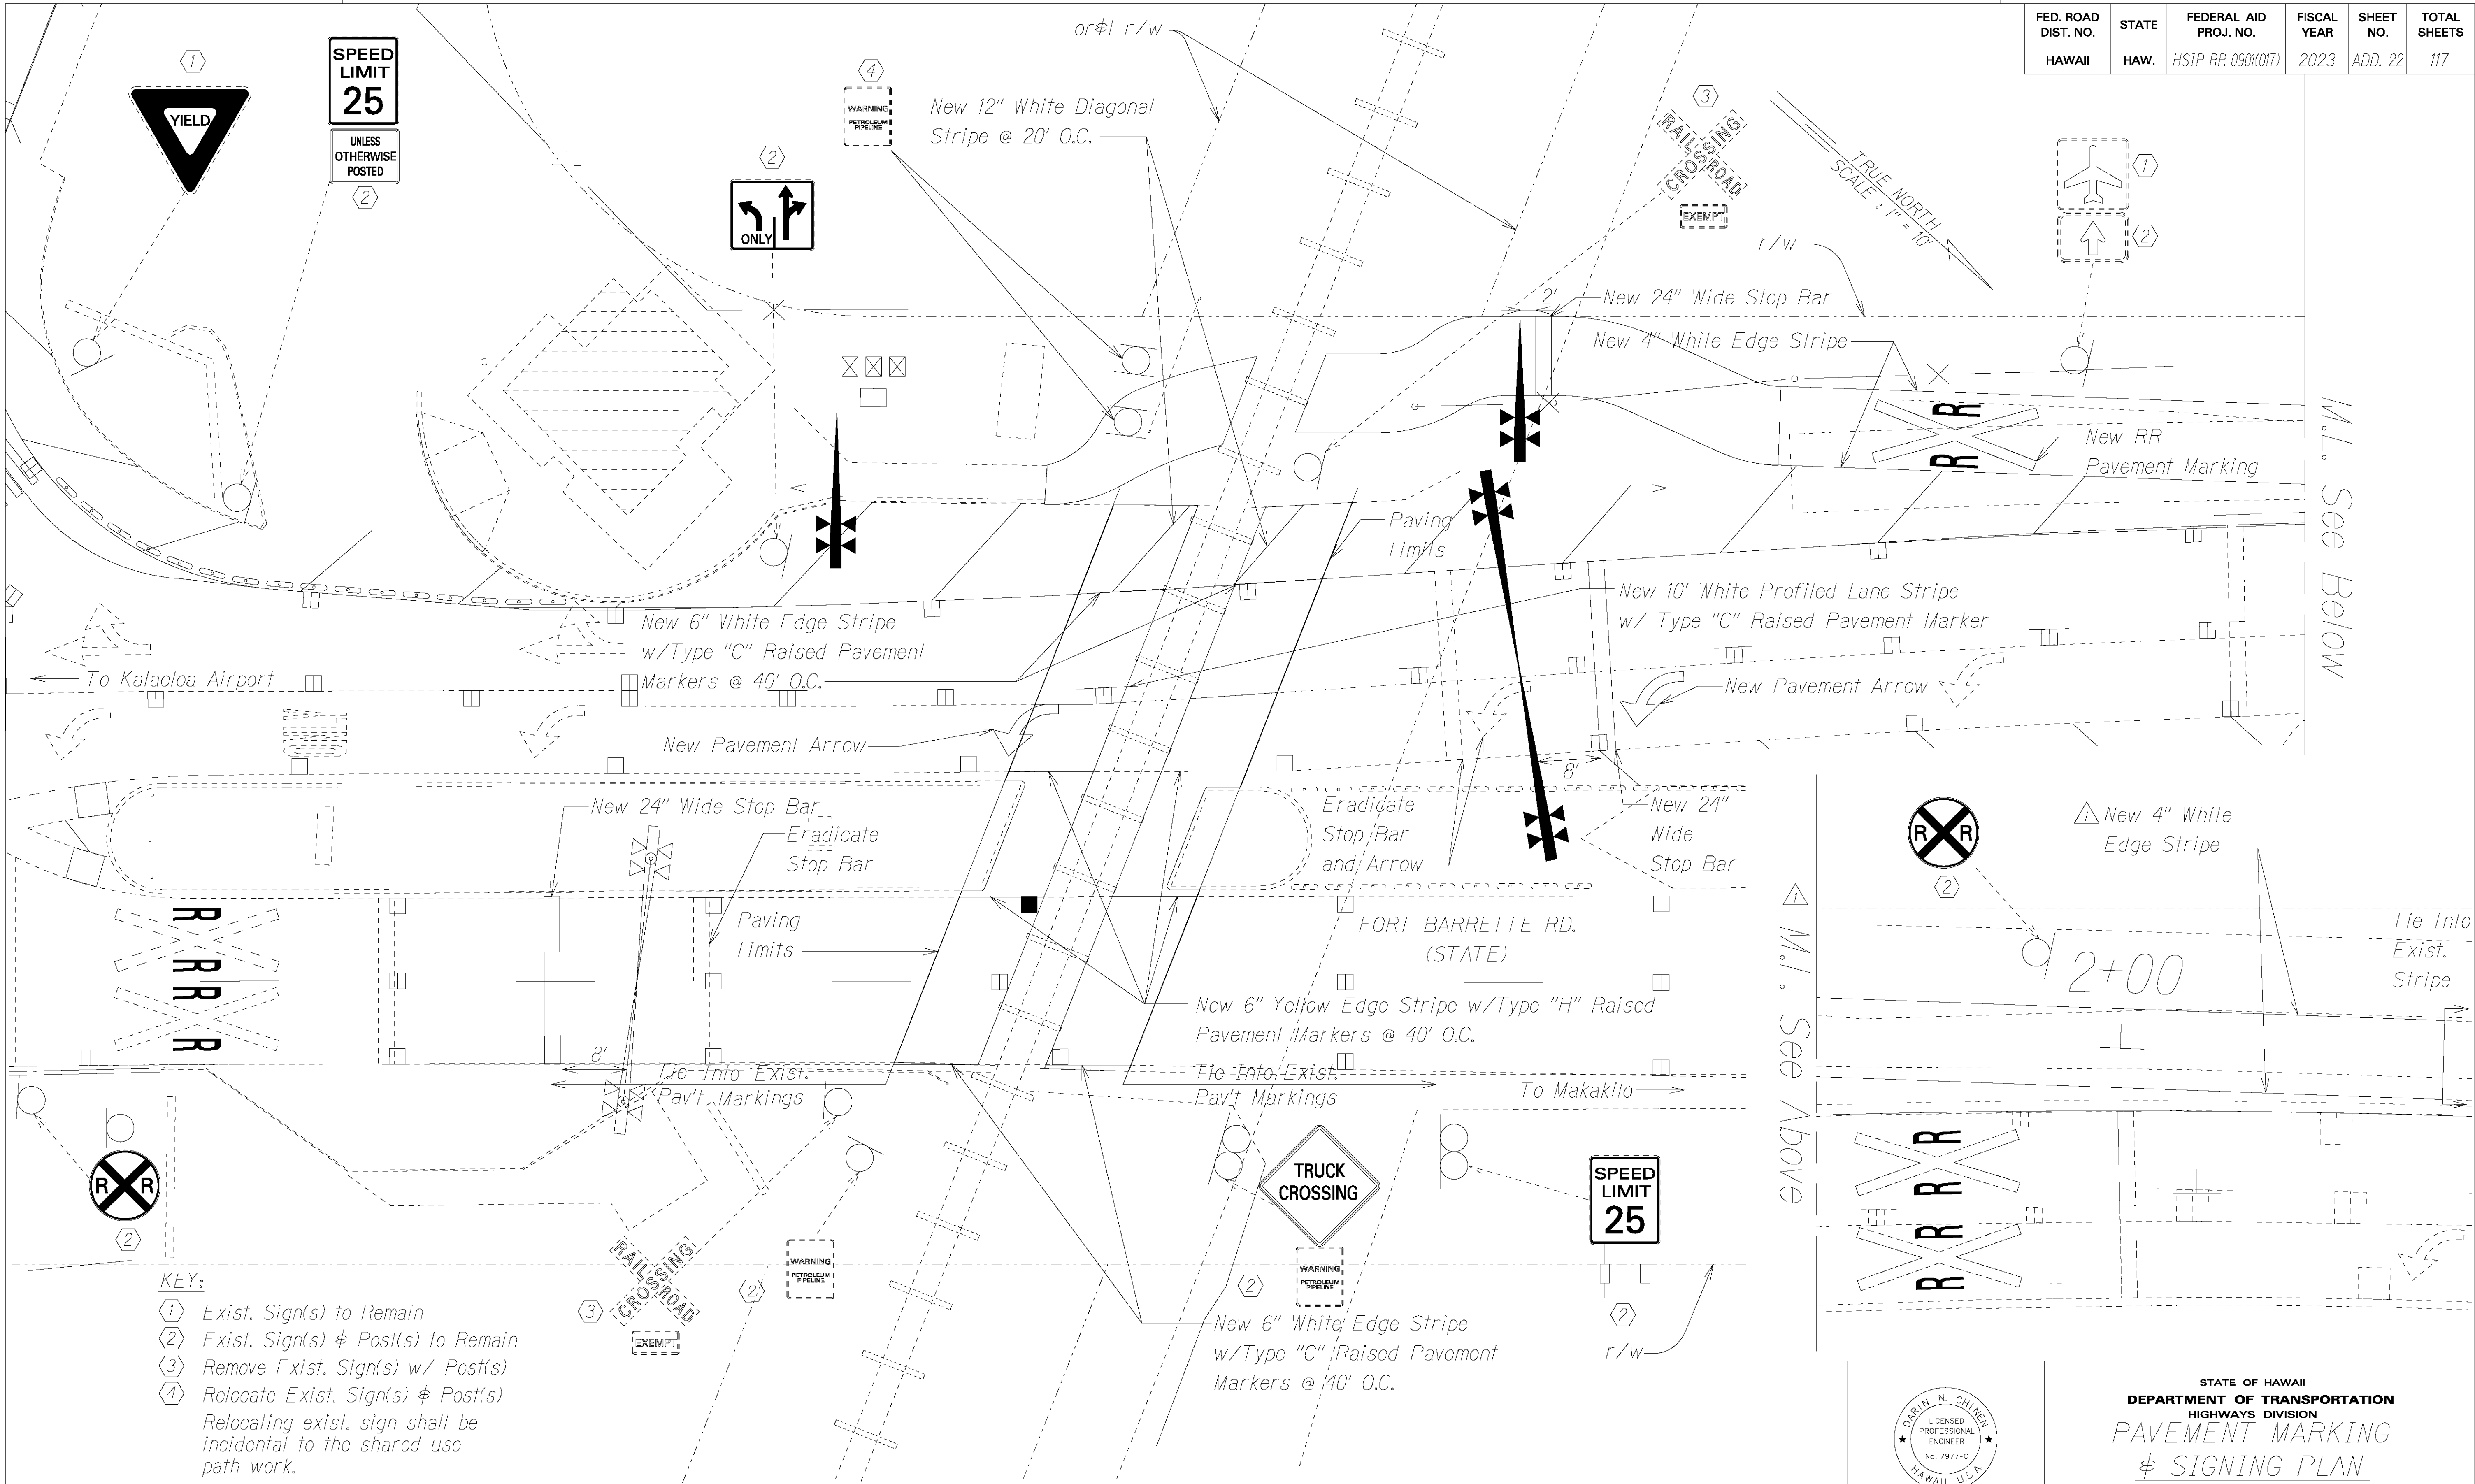

DATE	
SURVEY PLOTTED BY	
ORIGINAL PLAN	
DESIGNED BY	
NOTED BY	
CHECKED BY	
DATE	

- KEY:
- ① Exist. Sign(s) to Remain
 - ② Exist. Sign(s) & Post(s) to Remain
 - ③ Remove Exist. Sign(s) w/ Post(s)
 - ④ Relocate Exist. Sign(s) & Post(s)
- Relocating exist. sign shall be incidental to the shared use path work.

7/10/23	Revised New Striping, Callouts, and Bottom View.
Date	Revision

THIS WORK WAS PREPARED BY ME OR UNDER MY SUPERVISION.

SIGNATURE: *Darin N. Chinen* EXPIRATION DATE OF THE LICENSE: 04/30/24

STATE OF HAWAII
DEPARTMENT OF TRANSPORTATION
HIGHWAYS DIVISION

**PAVEMENT MARKING
& SIGNING PLAN**

FORT BARRETTE ROAD

RAILROAD CROSSING & LIGHTING IMPROVEMENTS

Roosevelt Avenue to Farrington Highway
Federal-Aid Project No. HSIP-RR-0901(017)

Scale: 1"=10' Date: June 2023