


FED. ROAD DIST. NO.	STATE	FEDERAL AID PROJ. NO.	FISCAL YEAR	SHEET NO.	TOTAL SHEETS
HAWAII	HAW.	HSIP-RR-0901(017)	2023	ADD. 18	117

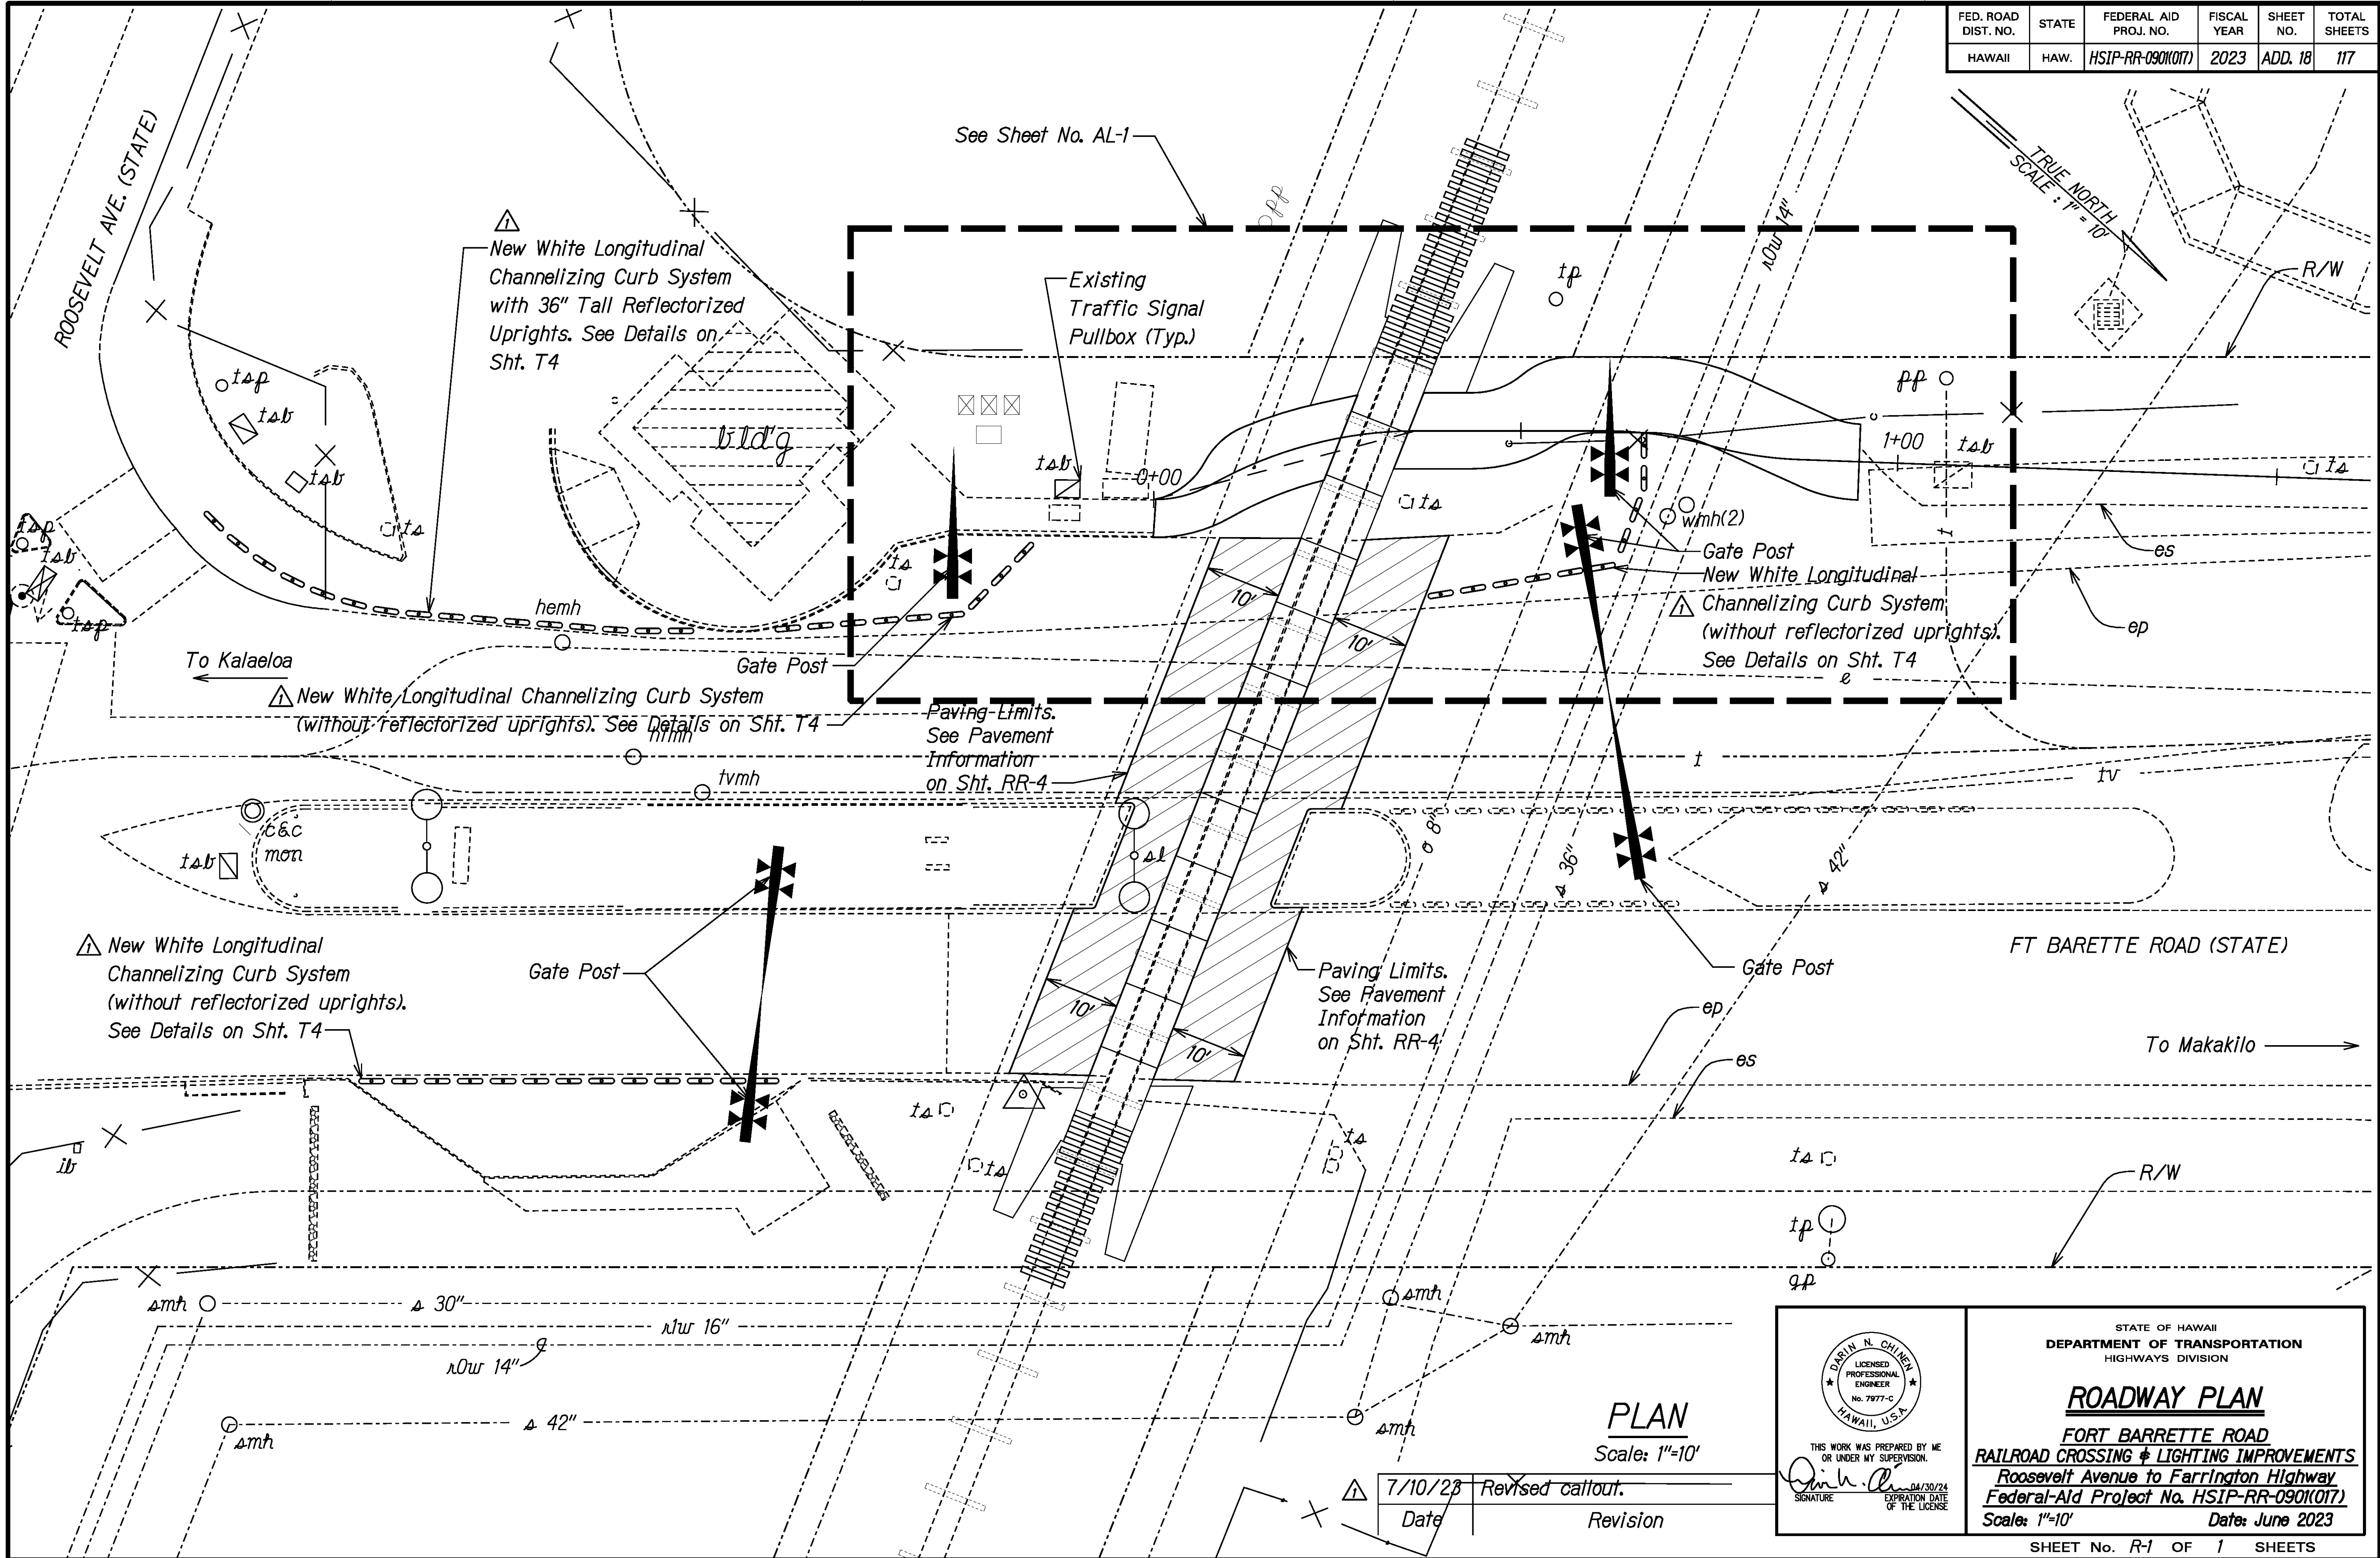

DARIN N. CHEN

LICENSED PROFESSIONAL ENGINEER

No. 7977-C

HAWAII, U.S.A.

THIS WORK WAS PREPARED BY ME OR UNDER MY SUPERVISION.

SIGNATURE

04/30/24

EXPIRATION DATE OF THE LICENSE

STATE OF HAWAII
DEPARTMENT OF TRANSPORTATION
HIGHWAYS DIVISION

ROADWAY PLAN

FORT BARRETTE ROAD

RAILROAD CROSSING & LIGHTING IMPROVEMENTS

Roosevelt Avenue to Farrington Highway

Federal-Aid Project No. HSIP-RR-0901(017)

Scale: 1"=10'

Date: June 2023

SHEET No. R-1 OF 1 SHEETS

SURVEY PLOTTED BY	DATE
DRAWN BY	
CHECKED BY	
NOTE BOOK	
QUANTITIES BY	
CHECKED BY	