


FINAL SURVEY
DATE: 10/1/32
BY: [Signature]
SURVEYED: [Signature]
TEMPLATE: [Signature]
NOTE BOOK: [Signature]
NO. 7113


ORIGINAL SURVEY
DATE: 10/1/32
BY: [Signature]
SURVEYED: [Signature]
TEMPLATE: [Signature]
NOTE BOOK: [Signature]
NO. 7113

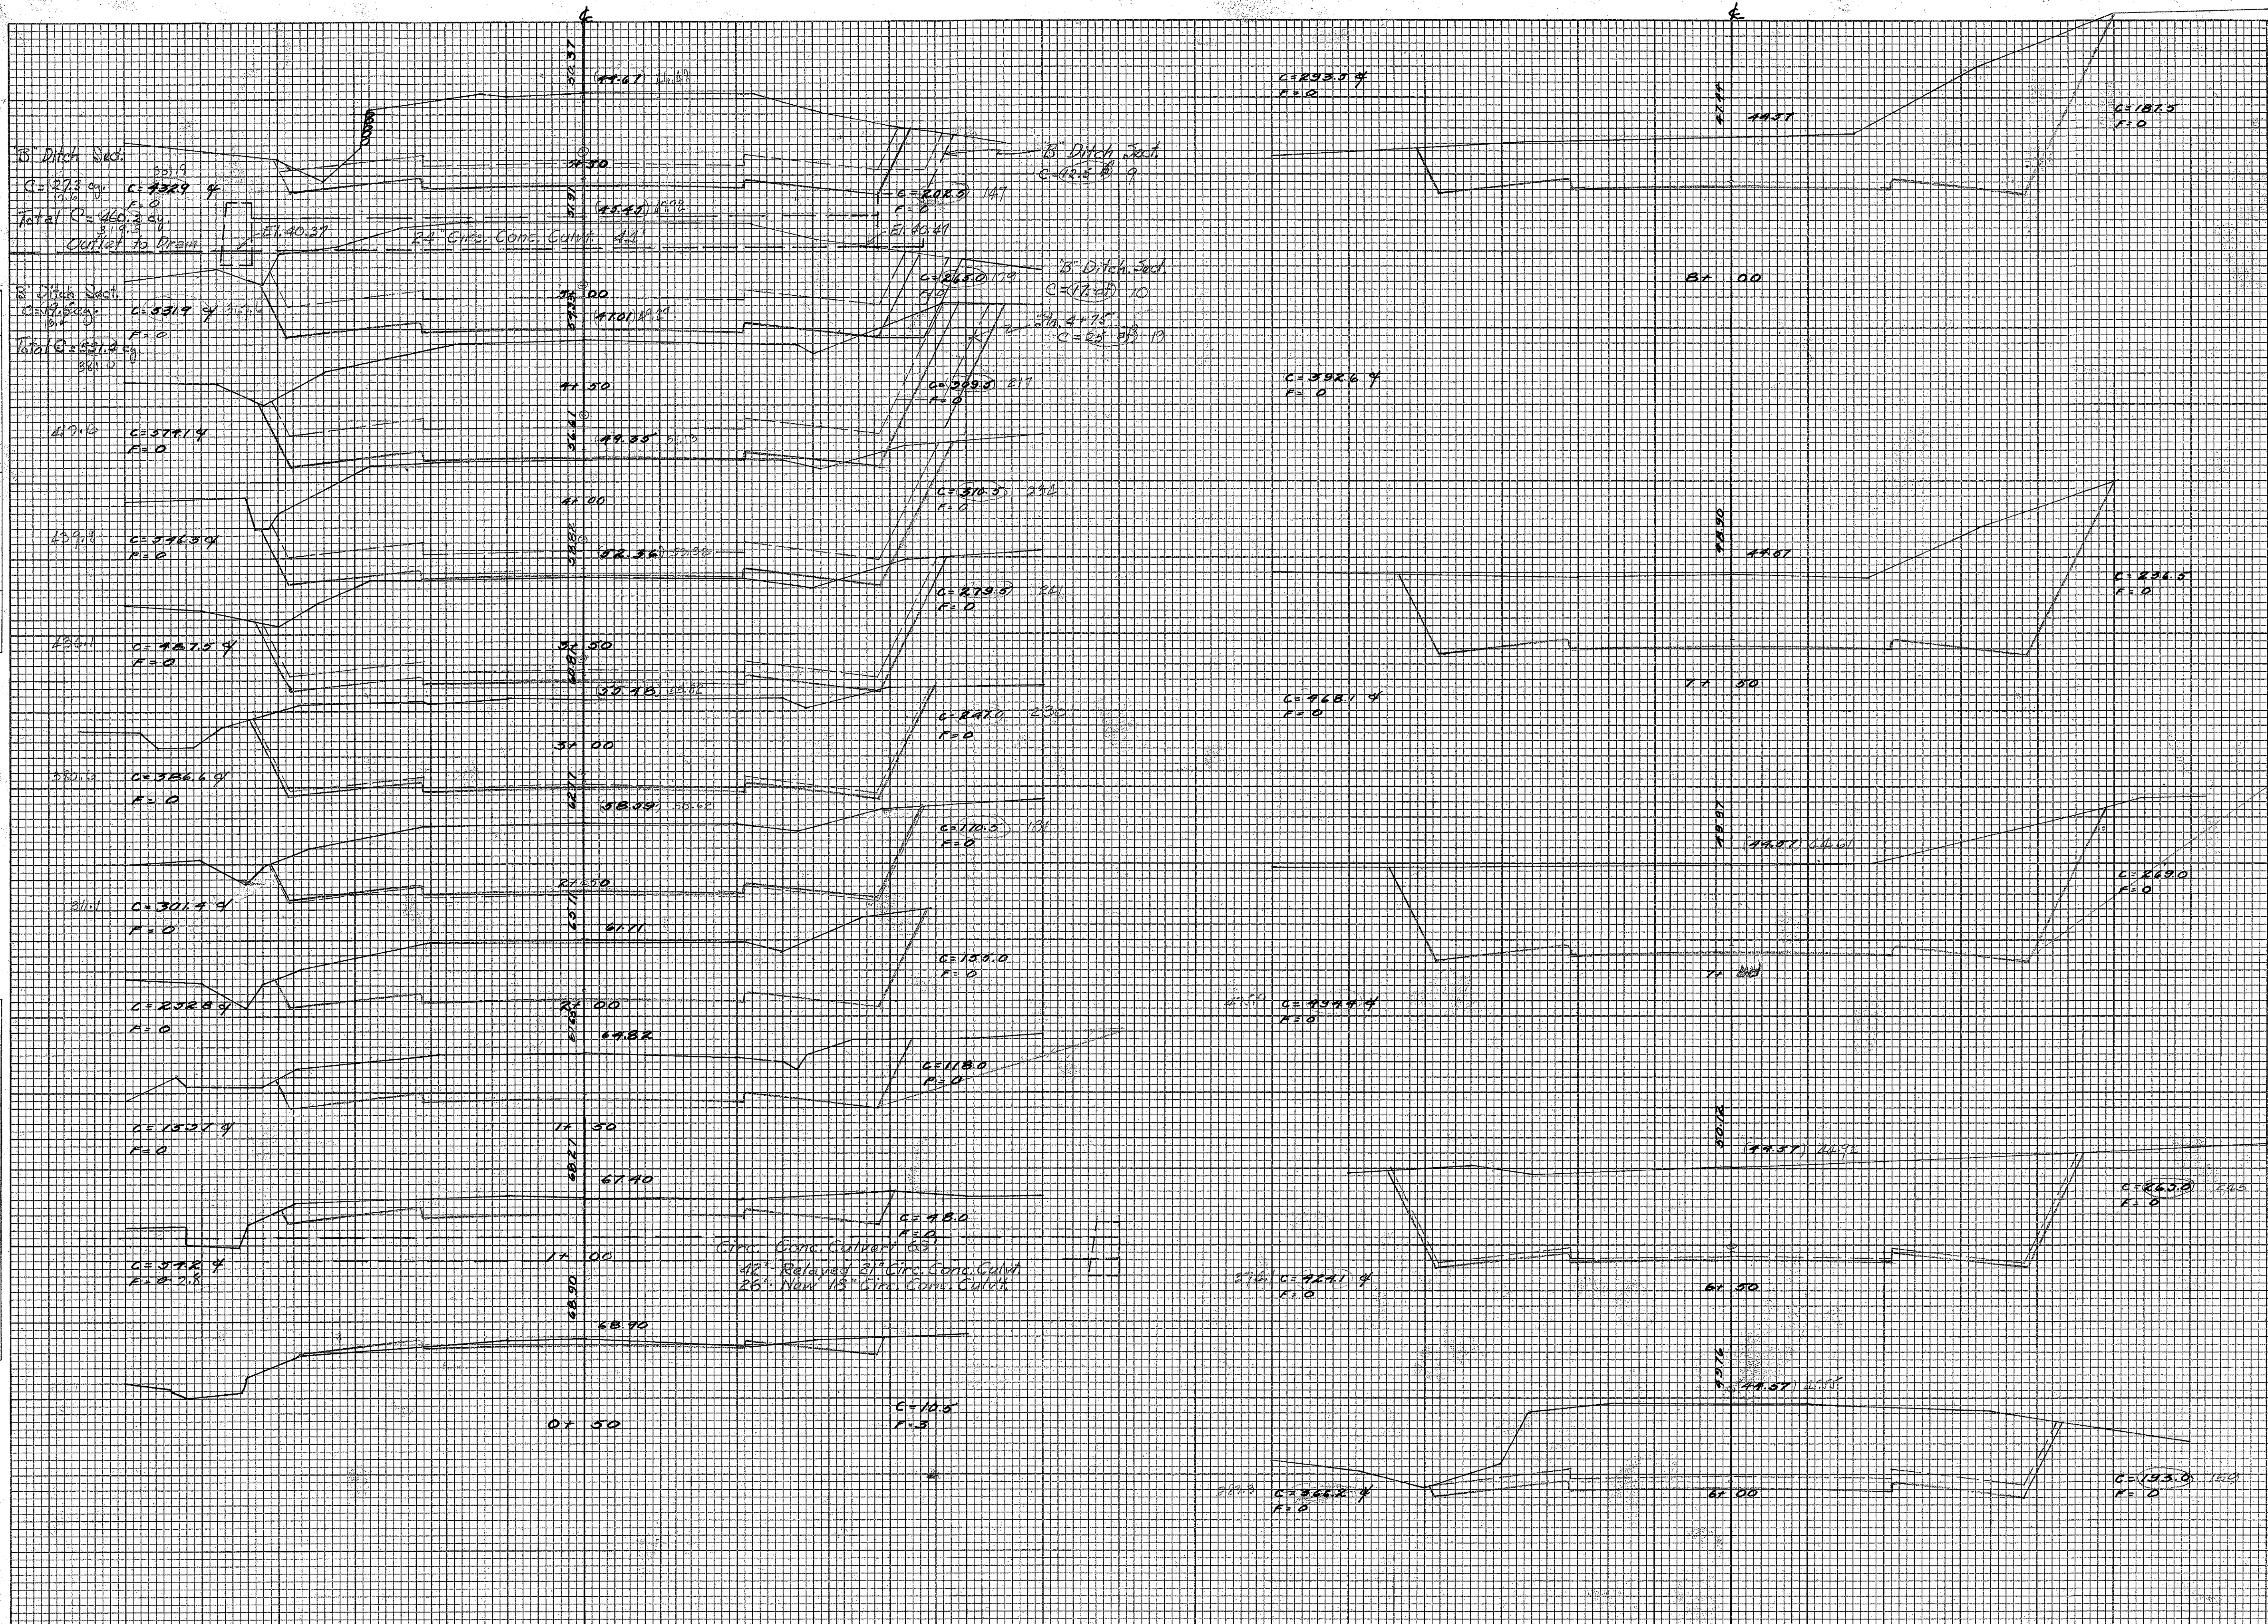

DATE	BY	SUPERVISOR	DATE
FINAL SURVEY	NOTE BOOK	NO.	

DATE	BY	SUPERVISOR	DATE
ORIGINAL SURVEY	NOTE BOOK	NO.	


FED. ROAD DIST. NO.	STATE	FED. AID PROJ. NO.	FISCAL YEAR	SHEET NO.	TOTAL SHEETS
HAWAII	HAW	NRH.7E	1933	18	20

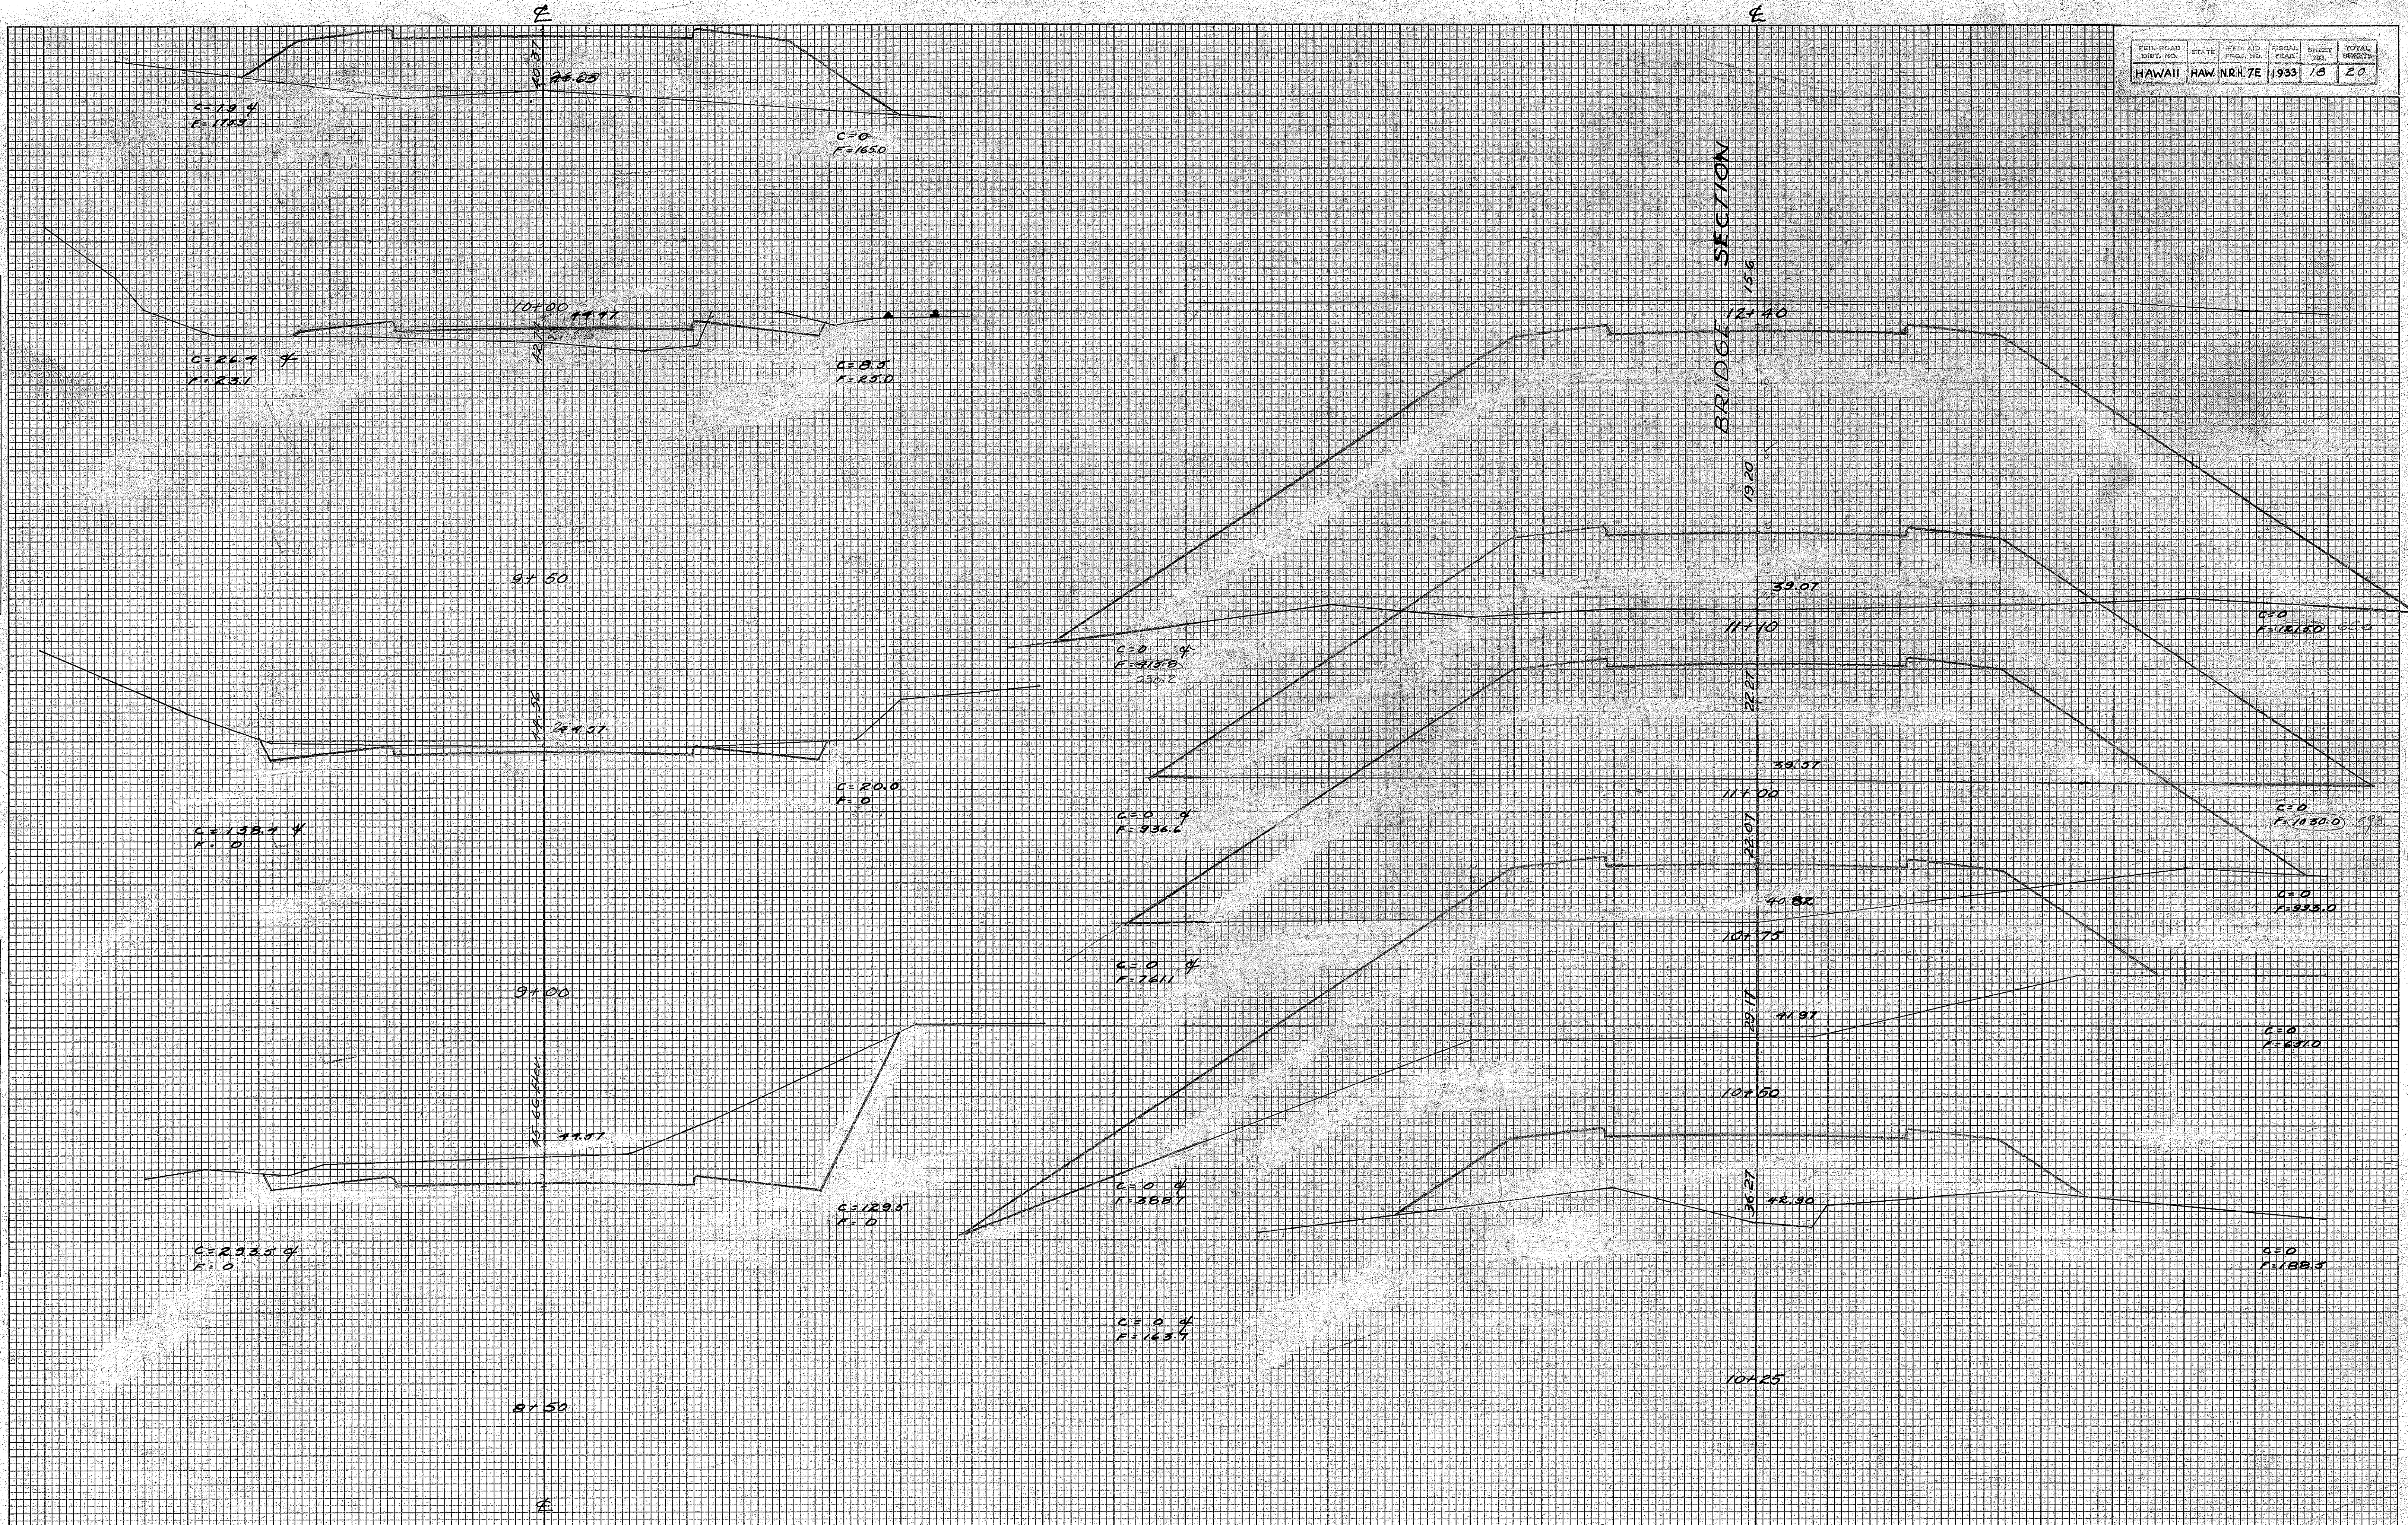

FINAL SURVEY NOTE BOOK NO.	SURVEYED	BY	DATE
	PLOTTED		
	AREA		
	CHECKED		

ORIGINAL SURVEY NOTE BOOK NO.	SURVEYED	BY	DATE
	PLOTTED		
	AREA		
	CHECKED		

FED. ROAD DIST. NO.	STATE	FED. AID PROJ. NO.	FISCAL YEAR	SHEET NO.	TOTAL SHEETS
HAWAII	HAW.	NRH 7E	1933	19	20

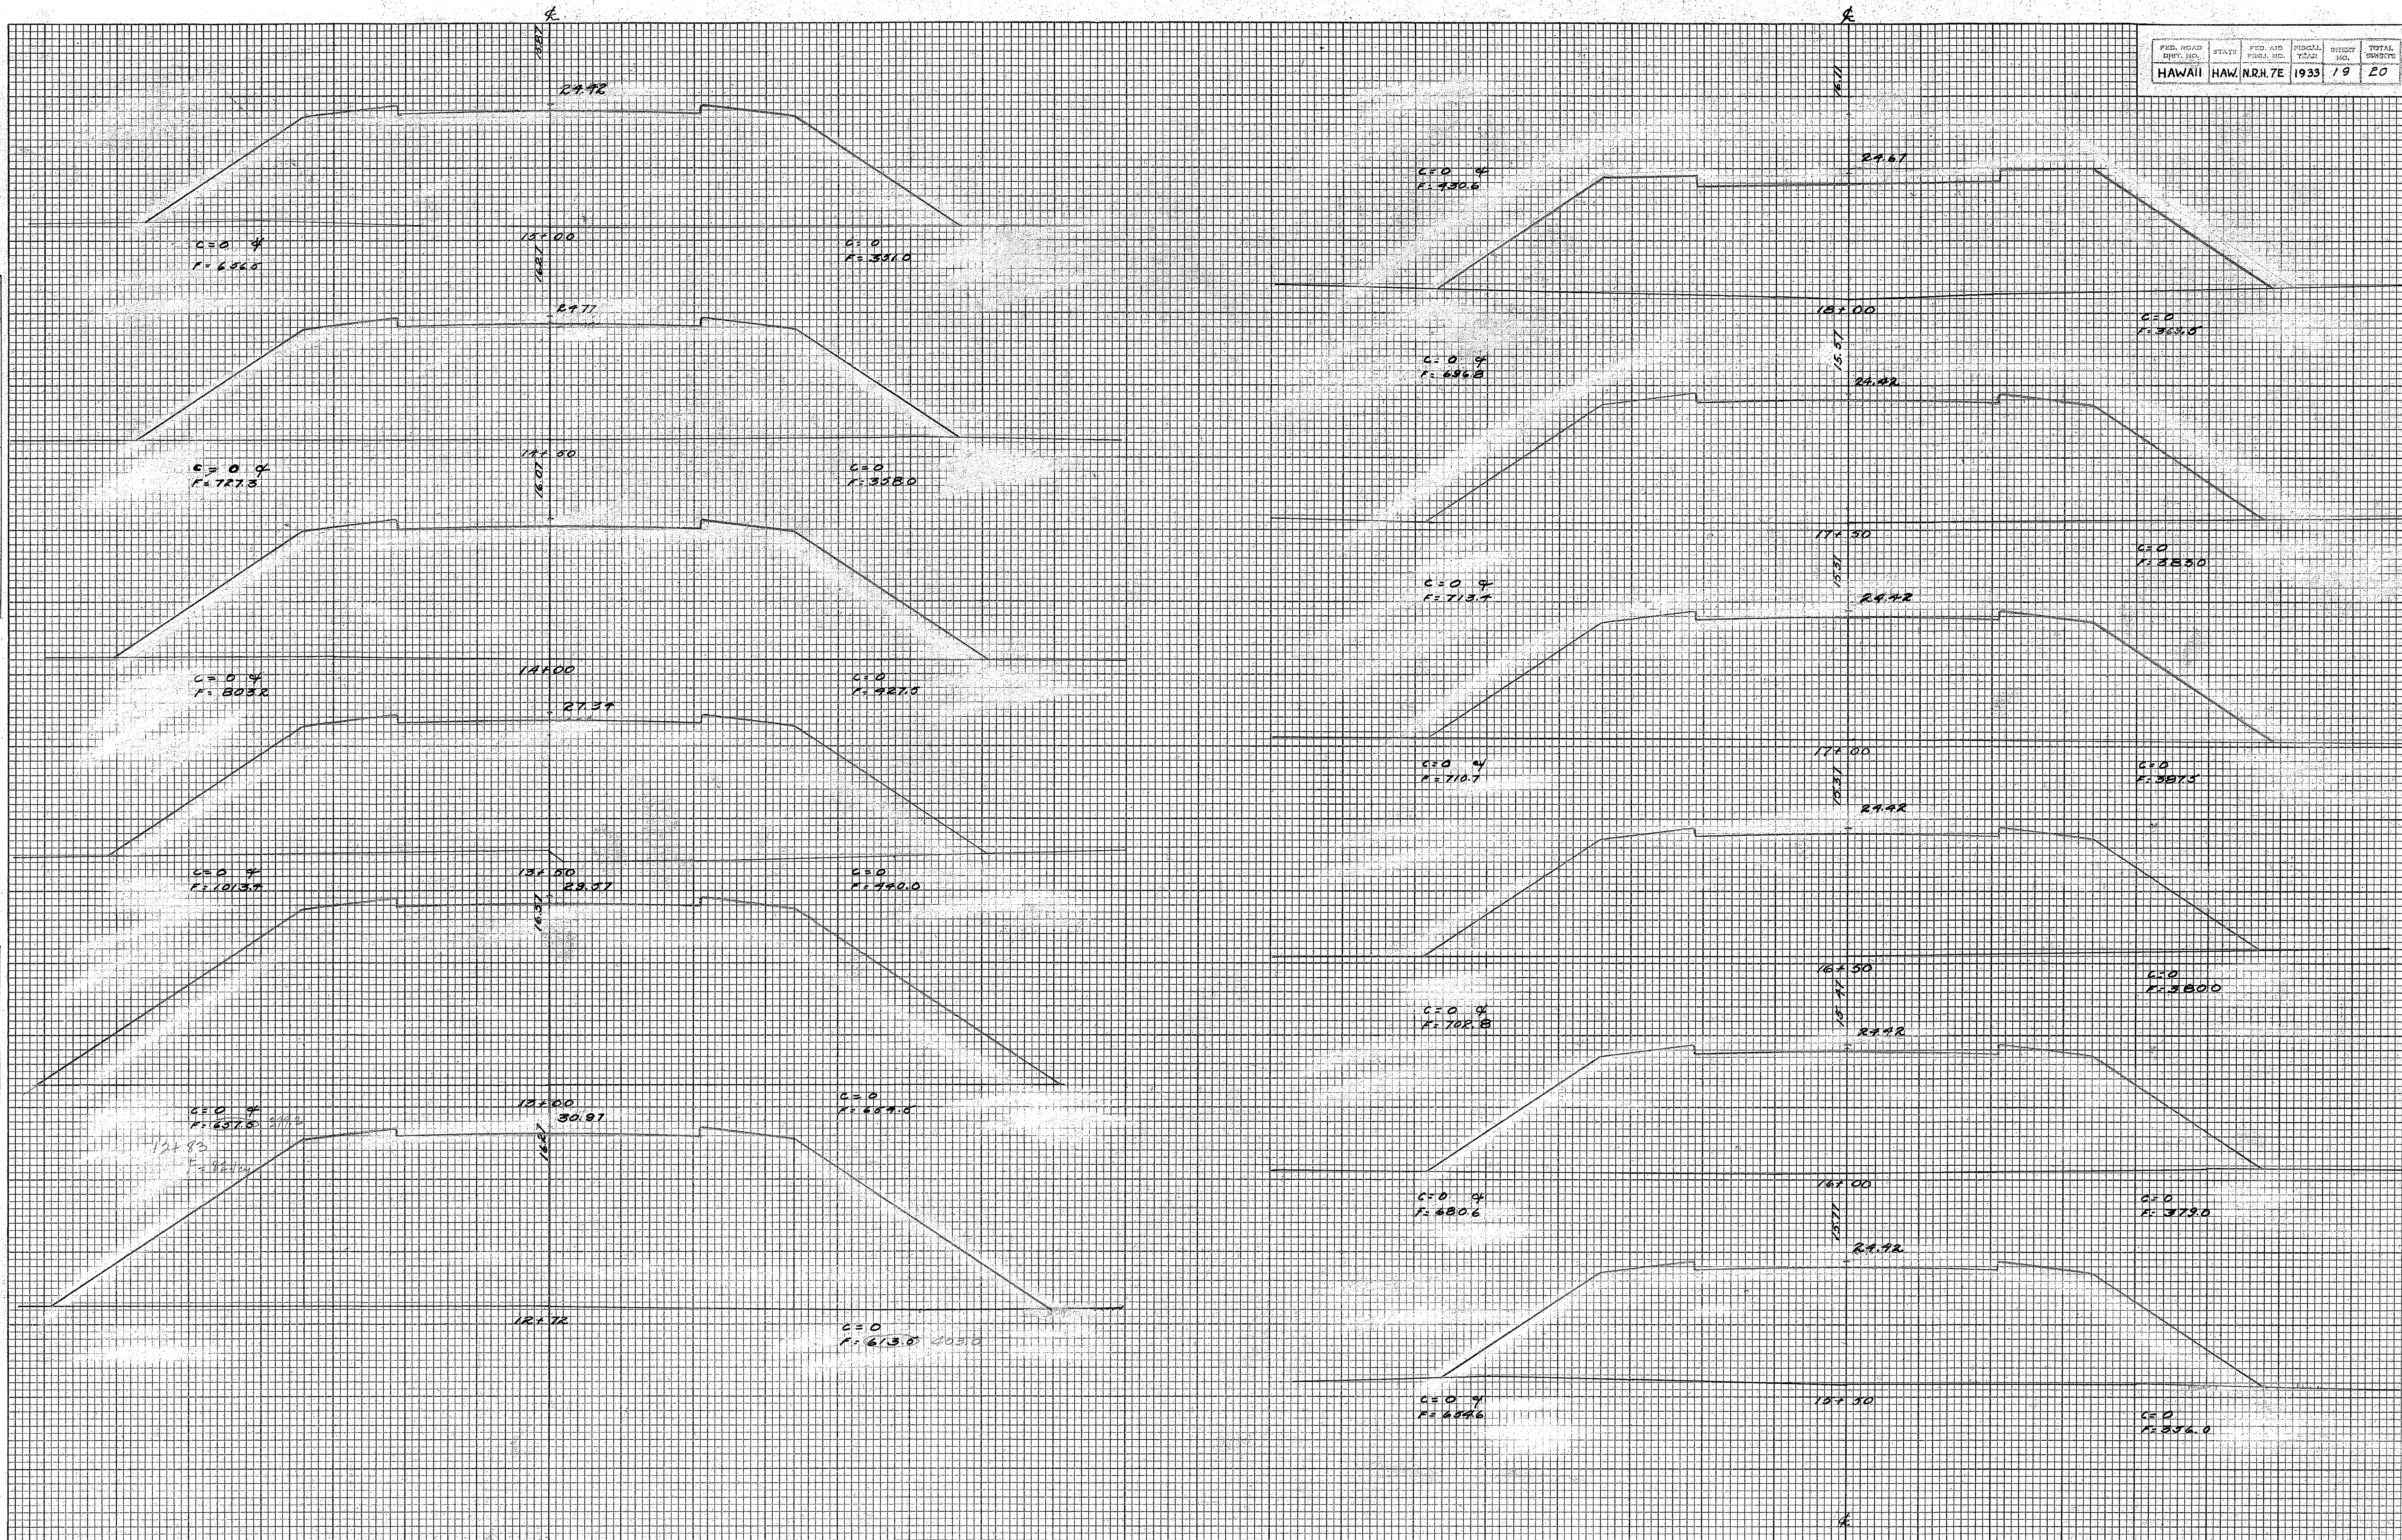

ORIGINAL SURVEY	SURVEYED	BY	DATE
	PLOTTED		
	TEMPLATE		
	AREAS		10/25/23
	AREAS CHECKED		10/25/23
NOTE BOOK			
NO.			

